



PARIC CORPORATION
77 Westport Plaza Suite 250
St. Louis, MO 63146
TEL: 636-561-9500
FAX: 636-561-9501

REQUEST FOR INFORMATION DATE: June 02, 2016 NO.: RFI-147

To: Cannon Design

Attn: Kelvin Patel

From: Paric Corporation

Requested By: Joe Voypick

Project Name: 15051-Webster University Interdisciplinary Science Building Project No.: 15051

Subject: AVB at detail 3/A421

Response Required By: June 09, 2016

Drawing / Spec Reference:

Information Requested:

Please confirm the AVB is not required behind the Galvanized angle (area indicated in red on attached plan). The angle will be placed in contact with the sheathing and the AVB will be placed over it and returned into the jamb (area denoted in green).

Response:

Please see KWA's response on the
attached drawing: Sheet A0421
6/9/2016




ARCHITECT'S RESPONSE:

This information is provided as an interpretation of the Contract Documents for implementation. It is not an authorization for change to the Contract Sum or Contract Time. If this information results in a claim for a change to the Contract, the Contractor shall notify the [Construction Manager][Architect] of a change through the change process.

Cc: Kathy Bathe, Paric Corporation

Answered By: _____

Date: June 9, 2016

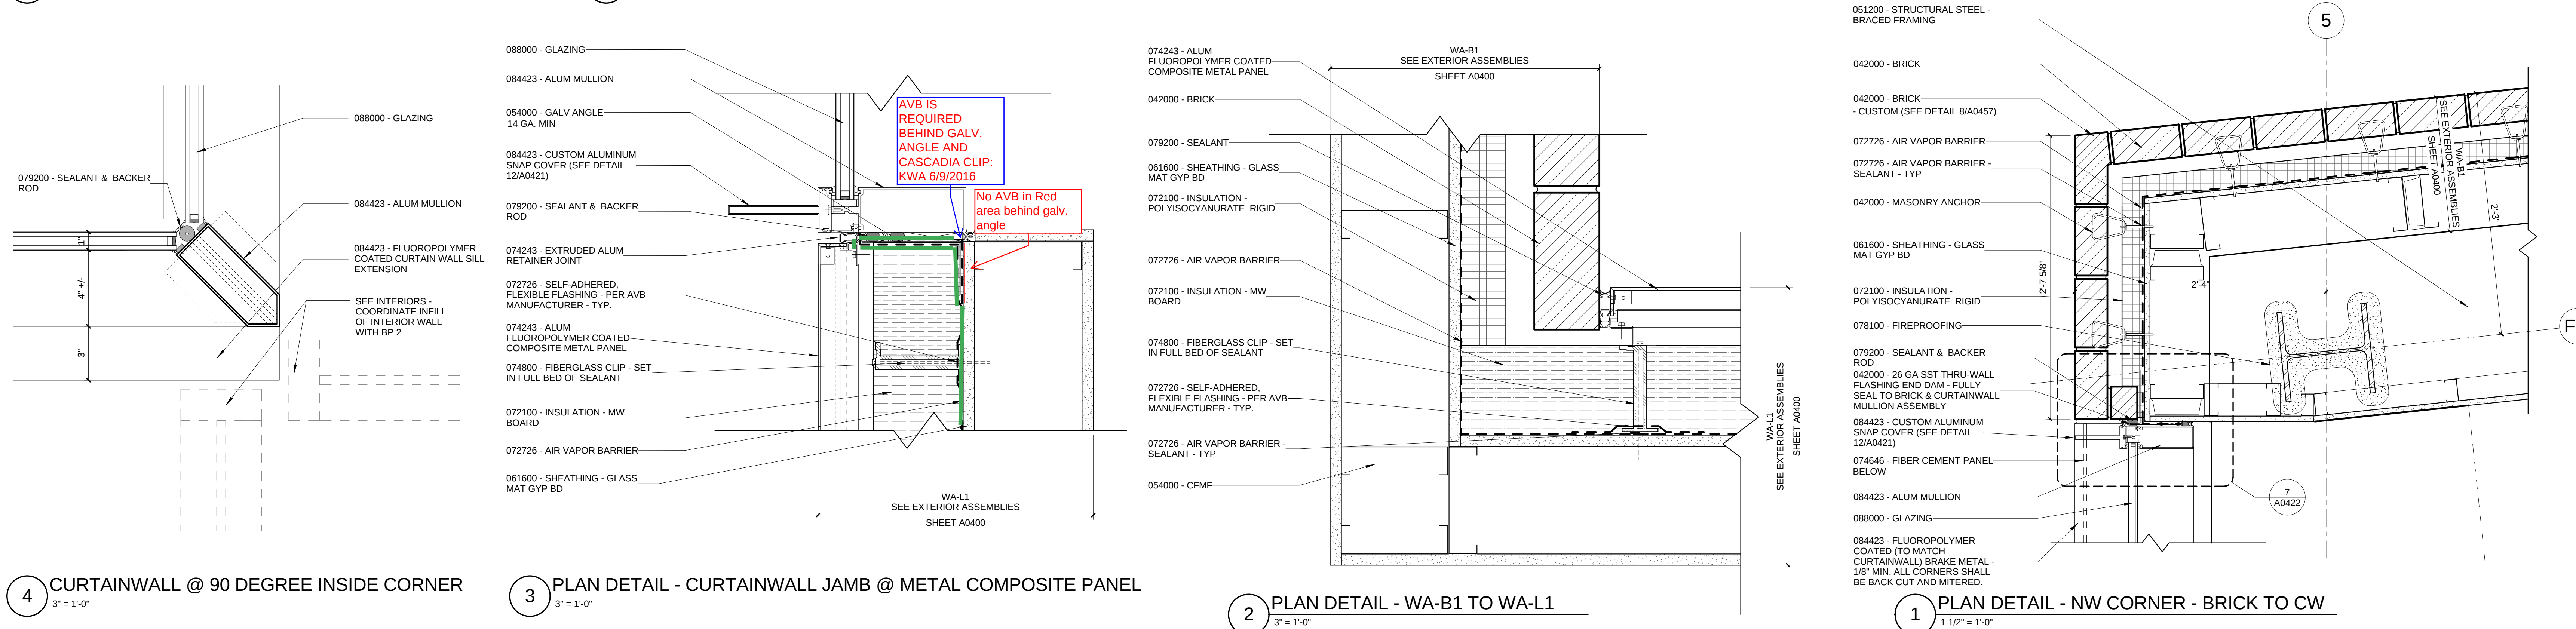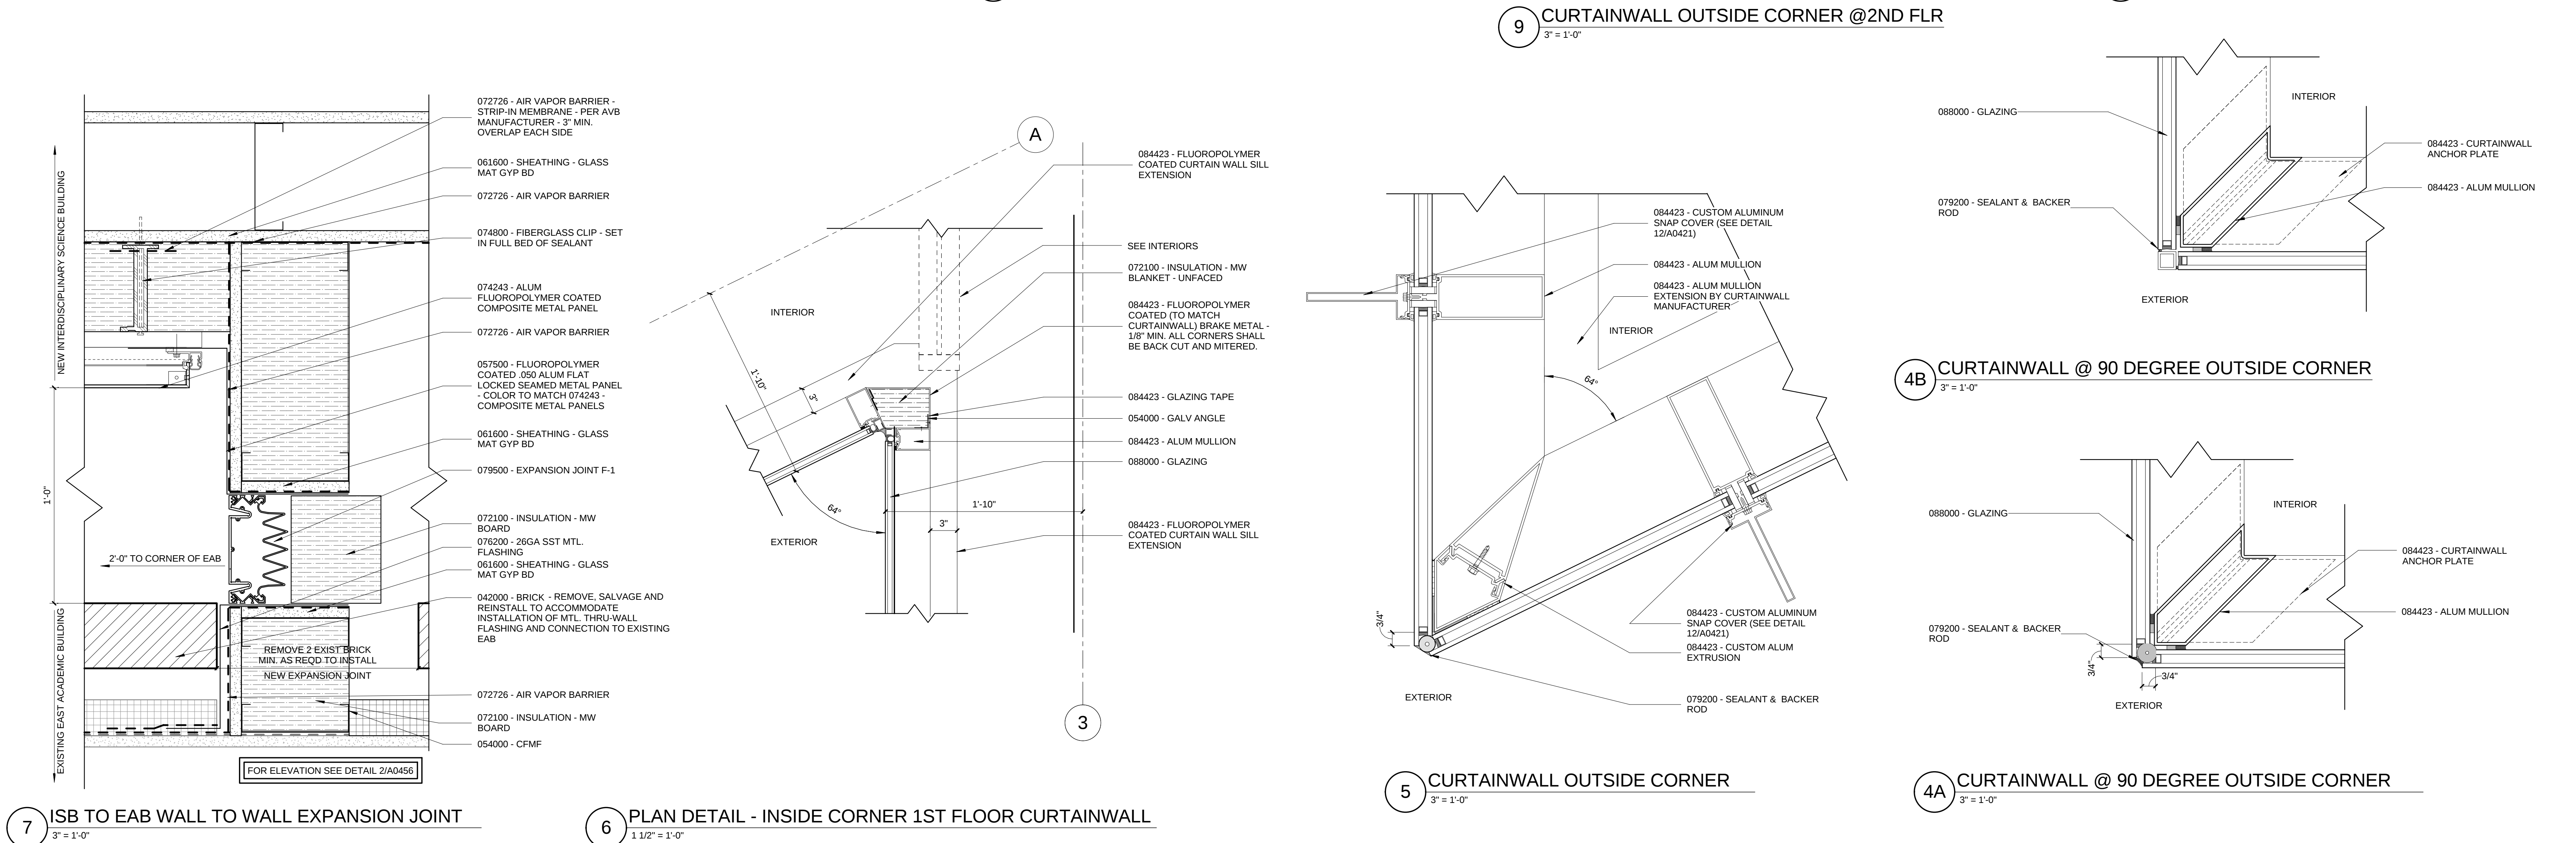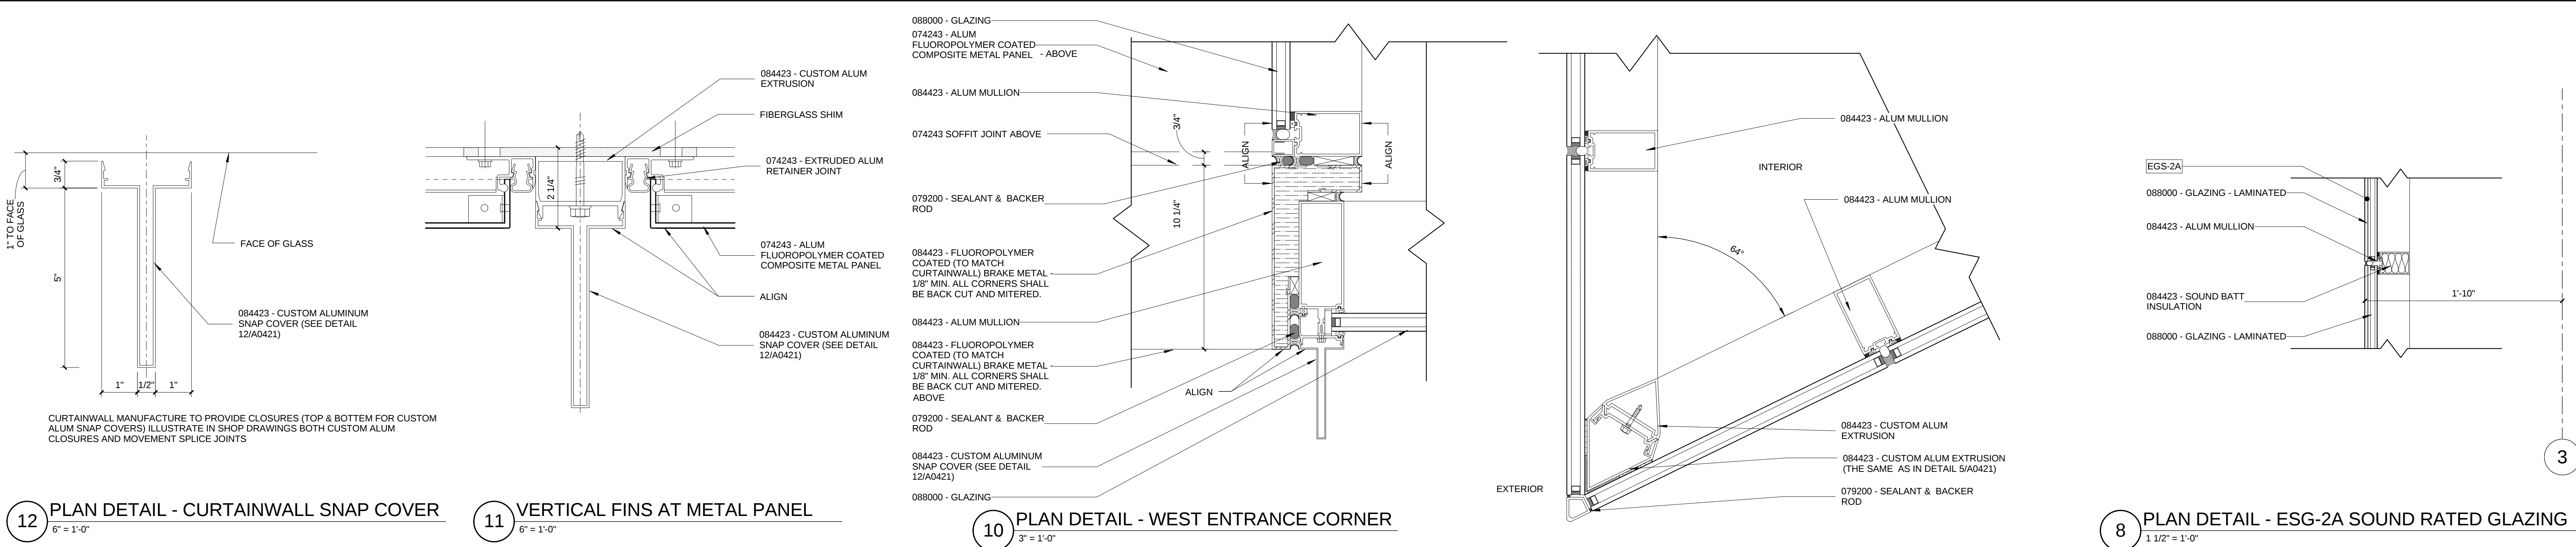

William Tao & Associates, Inc.
ME/PE/PP Engineer
7955 Manchester Road, Suite 125
St. Louis, MO 63143
314-884-7600

David Mason & Associates, Inc.
Structural & Civil Engineer
800 South Vandeventer Avenue
St. Louis, MO 63110
314-534-1053

Faith Group
Technology
3101 S. Hanley Rd. Suite 100
St. Louis, MO 63143
314-991-2229

Kuhnmann Leavitt, Inc.
Environmental Graphics & Signage
7400 Pershing Ave.
St. Louis, MO 63130
314-725-6616

KWA Architects
Architecture
9721 Litzinger Road
St. Louis, MO 63124
314-962-2560

Spellman Brady & Company
Interior Designer
8251 Maryland Avenue, Suite 300
St. Louis, MO 63105
314-862-0070

SWT Design
Landscape Architect
7722 Big Bend Blvd
St. Louis, MO 63119
314-644-5700

Webb Engineering Services, Inc.
Planning & Fire Protection
1400 S. 3rd Street, Suite 201
St. Louis, MO 63104
314-588-0600

ISSUED FOR CONSTRUCTION (BP1) 15 JAN 2016
No. Description Date

Drawing Title:

EXTERIOR PLAN DETAILS

Project No.: 04561.01 Checked by:

A0421