



PARIC CORPORATION
77 Westport Plaza Suite 250
St. Louis, MO 63146
TEL: 636-561-9500
FAX: 636-561-9501

REQUEST FOR INFORMATION DATE: June 13, 2016 NO.: RFI-166

To: Cannon Design

Attn: Kelvin Patel

From: Paric Corporation

Requested By: Joe Voypick

Project Name: 15051-Webster University Interdisciplinary Science Building Project No.: 15051

Subject: revised edge of slab anchor proposal for curtainwall

Response Required By: June 20, 2016

Drawing / Spec Reference:

Information Requested:

In response to comments on RFI 155, the shim width will be 3/8" and the attached document provides loads

Response:

DOCUMENT RETAINED FOR INFORMATION ONLY. FINAL COORDINATION WILL OCCUR ONCE A SYSTEM AND SYSTEM SUPPORT PROPOSAL HAVE BEEN APPROVED.

ARCHITECT'S RESPONSE:


This information is provided as an interpretation of the Contract Documents for implementation. It is not an authorization for change to the Contract Sum or Contract Time. If this information results in a claim for a change to the Contract, the Contractor shall notify the [Construction Manager][Architect] of a change through the change process.

Cc: Kathy Bathe, Paric Corporation


Answered By: **JILL WALKER / DMA**

Date: **6/20/2016**


Red lines denote location where system weight would be supported

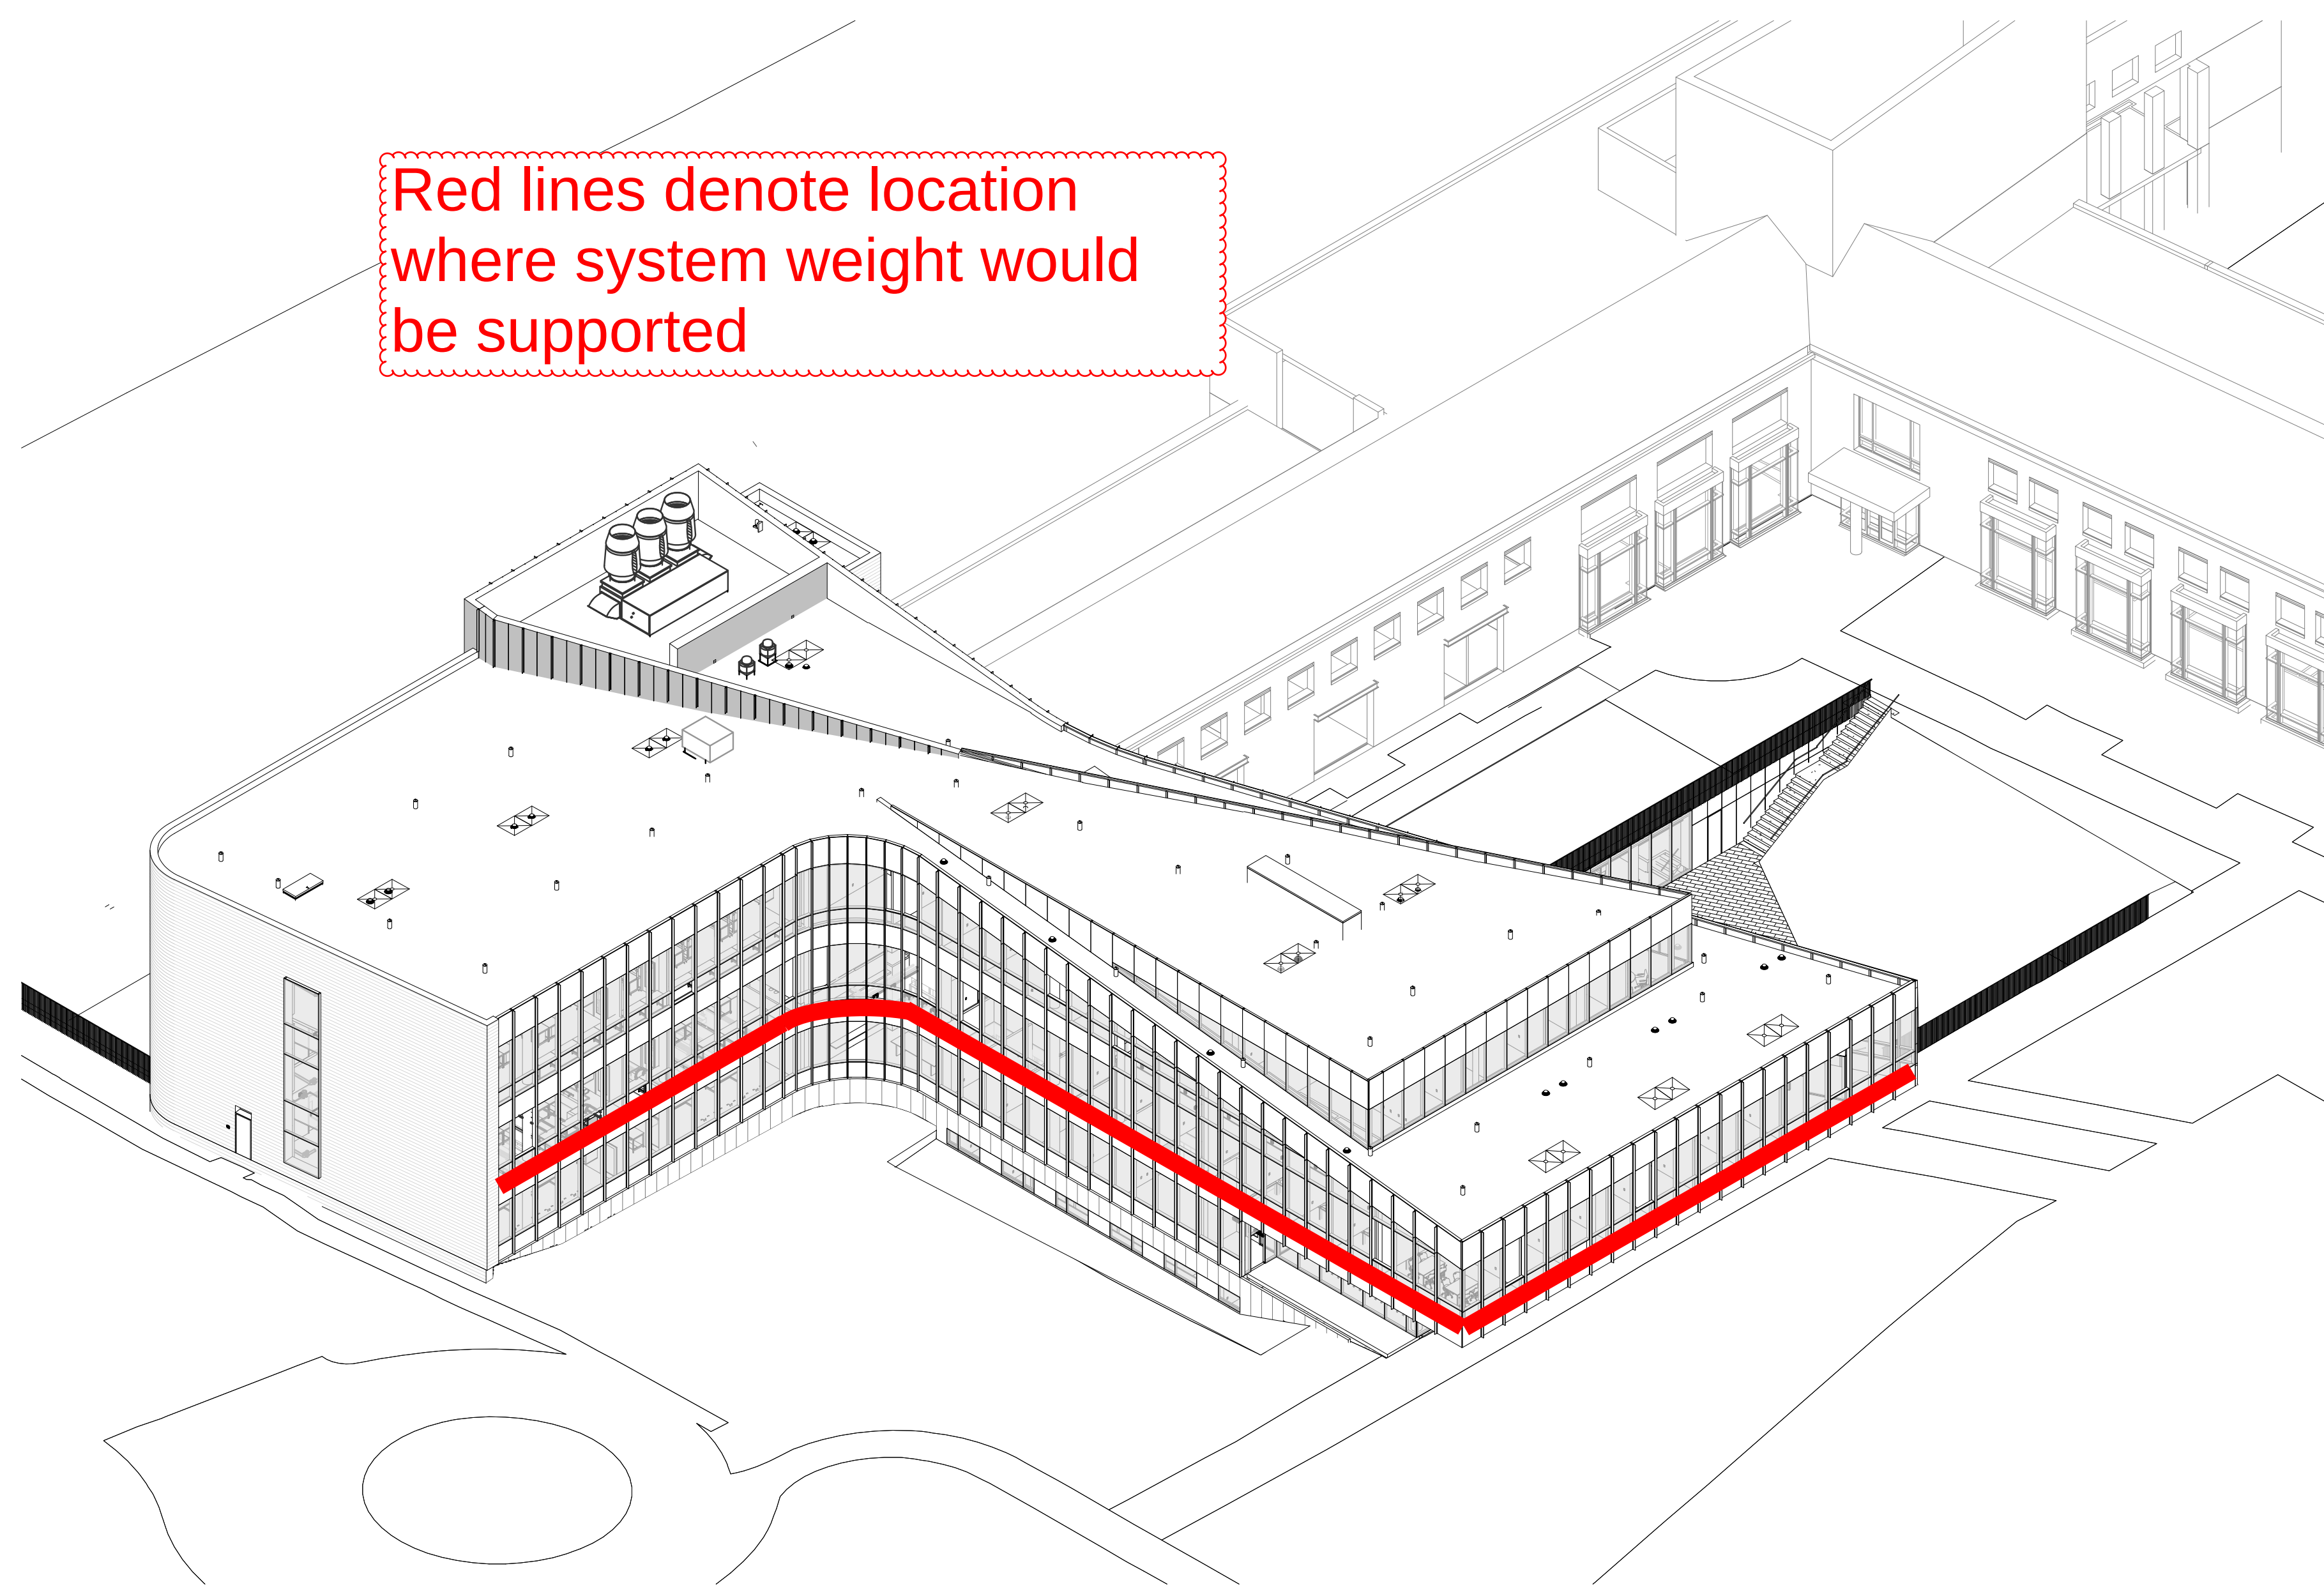


4 3D VIEW - NW CORNER

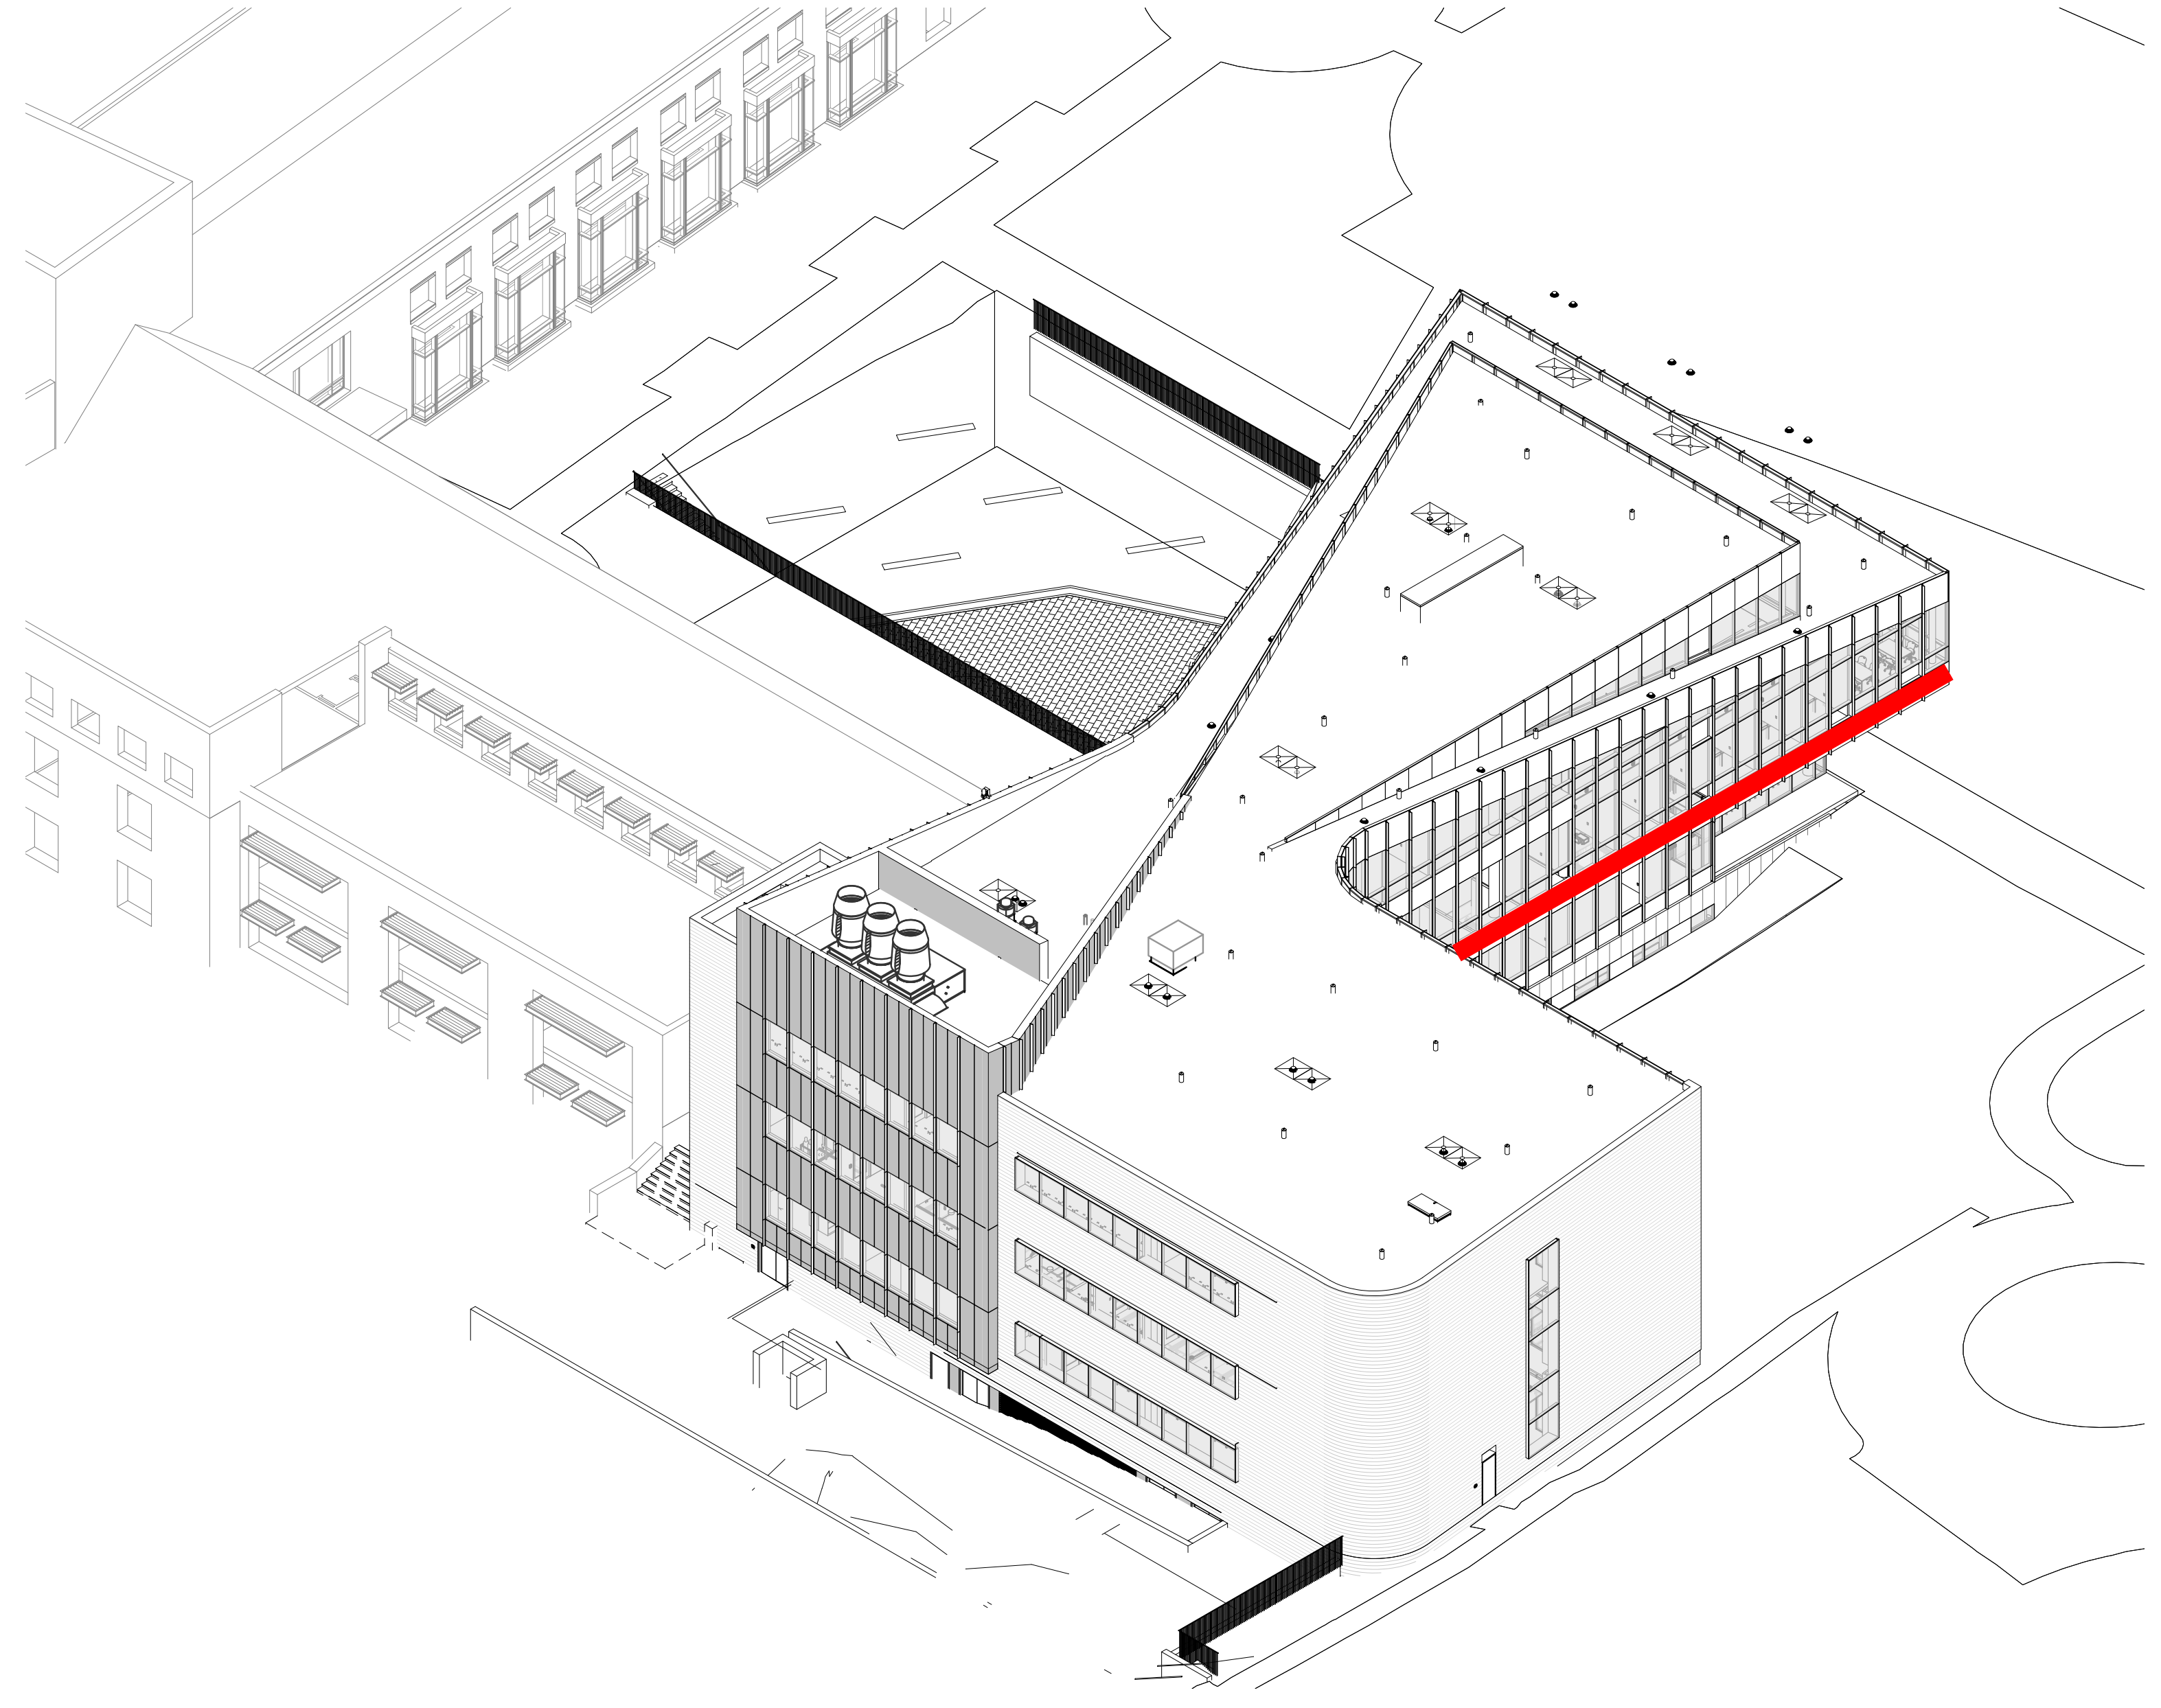

3 3D VIEW - NE CORNER

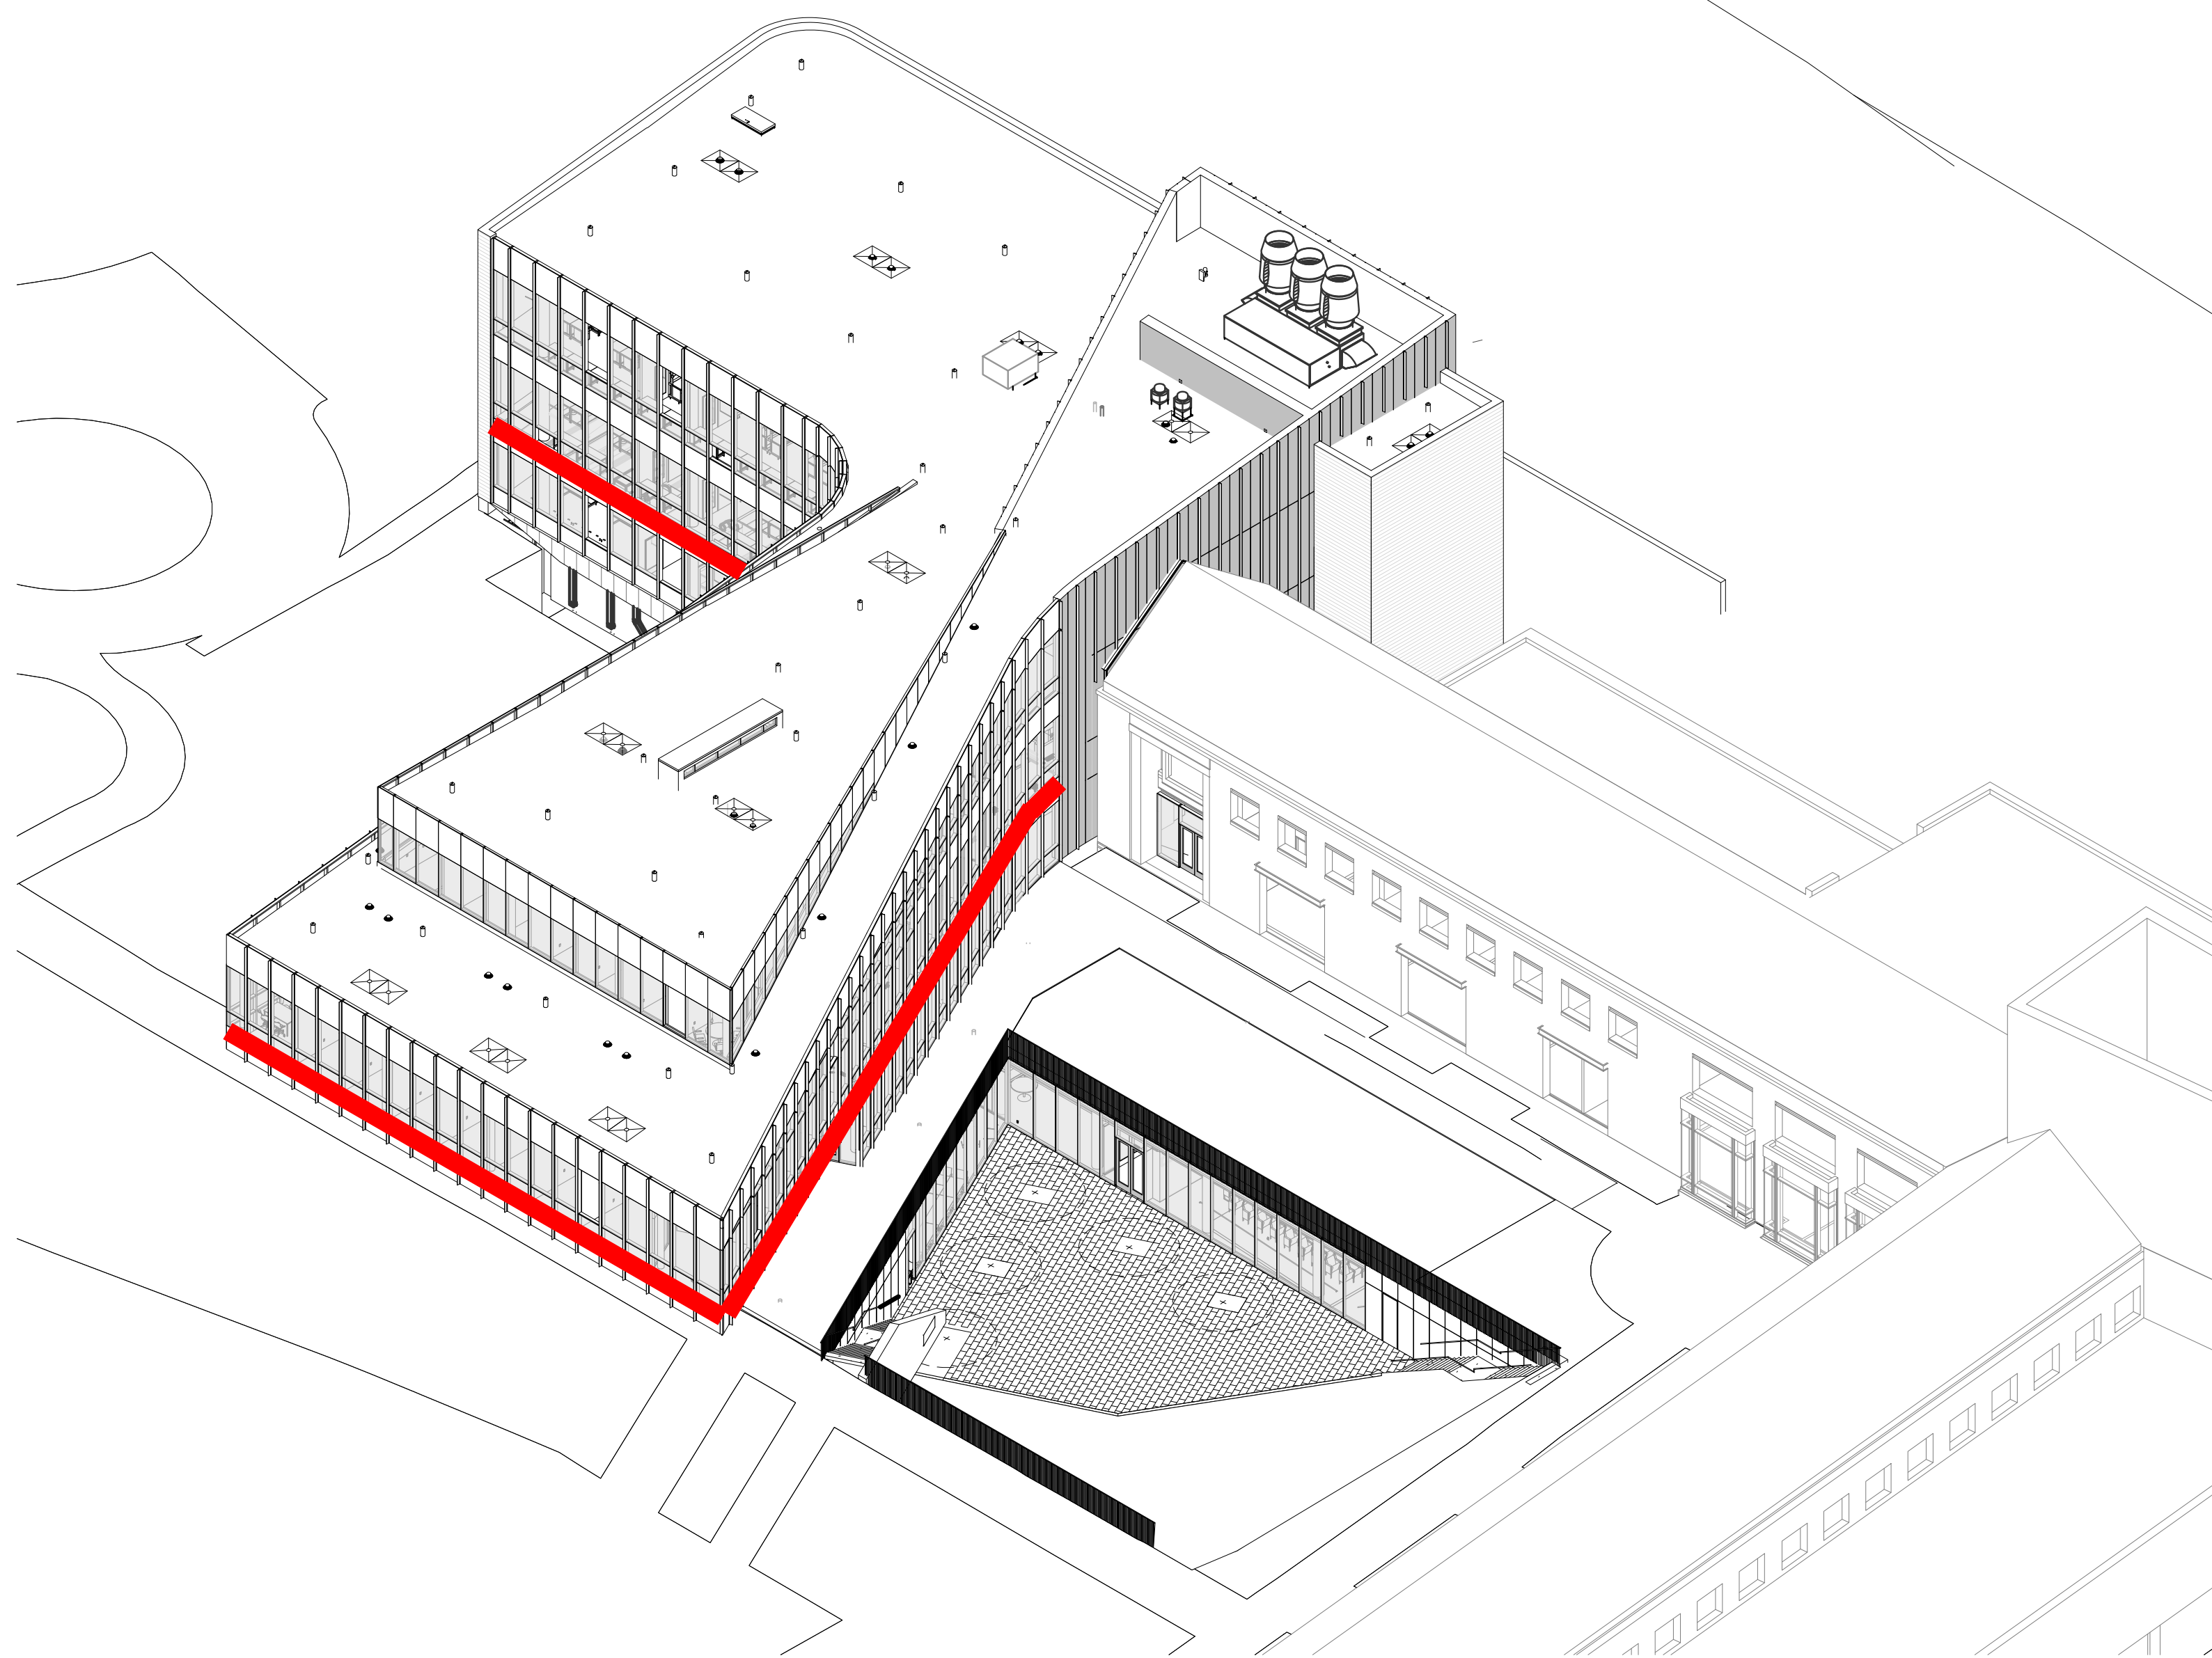

2 3D VIEW - SW CORNER

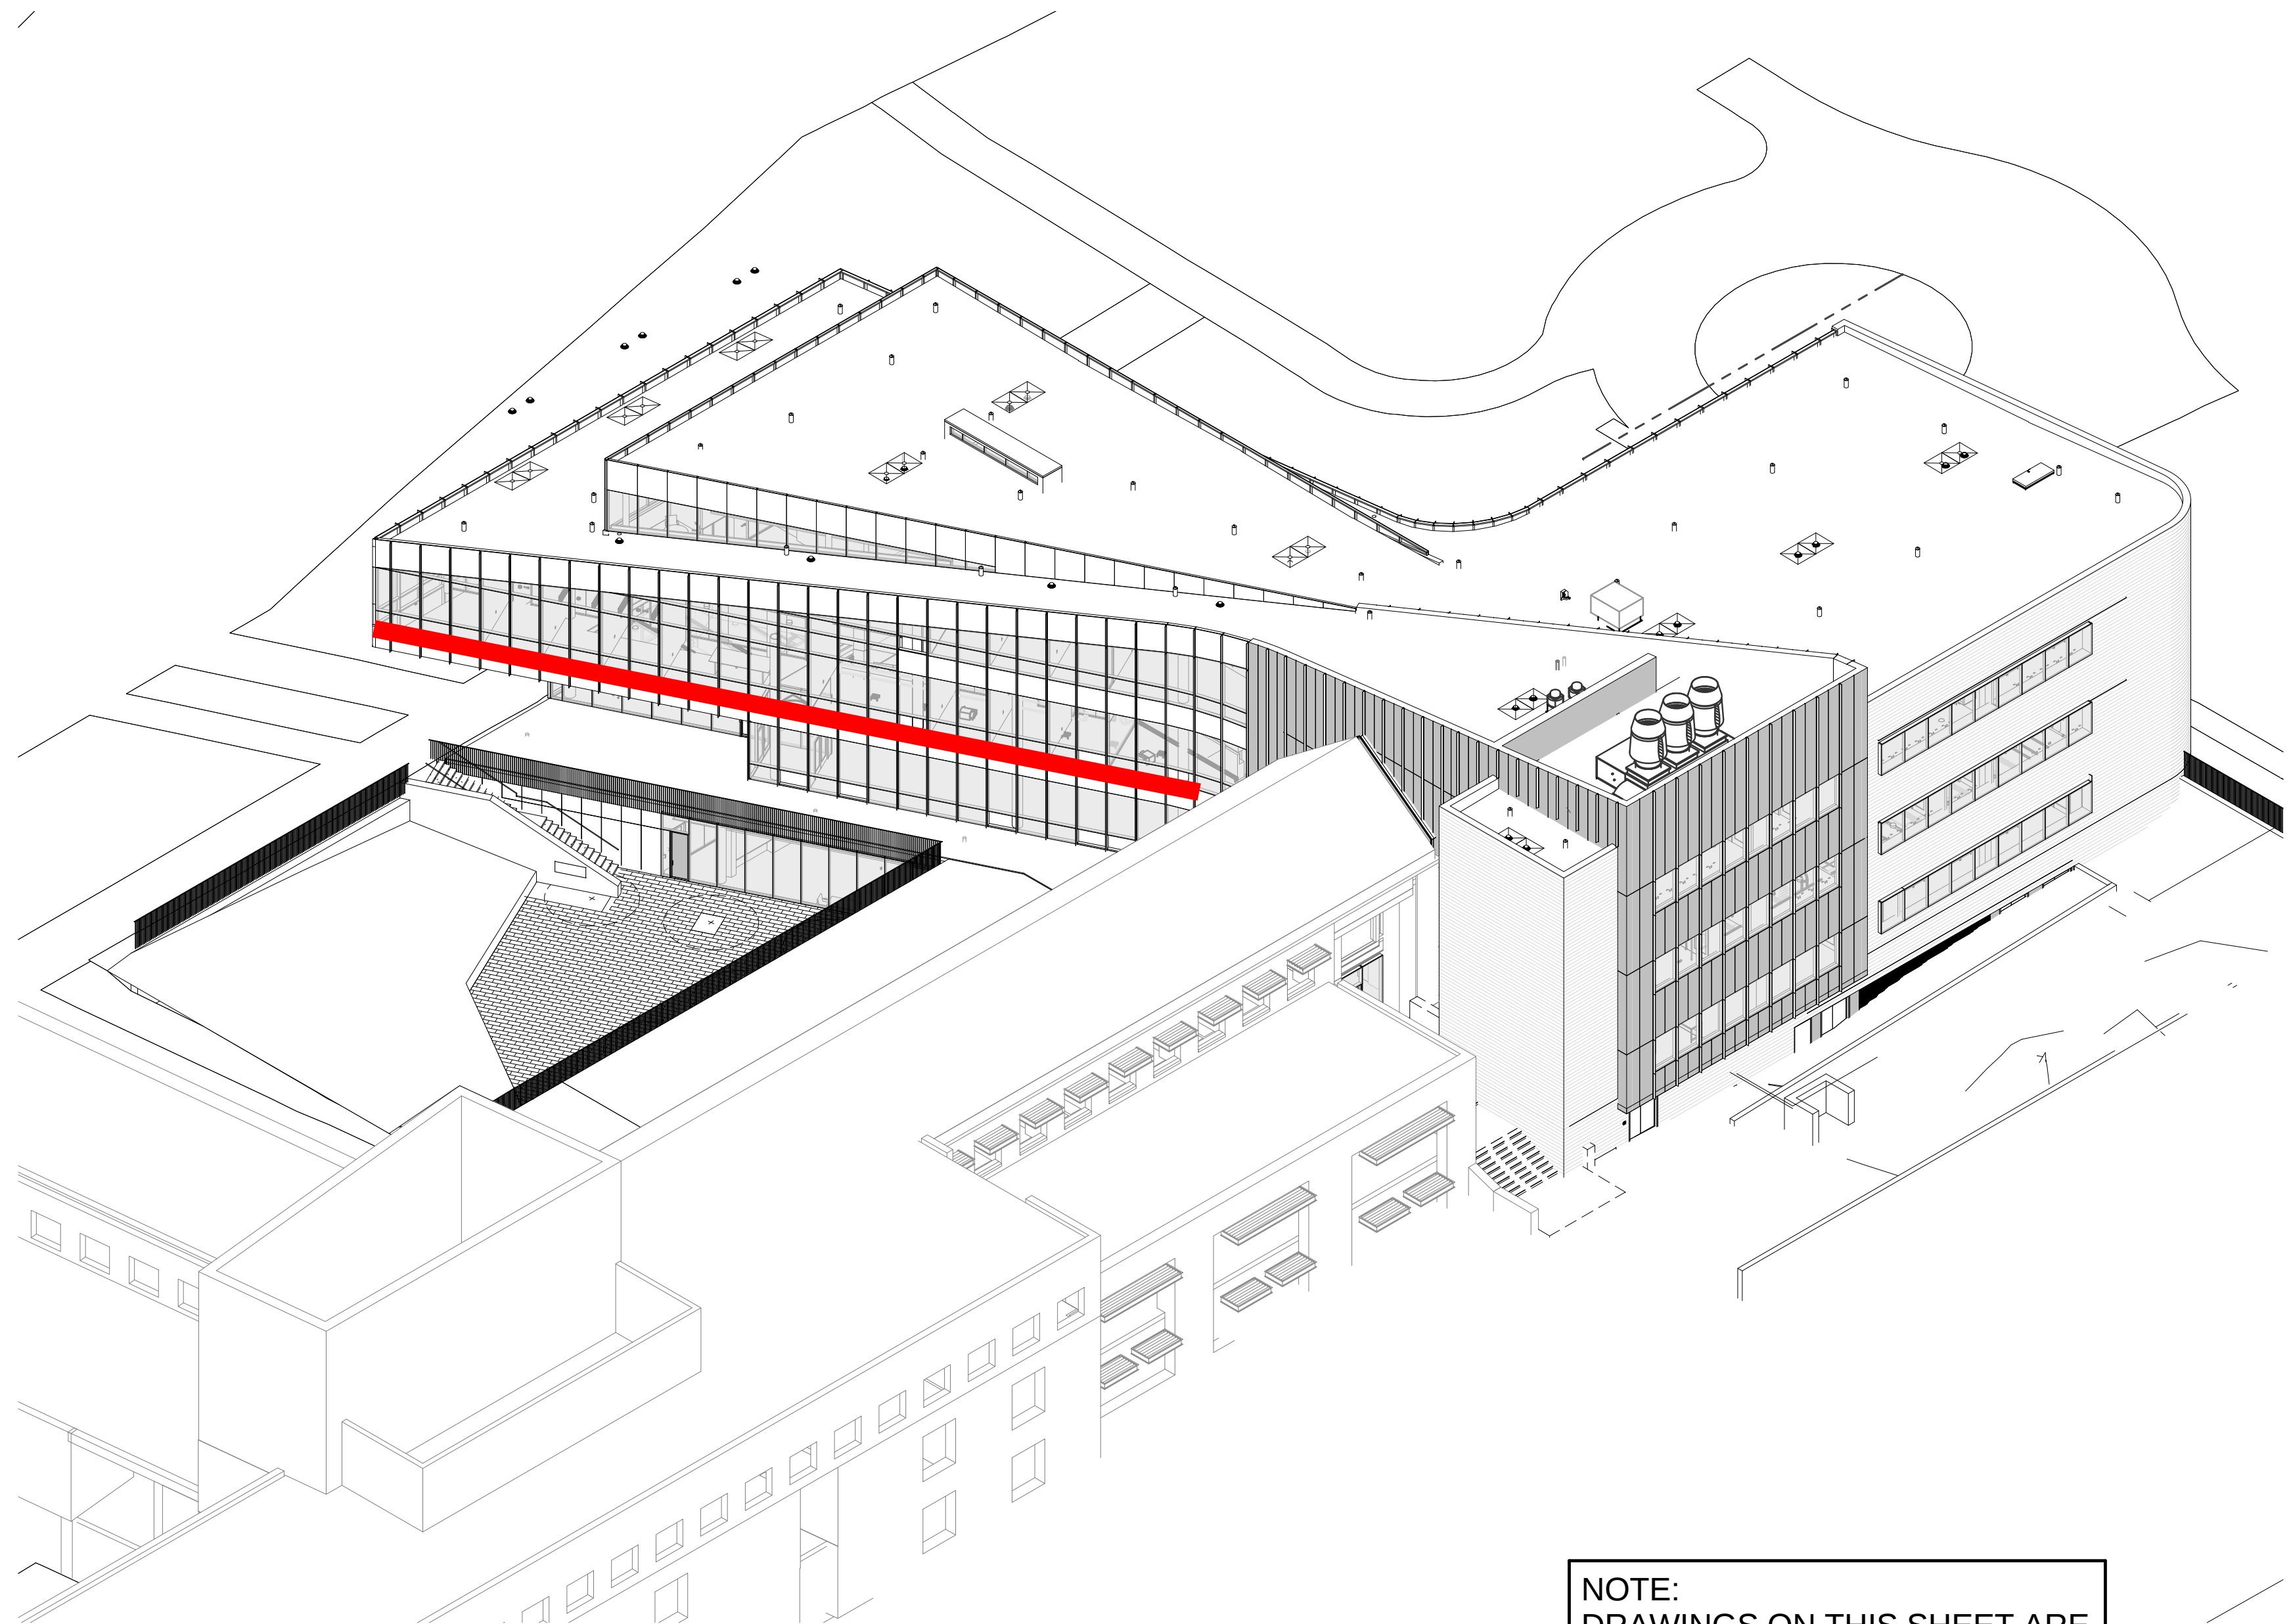

1 3D VIEW - SE CORNER

NOTE:
DRAWINGS ON THIS SHEET ARE
FOR ORIENTATION AND SPATIAL
RELATIONSHIPS ONLY.

William Tao & Associates, Inc.
MEP/FP Engineer
7955 Manchester Road, Suite 125
St. Louis, MO 63143
314-884-7600

David Mason & Associates, Inc.
Structural & Civil Engineer
800 South Vandeventer Avenue
St. Louis, MO 63110
314-534-1053

Faith Group
Technology
3101 S. Hanley Rd. Suite 100
St. Louis, MO 63143
314-991-2229

Kuhnmann Leavitt, Inc.
Environmental Graphics & Signage
7400 Pershing Ave.
St. Louis, MO 63130
314-725-6616


KWA Architects
Architecture
9721 Litzinger Road
St. Louis, MO 63124
314-962-2560

Spellman Brady & Company
Interior Designer
8251 Maryland Avenue, Suite 300
St. Louis, MO 63105
314-862-0070

SWT Design
Landscape Architect
7722 Big Bend Blvd
St. Louis, MO 63119
314-644-5700

Webb Engineering Services, Inc.
Planning & Fire Protection
1400 S. 3rd Street, Suite 201
St. Louis, MO 63104
314-588-0600

ISSUED FOR CONSTRUCTION (BP1) 15 JAN 2016

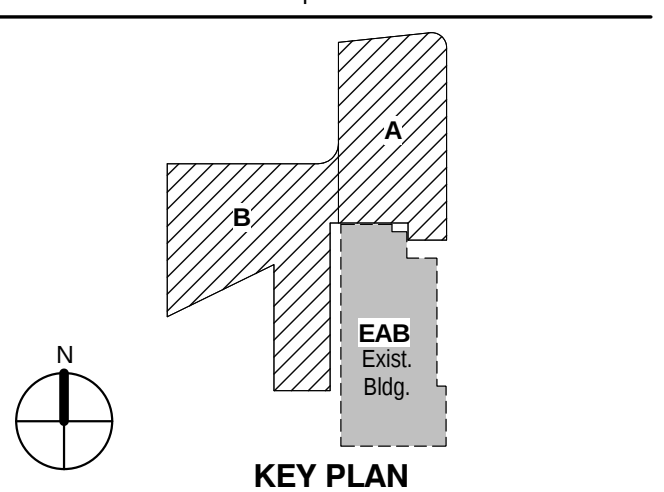

KEY PLAN

3D VIEWS

Project No.: 04561.01 Checked by:

A0300

William Tao & Associates, Inc.
MEP/FP Engineer
7955 Manchester Road, Suite 125
St. Louis, MO 63143
314-884-7600

David Mason & Associates, Inc.
Structural & Civil Engineer
800 South Vandeventer Avenue
St. Louis, MO 63110
314-534-1053

Faith Group
Technology
101 S. Hanley Rd, Suite 100
St. Louis, MO 63143
314-591-2226

Kuhmann Leavitt, Inc.
Environmental Graphics & Signage
7400 Pershing Ave
St. Louis, MO 63130
314-725-6616

KWA Architects
Architecture
9721 Litzinger Road
St. Louis, MO 63124
314-962-2560

Spellman Brady & Company
Interior Designer
8251 Maryland Avenue, Suite 300
St. Louis, MO 63105
314-862-0070

SWT Design
Landscape Architect
7722 Big Bend Blvd
St. Louis, MO 63119
314-644-5700

Webb Engineering Services, Inc.
Planning & Fire Protection
1400 S. 3rd Street, Suite 201
St. Louis, MO 63104
314-588-0600

ISSUED FOR CONSTRUCTION (BP1) 15 JAN 2016
No. Description Date


Drawing Title:

WALL SECTIONS


Project No.: 04561.01 Checked by:

A0402


© Cannon Design 2015

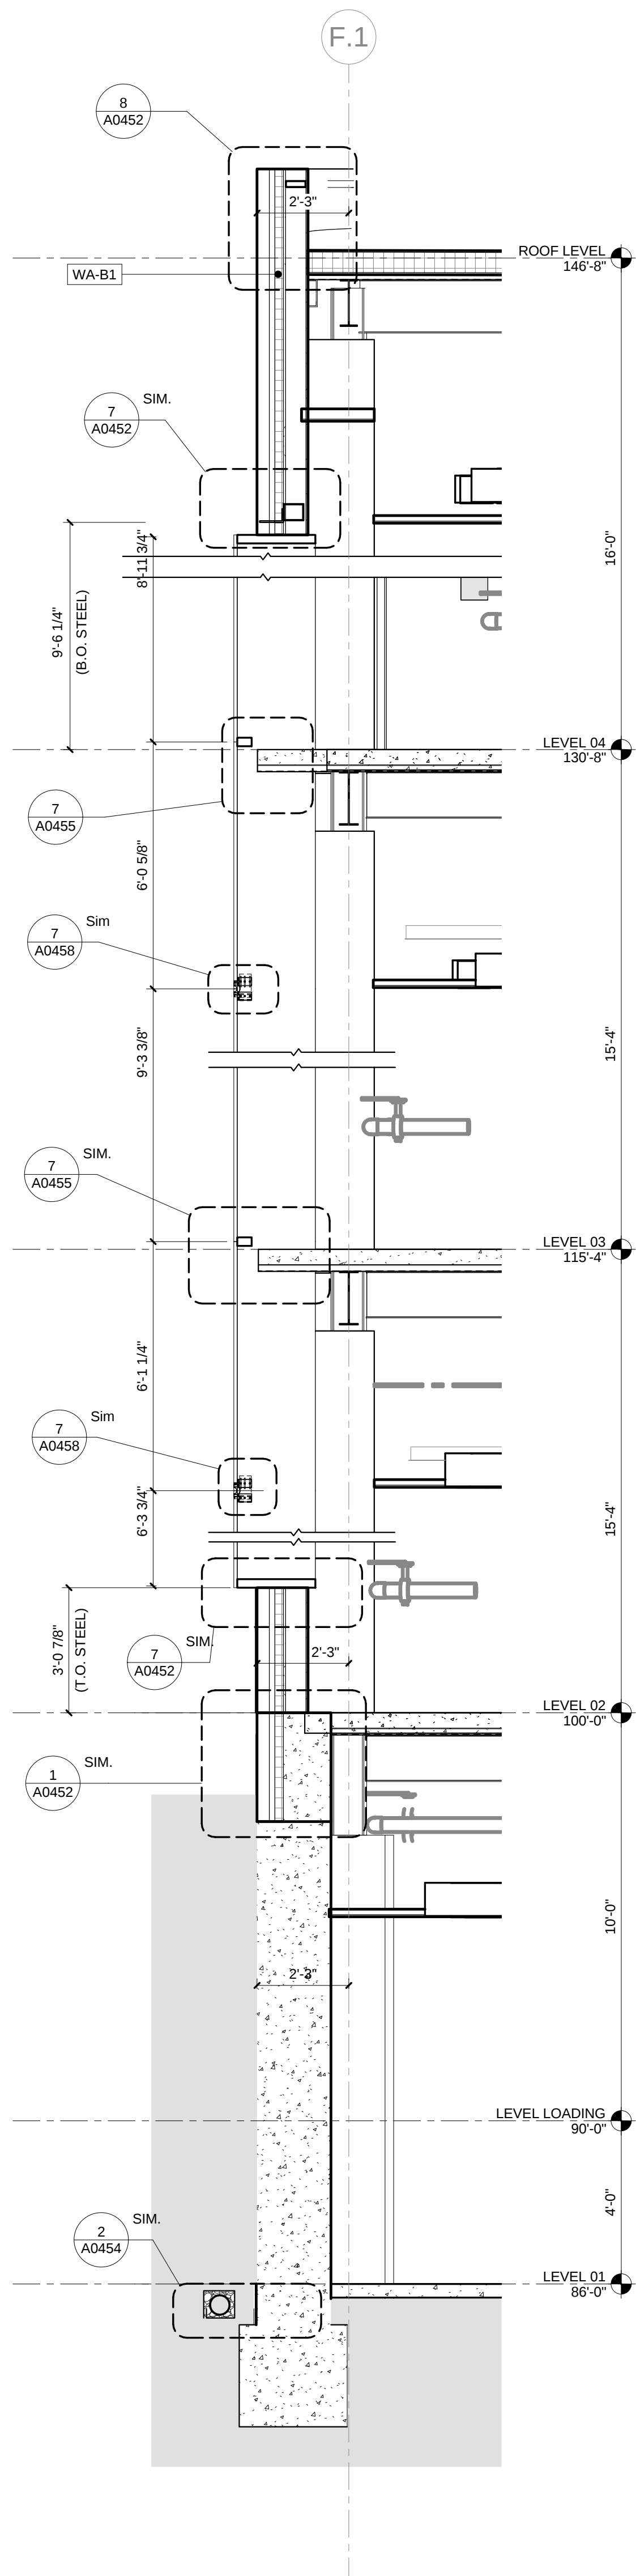


4 NORTH WALL SECTION E - WA-B1
3/8" = 1'-0"

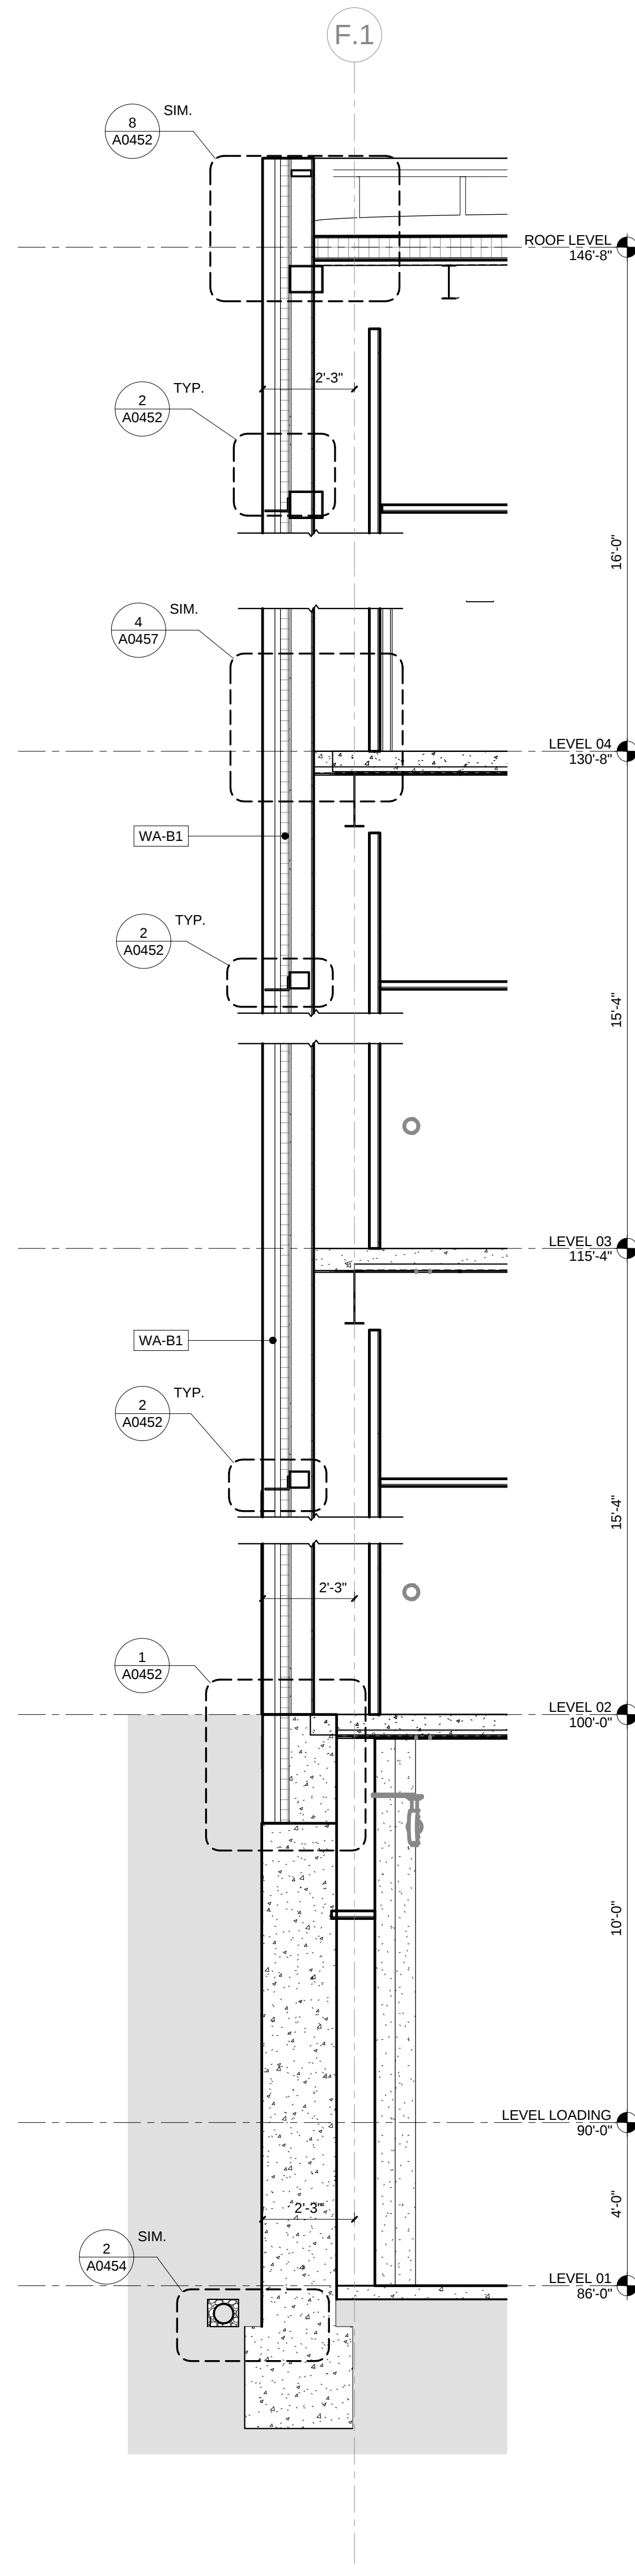

3 NORTH WALL SECTION D - WA-B1
3/8" = 1'-0"

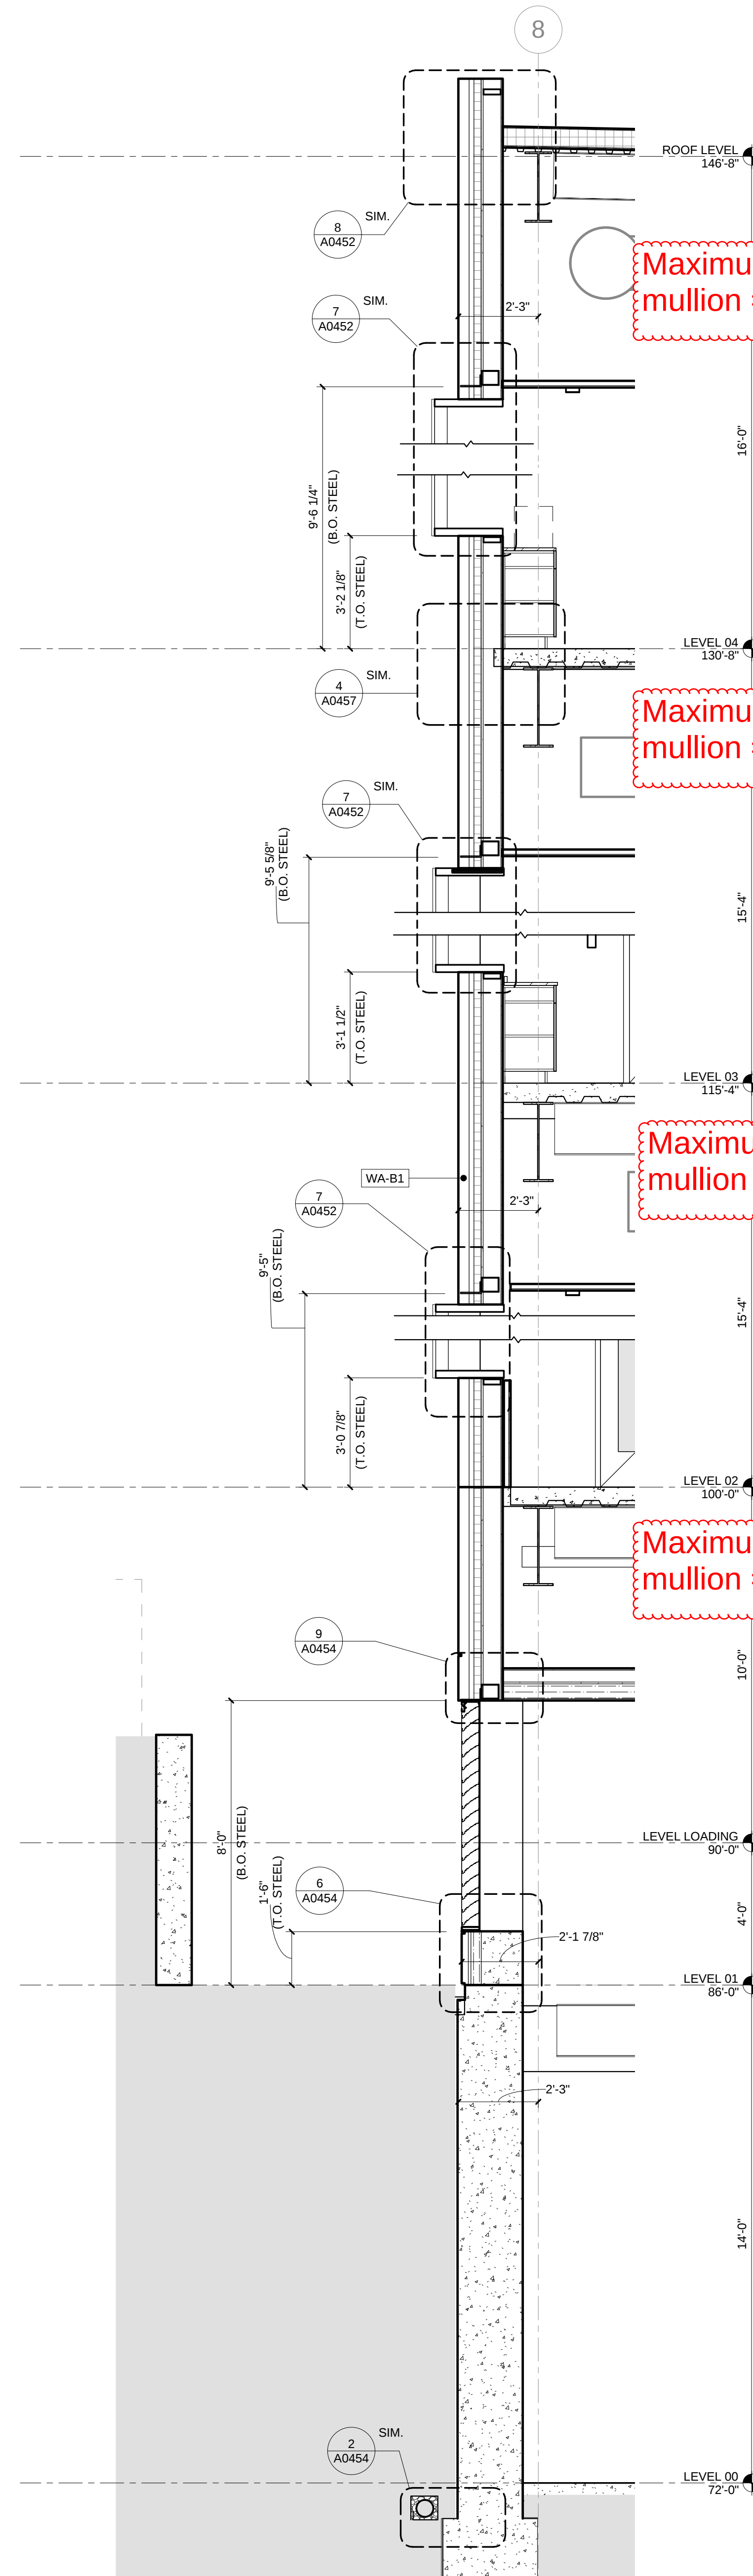

2 EAST WALL SECTION - WA-B1
3/8" = 1'-0"

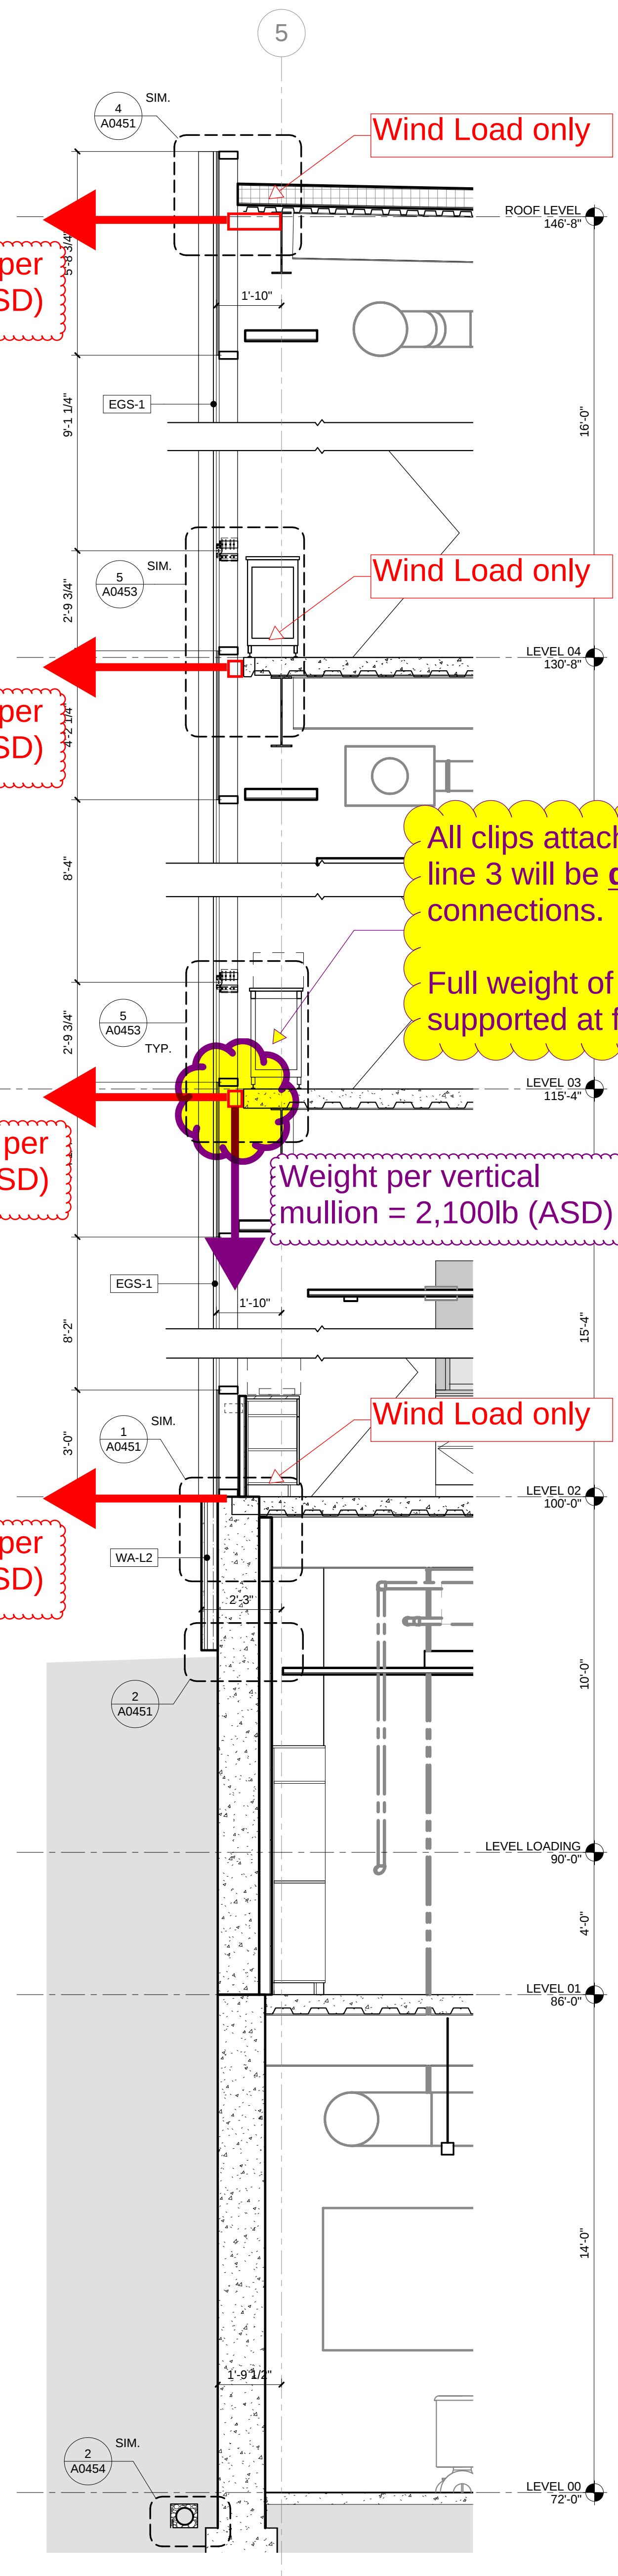

1 WEST WALL SECTION - SSG CURTAINWALL & WA-L2
3/8" = 1'-0"


Webb Engineering Services, Inc.
Plumbing & Fire Protection
1400 S. 3rd Street, Suite 201
St. Louis, MO 63104
314.588.0600

WALL SECTIONS


Project No.: 04561.01
Checked by

A0404


© Cannon Design 2015

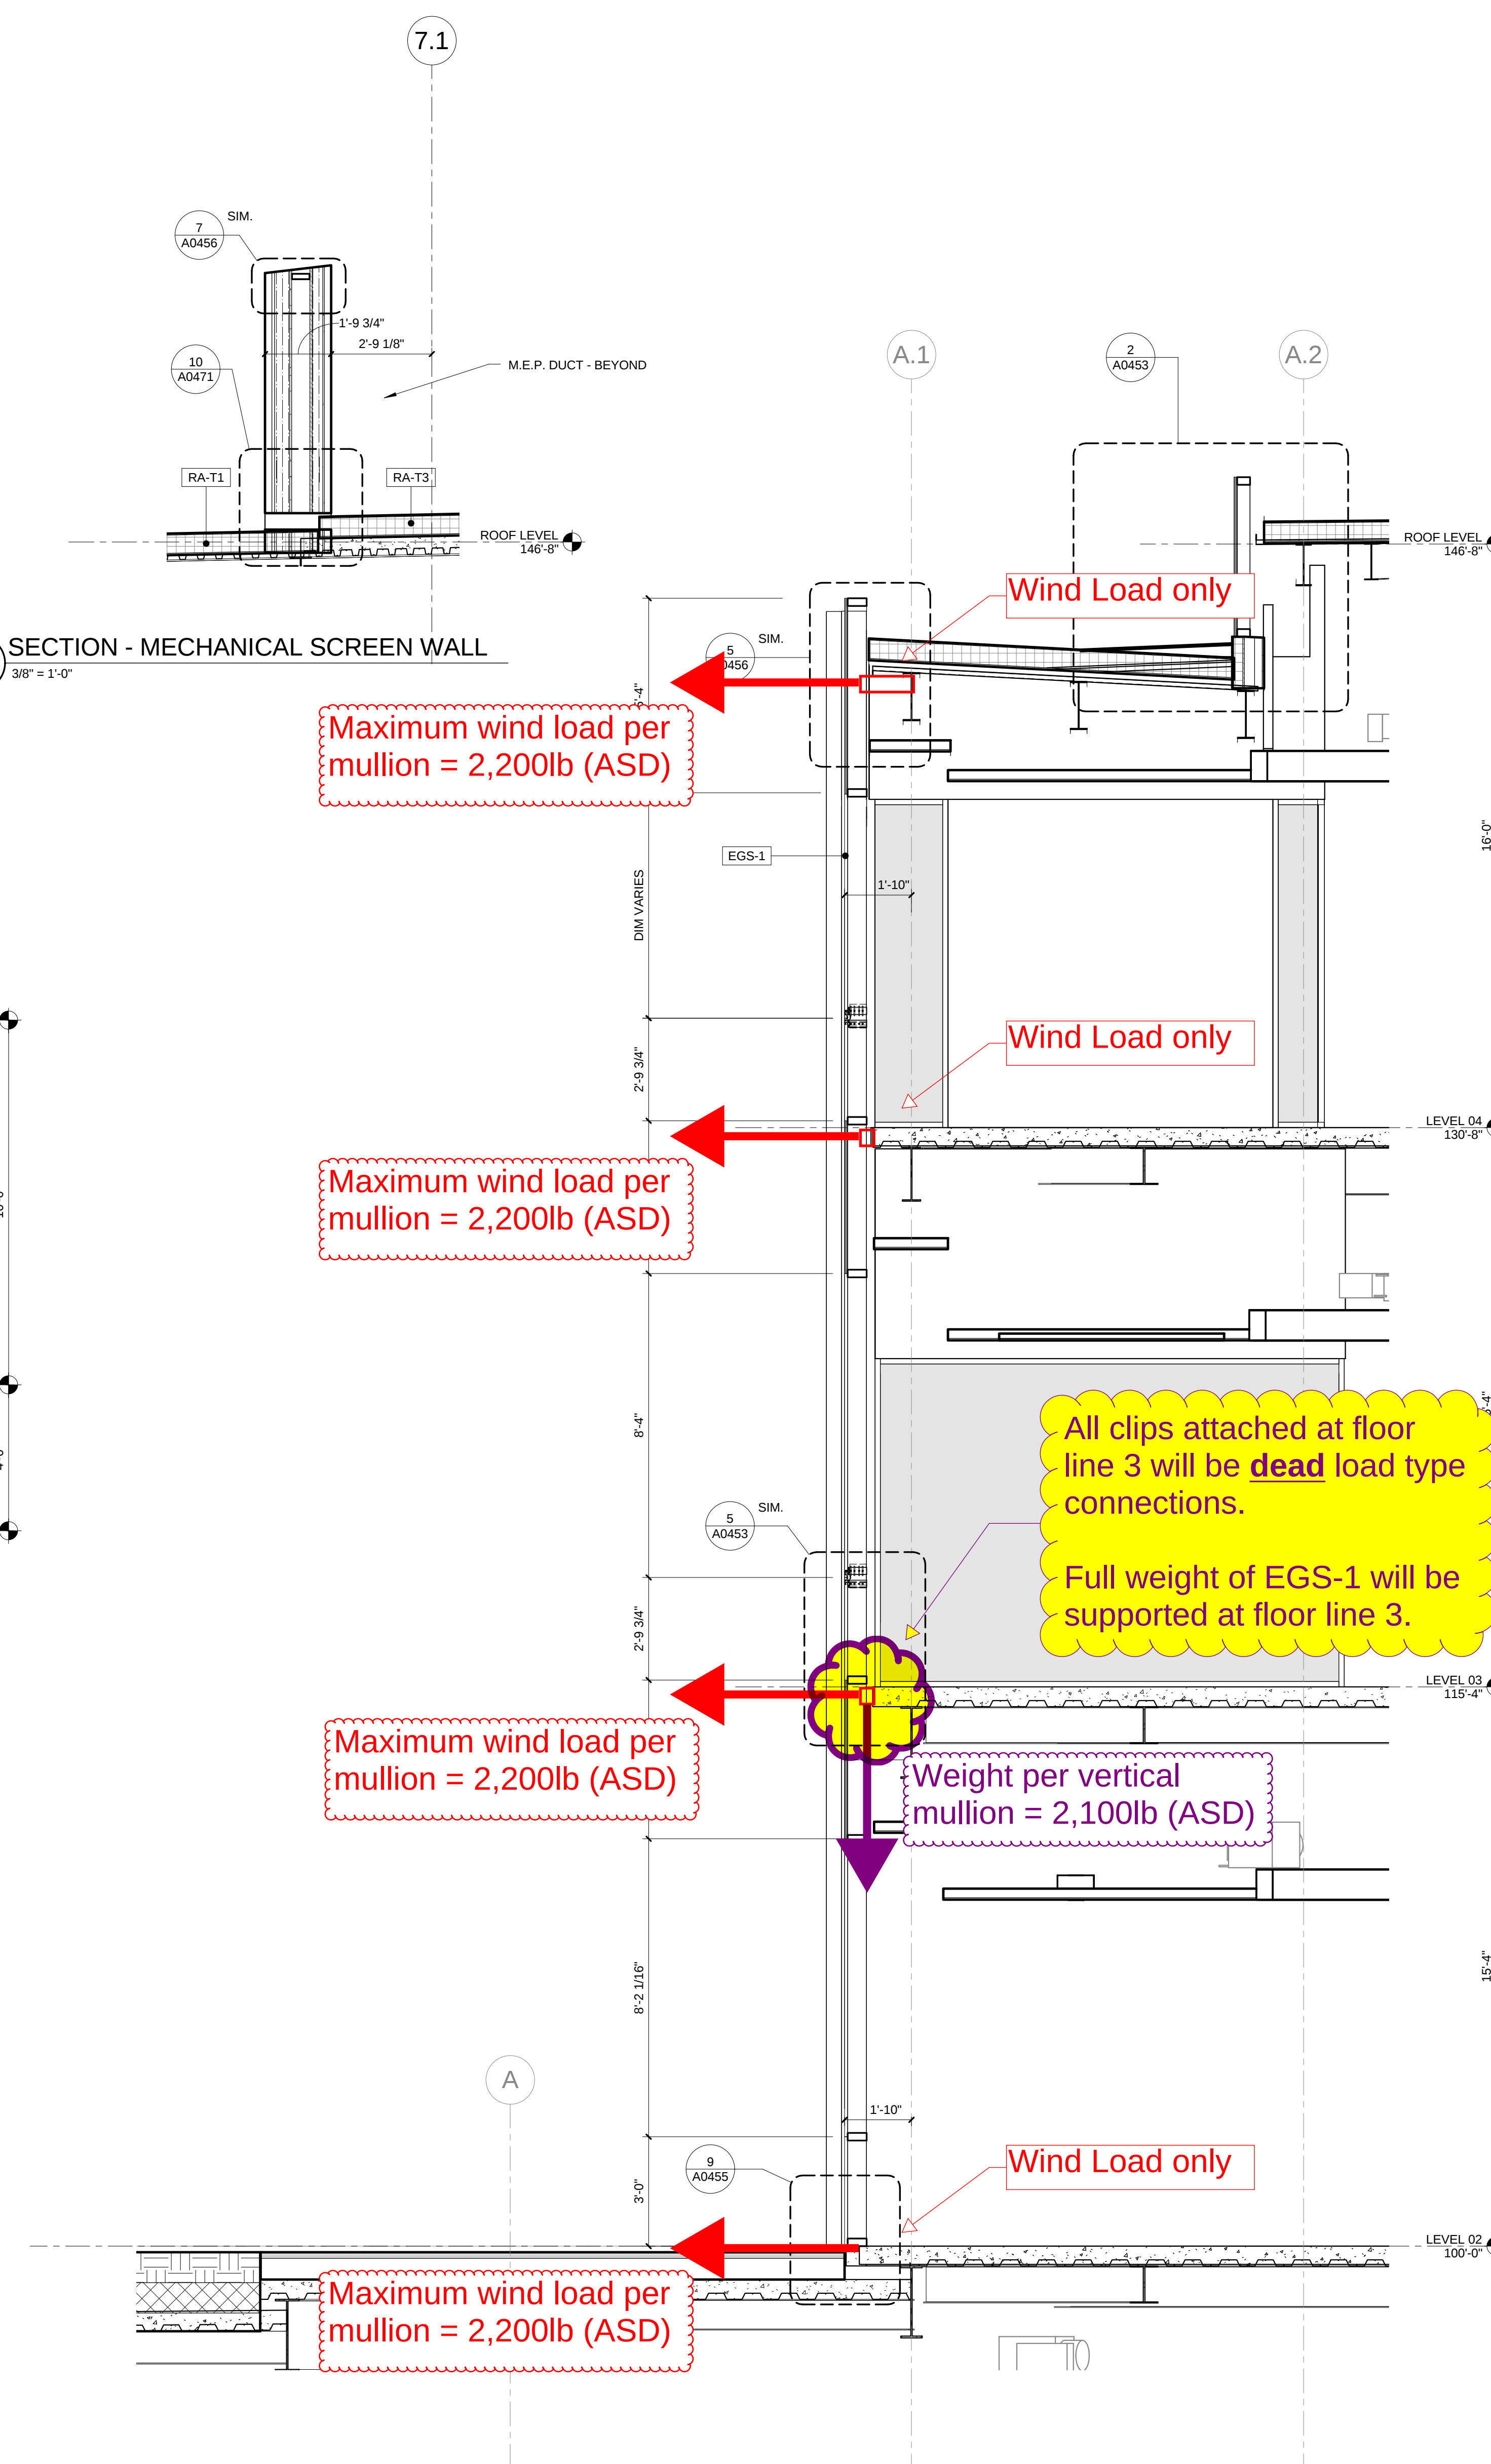

1 SOUTH WALL SECTION - SSG CURTAINWALL
3/8" = 1'-0"

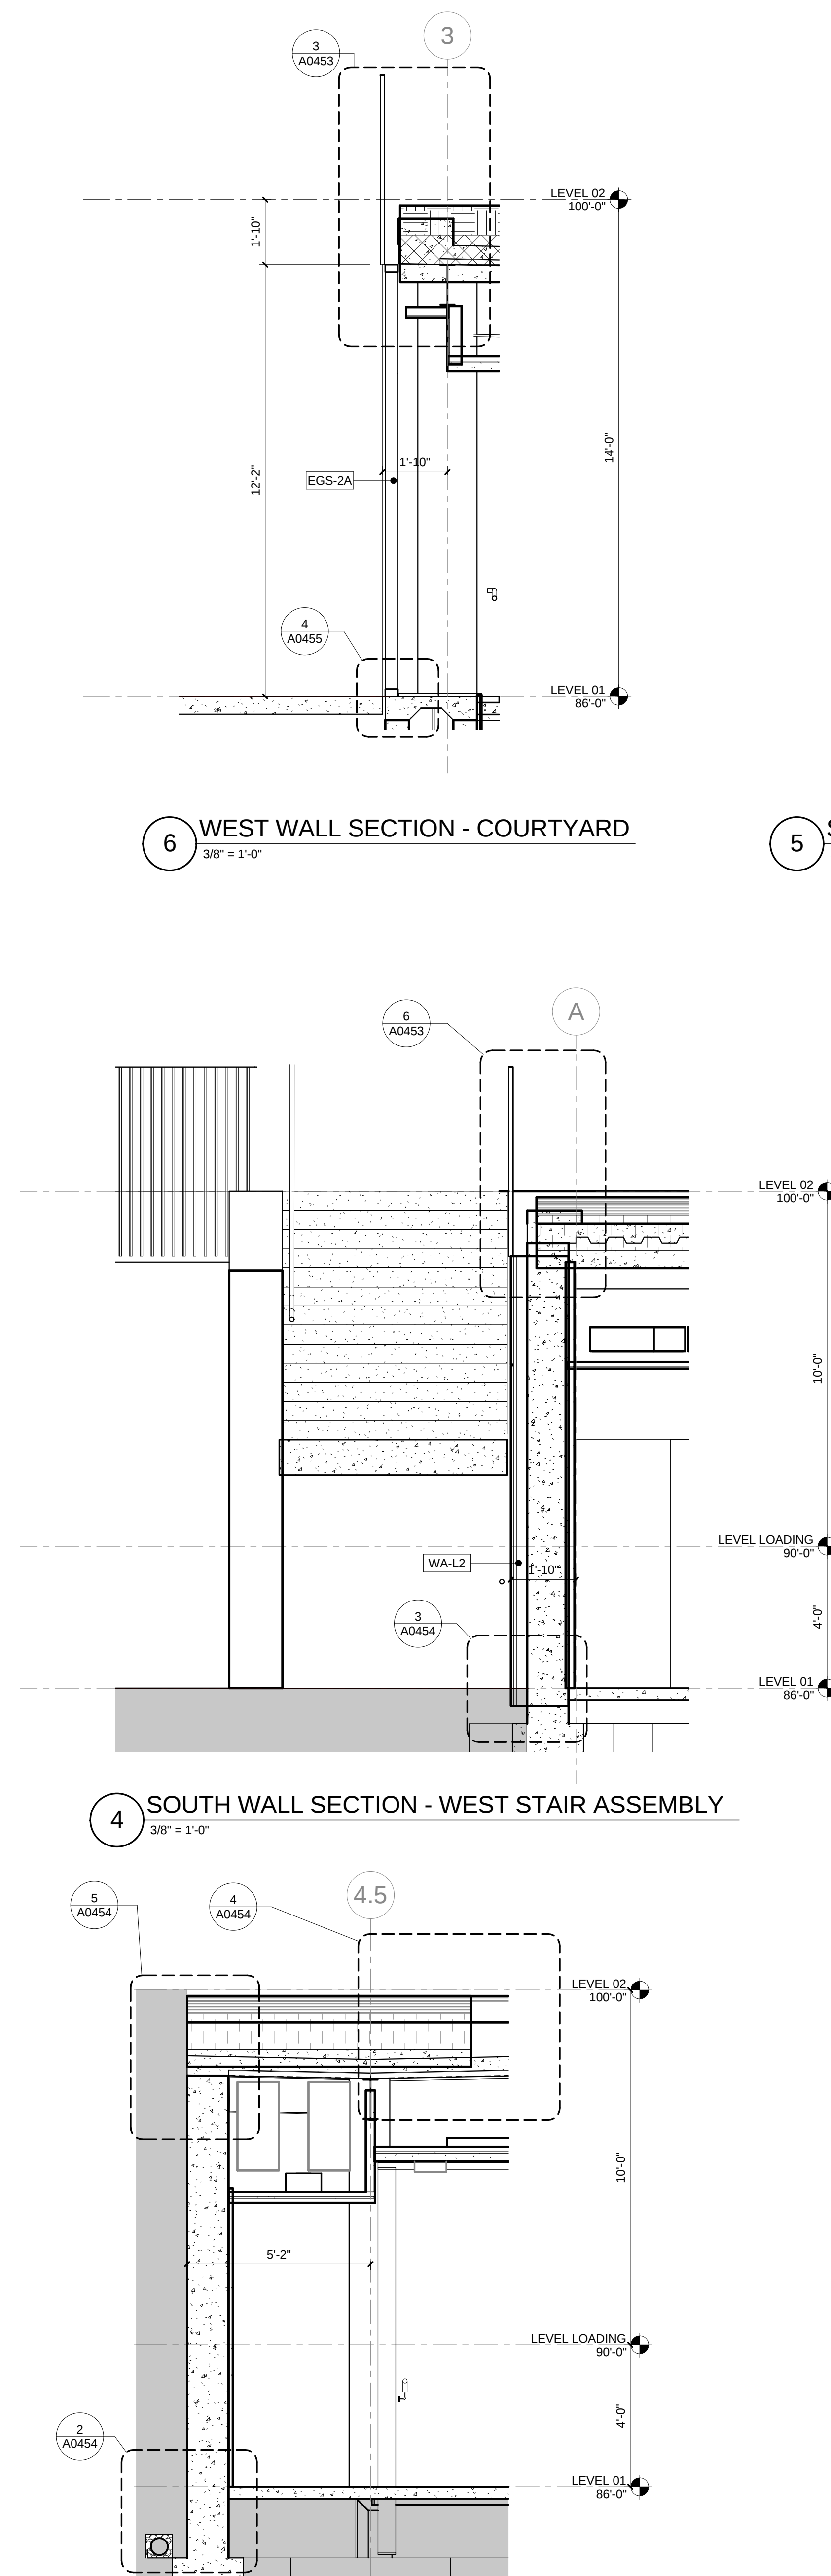


2 EAST WALL SECTION - COURTYARD
3/8" = 1'-0"

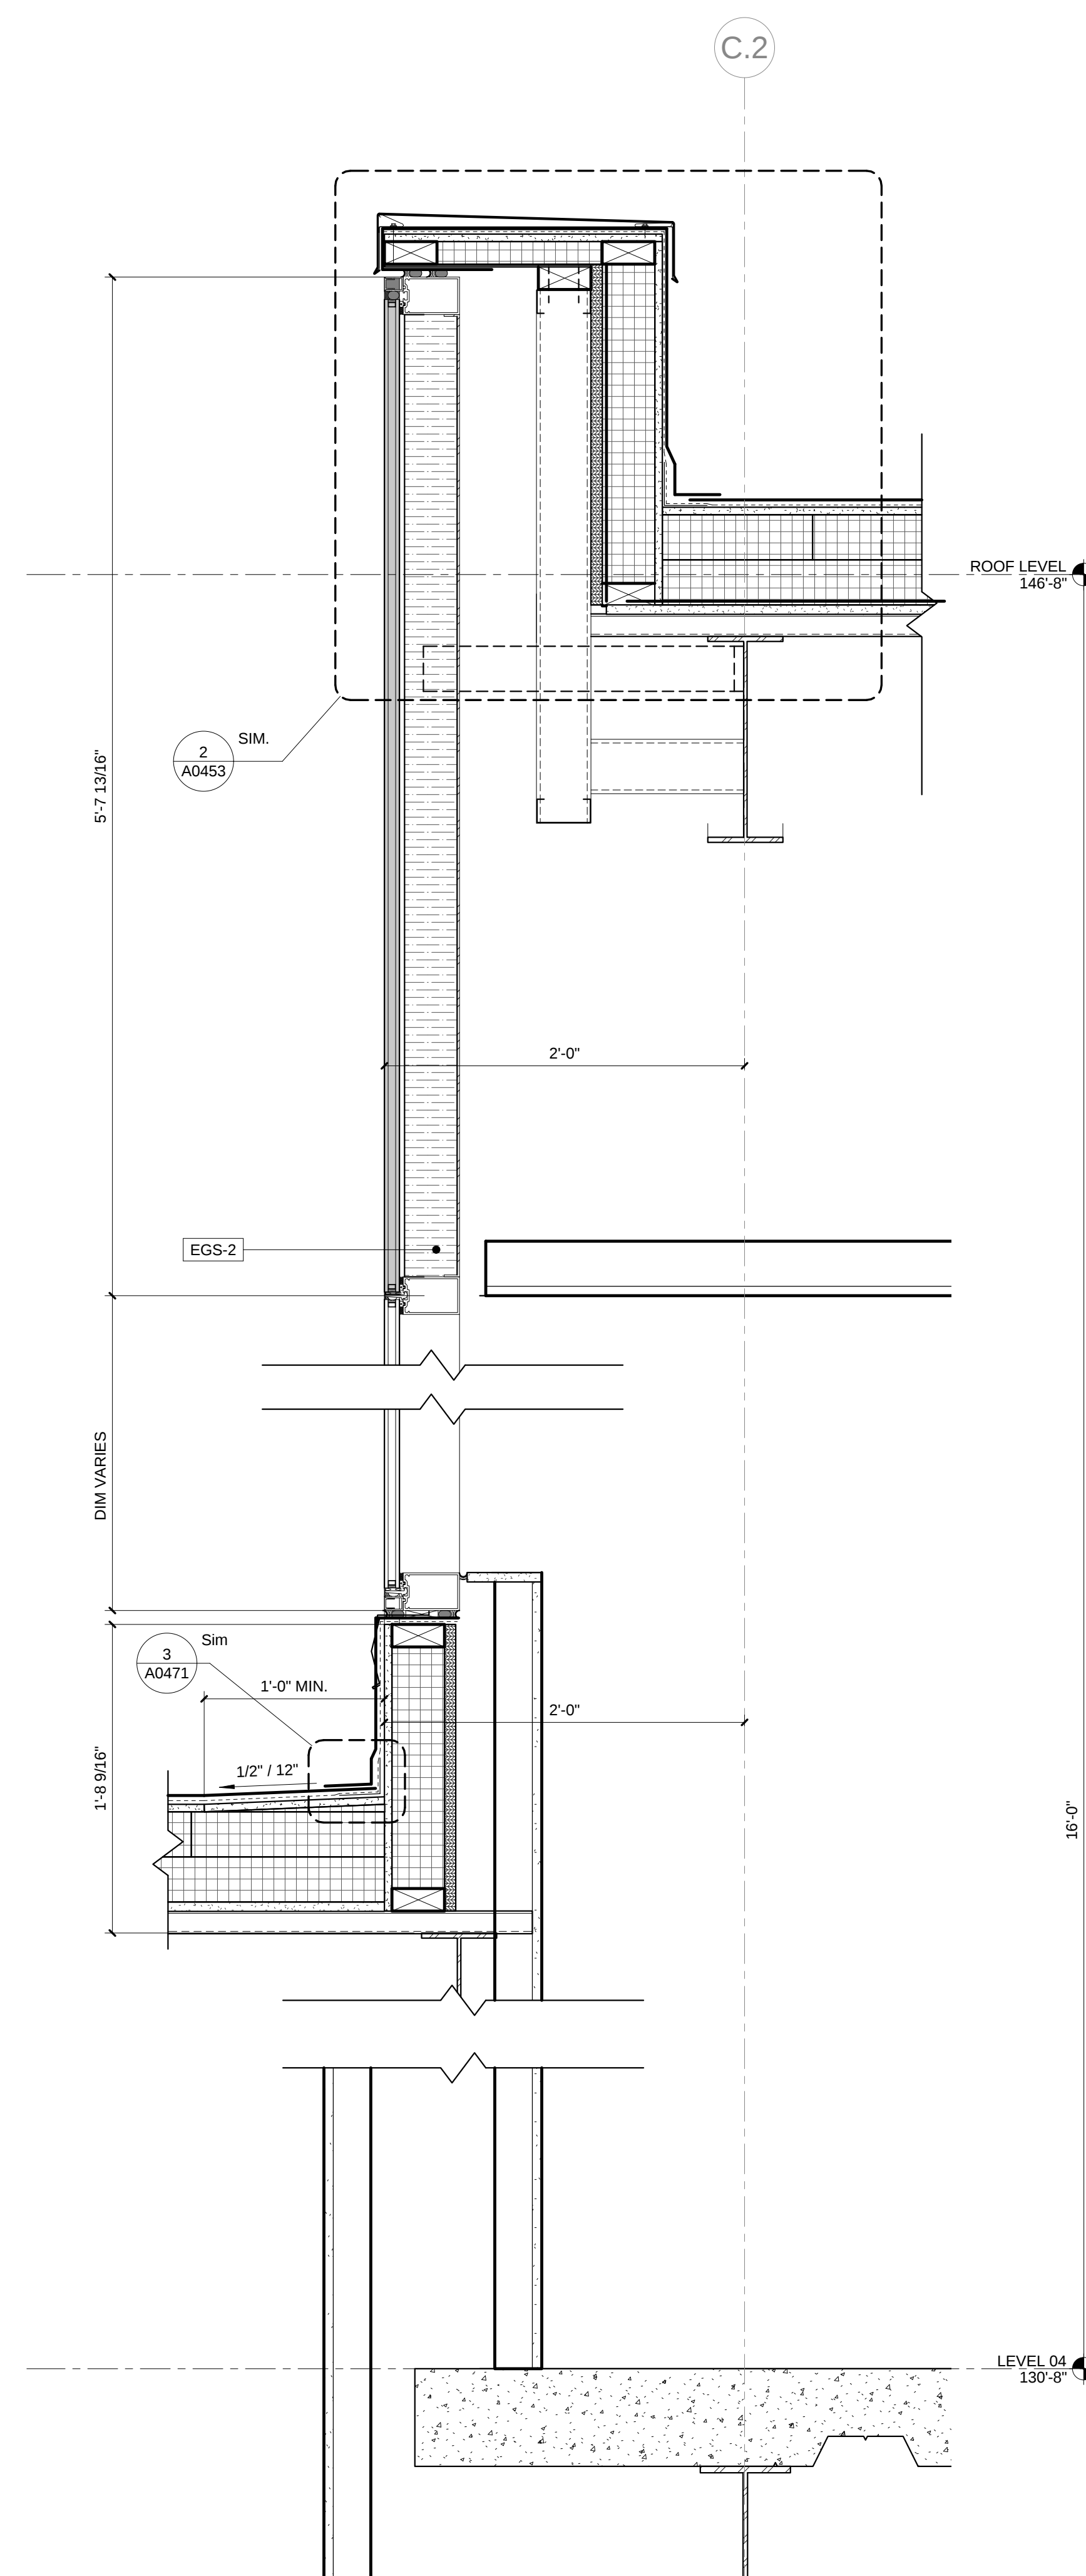


3 ENLARGED DETAIL - NORTH CURTAINWALL @ ROOF ASSEMBLY
1 1/2" = 1'-0"

© Cannon Design 2015
All rights reserved. No part of this document may be reproduced or utilized in any form, without prior written authorization by The Cannon Corporation.
1/15/2016 12:21:35 PM

© Cannon Design 2015
All rights reserved. No part of this document may be reproduced or transmitted in any form without written authorization by The Cannon Corporation.
1/15/2016 12:21:46 PM

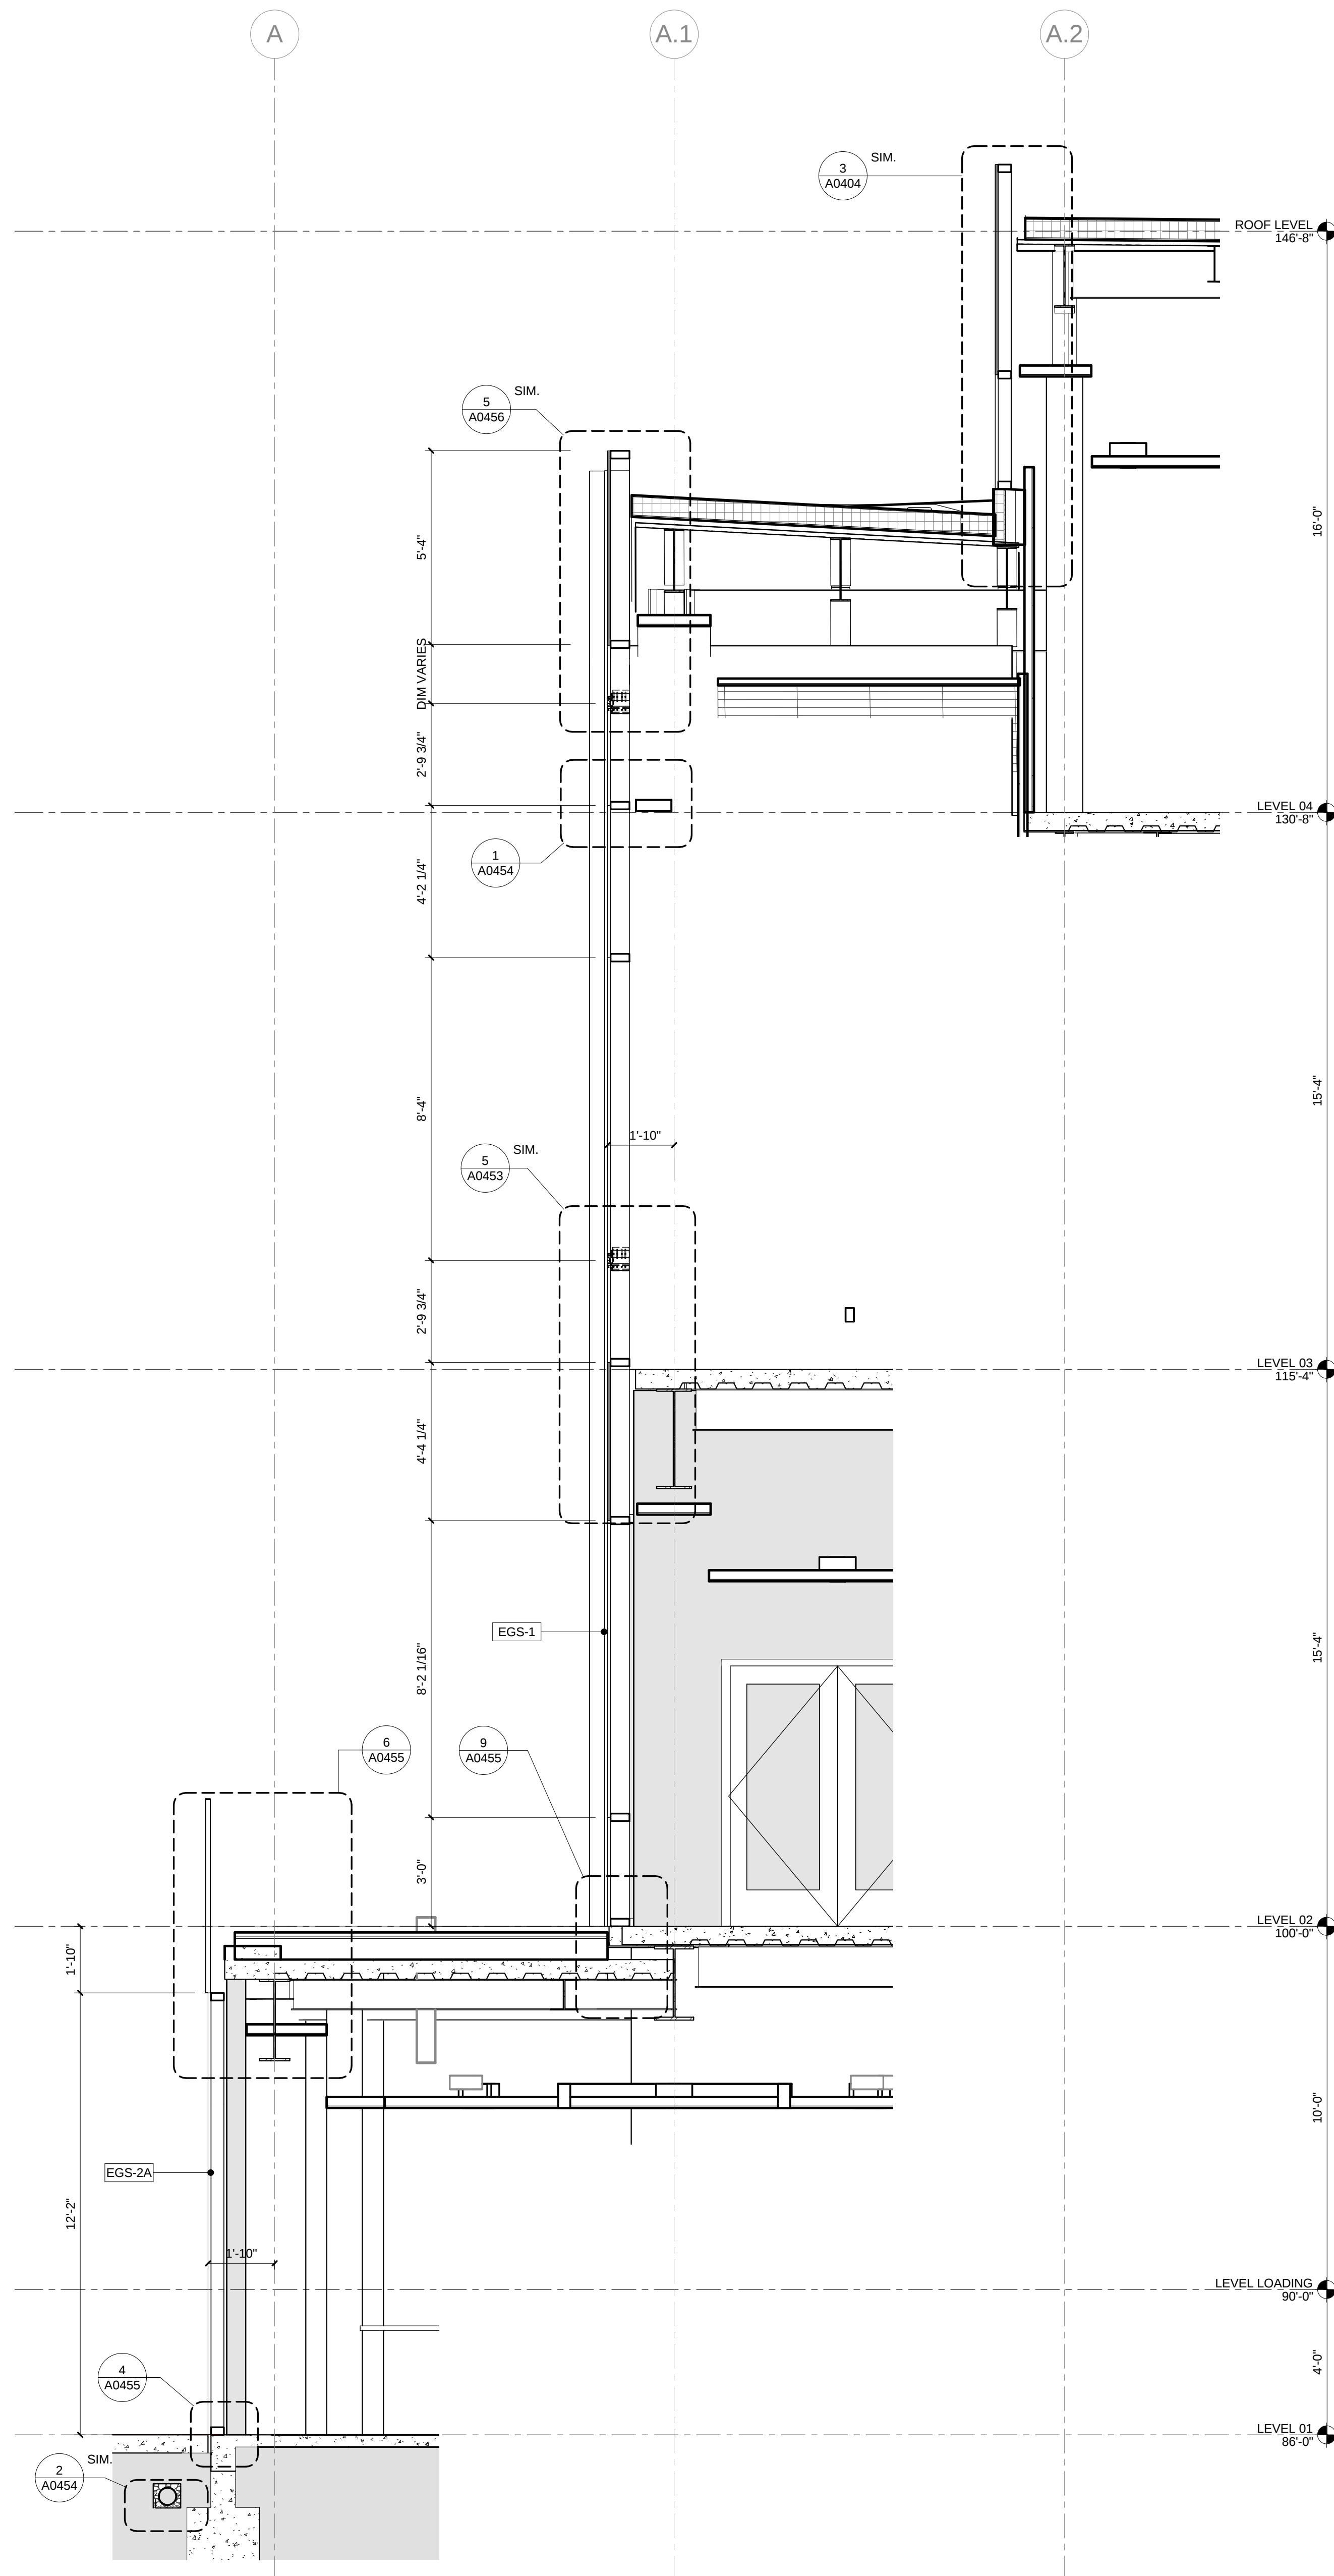

2 SOUTH WALL SECTION - COURTYARD
3/8" = 1'-0"

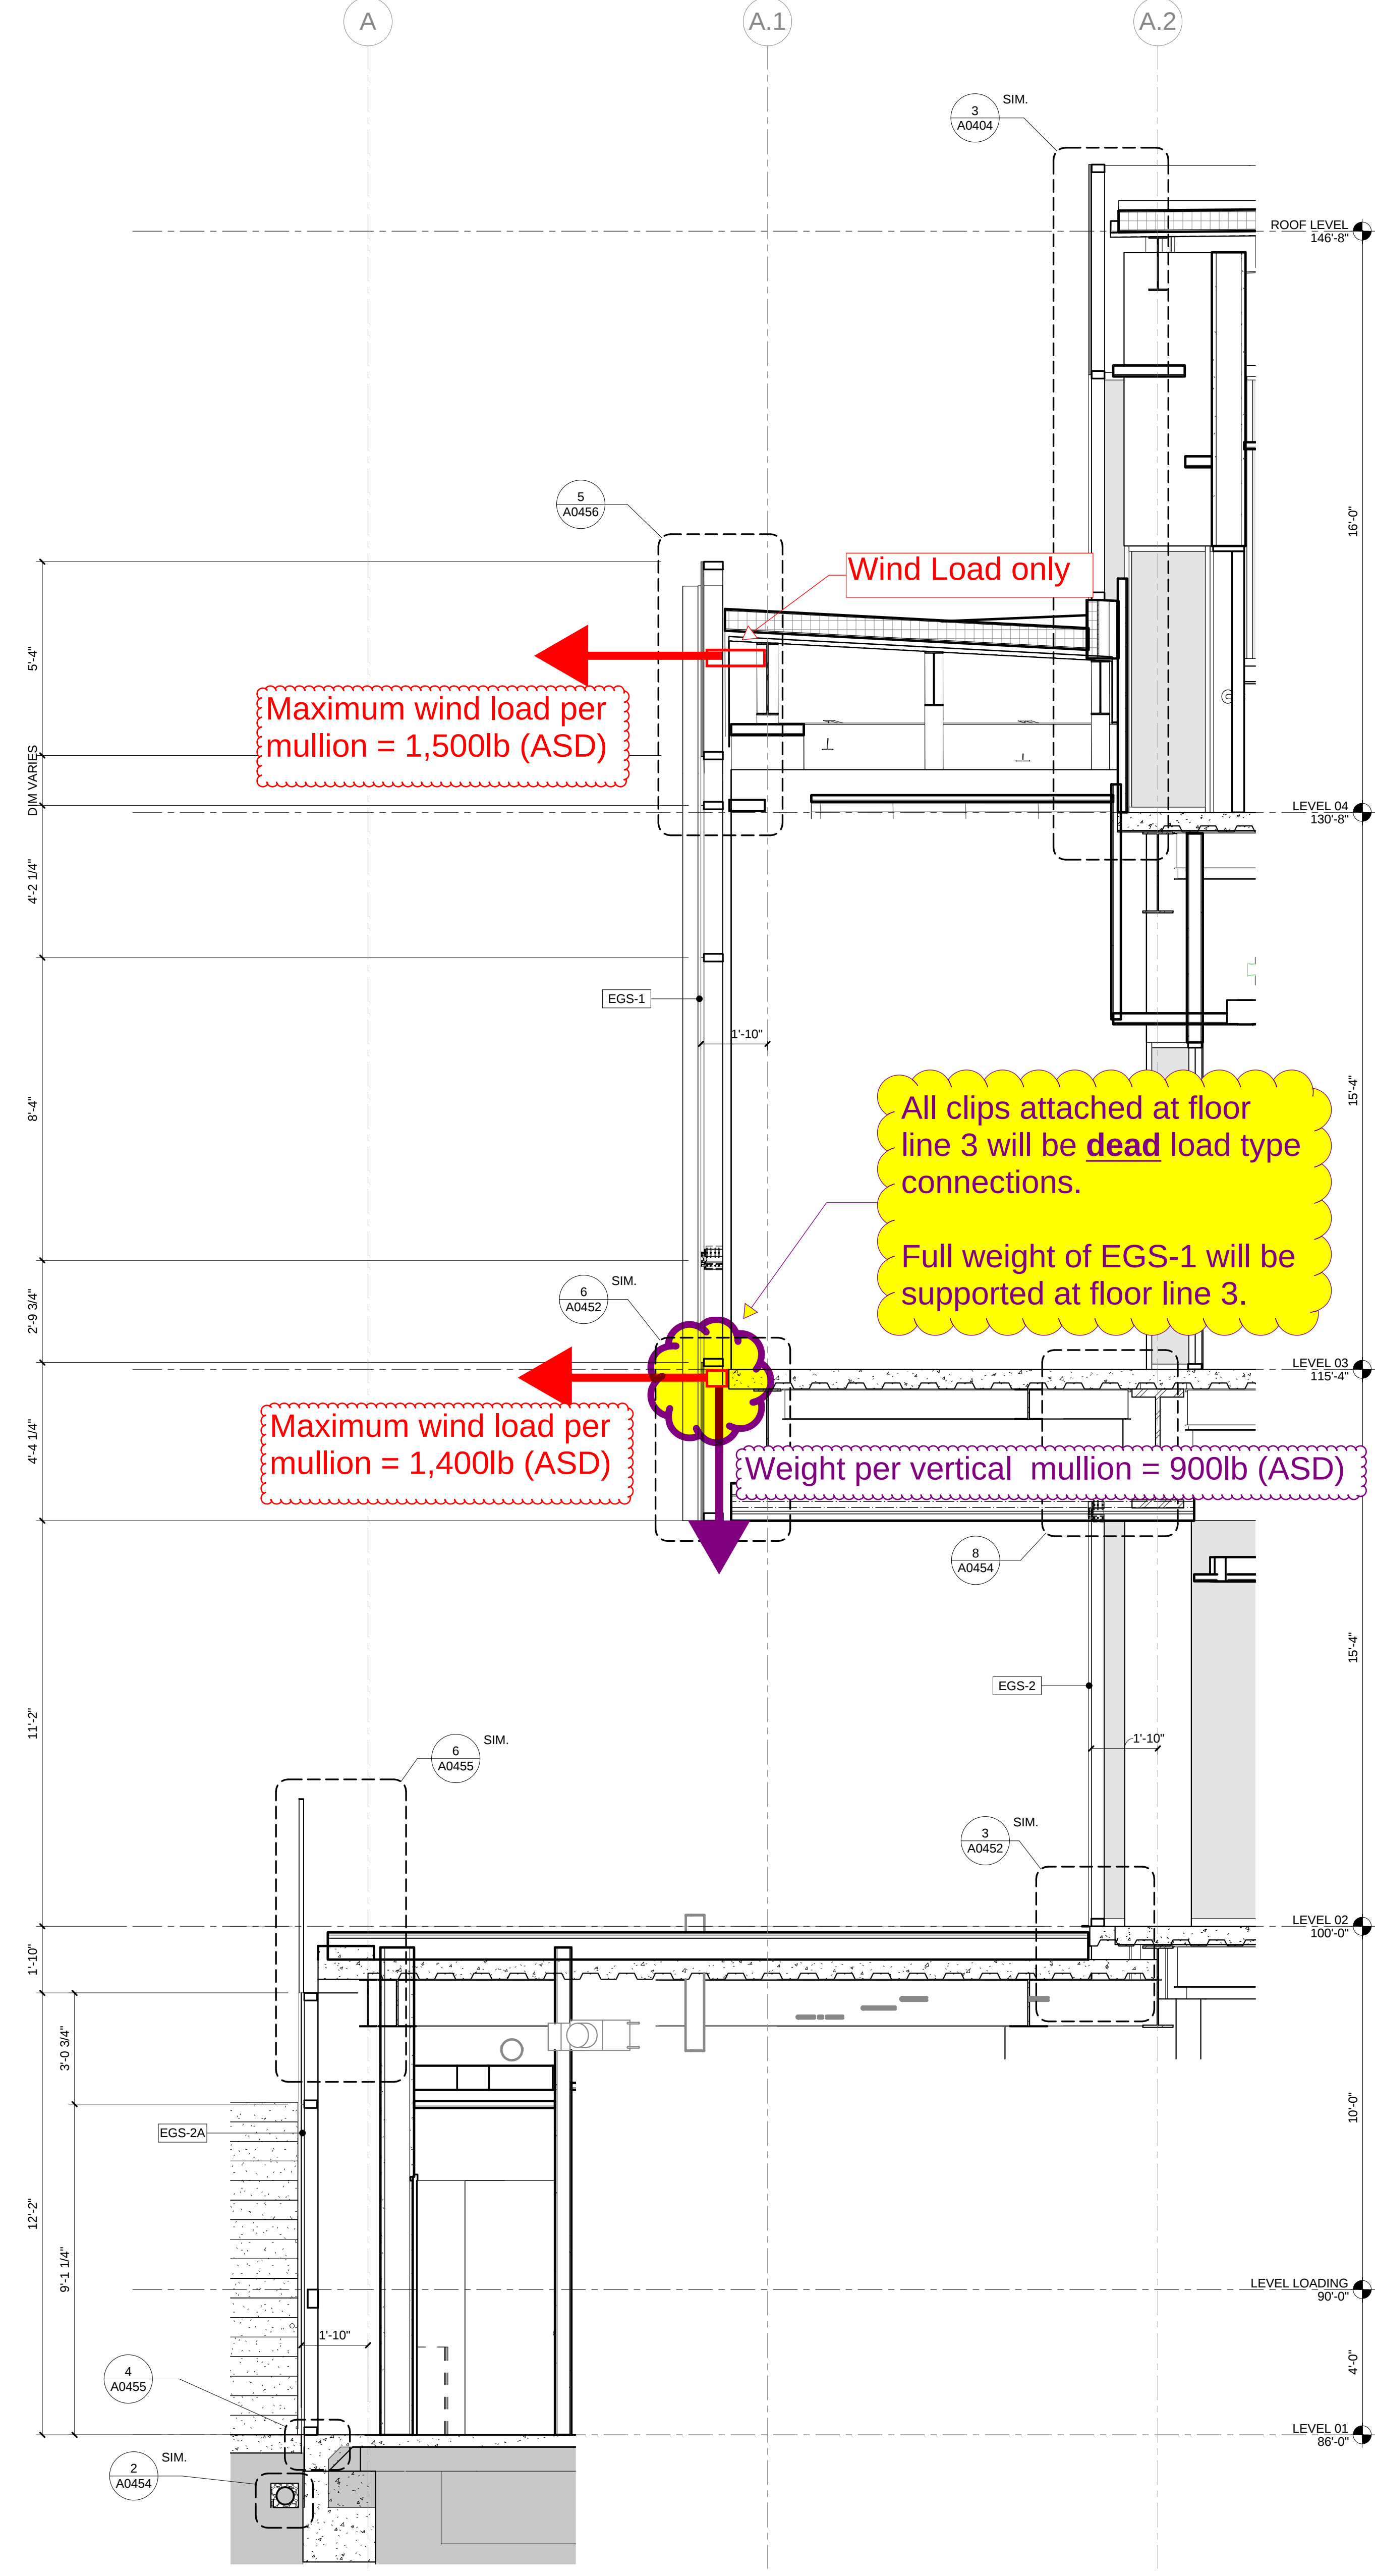

1 SOUTH WALL SECTION - COURTYARD @ ISB OVERHANG
3/8" = 1'-0"

William Tao & Associates, Inc.
MEP/FP Engineer
7955 Manchester Road, Suite 125
St. Louis, MO 63143
314-884-7600

David Mason & Associates, Inc.
Structural & Civil Engineer
800 South Vandeventer Avenue
St. Louis, MO 63110
314-534-1053

Faith Group
Technology
3101 S. Hanley Rd. Suite 100
St. Louis, MO 63143
314-991-2229

Kuhmann Leavitt, Inc.
Environmental Graphics & Signage
7400 Pershing Ave.
St. Louis, MO 63130
314-725-6616

KWA Architects
Architecture
9721 Litzinger Road
St. Louis, MO 63124
314-962-2560

Spellman Brady & Company
Interior Designer
8251 Maryland Avenue, Suite 300
St. Louis, MO 63105
314-862-0070

SWT Design
Landscape Architect
7722 Big Bend Blvd
St. Louis, MO 63119
314-644-5700

Webb Engineering Services, Inc.
Planning & Fire Protection
1400 S. 3rd Street, Suite 201
St. Louis, MO 63104
314-588-0600

ISSUED FOR CONSTRUCTION (BP1) 15 JAN 2016
No. Description Date

Drawing Title:


WALL SECTIONS

Project No.: 04561.01 Checked by:


A0405

Red lines denote location where system weight would be supported.


All other floor slab anchors will be wind load only connections.

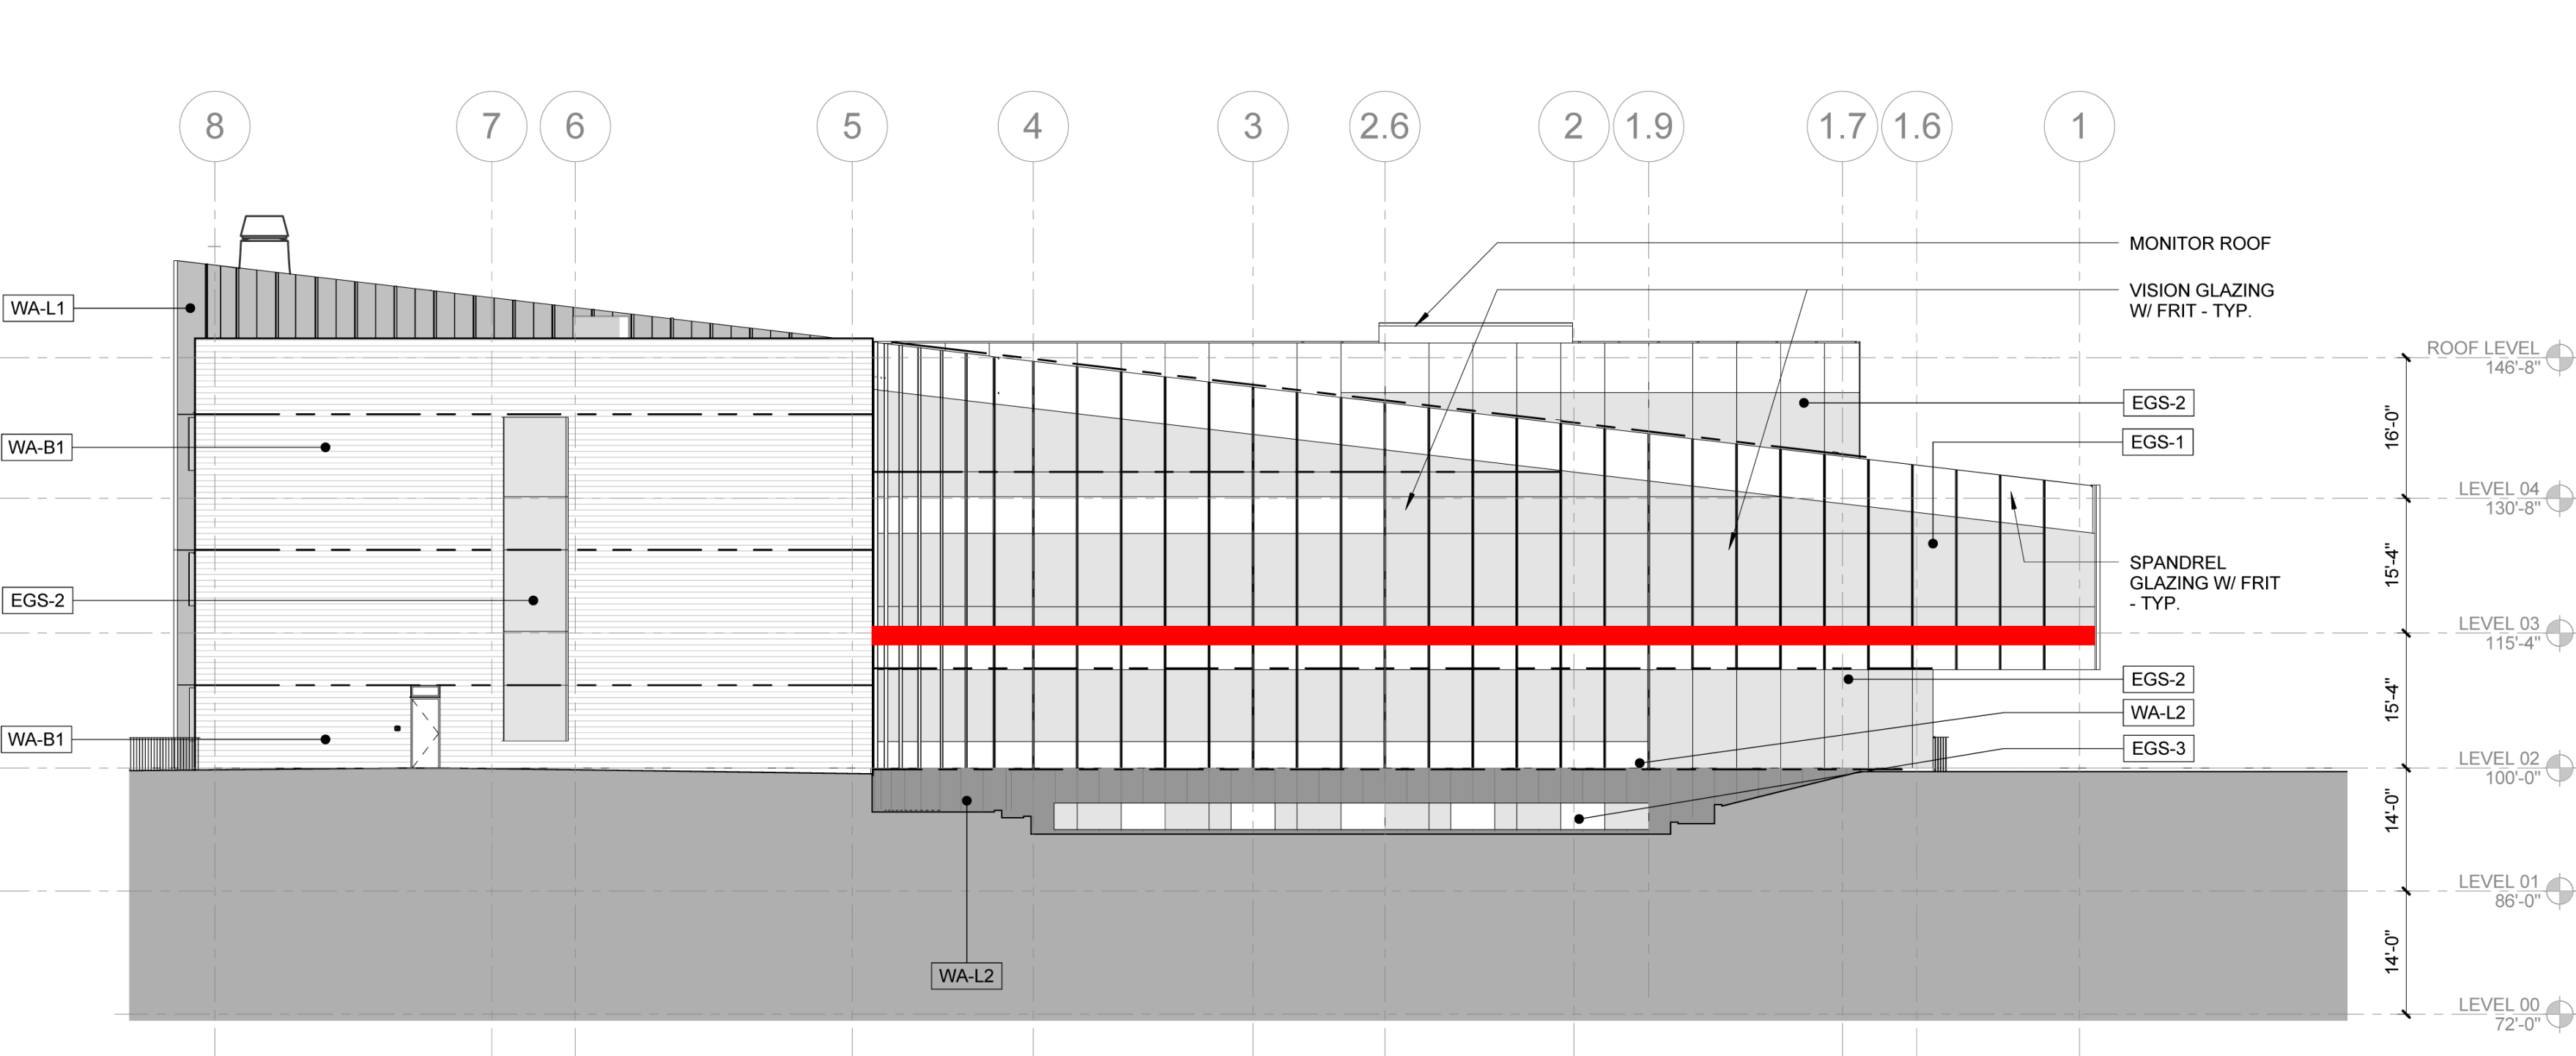


4 EXTERIOR NORTH
1/16" = 1'-0"

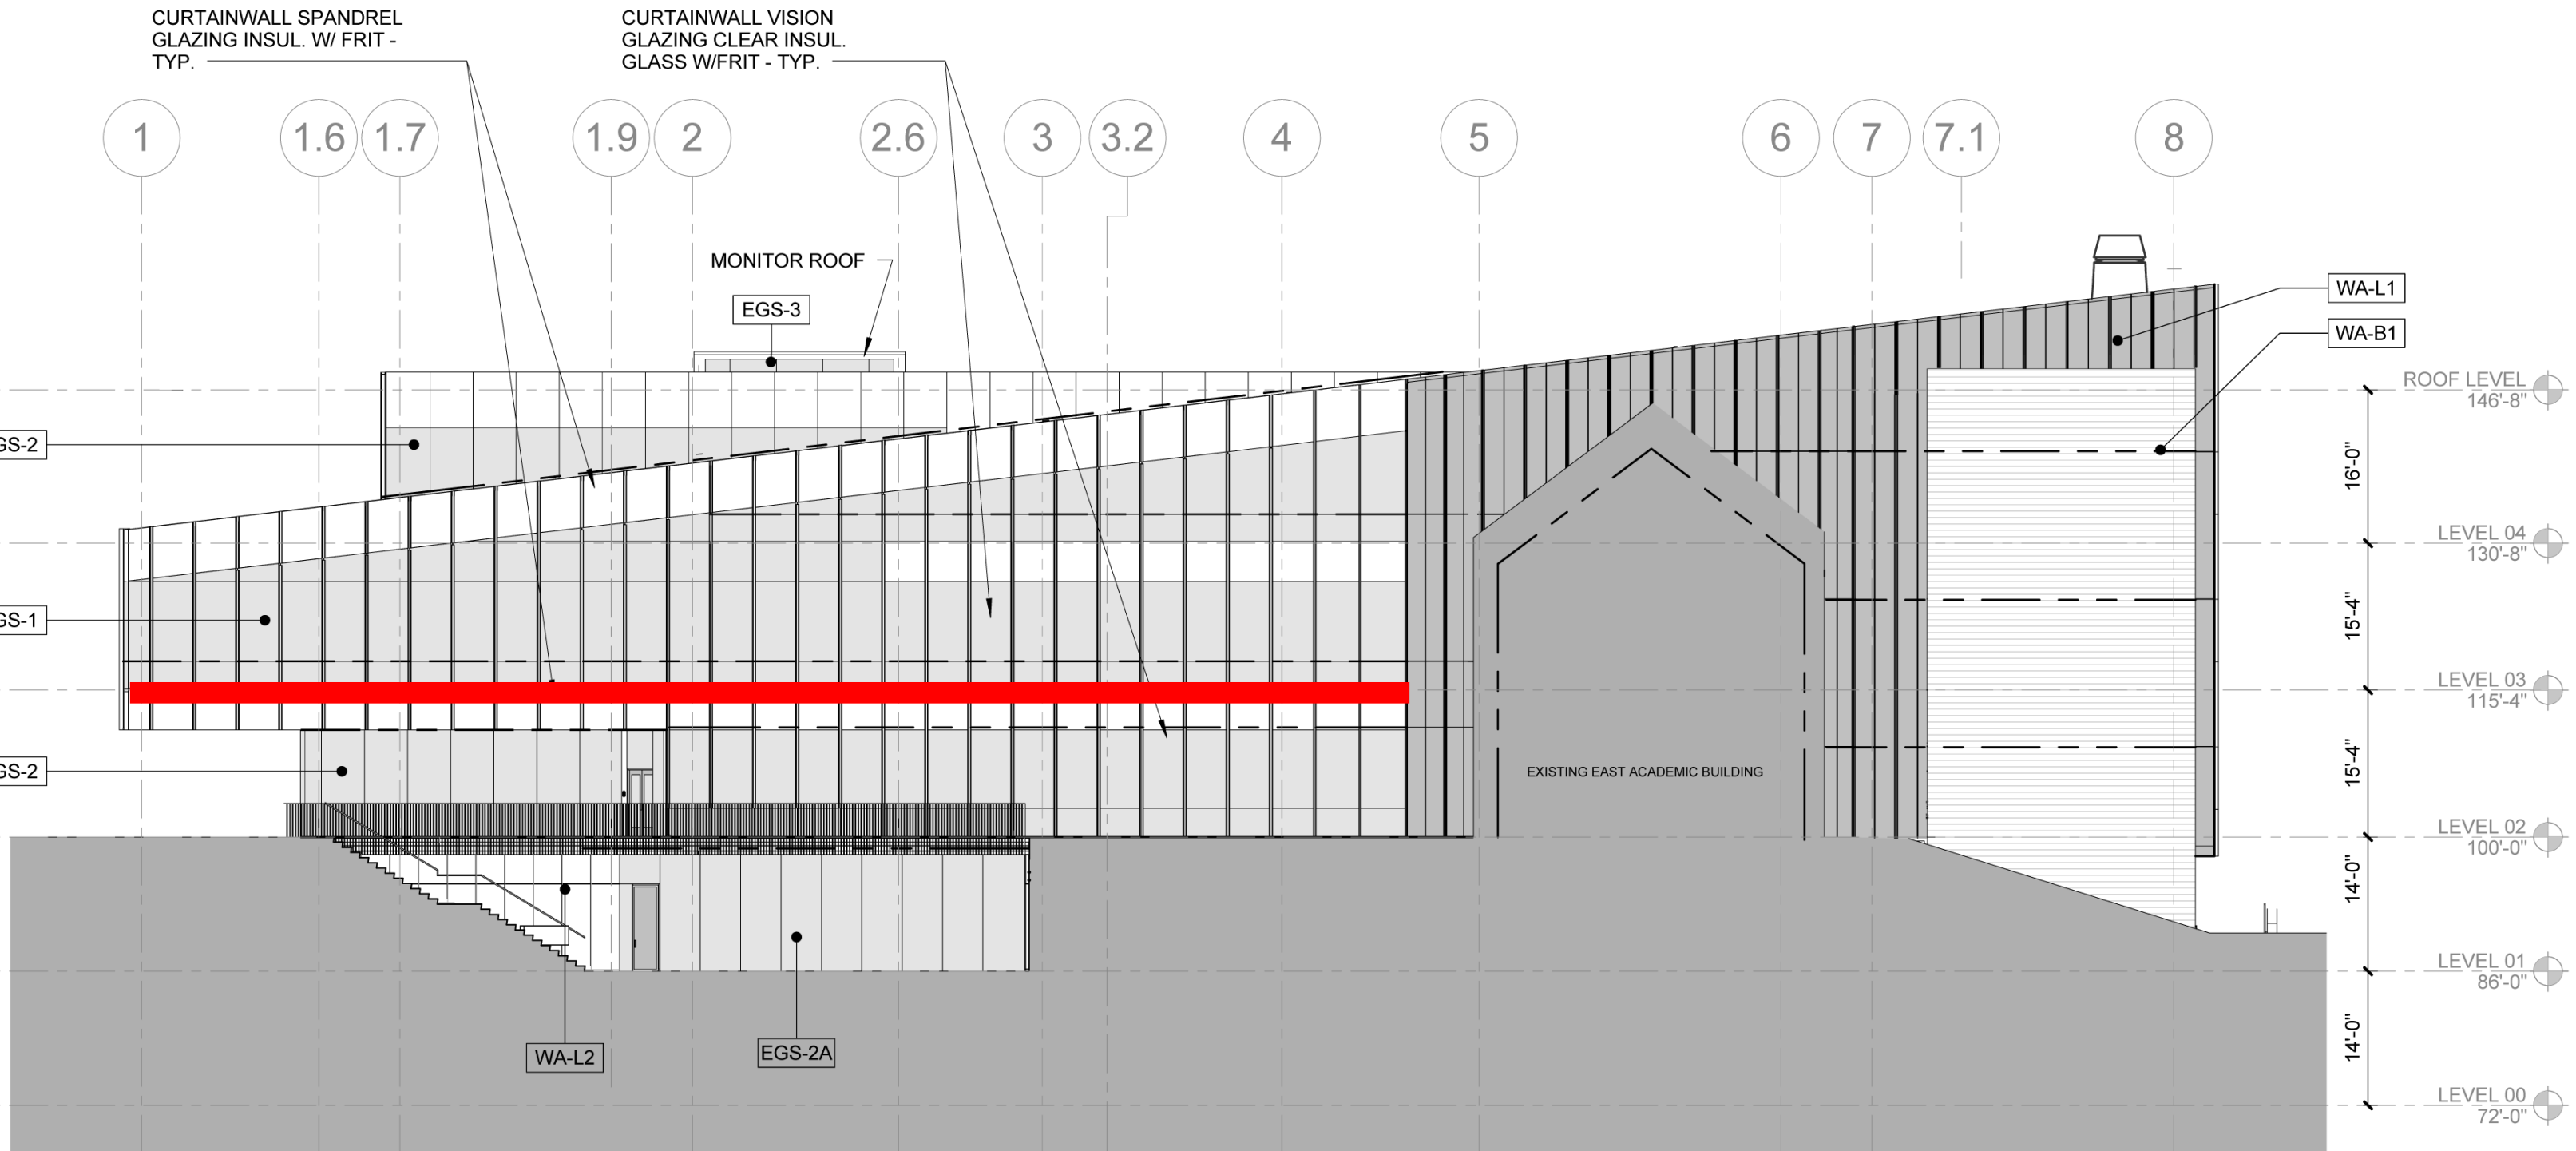

3 EXTERIOR SOUTH
1/16" = 1'-0"

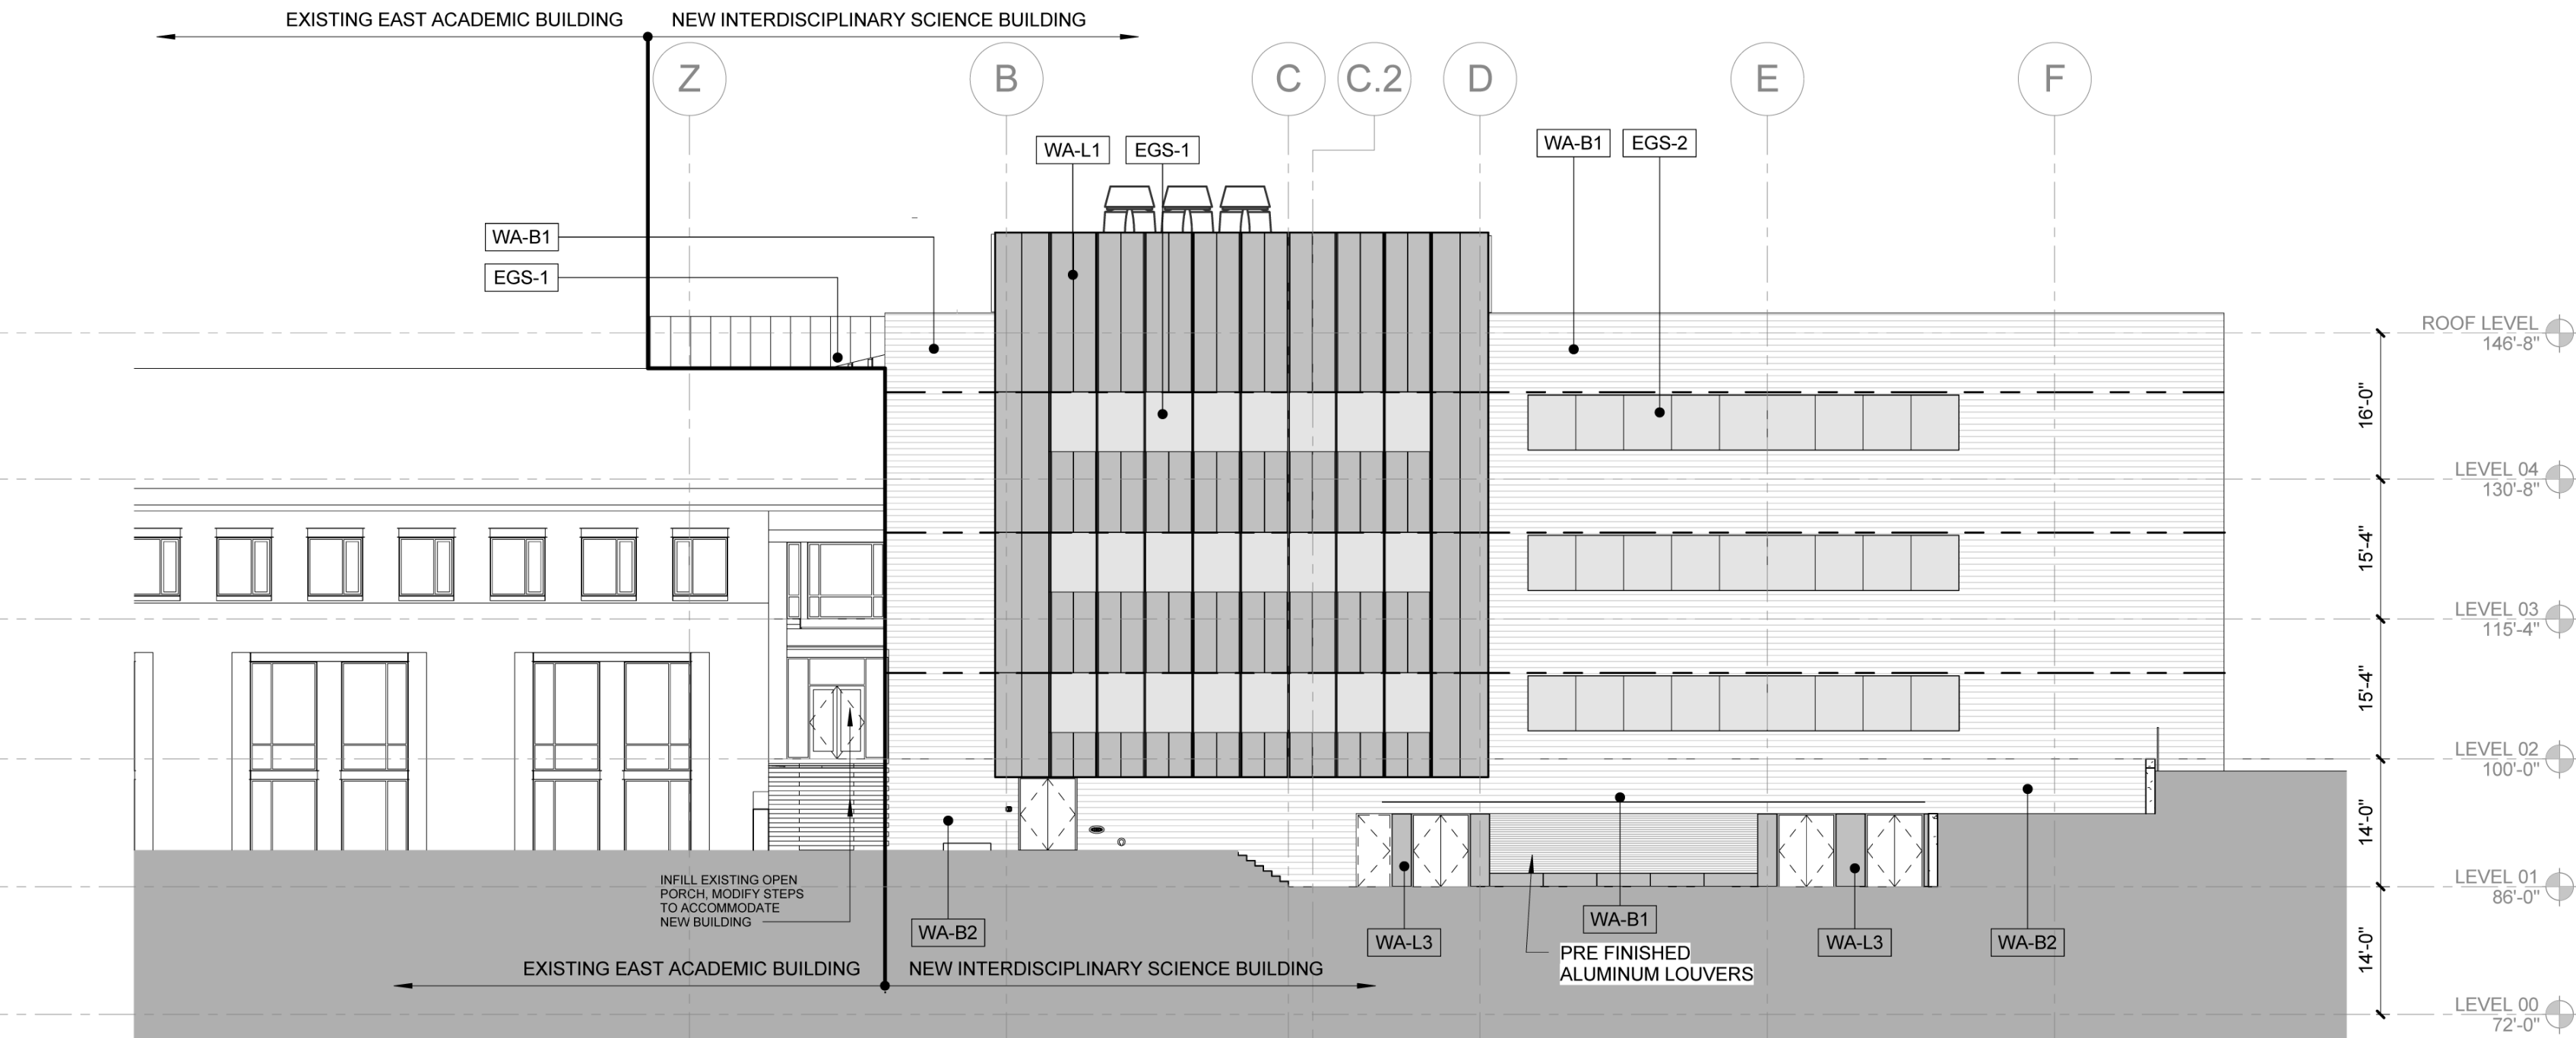

2 EXTERIOR EAST
1/16" = 1'-0"

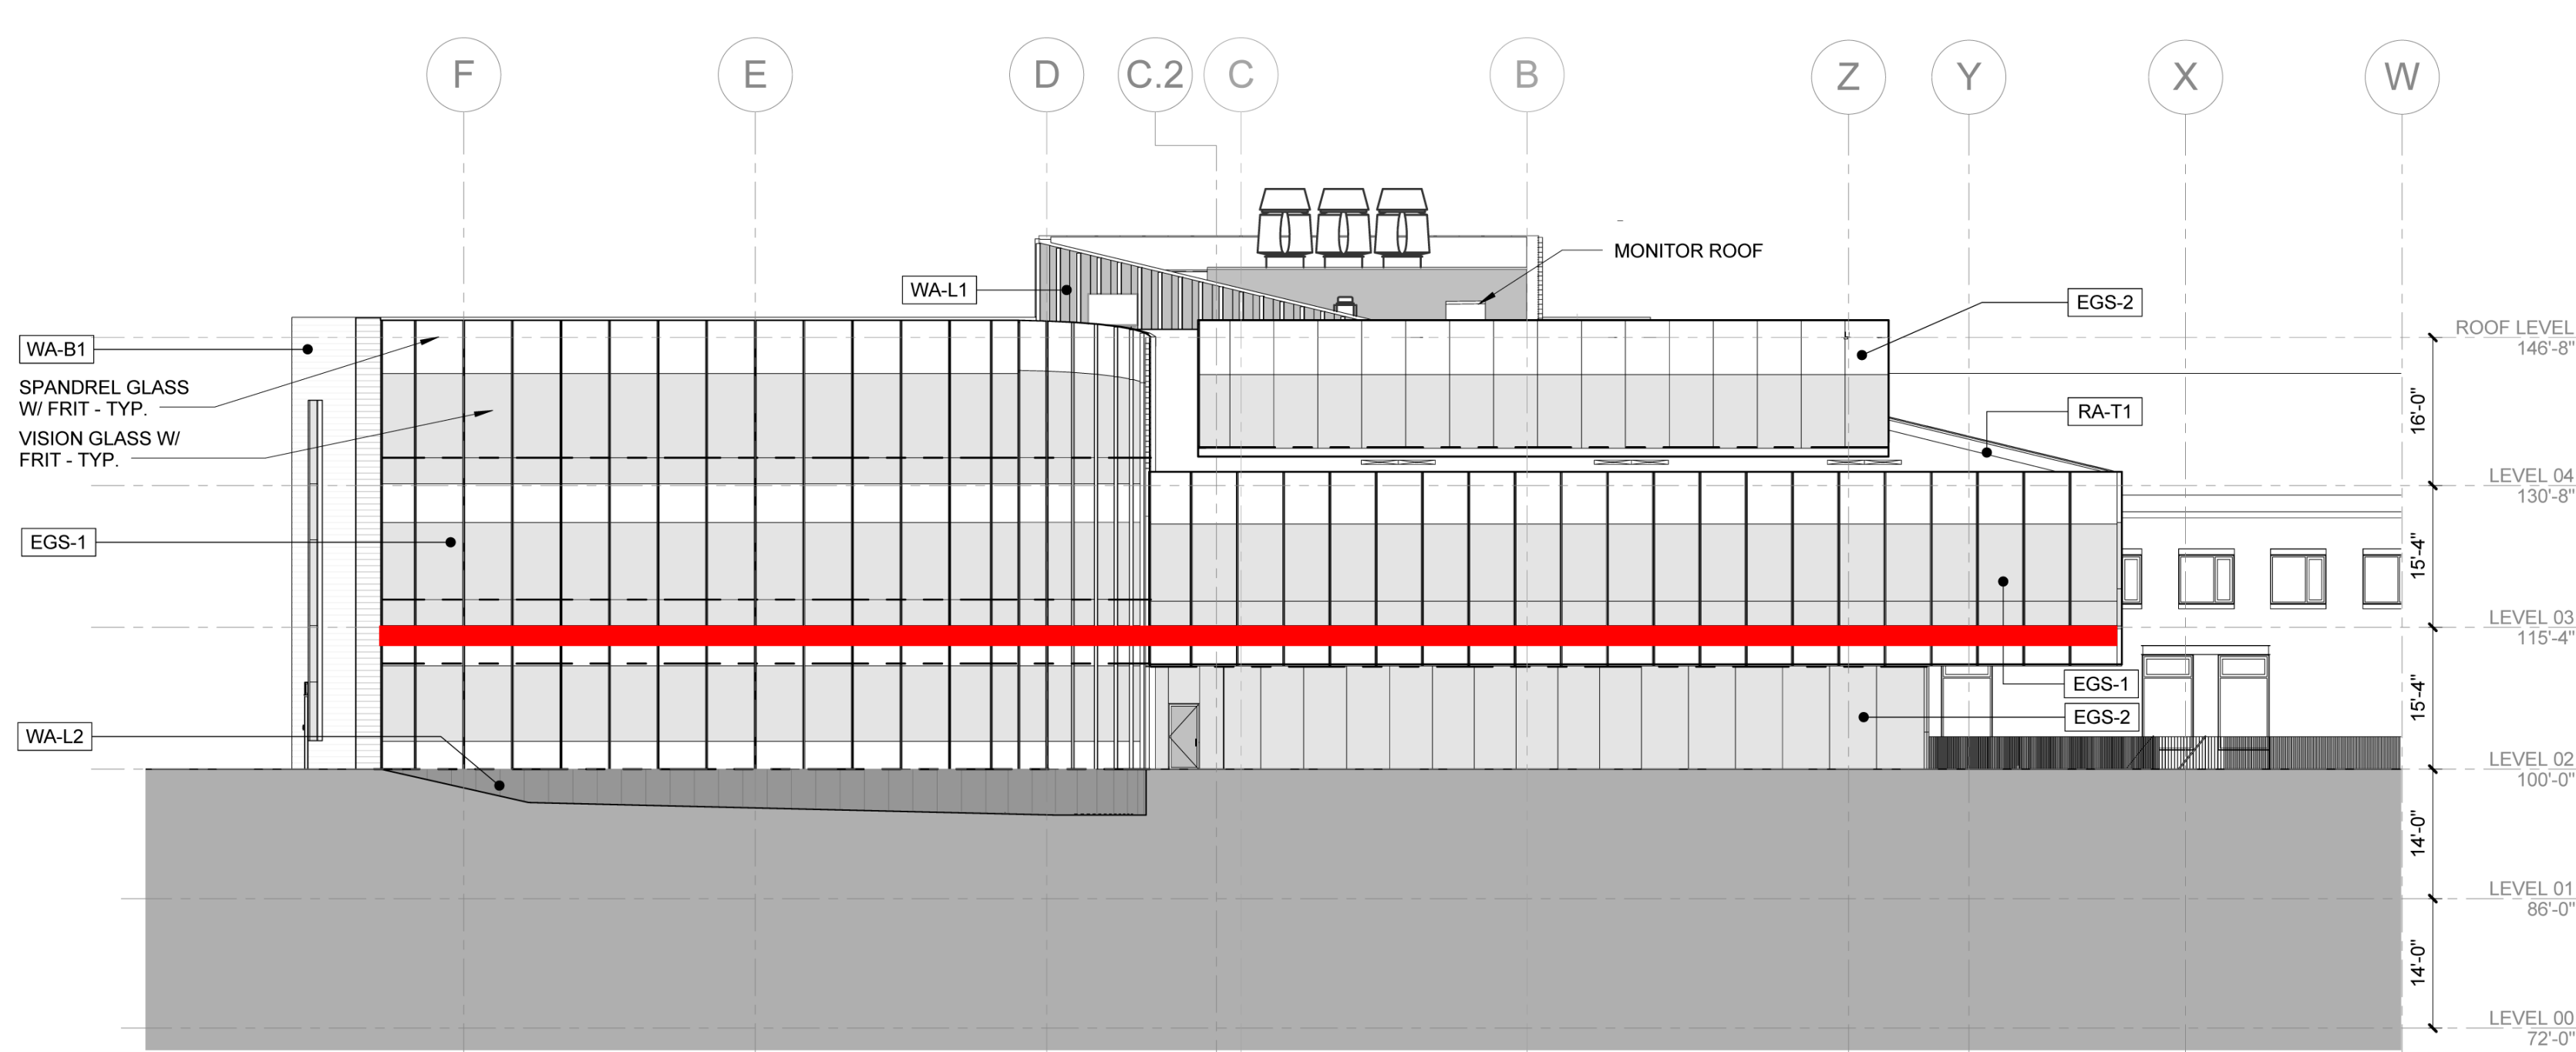

1 EXTERIOR WEST
1/16" = 1'-0"

NOTE:
1. SEE SPECIFICATIONS FOR EGS TYPES
2. SEE SHEET A0400 FOR WALL AND ROOF ASSEMBLIES

William Tao & Associates, Inc.
MEP/FP Engineer
7955 Manchester Road, Suite 125
St. Louis, MO 63143
314-884-7600

David Mason & Associates, Inc.
Structural & Civil Engineer
800 South Vandeventer Avenue
St. Louis, MO 63110
314.534.1053

Faith Group
Technology
3101 S. Hanley Rd. Suite 100
St. Louis, MO 63143
314.591.2229

Kuhmann Leavitt, Inc.
Environmental Graphics & Signage
7400 Pershing Ave.
St. Louis, MO 63130
314.725.6616


KWA Architects
Architecture
8721 Litzinger Road
St. Louis, MO 63124
314.962.2560

Spellman Brady & Company
Interior Designer
8251 Maryland Avenue, Suite 300
St. Louis, MO 63105
314.862.0070

SWT Design
Landscape Architect
7722 Big Bend Blvd
St. Louis, MO 63119
314.644.5700

Webb Engineering Services, Inc.
Plumbing & Fire Protection
1400 S. 3rd Street, Suite 201
St. Louis, MO 63104
314.558.0600

ISSUED FOR CONSTRUCTION (BP1) 15 JAN 2016
No. Description Date

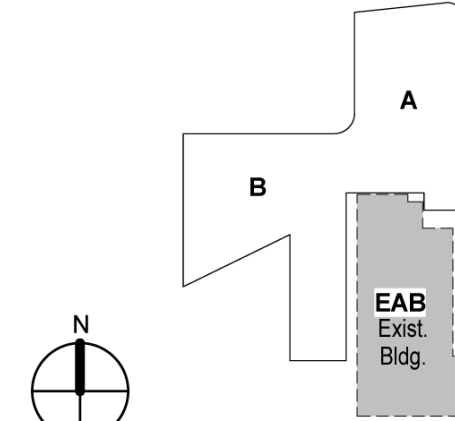

KEY PLAN


OVERALL EXTERIOR
ELEVATIONS

Project No.: 04561.01 Checked by:


A0301

Red lines denote location where system weight would be supported.


All other floor slab anchors will be wind load only connections.

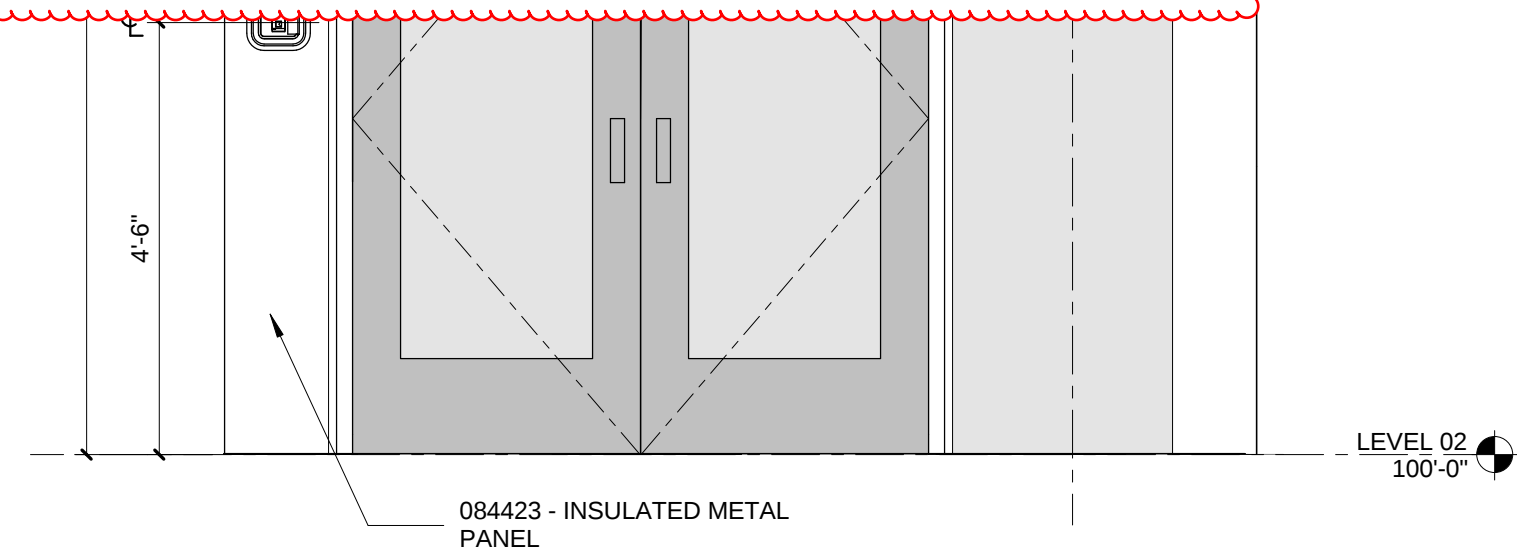


3 WEST ENTRANCE
1/2" = 1'-0"

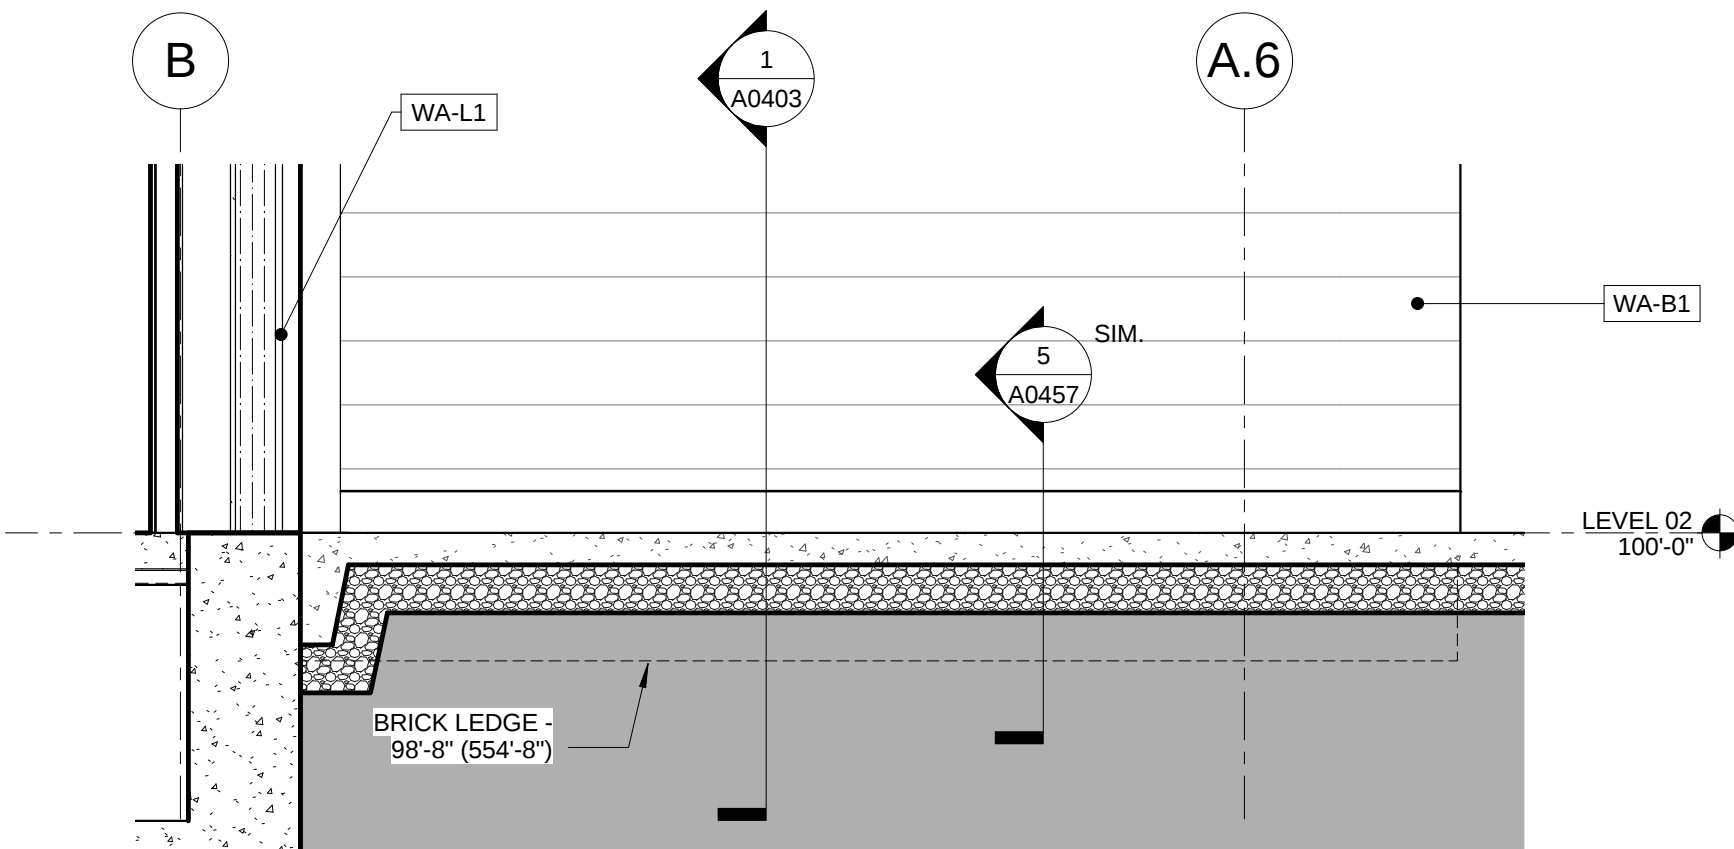

4 PARTIAL WEST ELEVATION AT COLUMN LINE "B"
1/2" = 1'-0"

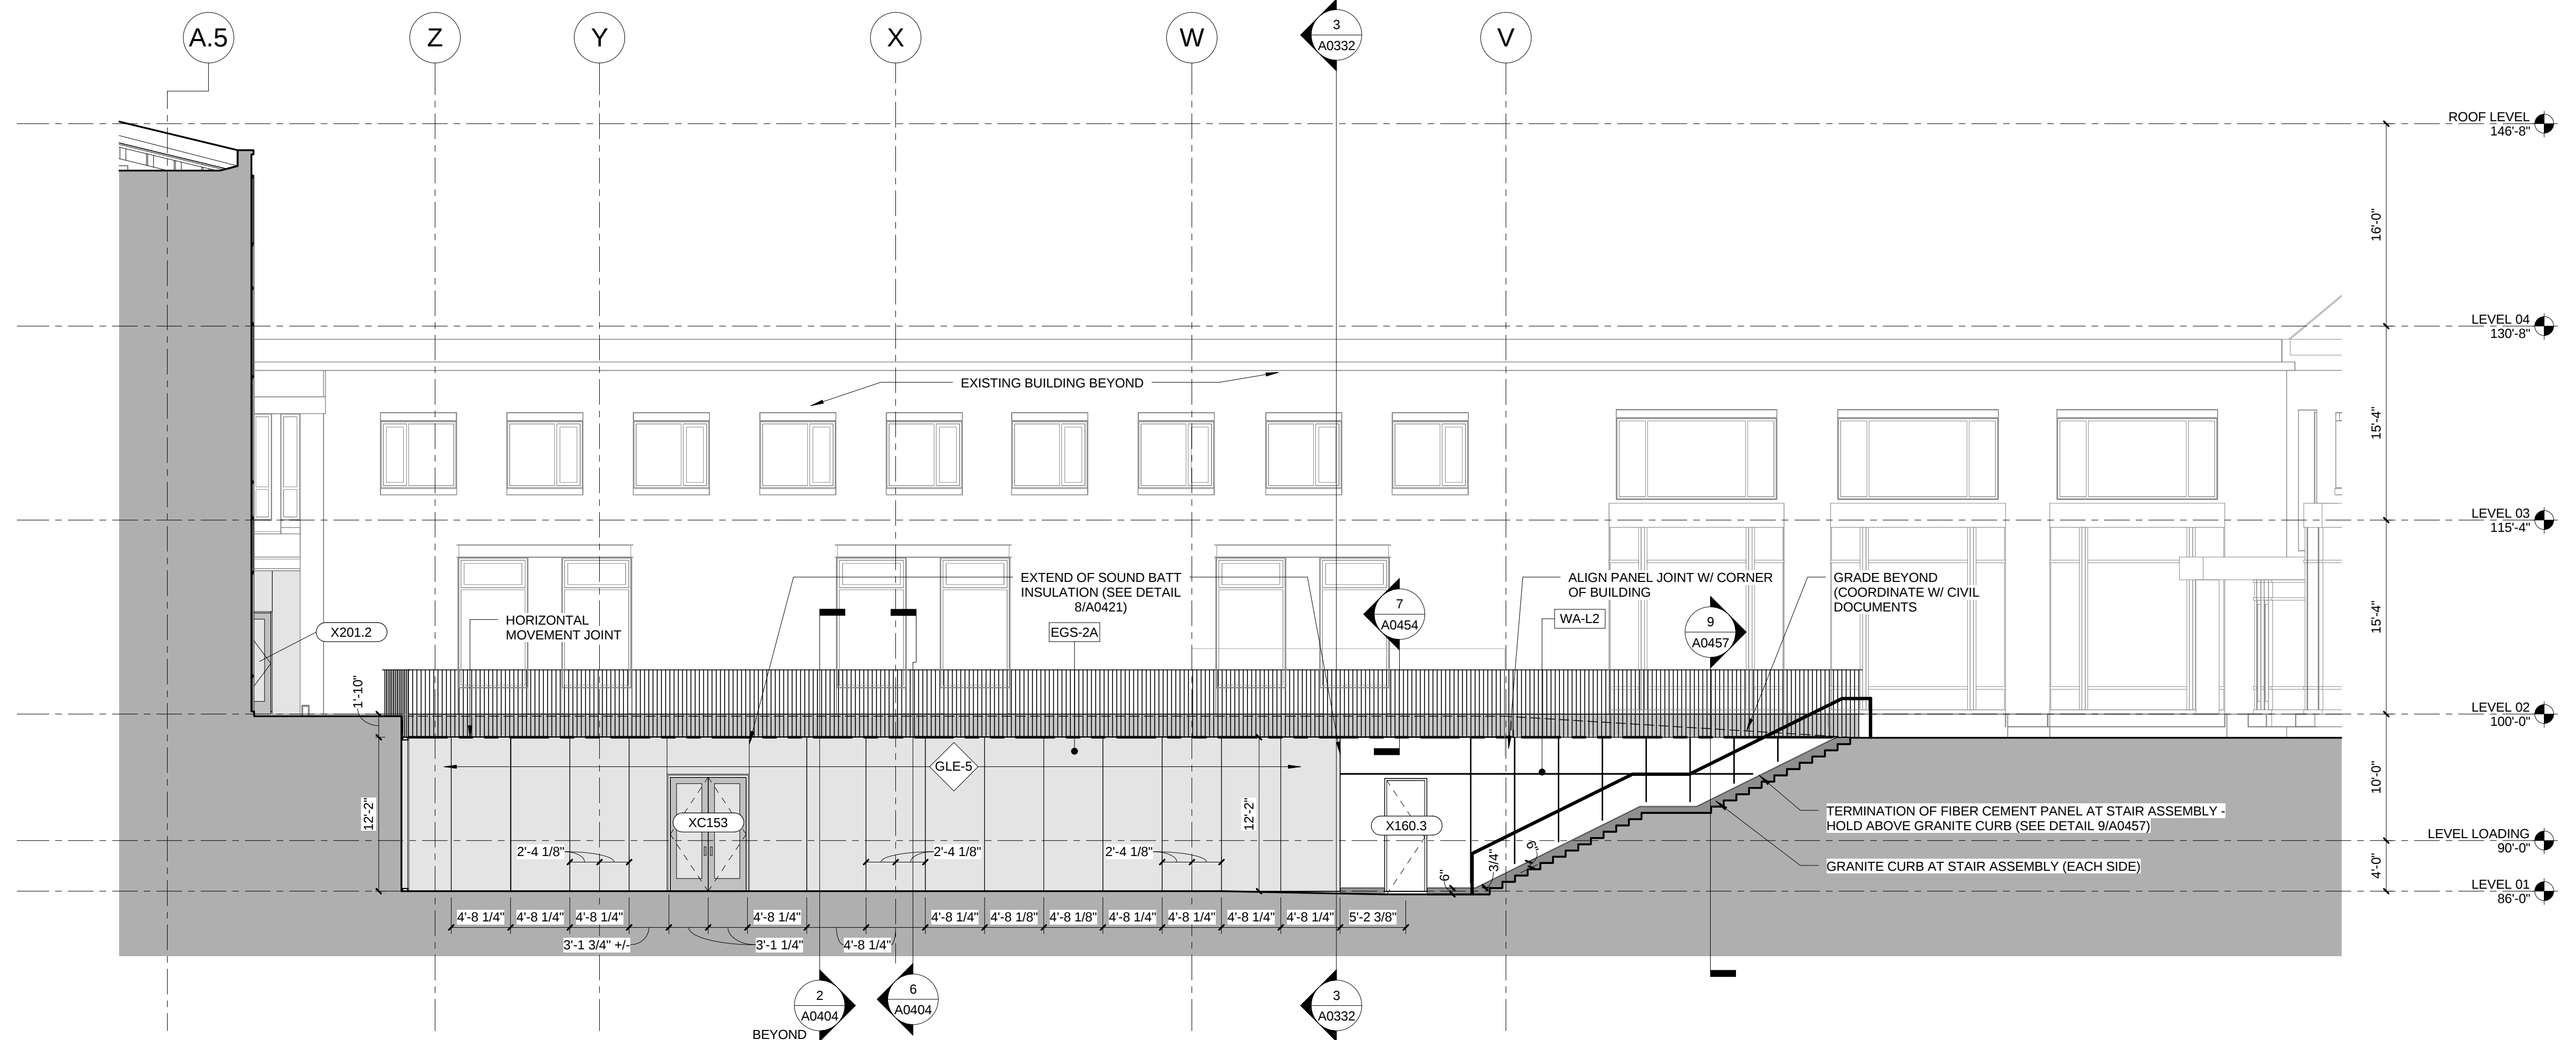

2 WEST ELEVATION AT SOUTH WING
1/8" = 1'-0"

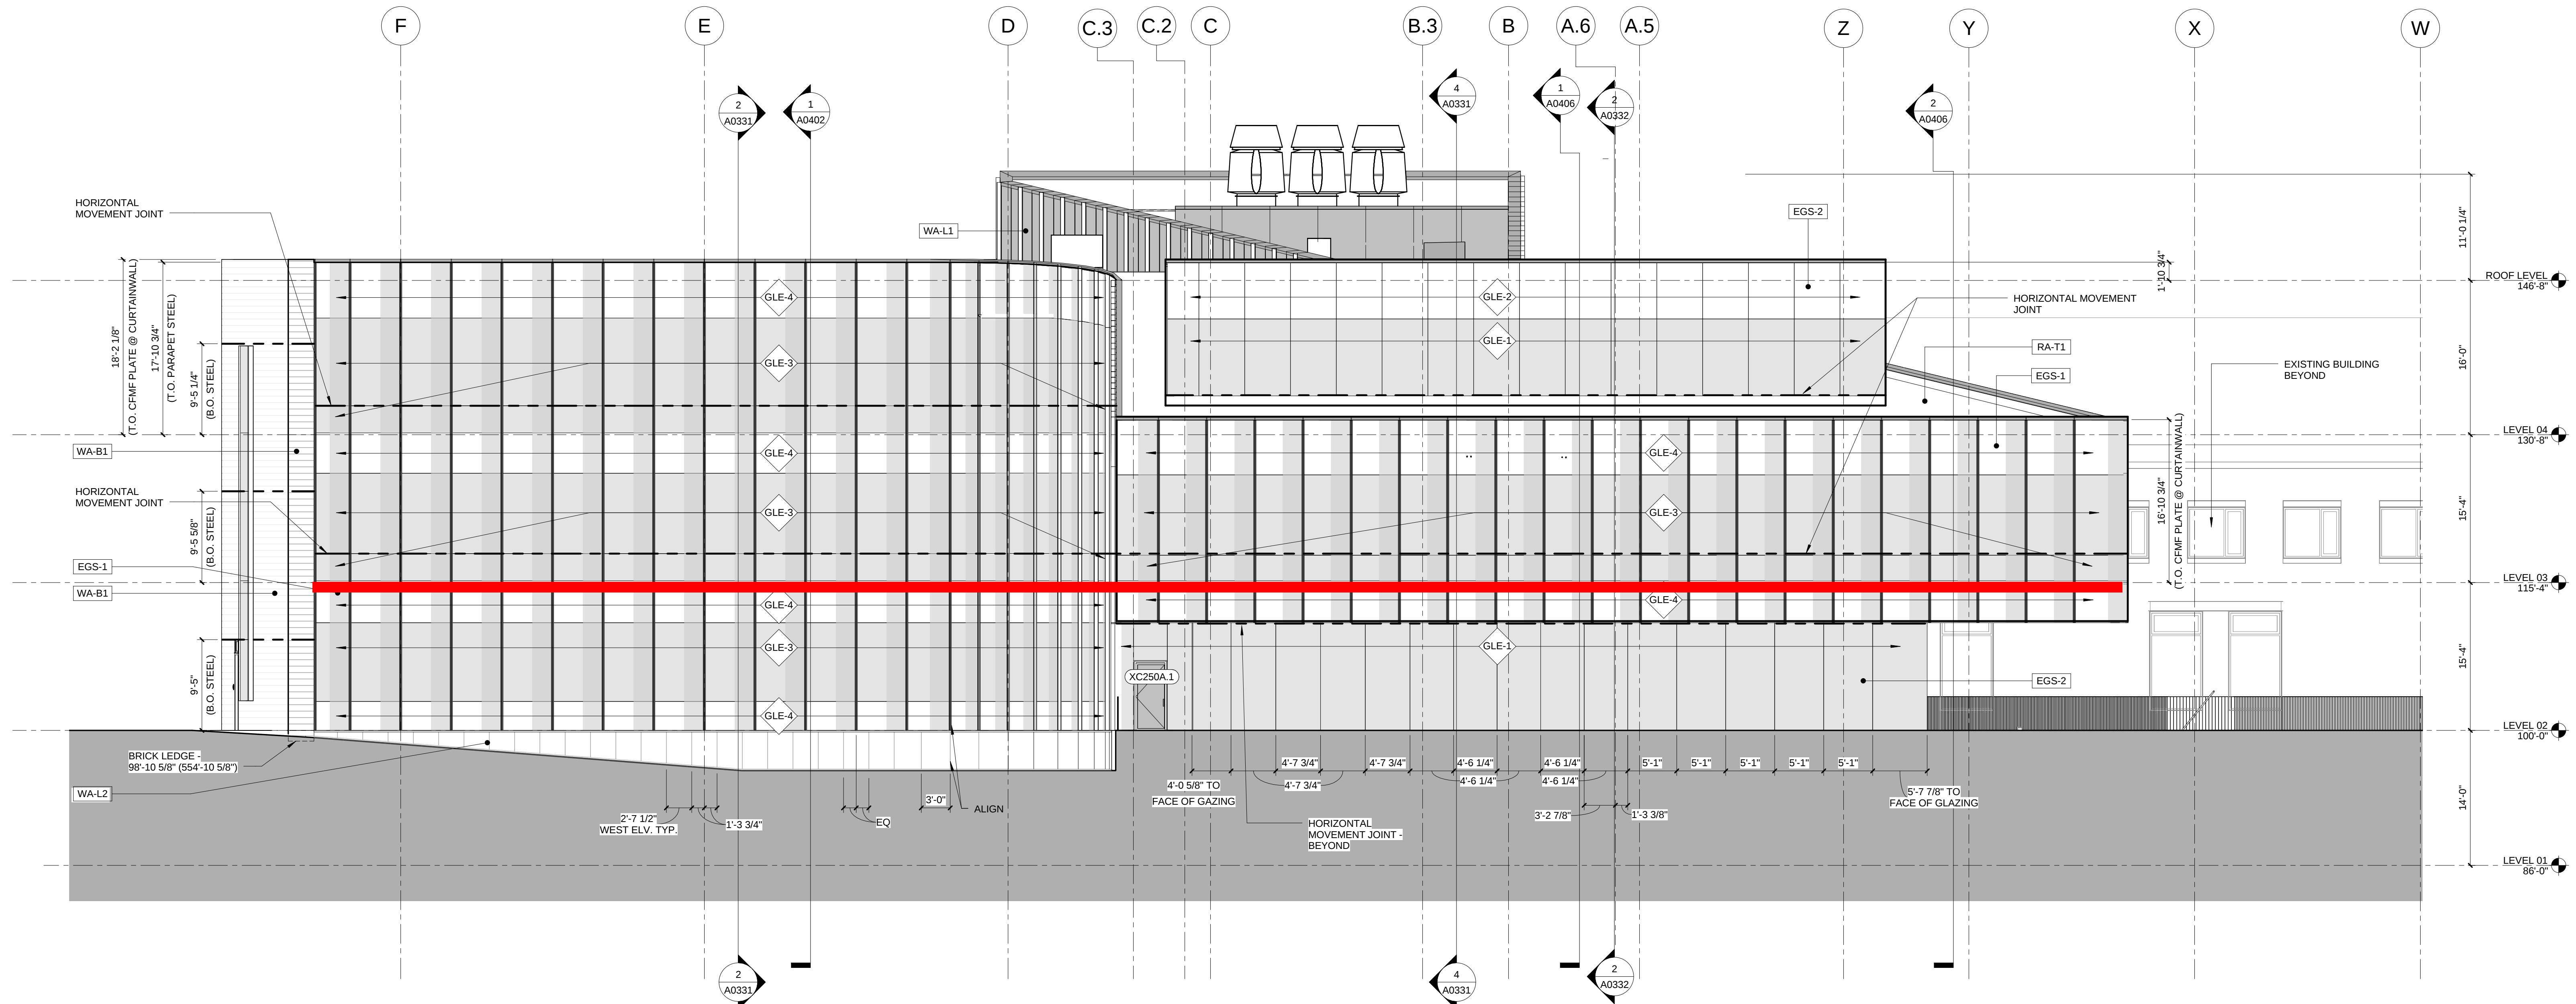

1 WEST ELEVATION
1/8" = 1'-0"

William Tao & Associates, Inc.
MEP/FP Engineer
7955 Manchester Road, Suite 125
St. Louis, MO 63143
314-884-7600

David Mason & Associates, Inc.
Structural & Civil Engineer
800 South Vandeventer Avenue
St. Louis, MO 63110
314-534-1053

Faith Group
Technology
3101 S. Hanley Rd. Suite 100
St. Louis, MO 63143
314-991-2229

Kuhnmann Leavitt, Inc.
Environmental Graphics & Signage
7400 Pershing Ave.
St. Louis, MO 63130
314-725-6616

KWA Architects
Architecture
9721 Litzinger Road
St. Louis, MO 63124
314-962-2560


Spellman Brady & Company
Interior Designer
8251 Maryland Avenue, Suite 300
St. Louis, MO 63105
314-862-0070

SWT Design
Landscape Architect
7722 Big Bend Blvd.
St. Louis, MO 63119
314-644-5700

Webb Engineering Services, Inc.
Planning & Fire Protection
1400 S. 3rd Street, Suite 201
St. Louis, MO 63104
314-588-0600

ISSUED FOR CONSTRUCTION (BP1) 15 JAN 2016

No. Description Date

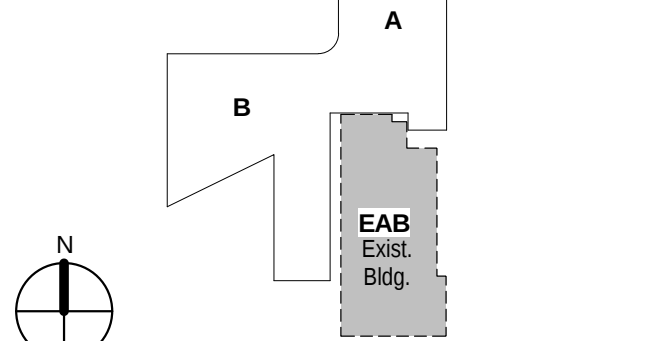

KEY PLAN

Drawing Title:


EXTERIOR ELEVATIONS

Project No.: 04561.01 Checked by:


A0311

Red lines denote location where system weight would be supported.

All other floor slab anchors will be wind load only connections.

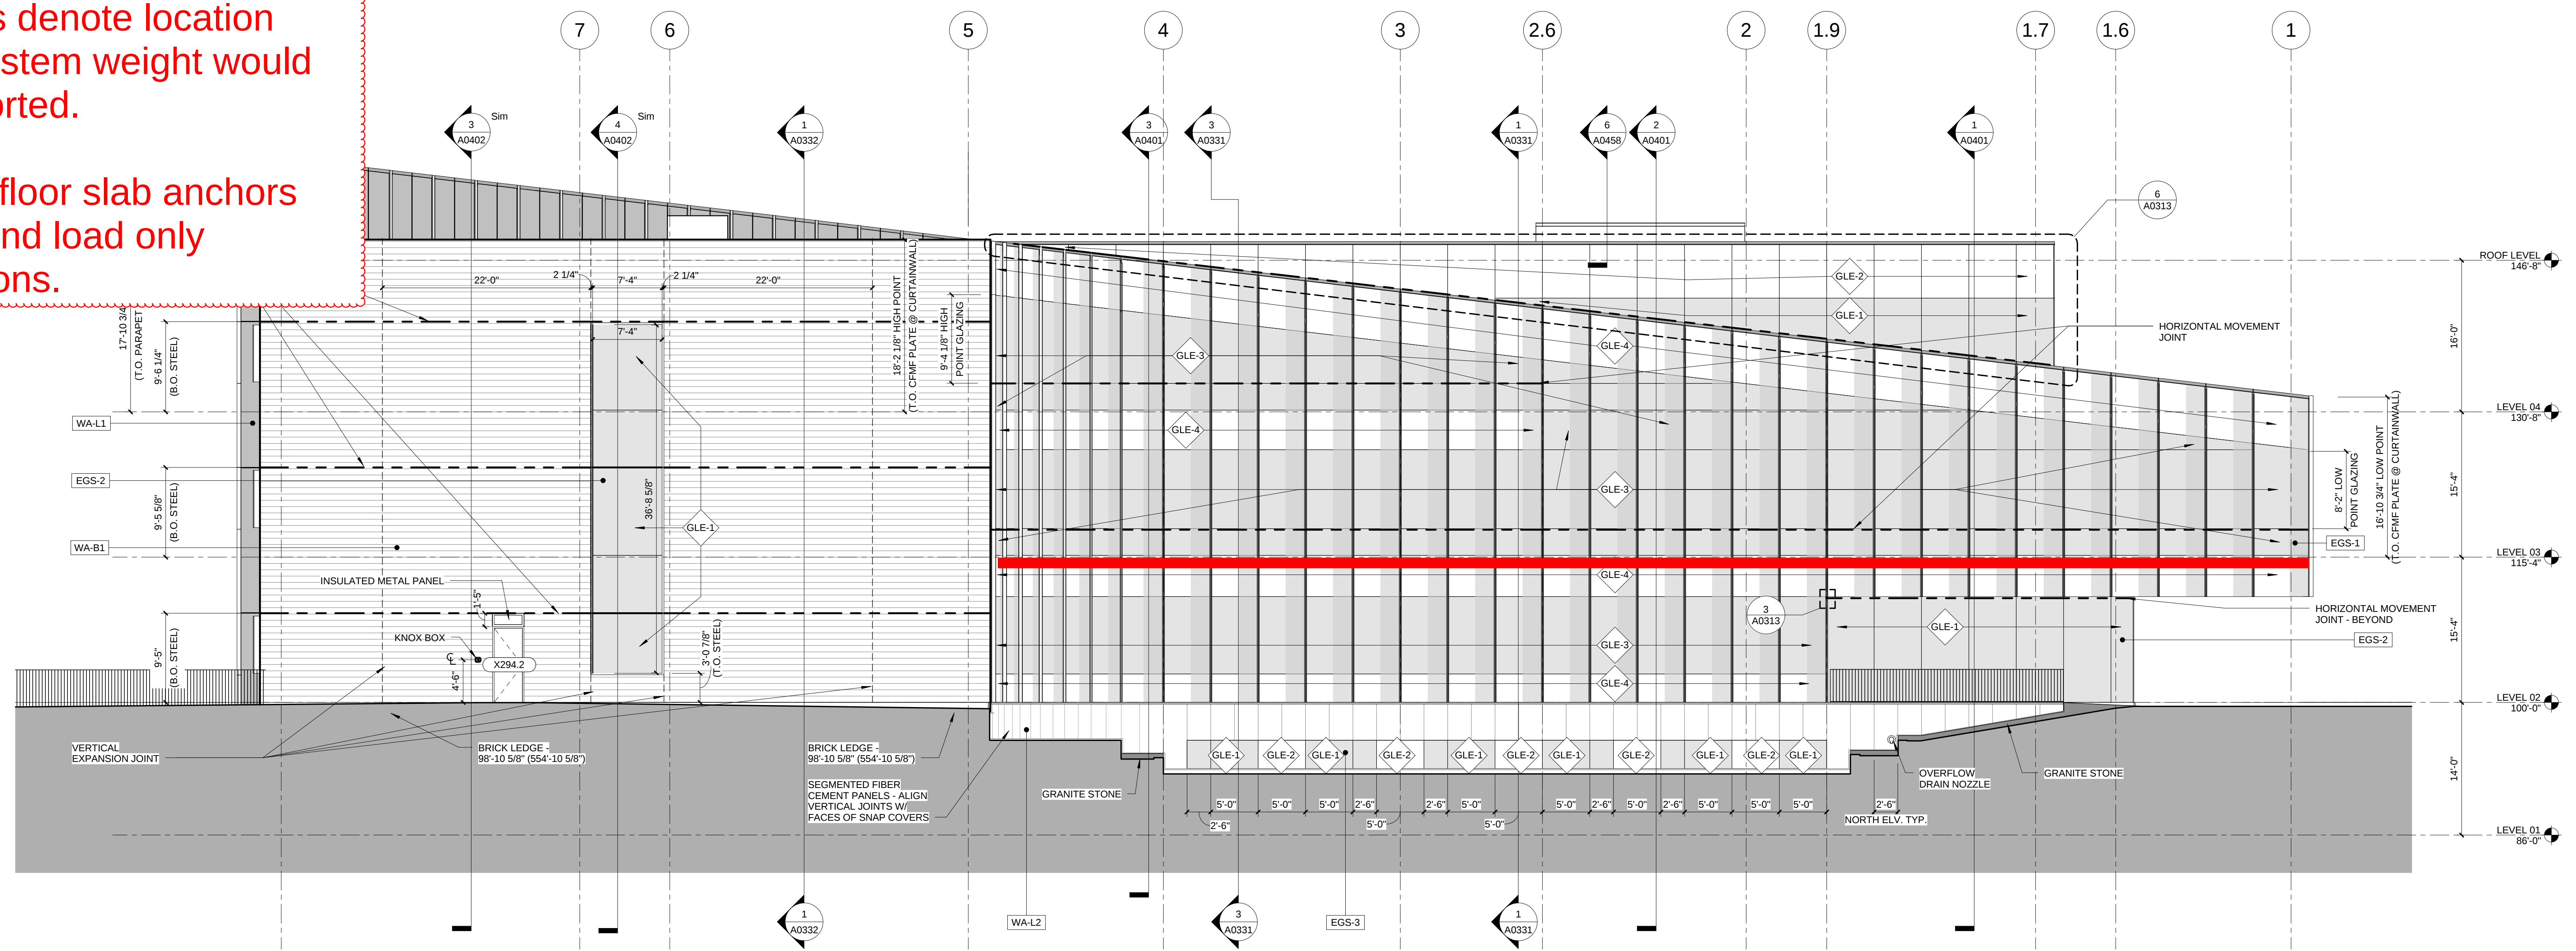


2 NORTH ELEVATION
1/8" = 1'-0"

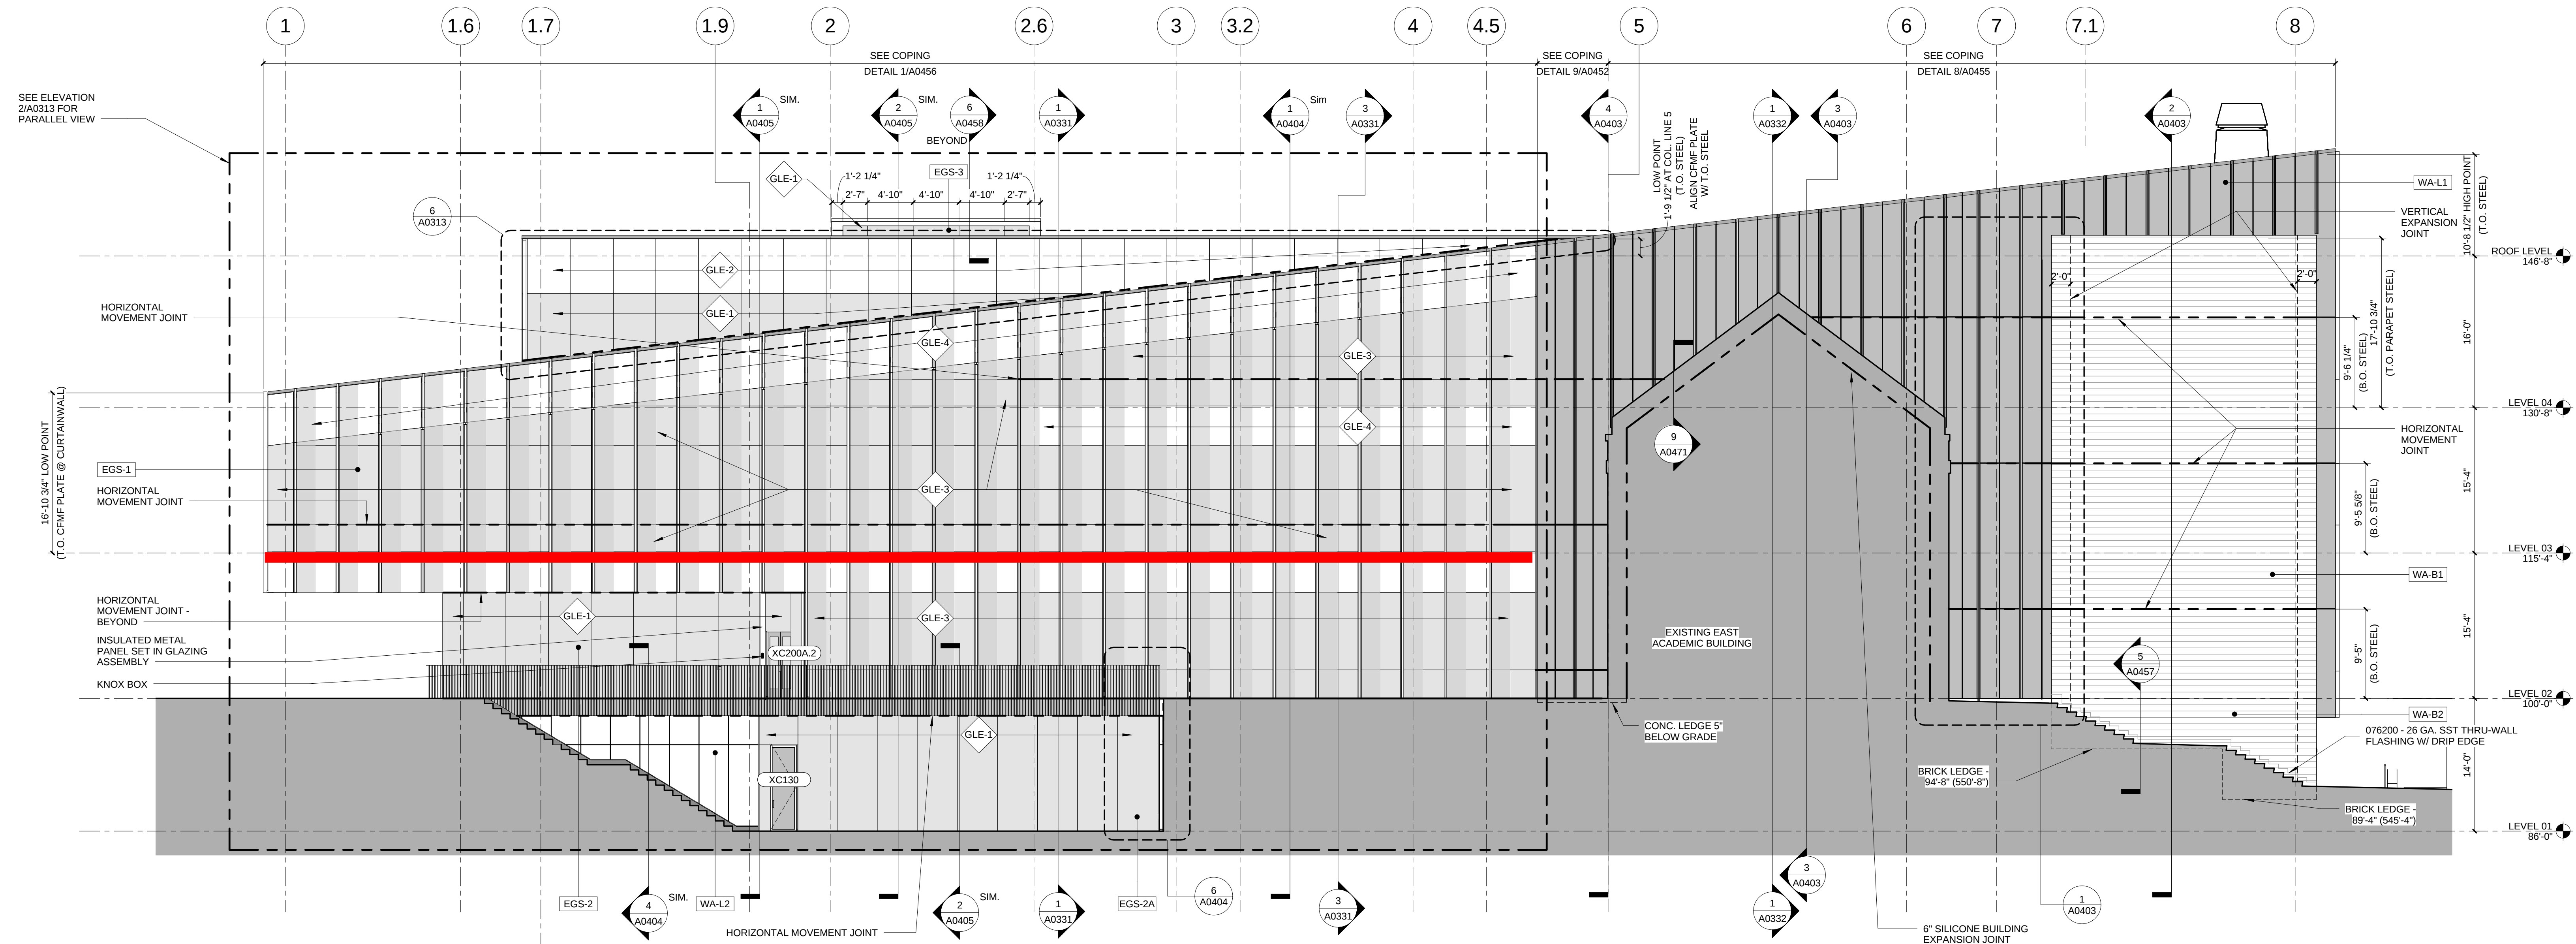

1 SOUTH ELEVATION
1/8" = 1'-0"

- William Tao & Associates, Inc.
MEP/FP Engineer
7955 Manchester Road, Suite 125
St. Louis, MO 63143
314-884-7600
- David Mason & Associates, Inc.
Structural & Civil Engineer
800 South Vandeventer Avenue
St. Louis, MO 63110
314-534-1053
- Faith Group
Technology
3101 S. Hanley Rd. Suite 100
St. Louis, MO 63143
314-591-2226
- Kuhmann Leavitt, Inc.
Environmental Graphics & Signage
7400 Pershing Ave.
St. Louis, MO 63130
314-725-6616
- KWA Architects
Architecture
9721 Litzinger Road
St. Louis, MO 63124
314-962-2560
- Spellman Brady & Company
Interior Designer
8251 Maryland Avenue, Suite 300
St. Louis, MO 63105
314-862-0070
- SWT Design
Landscape Architect
7722 Big Bend Blvd
St. Louis, MO 63119
314-644-5700
- Webb Engineering Services, Inc.
Planning & Fire Protection
1400 S. 3rd Street, Suite 201
St. Louis, MO 63104
314-588-0600

ISSUED FOR CONSTRUCTION (BP1) 15 JAN 2016

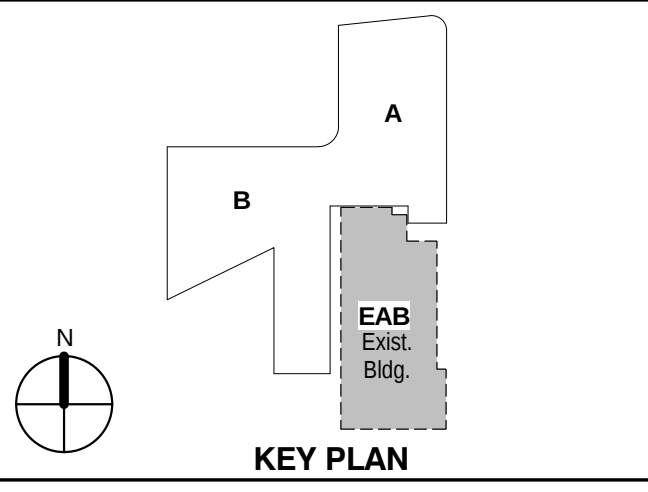

KEY PLAN

EXTERIOR ELEVATIONS

Project No.: 04561.01 Checked by:

A0312

Red lines denote location where system weight would be supported.

All other floor slab anchors will be wind load only connections.

