



PARIC CORPORATION
77 Westport Plaza Suite 250
St. Louis, MO 63146
TEL: 636-561-9500
FAX: 636-561-9501

REQUEST FOR INFORMATION **DATE:** June 15, 2016 **NO.:** RFI-170

To: Cannon Design

Attn: Kelvin Patel

From: Paric Corporation

Requested By: Joe Voypick

Project Name: 15051-Webster University Interdisciplinary Science Building Project No.: 15051

Subject: Drain Trap Primer Supplies

Response Required By: June 22, 2016

Drawing / Spec Reference:

Information Requested:

Sheet: P0101.A

Will the following drains receive regular drainage to maintain the p-trap seal, or would a trap primer supply need to be added?

196 Water Entry – FS-3
191 Cadaver Lab – FD-2 (2)
178 Mechanical Room – FD-3 (2)
172 Loading Dock – FD-3 (2)

Response:

This was addressed in Addendum 2-4 with the inclusion of a trap seal device being provided for floor drains; FD-2 and FD-3 and floor sink FS-3.
Refer to Plumbing Fixture Schedule on drawing P0601, dated 24 May 2016 as Addendum 2-4.

ARCHITECT'S RESPONSE:


This information is provided as an interpretation of the Contract Documents for implementation. It is not an authorization for change to the Contract Sum or Contract Time. If this information results in a claim for a change to the Contract, the Contractor shall notify the [Construction Manager][Architect] of a change through the change process.

Cc: Kathy Bathe, Paric Corporation

Answered By: Mike Whitworth - WES

Date: June 17, 2016

4	ADDENDUM 2-4	24 MAY 2016
3	ADDENDUM 2-2	19 APR 2016
2	MSD SUBMITTAL	12 APR 2016
1	ADDENDUM 2-1	17 MAR 2016
-	ISSUED FOR CONSTRUCTION (BP2)	01 MAR 2016

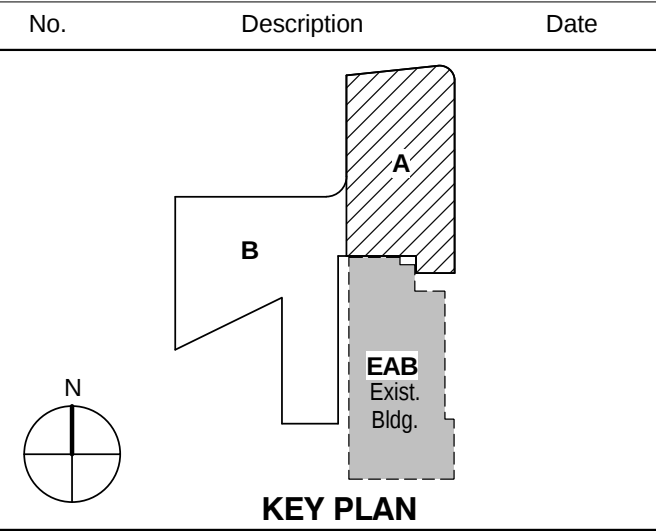


KEY PLAN

LEVEL 01 AREA A FLOOR
PLAN - PLUMBING

Project No.: 04561.01 Checked by:

P0101.A

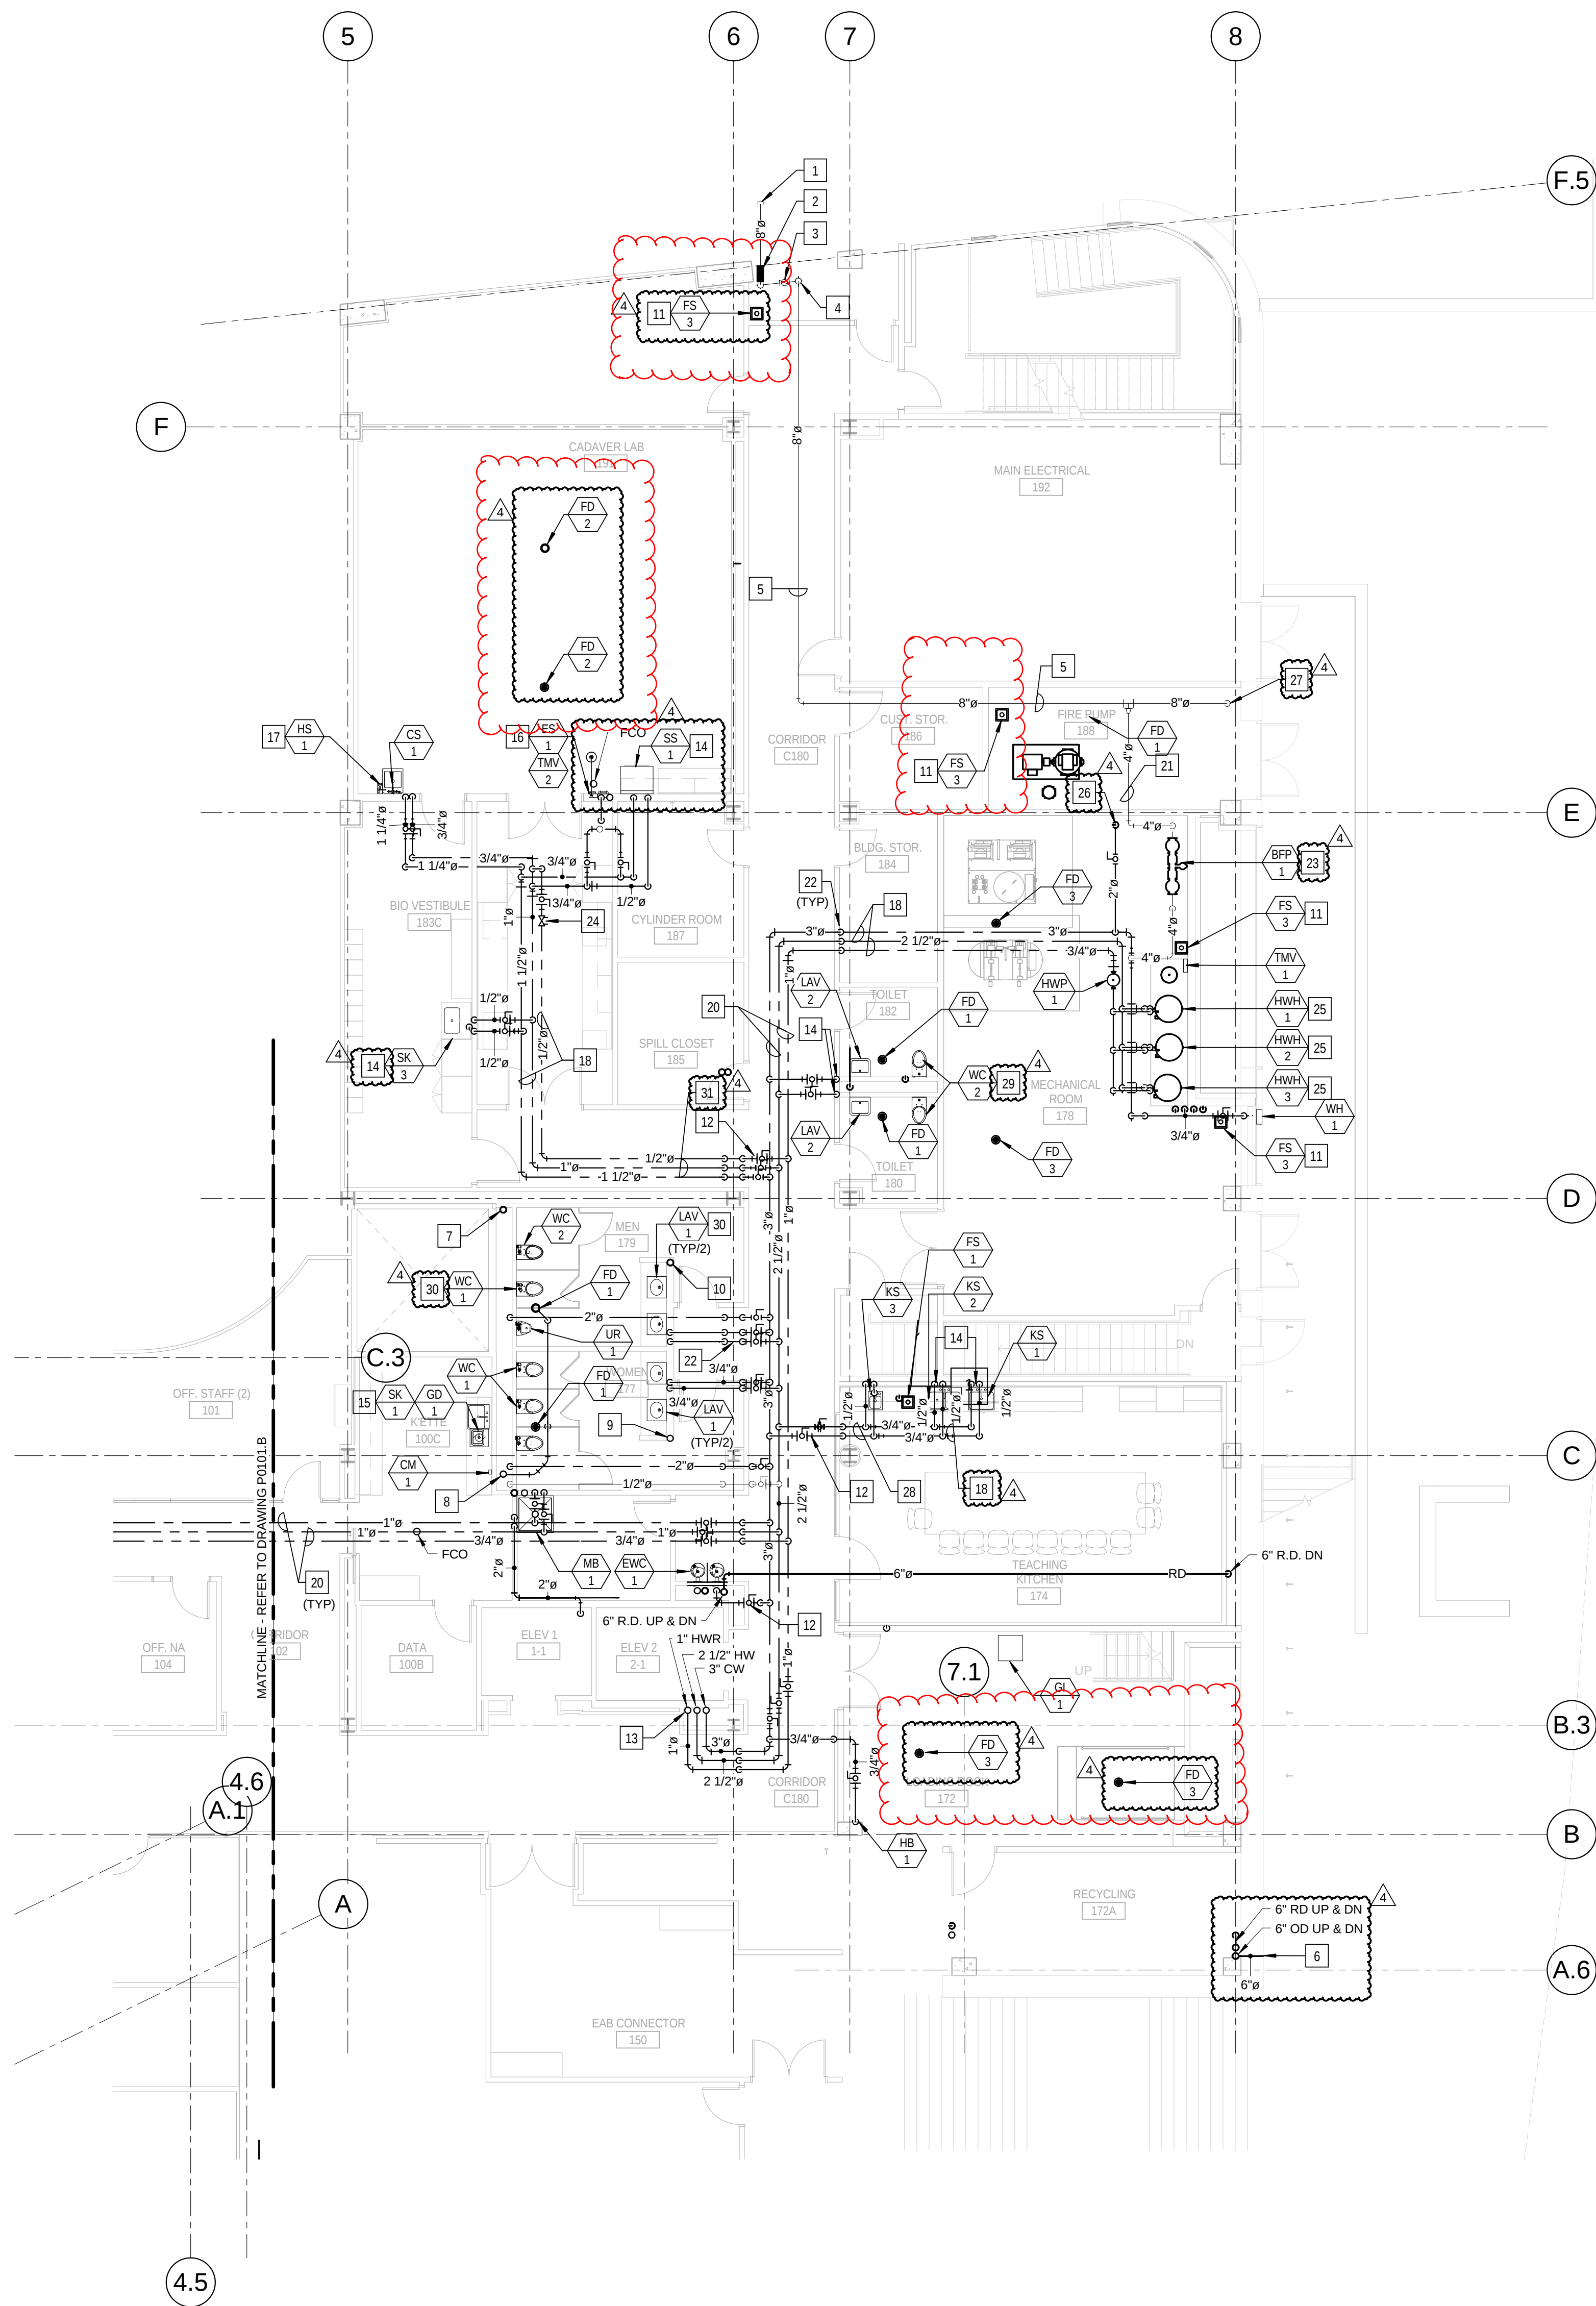

1 LEVEL 01 AREA A FLOOR PLAN - PLUMBING
1/8" = 1'-0"

KEYED NOTES - (THIS SHEET ONLY)

- 8" COMBINATION FIRE/DOMESTIC WATER SERVICE. REFER TO CIVIL DRAWINGS FOR CONTINUATION.
- SLEEVE AND SEAL WATER TIGHT WITH "LINK-SEAL" ASSEMBLY. REFER TO DETAIL ON SHEET P0501.
- MAIN SERVICE VALVE FOR COMBINATION DOMESTIC WATER AND FIRE SERVICE. REFER TO DRAWING P0403, DETAIL 1/P0403.
- BUILDING PRESSURE GAUGE POSITION TO BE VISIBLE.
- 8" GALVANIZED COMBINATION FIRE/DOMESTIC WATER SERVICE ABOVE CEILING. COORDINATE WITH OTHER TRADES PRIOR TO ROUGH IN. REFER TO DRAWING P0401, DETAIL 1.
- COORDINATE LOCATION OF DOWN SPOUT NOZZLE AND WALL SLEEVE WITH OTHER TRADES PRIOR TO ROUGH IN.
- 4" SANITARY VENT RISER UP TO SERVE WATER CLOSETS, URINALS AND FLOOR DRAINS ON EACH LEVEL.
- 4" SANITARY WASTE RISER UP TO SERVE WATER CLOSETS, URINALS AND FLOOR DRAINS ON EACH LEVEL.
- 2" SANITARY WASTE RISER UP TO SERVE LAVATORIES ON EACH LEVEL.
- 2" SANITARY VENT RISER UP TO SERVE LAVATORIES ON EACH LEVEL.
- COORDINATE LOCATION OF FLOOR SINK WITH LAYOUT OF ROOM AND FOUNDATION BELOW PRIOR TO ROUGH IN.
- FURNISH AND INSTALL SHUT-OFF VALVES AT THE ENTRY TO EACH ROOM.
- FURNISH AND INSTALL 3" CW, 2 1/2" HW AND 1" HWR PIPING UP TO SERVE LEVEL 2. ALIGN PIPE WITH WALL ABOVE.
- FURNISH AND INSTALL 1/2" CW, 1/2" HW AND 2" VENT DOWN IN WALL TO SERVE FIXTURES.
- BREAK-ROOM SINKS ARE TO BE SERVED FROM WATER, WASTE AND VENT PIPING IN TOILET ROOM CHASE.
- EMERGENCY SHOWER TO BE SERVED WITH FIELD FURNISHED AND INSTALLED 1" TEMPERED WATER TO SHOWER HEAD FROM WALL RECESSED CABINET. EYEWASH PORTION OF ASSEMBLY WILL REQUIRE 2" WASTE AND 2" VENT TYPICAL FOR ALL INSTALLATIONS. REFER TO DRAWING P0403, DETAIL 3/P0403.
- WALL RECESSED CW AND HW HOSE STATION. SERVE WITH 1/2" CW AND 1/2" HW FROM CLINICAL SINK. COORDINATE LOCATION AND MOUNTING HEIGHT WITH OTHER TRADES PRIOR TO ROUGH IN.
- PIPING IN EACH ROOM SHALL BE RUN AS HIGH AS POSSIBLE TO AVOID CONFLICTS. COORDINATE INSTALLATION AND ROUTING WITH OTHER TRADES PRIOR TO ROUGH IN.
- NOT USED.
- PIPING IN CORRIDOR TO BE AT BOTTOM OF STRUCTURAL STEEL CROSS MEMBERS. COORDINATE INSTALLATION AND ROUTING WITH OTHER TRADES PRIOR TO ROUGH IN.
- 4" GALVANIZED DOMESTIC WATER TO DOMESTIC WATER BEAUFLOW PREVENTER.
- DROP PIPING DOWN TO BELOW STRUCTURAL STEEL MEMBER. HOLD TIGHT TO BOTTOM OF STEEL.
- DOMESTIC WATER SERVICE BACK FLOW PREVENTER. REFER TO DRAWING P0501, DETAIL 6/P0501.
- HOT WATER RETURN CIRCUIT SETTER VALVE. LOCATE IN AN ACCESSIBLE LOCATION ABOVE THE CEILING. REFER TO DRAWING P0502, DETAIL 11/P0502.
- REFER TO DRAWING P0403, DETAIL 2/P0403 FOR HOT WATER HEATER PIPING DIAGRAM.
- 2" DOMESTIC WATER SERVICE DOWN TO LEVEL 0. REFER TO DRAWING P0011 FOR CONTINUATION.
- 8" GALVANIZED WATER SERVICE DOWN FOR FIRE SERVICE.
- REFER TO DRAWING P0402, DETAIL 1 FOR RISER DIAGRAMS.
- REFER TO DRAWING P0402, DETAIL 2 FOR RISER DIAGRAMS.
- REFER TO DRAWING P0401 FOR PUBLIC TOILET ROOM RISER DIAGRAMS.
- REFER TO DRAWING P0405 FOR WATER SUPPORT RISER 1.