



**PARIC CORPORATION**  
77 Westport Plaza Suite 250  
St. Louis, MO 63146  
TEL: 636-561-9500  
FAX: 636-561-9501

---

**REQUEST FOR INFORMATION      DATE: June 27, 2016      NO.: RFI-185**

---

To: Cannon Design

Attn: Kelvin Patel

From: Paric Corporation

Requested By: Joe Voypick

Project Name: 15051-Webster University Interdisciplinary Science Building      Project No.: 15051

Subject: Concrete Wall Dimensions

Response Required By: July 04, 2016

Drawing / Spec Reference:

**Information Requested:**

We cannot find a hard dimension for the level 1 concrete wall along A line from 1.6 line to 1.9 line. We were able to pull 36' 9 5/16" from the southwest corner of the wall to the end at 1.9 line. Please confirm dimension.

**Response:**

SEE ATTACHED: SET EAST END OF WALL FROM INTERSECTION OF COLUMN LINE 2 AND COLUMN LINE A. (THE DIMENSION INDICATED SHOULD BE CLOSE.)

NOTE: TOP OF WALL BETWEEN 1.8 & 1.9 IS NOTCHED FOR W16 CONN TO PILASTER - SEE CONCRETE REINF SHOP SUBMITTAL RETURNS AND ADD #1-11

**ARCHITECT'S RESPONSE:**

This information is provided as an interpretation of the Contract Documents for implementation. It is not an authorization for change to the Contract Sum or Contract Time. If this information results in a claim for a change to the Contract, the Contractor shall notify the [Construction Manager][Architect] of a change through the change process.

Cc: Kathy Bathe, Paric Corporation

Answered By: LYNN GROSSMAN

Date: 07.06.16

William Tao & Associates, Inc.  
MEP/FP Engineer  
7955 Manchester Road, Suite 125  
St. Louis, MO 63143  
314-884-7600

David Mason & Associates, Inc.  
Structural & Civil Engineer  
800 South Vandeventer Avenue  
St. Louis, MO 63110  
314.534.1053

Faith Group  
Technology  
3101 S. Hanley Rd. Suite 100  
St. Louis, MO 63143  
314.991.2229

Kuhnmann Leavitt, Inc.  
Environmental Graphics & Signage  
7400 Pershing Ave.  
St. Louis, MO 63130  
314.725.6616

KWA Architects  
Architecture  
9721 Litzinger Road  
St. Louis, MO 63124  
314.962.2560


Spellman Brady & Company  
Interior Designer  
8251 Maryland Avenue, Suite 300  
St. Louis, MO 63105  
314.862.0070

SWT Design  
Landscape Architect  
7722 Big Bend Blvd  
St. Louis, MO 63119  
314.644.5700

Webb Engineering Services, Inc.  
Planning & Fire Protection  
1400 S. 3rd Street, Suite 201  
St. Louis, MO 63104  
314.588.0600

CONFORMED SET 01 JUL 2016

ISSUED FOR CONSTRUCTION (BP1) 15 JAN 2016  
No. Description Date

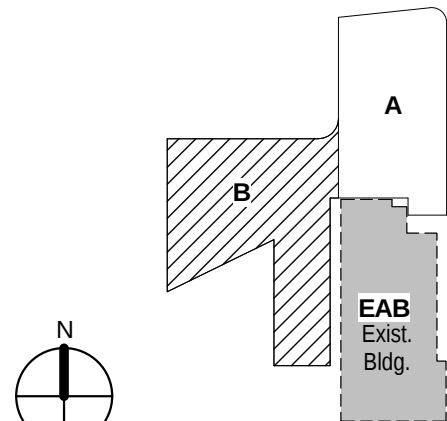


KEY PLAN

EXTERIOR - LEVEL 01  
AREA B FLOOR PLAN

Project No.: 04561.01 Checked by:

A0101.EB

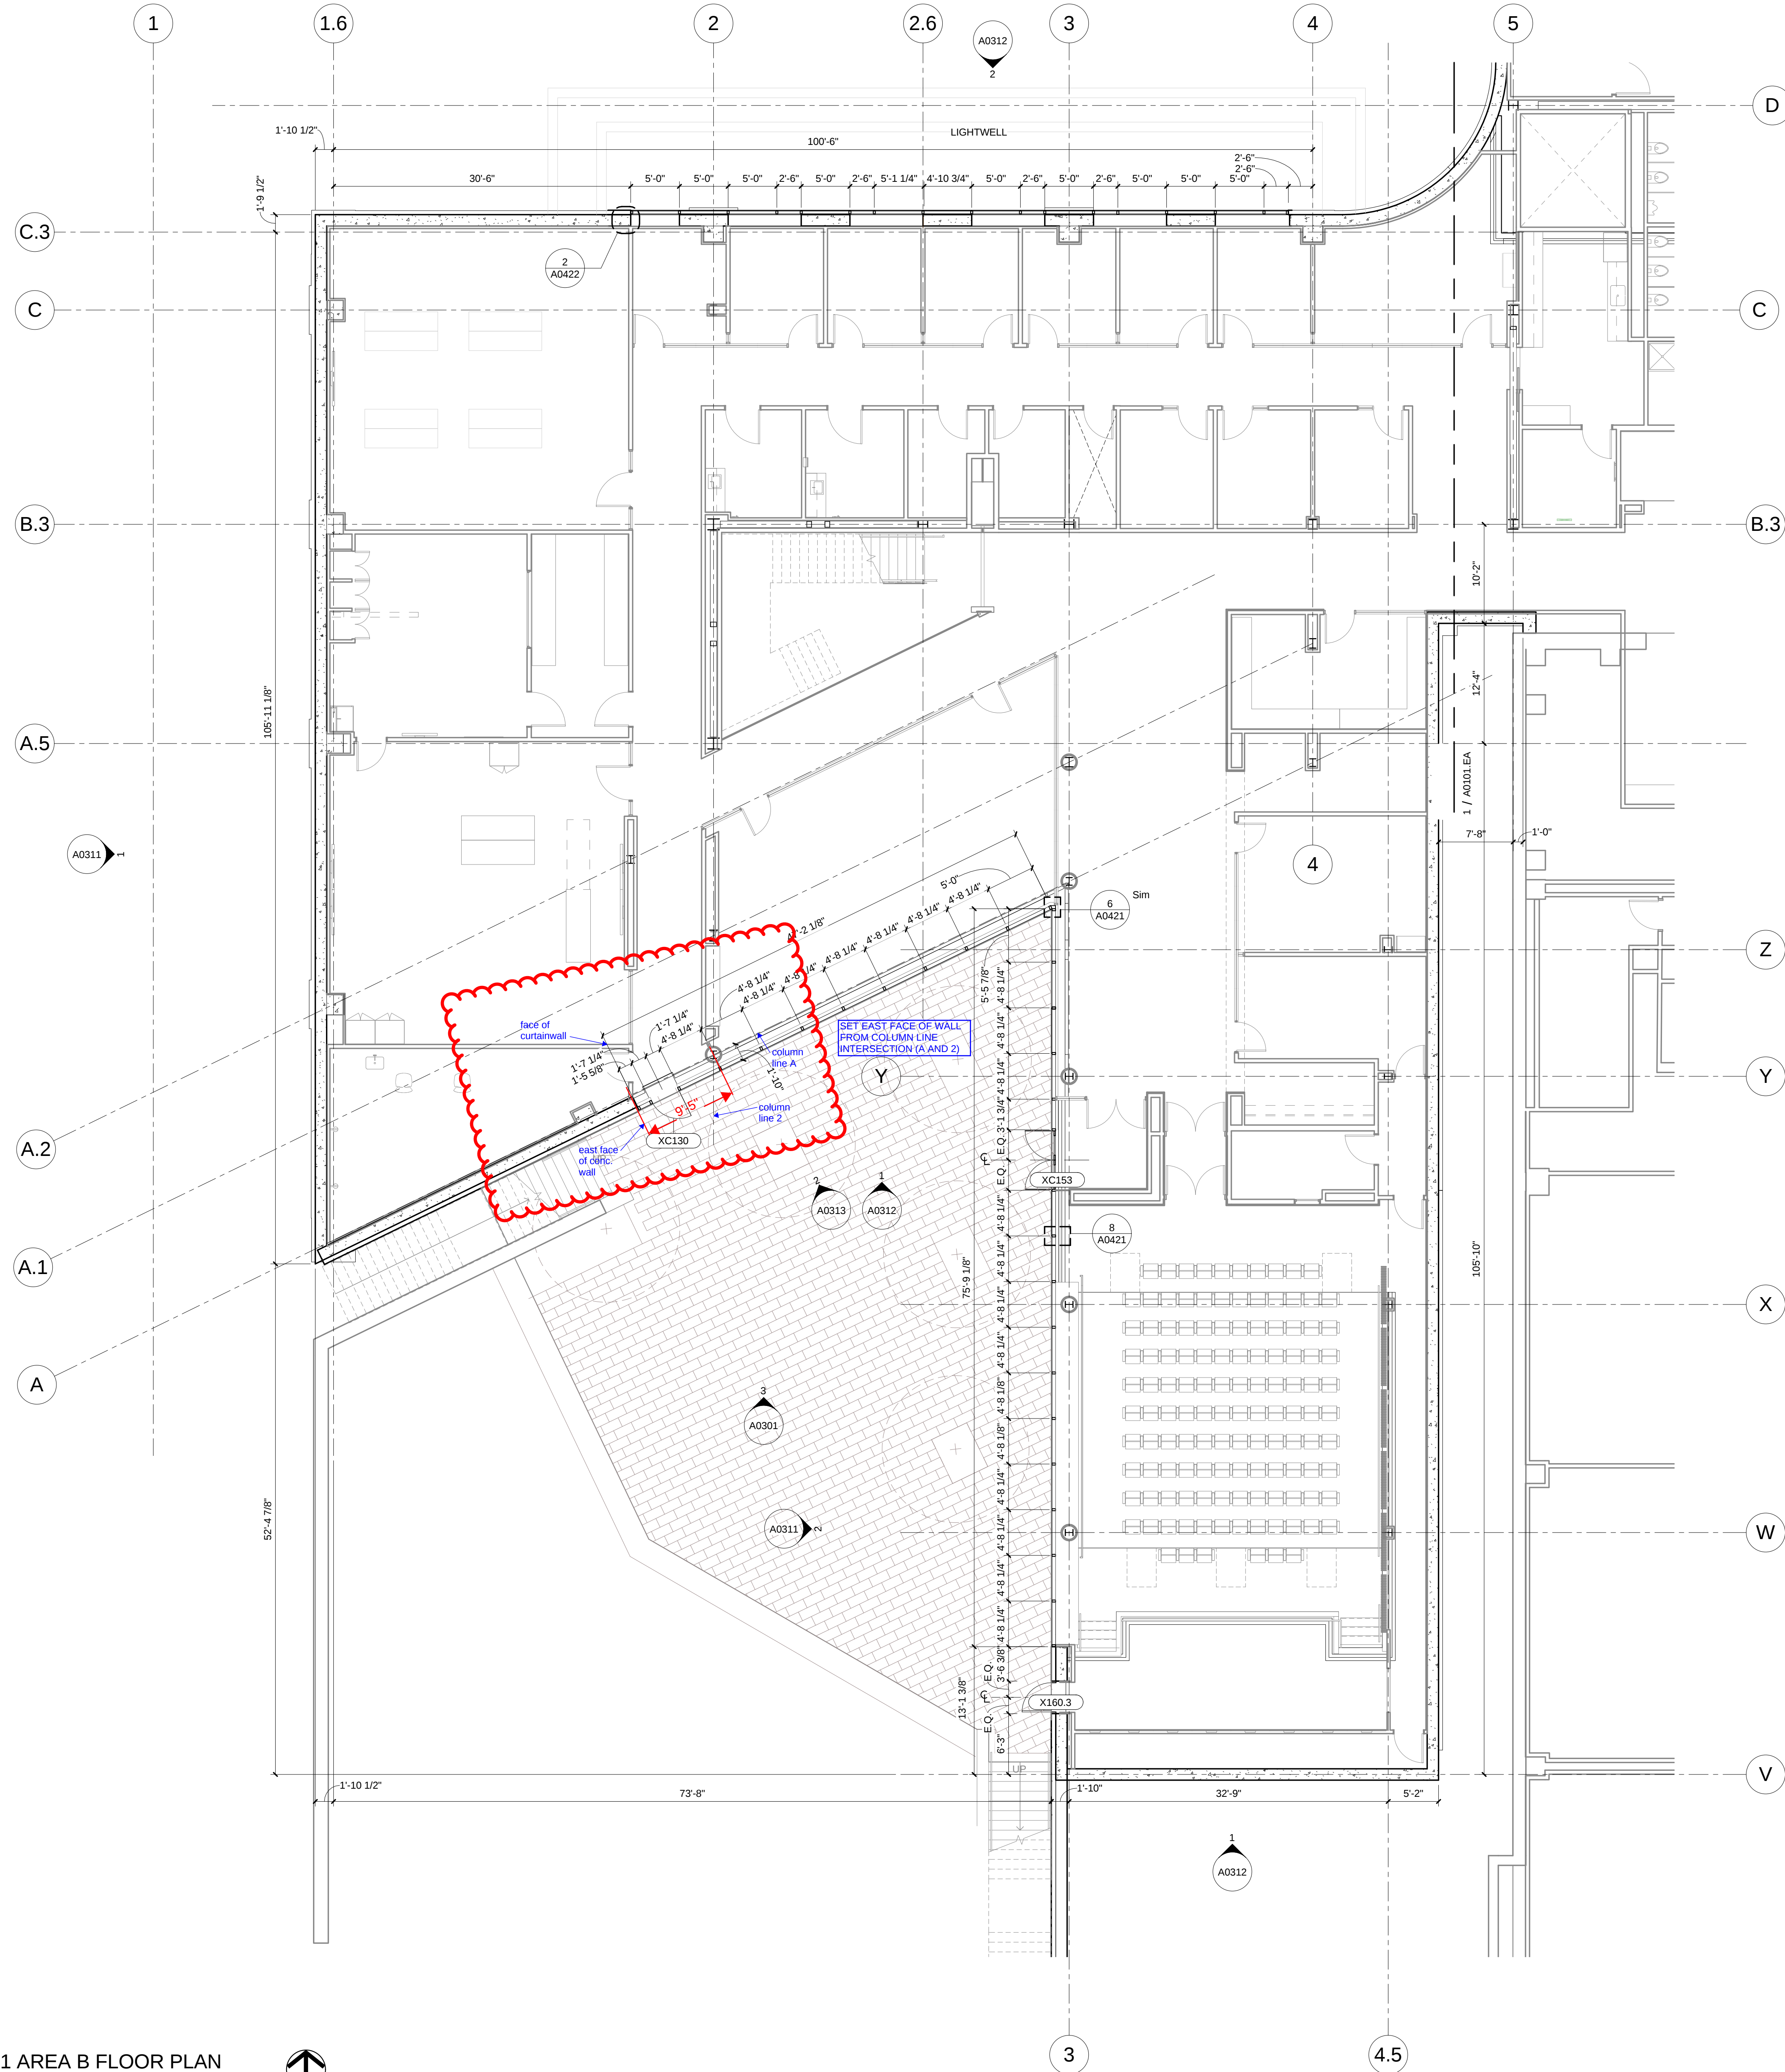

1 LEVEL 01 AREA B FLOOR PLAN  
1/8" = 1'-0"

