



PARIC CORPORATION
77 Westport Plaza Suite 250
St. Louis, MO 63146
TEL: 636-561-9500
FAX: 636-561-9501

REQUEST FOR INFORMATION	DATE: July 08, 2016	NO.: RFI-195
--------------------------------	----------------------------	---------------------

To: Cannon Design

Attn: Kelvin Patel

From: Paric Corporation

Requested By: Devin Gates

Project Name: 15051-Webster University Interdisciplinary Science Building	Project No.: 15051
---	--------------------

Subject: Added gusset plates

Response Required By: July 15, 2016

Drawing / Spec Reference:

Information Requested:

RFI 135 stated that "at roofs, detail 7/S0302 is missing the linework for the exterior gussets (as are 4/S0302, 4&15&22/S0303, and 13/S0304). Typical roof edge details are to follow 5&6/S0303."

Please provide revised contract documents showing these changes so that the documents may be interpreted correctly.

Response:

Attached revisions - formal document submission at future date.
4 & 7 / S0302 and 4 & 22 / S0303 included
15/S0303 is located at high roof and is unchanged.
13/S0304 refers to 7/S0302 and therefore is not included.
17/S0303 stiffener spacing reduced from 24"o.c to 48"o.c.


ARCHITECT'S RESPONSE:

This information is provided as an interpretation of the Contract Documents for implementation. It is not an authorization for change to the Contract Sum or Contract Time. If this information results in a claim for a change to the Contract, the Contractor shall notify the [Construction Manager][Architect] of a change through the change process.


Answered By: JILL WALKER / DMA

Date: 7/11/2016


© Cannon Design 2015
All rights reserved. No part of this document may be reproduced or transmitted in any form without written authorization by The Cannon Corporation.
5/12/2016 4:52:08 PM

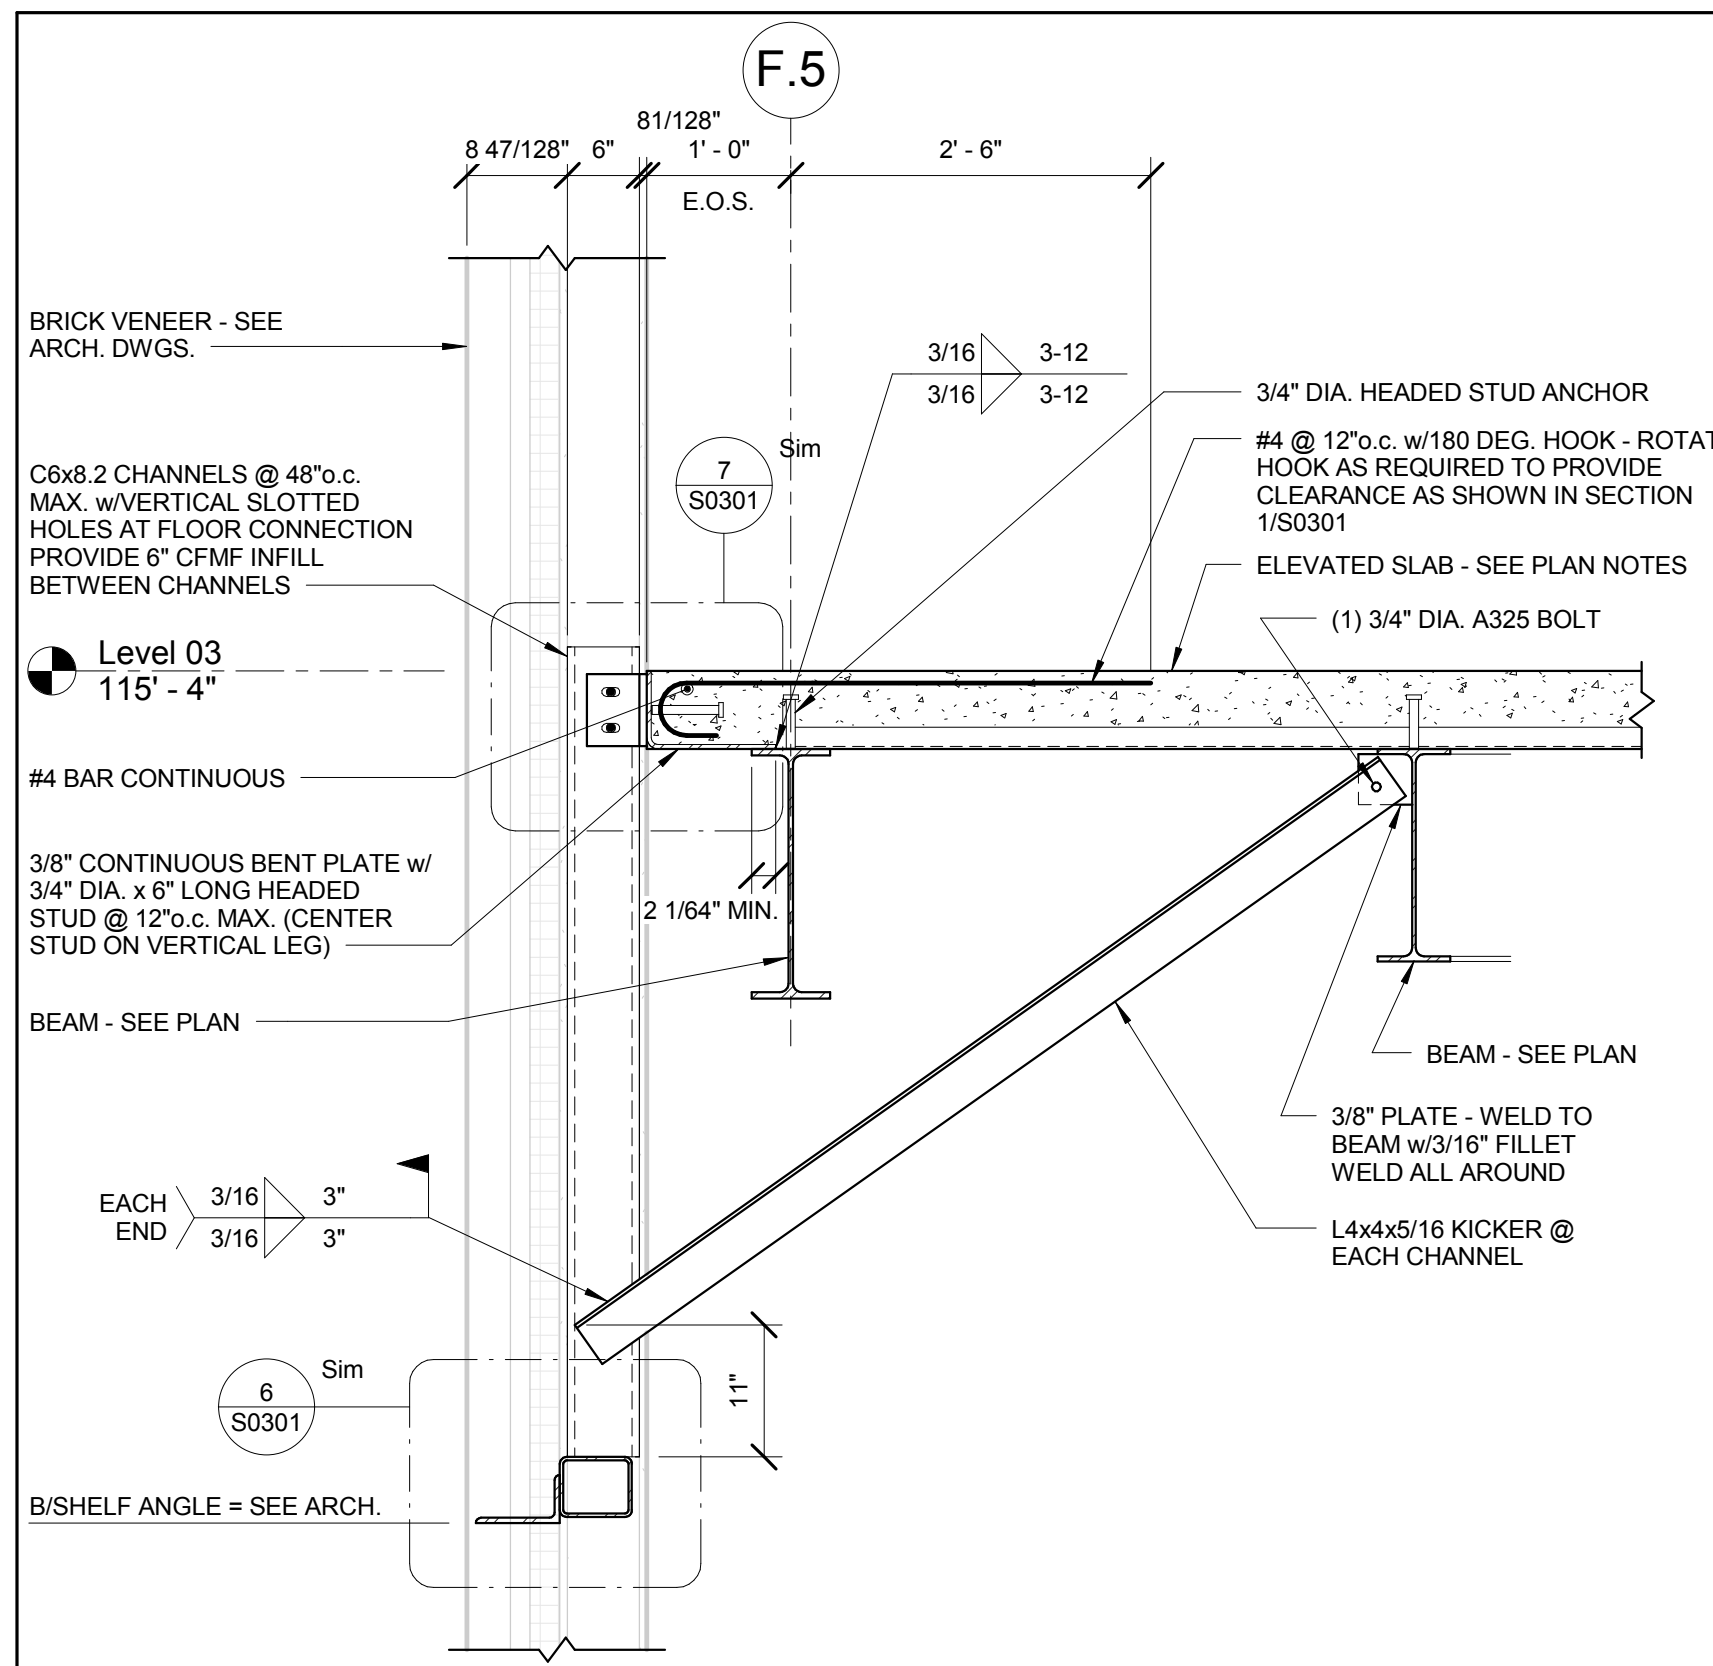


1 FRAMING SECTION
3/4" = 1'-0"

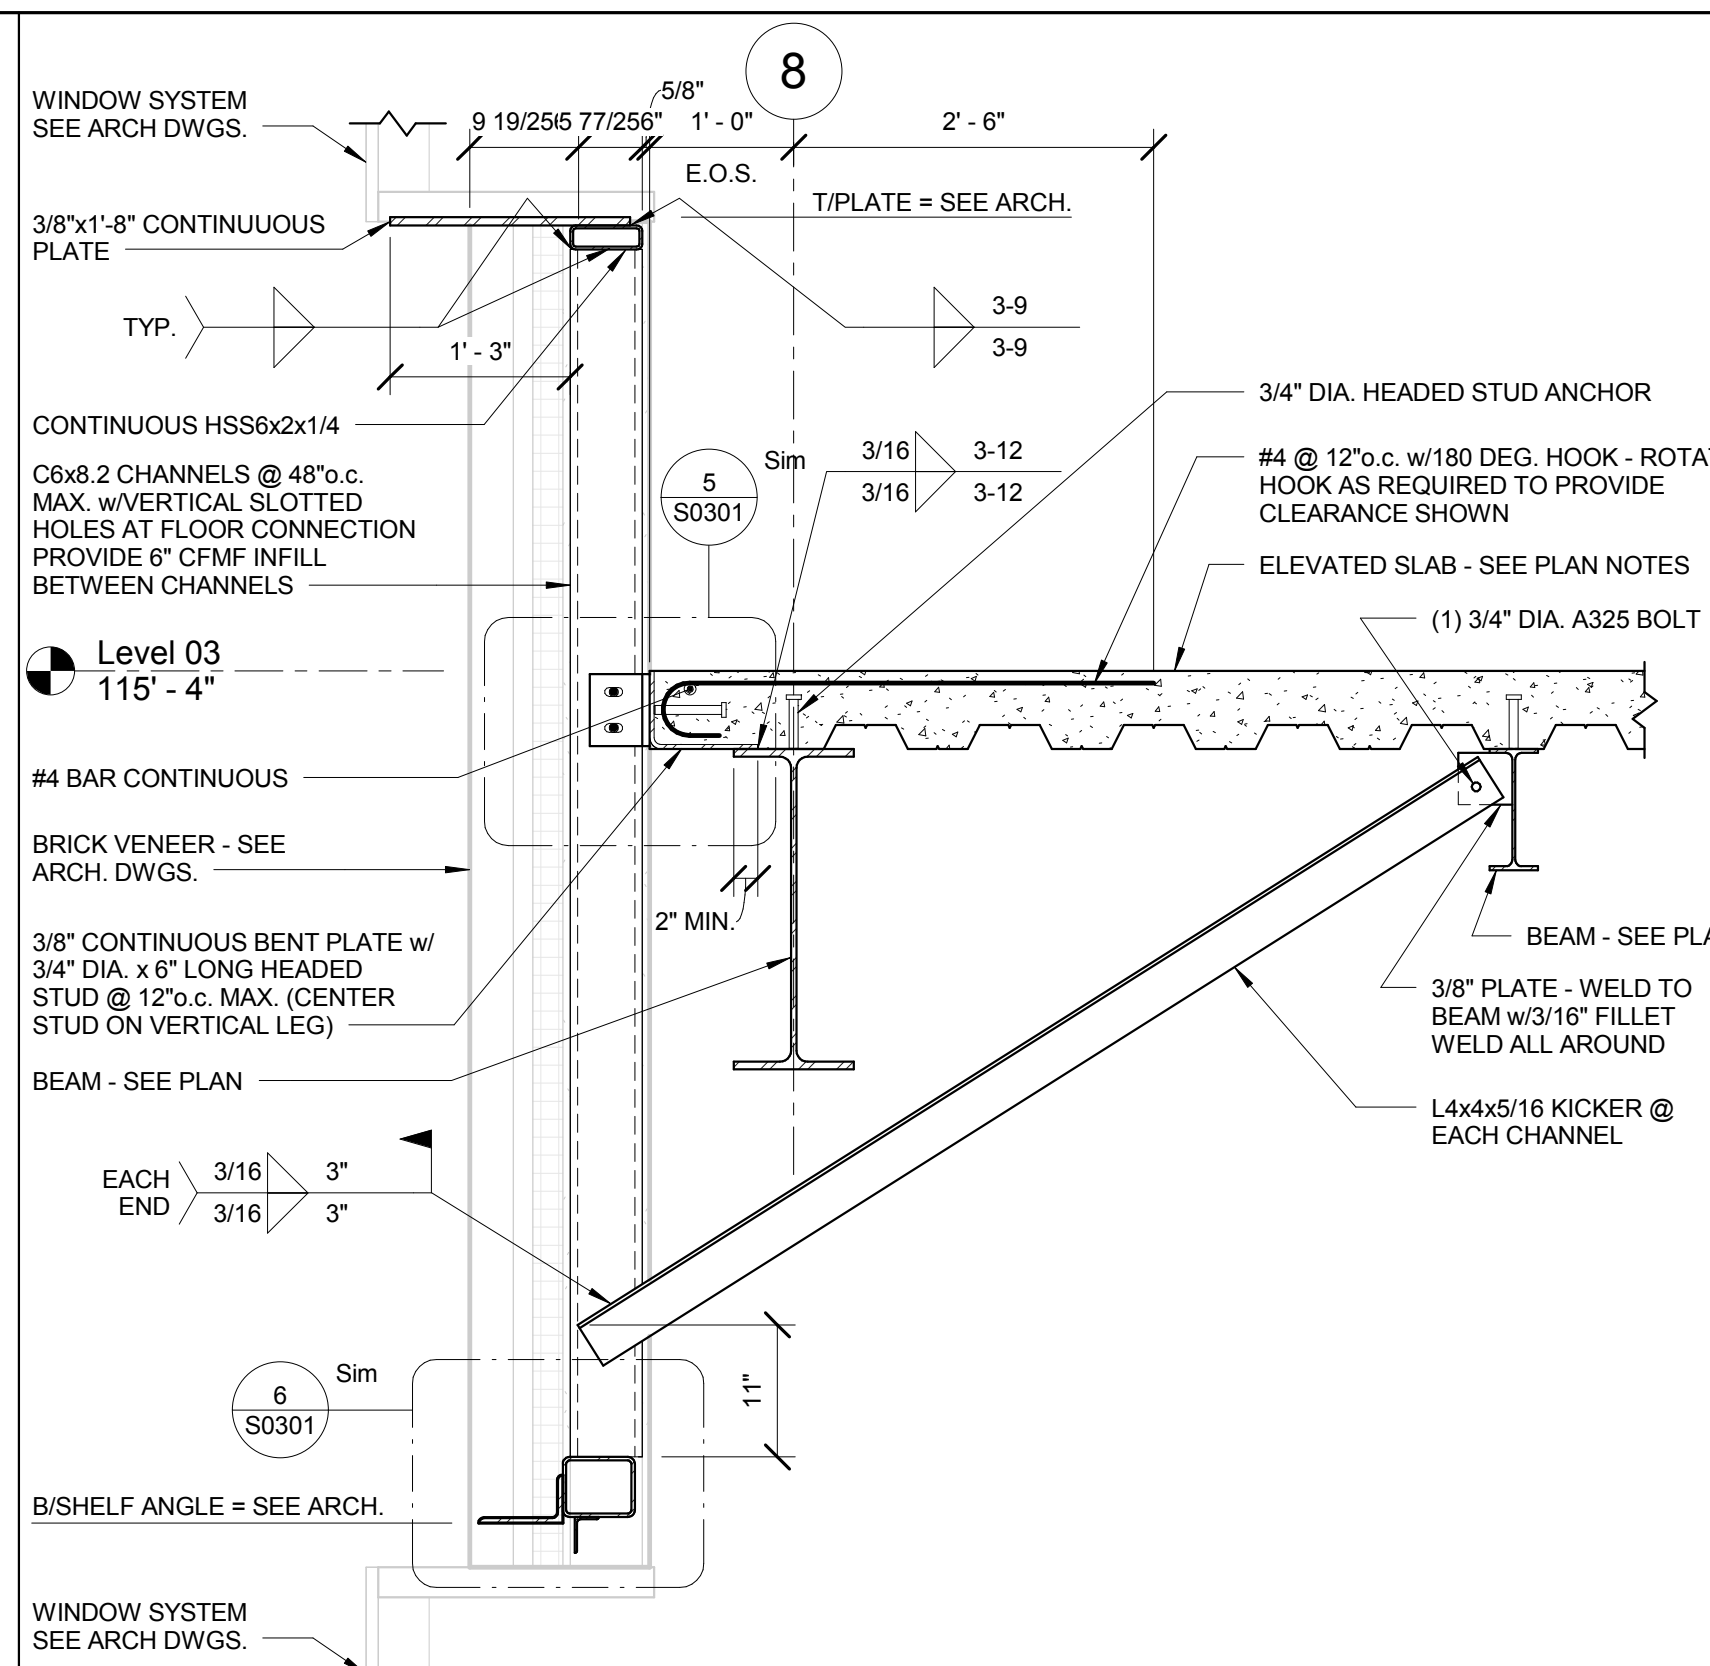


2 FRAMING SECTION
3/4" = 1'-0"

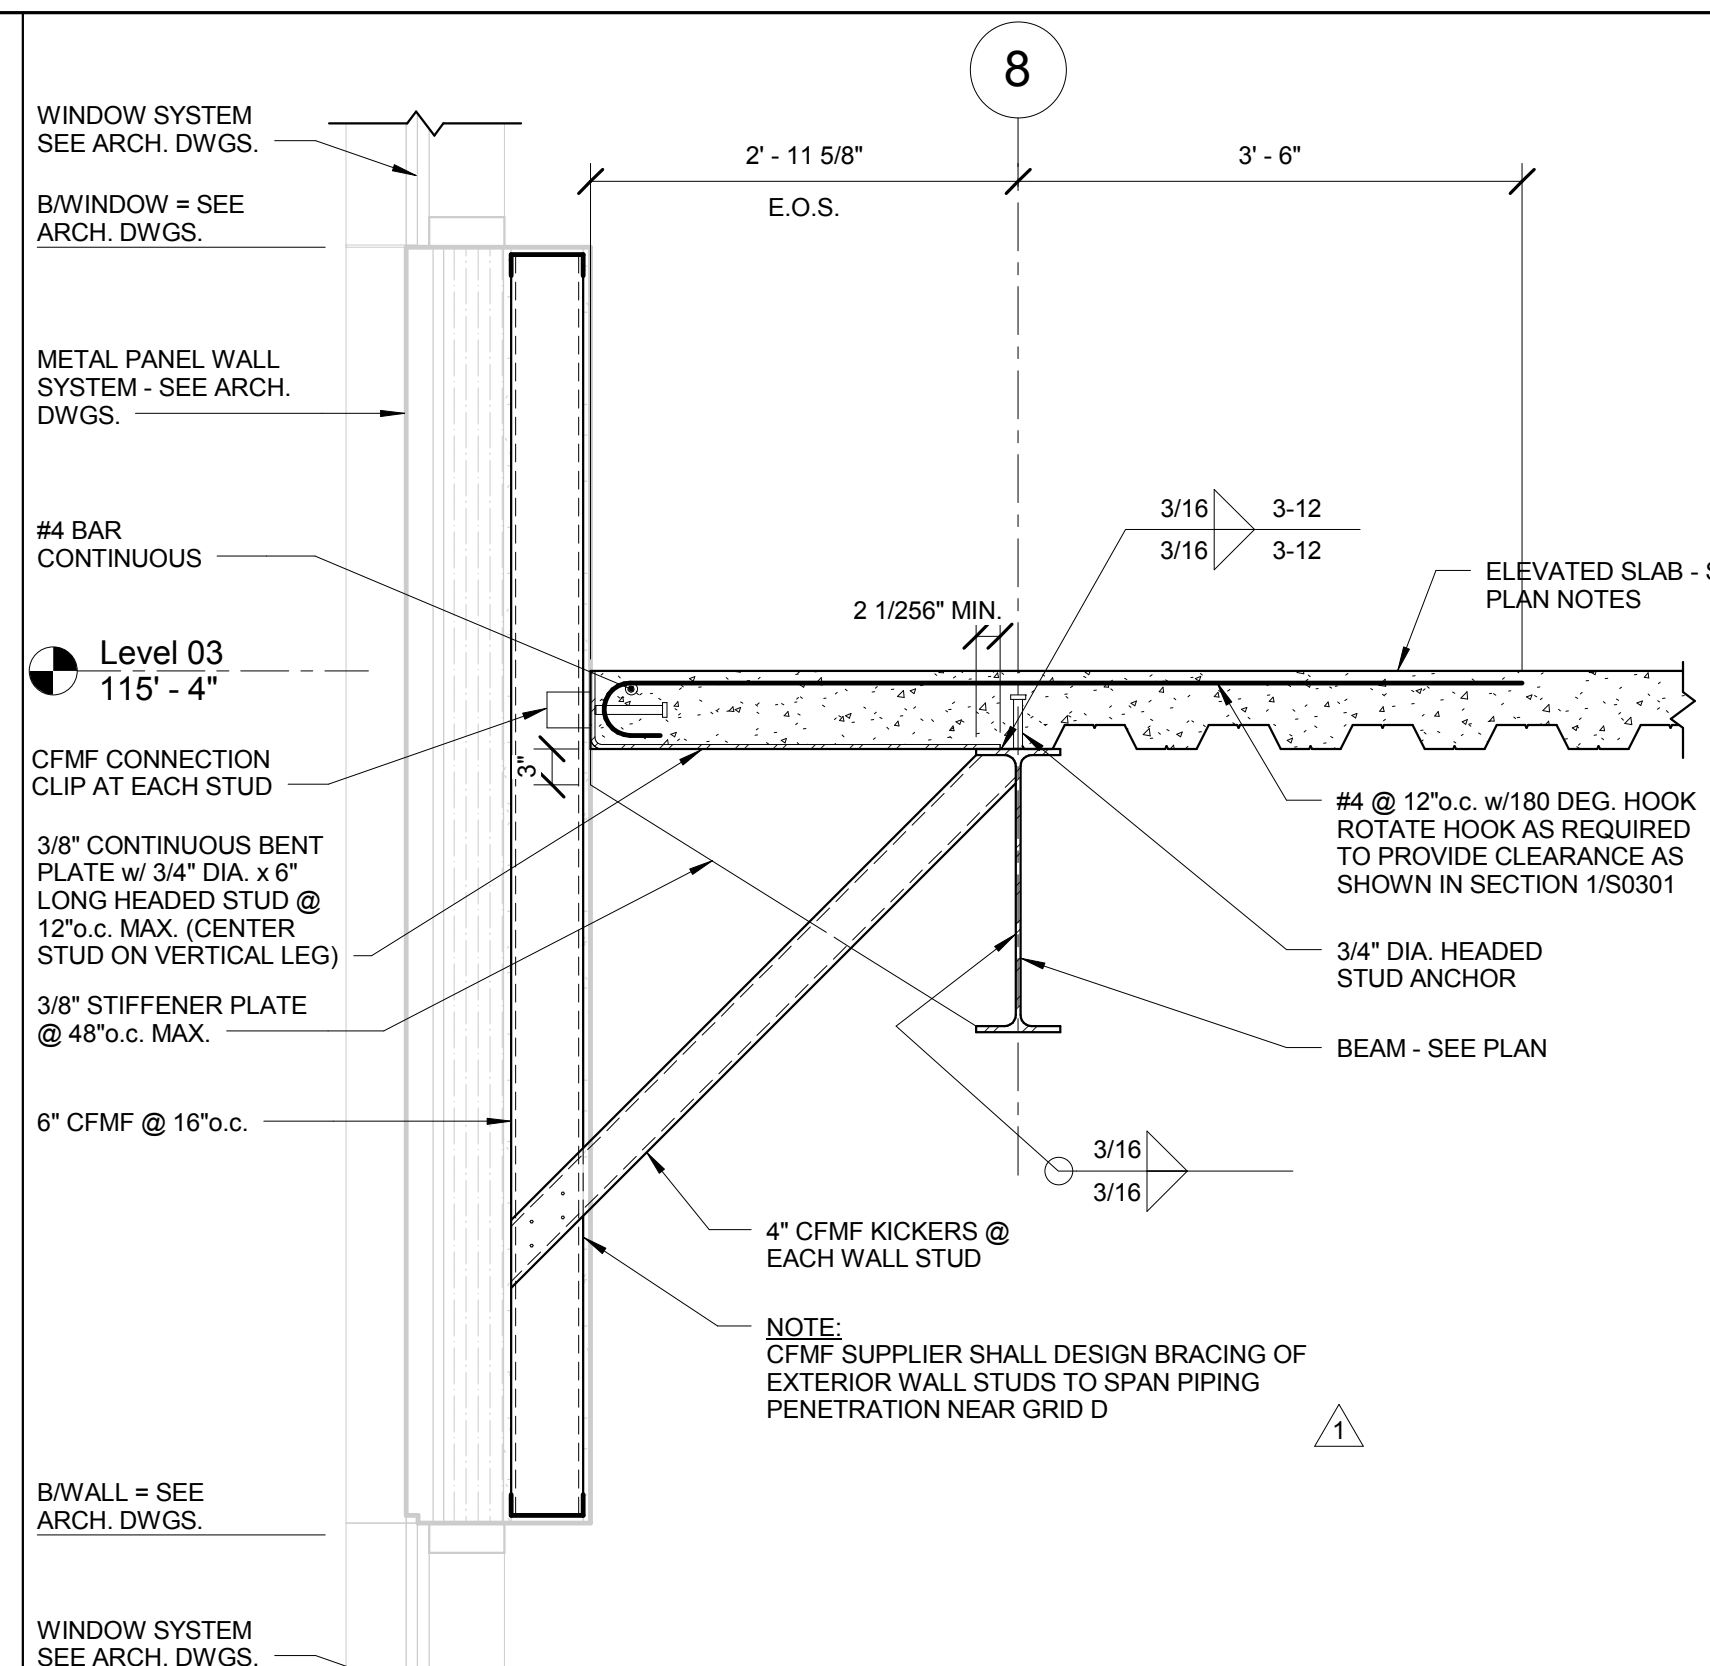


3 FRAMING SECTION
3/4" = 1'-0"

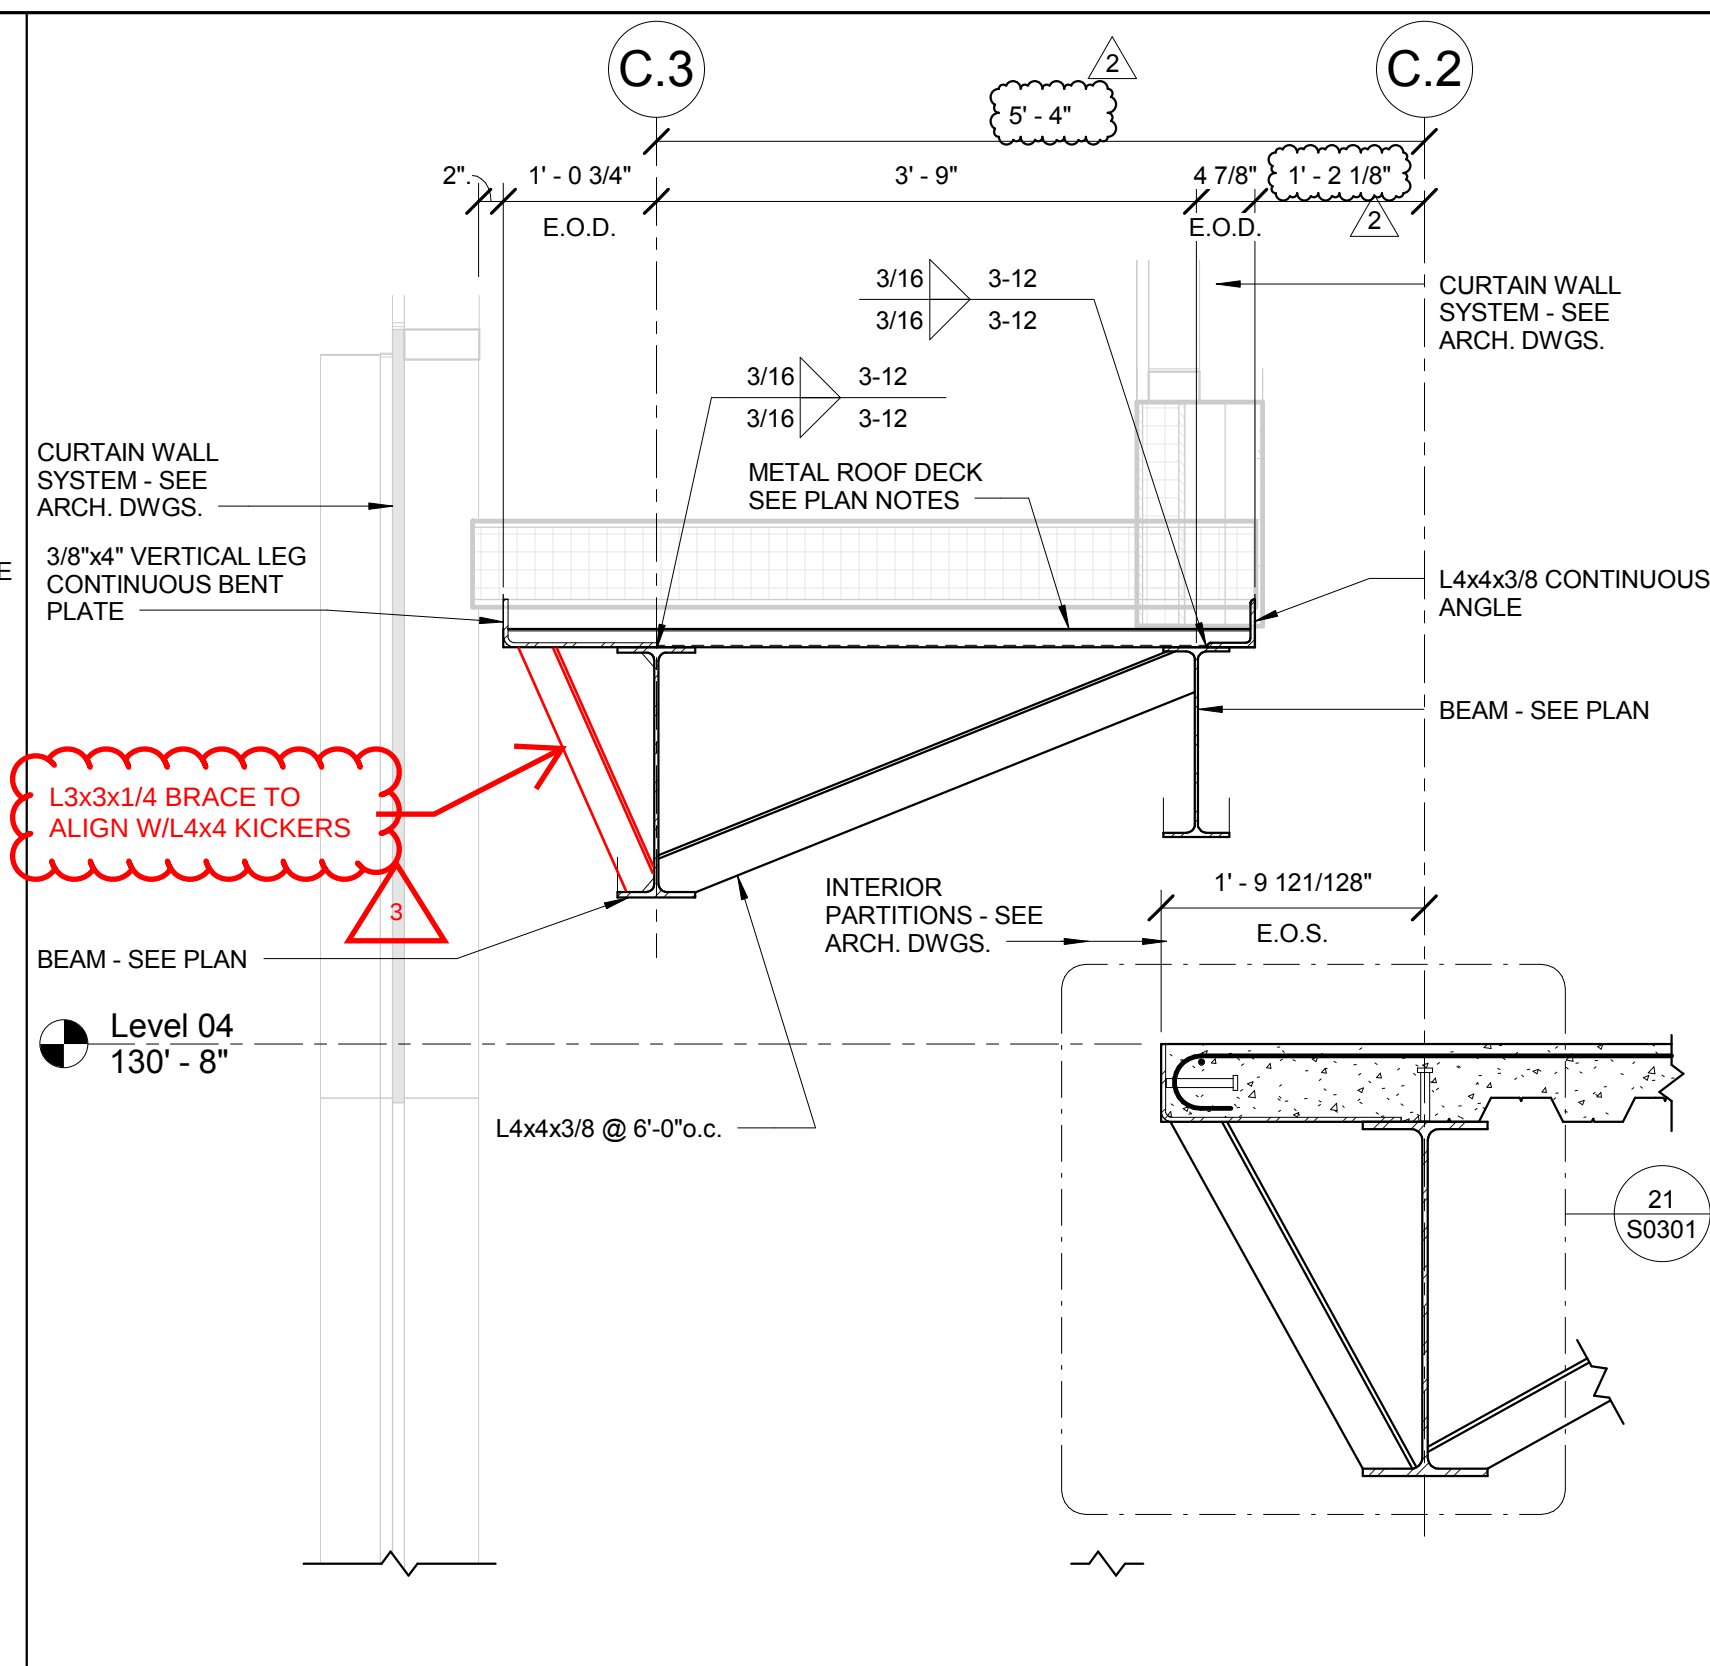


4 FRAMING SECTION
3/4" = 1'-0"

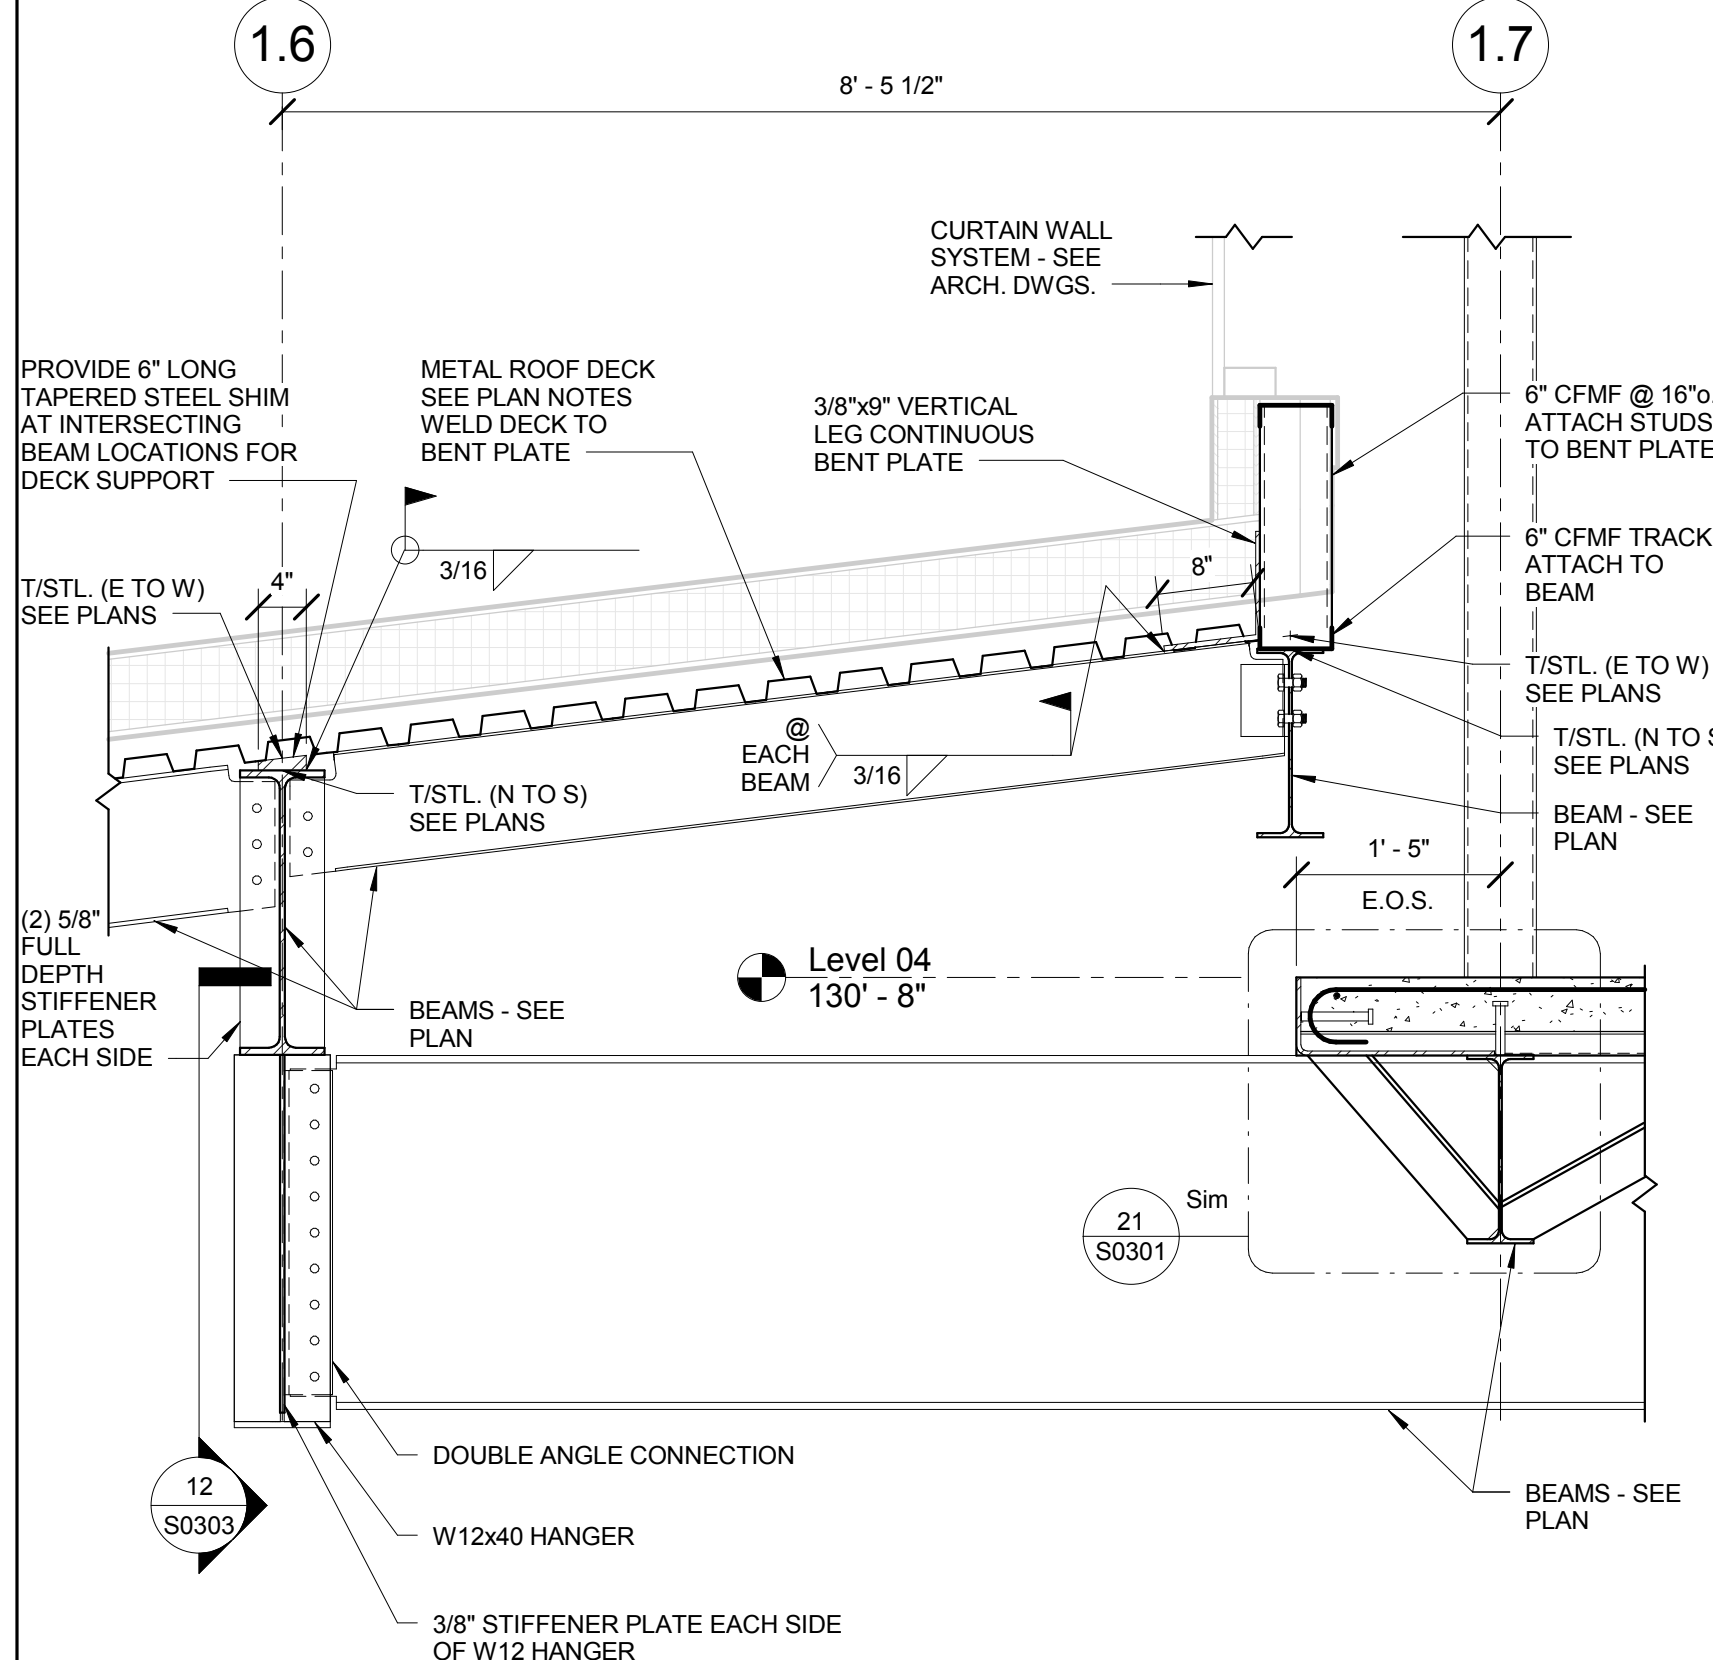


5 FRAMING SECTION
3/4" = 1'-0"

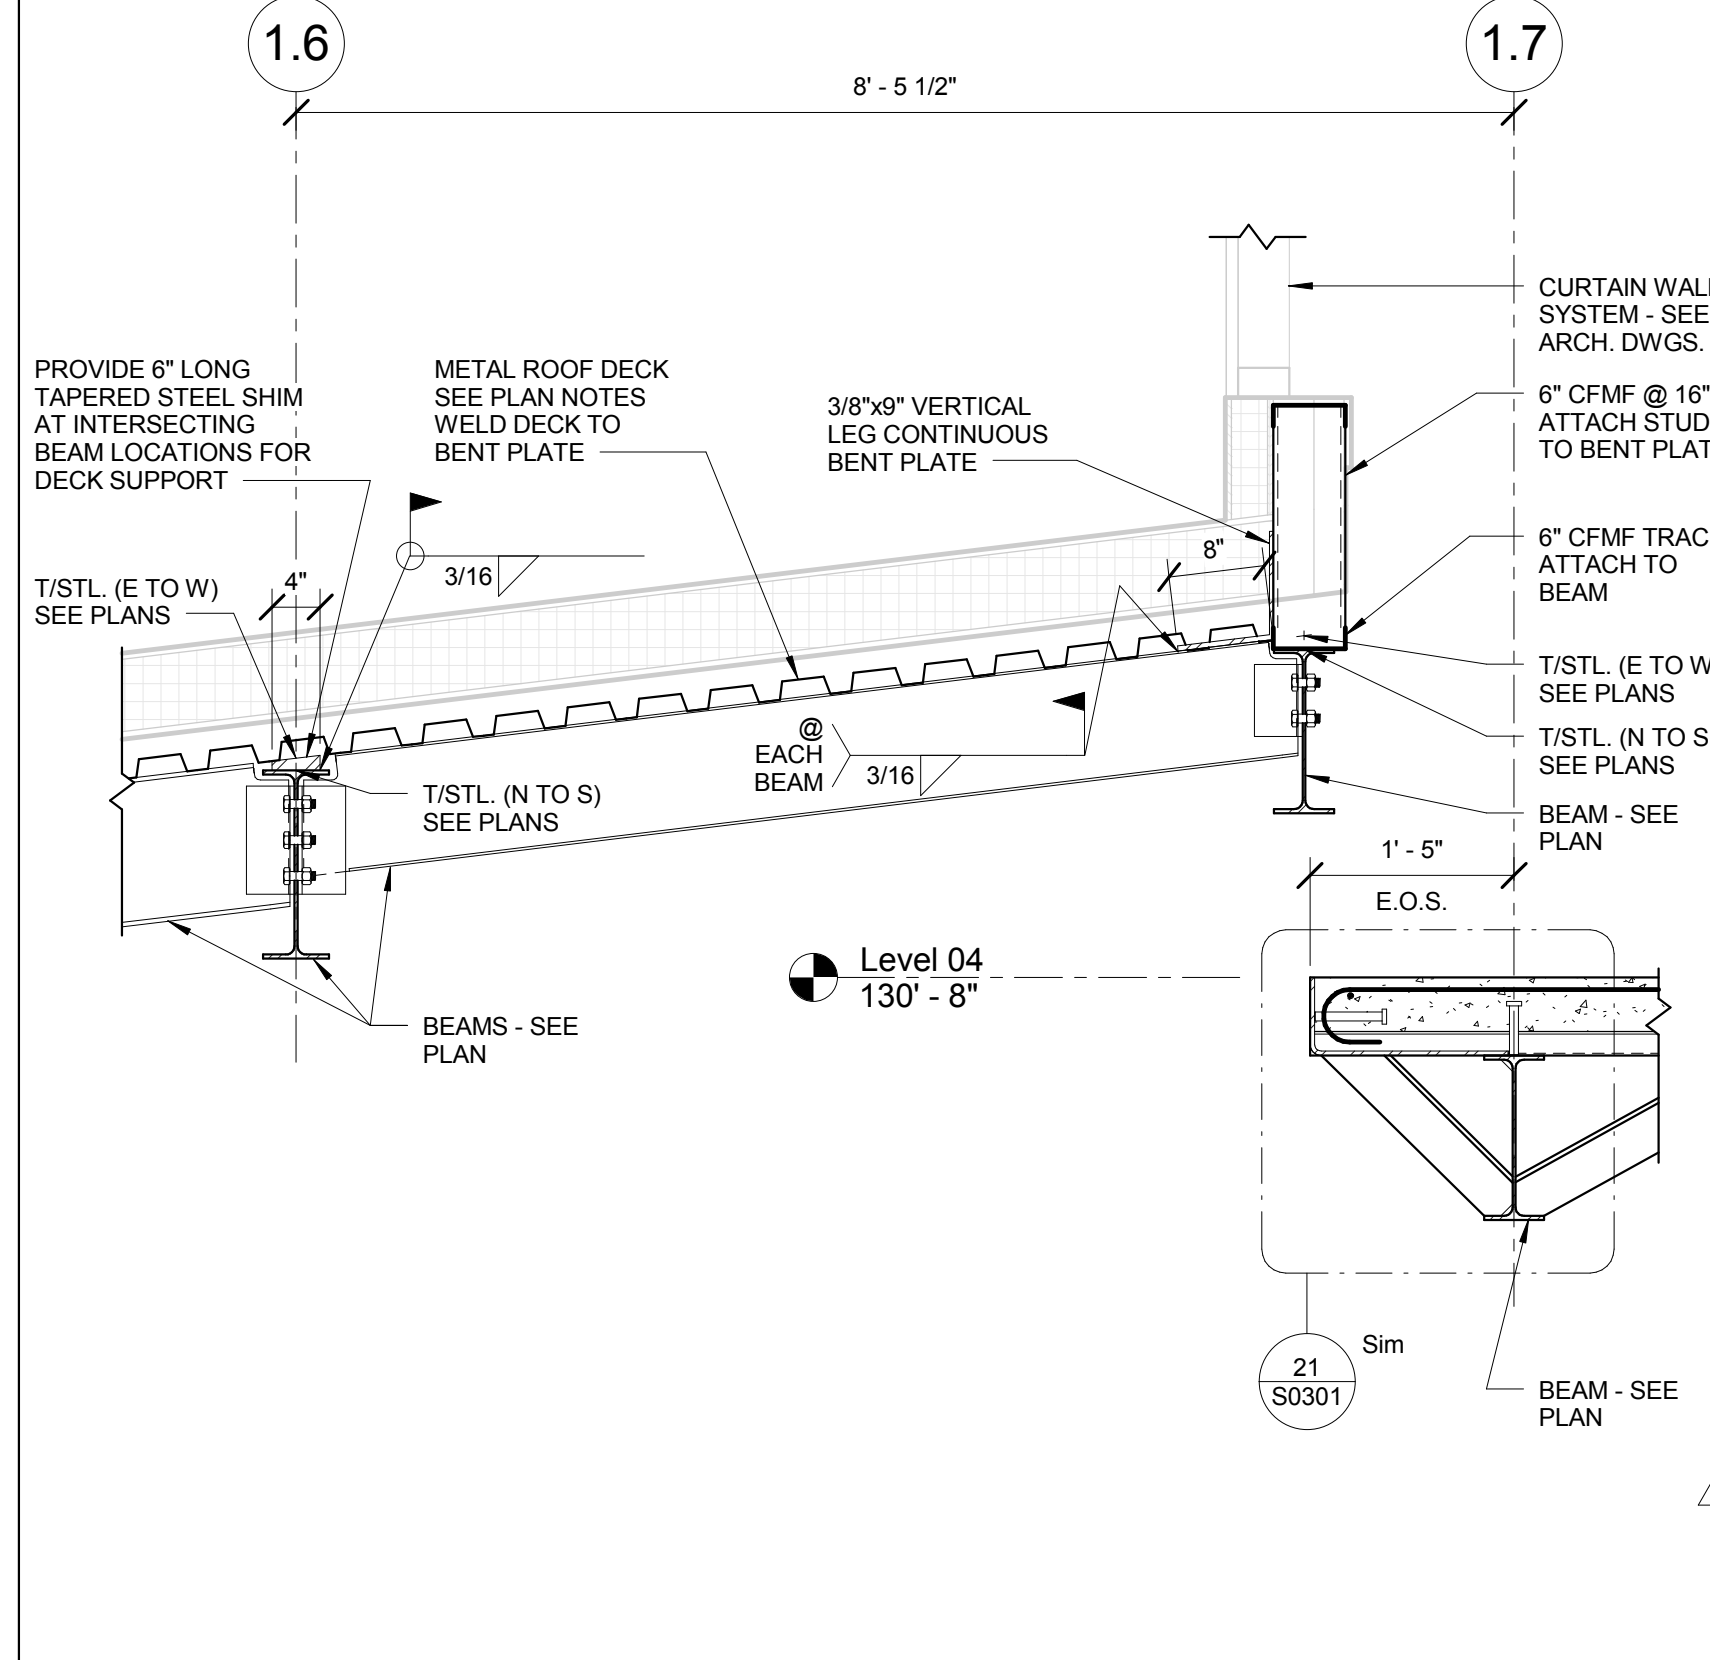


6 FRAMING SECTION
3/4" = 1'-0"

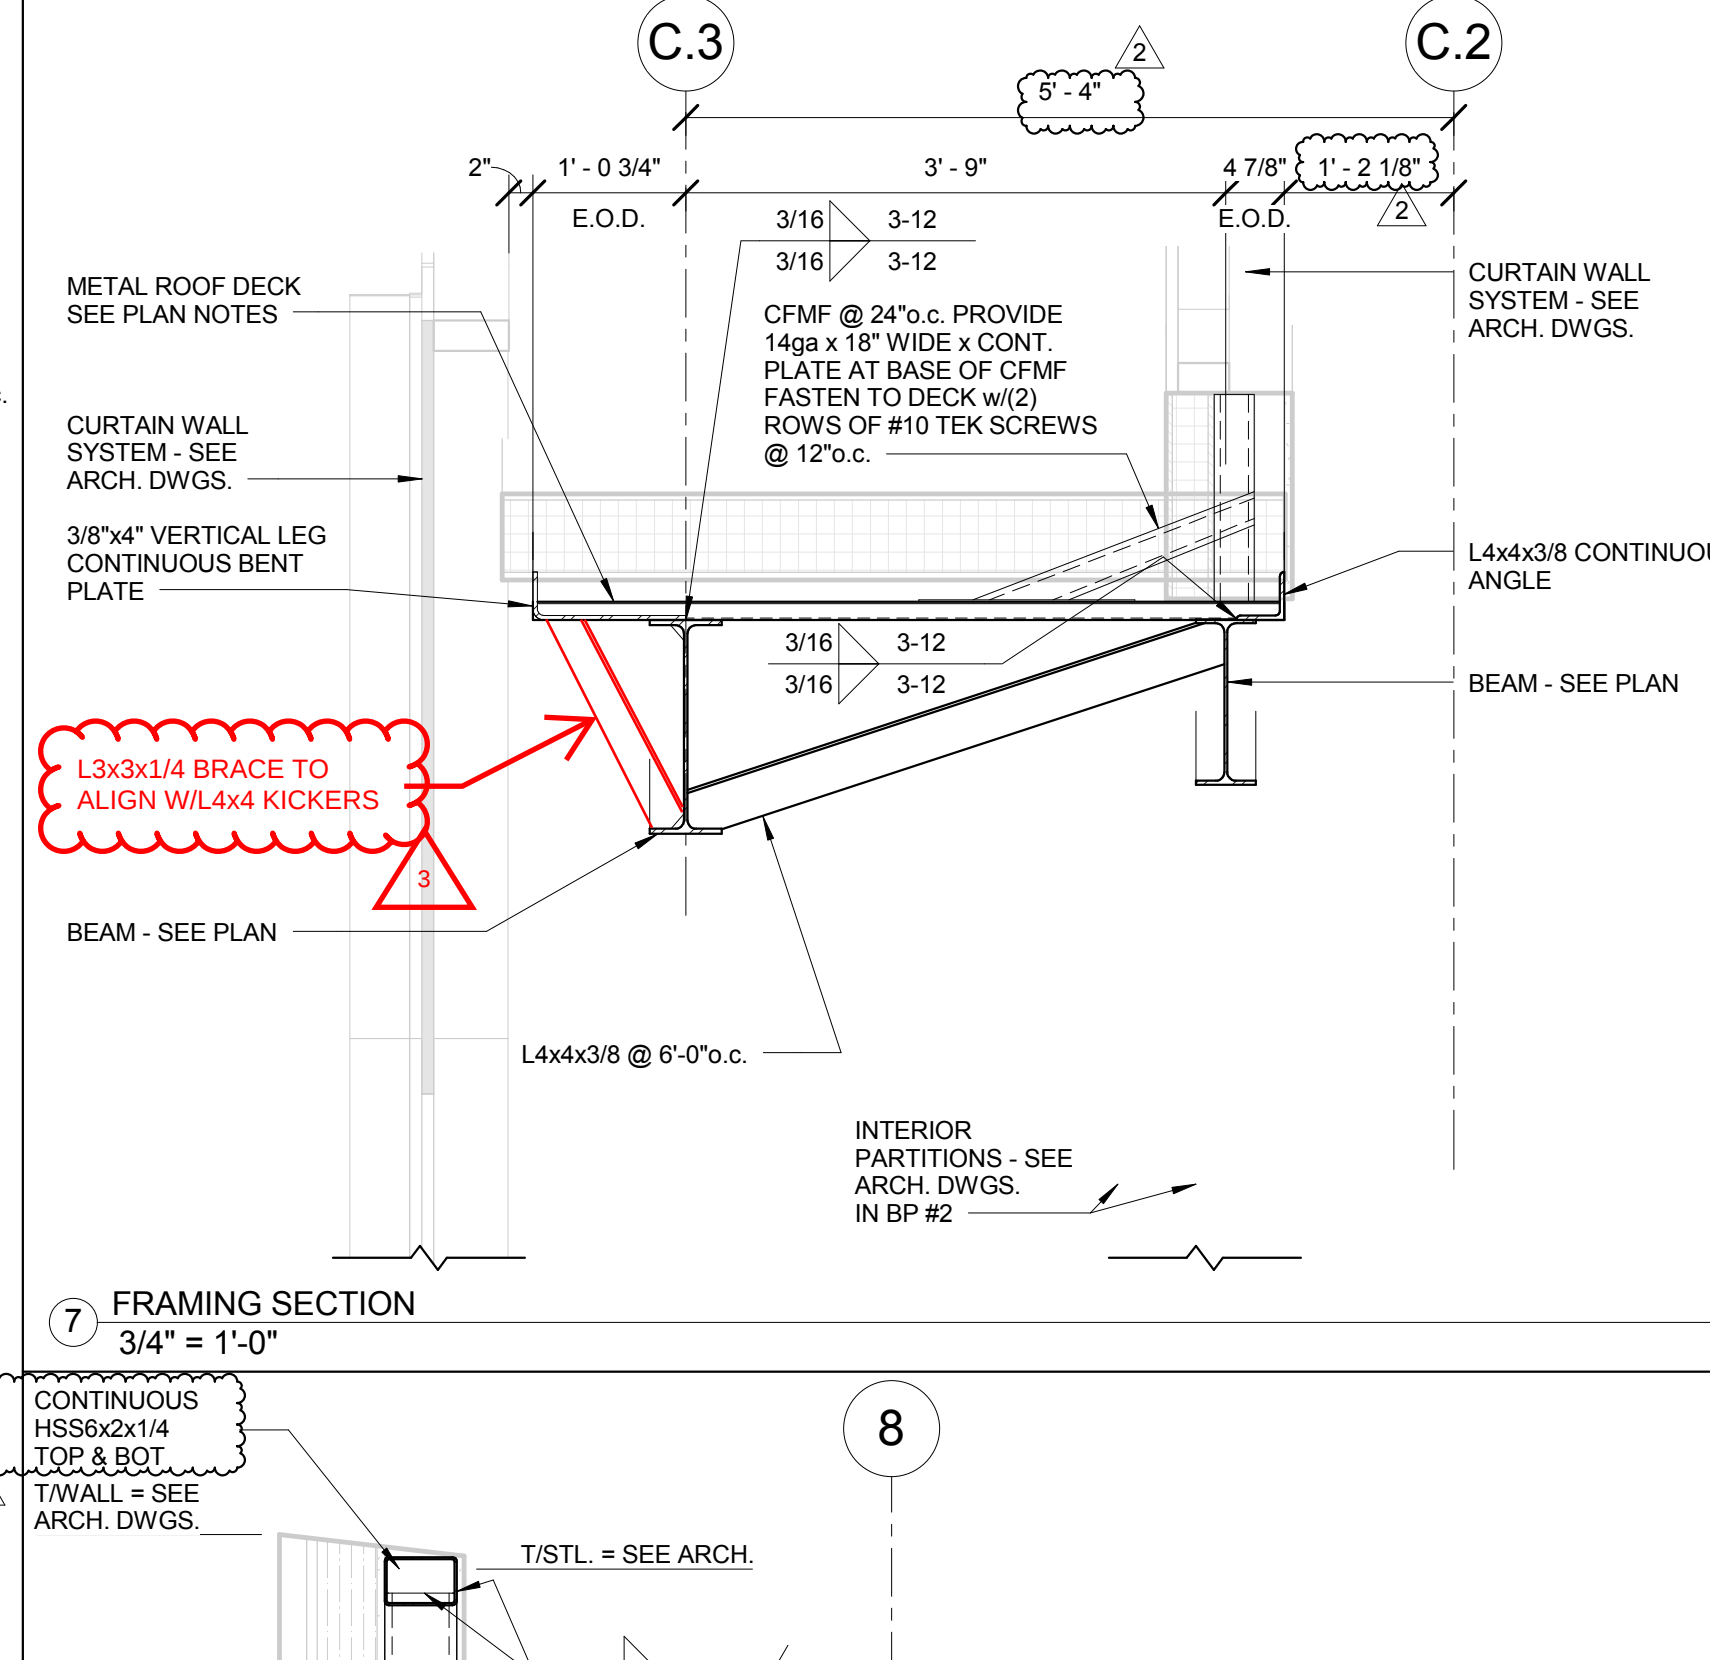


7 FRAMING SECTION
3/4" = 1'-0"

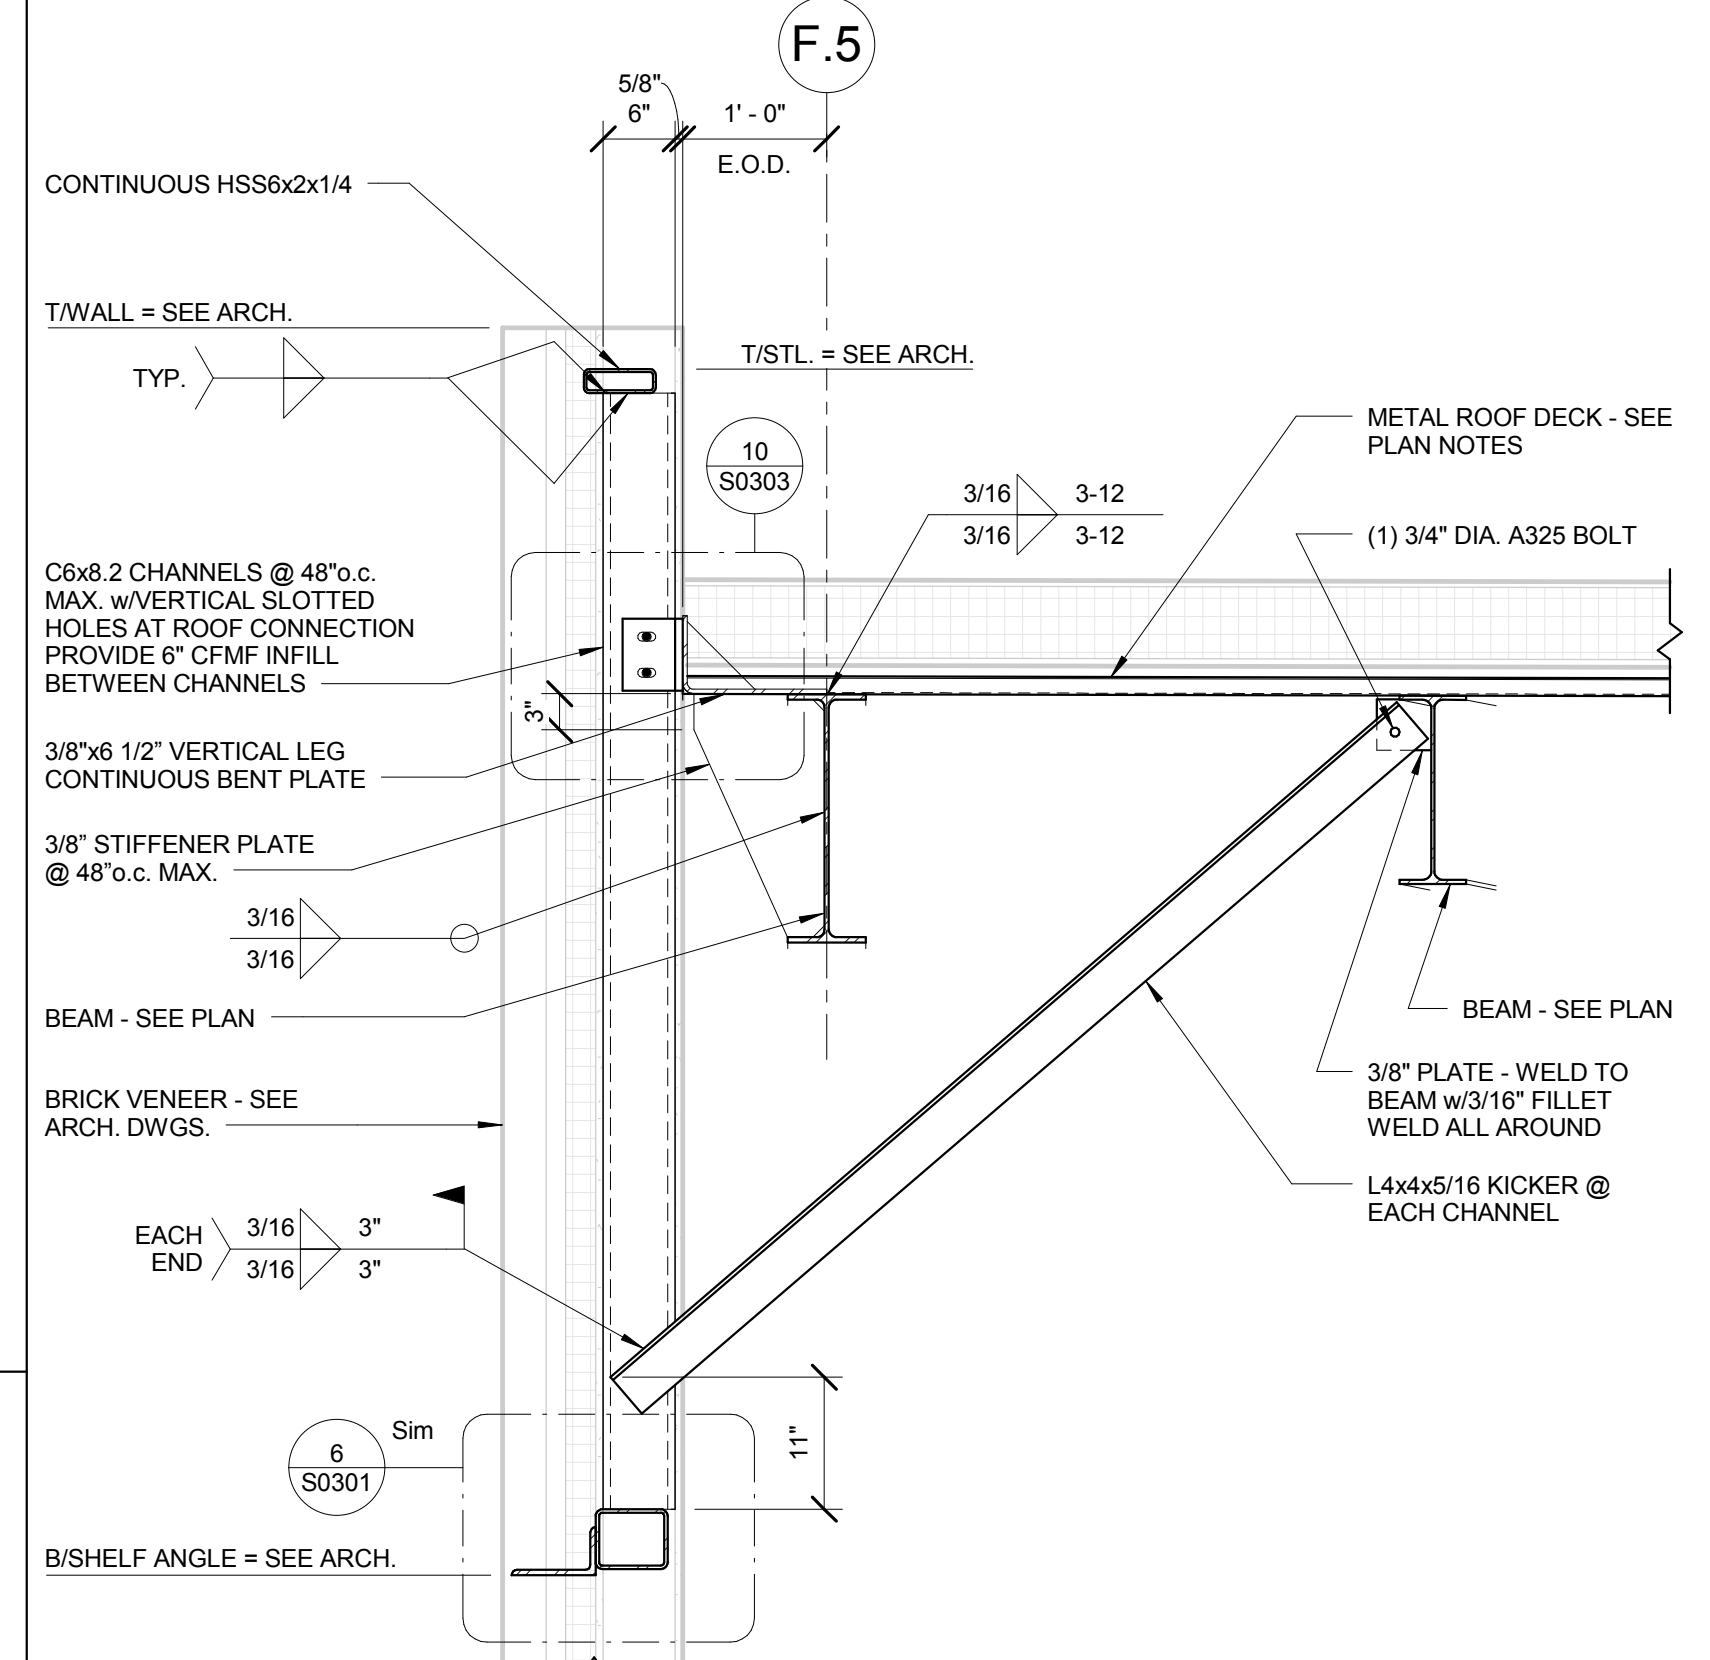


8 FRAMING SECTION
3/4" = 1'-0"

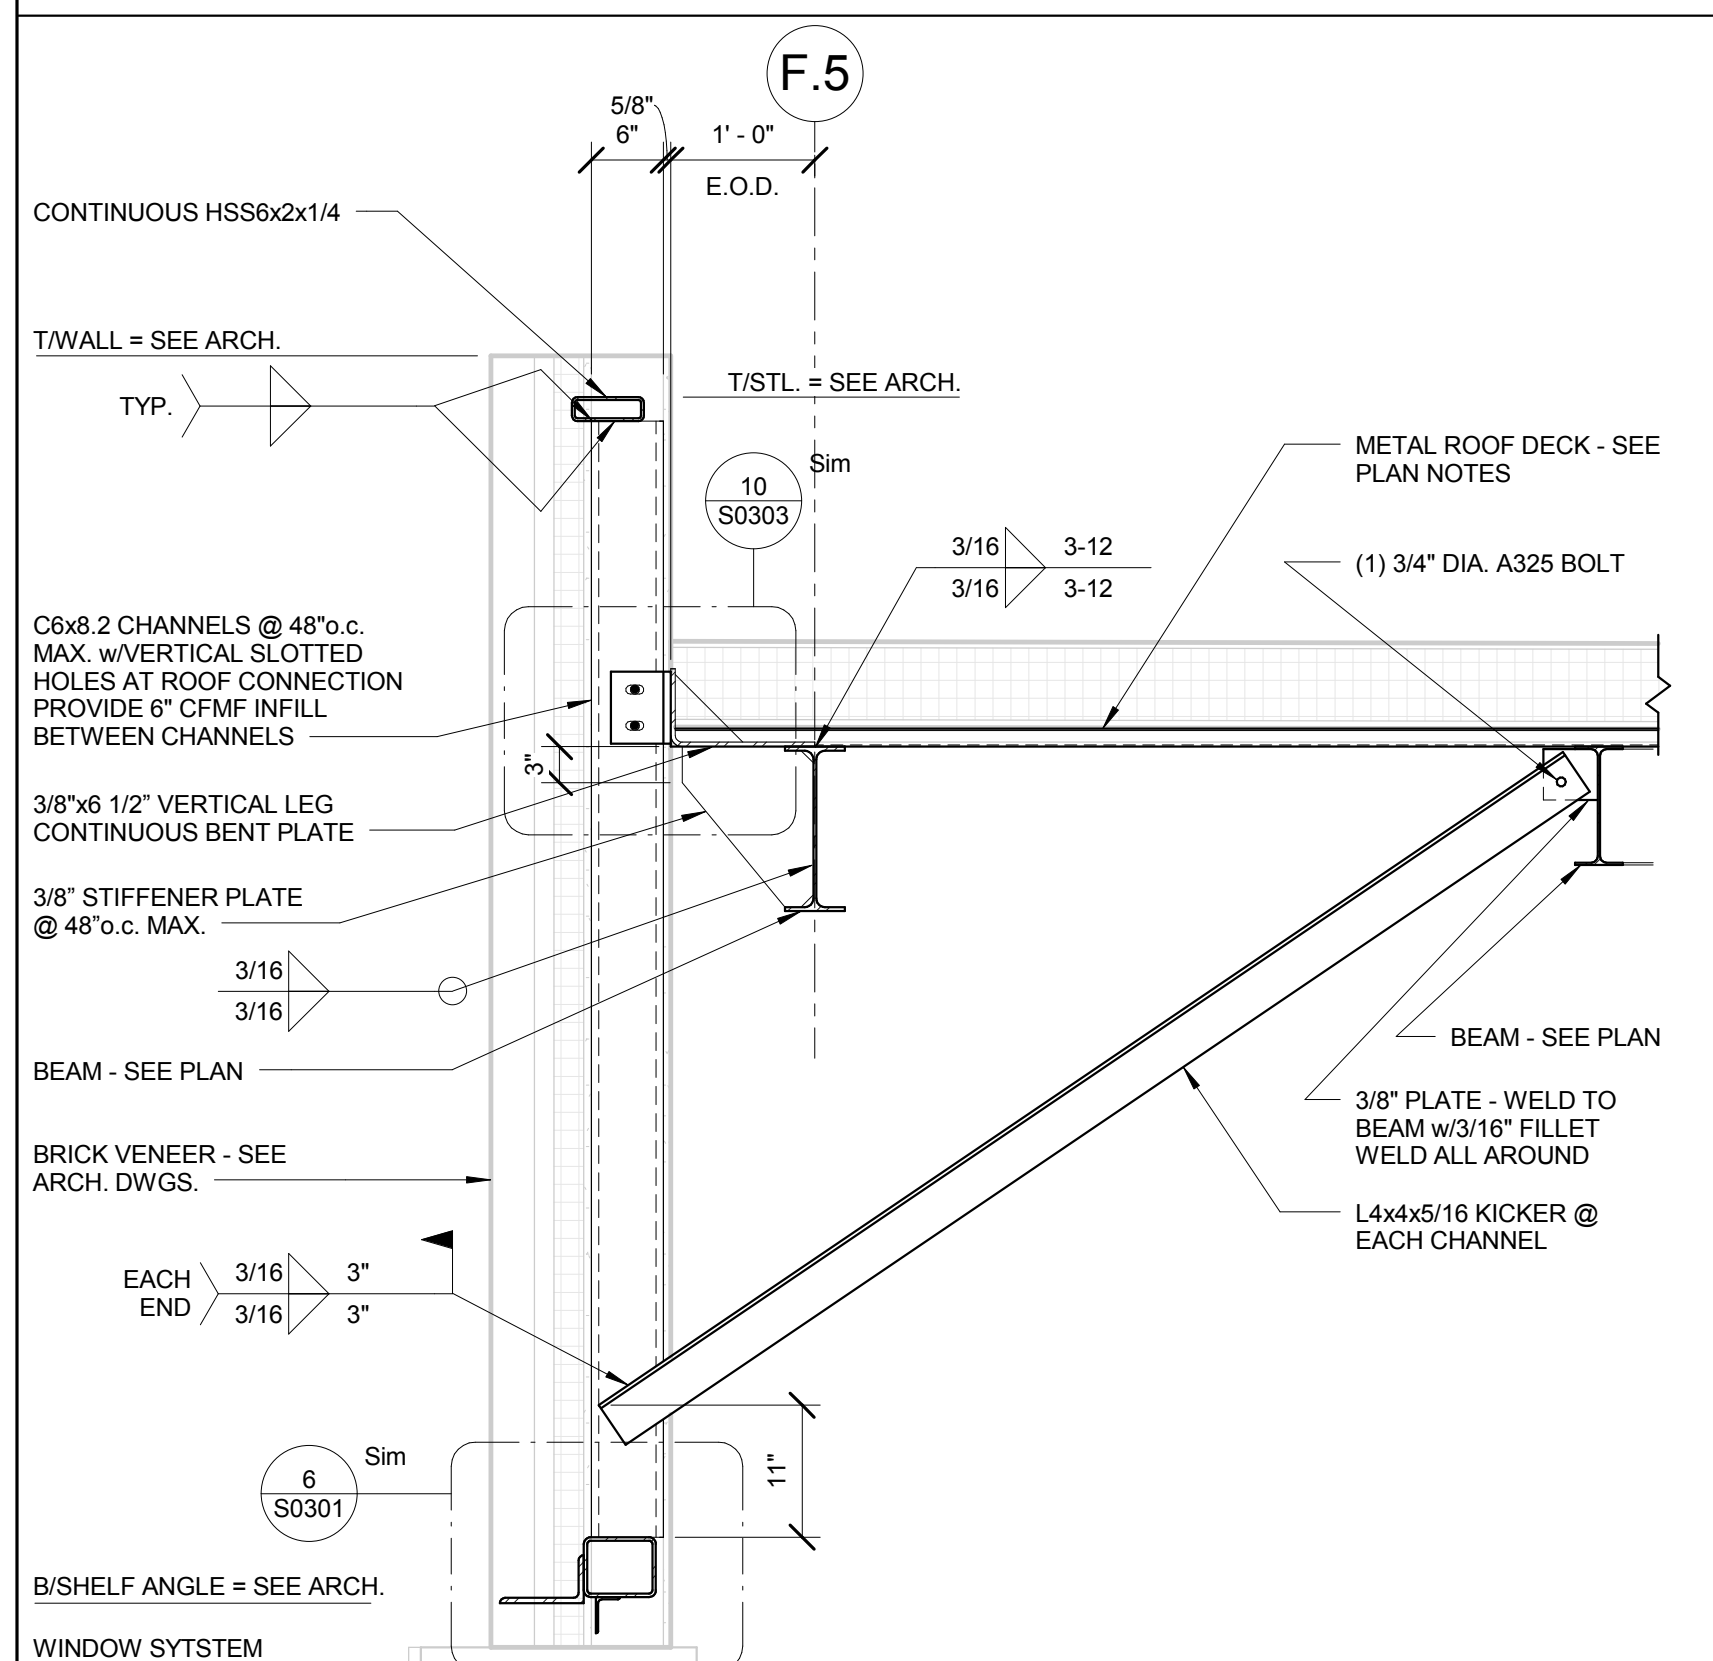


9 FRAMING SECTION
3/4" = 1'-0"

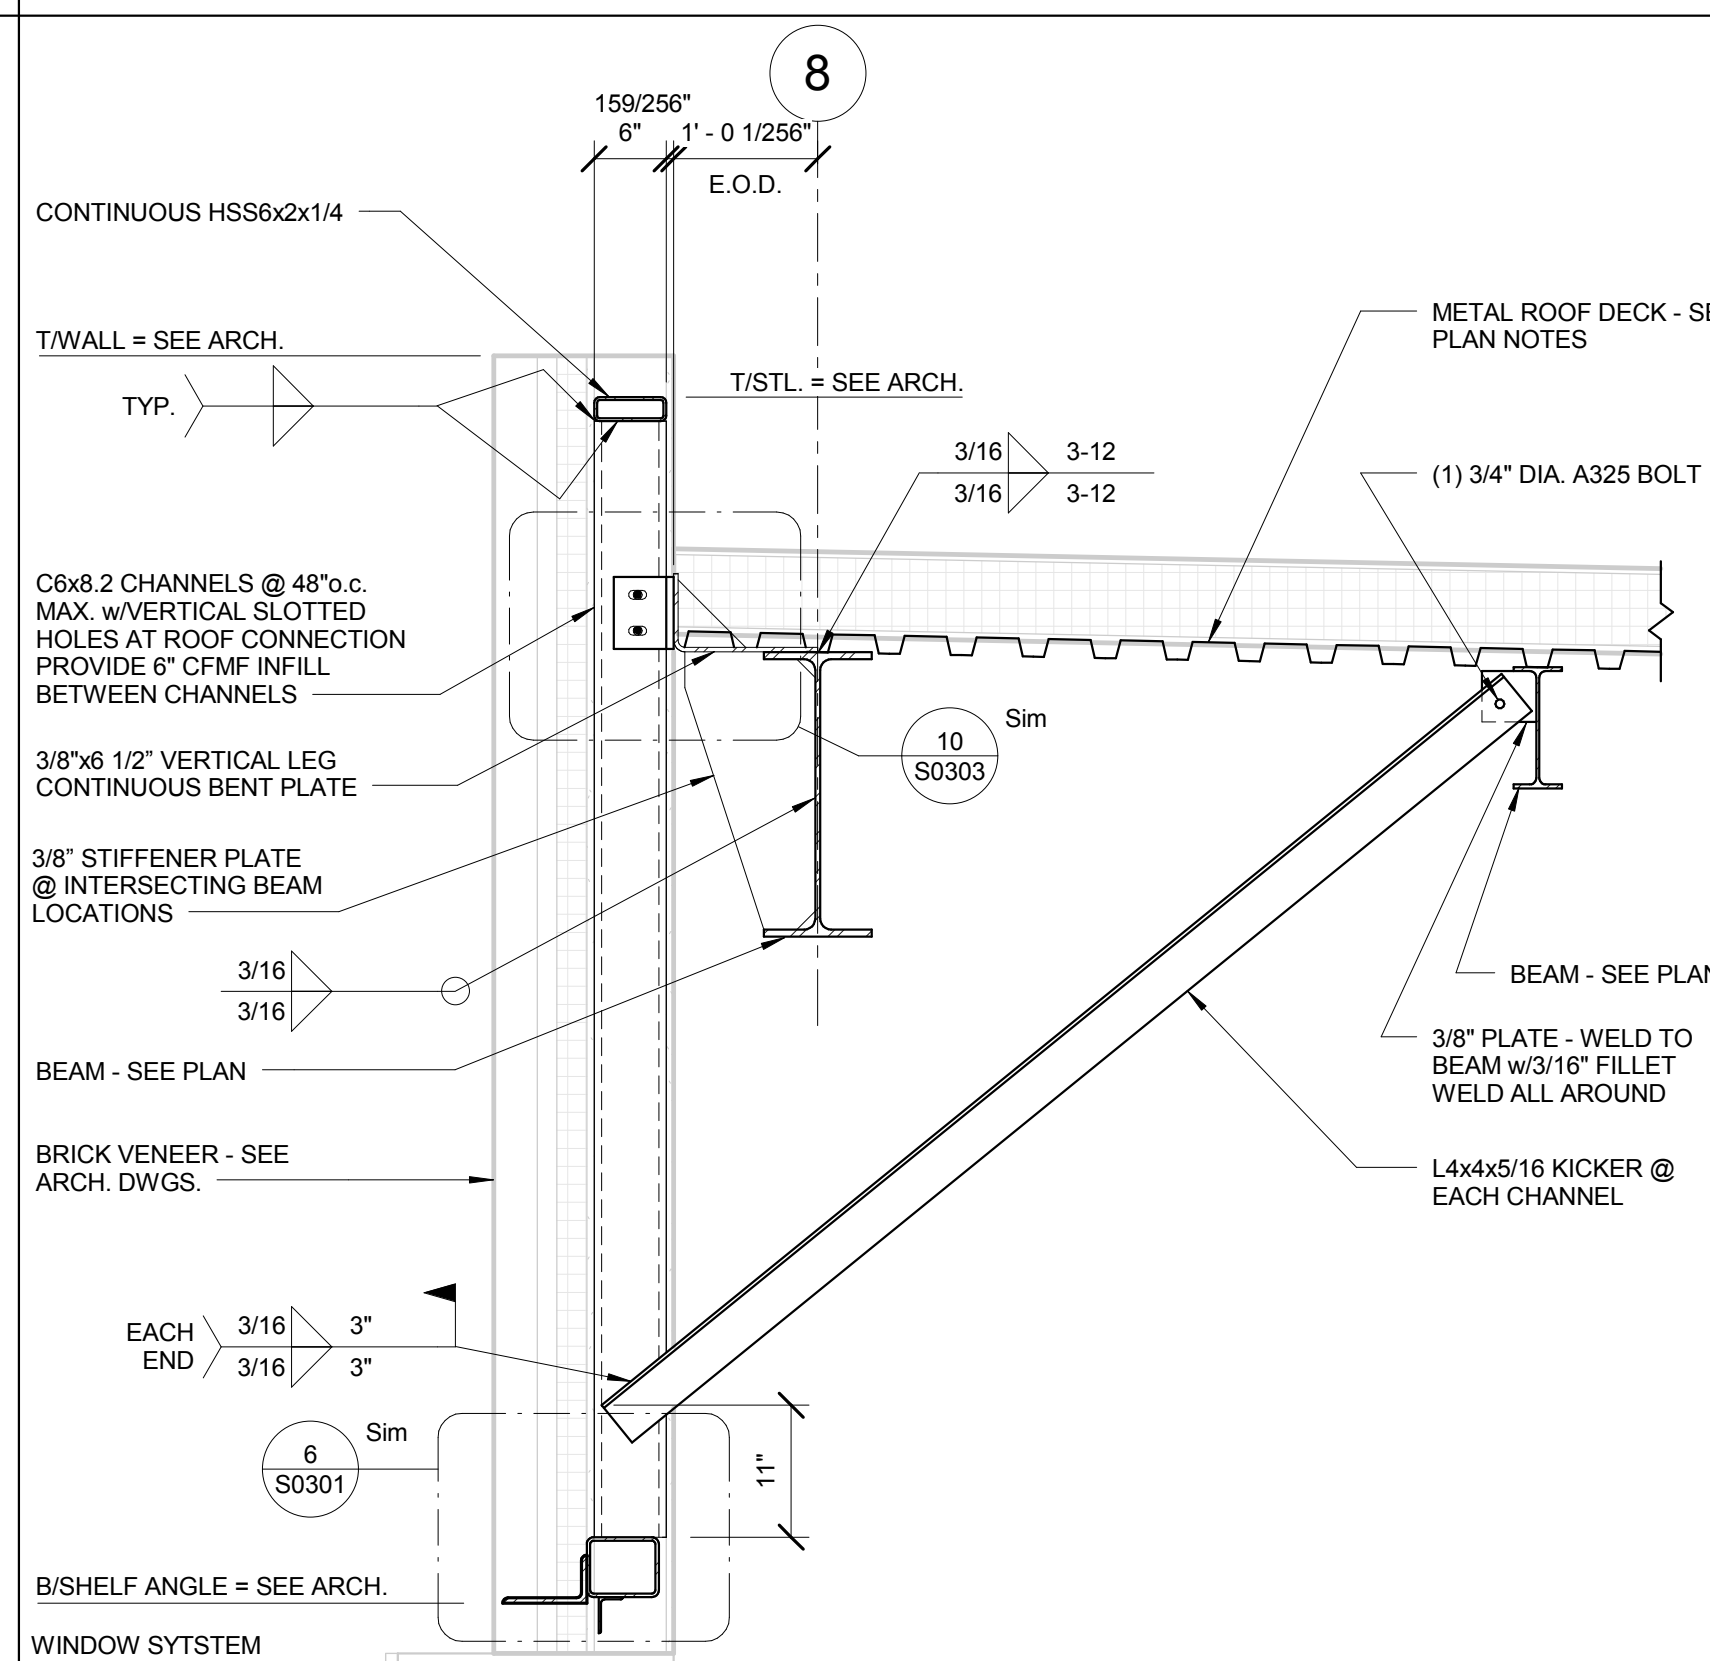

10 FRAMING SECTION
3/4" = 1'-0"

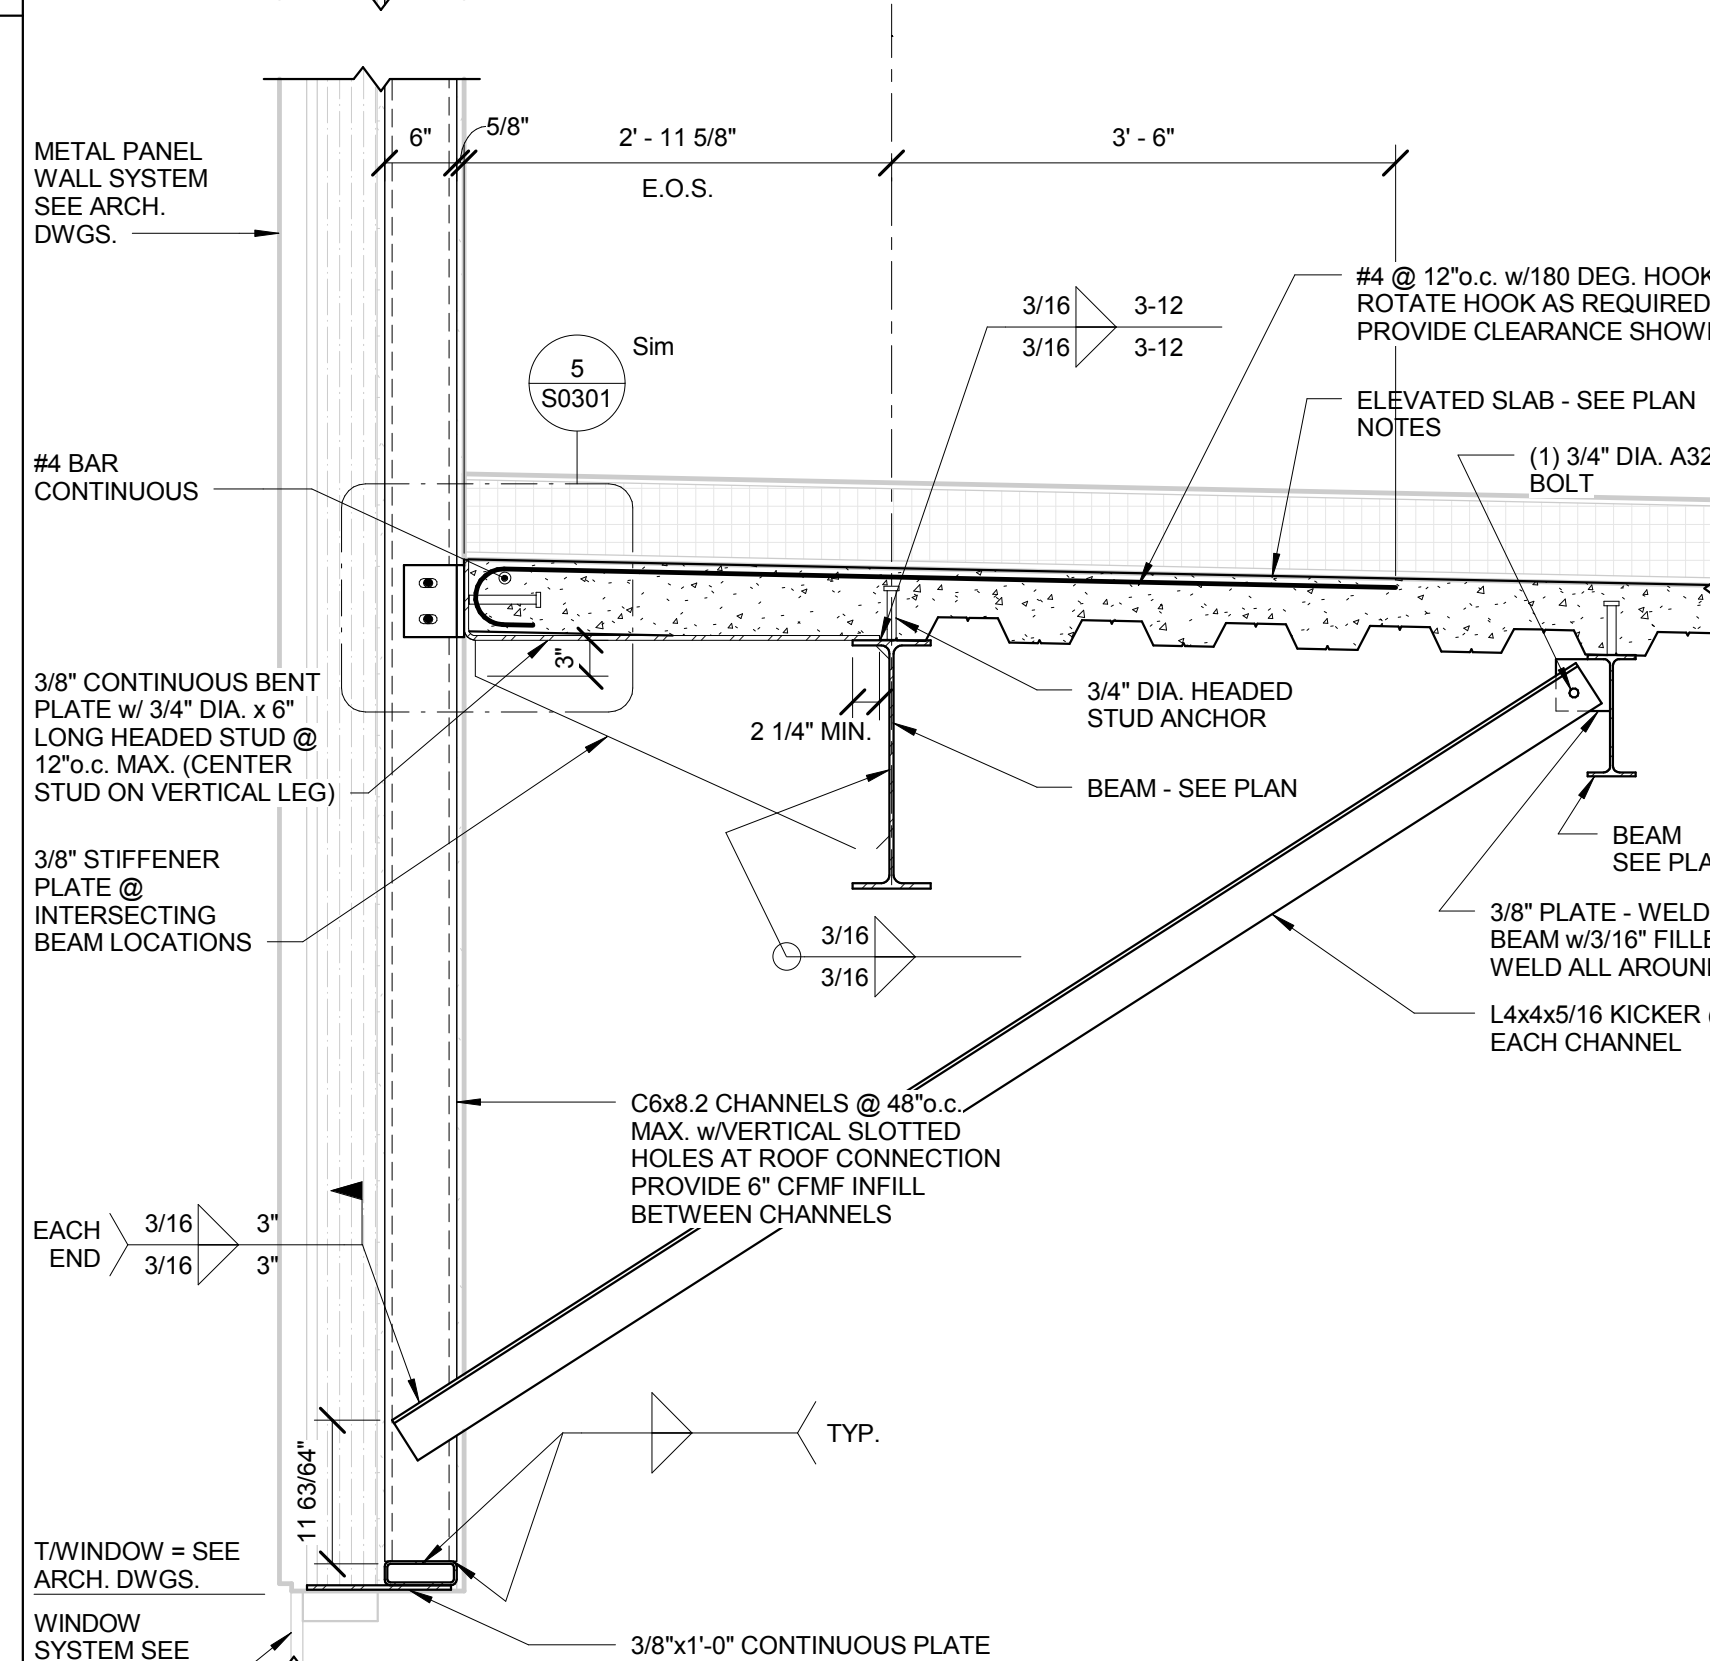

11 FRAMING SECTION
3/4" = 1'-0"

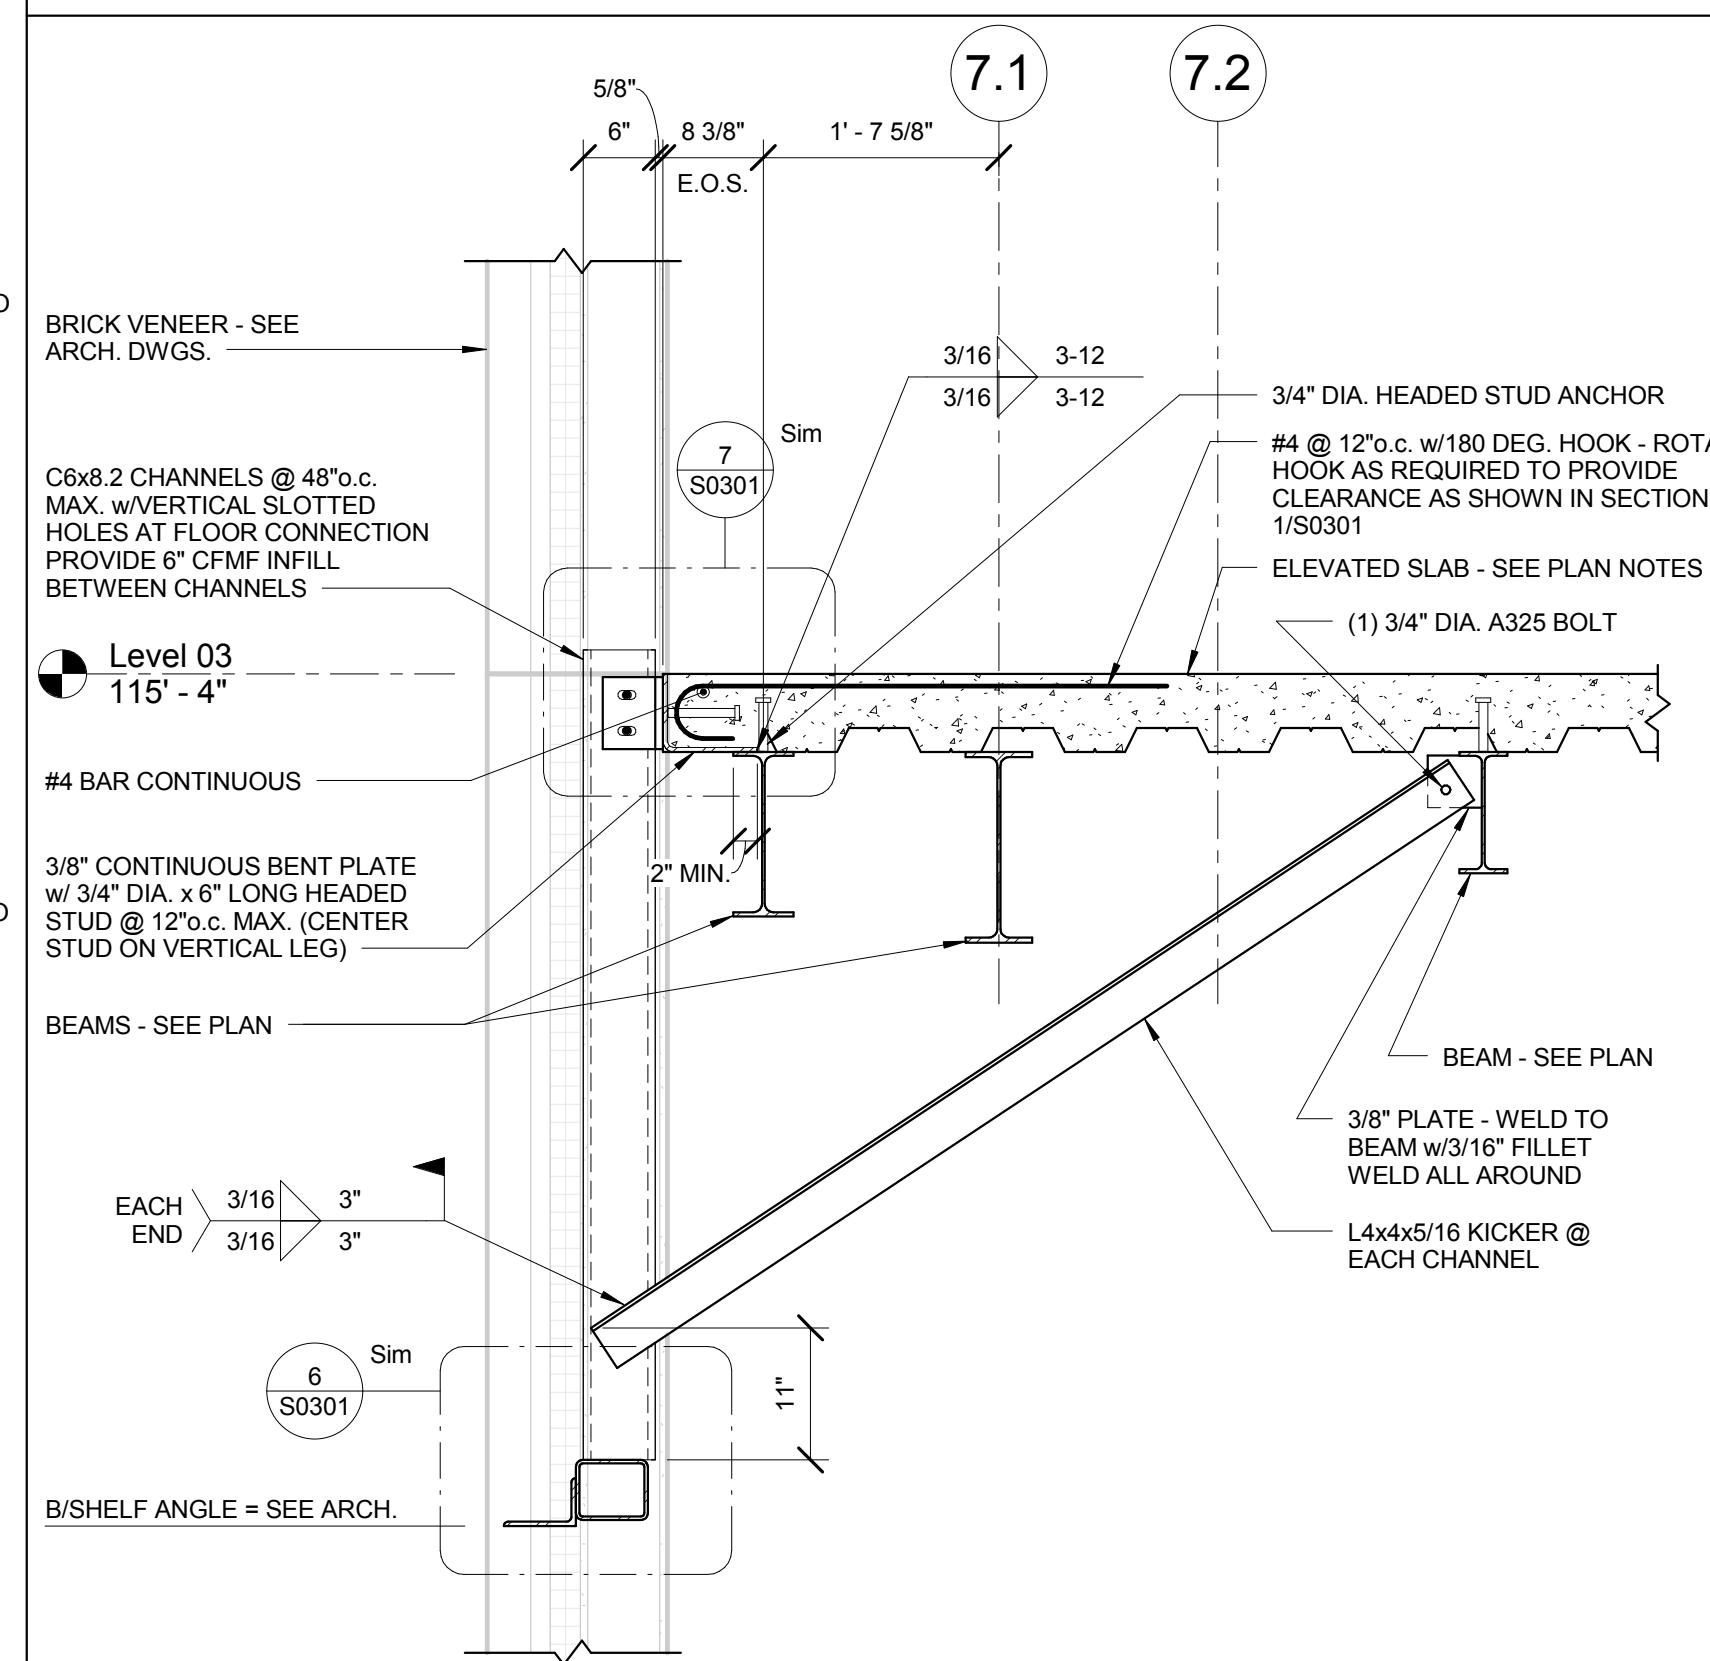

12 FRAMING SECTION
3/4" = 1'-0"

CONFORMED SET 01 JUL 2016

2	ADDENDUM 1-11	13 MAY 2016
1	ADDENDUM 1-1	29 JAN 2016
ISSUED FOR CONSTRUCTION (BPT)		15 JAN 2016
No.	Description	Date

Drawing Title:

FRAMING SECTIONS AND
DETAILS

Project No.: 04561.01 Checked by:

S0302

CONFORMED SET 01 JUL 2016

2	ADDENDUM 1-11	13 MAY 2016
1	ADDENDUM 1-1	29 JAN 2016
-	ISSUED FOR CONSTRUCTION (BP1)	15 JAN 2016
No.	Description	Date

Drawing Title:

FRAMING SECTIONS AND
DETAILS

Project No.: 04561.01 Checked by:

S0303

