



PARIC CORPORATION
77 Westport Plaza Suite 250
St. Louis, MO 63146
TEL: 636-561-9500
FAX: 636-561-9501

REQUEST FOR INFORMATION DATE: August 11, 2016 NO.: RFI-240

To: Cannon Design

Attn: Kelvin Patel

From: Paric Corporation

Requested By: Joe Voypick

Project Name: 15051-Webster University Interdisciplinary Science Building Project No.: 15051

Subject: Locations of Court Yard Lighting and Automatic Door Pedestal

Response Required By: August 18, 2016

Drawing / Spec Reference:

Information Requested:

Please provide rough in dimensions for the following items located in the courtyard.

- Door Opener for Vest C153
- Fixture Types EL, EC and the type EH fixture located in the wall

Response:


EC AND EL fixtures are located in typical tree well on attached drawing
EH - Wall mounted fixture is located on A0507.B issued with ASI 003. Annotated drawing is attached.
Door Opener Bollard - see attachment


ARCHITECT'S RESPONSE:


This information is provided as an interpretation of the Contract Documents for implementation. It is not an authorization for change to the Contract Sum or Contract Time. If this information results in a claim for a change to the Contract, the Contractor shall notify the [Construction Manager][Architect] of a change through the change process.

Answered By: Lynn :Grossman


Date: 08.15.16

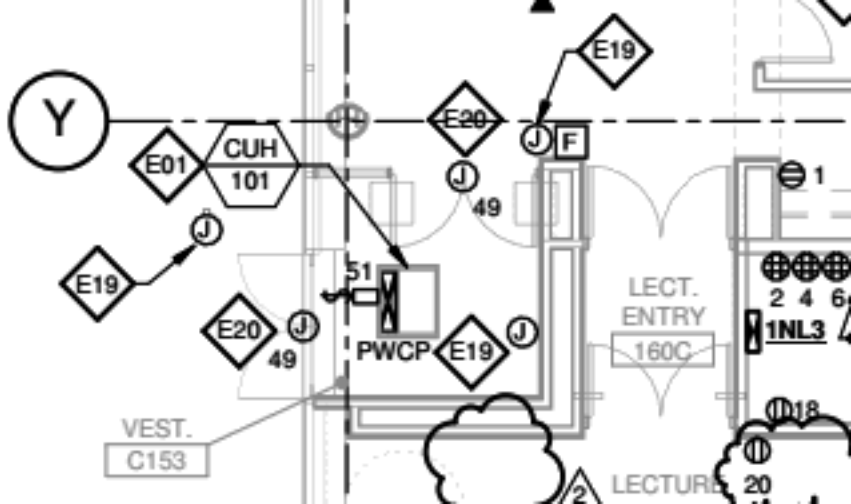

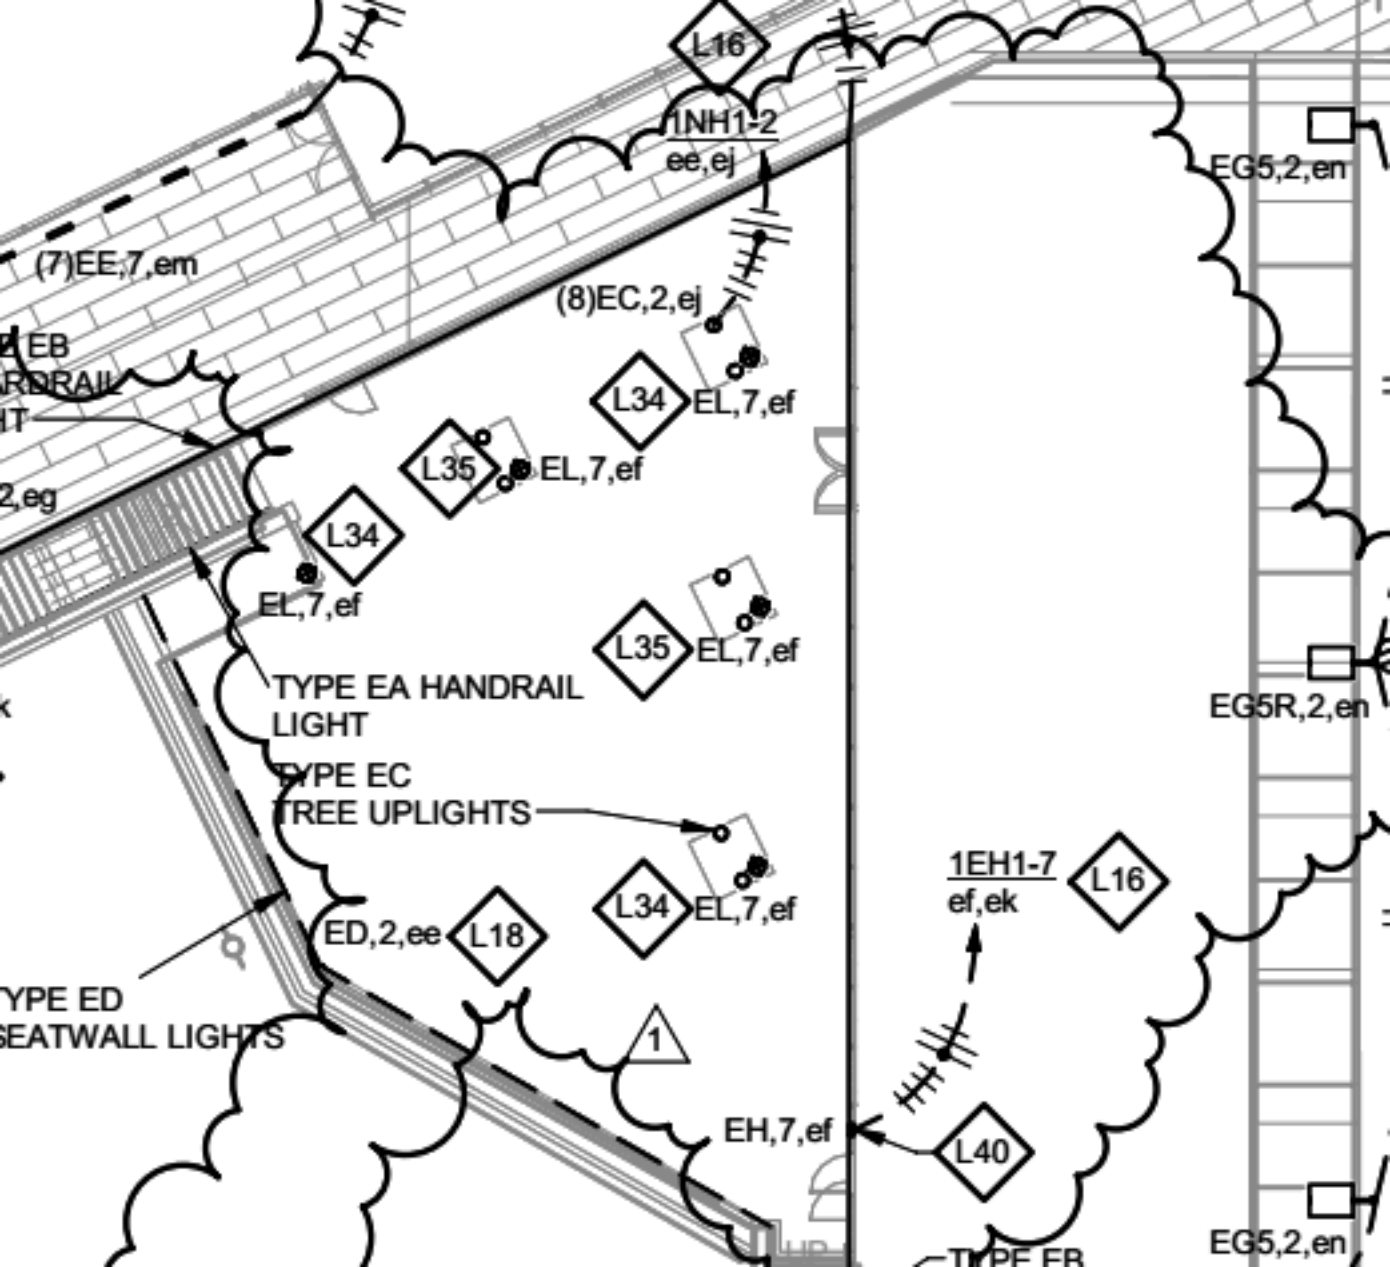

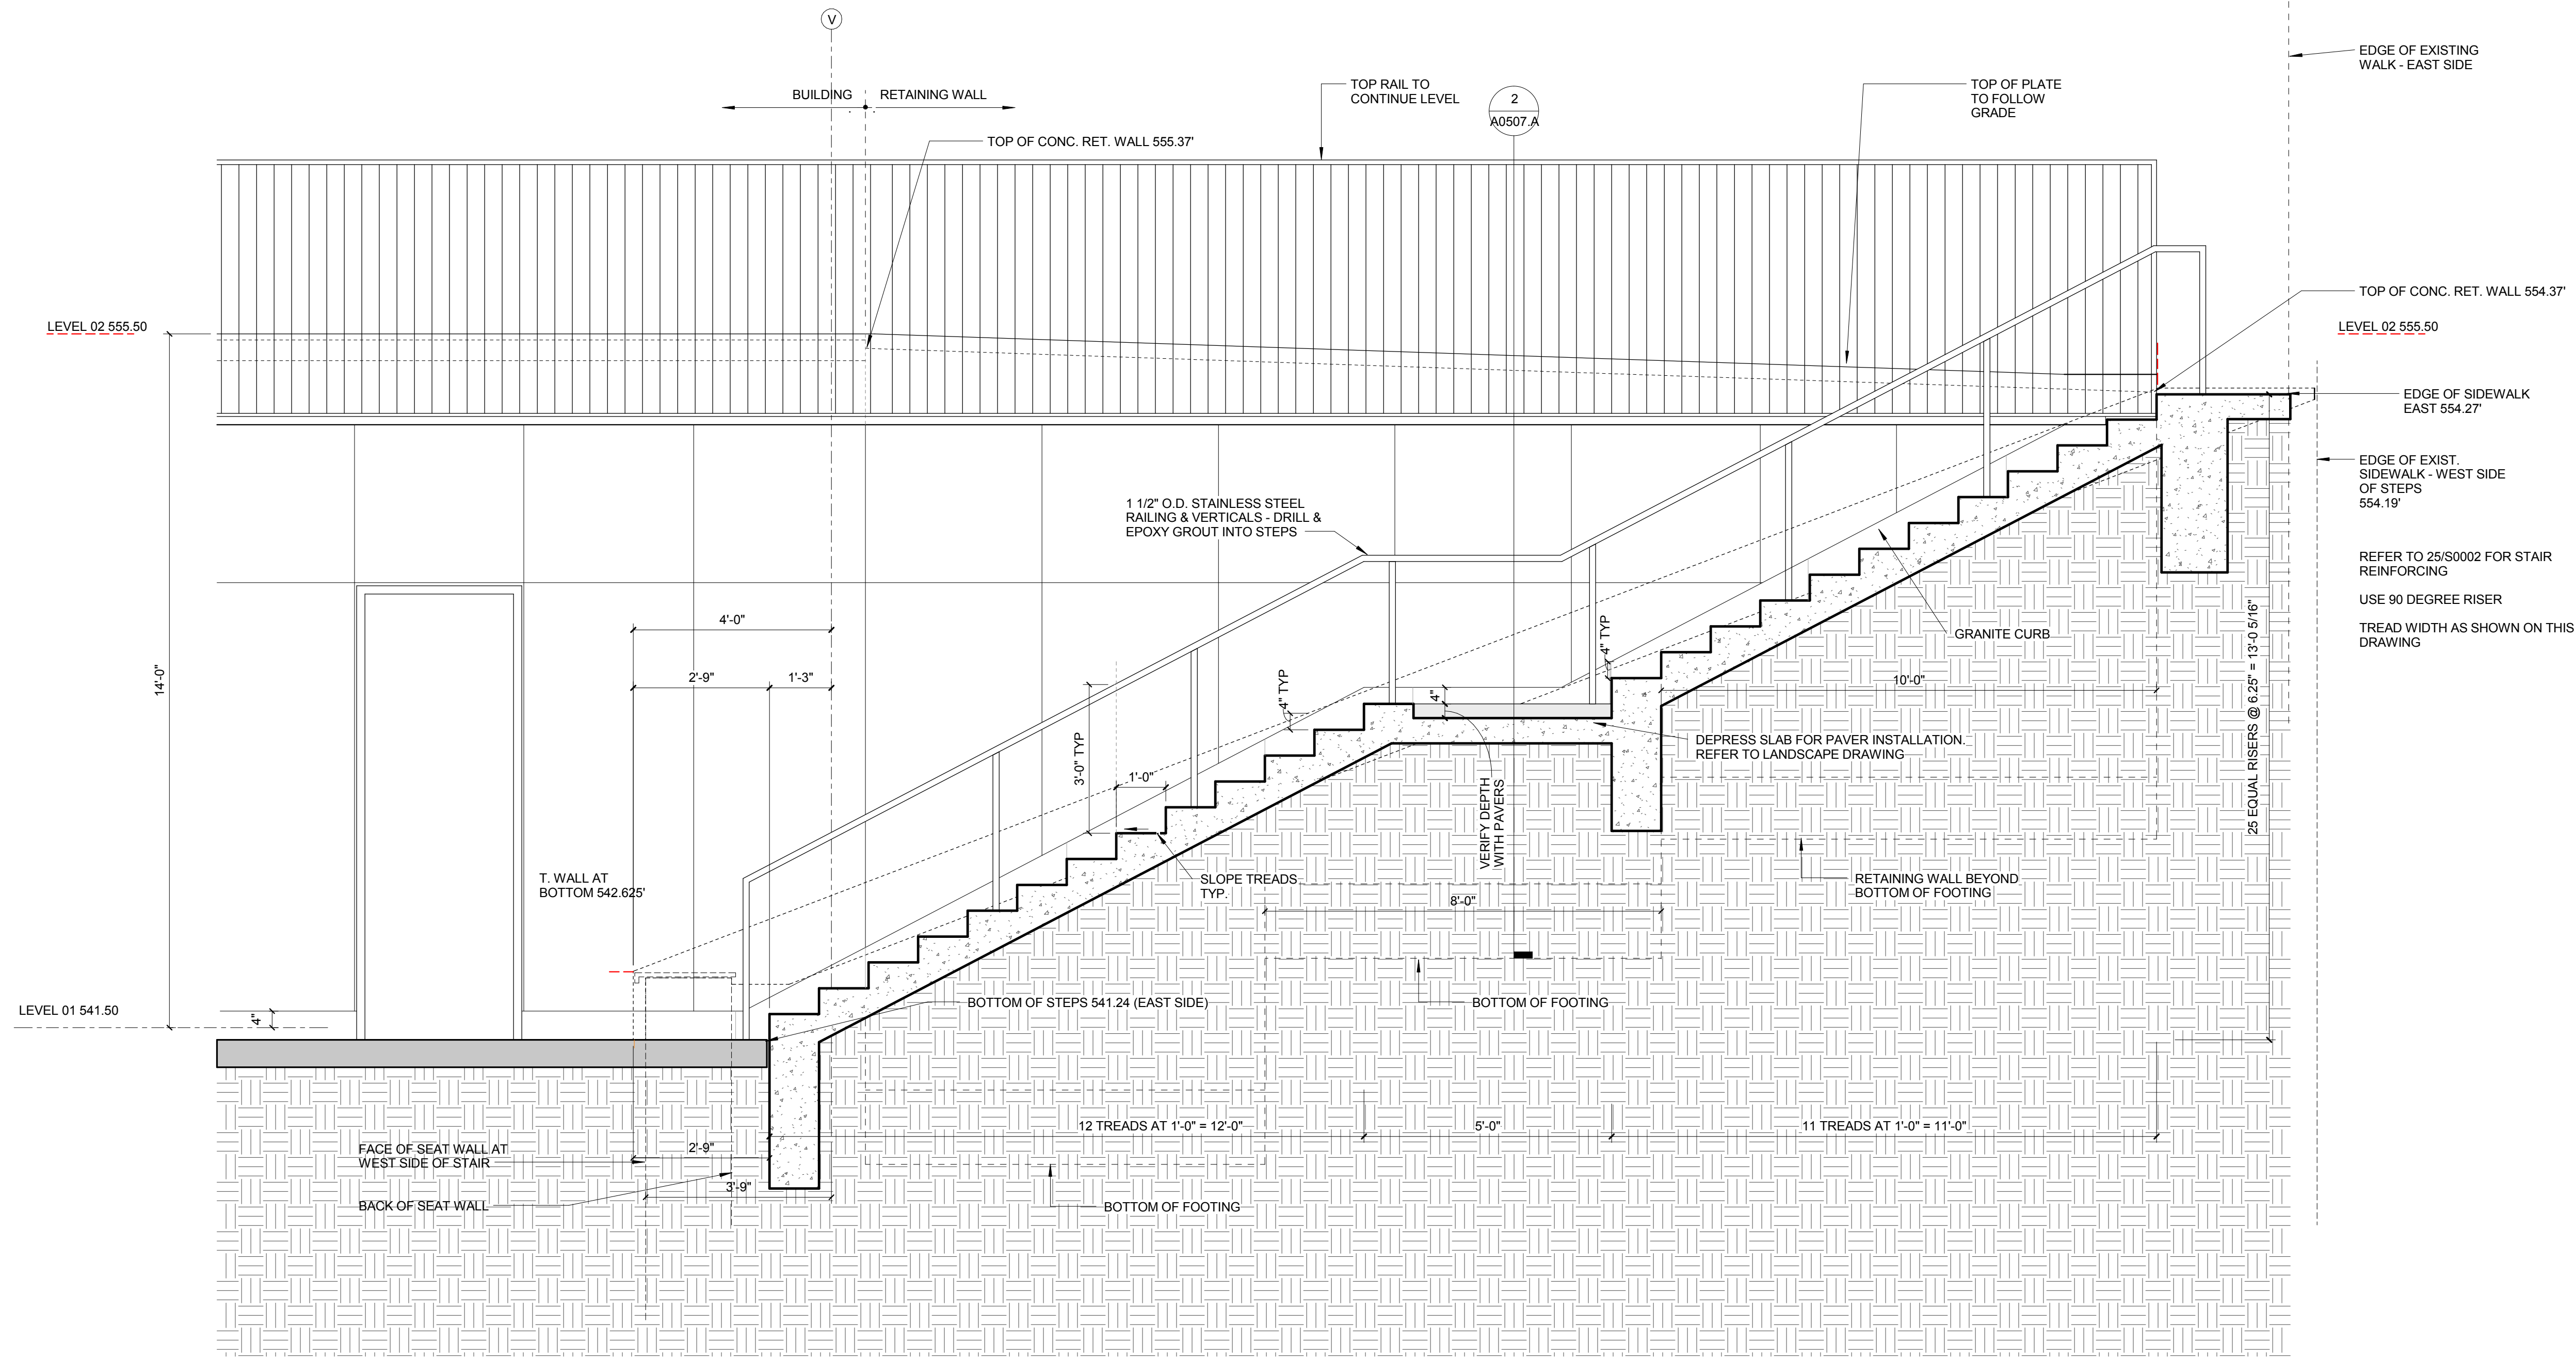

2 SOUTH COURTYARD STAIR - SECTION
1/2" = 1'-0"

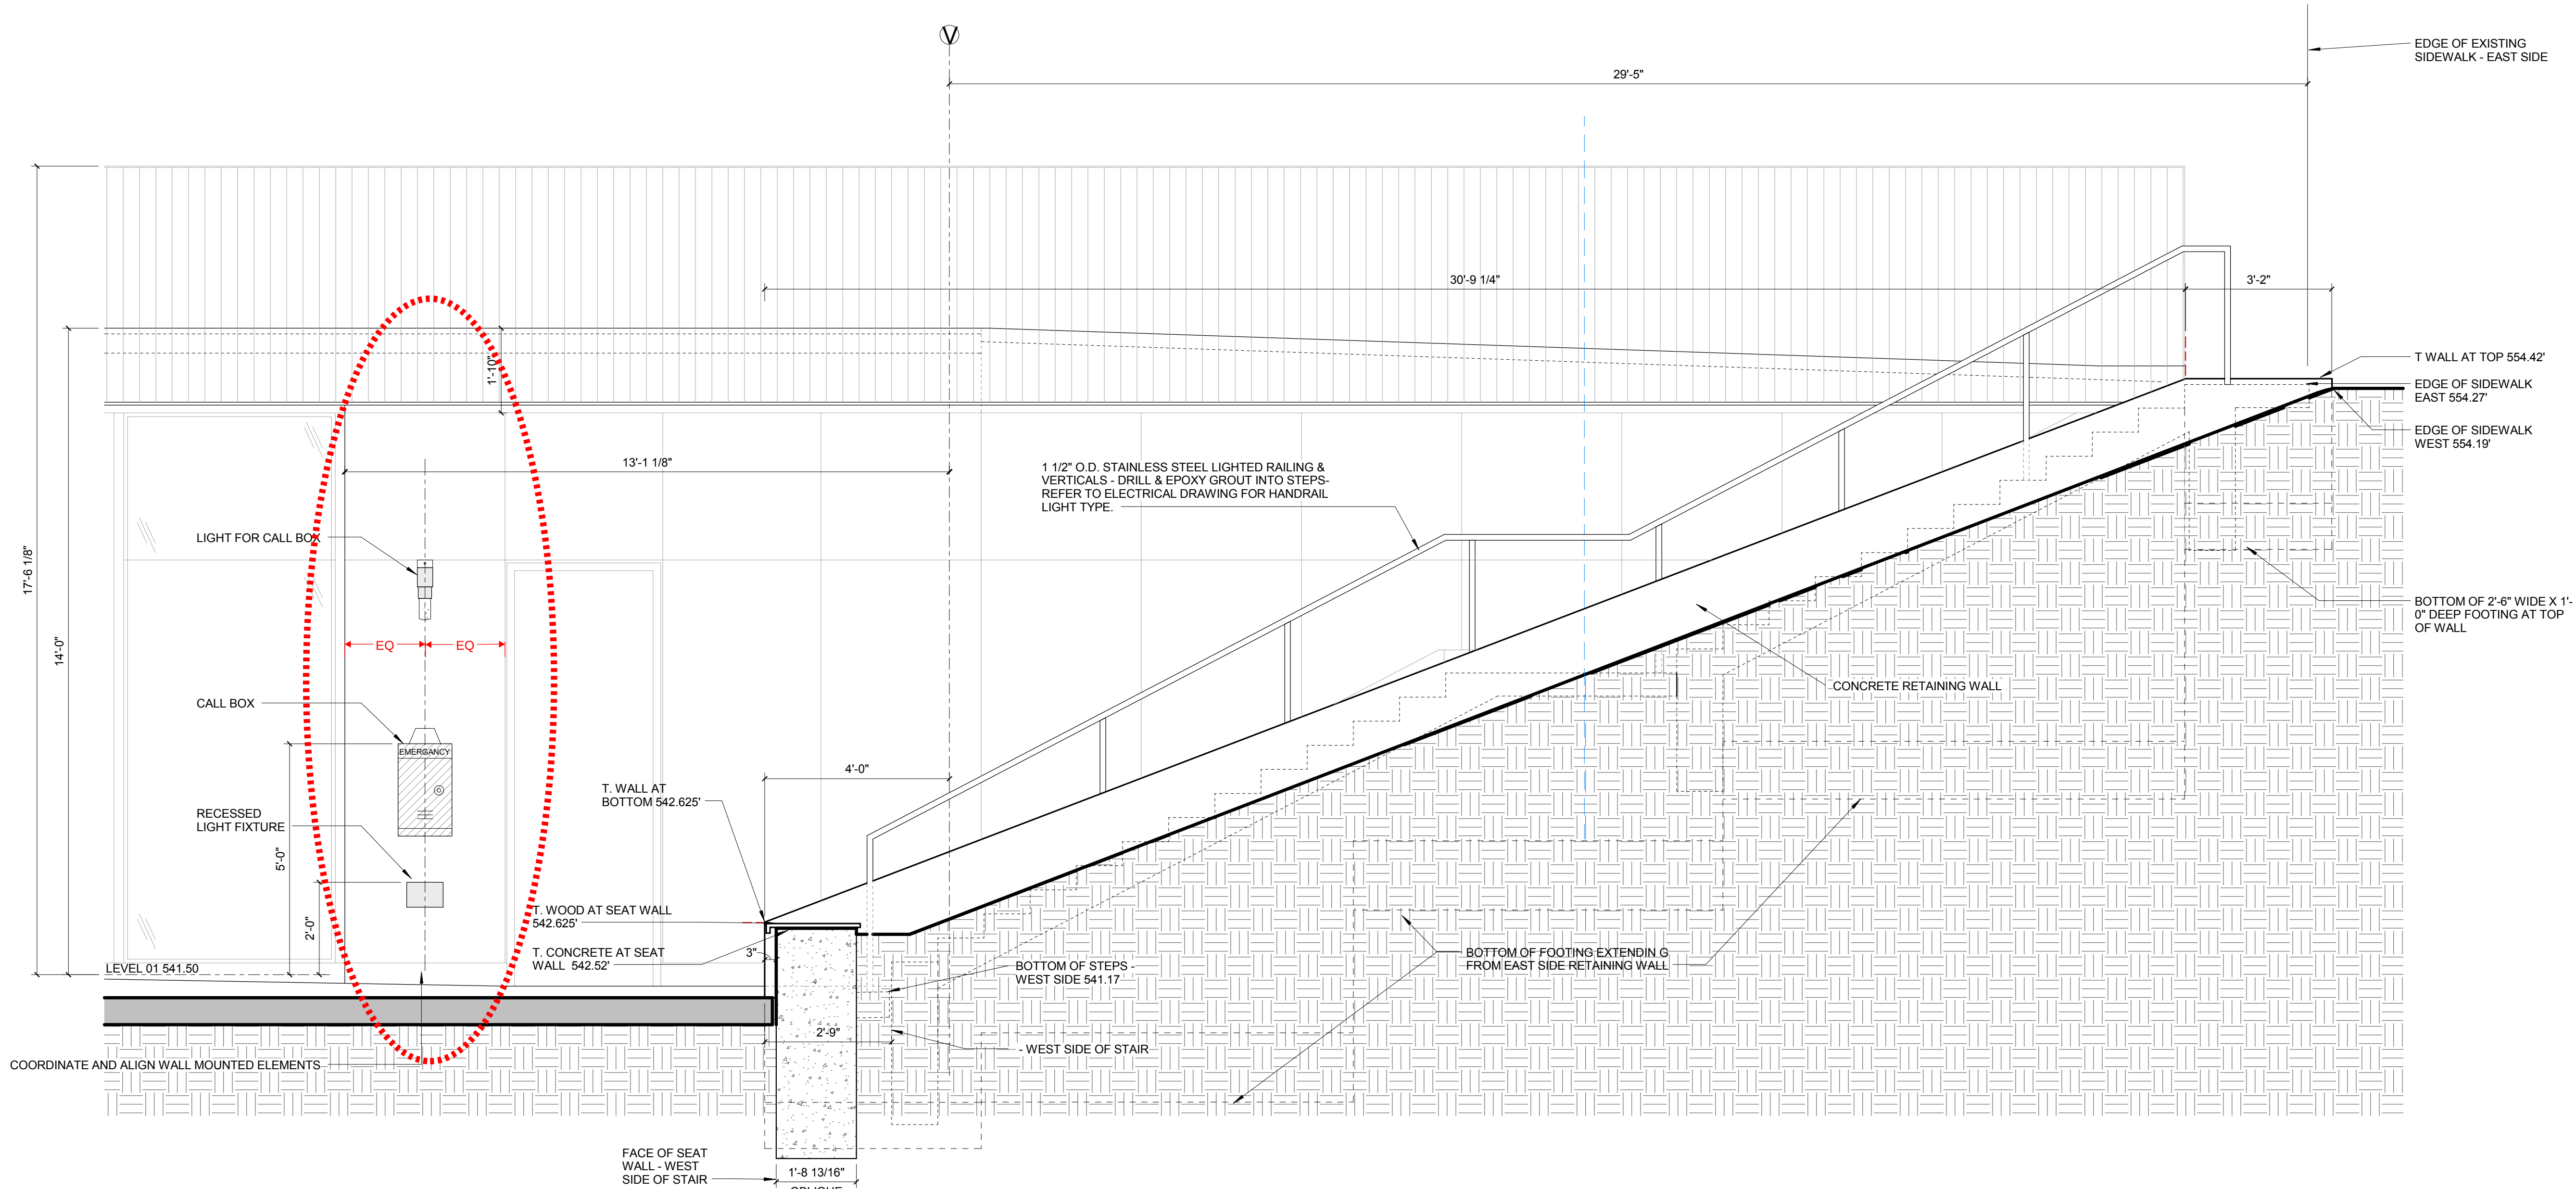

1 SOUTH COURTYARD STAIR - WEST SIDE WALL ELEVATION
1/2" = 1'-0"

1	ASI-003	01 AUG 2016
-	ISSUED FOR CONSTRUCTION (BP1)	15 JAN 2016
No.	Description	Date

Drawing Title:

**COURTYARD WALLS &
STAIRS - SOUTH**

Project No.: 04561.01

Checked by:

A0507.B

