



PARIC CORPORATION
77 Westport Plaza Suite 250
St. Louis, MO 63146
TEL: 636-561-9500
FAX: 636-561-9501

REQUEST FOR INFORMATION **DATE:** September 18, 2016 **NO.:** RFI-285

To: Cannon Design

Attn: Kelvin Patel

From: Paric Corporation

Requested By: Devin Gates

Project Name: 15051-Webster University Interdisciplinary Science Building Project No.: 15051

Subject: Verify housekeeping pad locations are acceptable

Response Required By: September 25, 2016

Drawing / Spec Reference:

Information Requested:

See attached sketches with dimensioned mechanical pad locations. Please verify there are no clearance or accessibility concerns with the proposed locations.

Response:

All housekeeping pad sizes and locations should be fully coordinated with all construction trades using shop drawings and clearance requirements of the exact equipment that is being provided. Also, all housekeeping pad details shall be reviewed and approved by the architect and structural engineer.

ARCHITECT'S RESPONSE:

This information is provided as an interpretation of the Contract Documents for implementation. It is not an authorization for change to the Contract Sum or Contract Time. If this information results in a claim for a change to the Contract, the Contractor shall notify the [Construction Manager][Architect] of a change through the change process.

[SEE ARCHITECTS COMMENTS ON PAGE 3](#)


Lynn Grossman

09.28.16



Answered By: Patrick Garner, WTA

Date: 9/28/16

DATE: 08/29/2016 FILE PATH: N:\Engineering\CAD\2016_AREAS\5768 - Webster ISB\Design\Mechanical\ISB\Construction\Mechanical\Lower Level Housekeeping pads.dwg
PLOT BY: J. Zimany, LSC

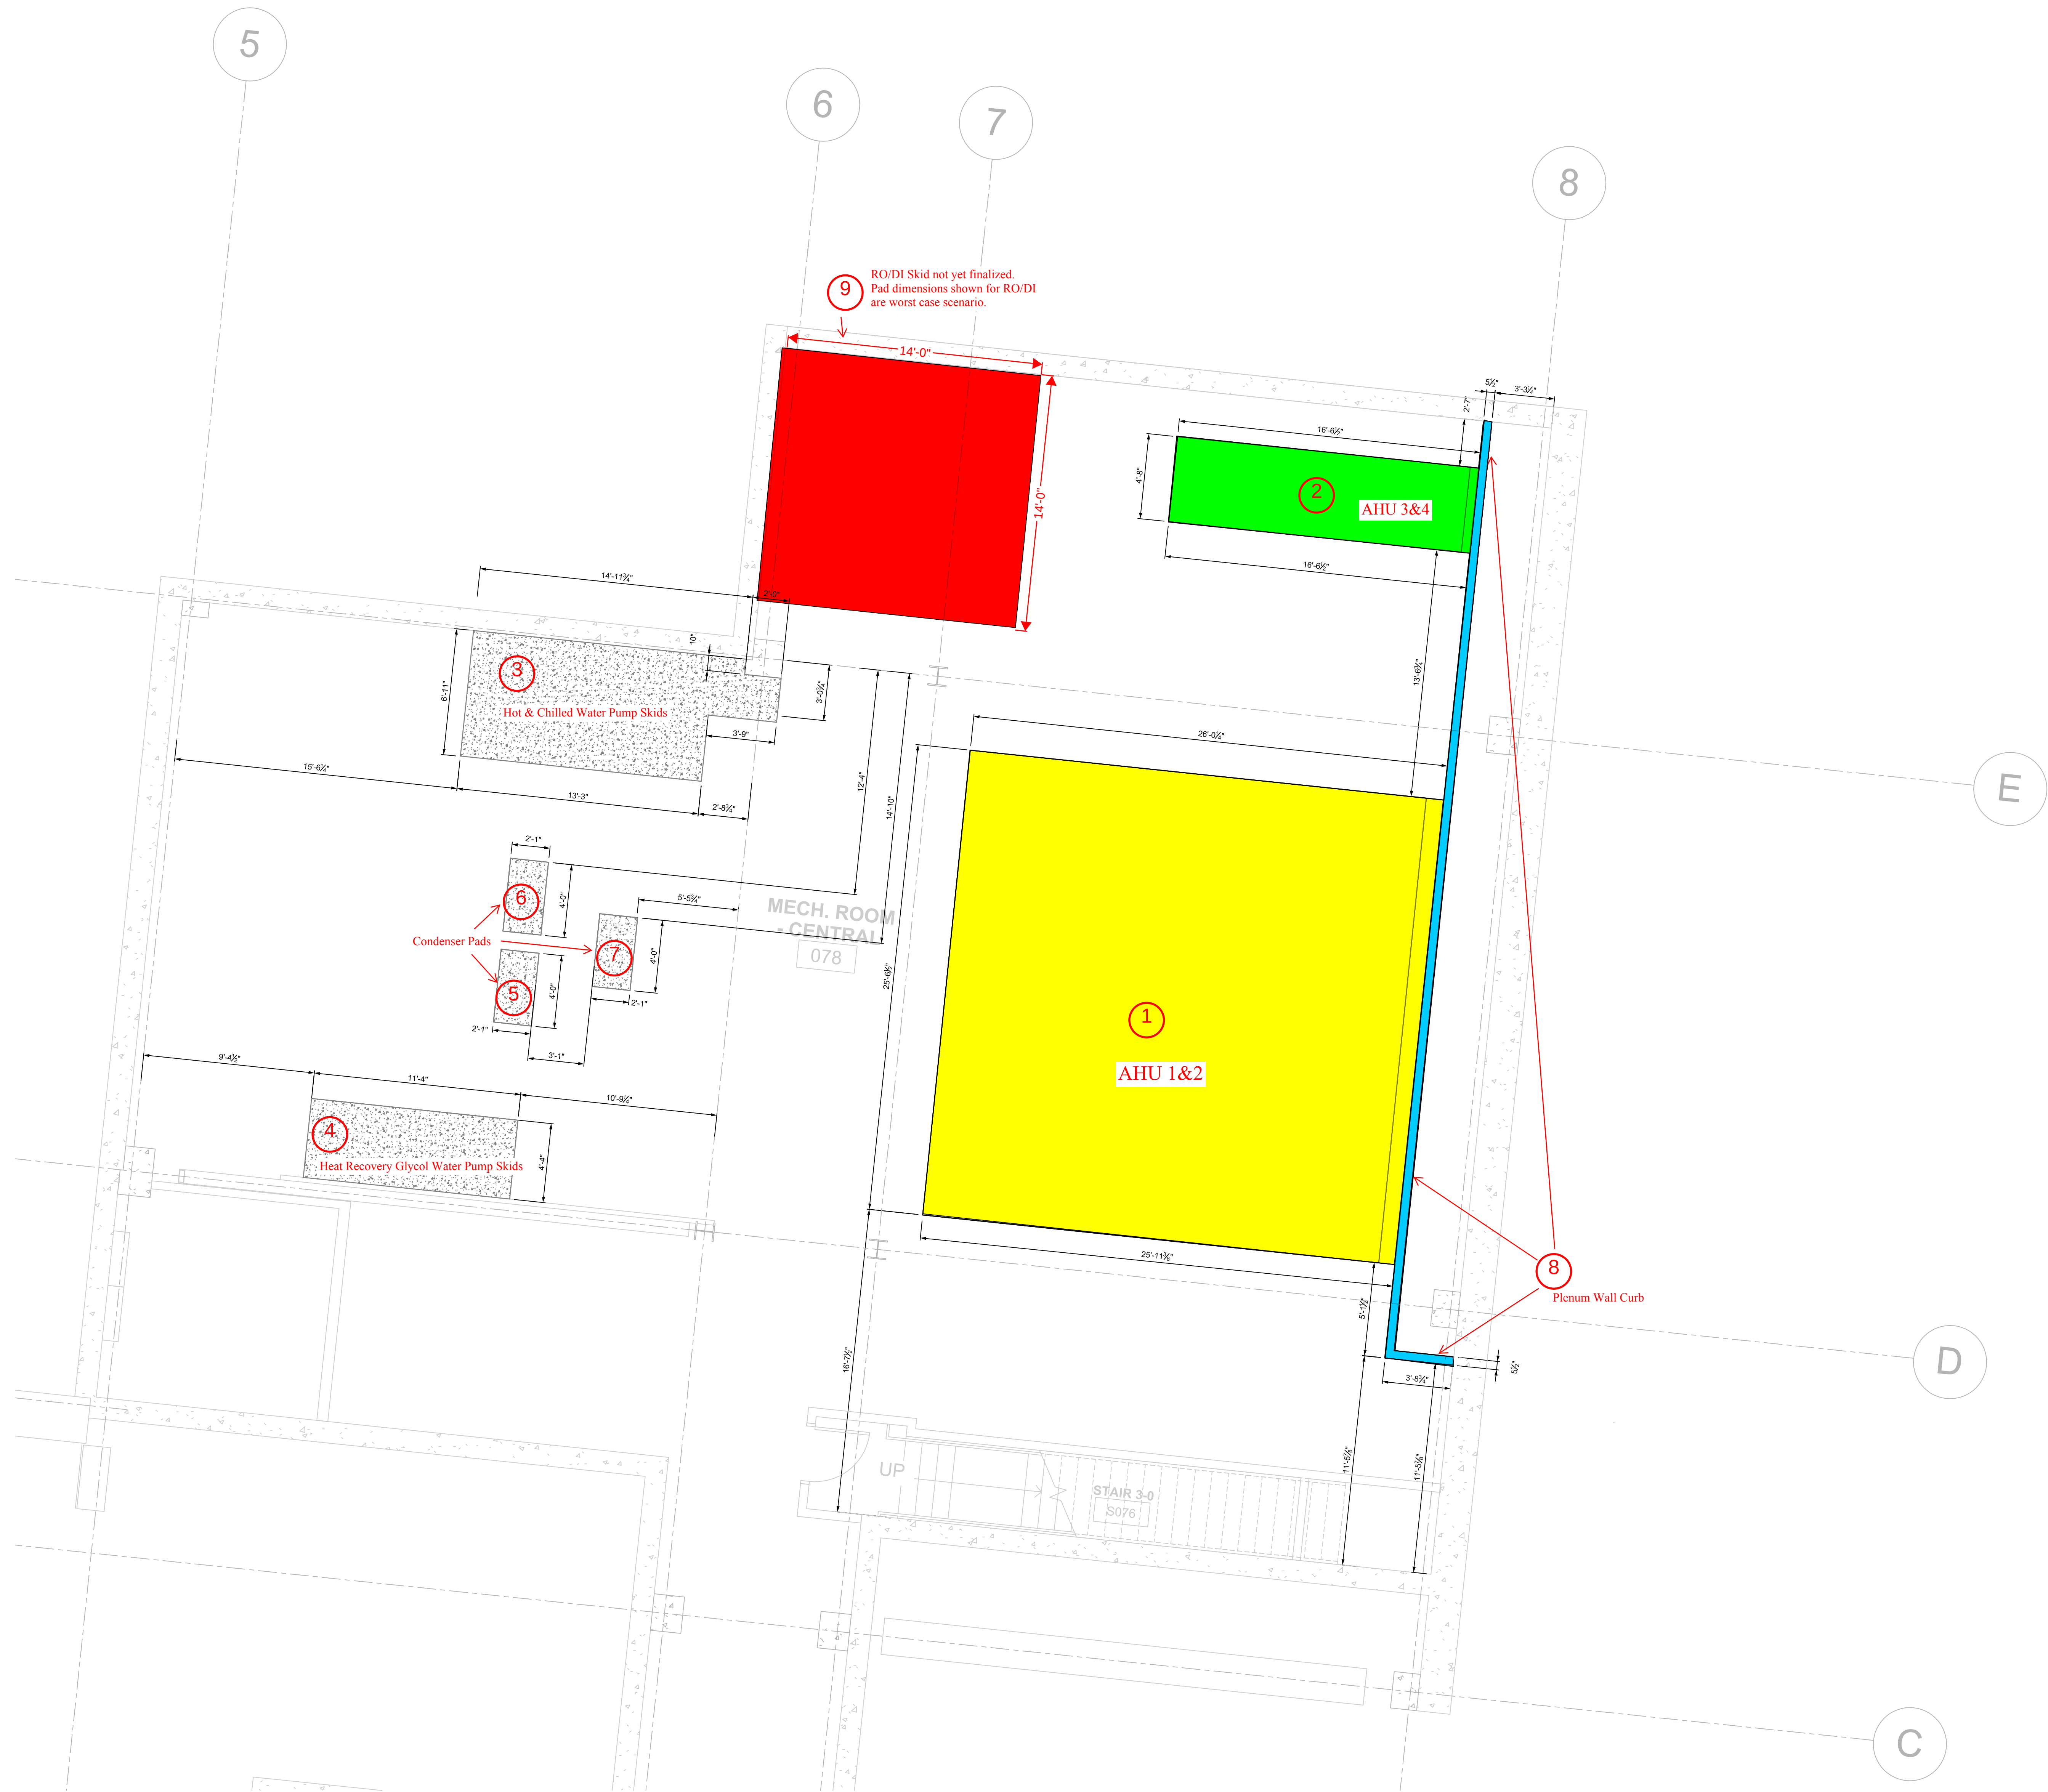

① LOWER LEVEL HOUSEKEEPING PAD
SCALE: 1/4"=1'-0"

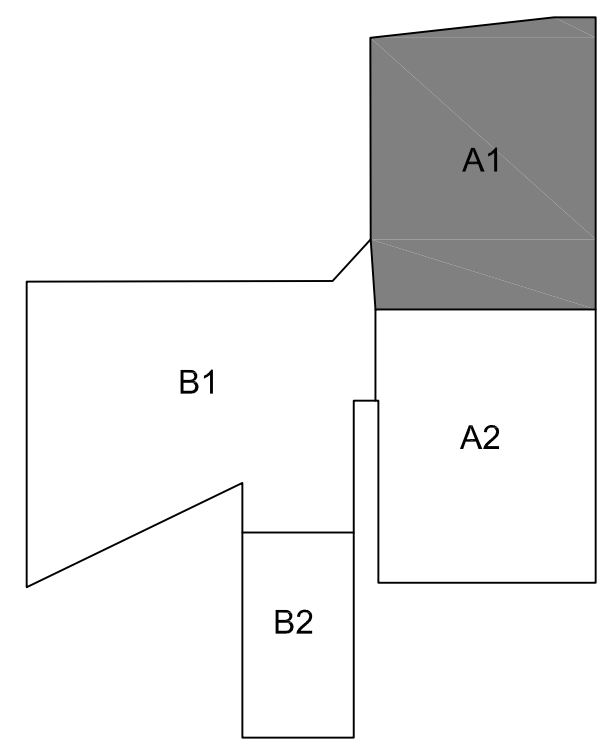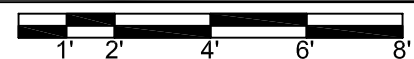


KEY PLAN

Revision:	1	2	3	4	5
Issue Date	8/29/2016				
Sheet Title	SK-1				
Project Number	5768				
Sheet Number	1 of 1				

WEBSTER UNIVERSITY - ISB
WEBSTER GROVES, MISSOURI
ICON MECHANICAL CONTRACTORS AND ENGINEERS

NOT VALID FOR PERMITS
UNLESS SEALED BY
ENGINEER

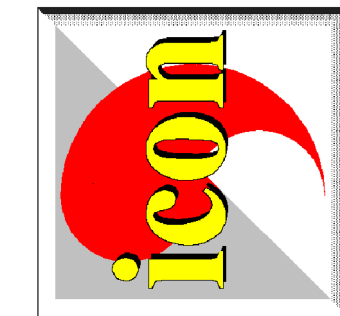


icon
Mechanical
1616 Cleveland Blvd. • Granite City, IL 62040
www.iconmech.com




Webster ISB - Level 1


Housekeeping pad Locations

1/4" = 1'-0"

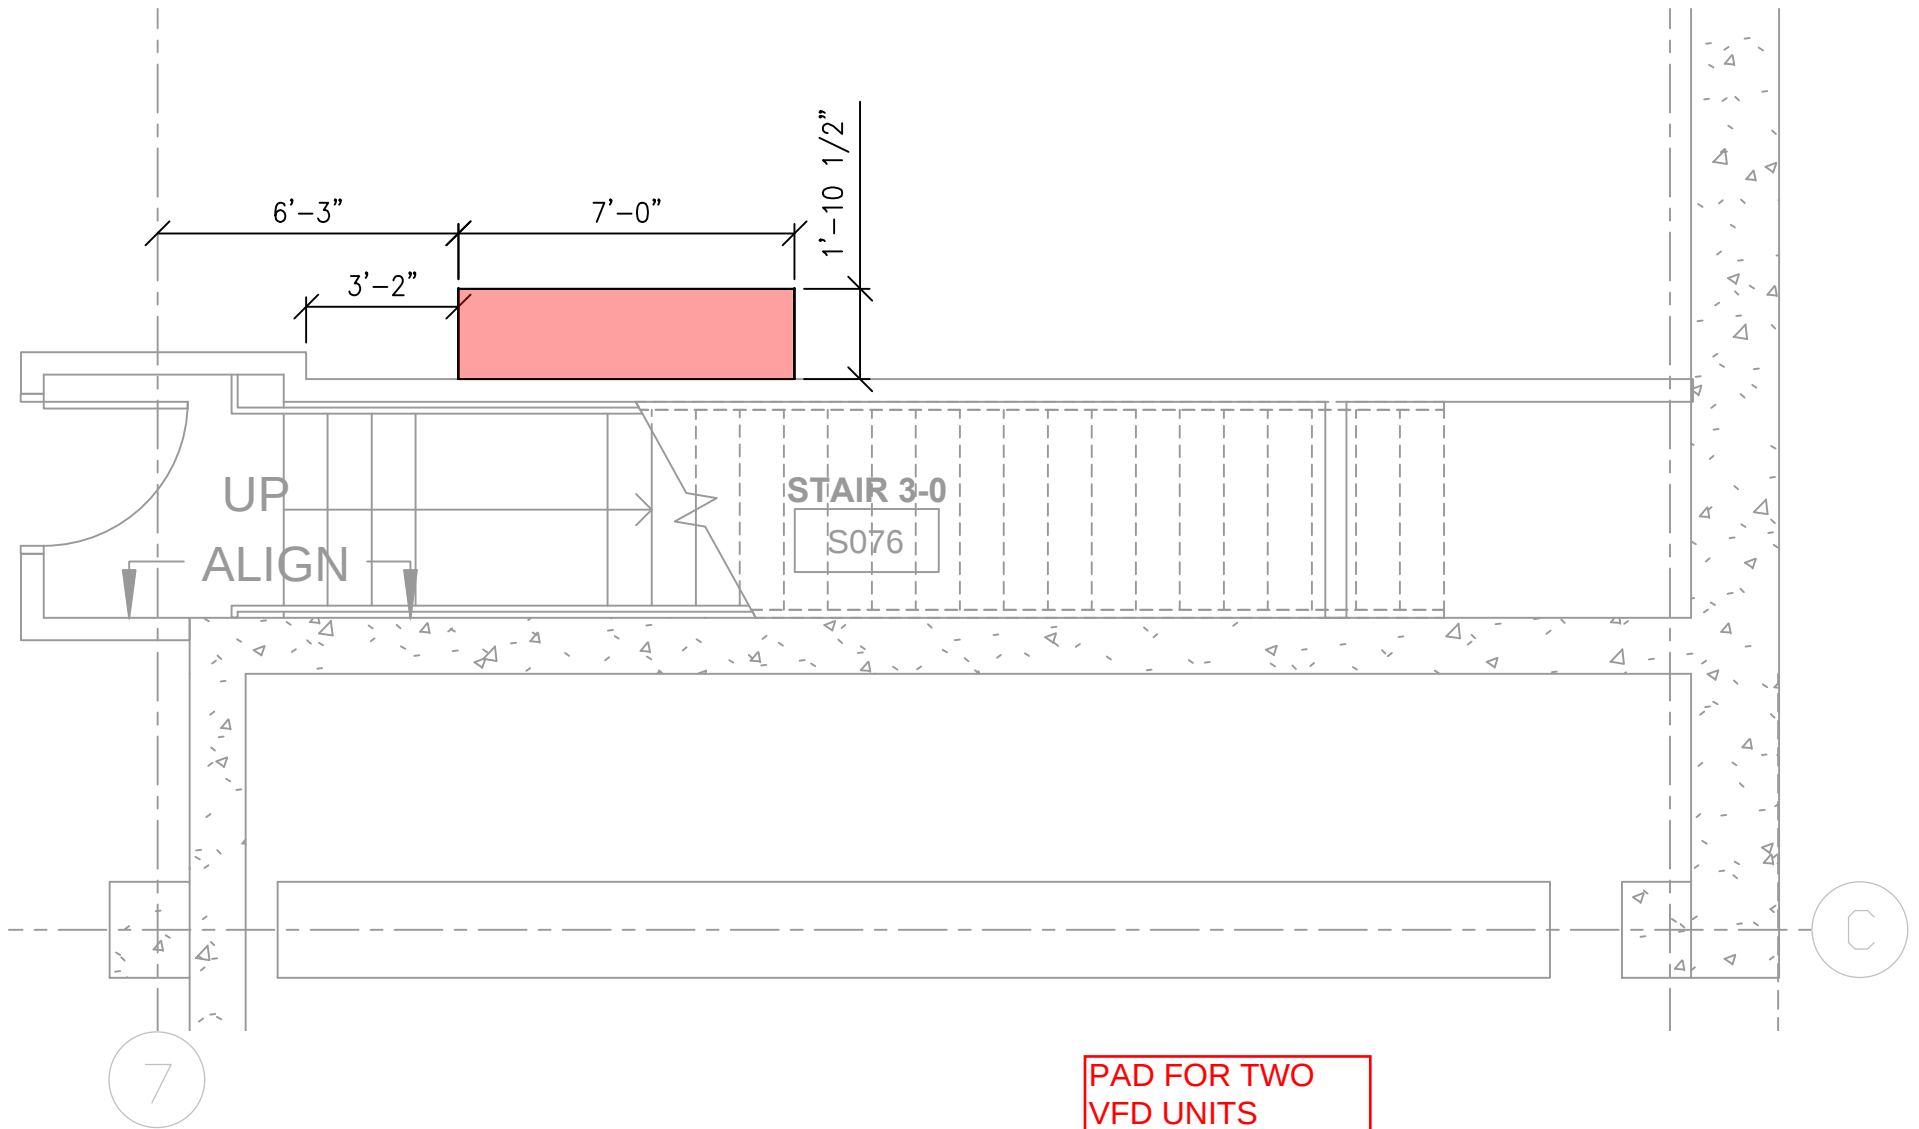



LO EQUIPMENT PAD

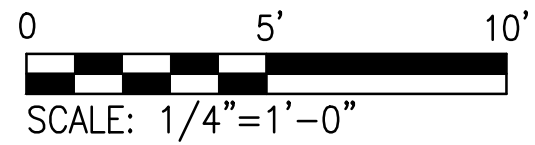

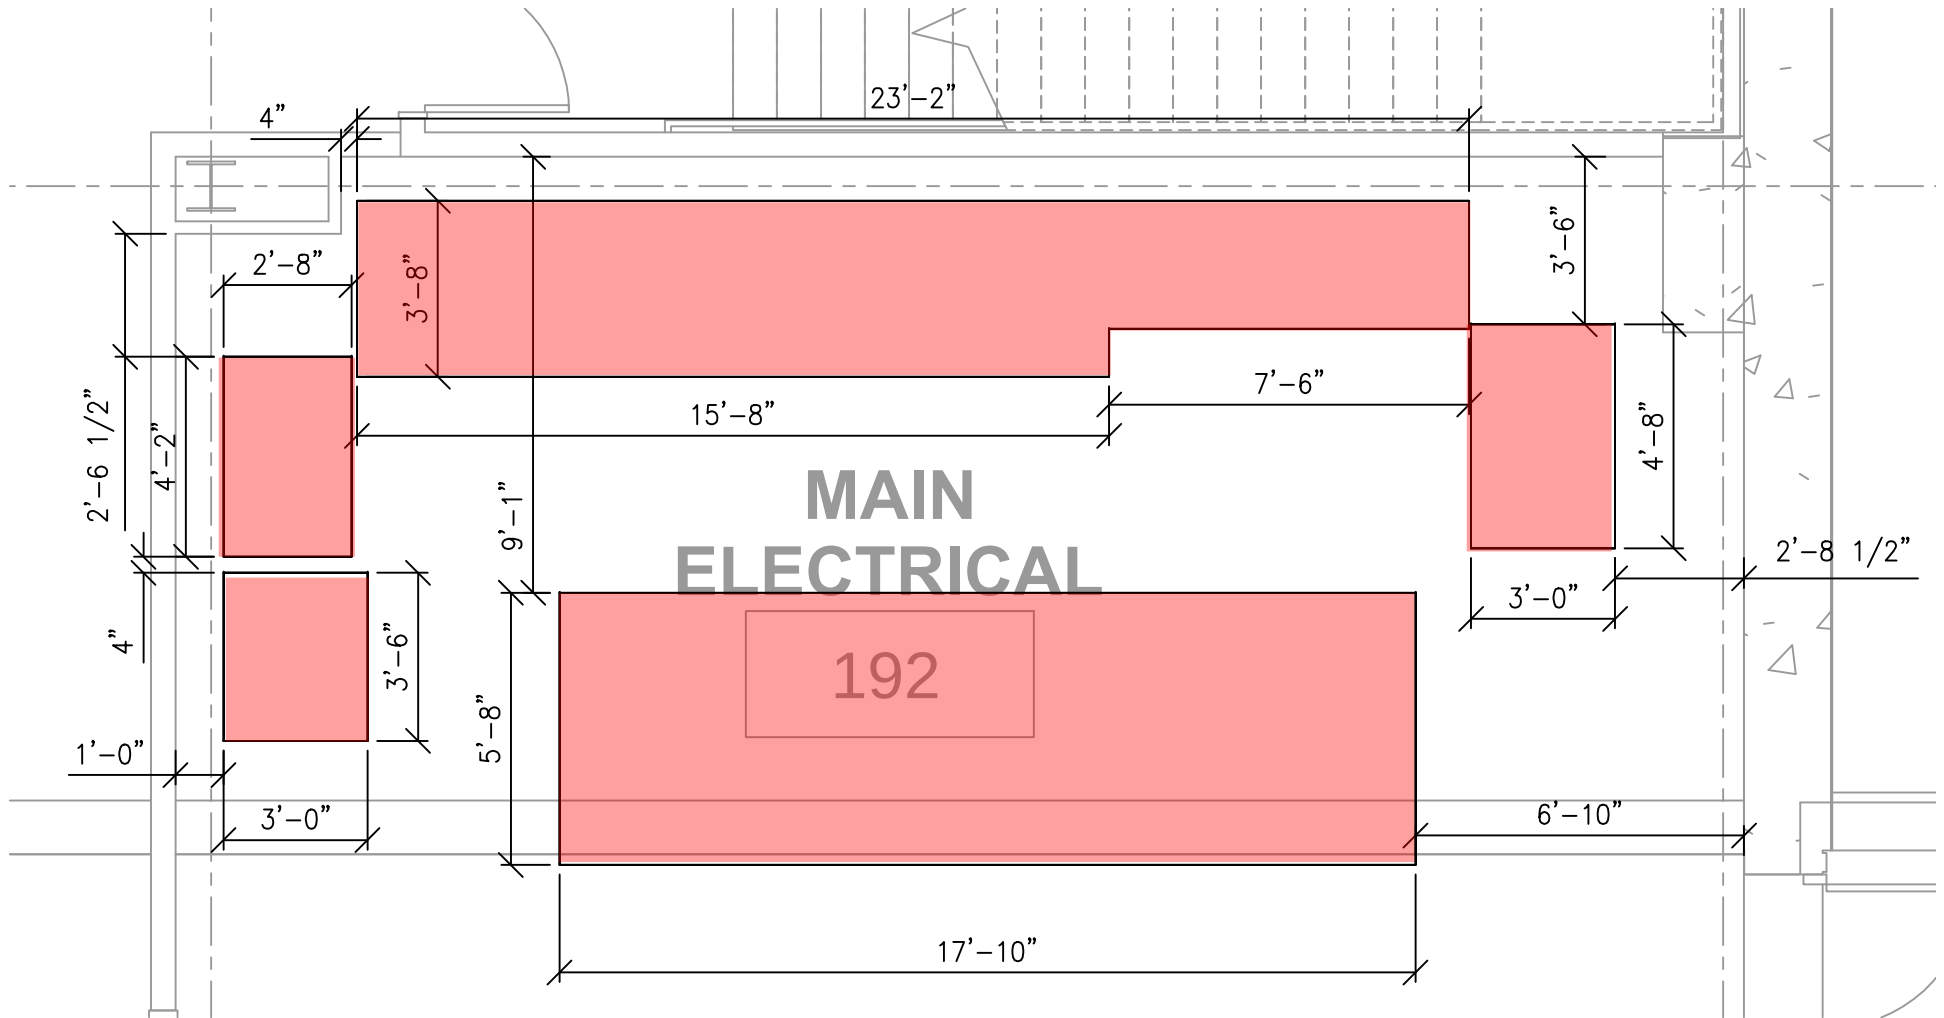


MAIN ELECTRICAL ROOM 192
EQUIPMENT PADS

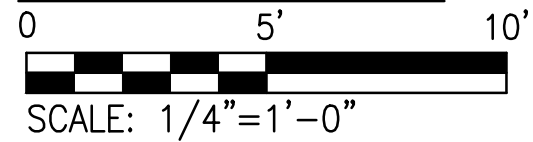

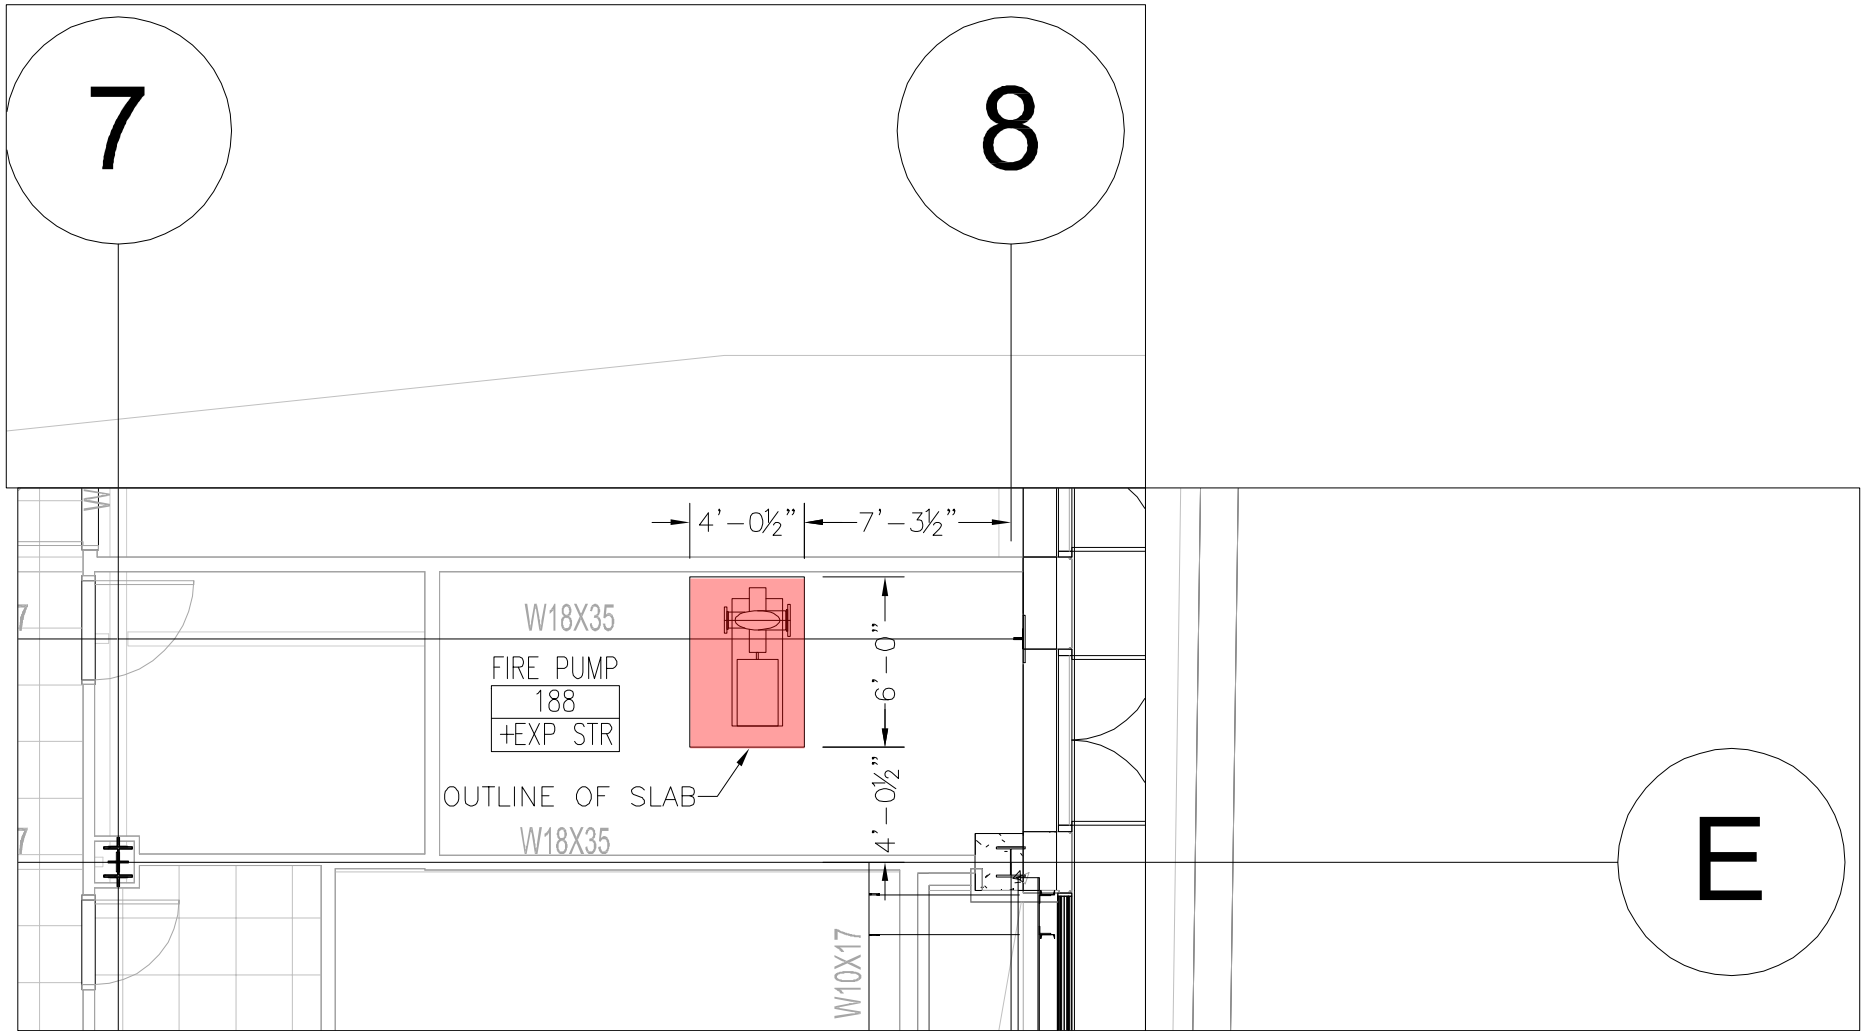

1ST LVL THRU FLOOR PENETRATION

FIRE PUMP PAD

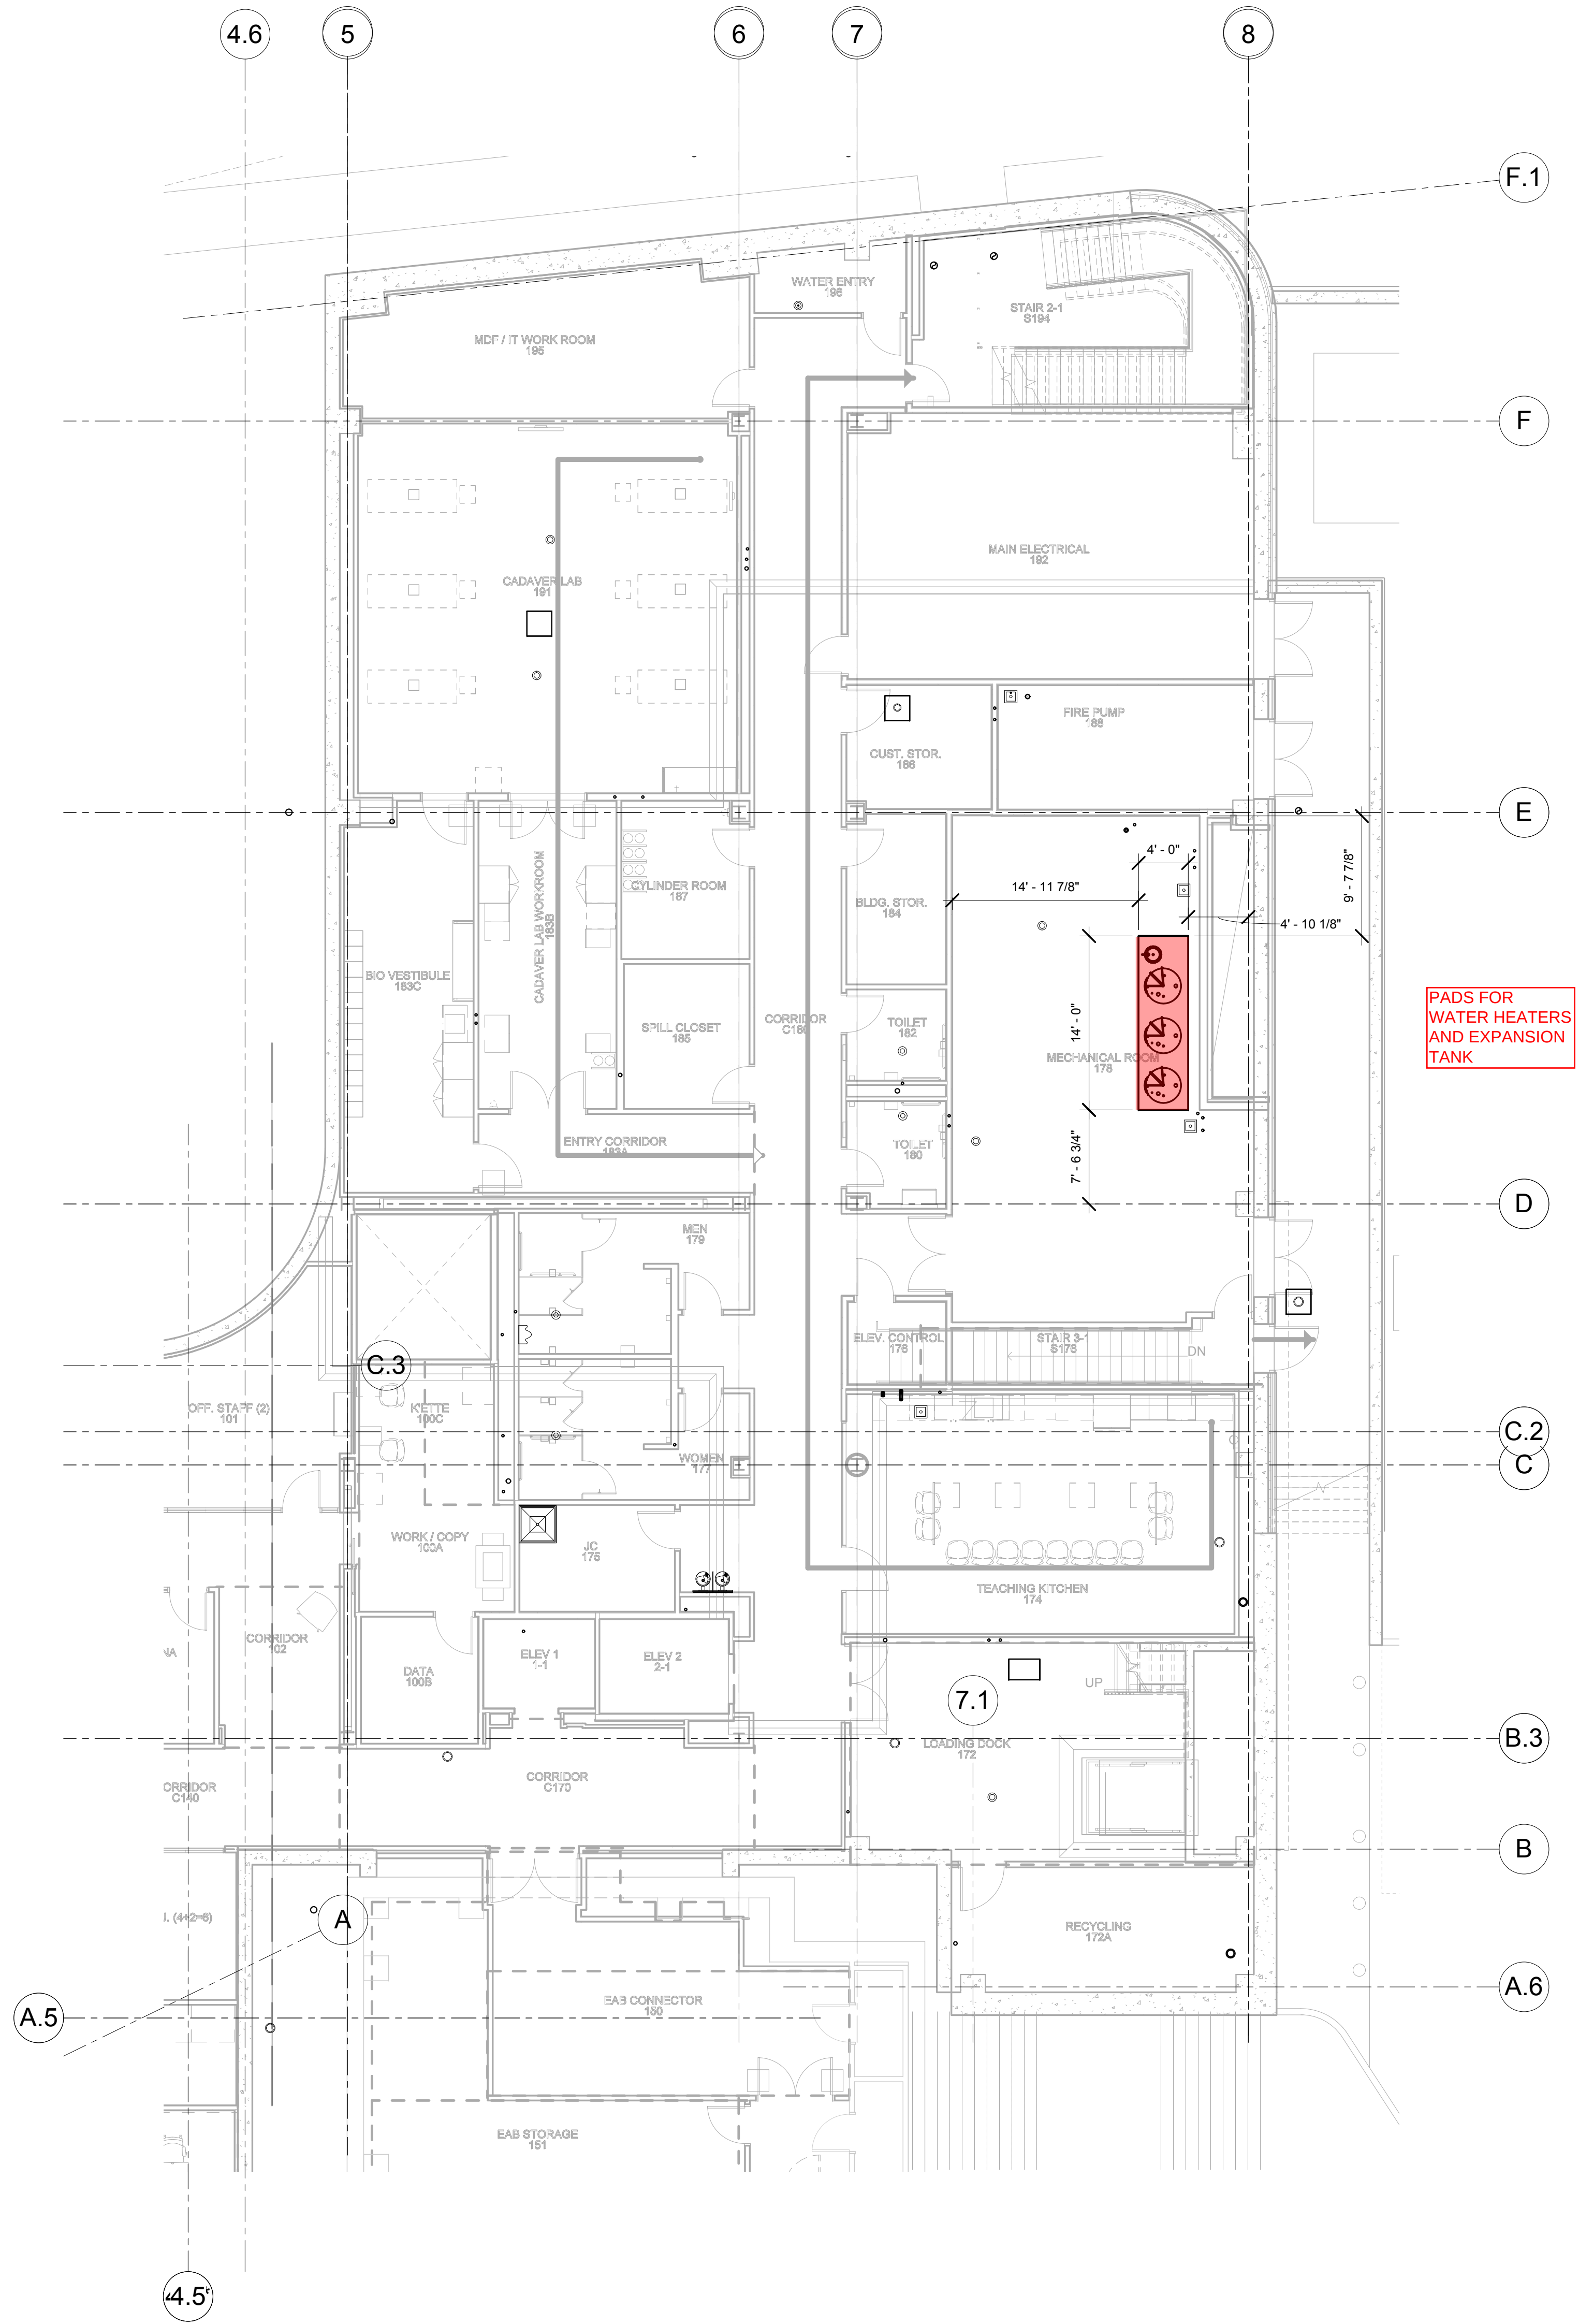

① LEVEL 01 Concrete Pads
1/8" = 1'-0"

No.	Issue Description:	Date:
1	ISSUED TO PARIC	2016.09.13

Drawn by:PCD Checked by:

Facility Index No.:

Sheet Title:
CONCRETE PADS -
PLUMBING

Sheet Number:

P09-01