



PARIC CORPORATION
77 Westport Plaza Suite 250
St. Louis, MO 63146
TEL: 636-561-9500
FAX: 636-561-9501

REQUEST FOR INFORMATION DATE: September 20, 2016 NO.: RFI-290

To: Cannon Design

Attn: Kelvin Patel

From: Paric Corporation

Requested By: Devin Gates

Project Name: 15051-Webster University Interdisciplinary Science Building Project No.: 15051

Subject: Confirm brick ledge dimension

Response Required By: September 27, 2016

Drawing / Spec Reference:

Information Requested:

Please confirm the brick ledge shown on the west view of A0311 is to begin 8' 11" west of F line (see attached sketch)

Response:


Brick ledge should be 9'-0" west of column line F.

ARCHITECT'S RESPONSE:

This information is provided as an interpretation of the Contract Documents for implementation. It is not an authorization for change to the Contract Sum or Contract Time. If this information results in a claim for a change to the Contract, the Contractor shall notify the [Construction Manager][Architect] of a change through the change process.

Answered By: _____

Date: 9/21/16

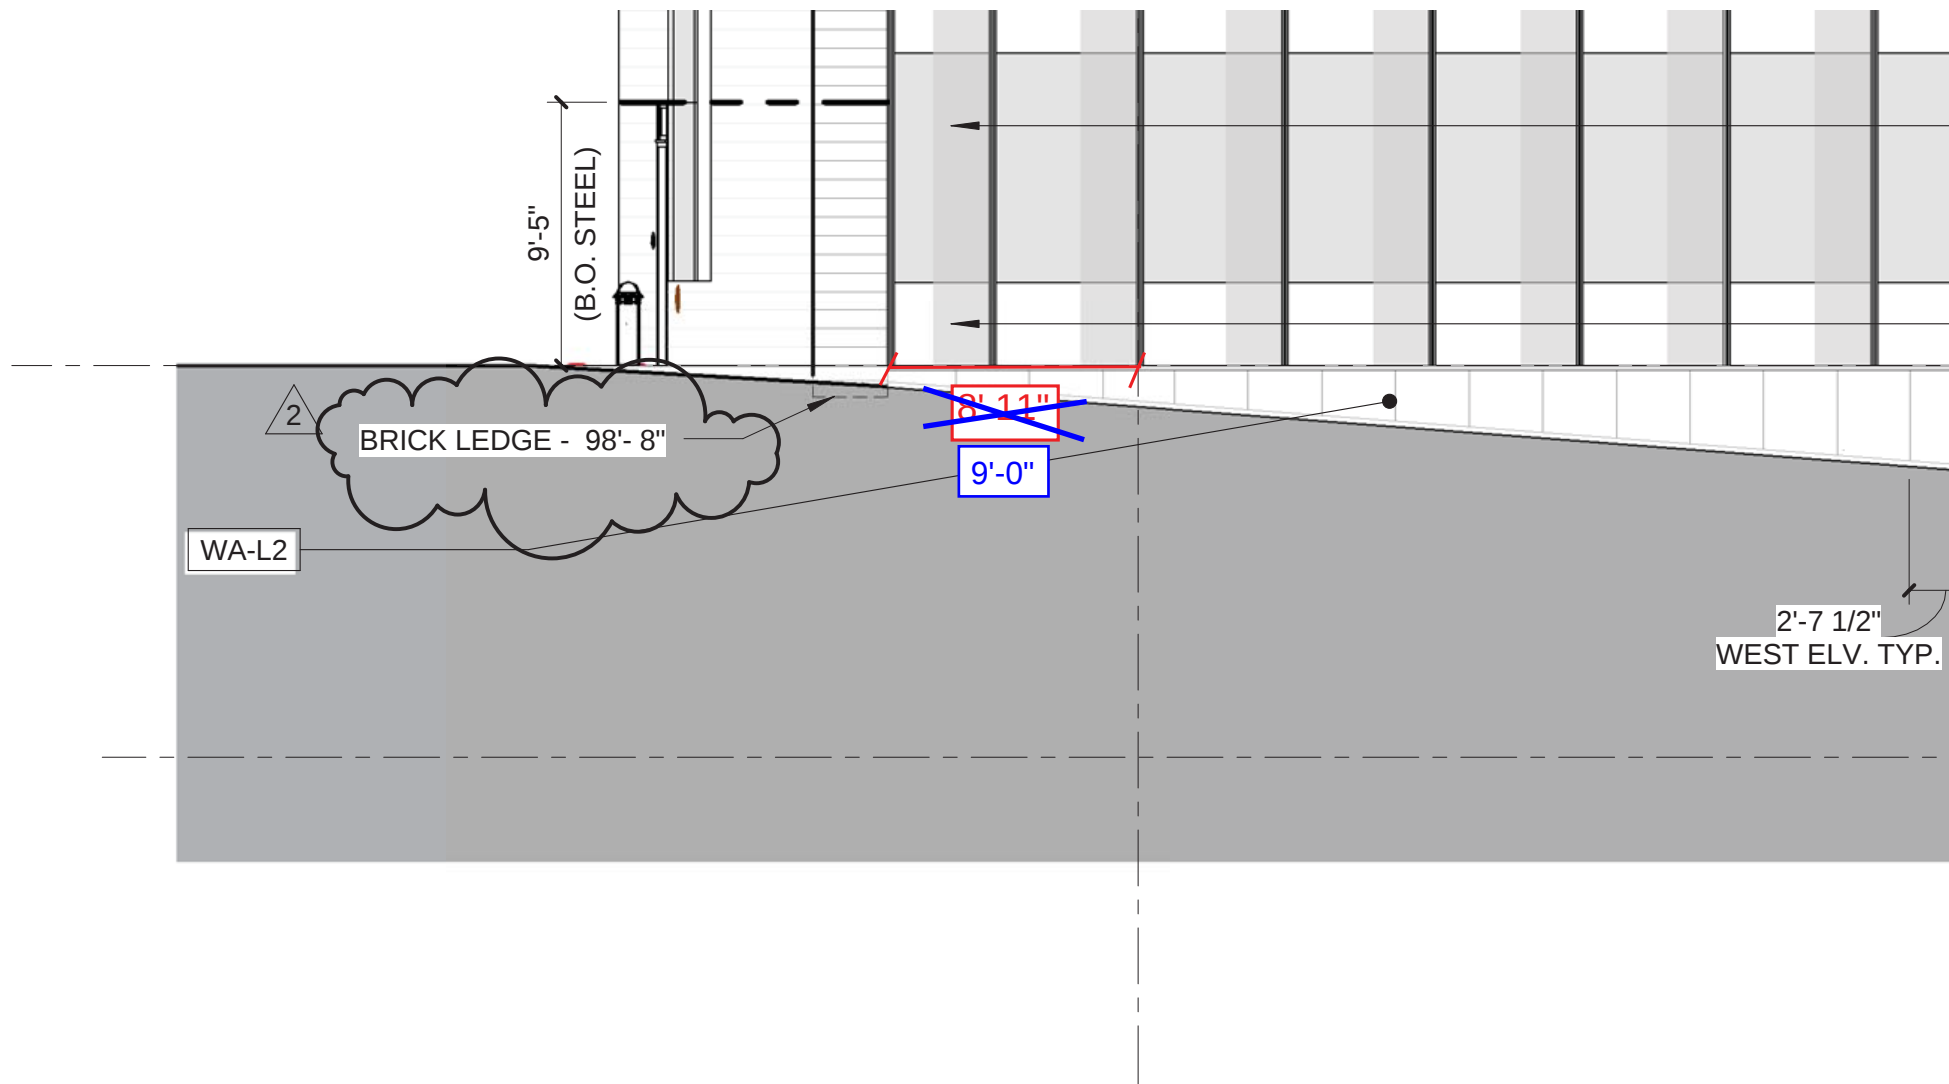

1 WEST ELEVATION

1/8" = 1'-0"