



PARIC CORPORATION
77 Westport Plaza Suite 250
St. Louis, MO 63146
TEL: 636-561-9500
FAX: 636-561-9501

REQUEST FOR INFORMATION	DATE: December 01, 2016	NO.: RFI-368
--------------------------------	--------------------------------	---------------------

To: Cannon Design

Attn: Kelvin Patel

From: Paric Corporation

Requested By: Devin Gates

Project Name:	15051-Webster University Interdisciplinary Science Building	Project No.: 15051
---------------	---	--------------------

Subject: Window shade pocket detail

Response Required By: December 08, 2016

Drawing / Spec Reference:

Information Requested:

Please see the attached marked up architectural detail 12/A0841. This is the shade pocket detail for the double shades at the exterior windows in Conf. room 140 and Lecture Hall 160 on the first floor, as well as Classroom 276, Classroom 231, Classroom 233 and Lab 235. The shade contractor has made necessary revisions to this pocket detail. Please see the attached drawings and shade manufacturers cut sheet.

Suggestion: Please advise if this will be acceptable.

Response:

12/A0841 applies to Lecture Hall 160. Conf Room 140 is similar. No fascia or bottom closure is intended. the shades should be installed exposed . They are at the top of the pocket because of the vision glass in front of them.

The detail provided is not acceptable in these two rooms. We have marked up the attached detail to show a wider pocket to provide additional installation and maintenance space. Narrow width of pocket is being driven by desire to have 10'-3" high soffit extending to edge of column covers. Please confirm that the space is available with the steel angle braces at each room.

Classrooms 231, 233, and Lab 235: Follow schedule in specification - for Shade Type 5. This shade has a full recessed shade pocket. shade to be installed

ARCHITECT'S RESPONSE:


This information is provided as an interpretation of the Contract Documents for implementation. It is not an authorization for change to the Contract Sum or Contract Time. If this information results in a claim for a change to the Contract, the Contractor shall notify the [Construction Manager][Architect] of a change through the change process.

We'd be happy to discuss this condition - we understand that there are many constraints this location.

We have also attached a photo of a similar condition with shades exposed in a pocket at vision glass for your reference.

Answered By: LYNN GROSSMAN

Date: 12.09.16

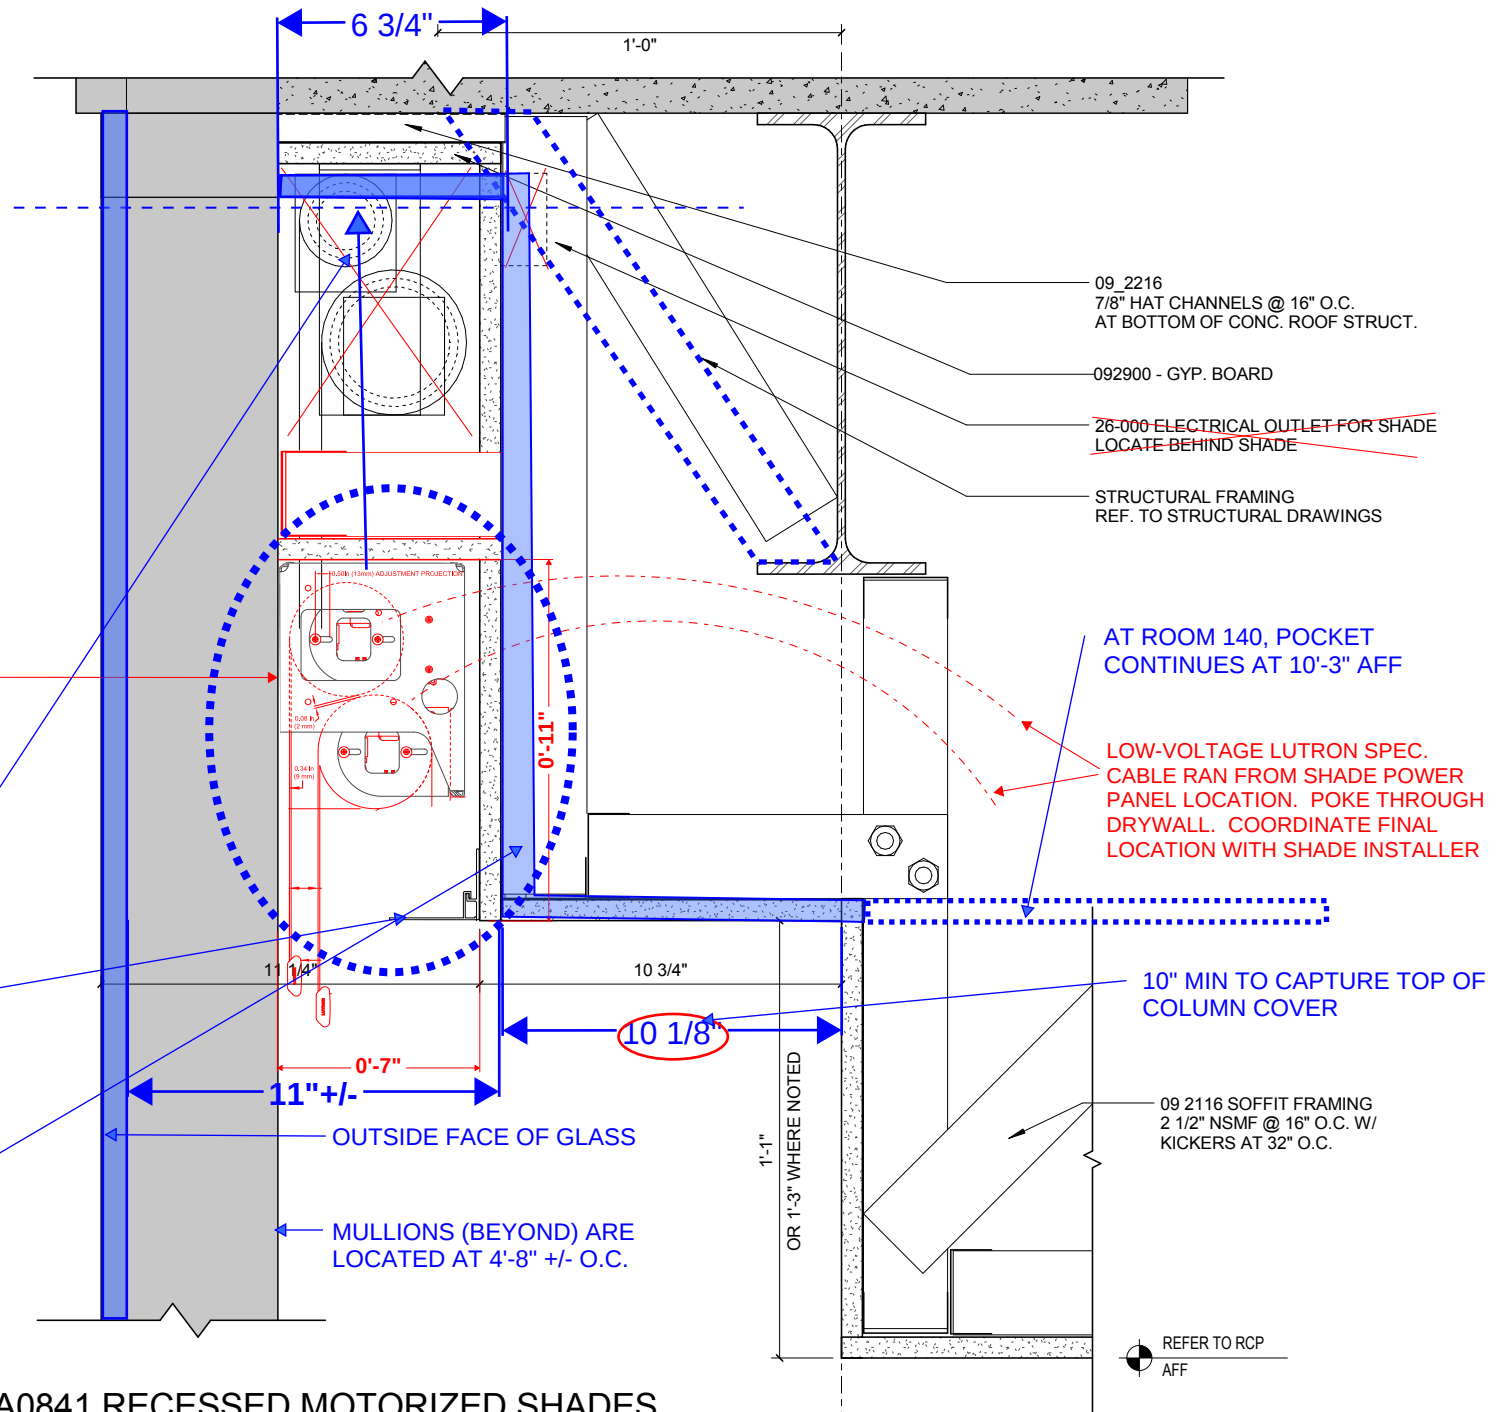

12
A0841

A0841 3" = 1'-0"

A0841 RECESSED MOTORIZED SHADES

(TYP. ROOMS: 140 & 160)

(C.2)

122413 TYPE 2 SHADES MOTORIZED DOUBLE ROLLER SHADES: SURFACE
MOUNTED W/ CUSTOM COLOR FASCIA FOLLOW SCHEDULE IN SPECIFICATION: NO FASCIA REQUIRED -
PAINT EXPOSED BRACKETS TO MATCH CURTAINWALL

ROLLER SHADE DETAIL DRAWING


SCALE: 1/2

0051-R100-DMT-S

ROLLER 100 / 200CW - DUAL BRACKET MOUNT
REV: A
DRAWING #

Lutron Electronics Co., Inc.
7200 Sutter Road | Coopersburg, PA 18036 | USA
1(800) 446-1503 | fax: (610) 282-7439
shadinginfo@lutron.com

LUTRON
Copyright © 2009 Lutron Electronics Co., Inc.

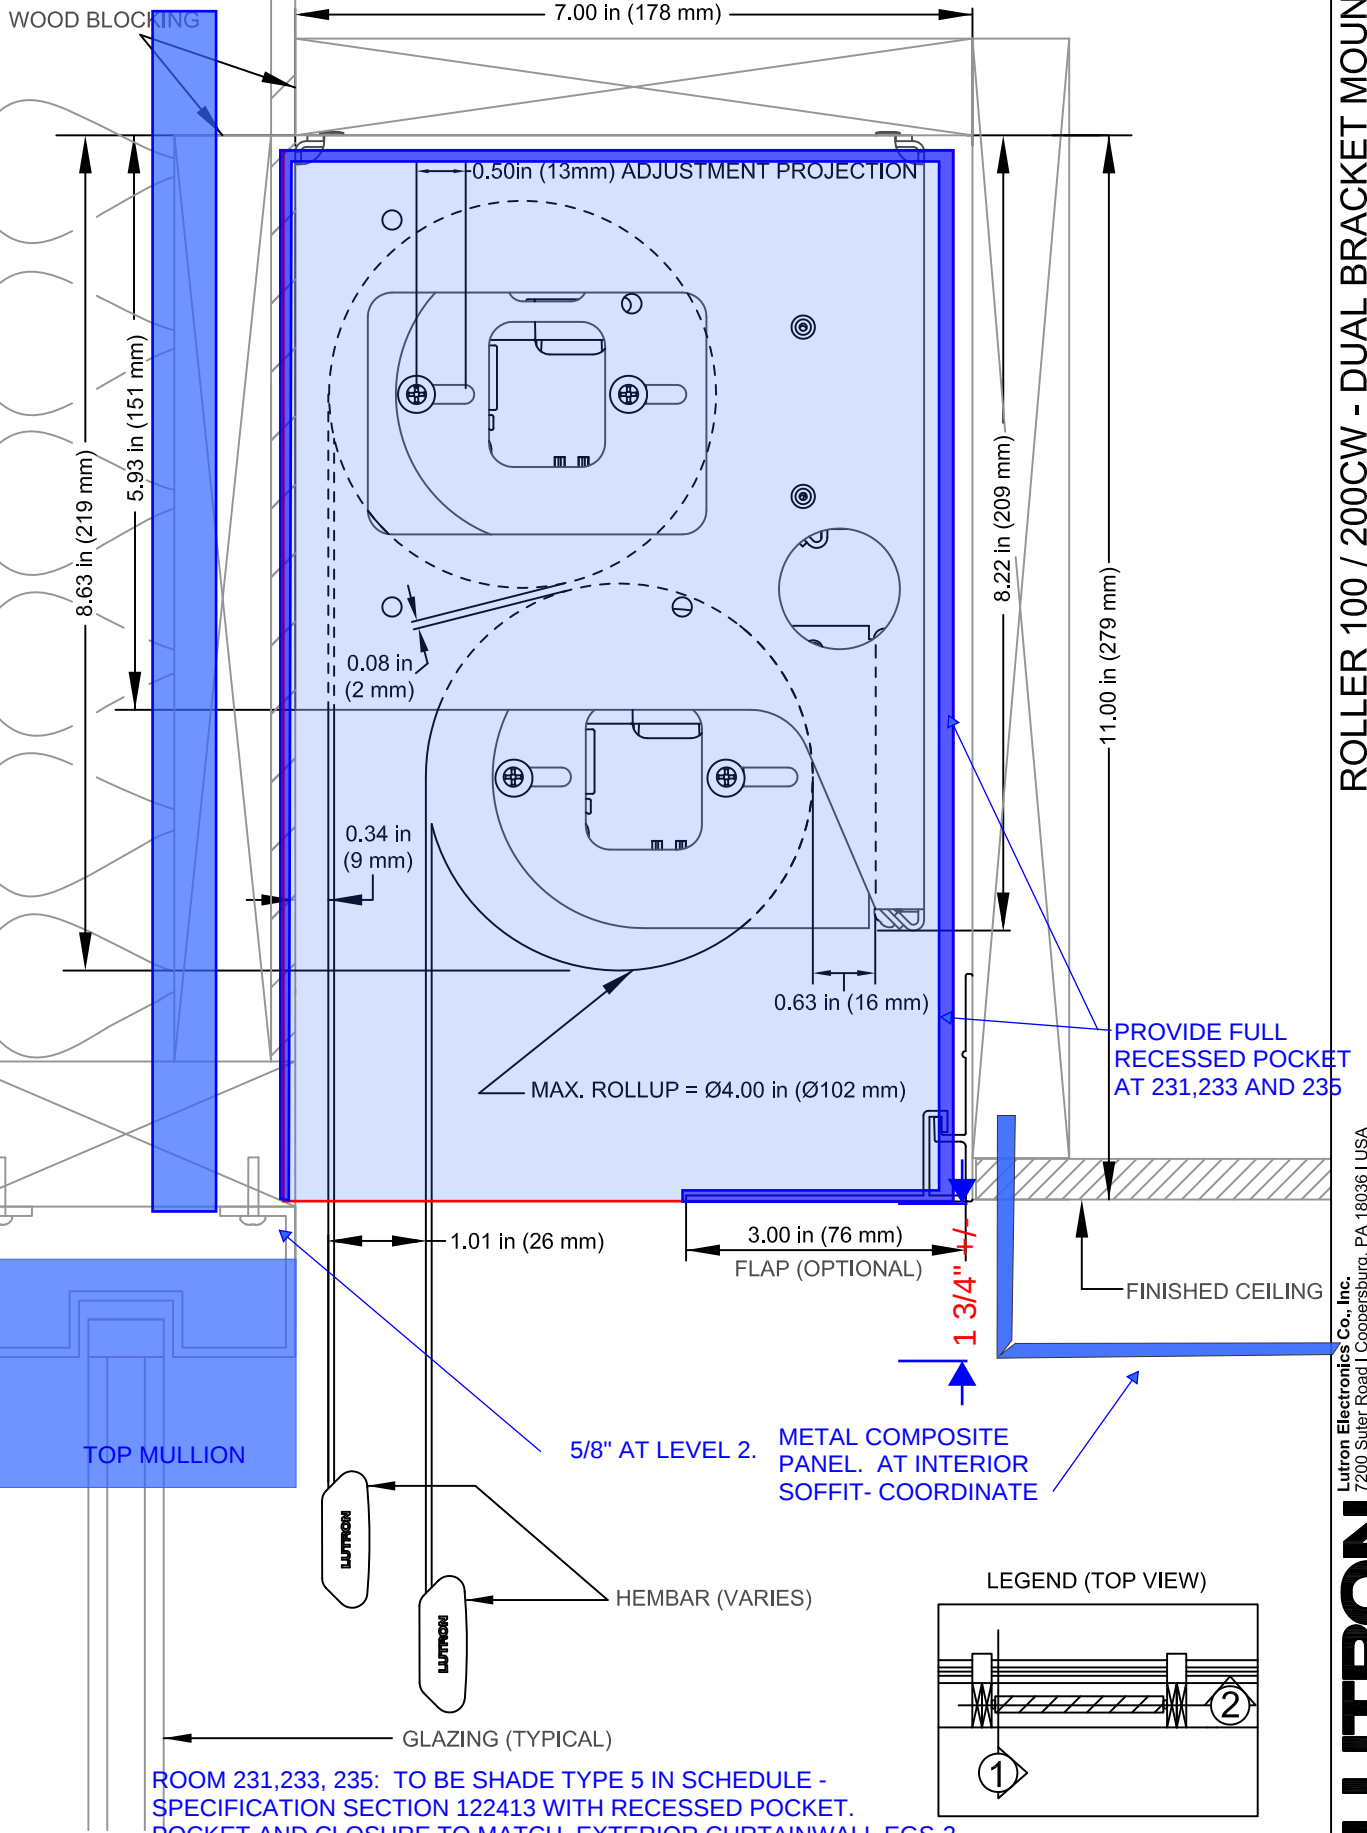

TYPICAL SECTION

SCALE: 1/2

1

EXAMPLE OF SHADE EXPOSED IN
POCKET

