



PARIC CORPORATION
77 Westport Plaza Suite 250
St. Louis, MO 63146
TEL: 636-561-9500
FAX: 636-561-9501

REQUEST FOR INFORMATION **DATE:** December 05, 2016 **NO.:** RFI-370

To: Cannon Design

Attn: Kelvin Patel

From: Paric Corporation

Requested By: Devin Gates

Project Name: 15051-Webster University Interdisciplinary Science Building Project No.: 15051

Subject: Additional guard rail details at retaining wall

Response Required By: December 12, 2016

Drawing / Spec Reference:

Information Requested:

See attached markup.

1. Please advise rail details to be used for the 3'-6" high railings, shown north and south of the Emergency Generator (near lines F – 8). **USE RAILING DETAILS ON 1/A0508.E. COLOR TO MATCH CURTAINWALL MULLIONS.**
2. Please advise the details, extents and elevations for the 'long' 3'-6" high rail' shown approximately 10'-9" east of line 8, from line C to nearly line F. (Ref: Paric RFI #291) **PROVIDE RAILING PER RAILING DETAILS ON 1/A0508.E. COLOR TO MATCH CURTAINWALL MULLIONS.**
3. Please advise sections and details to be used for the concrete steps with ~~painted~~ galvanized rails shown near lines C – 8. **RAILING DETAILS SIMILAR TO RAILINGS ON 1/A0505 & 3/A0505. COLOR TO MATCH CURTAINWALL MULLIONS. RAILING TO BE POWDER COATED GALVANIZED STEEL.**


Response:

ARCHITECT'S RESPONSE:

This information is provided as an interpretation of the Contract Documents for implementation. It is not an authorization for change to the Contract Sum or Contract Time. If this information results in a claim for a change to the Contract, the Contractor shall notify the [Construction Manager][Architect] of a change through the change process.

Answered By: Kelvin Patel

Date: 12/12/2016

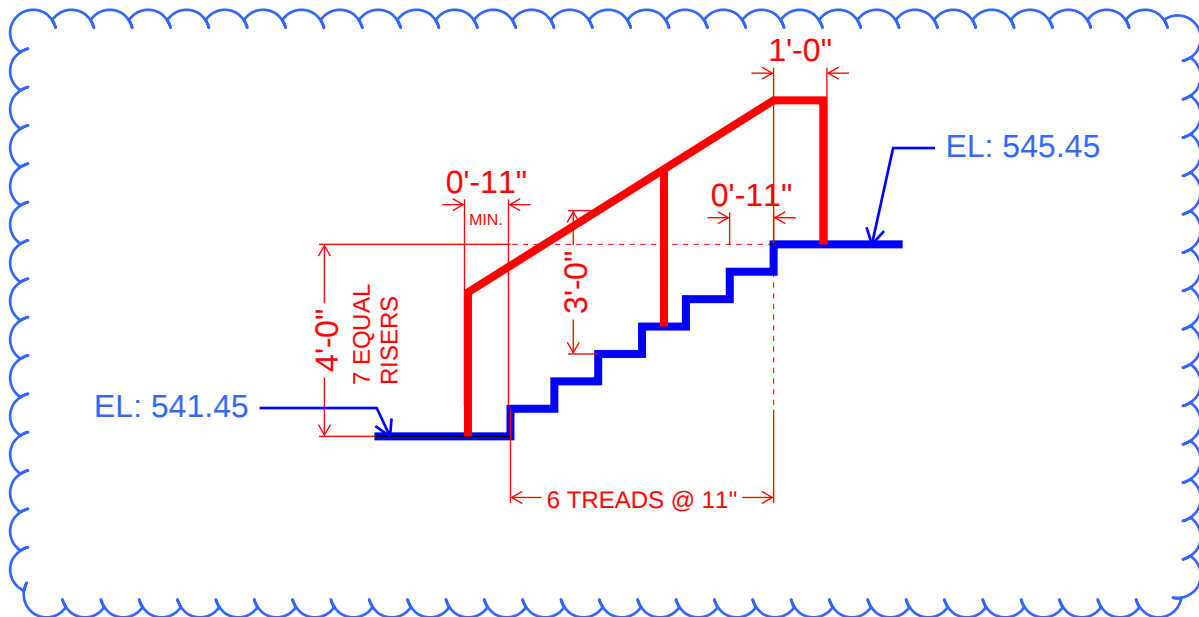

RAILINGS AT COL. LINE C & 8:


RAILING DETAILS SIMILAR TO RAILINGS ON 1/A0505 & 3/A0505.

COLOR TO MATCH CURTAINWALL MULLIONS.

RAILING TO BE 1 1/2" O.D. POWDER COATED GALVANIZED STEEL.

CONFORMED SET 01 JUL 2016

1	ADDENDUM 3-1	05 APR 2016
-	ISSUED FOR CONSTRUCTION (BP3)	15 MAR 2016
No.	Description	Date

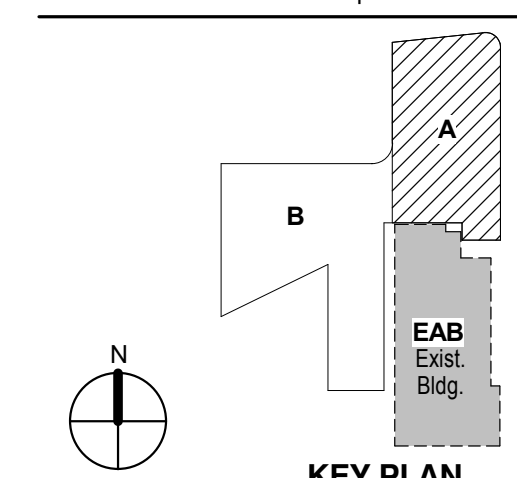


**LEVEL 01 AREA A FLOOR
PLAN**

Project No.: 04561.01 Checked by:

A0101.A

© Cannon Design 2015

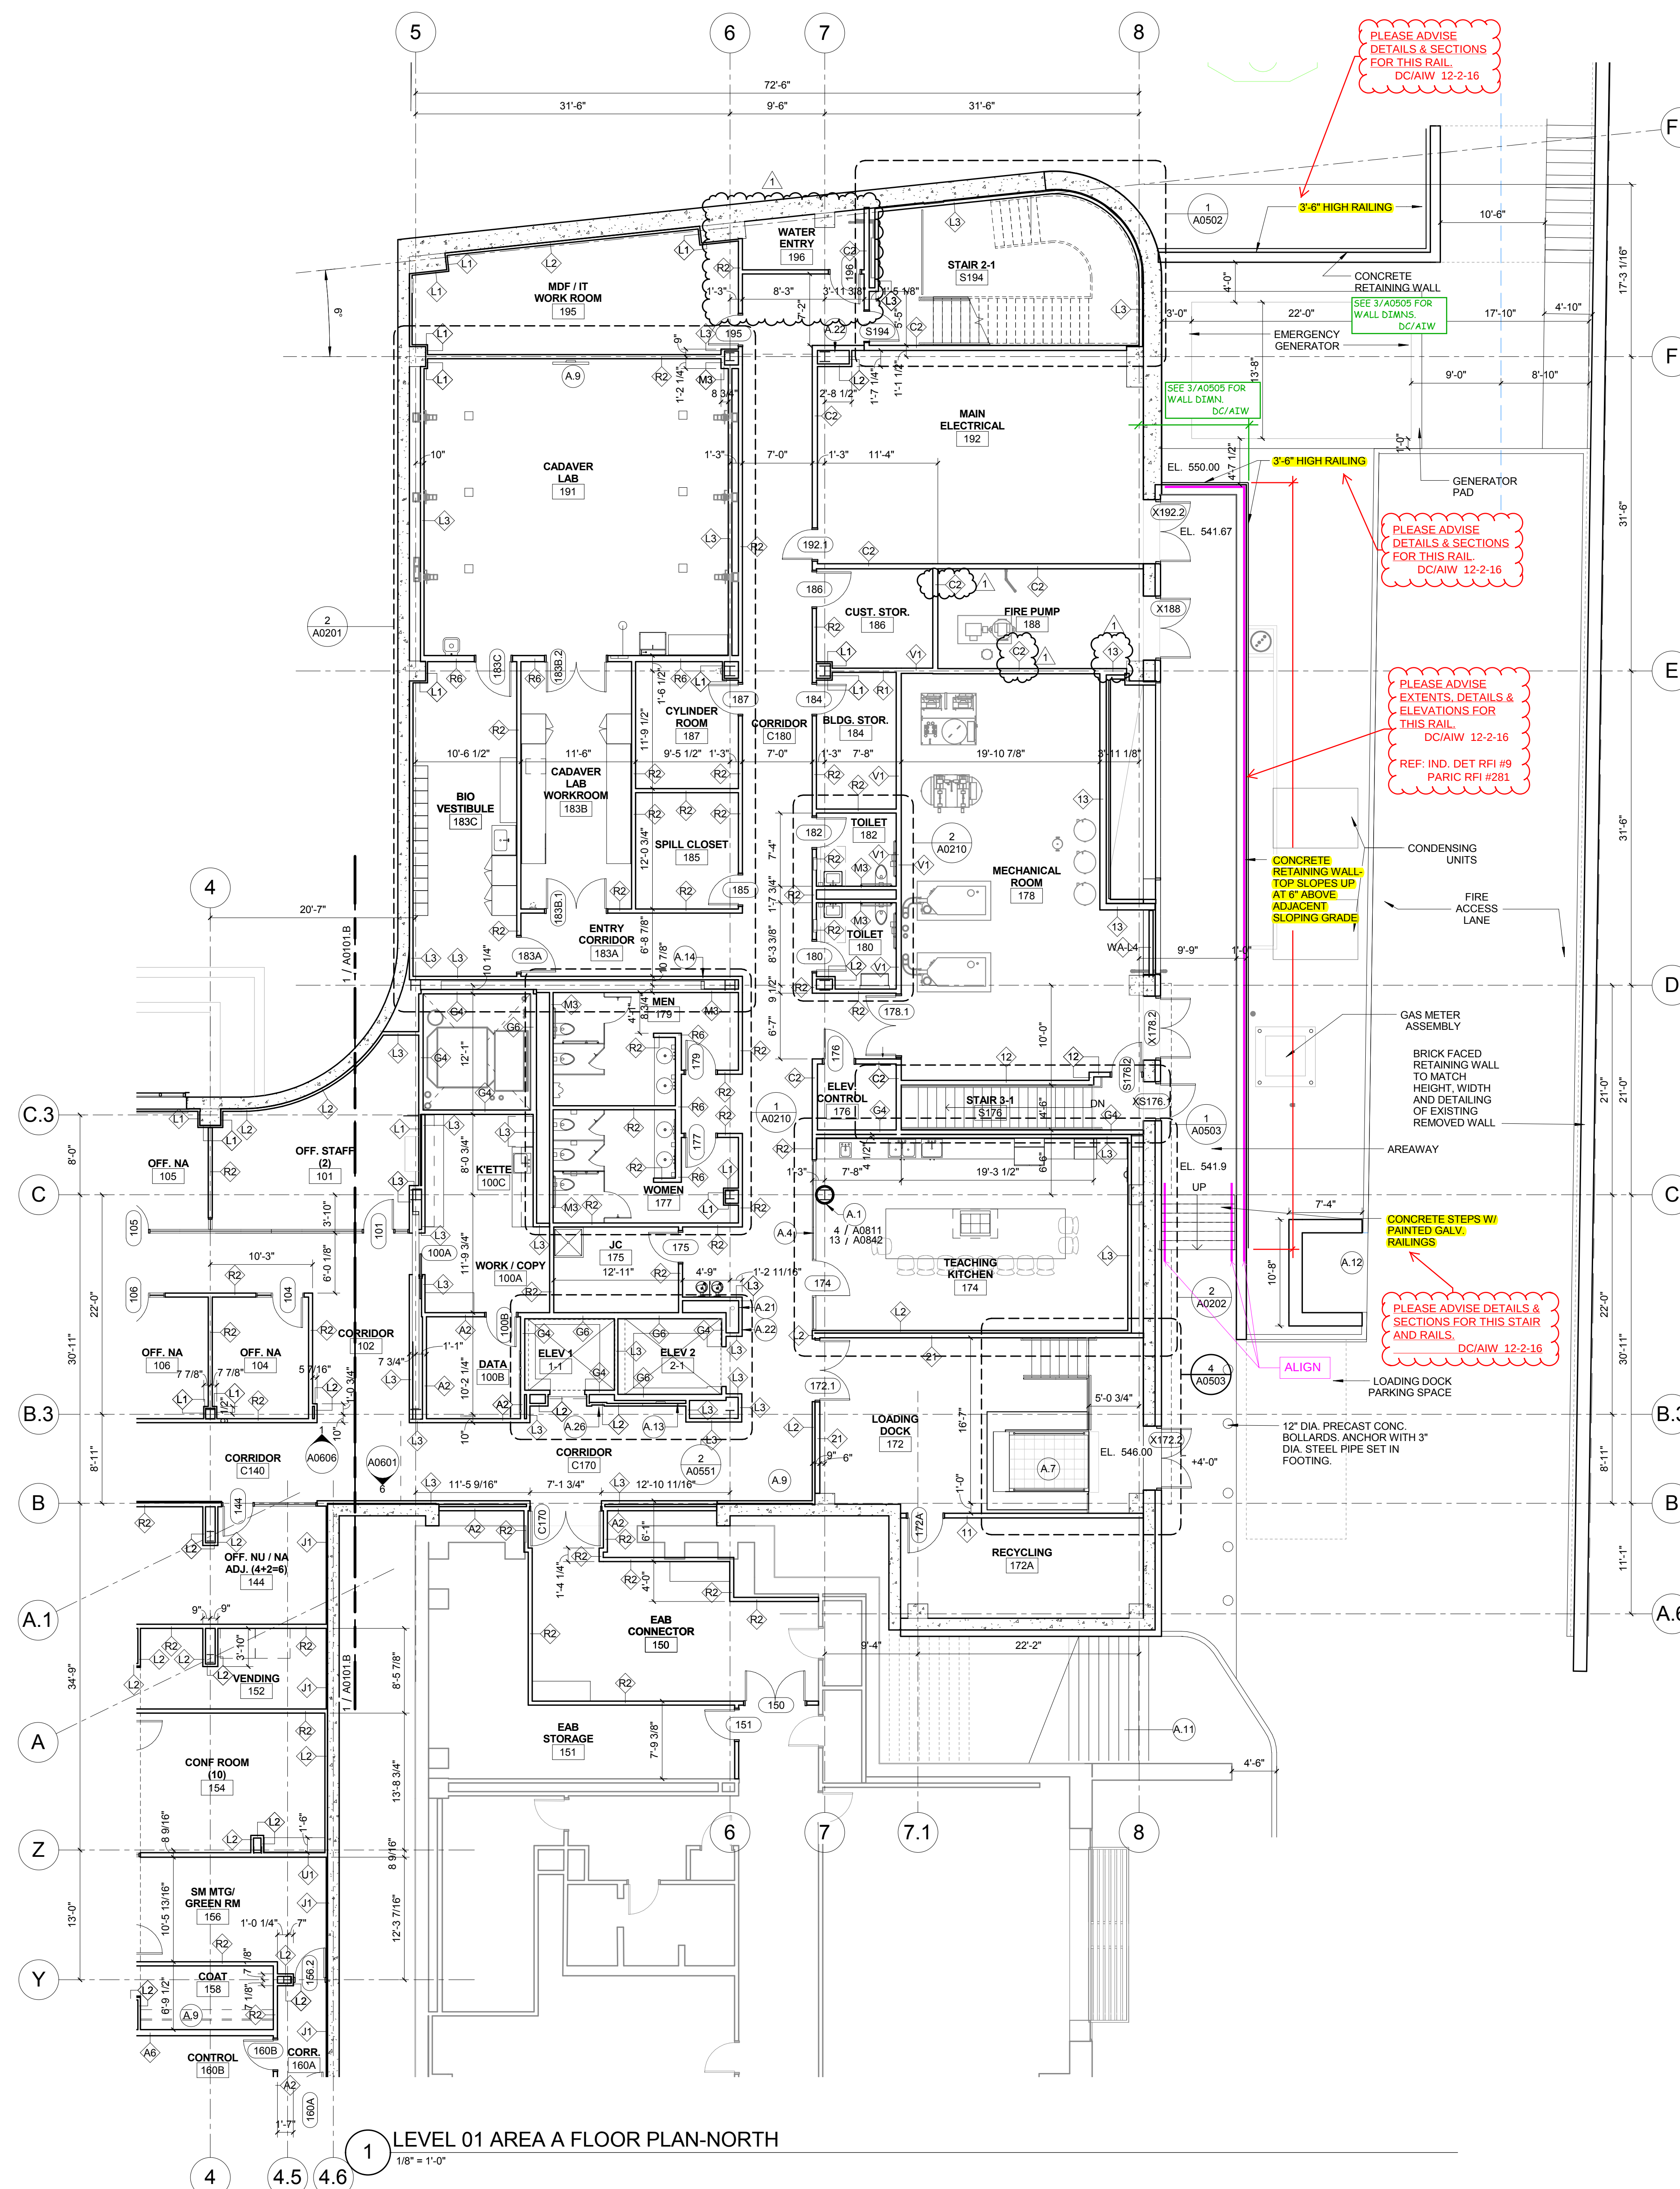

© Cannon Design 2015
All rights reserved. No part of this document may
be reproduced or utilized in any form, without prior
written authorization by The Cannon Corporation.
4/5/2016 8:54:05 PM