



PARIC CORPORATION
77 Westport Plaza Suite 250
St. Louis, MO 63146
TEL: 636-561-9500
FAX: 636-561-9501

REQUEST FOR INFORMATION **DATE:** January 04, 2017 **NO.:** RFI-396

To: Cannon Design

Attn: Kelvin Patel

From: Paric Corporation

Requested By: Devin Gates

Project Name: 15051-Webster University Interdisciplinary Science Building Project No.: 15051

Subject: Layout of teaching walls based off of grid lines

Response Required By: January 11, 2017

Drawing / Spec Reference:

Information Requested:

Please provide North/South dimensions for the teaching walls shown in the following rooms

383
391 (or confirm the north face of wall is 1'-3" north of F line) YES
388
383
378
491
488
483
480
472

Please confirm if the ^{1'-8"}~~4'-9"~~ and 1'0" dimensions given east and west from gridlines 6 and 7 are typical at all locations.

YES. EXCEPT AT ROOM 378 DUE TO AQUARIUM - MIGHT MOVE EAST TO ACCOMMODATE A WIDER TANK AND ROOM 472.

Response:

SEE ATTACHED MARKUPS.

ARCHITECT'S RESPONSE:

This information is provided as an interpretation of the Contract Documents for implementation. It is not an authorization for change to the Contract Sum or Contract Time. If this information results in a claim for a change to the Contract, the Contractor shall notify the [Construction

Answered By: Kelvin Patel


Date: 01/12/2017



Manager][Architect] of a change through the change process.

Answered By: _____

Date: _____

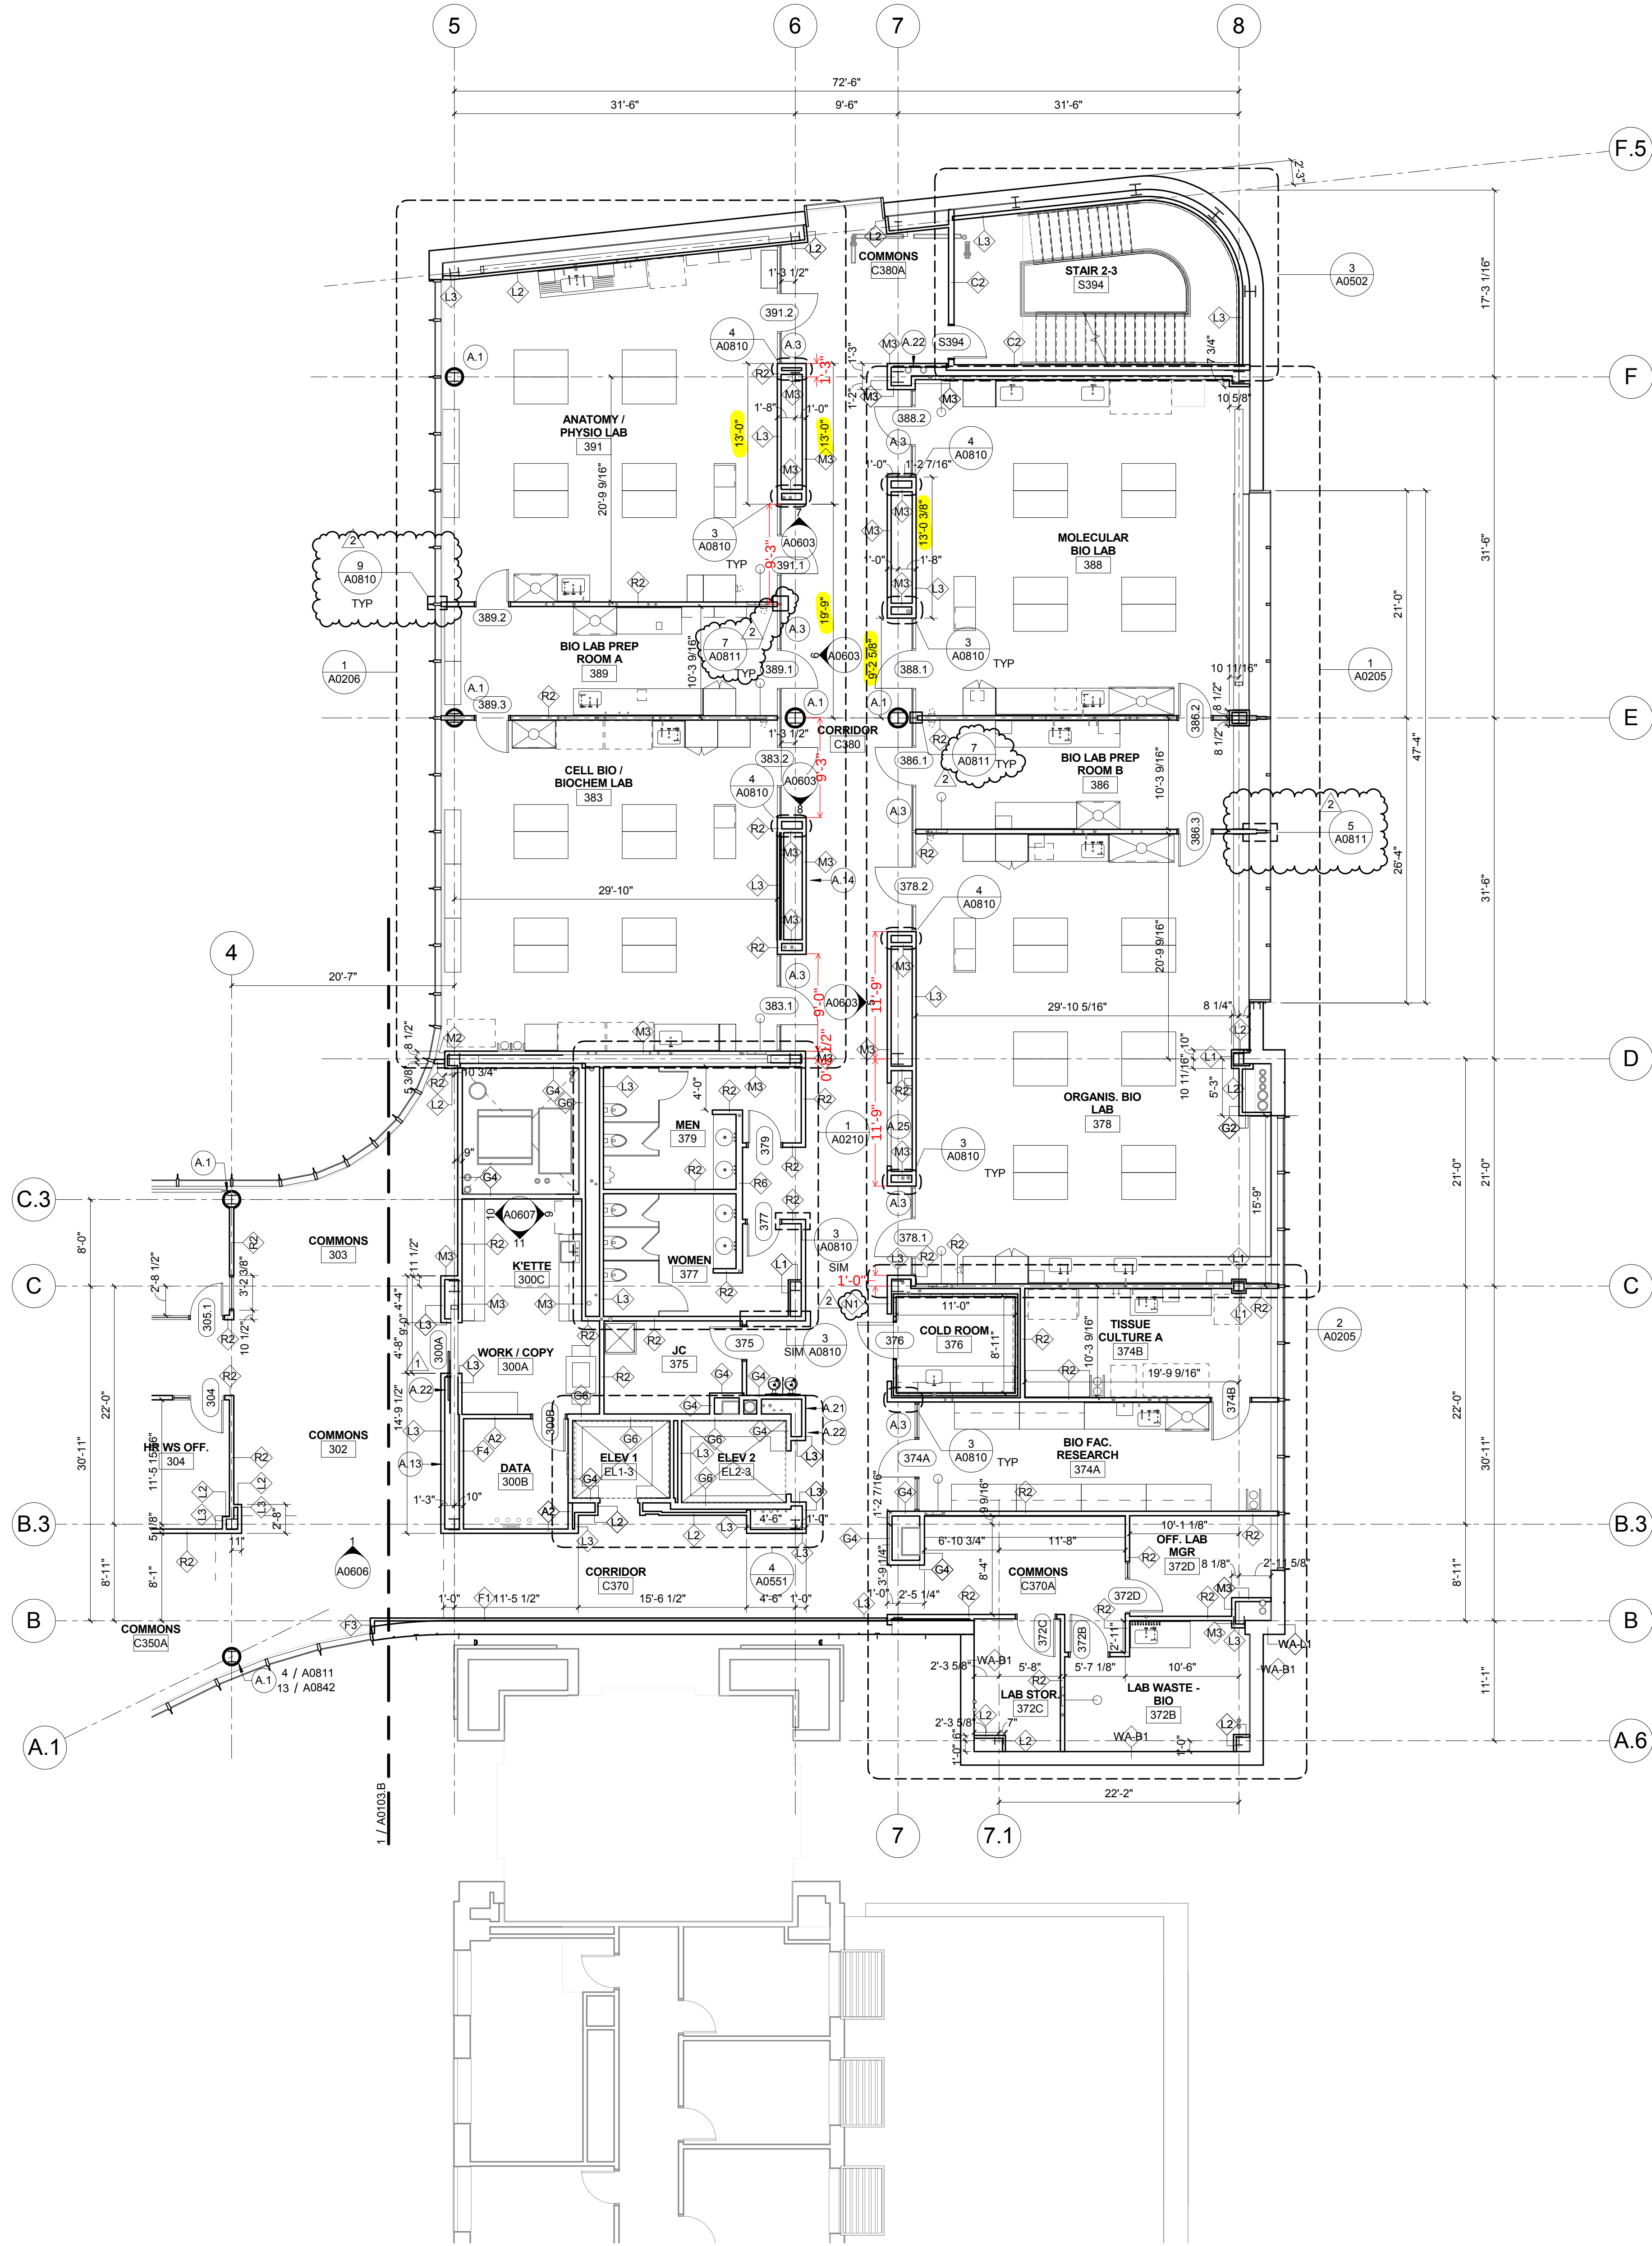


1 LEVEL 03 AREA A - NORTH FLOOR PLAN
1/8" = 1'-0"

- KEYED NOTE LEGEND - PLAN**
- A.1 092700 GRG COLUMN COVER TO 3" ABOVE CEILING - 20" DIA. TYP. SEE DETAIL 4/A0811 AND 13/A0842.
 - A.2 081216 INTERIOR GLAZING SYSTEM: IGS-1. REFER TO TYPICAL INT. ELEVATIONS 1 AND 2 ON SHEET A0803
 - A.3 081216 INTERIOR GLAZING SYSTEM IGS-2. SEE TYPICAL ELEVATION 5 AND 6 A0603
 - A.4 081216 INTERIOR GLAZING SYSTEM: IGS-3. REFER TO INTERIOR ELEVATIONS
 - A.5 088813 FIRE RATED GLAZING- 120 MIN. FIRE RATED GLAZING 10'-0" HIGH. BASIS OF DESIGN: VETROTECH CONTRAFILAMM STRUTTURA - WITH BUTT JOINTS AND PERIMETER FRAMING
 - A.6 088813 FIRE RATED GLAZING AND FRAME- 120 MIN. FIRE RATED GLAZING 1'-8" HIGH X 5'-0" WIDE. BASIS OF DESIGN: VETROTECH CONTRAFILAMM WITH PERIMETER FRAMING
 - A.7 111519 LOADING DOCK LIFT - STATIONARY - 6W X 8' DEEPW/ 14" PIT
 - A.8 ALTERNATING TREAD STAIRWAY UP TO ROOF HATCH
 - A.9 UNDERSLAB DRAINAGE SYSTEM PER OWNER'S GEOTECHNICAL CONSULTANT RECOMMENDATION TYPICAL ALL SLAB ON GRADE AREAS
 - A.11 NEW CONCRETE STEPS TO MATCH EXISTING REMOVED FOR CONSTRUCTION
 - A.12 553006 BRICK FACED CONCRETE DUMPSTER ENCLOSURE TOP OF WALL
 - A.13 LCD SIGNAGE SCREEN IN WALL RECESS (OFCI)
 - A.14 MARKERBOARD SURFACE
 - A.15 WOOD SCREEN W/ SOLID LUMBER
 - A.17 VIDEO WALL - 24 55" SCREENS
 - A.18 LCD SCREEN LOCATION (OFOI)
 - A.19 AIR PLENUM - INSULATED PLENUM CONSTRUCTION BY DIVISION 23
 - A.20 122200 CURTAIN LOCATION
 - A.21 104313 AED CABINET LOCATION
 - A.22 10 4413 FEC WITH FIRE EXTINGUISHER
 - A.23 08 4423 SULL SASH LOCATION: PROVIDE 1/4" TEMPERED CLEAR GLAZING AT INTERIOR FACE OF CURTAIN WALL MULLIONS FOR ACOUSTICAL SEPARATION.
 - A.24 6" X 8" FORMED CONCRETE TRENCH IN FLOOR W/ METAL PLATE COVER. PROVIDE BLIND SIDE WATERPROOFING
 - A.25 BUILT IN SALT WATER FISH TANK LOCATION. SIZE APPROX. 7'-6" X 2'-4" X 2'-6" HIGH. LOW IRON GLASS VIEW WINDOW ON CORRIDOR SIDE. SLIDING DOOR ON LAB SIDE. FISH TANK EQUIPMENT BELOW TANK W/ CABINET DOOR ACCESS ON LAB SIDE. FINISHED INTERIOR FACE OF WALLS AND CEILING INSIDE CAVITY W/ WATER RESISTANT GYP BOARD AND EPOXY PAINT.
 - A.26 LCD SIGNAGE SCREEN IN WALL RECESS (OFCI)
 - A.27 CONSTRUCT 2 HOUR RATED SEPARATION BETWEEN BOTTOM OF STAIR AND UTILITY PIPING CROSSING THIS AREA. USE HORIZ. GYP BD. ENCLOSURE ON SHEET A1002

CONFORMED SET 01 JUL 2016

2	ADDENDUM 3-2	15 APR 2016
1	ADDENDUM 3-1	06 APR 2016
-	ISSUED FOR CONSTRUCTION (BP3)	15 MAR 2016
No.	Description	Date

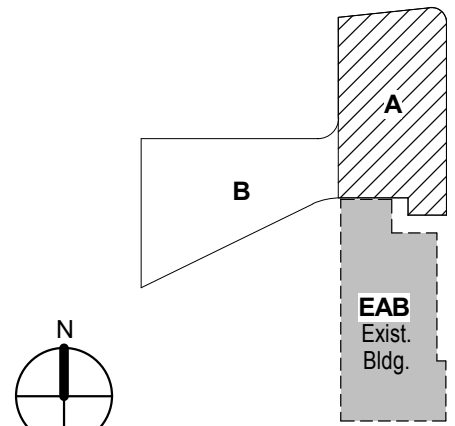


KEY PLAN

LEVEL 03 AREA A FLOOR PLAN

Project No.: 04561.01 Checked by:

A0103.A

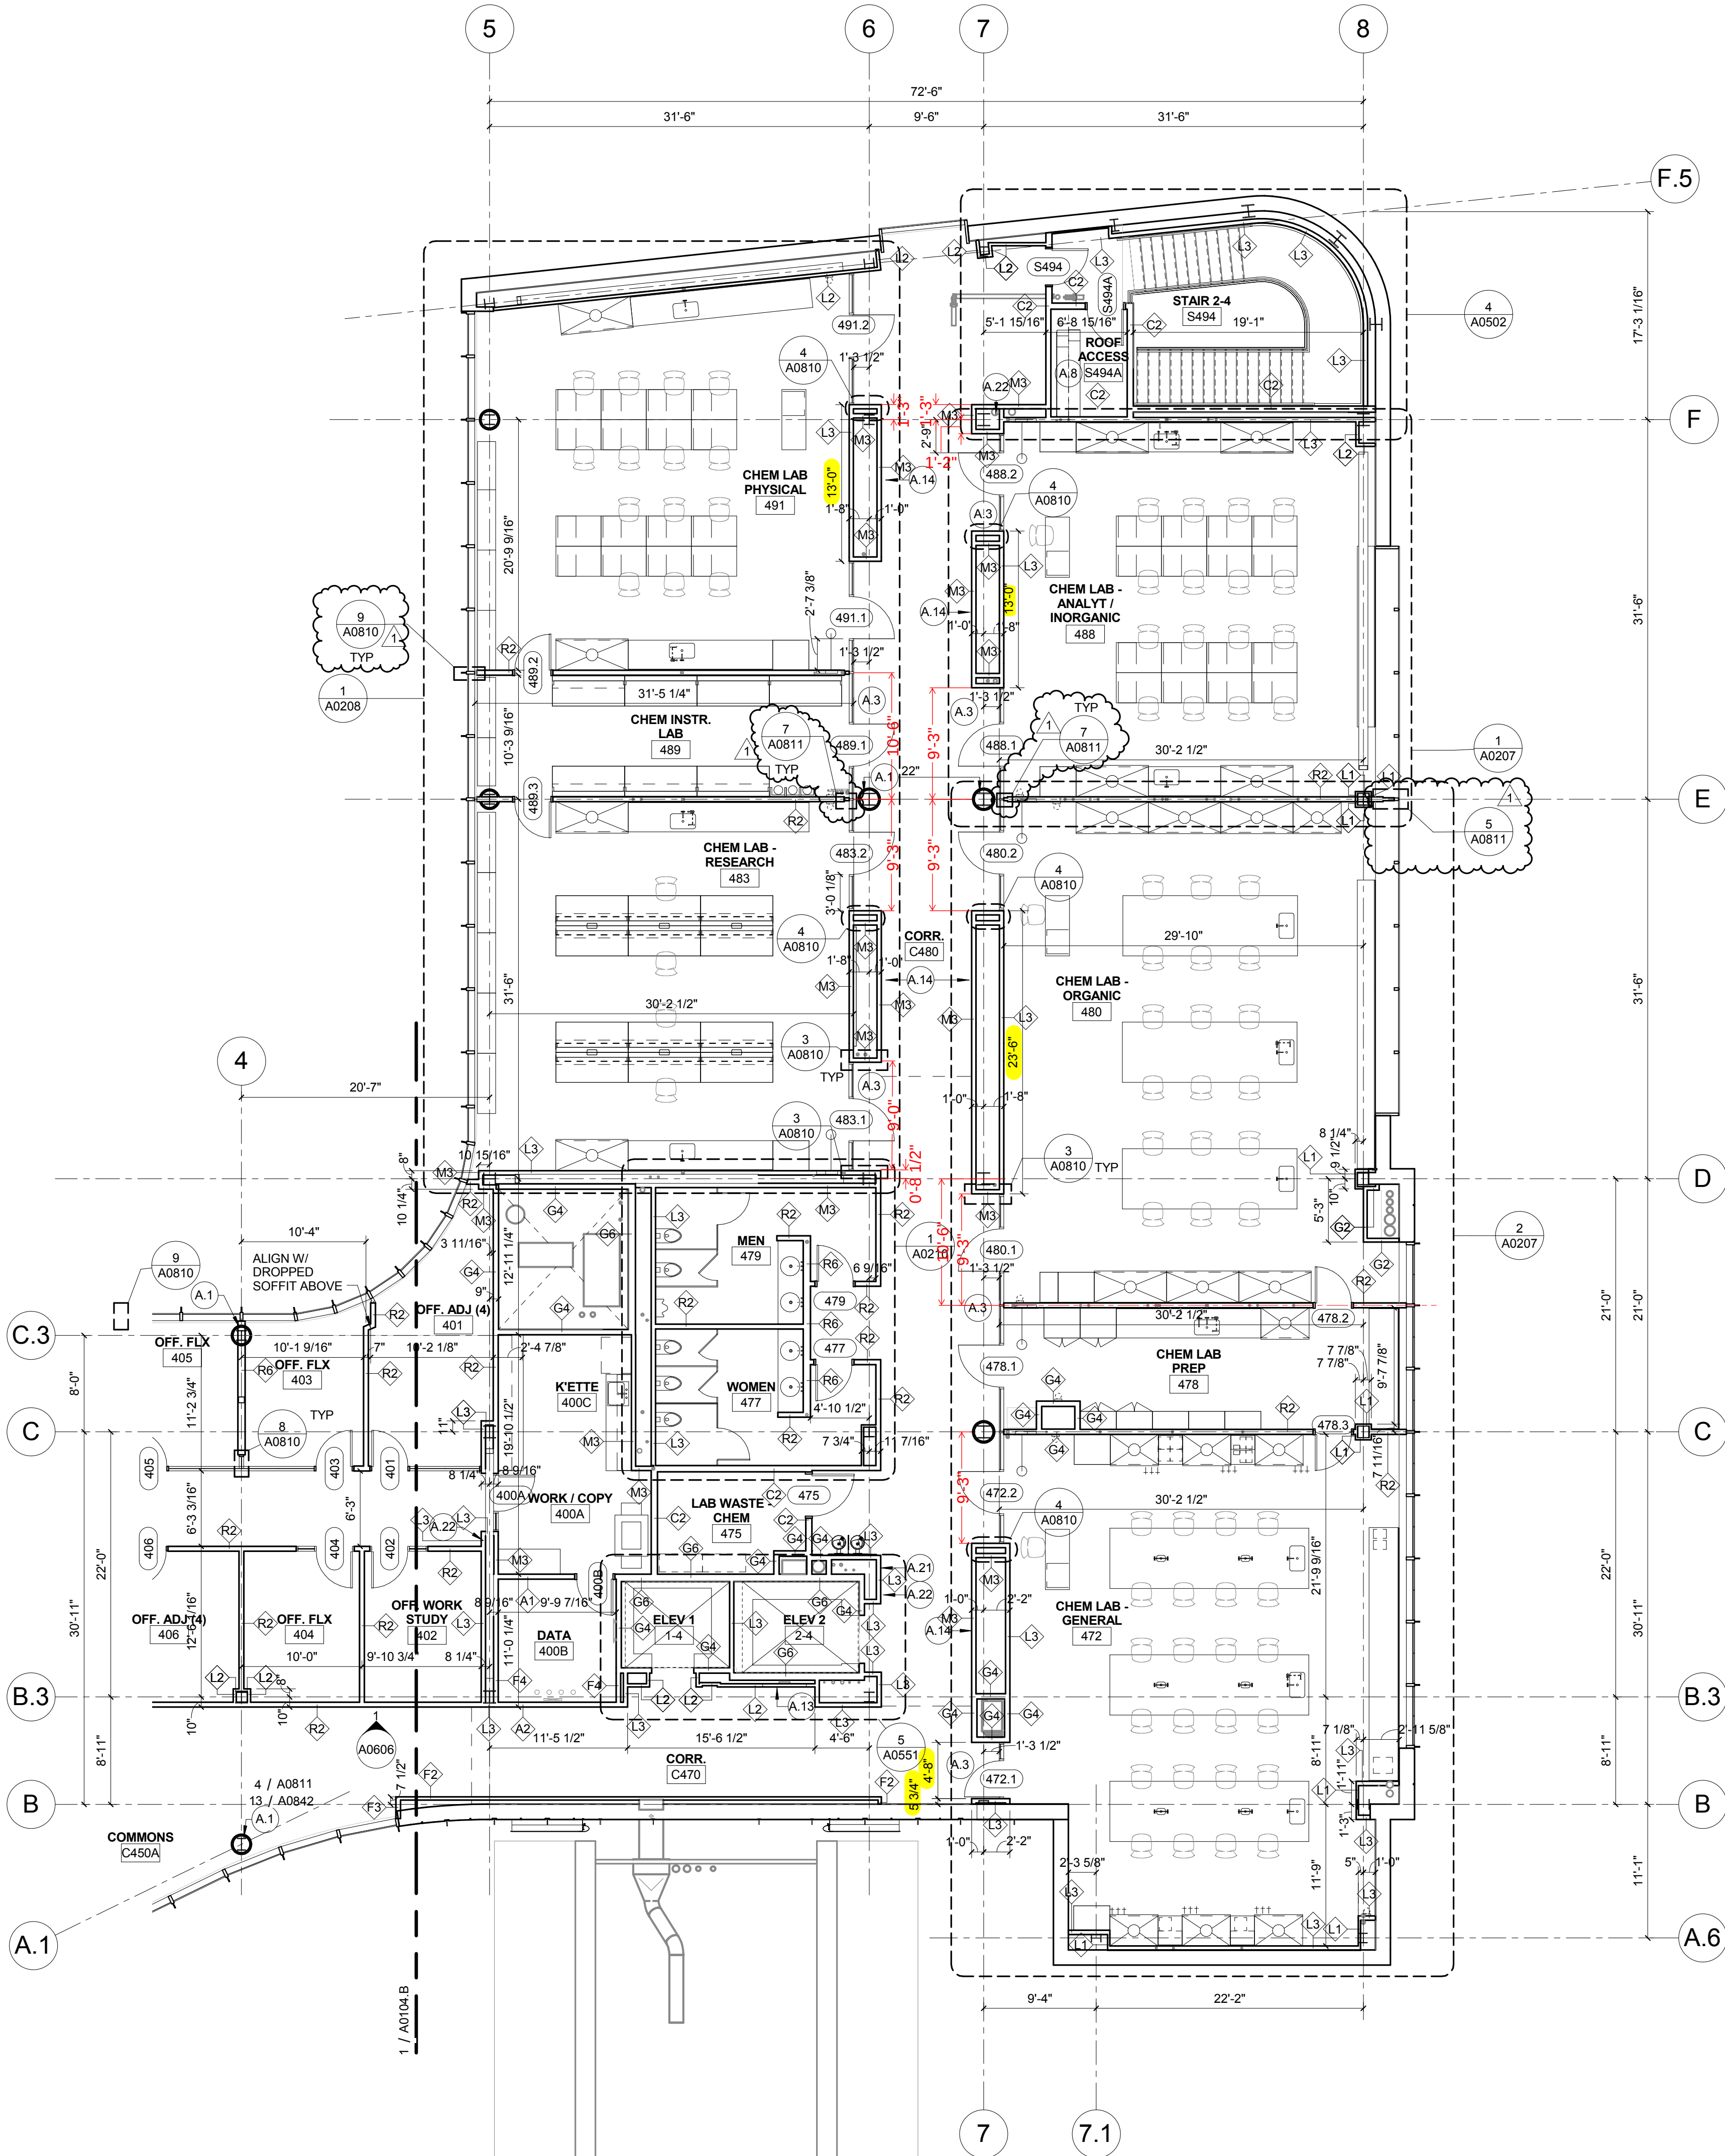


1 A-FL04-96 - AREA A
1/8" = 1'-0"

- KEYED NOTE LEGEND - PLAN**
- A.1 092709 GRG COLUMN COVER TO 3" ABOVE CEILING - 20" DIA. TYP. SEE DETAIL 4/A0811 AND 13/A0842.
 - A.2 081216 INTERIOR GLAZING SYSTEM: IGS-1: REFER TO TYPICAL INT. ELEVATIONS 1 AND 2 ON SHEET A0803
 - A.3 081216 INTERIOR GLAZING SYSTEM IGS-2: SEE TYPICAL ELEVATION 5 AND 6 A0603
 - A.4 081216 INTERIOR GLAZING SYSTEM: IGS-3: REFER TO INTERIOR ELEVATIONS
 - A.5 088813 FIRE RATED GLAZING- 120 MIN. FIRE RATED GLAZING 10'-0" HIGH. BASIS OF DESIGN: VETROTECH CONTRAFILAMM STRUTTURA - WITH BUTT JOINTS AND PERIMETER FRAMING.
 - A.6 088813 FIRE RATED GLAZING AND FRAME- 120 MIN. FIRE RATED GLAZING 1'-8" HIGH X 5'-0" WIDE. BASIS OF DESIGN: VETROTECH CONTRAFILAMM WITH PERIMETER FRAMING.
 - A.7 111519 LOADING DOCK LIFT - STATIONARY - 6W x 8' DEEPW/ 14" PIT
 - A.8 ALTERNATING TREAD STAIRWAY UP TO ROOF HATCH
 - A.9 UNDERSLAB DRAINAGE SYSTEM PER OWNER'S GEOTECHNICAL CONSULTANT RECOMMENDATION TYPICAL ALL SLAB ON GRADE AREAS
 - A.11 NEW CONCRETE STEPS TO MATCH EXISTING REMOVED FOR CONSTRUCTION
 - A.12 553006 BRICK FACED CONCRETE DUMPSTER ENCLOSURE TOP OF WALL
 - A.13 LCD SIGNAGE SCREEN IN WALL RECESS (OFCI)
 - A.14 MARKERBOARD SURFACE
 - A.15 WOOD SCREEN W/ SOLID LUMBER
 - A.17 VIDEO WALL - 24 55" SCREENS
 - A.18 LCD SCREEN LOCATION (OFOI)
 - A.19 AIR PLENUM - INSULATED PLENUM CONSTRUCTION BY DIVISION 23
 - A.20 122200 CURTAIN LOCATION
 - A.21 104313 AED CABINET LOCATION
 - A.22 10 4413 FEC WITH FIRE EXTINGUISHER
 - A.23 08 4423 SULL SASH LOCATION: PROVIDE 1/4" TEMPERED CLEAR GLAZING AT INTERIOR FACE OF CURTAIN WALL MULLIONS FOR ACOUSTICAL SEPARATION.
 - A.24 6" X 8" FORMED CONCRETE TRENCH IN FLOOR W/ METAL PLATE COVER. PROVIDE BLIND SIDE WATERPROOFING
 - A.25 BUILT IN SALT WATER FISH TANK LOCATION. SIZE APPROX. 7'-6" X 2'-4" X 2'-6" HIGH. LOW IRON GLASS VIEW WINDOW ON CORRIDOR SIDE. SLIDING DOOR ON LAB SIDE. FISH TANK EQUIPMENT BELOW TANK W/ CABINET DOOR ACCESS ON LAB SIDE. FINISHED INTERIOR FACE OF WALLS AND CEILING INSIDE CAVITY W/ WATER RESISTANT GYP BOARD AND EPOXY PAINT.
 - A.26 LCD SIGNAGE SCREEN IN WALL RECESS (OFCI)
 - A.27 CONSTRUCT 2 HOUR RATED SEPARATION BETWEEN BOTTOM OF STAIR AND UTILITY PIPING CROSSING THIS AREA. USE HORIZ. GYP BD. ENCLOSURE ON SHEET A1002

CONFORMED SET 01 JUL 2016

1	ADDENDUM 3-2	15 APR 2016
1	ISSUED FOR CONSTRUCTION (BP3)	15 MAR 2016
No.	Description	Date

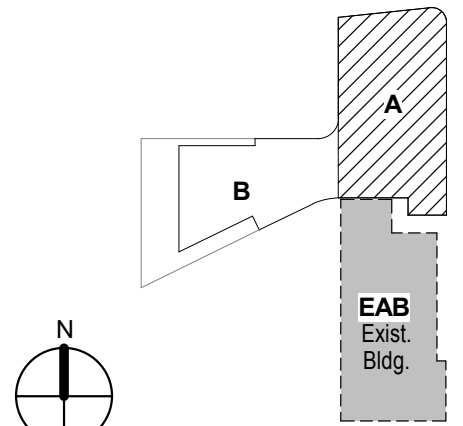

KEY PLAN

**LEVEL 04 AREA A FLOOR
PLAN**

Project No.: 04561.01 Checked by:

A0104.A