



PARIC CORPORATION
77 Westport Plaza Suite 250
St. Louis, MO 63146
TEL: 636-561-9500
FAX: 636-561-9501

REQUEST FOR INFORMATION **DATE:** January 06, 2017 **NO.:** RFI-401

To: Cannon Design

Attn: Kelvin Patel

From: Paric Corporation

Requested By: Devin Gates

Project Name: 15051-Webster University Interdisciplinary Science Building

Project No.: 15051

Subject: LCD digital sign in C270

Response Required By: January 13, 2017

Drawing / Spec Reference:

Information Requested:


Please provide dimensions for the recess for LCD digital sign shown on 16/A0551.

Response:



ARCHITECT'S RESPONSE:

This information is provided as an interpretation of the Contract Documents for implementation. It is not an authorization for change to the Contract Sum or Contract Time. If this information results in a claim for a change to the Contract, the Contractor shall notify the [Construction Manager][Architect] of a change through the change process.

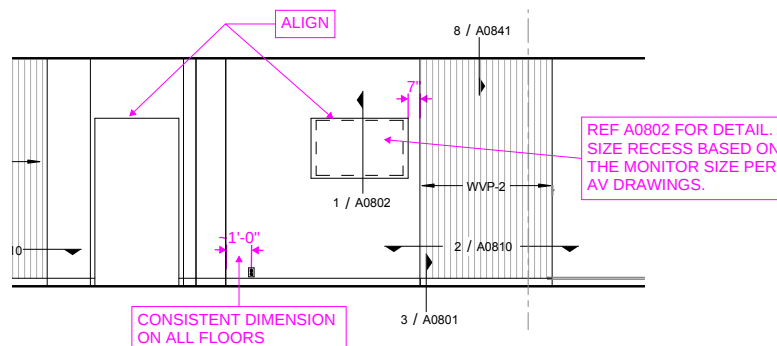

Answered By: Kelvin Patel

Date: 01/17/2017