



PARIC CORPORATION
77 Westport Plaza Suite 250
St. Louis, MO 63146
TEL: 636-561-9500
FAX: 636-561-9501

REQUEST FOR INFORMATION DATE: January 30, 2017 NO.: RFI-432

To: Cannon Design

Attn: Kelvin Patel

From: Paric Corporation

Requested By: Joe Voypick

Project Name: 15051-Webster University Interdisciplinary Science Building Project No.: 15051

Subject: Undercabinet light in room 289B

Response Required By: February 06, 2017

Drawing / Spec Reference:

Information Requested:

E0202.A calls for a UA4 4' undercabinet light in room 289B. Room 289B has adjustable shelves with vertical supports 3' apart. Please advise if this should be changed to two smaller lights in lieu of the 4' light.

Please provide vertical and horizontal light location.

Response:


Refer to ASI-049. Provide two Type UB2 fixtures in-lieu of one UA4 fixture. Fixtures will be magnetically mounted to the underside of the adjustable shelves. The associated power supply will plug into the raceway currently shown to serve counter. Attach power supply to shelf vertical support to keep it out of the way. Ensure the daisy chain cable is long enough (2' long recommended) to allow for reasonable shelf adjustment.

ARCHITECT'S RESPONSE:

This information is provided as an interpretation of the Contract Documents for implementation. It is not an authorization for change to the Contract Sum or Contract Time. If this information results in a claim for a change to the Contract, the Contractor shall notify the [Construction Manager][Architect] of a change through the change process.

Answered By: Mark de la Fuente, WTA

Date: 2/3/17

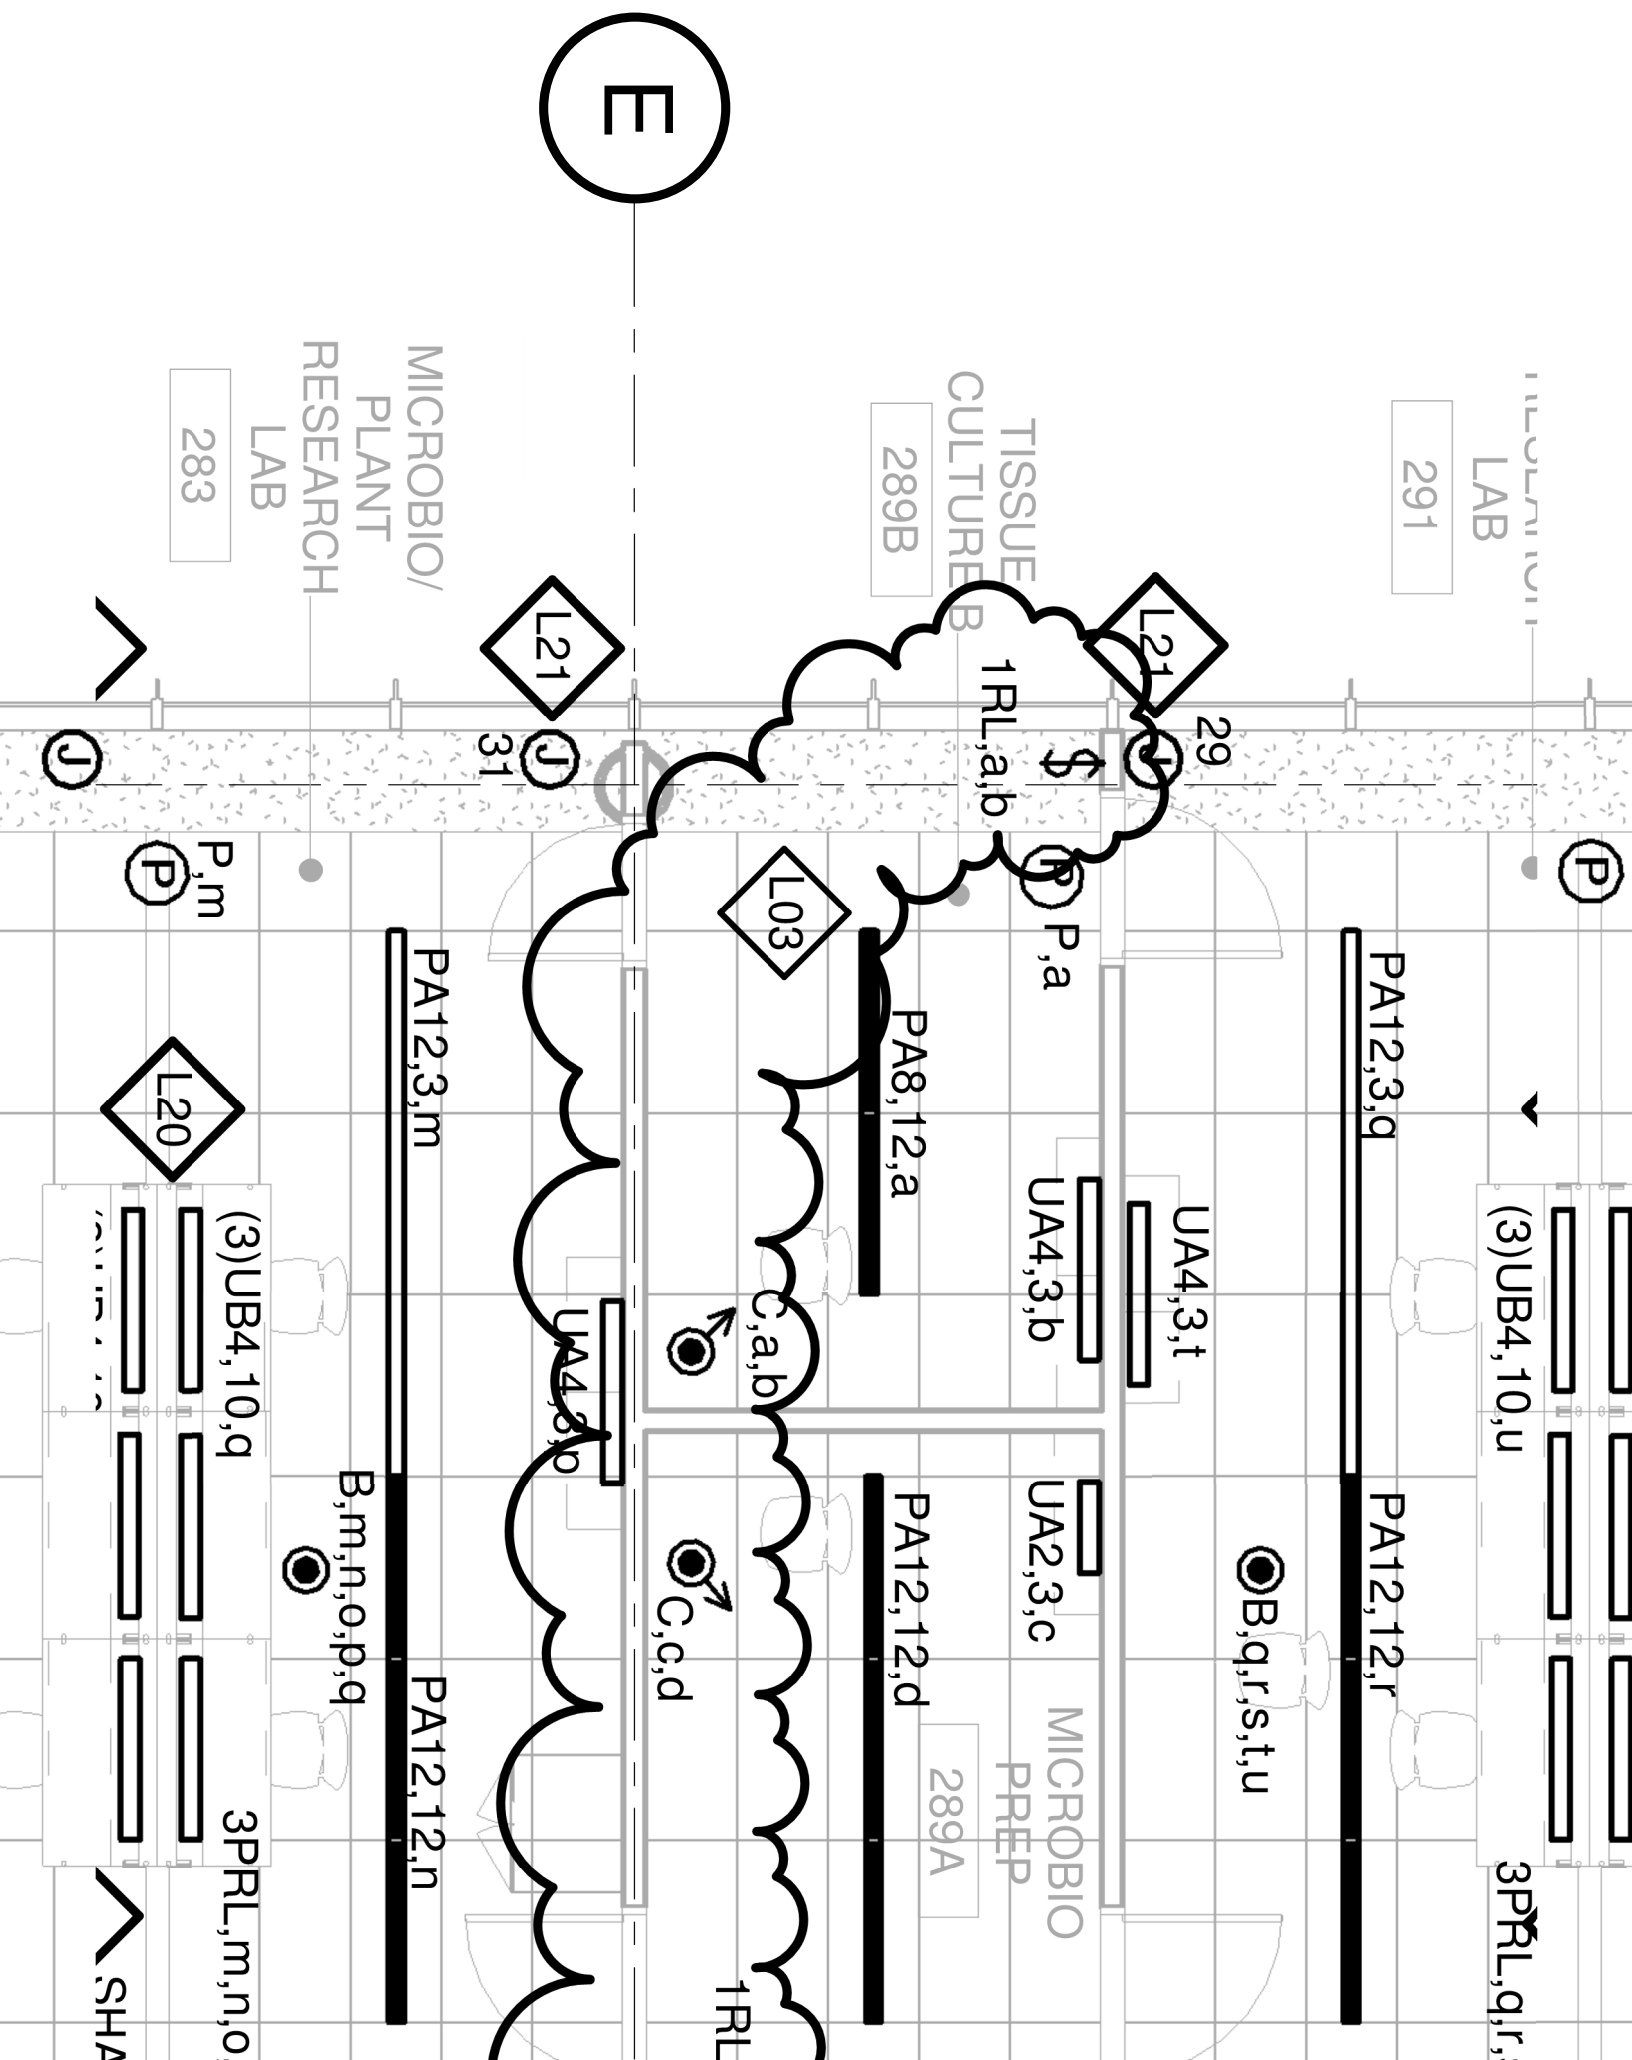

5

EW LOCATION
ON LEFT-HAND
SIDE OF SINK

ELECTRICAL
RACEWAY

3'-0"

3'-0"

7 / A0911

L.14

08.33B.07
Refrigerator
Deli-Type

08.33B.07
Refrigerator
Deli-Type

08.33B.03
Inverted
Microscope

08.33B.06
Clinical
Centrifuge

2'-10"

4'-4"

AD
CA

6 / A0912

2'-0"

2'-0"

2'-0"

7 / A0912

L.20

FLAMM.
STOR.
CAB

7

1/4" = 1'-0"

L02 TISSUE CULTURE - NORTH