



PARIC CORPORATION
77 Westport Plaza Suite 250
St. Louis, MO 63146
TEL: 636-561-9500
FAX: 636-561-9501

REQUEST FOR INFORMATION **DATE:** February 17, 2017 **NO.:** RFI-447

To: Cannon Design

Attn: Kelvin Patel

From: Paric Corporation

Requested By: Joe Voypick

Project Name: 15051-Webster University Interdisciplinary Science Building

Project No.: 15051

Subject: Shade pocket type along south wall level 04

Response Required By: February 24, 2017

Drawing / Spec Reference:

Information Requested:

Please confirm the shade pocket detail to use at the locations along the south wall level 04.

Response:

DETAIL SIMILAR TO 16/A0842, EXCEPT LIGHT LOCATIONS.

NOTE REMOVAL OF SHADES AT 'C450A COMMONS' AS MARKED UP.
PROVIDE CREDIT TO OWNER.


ARCHITECT'S RESPONSE:


This information is provided as an interpretation of the Contract Documents for implementation. It is not an authorization for change to the Contract Sum or Contract Time. If this information results in a claim for a change to the Contract, the Contractor shall notify the [Construction Manager][Architect] of a change through the change process.

ADDITIONAL MARKUPS FOR SHADES ON NORTH & SOUTH FACADE
ARE PROVIDED FOR CLARITY. SEE ATTACHED MARKUPS.


Answered By: Kelvin Patel

Date: 03/06/2017

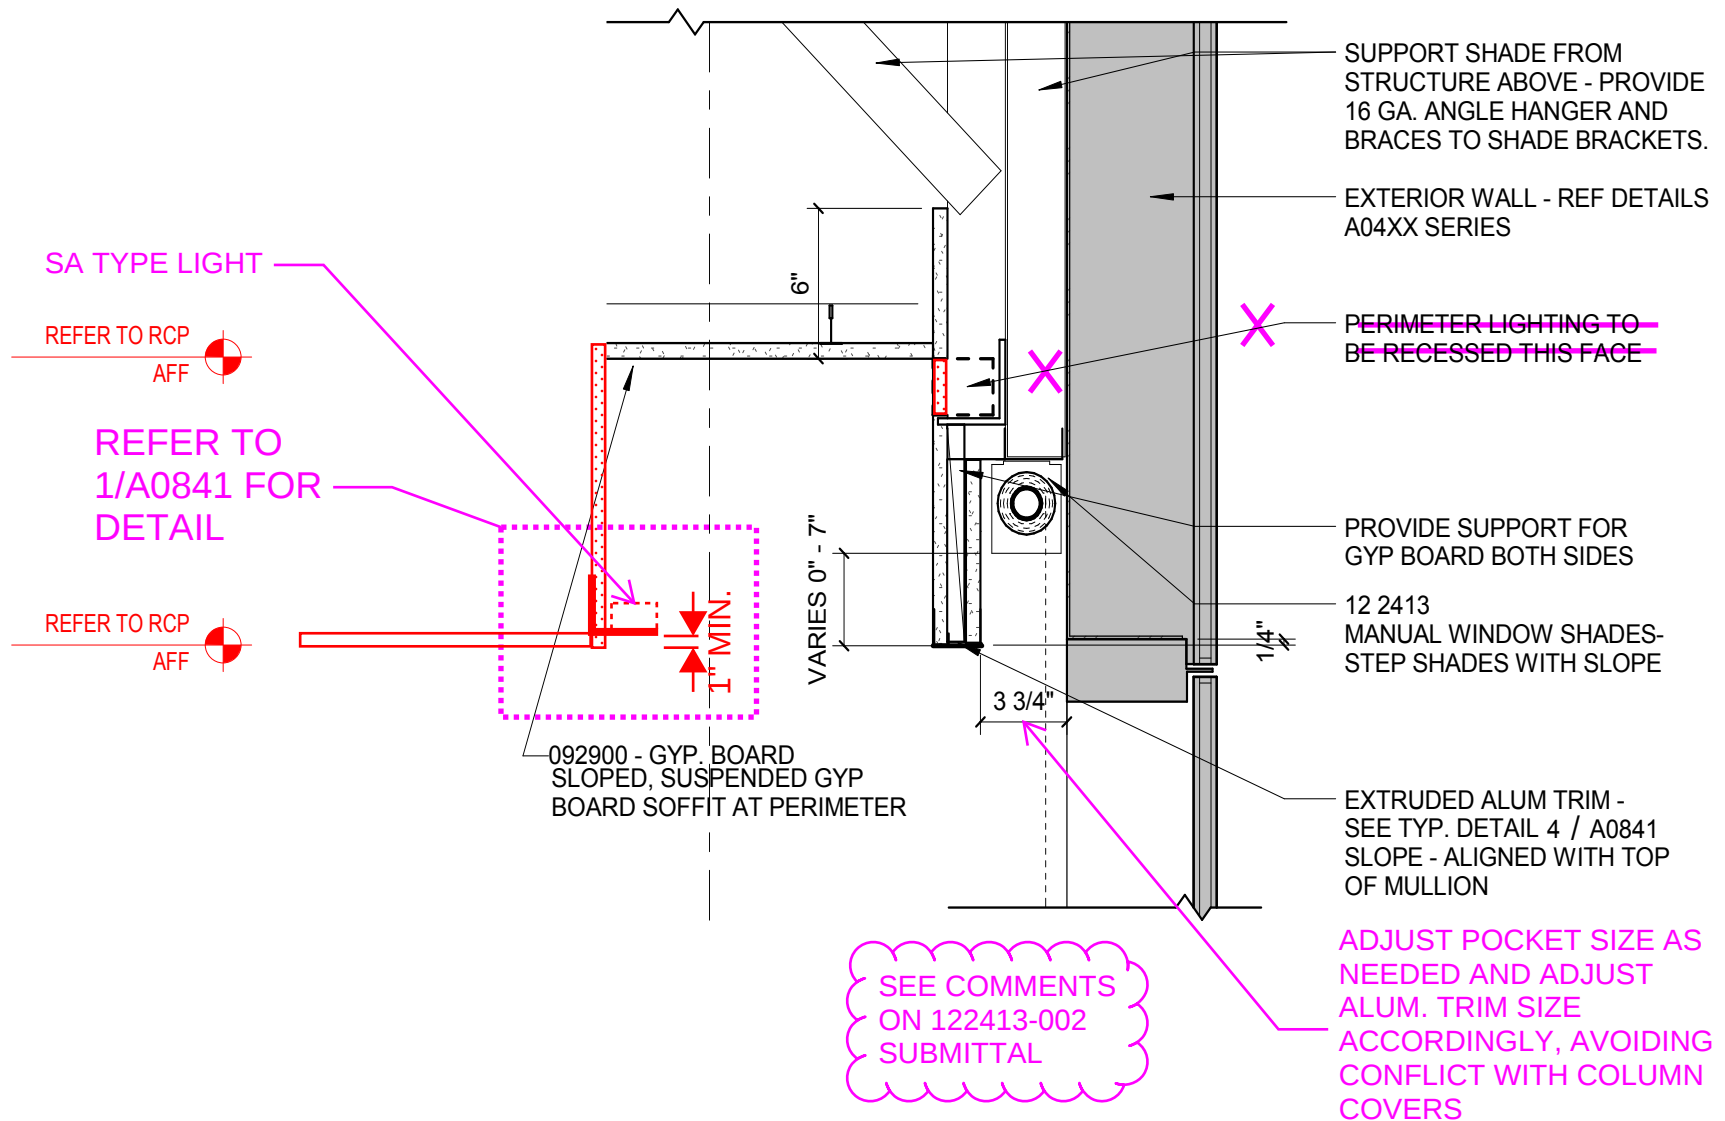

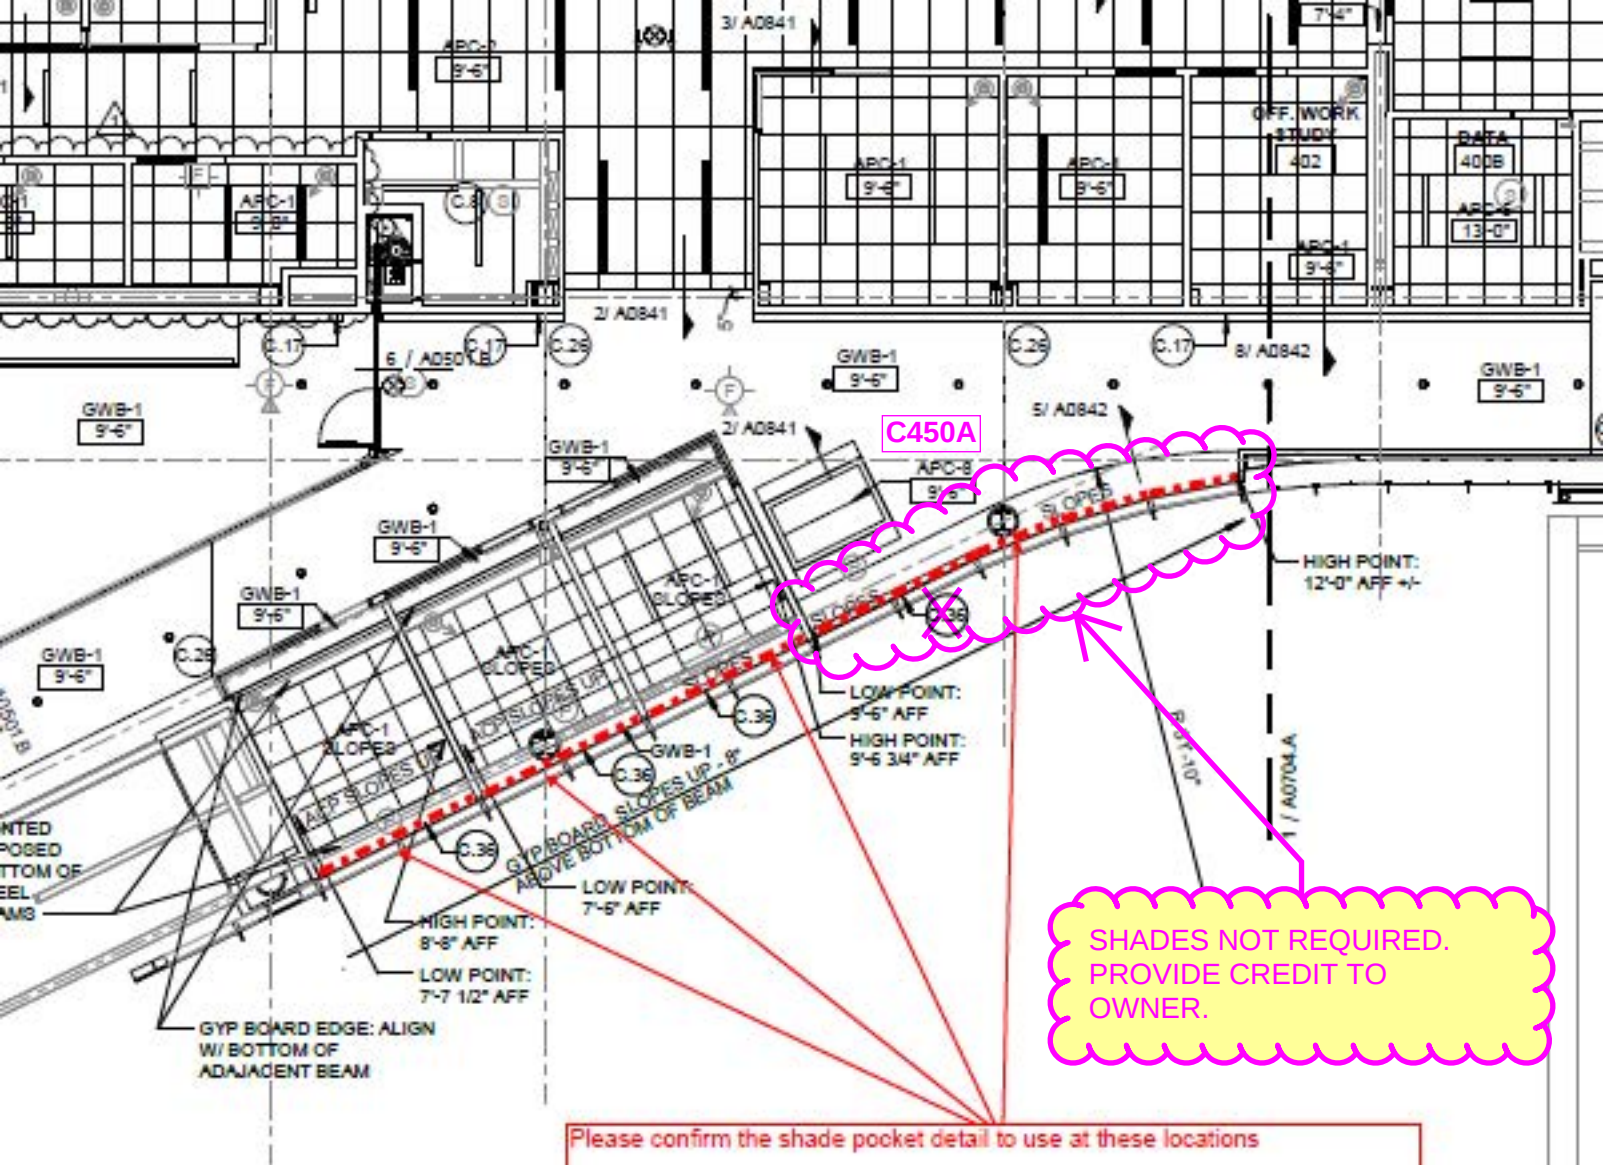

Please confirm the shade pocket detail to use at these locations

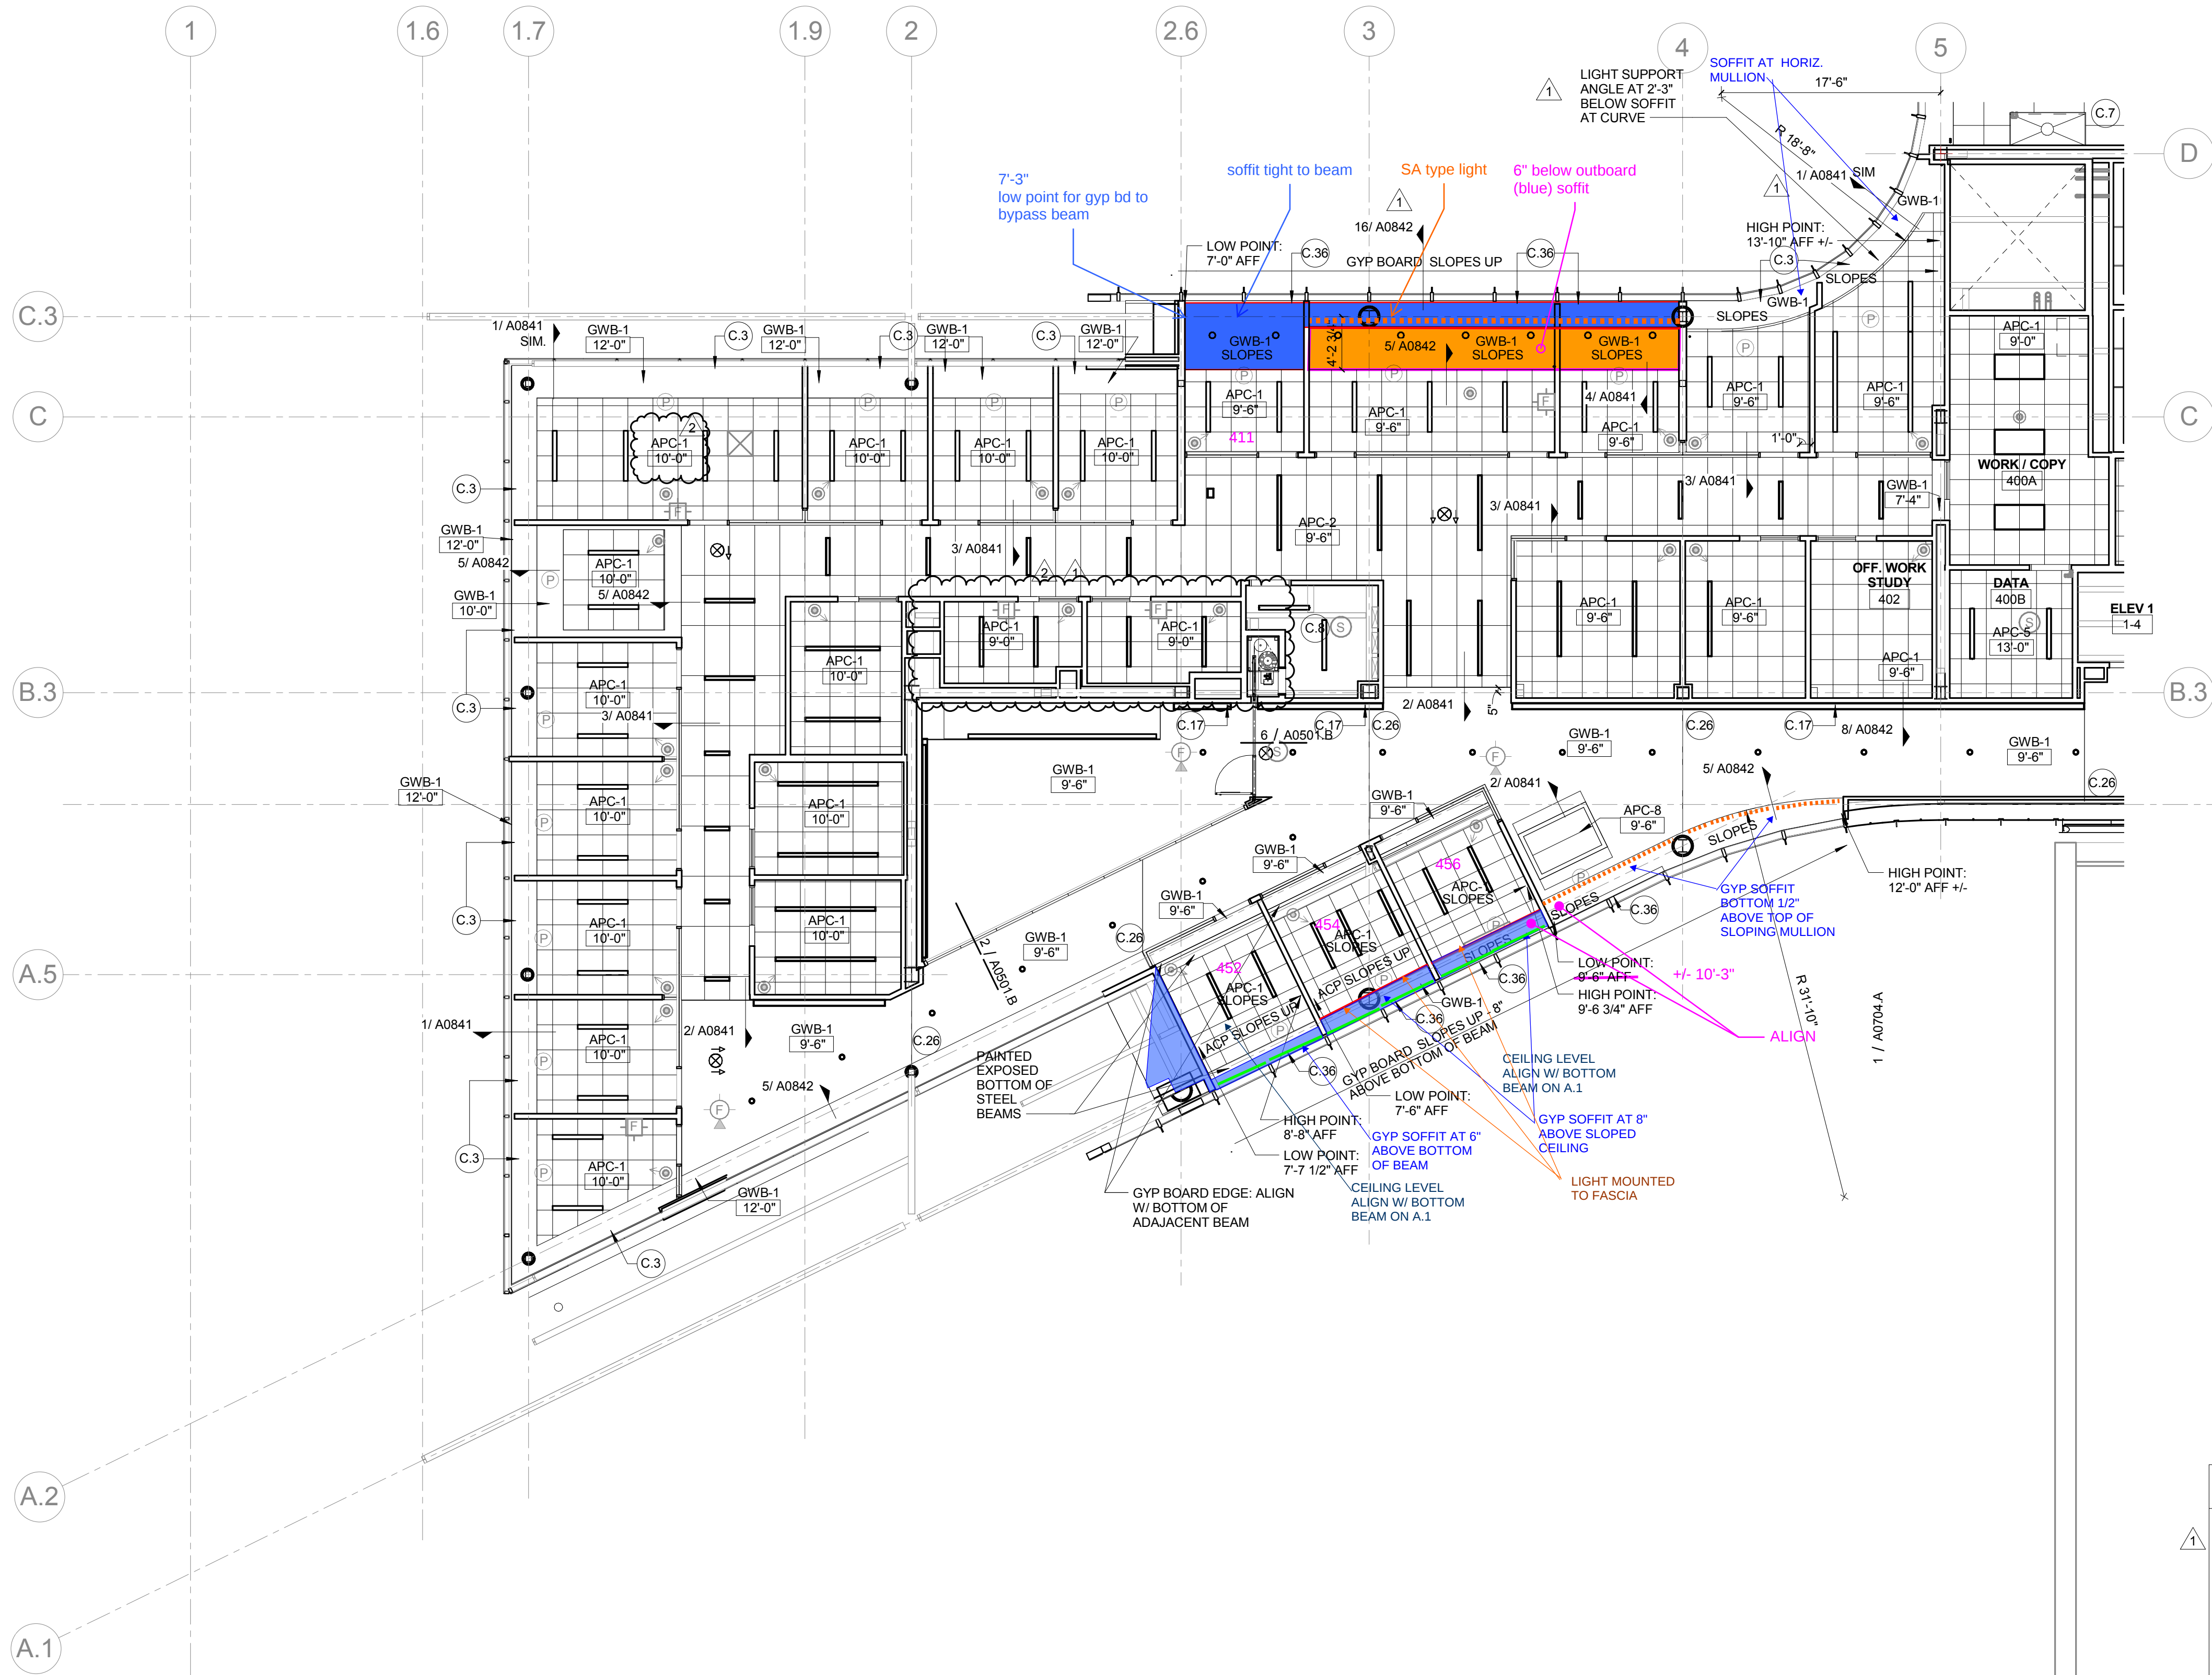

1 LEVEL 04 REFLECTED CEILING PLAN - AREA B
1/8" = 1'-0"

KEYED NOTE LEGEND - REFLECTED CEILING PLAN


- C.1 122413 TYPE 1 SHADES: MOTORIZED ROLLER SHADES IN CONTINUOUS RECESSED POCKET (OFCI)
C.2 122413 TYPE 2 SHADES: MOTORIZED DOUBLE ROLLER SHADES: SURFACE MOUNTED W/ CUSTOM COLOR FASCIA
C.3 122413 TYPE 3 SHADES: MANUAL SHADES IN RECESSED POCKET
C.4 122413 TYPE 4 SHADES: MULLION MOUNTED SHADE IN CONTINUOUS POCKET
C.5 CEILING MOUNTING SUSPENSION FOR LCD SCREEN- PROVIDE STEEL SUPPORT ABOVE CEILING
C.6 EXHAUST HOOD LOCATION - REFER TO FOOD SERVICE DRAWINGS
C.7 FUME HOOD LOCATION - HOOD ENCLOSURE EXTENDS 6\"/>

CEILING LEGEND


- APC-1 2' x 2' - ARMSTRONG OPTIMA REGULAR 1\"/>

- WDC-1 09 5426 WOOD GRILLE CEILING W/ 3/4\"/>


- GWB-1 PAINTED GYP. BOARD
GWB-2 GYP. BOARD W/ COATING TO MATCH ADJACENT ACOUST. PLASTER

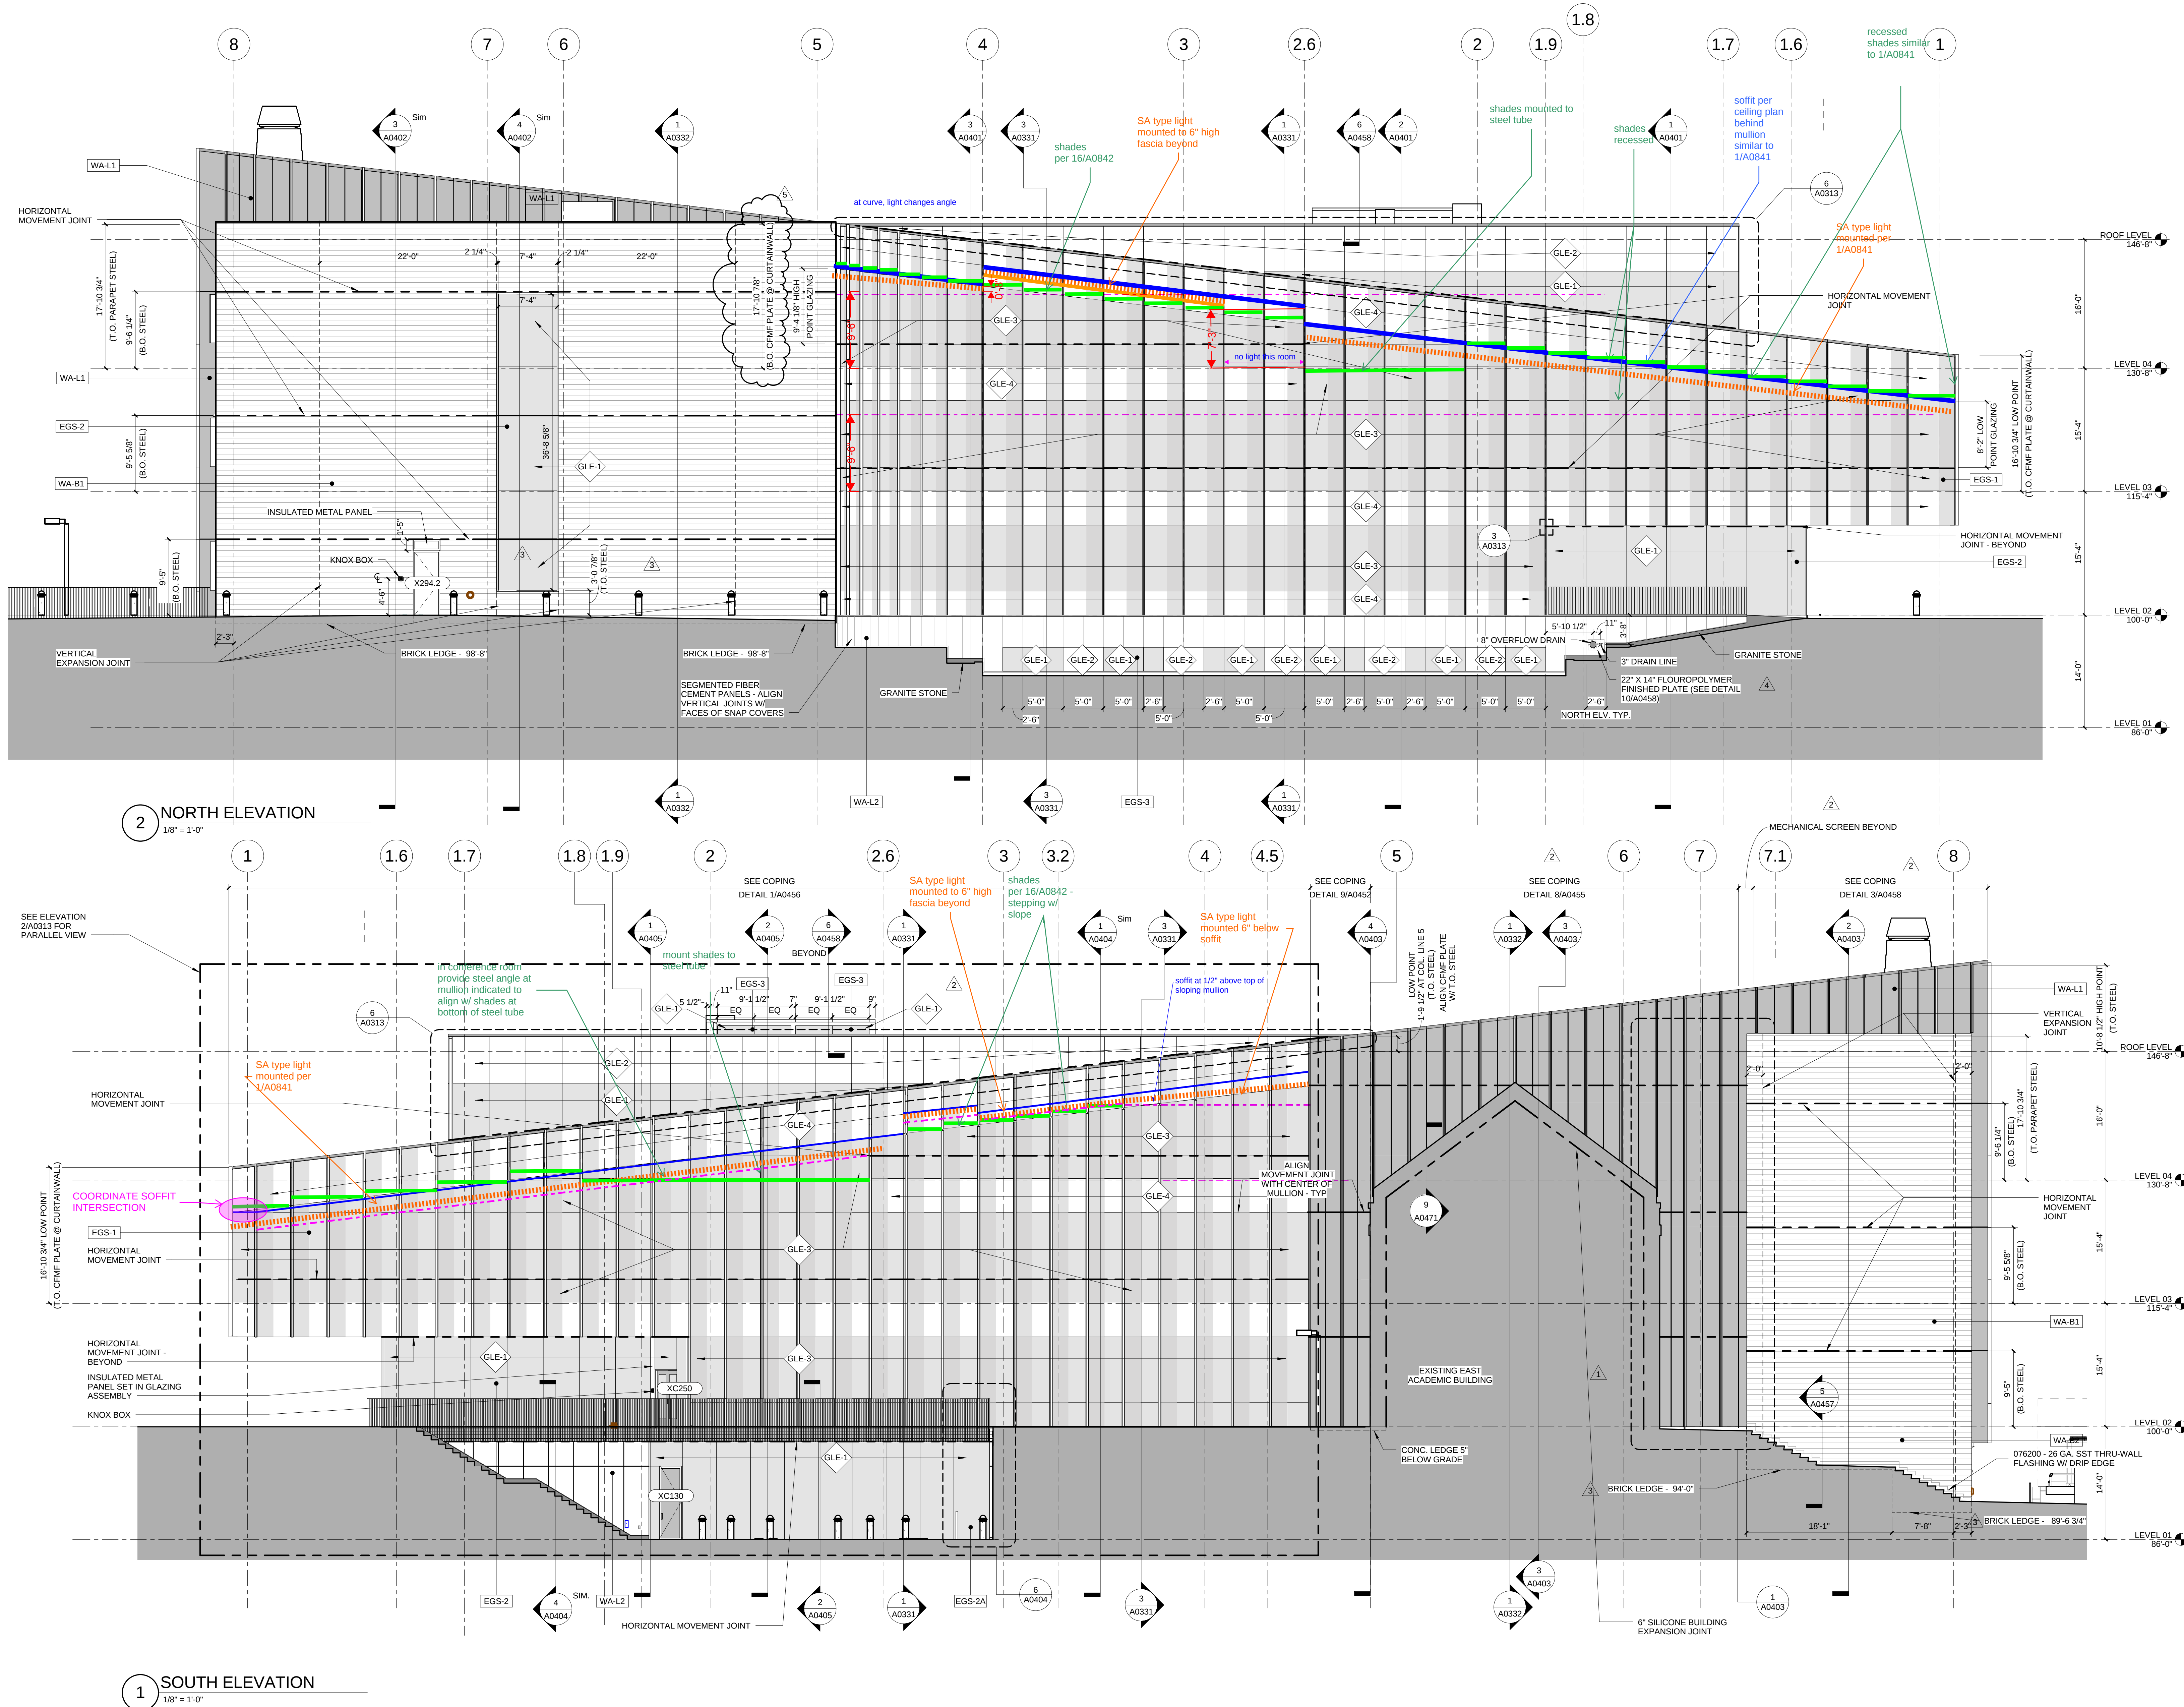



6 Section 13 level 04 office
3/8" = 1'-0"

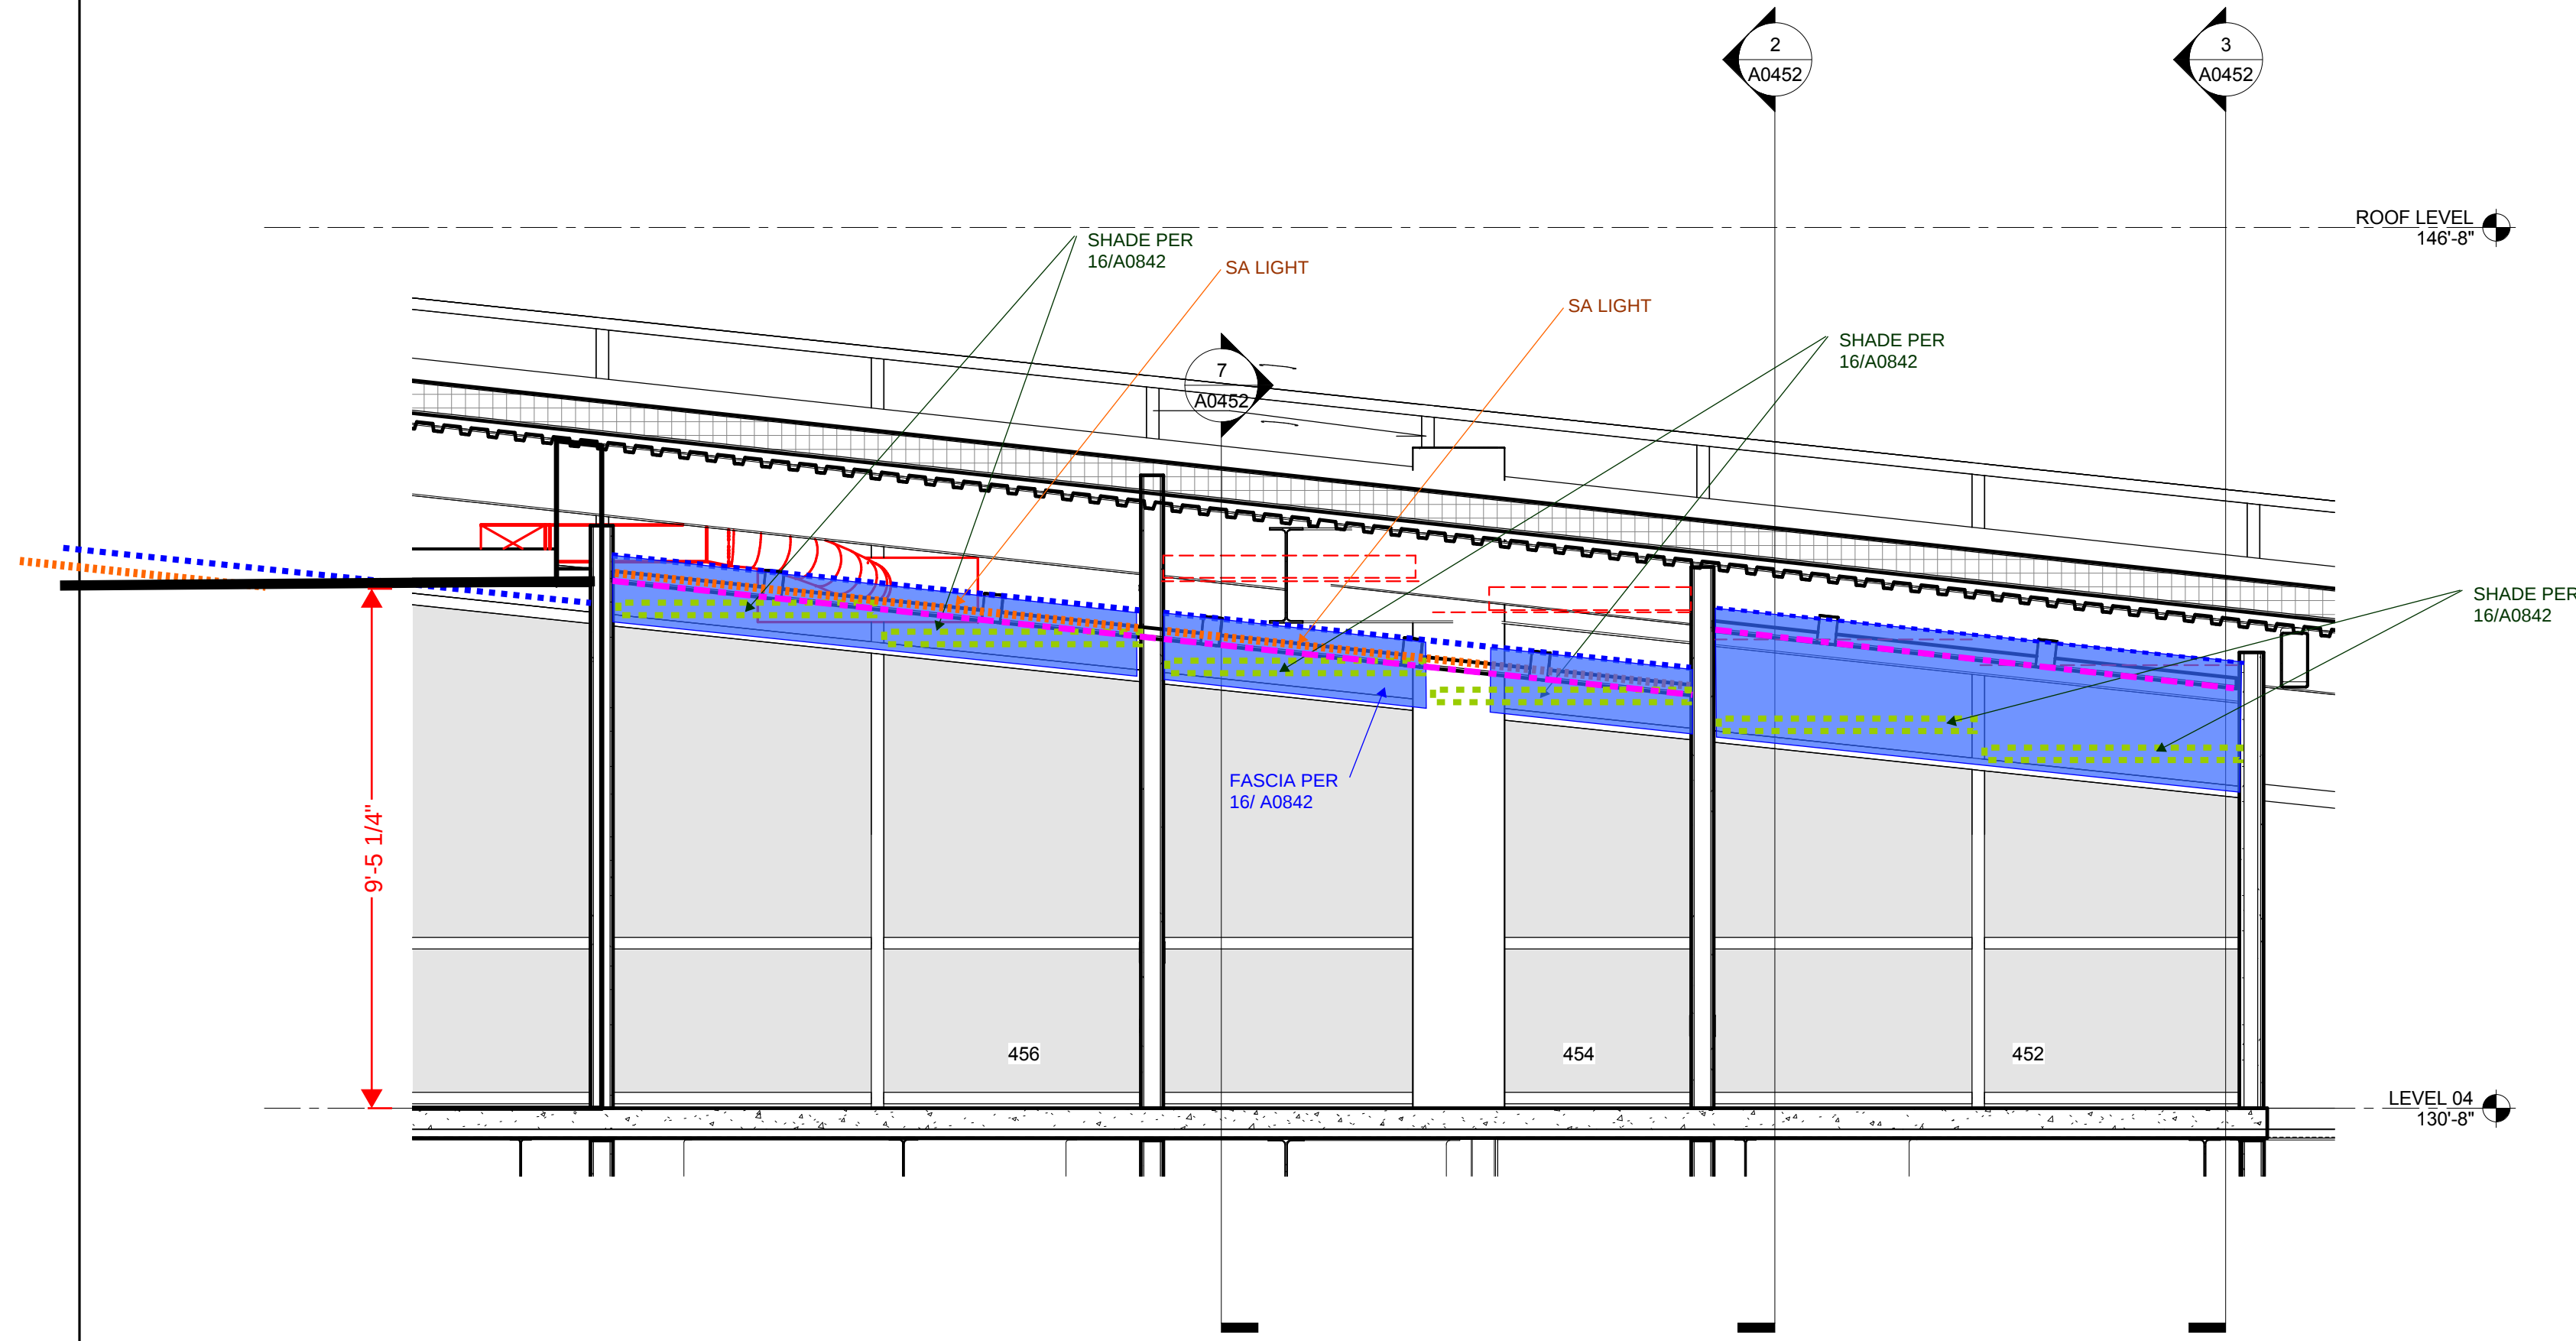


3 Section 51
3/8" = 1'-0"

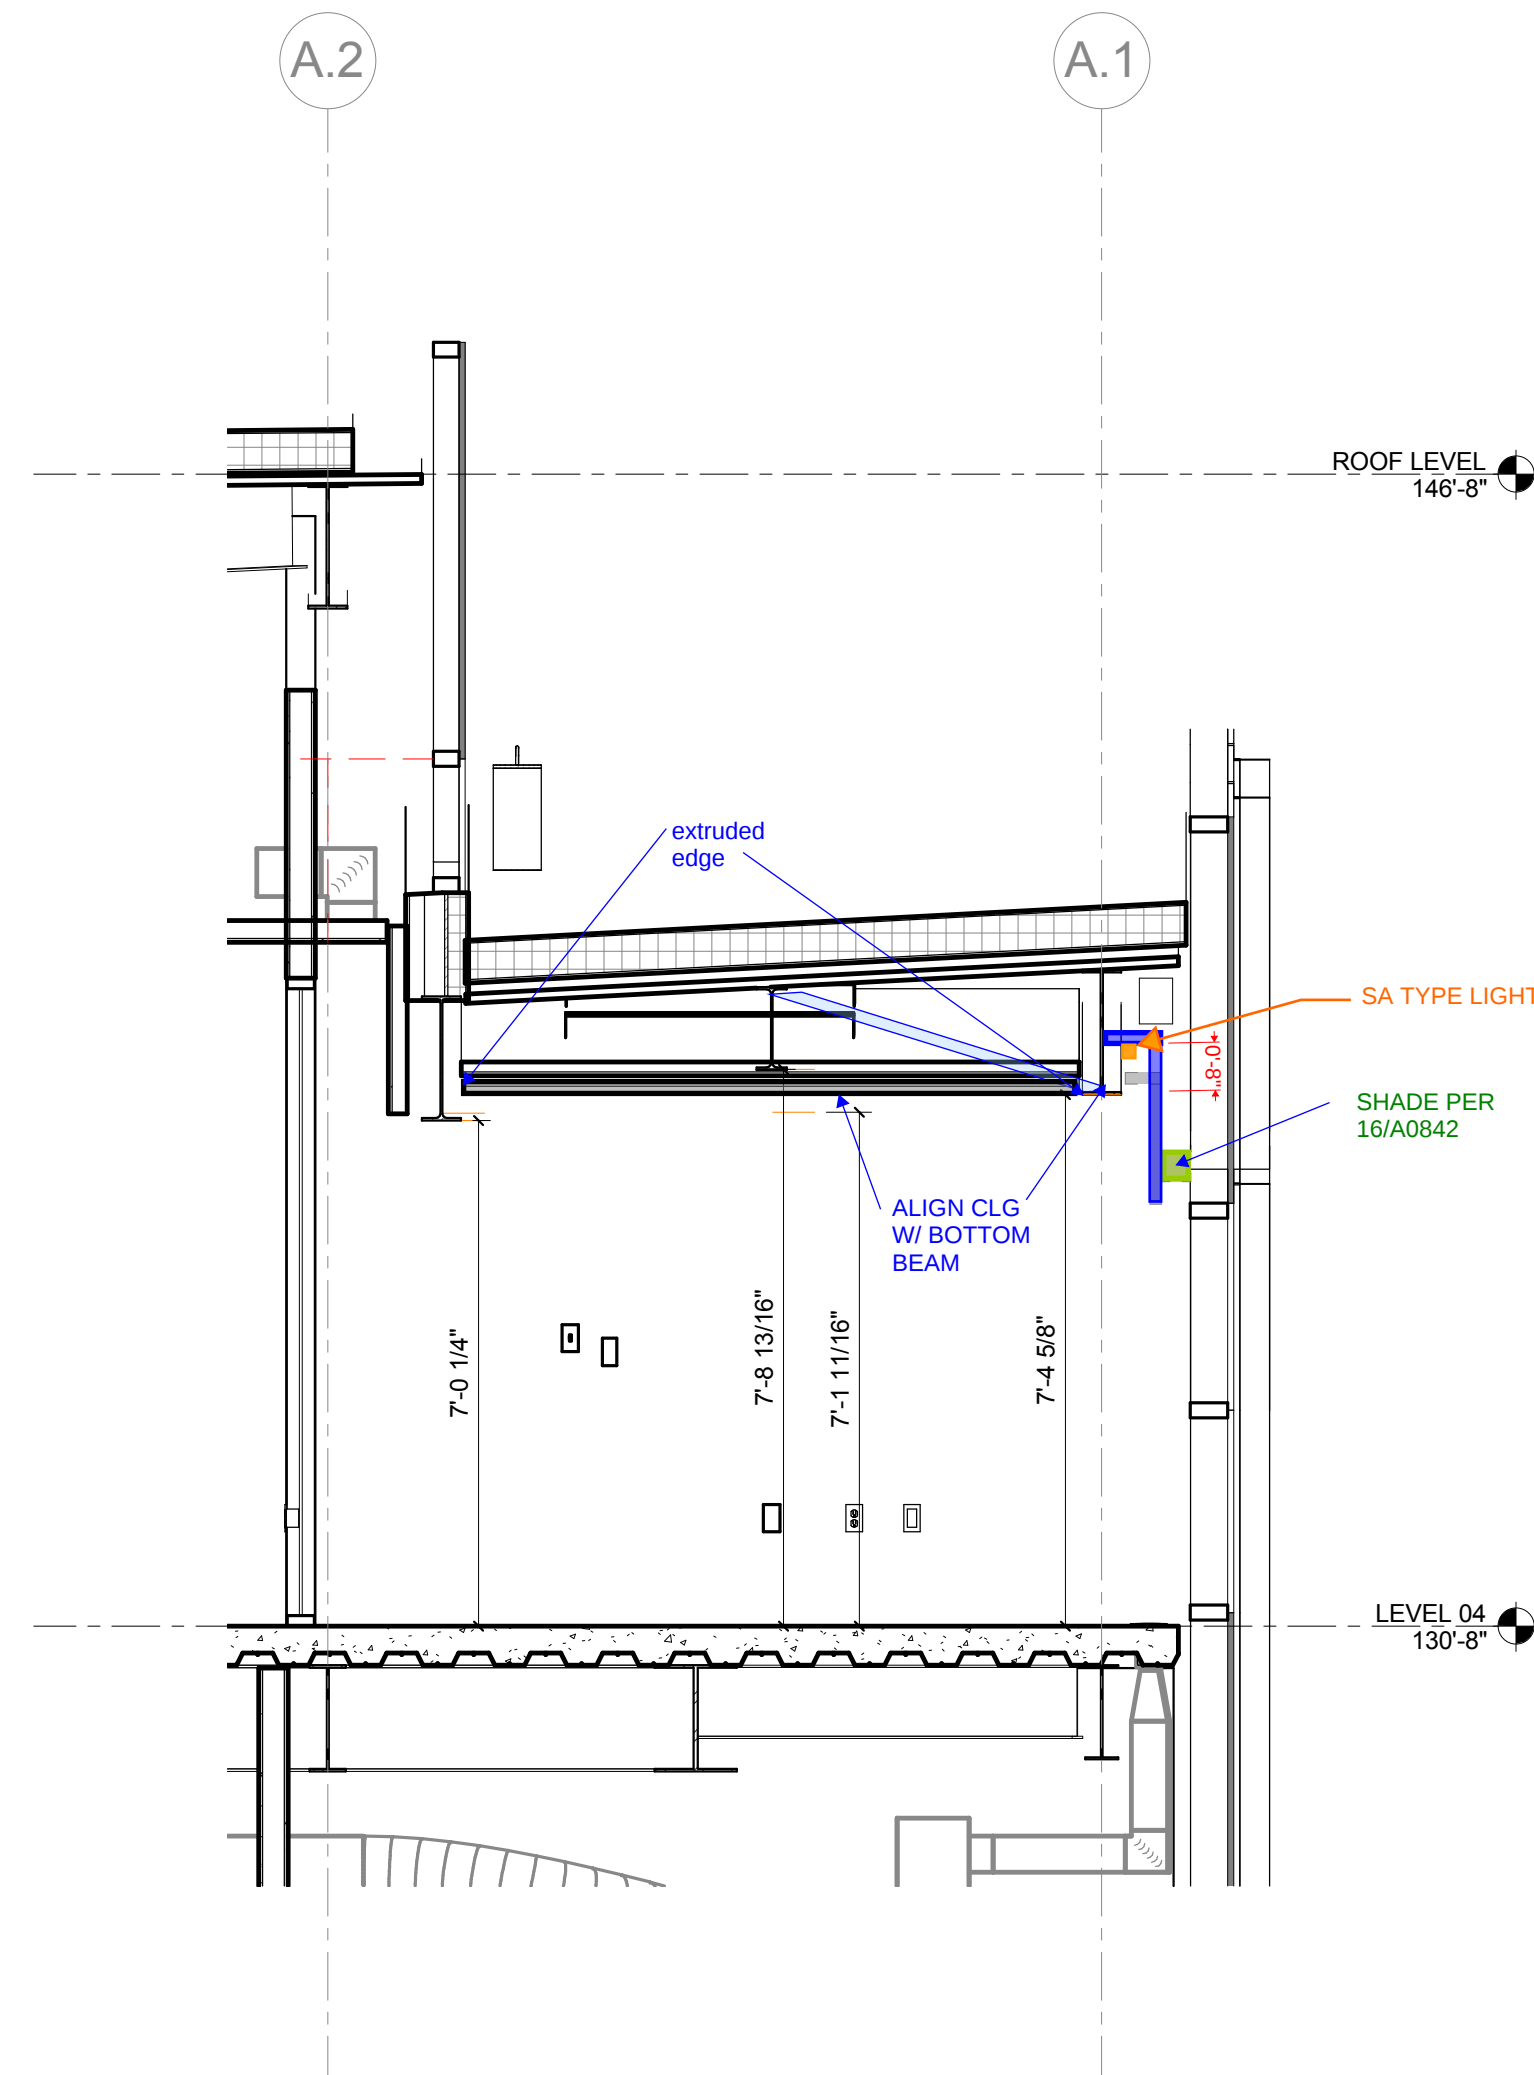

2 Section 2
3/8" = 1'-0"

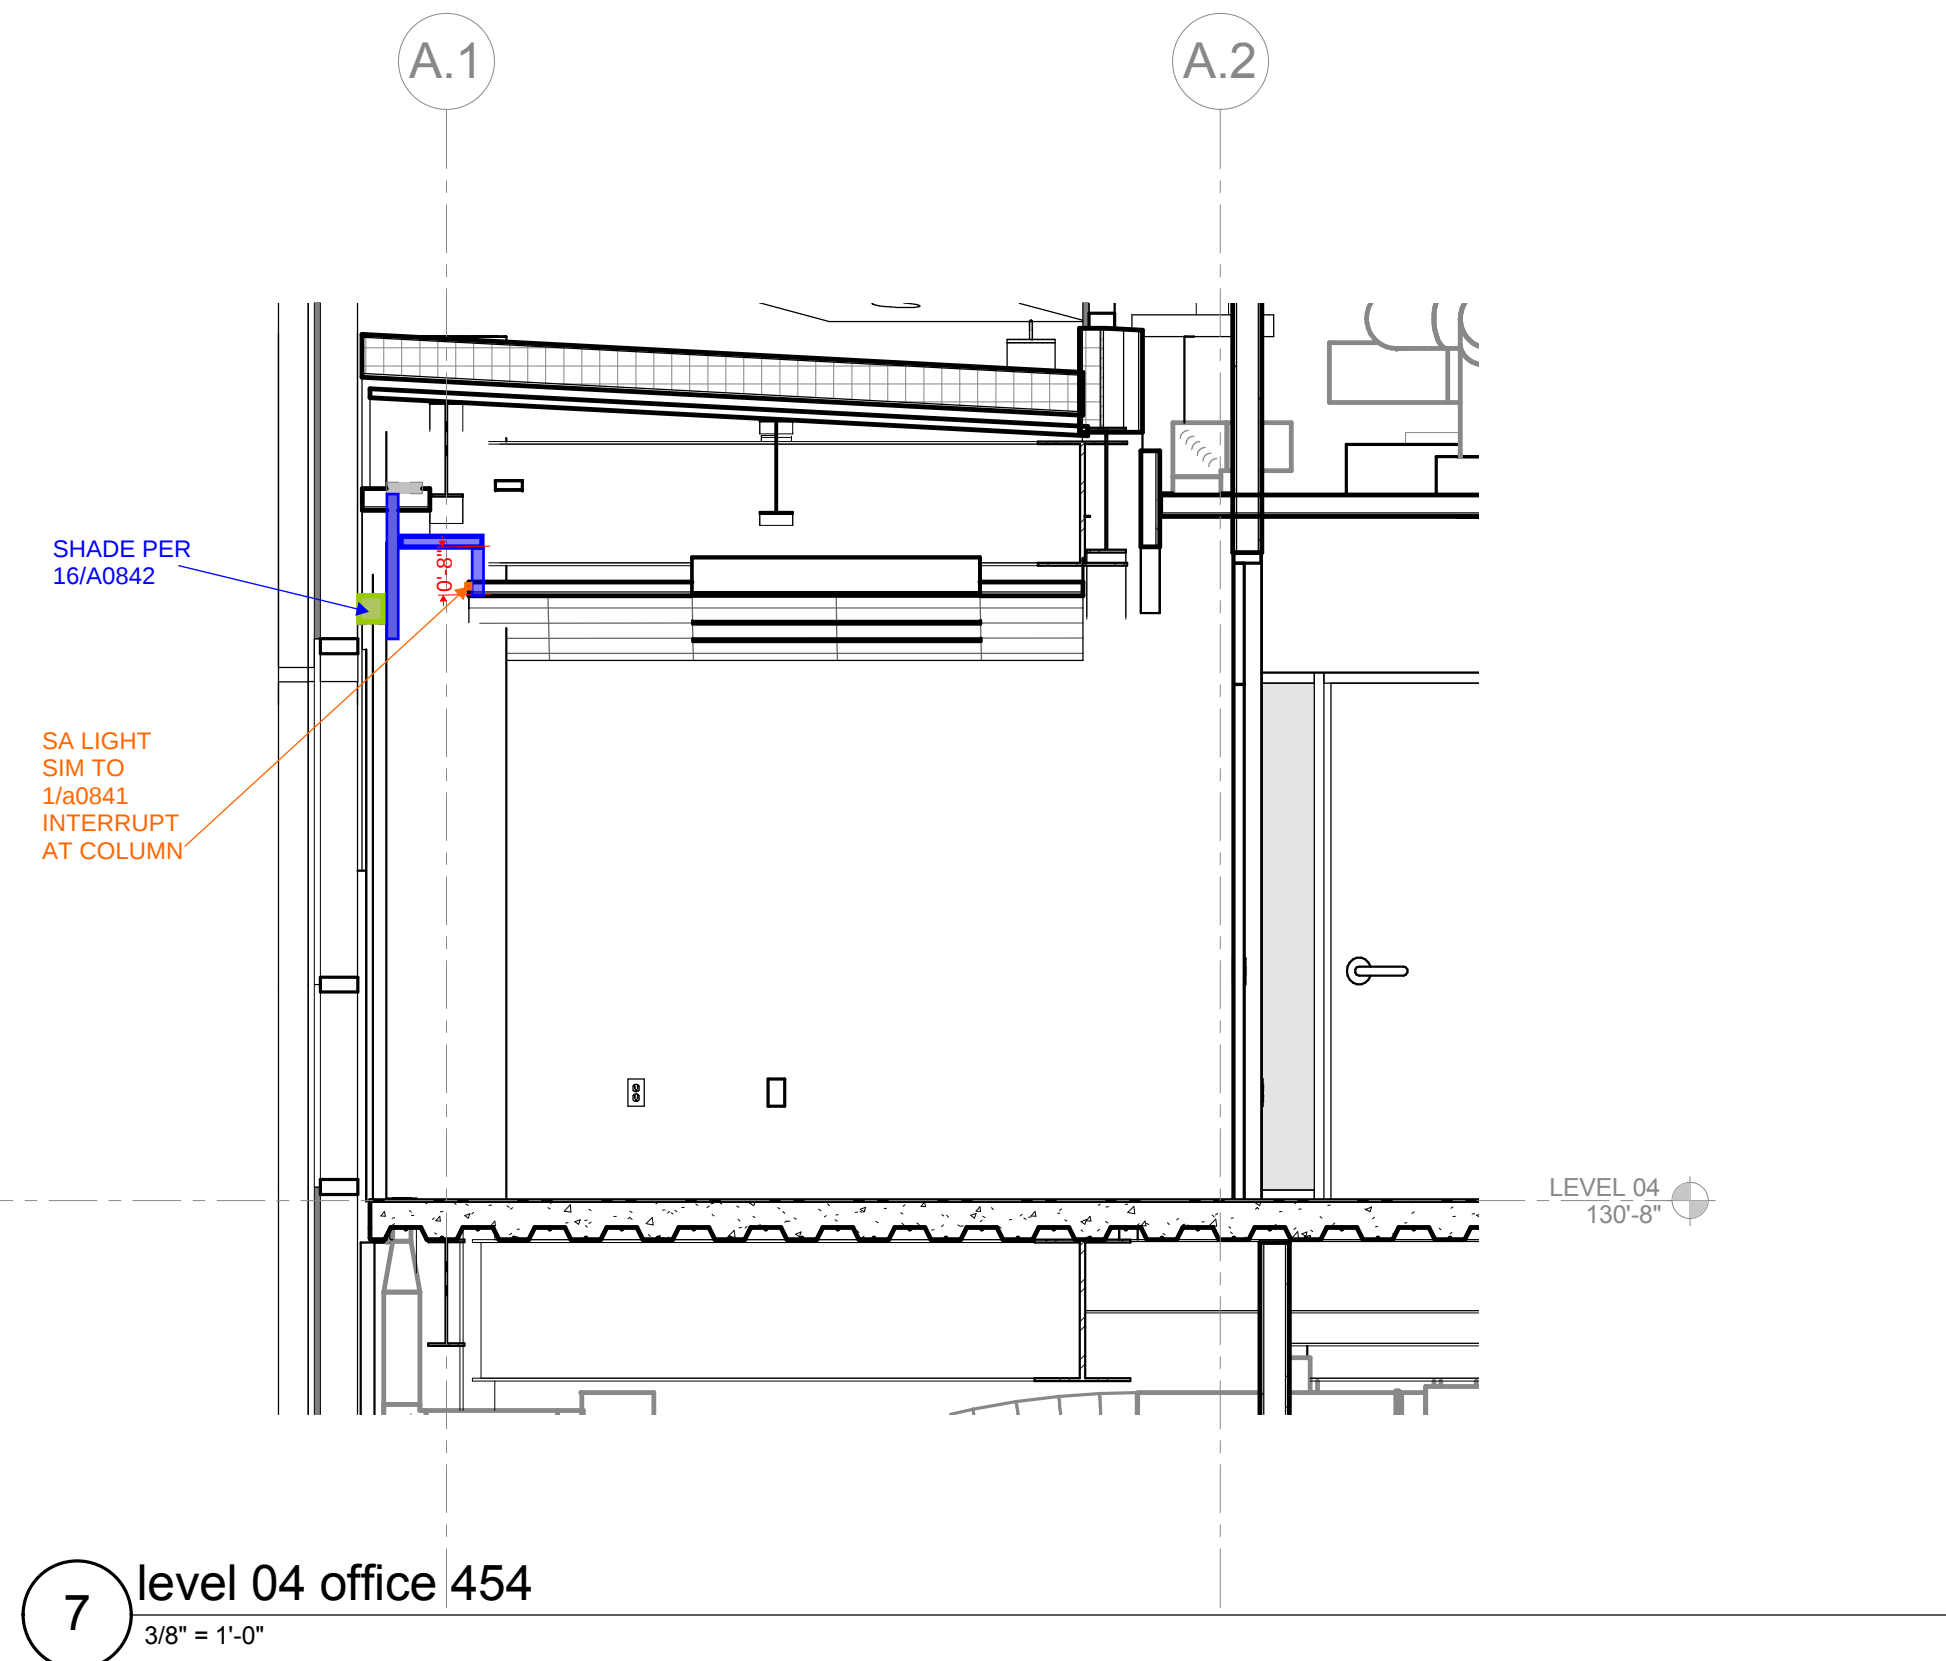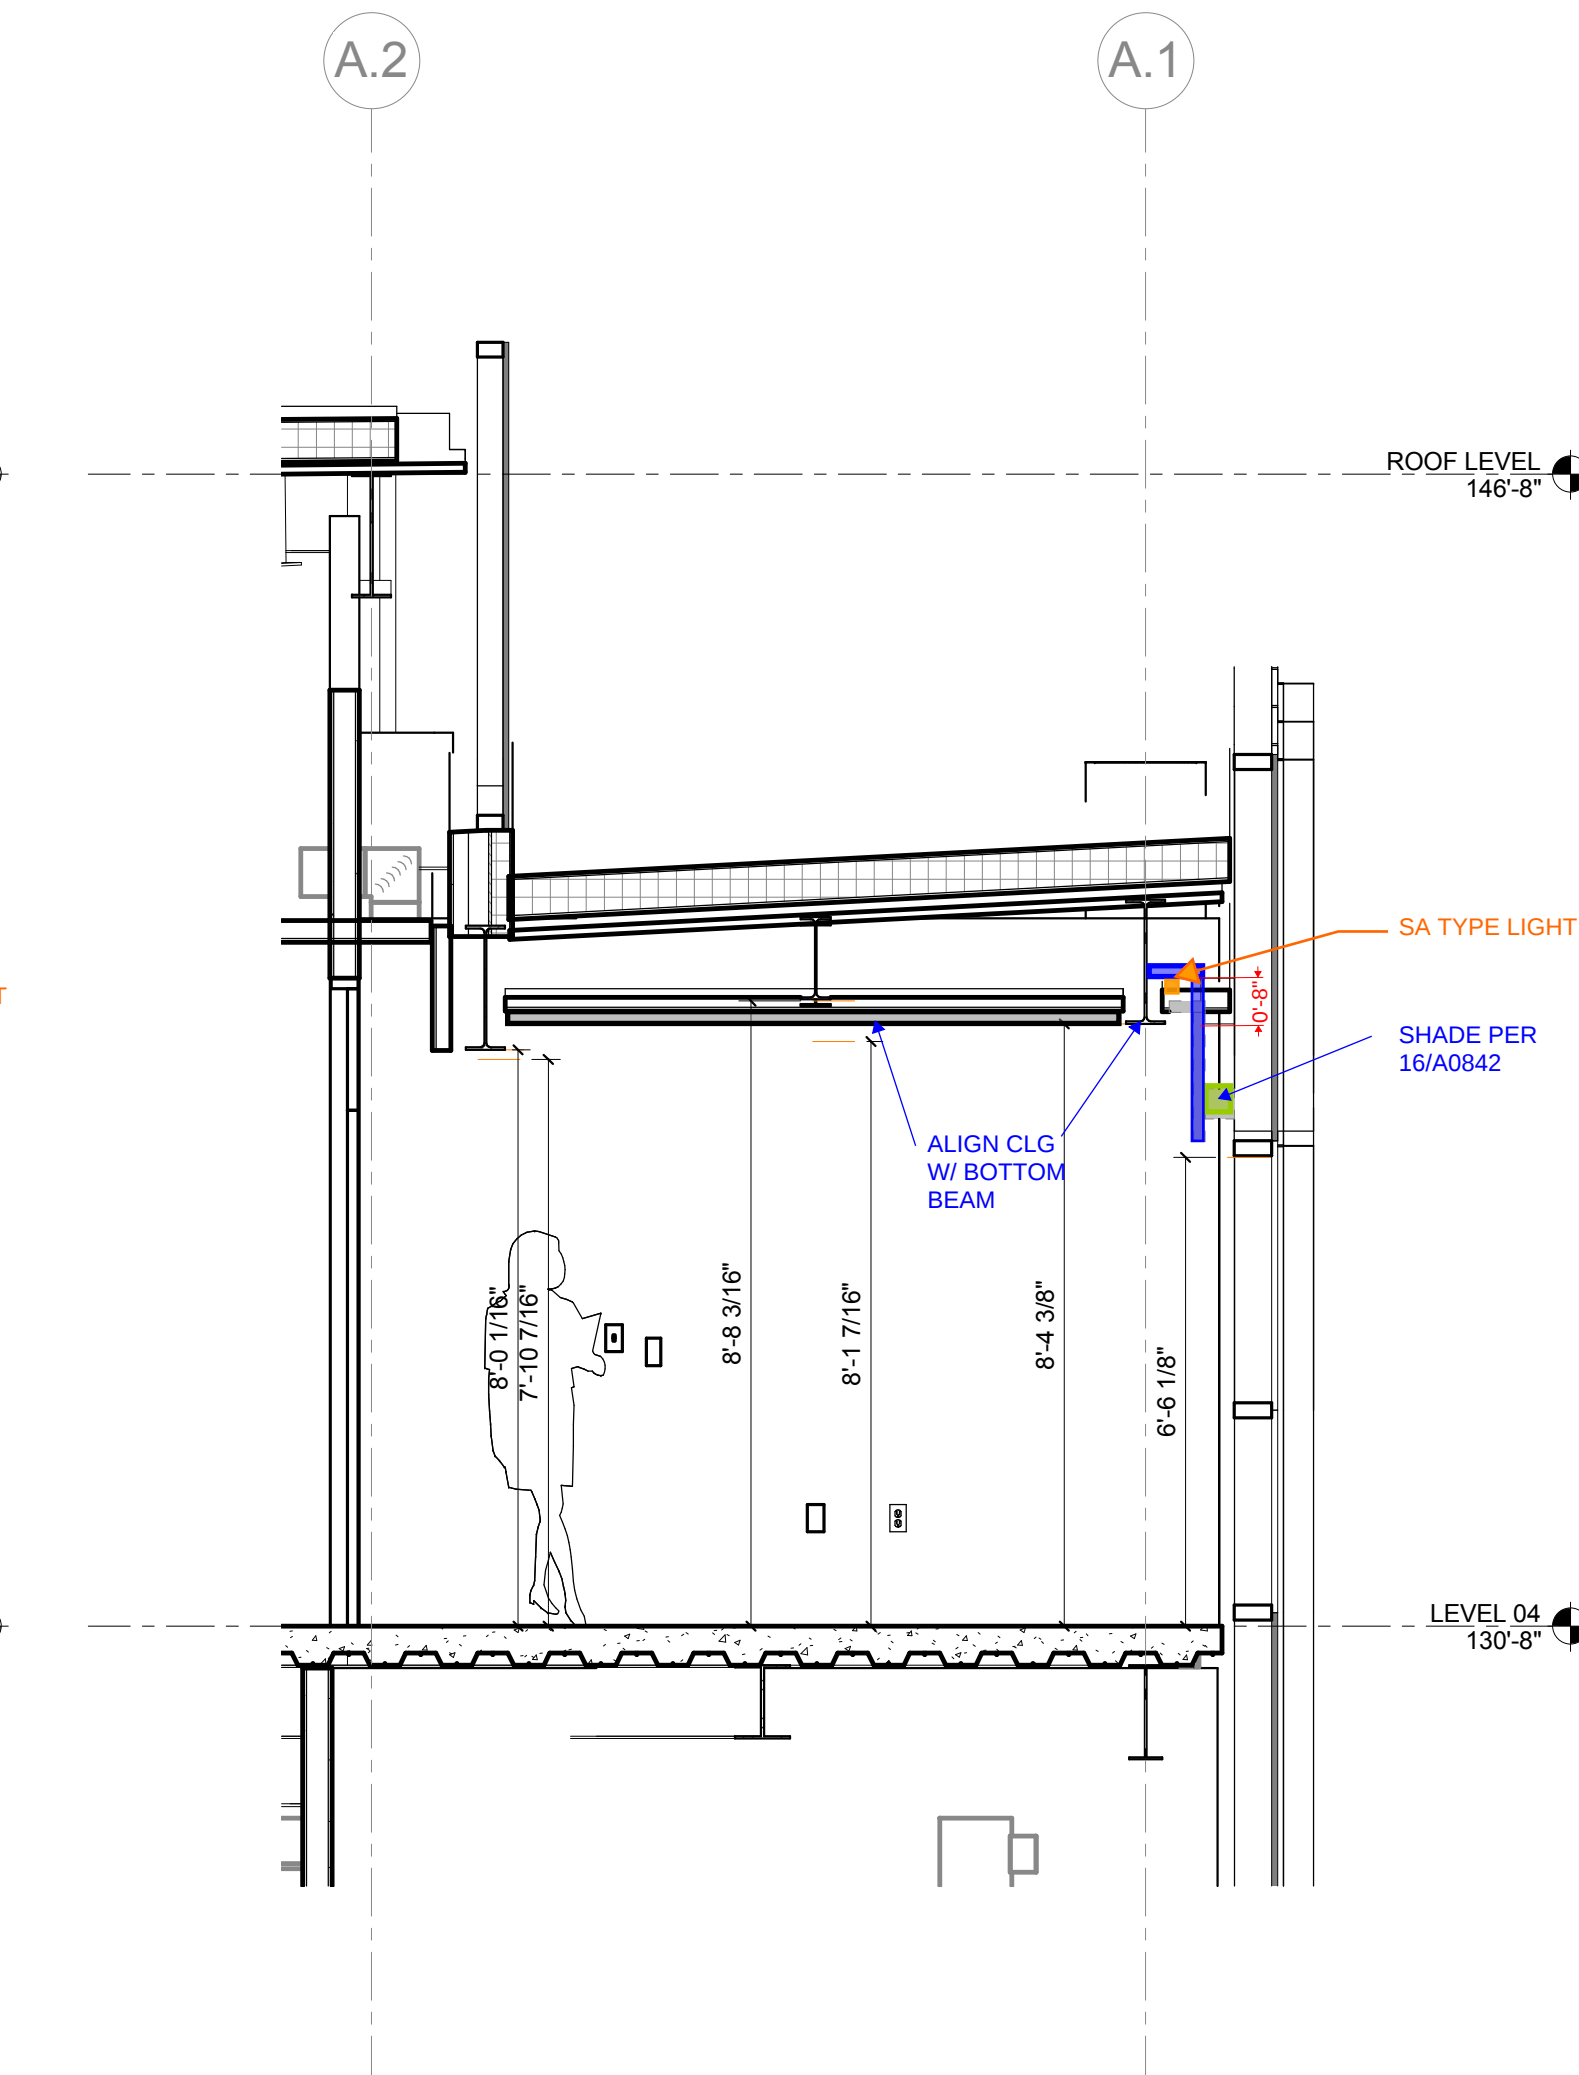

7 level 04 office 454
3/8" = 1'-0"

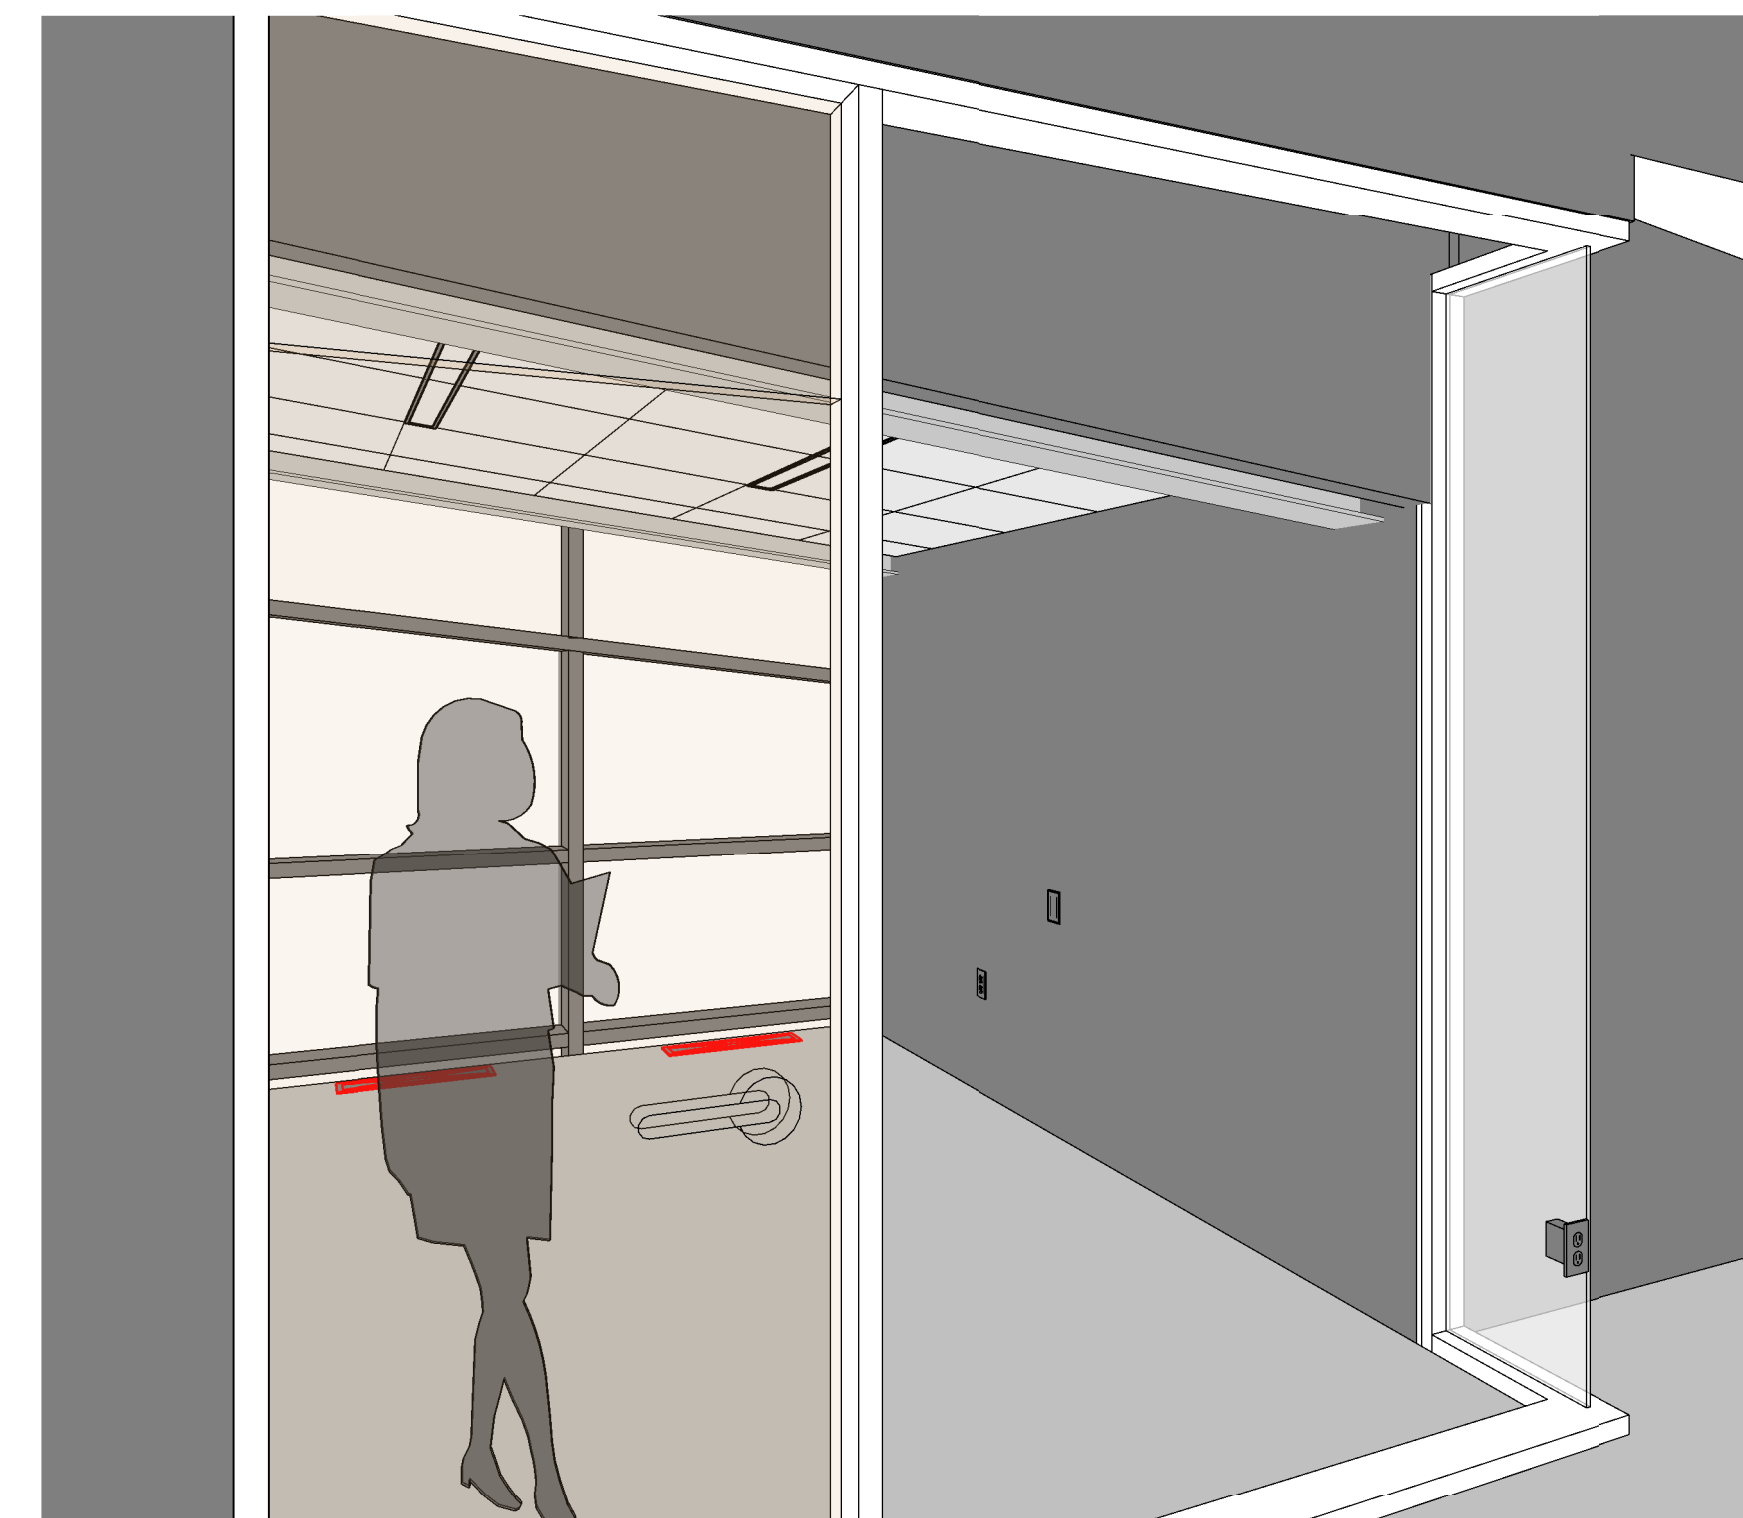

Placeholder_Soffit Detail_06/A0452

1 EXTERIOR SOFFIT
DETAIL
3" = 1'-0"