



PARIC CORPORATION
77 Westport Plaza Suite 250
St. Louis, MO 63146
TEL: 636-561-9500
FAX: 636-561-9501

REQUEST FOR INFORMATION DATE: February 21, 2017 NO.: RFI-452

To: Cannon Design

Attn: Kelvin Patel

From: Paric Corporation

Requested By: Joe Voypick

Project Name: 15051-Webster University Interdisciplinary Science Building Project No.: 15051

Subject: north courtyard stair wall dimensions

Response Required By: February 28, 2017

Drawing / Spec Reference:

Information Requested:

1. Please provide the dimension to the bottom of this wall (shown on A0508.C) based off of a grid line.
2. Per the attached shop drawing it appears the top of wall elevation 541.42 will not work with the run of the wall. Please advise correct dimensions/elevations to remain ADA compliant.

This can be addressed quickly via conference call if need be but the wall is being placed this week.

This can be addressed quickly via conference call if need be but the wall is being placed this week.

Response:


As discussed, see markups.

ARCHITECT'S RESPONSE:

This information is provided as an interpretation of the Contract Documents for implementation. It is not an authorization for change to the Contract Sum or Contract Time. If this information results in a claim for a change to the Contract, the Contractor shall notify the [Construction Manager][Architect] of a change through the change process.

Answered By: Kelvin Patel

Date: 02/21/2017

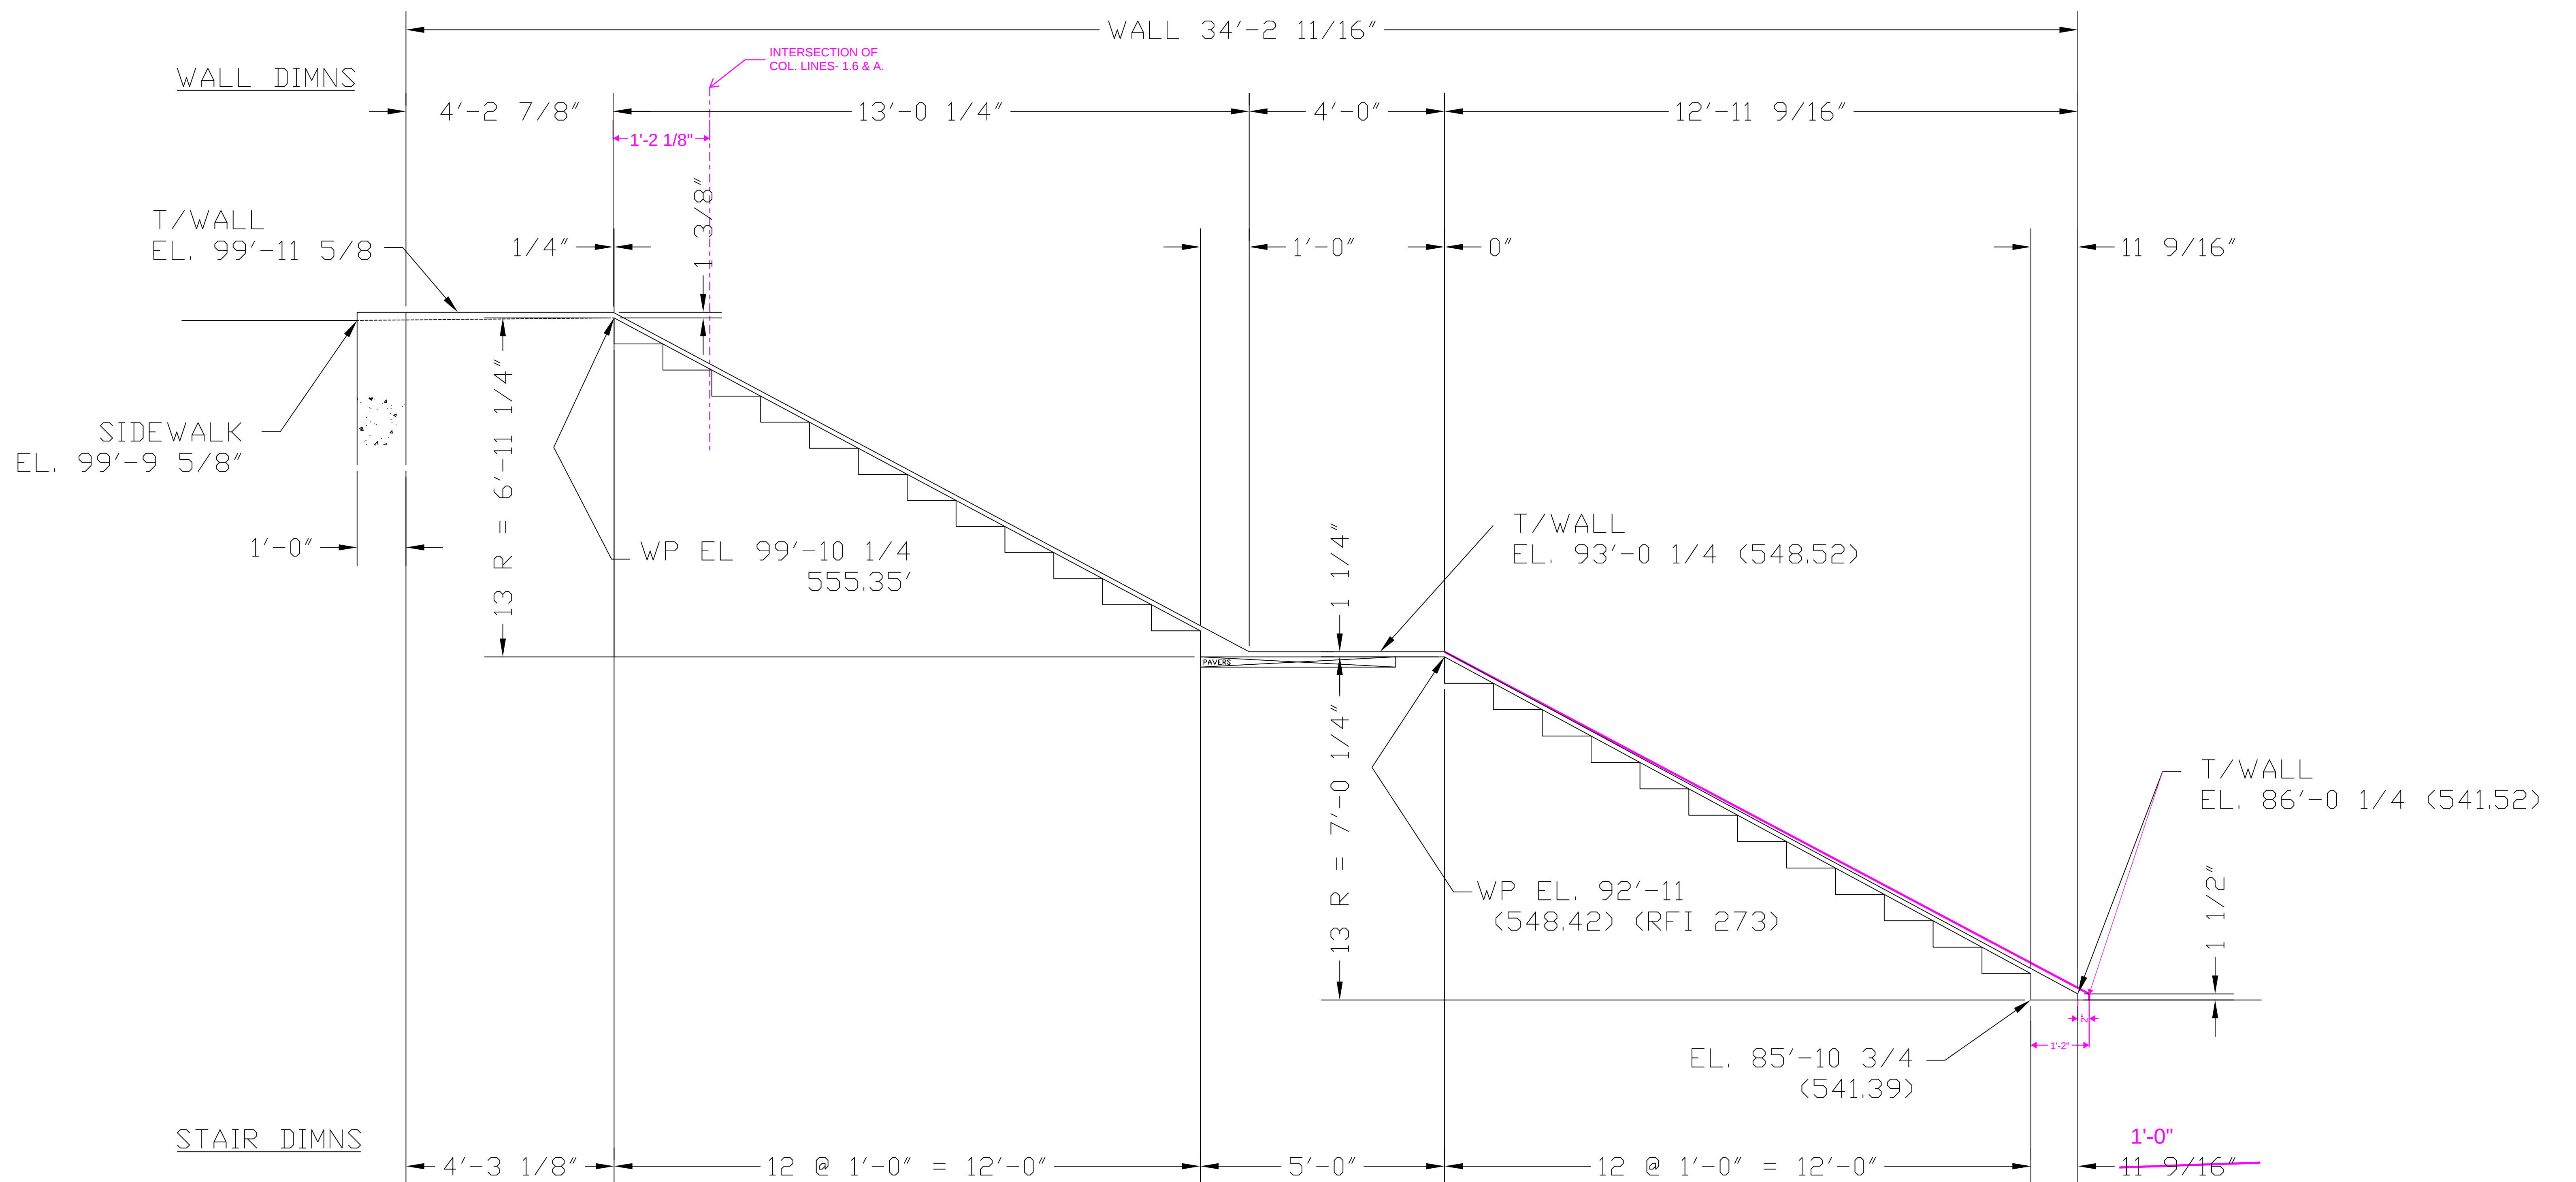

RETAINING WALL AND SOUTH SIDE OF STEPS AT THE WEST COURTYARD STAIR