



PARIC CORPORATION
77 Westport Plaza Suite 250
St. Louis, MO 63146
TEL: 636-561-9500
FAX: 636-561-9501

REQUEST FOR INFORMATION **DATE:** February 22, 2017 **NO.:** RFI-458

To: Cannon Design

Attn: Kelvin Patel

From: Paric Corporation

Requested By: Joe Voypick

Project Name: 15051-Webster University Interdisciplinary Science Building

Project No.: 15051

Subject: Rough In Location for LED Monitor

Response Required By: March 01, 2017


Drawing / Spec Reference:

Information Requested:

2/A0611 shows a LED monitor in the cadaver storage workroom. Please provide an elevation for the rough in and confirm if centering the rough in on the opening under the countertop between the cabinets is acceptable.

Response:

SEE SKETCH.
NO RECESS REQUIRED.
SURFACE MOUNTED LED MONITOR.

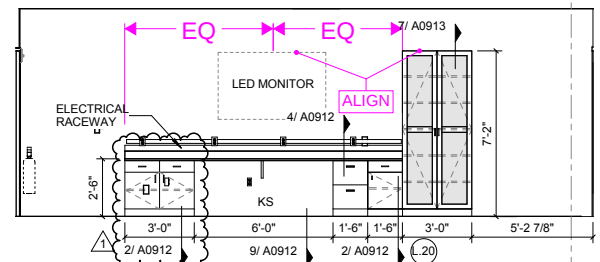

2 L01 CADAVER STORAGE/WORKROOM - WEST
1/4" = 1'-0"

ARCHITECT'S RESPONSE:

This information is provided as an interpretation of the Contract Documents for implementation. It is not an authorization for change to the Contract Sum or Contract Time. If this information results in a claim for a change to the Contract, the Contractor shall notify the [Construction Manager][Architect] of a change through the change process.

Answered By: Kelvin Patel

Date: 02/23/2017