



PARIC CORPORATION
77 Westport Plaza Suite 250
St. Louis, MO 63146
TEL: 636-561-9500
FAX: 636-561-9501

REQUEST FOR INFORMATION	DATE: March 14, 2017	NO.: RFI-482
--------------------------------	-----------------------------	---------------------

To: Cannon Design

Attn: Kelvin Patel

From: Paric Corporation

Requested By: Devin Gates

Project Name: 15051-Webster University Interdisciplinary Science Building	Project No.: 15051
---	--------------------

Subject: Alternate pre-rinse unit needed

Response Required By: March 21, 2017

Drawing / Spec Reference:

Information Requested:

Cannon has asked for a shorter pre-rinse unit to be provided so that it may fit under the wall cabinets. The pre-rinse spec'd cannot be customized due to the spring that holds the drench hose in place.

Suggestion: Please spec an alternate manufacturer if desired to work with current casework design.

Response:

THE ATTACHED PRE-RINSE UNIT WHICH IS APPROVED BY THE OWNER IS ACCEPTABLE, PROVIDED WATER FLOW PRESSURE IS SIMILAR TO THE PREVIOUSLY SUBMITTED TALL PRE-RINSE UNIT.

PROVIDE PRE-RINSE UNIT WITH VACUUM BREAKER

ARCHITECT'S RESPONSE:

This information is provided as an interpretation of the Contract Documents for implementation. It is not an authorization for change to the Contract Sum or Contract Time. If this information results in a claim for a change to the Contract, the Contractor shall notify the [Construction Manager][Architect] of a change through the change process.

Answered By: Kelvin Patel


03/24/2017
03/22/2017

Date: _____



CTPR1020 VB

PRE-RINSE UNIT, DECK MOUNTED

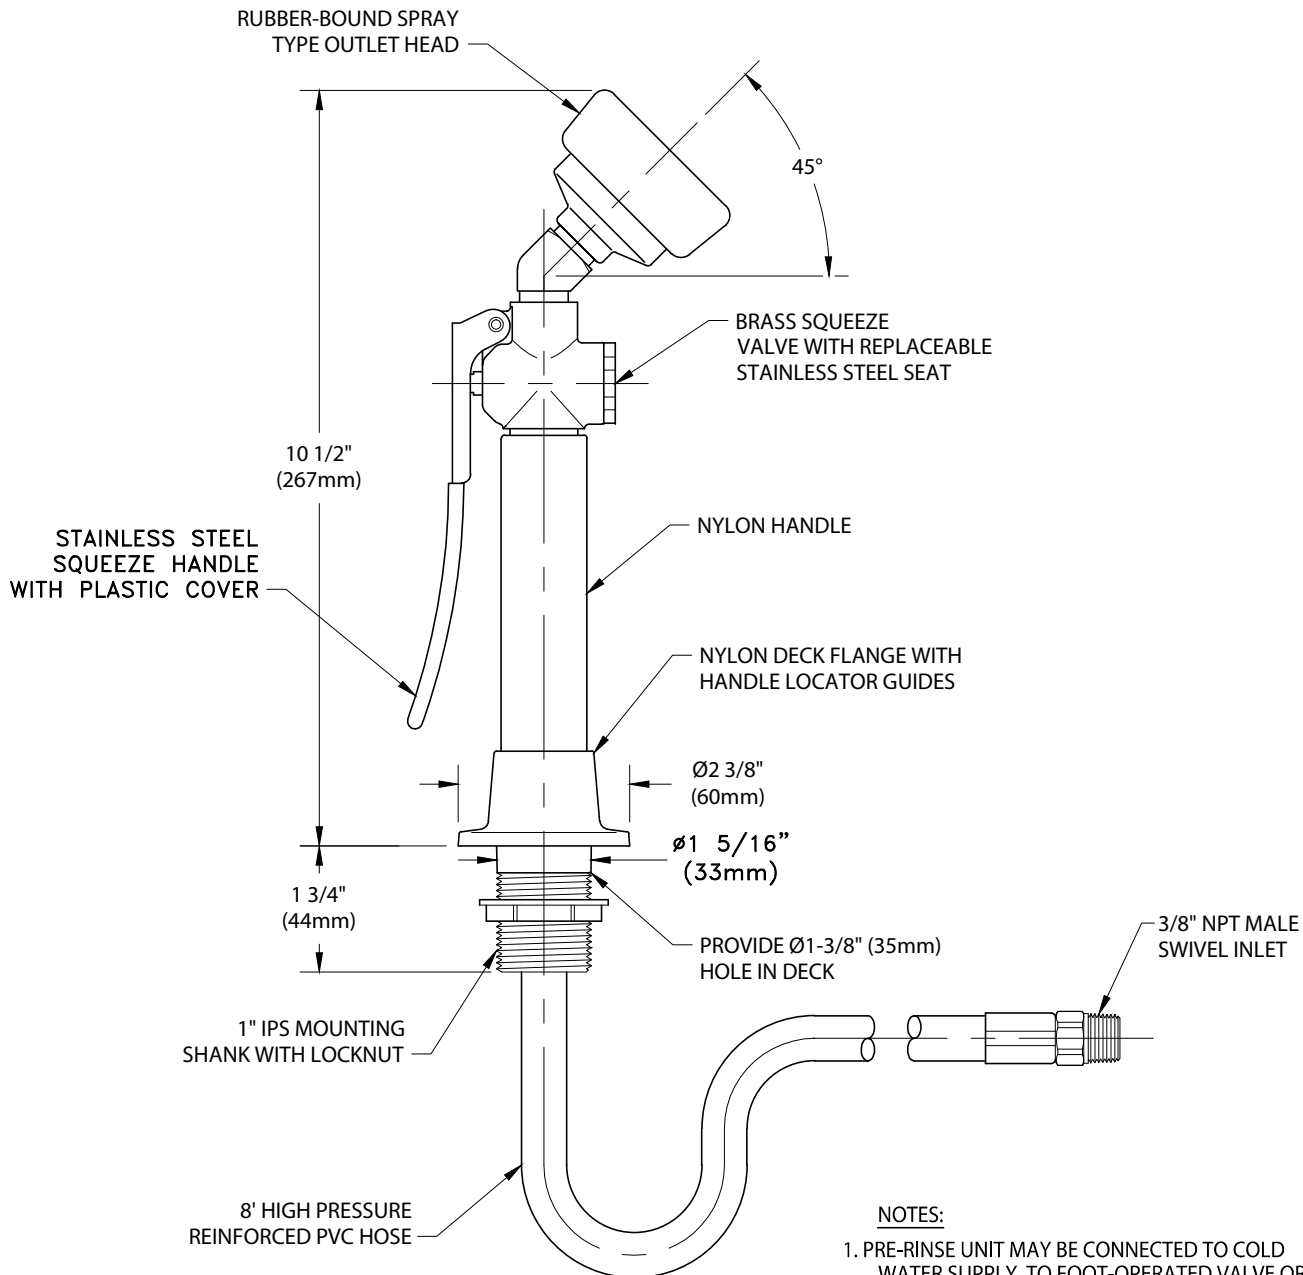

NOTES:

1. PRE-RINSE UNIT MAY BE CONNECTED TO COLD WATER SUPPLY, TO FOOT-OPERATED VALVE OR TO CT2200 SERIES WATER FIXTURES AS REQUIRED.
2. ~~IF VACUUM BREAKER IS REQUIRED, ADD SUFFIX "VB".~~
3. HOSE SHOULD NOT BE USED IN APPLICATIONS WHERE WATER PRESSURE EXCEEDS 90 PSI. INSPECT HOSE PERIODICALLY FOR DETERIORATION.
4. UNIT HAS COLORTECH EPOXY POWDER COATED FINISH. SPECIFY COLOR (WHITE, GRAY OR TAN) WHEN ORDERING.

VACUUM
BREAKER
REQUIRED


MEASUREMENTS MAY VARY $\pm 1/4$ " (6mm).

WaterSaver Faucet Co. 312 666 5500 t
701 West Erie Street 312 666 5501 f
Chicago, IL 60654 wsflab.com

Drawing Number:

Revised: 021313-TEC

PR1020 Pre-Rinse Unit

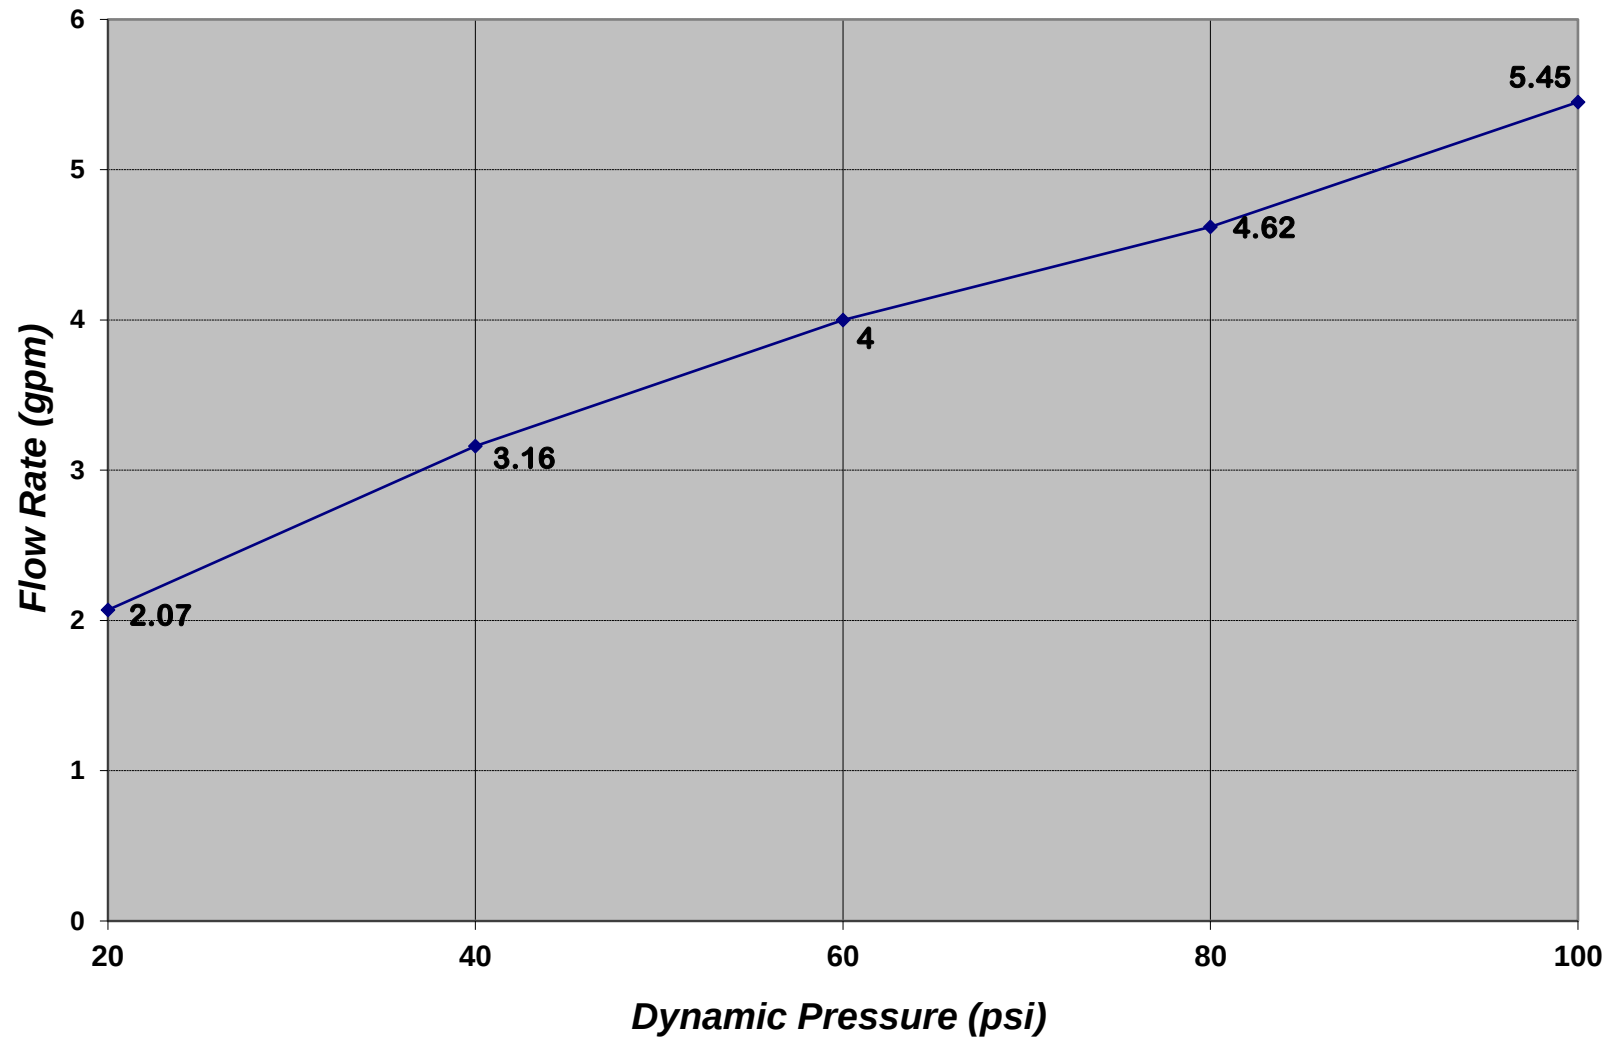

Patel, Kelvin

From: stephanie schroeder <schroeds@webster.edu>
Sent: Saturday, March 18, 2017 6:59 AM
To: Patel, Kelvin; Craig A. Miller, Sr.
Cc: Grossman, Lynn; Jain, Punit
Subject: Re: WU-ISB: Pre-rinse units at 291 & 391

Punit
I forwarded to Mary, since they will be used in her labs. She said they were fine.
Thank you
Stephanie

On March 17, 2017, at 7:13 PM, "Patel, Kelvin" <kpatel@cannondesign.com> wrote:

Hello Craig & Stephanie,

Please review the attached pre-rinse units for rooms **291** (CELL BIO / PHYS RESEARCH LAB) and **391** (ANATOMY / PHYSIO LAB).

Let us know if they are acceptable.

Thanks,

Kelvin Patel, CDT, LEED AP BD+C
Associate



1100 Clark Ave
St. Louis, Missouri 63102
T 314.425.8756
cannondesign.com