



PARIC CORPORATION
77 Westport Plaza Suite 250
St. Louis, MO 63146
TEL: 636-561-9500
FAX: 636-561-9501

REQUEST FOR INFORMATION **DATE:** March 15, 2017 **NO.:** RFI-486

To: Cannon Design

Attn: Kelvin Patel

From: Paric Corporation

Requested By: Joe Voypick

Project Name: 15051-Webster University Interdisciplinary Science Building Project No.: 15051

Subject: Curtainwall fin Splice locations

Response Required By: March 22, 2017

Drawing / Spec Reference:

Information Requested:

Please advise of where the splice locations for the fins are to be located in the tall curtainwall areas on the North, South and partial West elevation (there will be 2 splices in these areas). The splices can be minimized to approx. 1/4". We would suggest locating these adjacent to another horizontal element/floor line/etc.

Response:

PROVIDE FIN SPLICE LOCATION PER MARKUPS.

OPTION-1 (GREEN MARKUPS): FIN SPLICE LOCATION IF SPLICE IS NOT NEEDED AT WEST CANTILEVER.

OPTION-2 (MAGENTA MARKUPS): FIN SPLICE LOCATION IF SPLICE IS NEEDED AT WEST CANTILEVER.

IF POSSIBLE, PREFER NOT TO HAVE FIN SPLICE AT WEST CANTILEVERED PORTION.

ARCHITECT'S RESPONSE:

This information is provided as an interpretation of the Contract Documents for implementation. It is not an authorization for change to the Contract Sum or Contract Time. If this information results in a claim for a change to the Contract, the Contractor shall notify the [Construction Manager][Architect] of a change through the change process.

Answered By: Kelvin Patel


Date: 03/21/2017



Kathy R. Williams
3.13.16

CONFORMED SET 30 JAN 2017

5	ASI-026	30 AUG 2016
4	ASI-022	23 AUG 2016
3	ADDENDUM 1-11	13 MAY 2016
2	ADDENDUM 1-7	16 MAR 2016
1	ADDENDUM 1-1	29 JAN 2016
ISSUED FOR CONSTRUCTION (BP1)		15 JAN 2016
No.	Description	Date

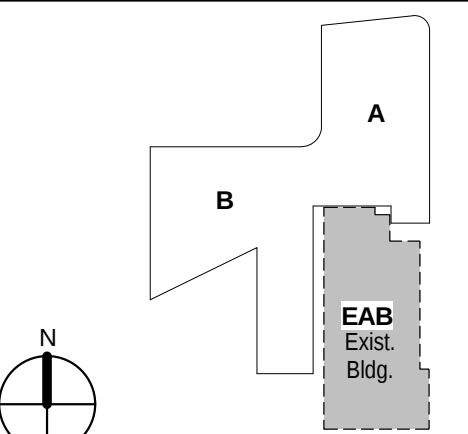

KEY PLAN

EXTERIOR ELEVATIONS

Project No.: 04561.01 Checked by:

A0312

FIN SPLICE LOCATION IF SPLICE IS NOT
NEEDED AT WEST CANTILEVER.

FIN SPLICE ONLY IF REQUIRED.
PREFER TO NOT HAVE FIN SPLICE
IN THIS AREA

FIN SPLICE LOCATION IF SPLICE IS NOT
NEEDED AT WEST CANTILEVER.

FIN SPLICE ONLY IF REQUIRED.
PREFER TO NOT HAVE FIN SPLICE
IN THIS AREA

2 NORTH ELEVATION
1/8" = 1'-0"

1 SOUTH ELEVATION
1/8" = 1'-0"