



PARIC CORPORATION
77 Westport Plaza Suite 250
St. Louis, MO 63146
TEL: 636-561-9500
FAX: 636-561-9501

REQUEST FOR INFORMATION	DATE: March 29, 2017	NO.: RFI-501
--------------------------------	-----------------------------	---------------------

To: Cannon Design

Attn: Kelvin Patel

From: Paric Corporation

Requested By: Joe Voypick

Project Name: 15051-Webster University Interdisciplinary Science Building

Project No.: 15051

Subject: Vacuum Pump Exhaust Vent and Natural Gas Venting Locations

Response Required By: April 05, 2017

Drawing / Spec Reference:

Information Requested:

Proposed natural gas and vacuum pump exhaust vent locations are attached. Locations chosen to follow applicable code (below) and to be concealed as much as possible. Vents will be between 6' and 10' above intake louver. All three vents will turn down to prevent water/debris infiltration.

2009 IMC states in section 401.4 "intake opening shall be located not less than 3ft below contaminant sources where such sources are located within 10ft of the opening."

Response:

Contractor proposed vent pipe discharge locations appear to be acceptable to WTA and meet the intent of the Code. Contractor to properly install any dissimilar metals to avoid galvanic corrosion. Architect has requested vent pipes to be painted to match the exterior of the building. Coordinate color and final location with Architect.

ARCHITECT'S RESPONSE:


This information is provided as an interpretation of the Contract Documents for implementation. It is not an authorization for change to the Contract Sum or Contract Time. If this information results in a claim for a change to the Contract, the Contractor shall notify the [Construction Manager][Architect] of a change through the change process.

Answered By: Mike Nolte, WTA

Date: 4/11/17

CONFORMED SET 01 JUL 2016


1 ADDENDUM 3-1 05 APR 2016
ISSUED FOR CONSTRUCTION (BP3) 15 MAR 2016

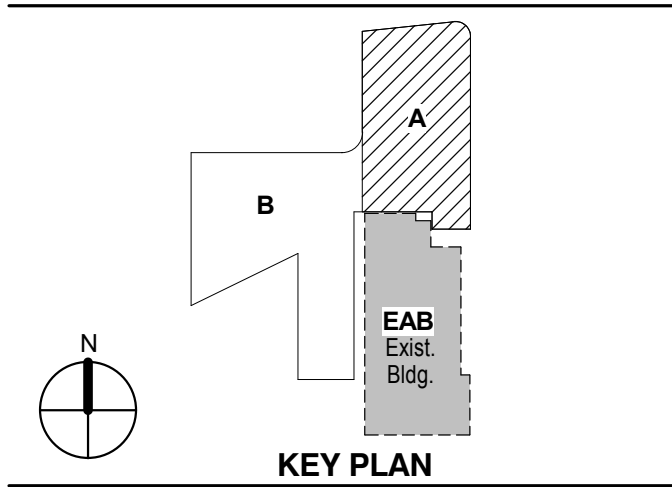

Drawing Title:
**LEVEL 01 AREA A FLOOR
PLAN**

Project No.: 04561.01 Checked by:

A0101.A

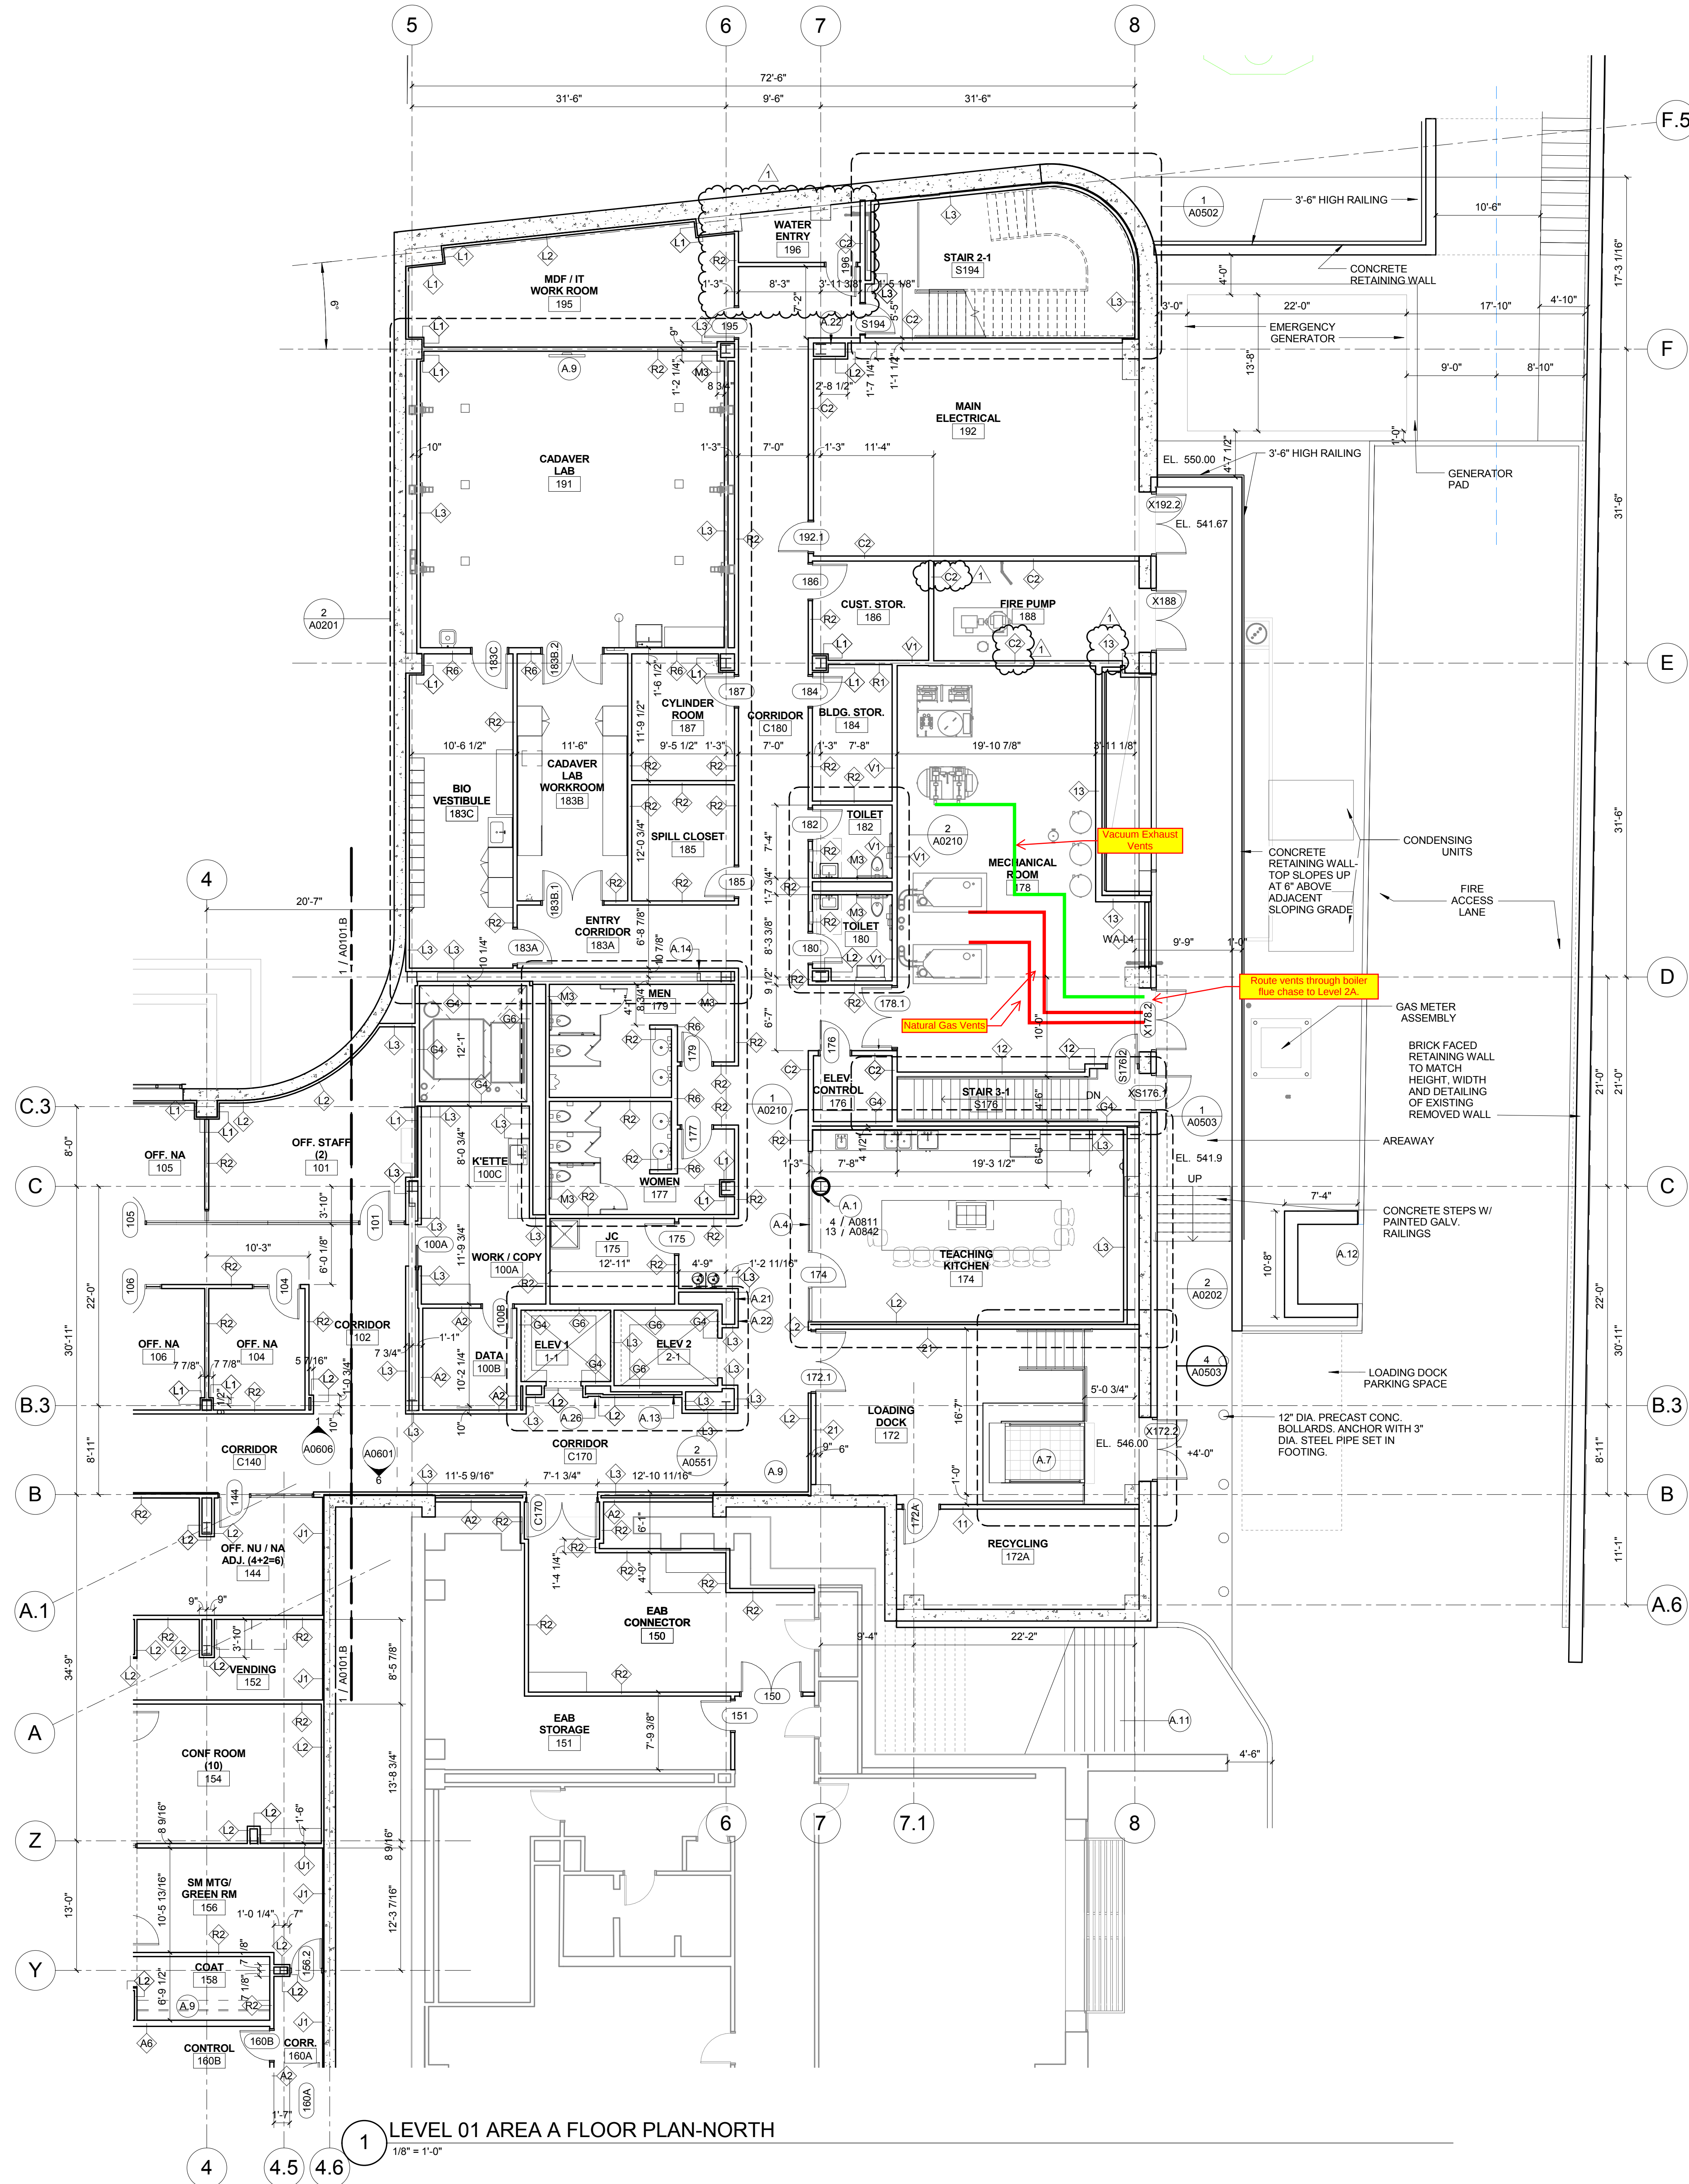

LEVEL 01 AREA A FLOOR PLAN-NORTH

1/8" = 1'-0"

William Tao & Associates, Inc.
MEP/FP Engineer
7955 Manchester Road, Suite 125
St. Louis, MO 63143
314-884-7600

David Mason & Associates, Inc.
Structural & Civil Engineer
800 South Vandeventer Avenue
St. Louis, MO 63110
314-534-1053

Faith Group
Technology
3101 S. Hanley Rd. Suite 100
St. Louis, MO 63143
314-991-2228

Kuhmann Leavitt, Inc.
Environmental Graphics & Signage
7400 Pershing Ave.
St. Louis, MO 63130
314-725-6616

KWA Architects
Architecture
9721 Litzinger Road
St. Louis, MO 63124
314-962-2560

Spellman Brady & Company
Interior Designer
8251 Maryland Avenue, Suite 300
St. Louis, MO 63105
314-862-0070


SWT Design
Landscape Architect
7722 Big Bend Blvd
St. Louis, MO 63119
314-644-5700

Webb Engineering Services, Inc.
Planning & Fire Protection
1400 S. 3rd Street, Suite 201
St. Louis, MO 63104
314-588-0600

CONFORMED SET 01 JUL 2016

ISSUED FOR CONSTRUCTION (BP1) 15 JAN 2016

No.	Description	Date

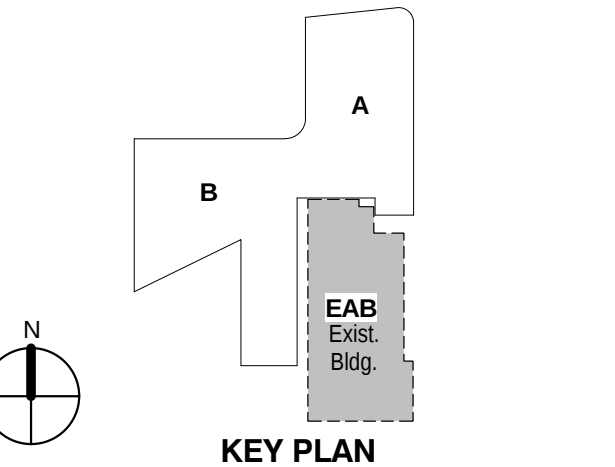


Drawing Title:


BUILDING SECTIONS

Project No.: 04561.01 Checked by:


A0331

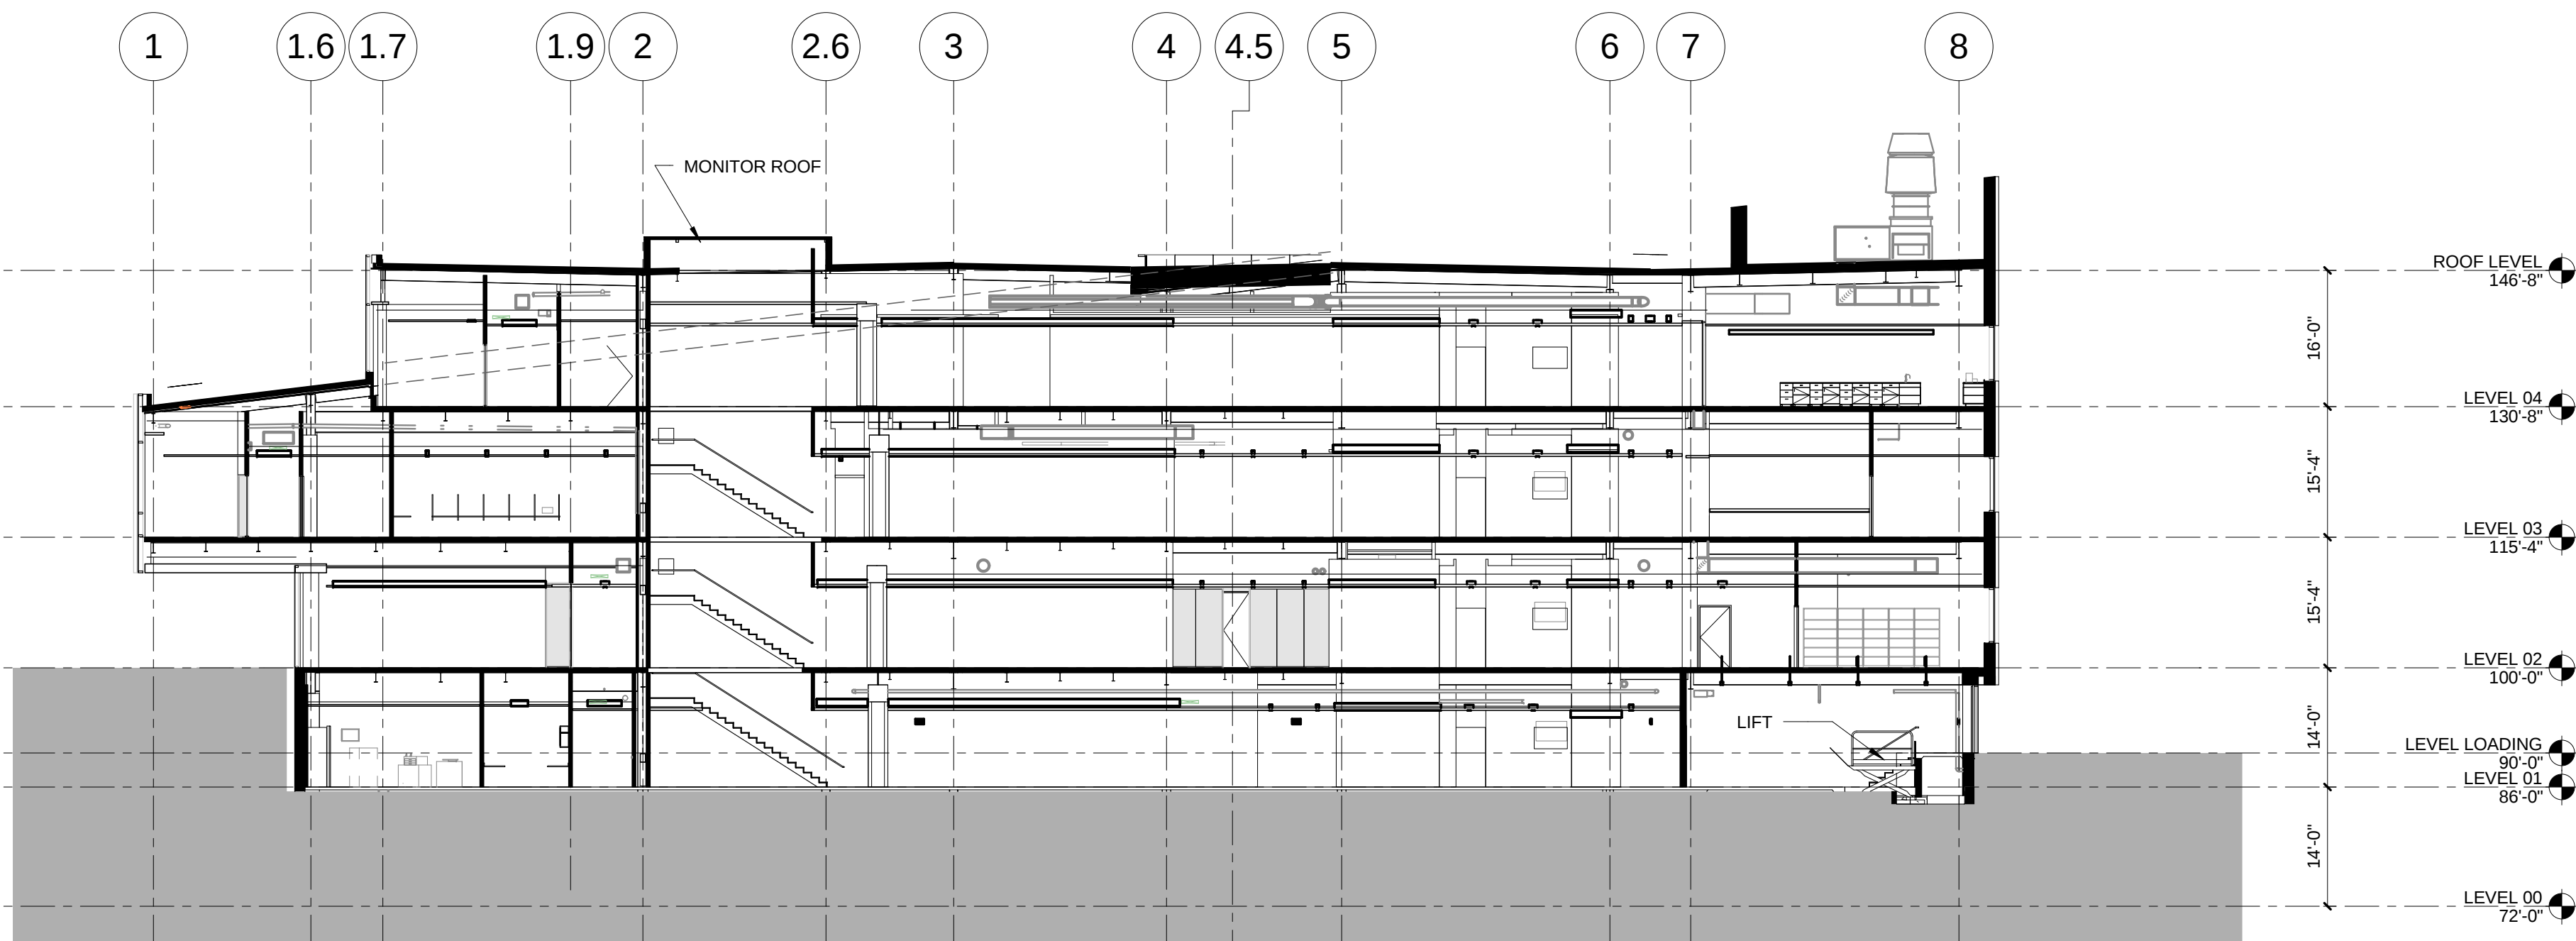


4 EAST WEST BUILDING SECTIONS
1/16" = 1'-0"

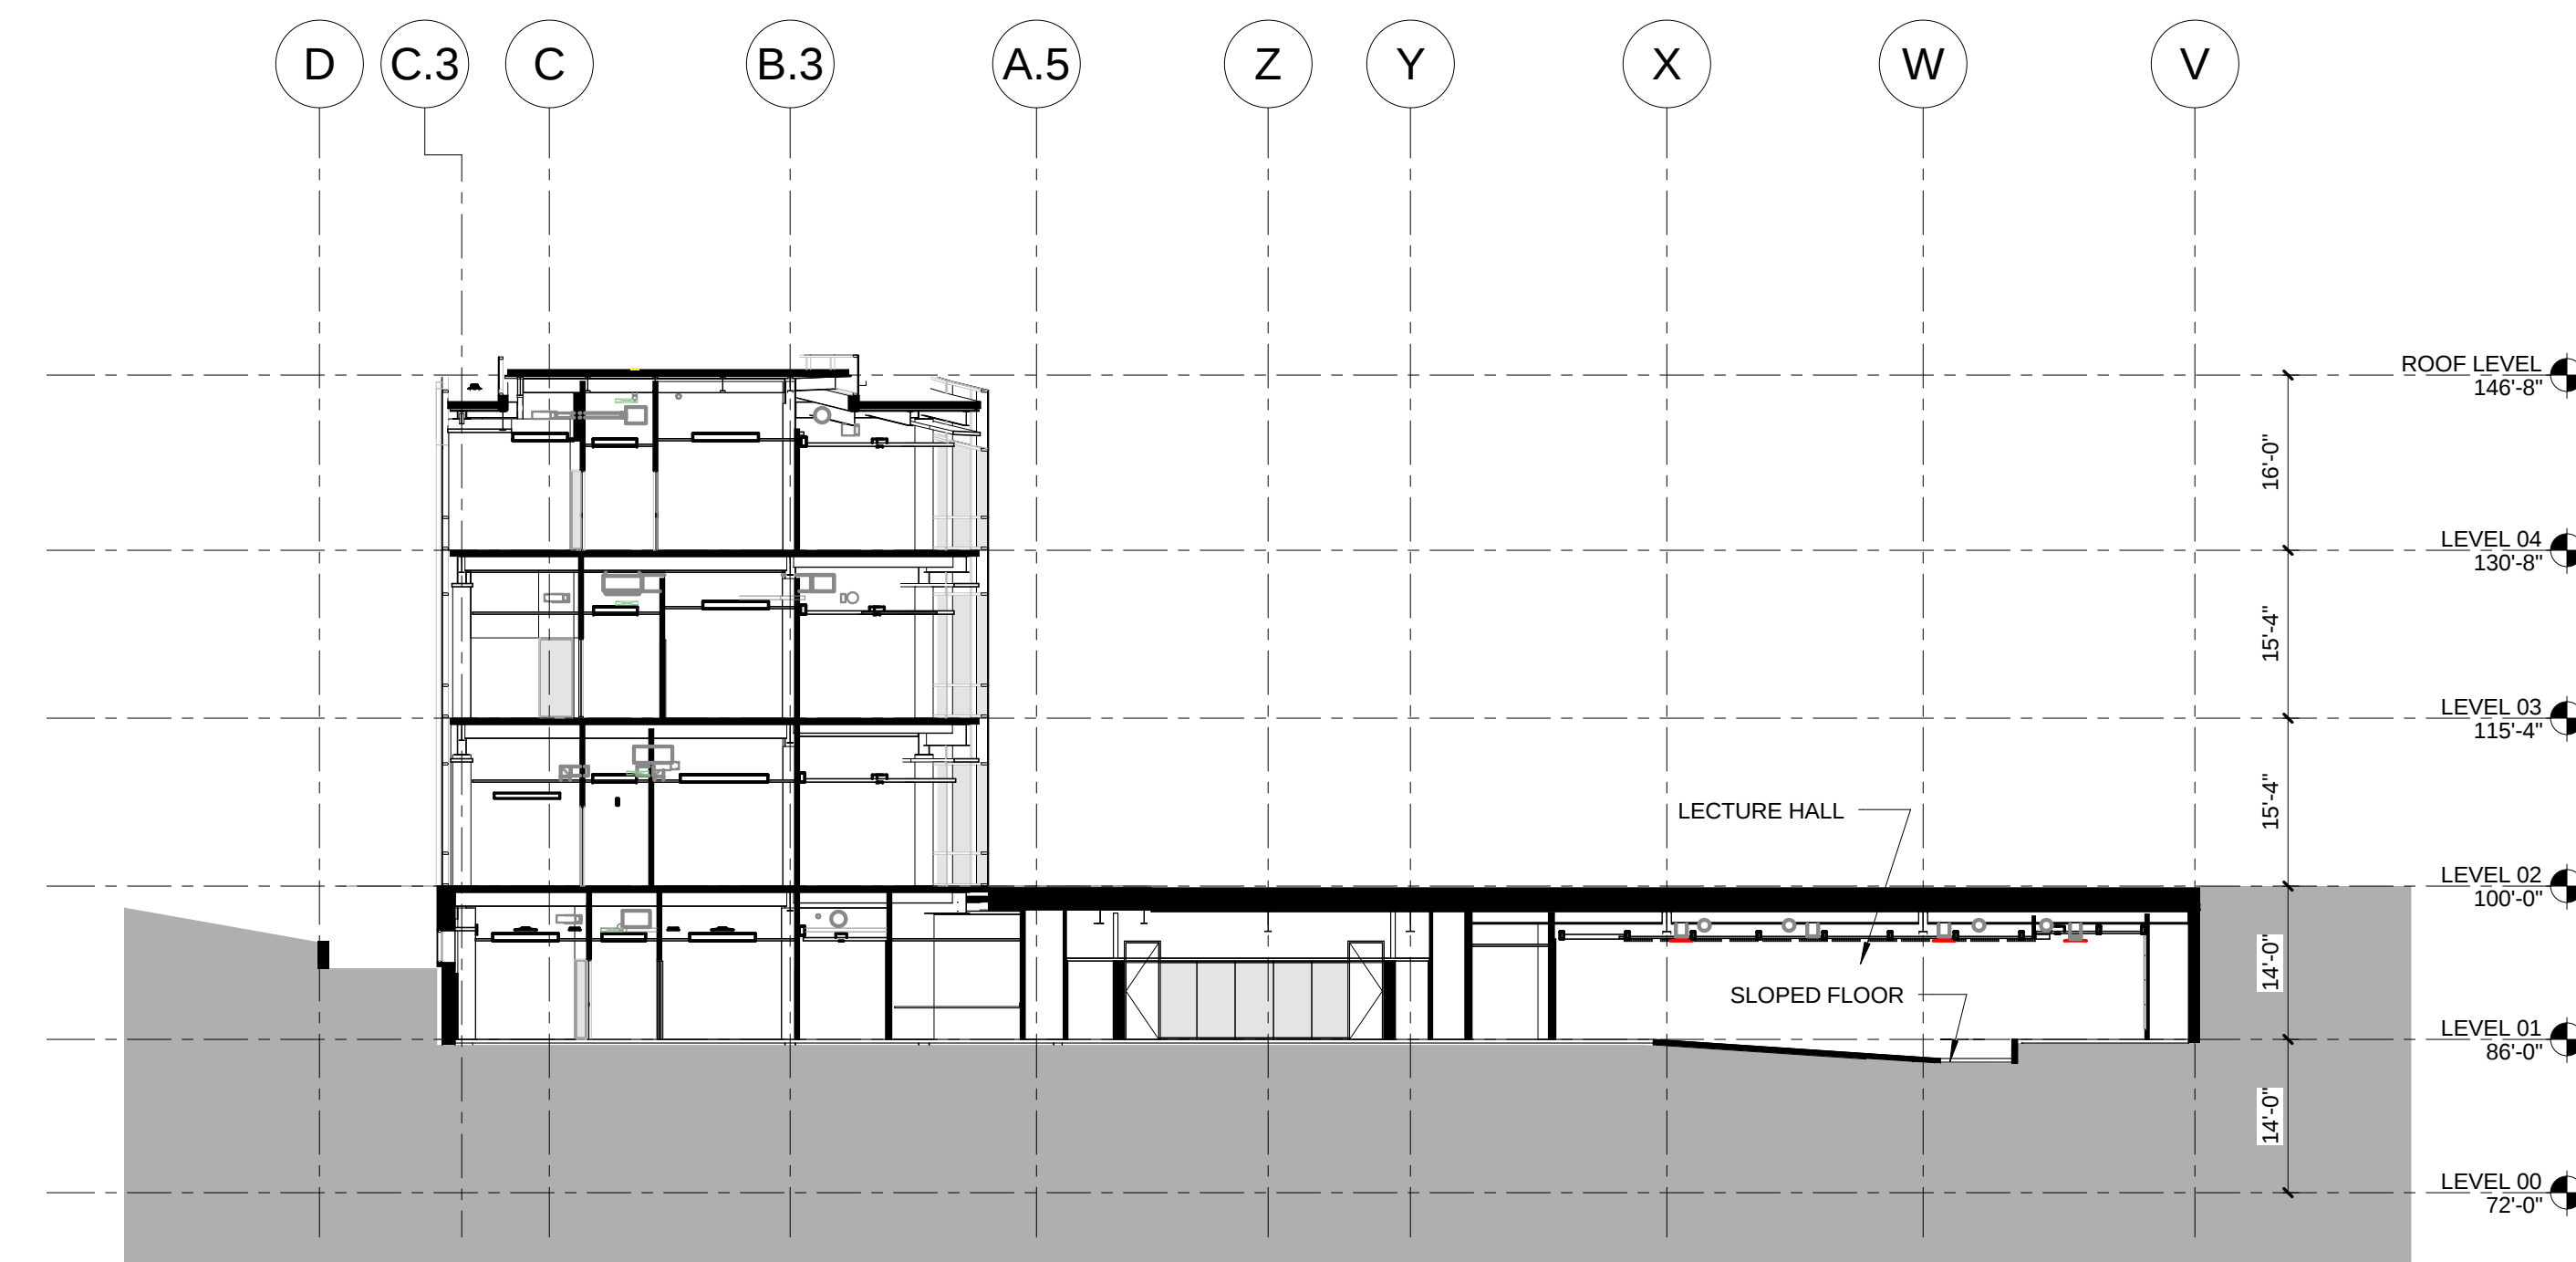

3 NORTH SOUTH AUDITORIUM BUILDING SECTIONS
1/16" = 1'-0"

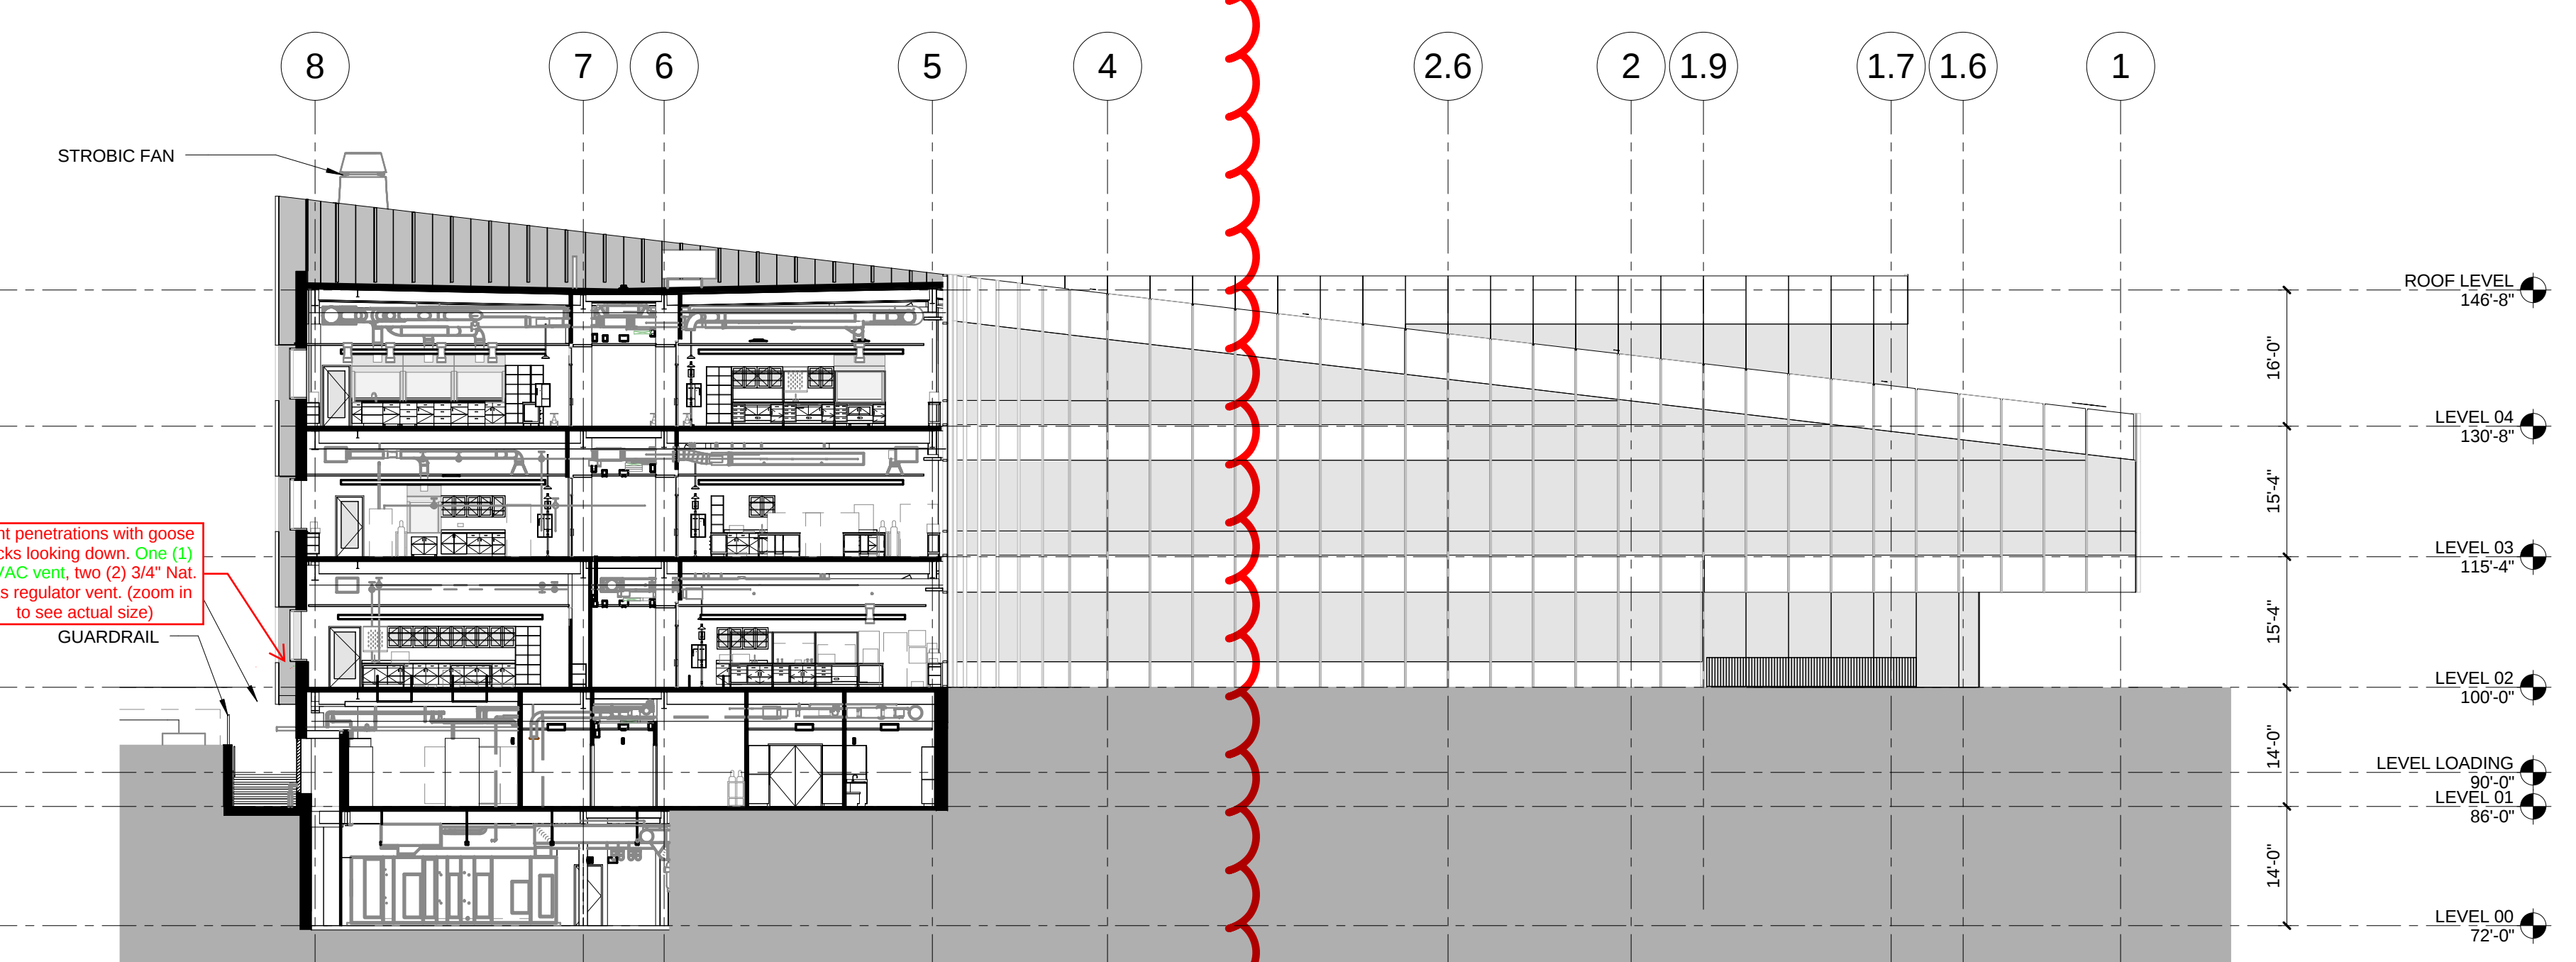

2 SECTION THROUGH NORTH WING LOOKING SOUTH BUILDING SECTIONS
1/16" = 1'-0"

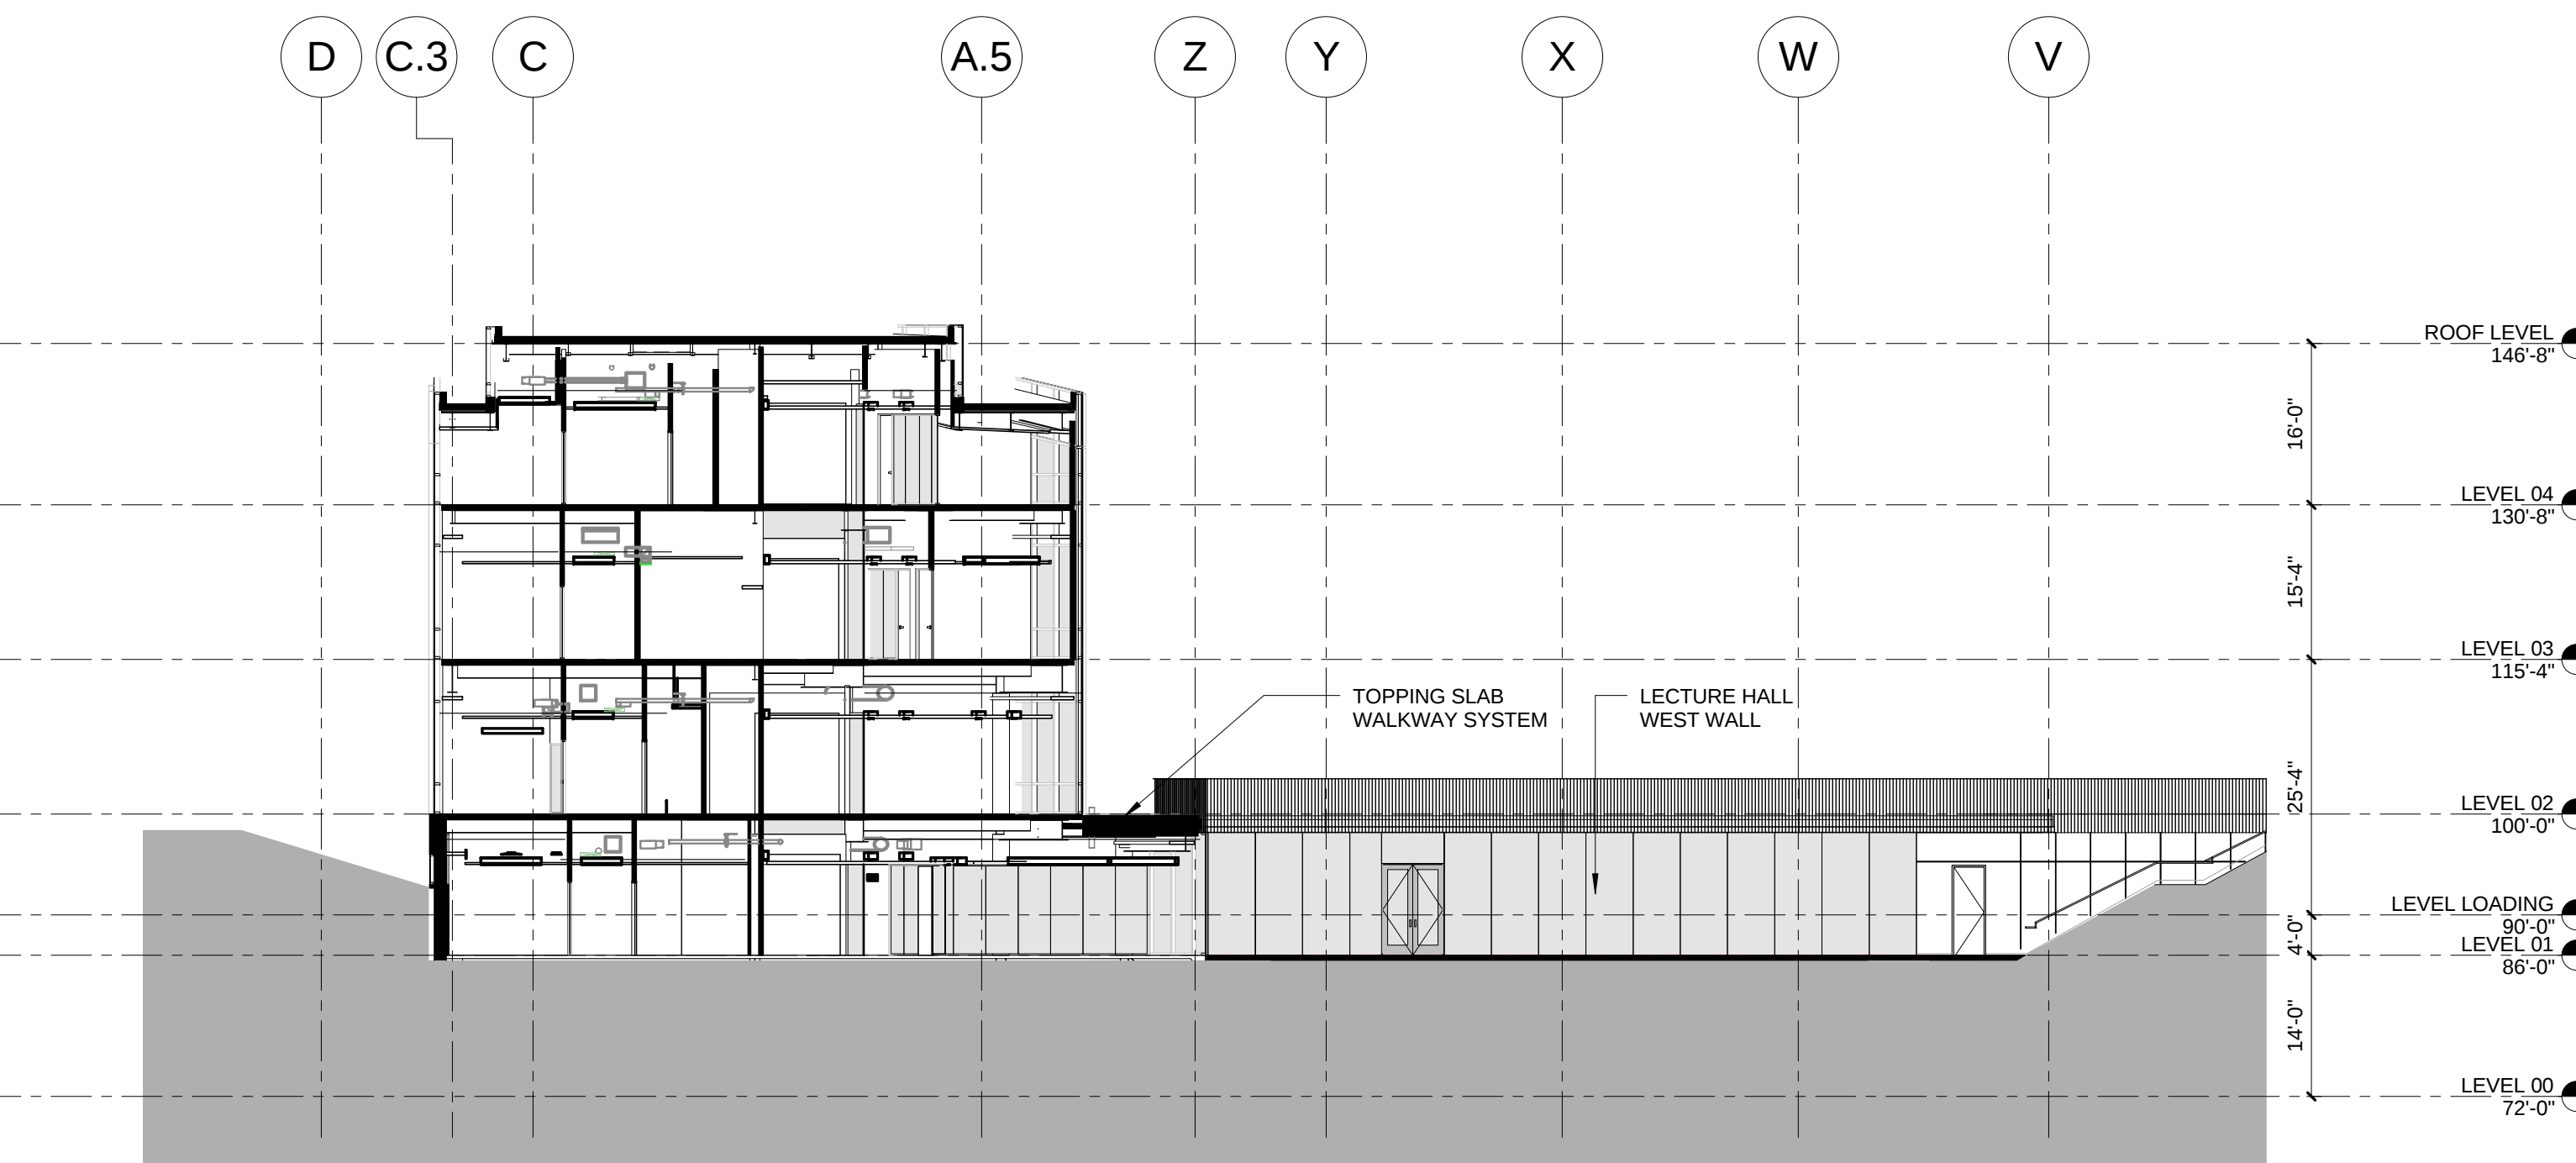

1 NORTH SOUTH COURTYARD BUILDING SECTIONS
1/16" = 1'-0"

