



PARIC CORPORATION
77 Westport Plaza Suite 250
St. Louis, MO 63146
TEL: 636-561-9500
FAX: 636-561-9501

REQUEST FOR INFORMATION	DATE: March 31, 2017	NO.: RFI-505
--------------------------------	-----------------------------	---------------------

To: Cannon Design

Attn: Kelvin Patel

From: Paric Corporation

Requested By: Devin Gates

Project Name: 15051-Webster University Interdisciplinary Science Building	Project No.: 15051
---	--------------------

Subject: Additional angle needed for masonry

Response Required By: April 07, 2017

Drawing / Spec Reference:

Information Requested:

Structural steel was fabricated and installed per 13/S303 which has a 9" gap between the horizontal and vertical supports (see attached photo). This will not provide sufficient support to install the masonry per 1/A423. Paric proposes to extend the horizontal support to the vertical support.

Suggestion: Please advise of acceptable method.

Response: A HORIZONTAL CLOSURE PIECE IS ACCEPTABLE. 1/4" IS SUFFICIENT WITH A 1" OVERLAP ON THE HORIZ LEG OF THE EXISTING ANGLE. BOTTOM OF FIRST BRICK WILL NEED TO BE COPED IN ORDER FOR THE HORIZ JOINT TO REMAIN A CONSISTENT WIDTH. FIELD WELD T&B. OPTION: PARTIAL BEVEL AND BUTT WELD TOP FOR FLUSH SURFACE AND NO ADJUSTMENT TO BOTTOM OF FIRST BRICK.


ARCHITECT'S RESPONSE:

This information is provided as an interpretation of the Contract Documents for implementation. It is not an authorization for change to the Contract Sum or Contract Time. If this information results in a claim for a change to the Contract, the Contractor shall notify the [Construction Manager][Architect] of a change through the change process.

Answered By: JILL WALKER / DMA


Date: 03.31.2017

1/4" PLATE
OVERLAP FOR TOP/BOTTOM FIELD WELD
OR BEVEL AND FIELD WELD FOR FLUSH
TOP SURFACES.
COORD PL SIZE WITH THE FIELD AND COPE
BOTTOM OF FIRST BRICK AS REQUIRED TO
MAINTAIN HORIZONTAL BRICK JOINT WIDTH.

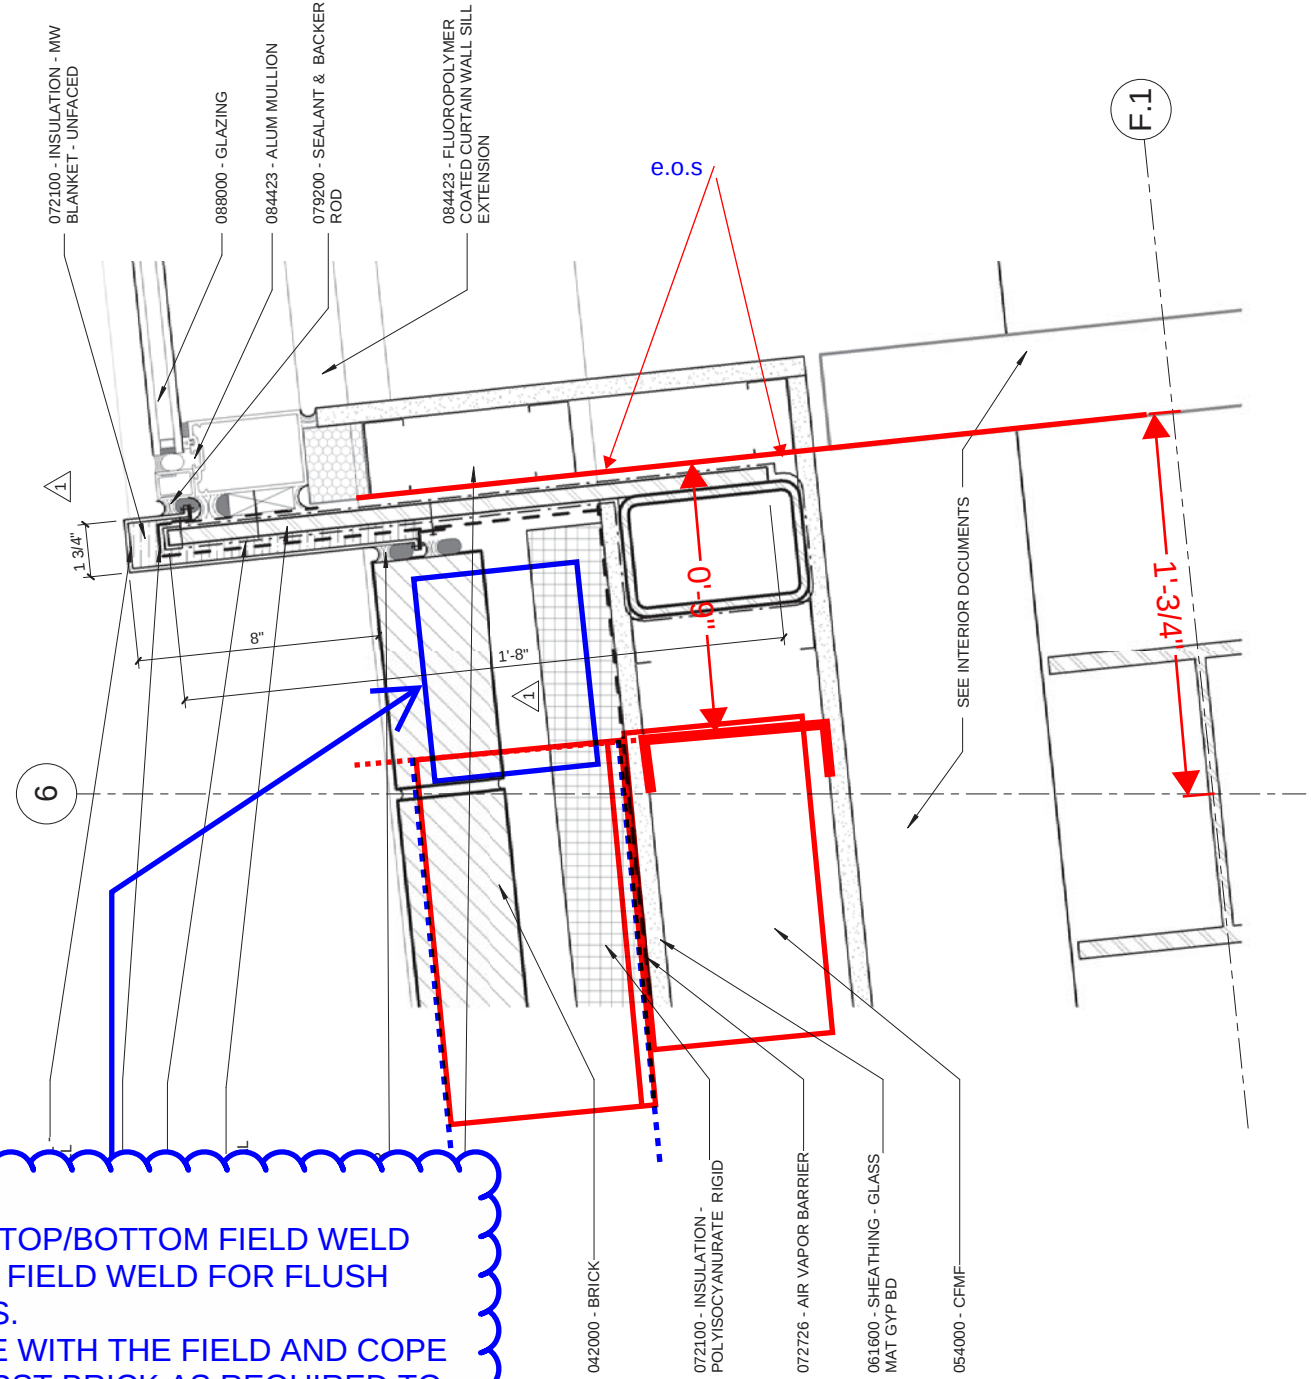


1 PLAN DETAIL - NORTH PROJECTED CURTAINWALL

WALL

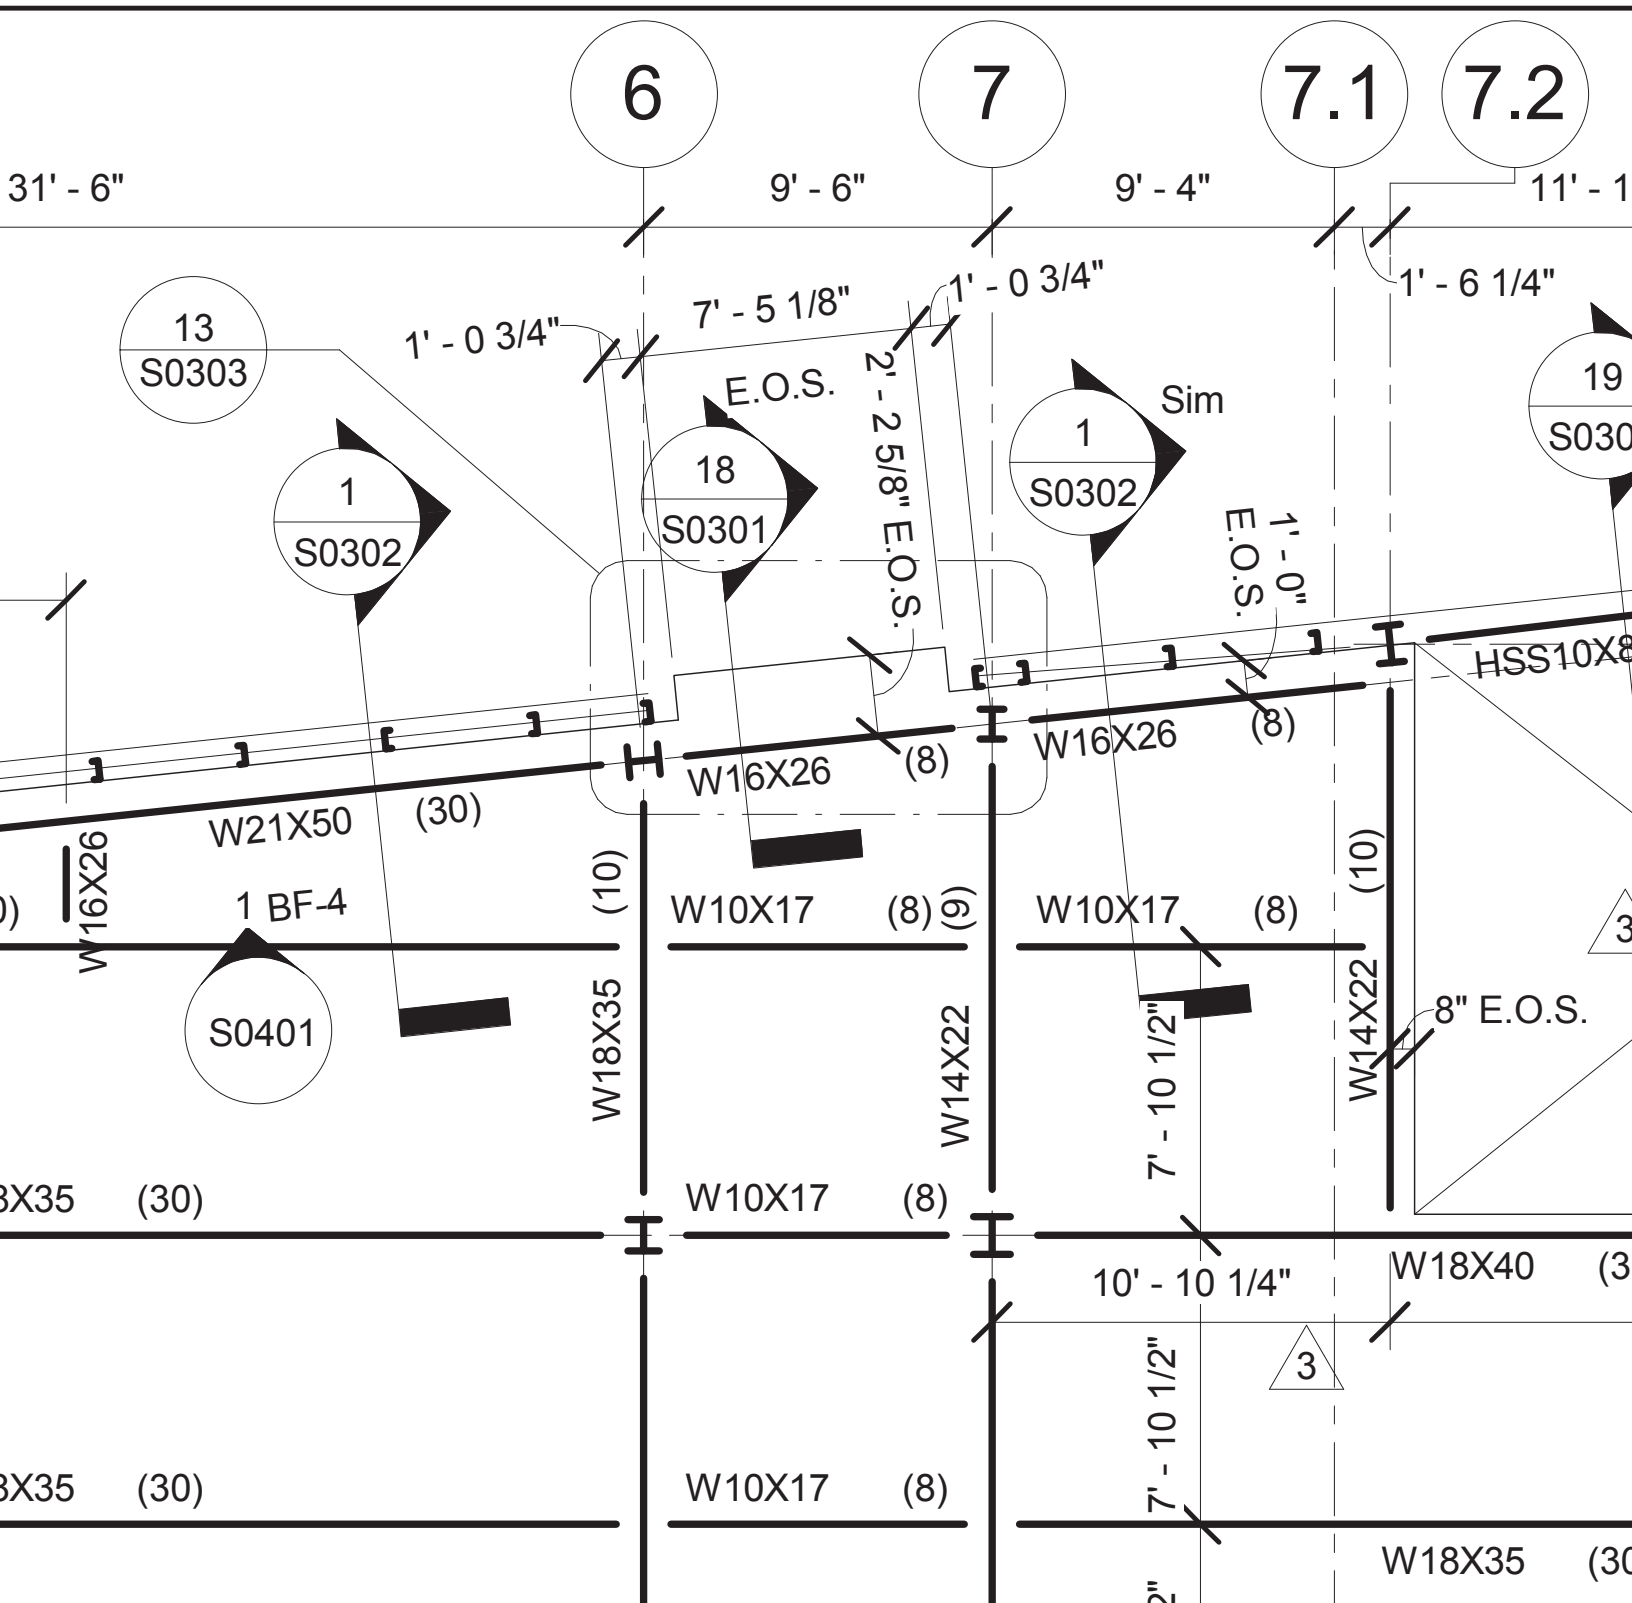

6 FRAMING SECTION
3/4" = 1'-0"


H
TES
BEAM

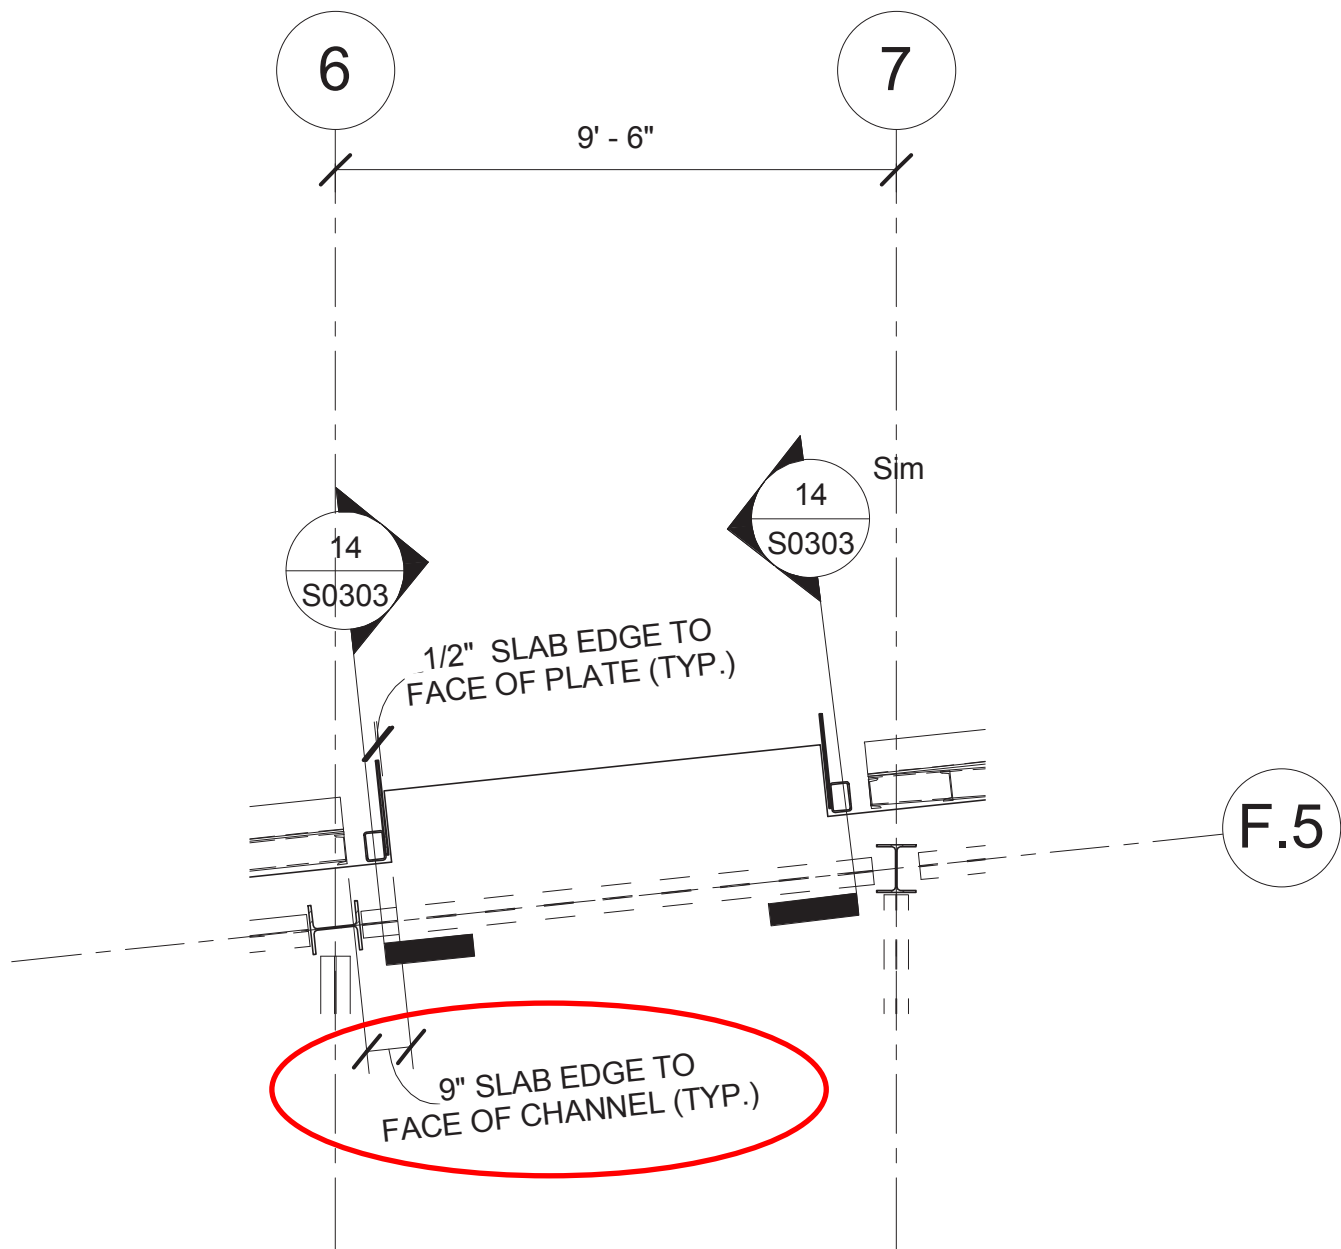

13 ENLARGED PLAN DETAIL
1/4" = 1'-0"

B



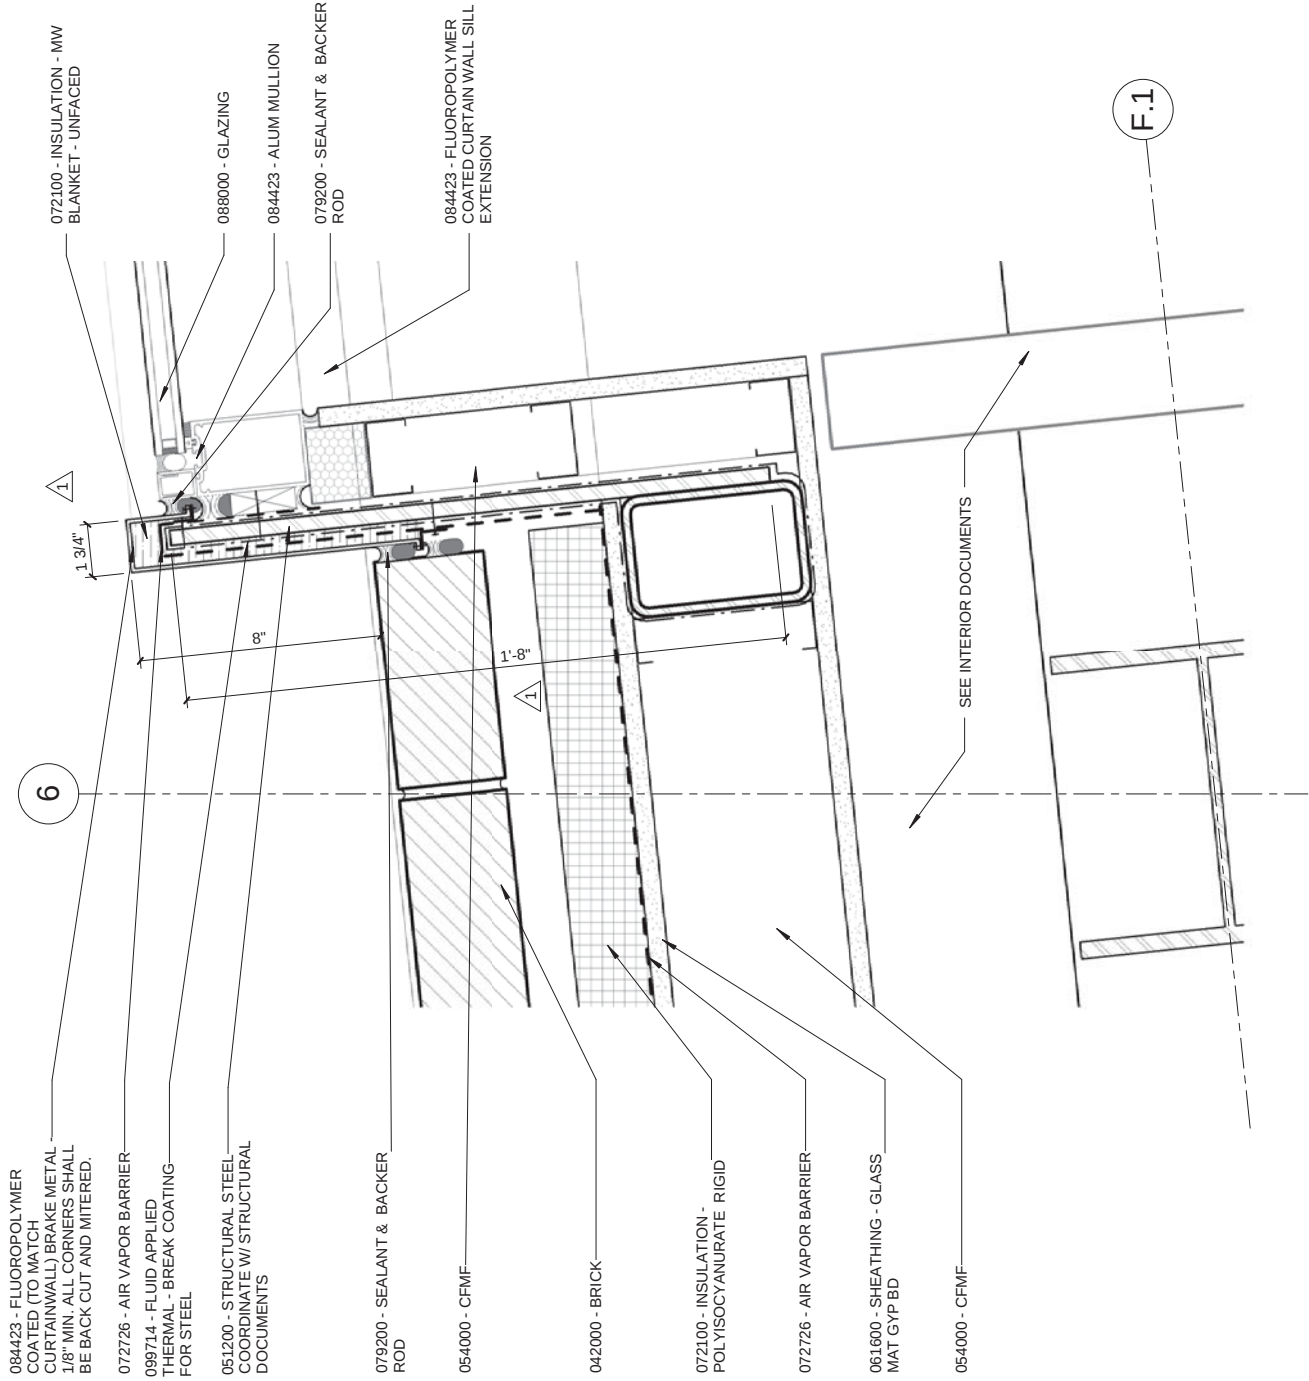

1 PLAN DETAIL - NORTH PROJECTED CURTAINWALL

3" = 1'-0"