



PARIC CORPORATION
77 Westport Plaza Suite 250
St. Louis, MO 63146
TEL: 636-561-9500
FAX: 636-561-9501

REQUEST FOR INFORMATION	DATE: May 26, 2017	NO.: RFI-550
--------------------------------	---------------------------	---------------------

To: Cannon Design

Attn: Kelvin Patel

From: Paric Corporation

Requested By: Ryan Tune

Project Name: 15051-Webster University Interdisciplinary Science Building	Project No.: 15051
---	--------------------

Subject: Vanity countertop shop layout

Response Required By: June 02, 2017

Drawing / Spec Reference:

Information Requested:

Proposed sink will not fit dimensionally. Attached are some details and drawings from the countertop manufacturer with what they think will solve the problem. Please review and respond ASAP.

Response:

proposed smaller lavatory is acceptable
verify that plumbing requirements match

ARCHITECT'S RESPONSE:

This information is provided as an interpretation of the Contract Documents for implementation. It is not an authorization for change to the Contract Sum or Contract Time. If this information results in a claim for a change to the Contract, the Contractor shall notify the [Construction Manager][Architect] of a change through the change process.

Answered By: Lynn Grossman

Date: 05.26.17

American Standard

Style That Works Better

 **BARRIER FREE****OVALYN™
UNDERCOUNTER SINK
VITREOUS CHINA****OVALYN™ UNDERCOUNTER SINK**

- Classic oval undermount sink
- Made from vitreous china
- Front overflow
- Supplied with mounting kit (047194-0070A) and template

☐ **0495.221 Unglazed rim**

435 x 359mm
(17-1/8" x 14-1/8")

☐ **0495.300 Glazed underside****Bowl size:**

382mm (15-1/16") wide
306mm (12-1/16") front to back
140mm (5-1/2") deep

☐ **0496.221 Unglazed rim**

489 x 413mm
(19-1/4" x 16-1/4")

☐ **0496.300 Glazed underside****Bowl size:**

432mm (17") wide
356mm (14") front to back
140mm (5-1/2") deep

☒ **0497.221 Unglazed rim**

546 x 441mm
(21-1/2" x 17-3/8")

☐ **0497.300 Glazed underside****Bowl size:**

483mm (19") wide
391mm (15-3/8") front to back
140mm (5-1/2") deep

Compliance Certifications -**Meets or Exceeds the Following Specifications:**

- ASME A112.19.2M for Vitreous China Fixtures
- CAN/CSA B45 series


To Be Specified:

- ☒ Color: ☒ White ☐ Bone ☐ Linen
☐ Silver ☐ Fawn Beige ☐ Black
- ☐ Faucet*:
☐ Faucet Finish:
☐ Supplies:
☐ 1-1/4" Trap:

* See faucet section for additional models available




SEE REVERSE FOR ROUGHING-IN DIMENSIONS

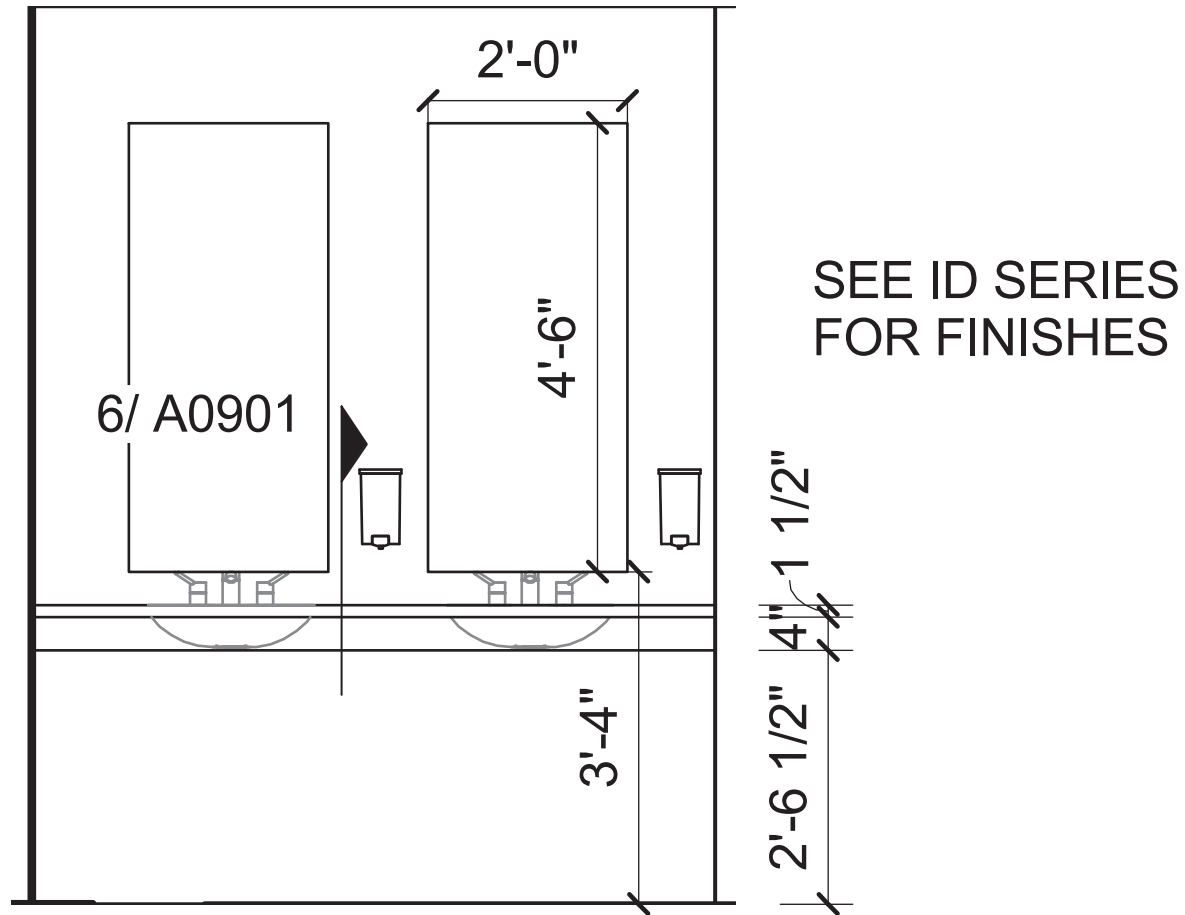

3

TOILET ROOMS MAIN - ELEVATION

1/4" = 1'-0"

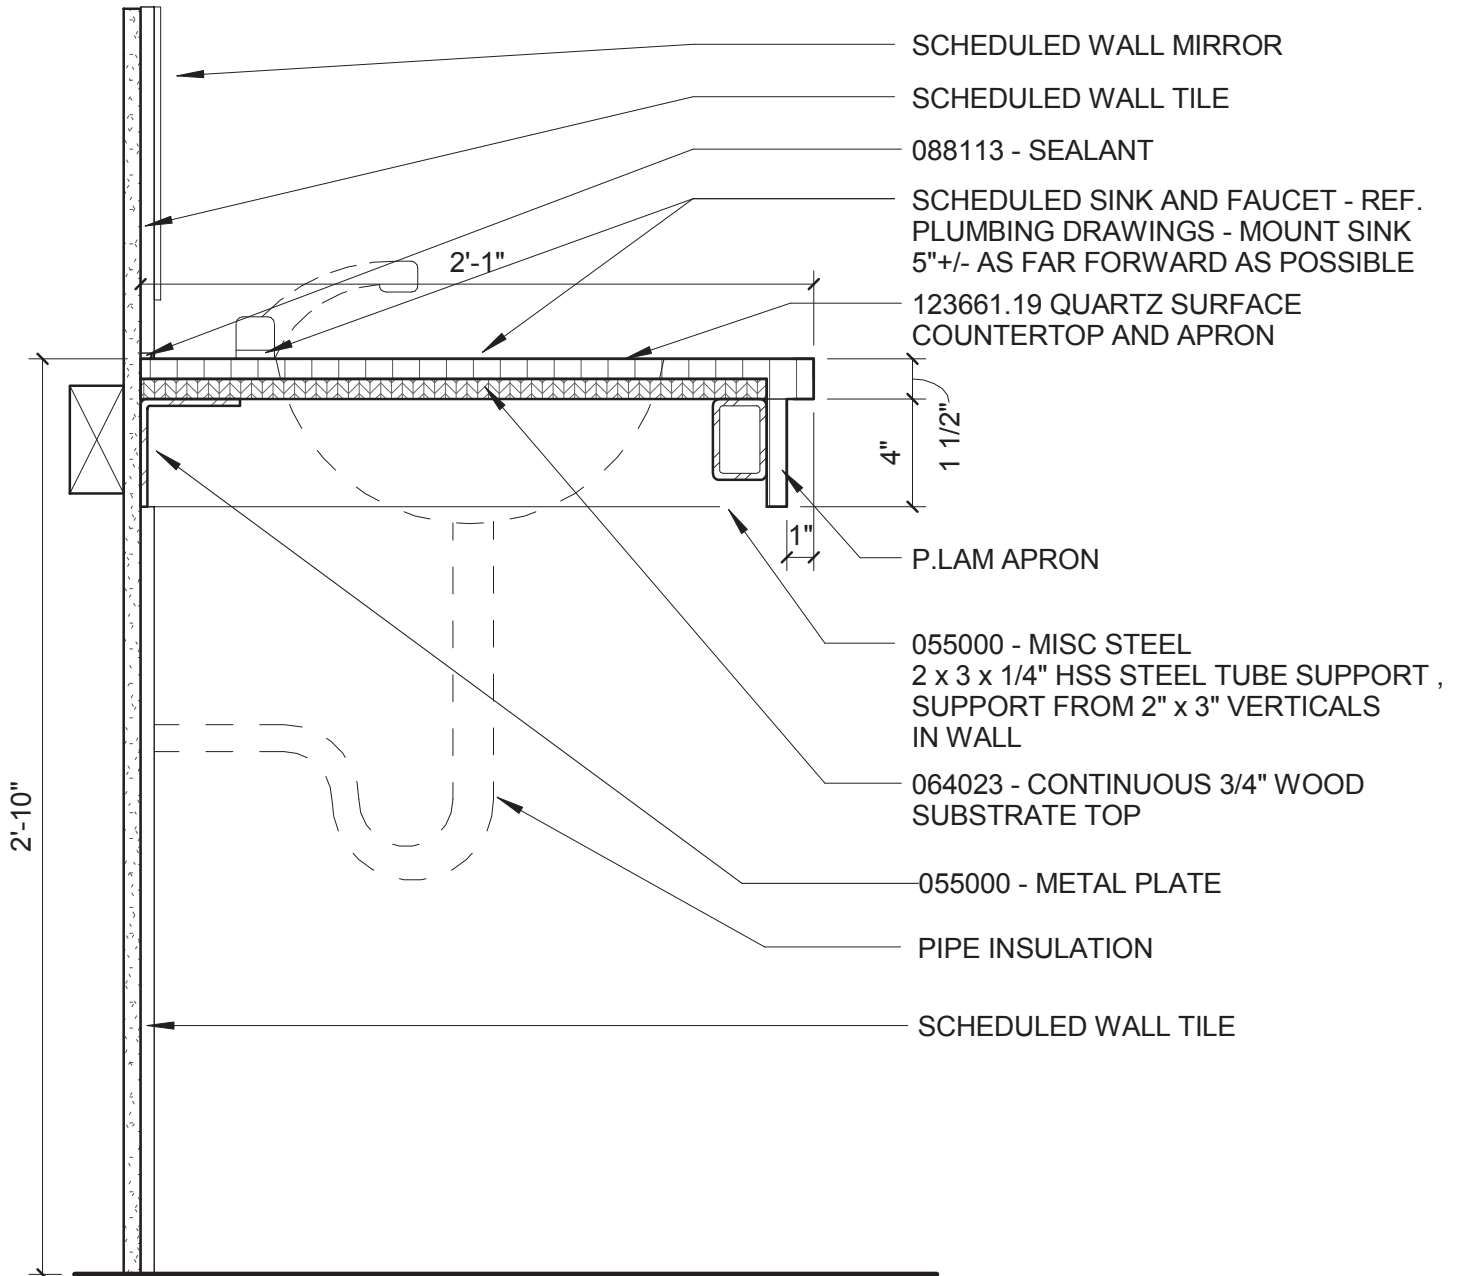

6

COUNTERTOP W LAV


1 1/2" = 1'-0"

American Standard

Style That Works Better


 **BARrier FREE**

OVALYN™ UNDERCOUNTER SINK VITREOUS CHINA

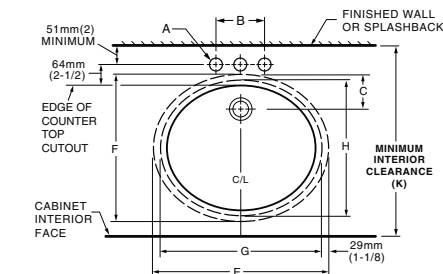

0496/0497

▼ **DETAIL OF MOUNTING CLIP**
(KIT No. 047194-0070A)

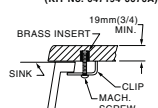


REFER TO INSTRUCTIONS
PROVIDED WITH KIT FOR
ADDITIONAL INFORMATION

NOTES:

* DIMENSIONS SHOWN FOR LOCATION OF SUPPLIED AND "P" TRAP ARE SUGGESTED.

▼ UNDERCOUNTER MOUNTING KIT SUPPLIED WITH SINK.
PLEASE NOTE MINIMUM INTERIOR CLEARANCE DIMENSION (K).
FITTINGS NOT INCLUDED AND MUST BE ORDERED SEPARATELY.
USE ENCLOSED TEMPLATE FOR COUNTERTOP CUTOUT
SEALING COMPOUND SUPPLIED BY OTHERS.

IMPORTANT: Dimensions of fixtures are nominal and may vary within the range of tolerances established by ANSI Standard A112.19.2. These measurements are subject to change or cancellation. No responsibility is assumed for use of superseded or voided pages.

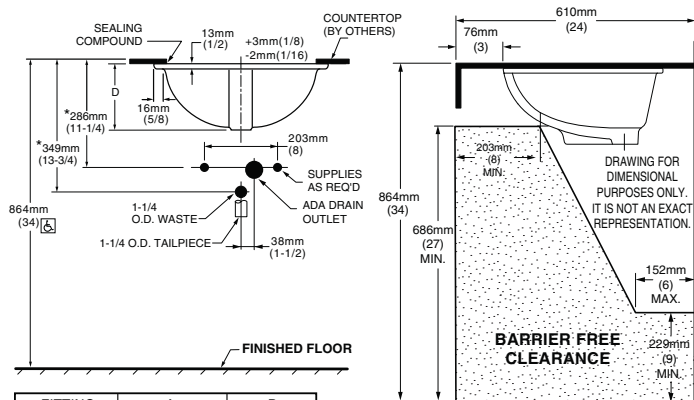

FITTING	A	B
CENTERSET	1-1/4 (32mm)	4 (102mm)
SPREAD	1-3/8 (35mm)	8 (203mm)

CAT. NO.	E	F	G	H	C	D	J	K
0496.221	489mm (19-1/4)	413mm (16-1/4)	432mm (17)	356mm (14)	103mm (4-1/16)	182mm (7-3/16)	16mm (5/8)	500mm (19-11/16)
0497.221	546mm (21-1/2)	441mm (17-3/8)	483mm (19)	391mm (15-3/8)	95mm (3-3/4)	191mm (7-1/2)	19mm (3/4)	534mm (21-1/16)




**MEETS THE AMERICANS WITH DISABILITIES ACT
GUIDELINES AND ANSI A117.1 ACCESSIBLE AND
USEABLE BUILDINGS AND FACILITIES -
CHECK LOCAL CODES.**

Countertop 864mm (34") from finished floor. Lavatory
installed 76mm (3") from front edge of countertop.
Countertop thickness to be 25mm (1") maximum.

0495

▼ **DETAIL OF MOUNTING CLIP**
(KIT No. 047194-0070A)

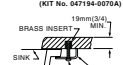

REFER TO INSTRUCTIONS
PROVIDED WITH KIT FOR
ADDITIONAL INFORMATION

FITTING	A	B
CENTERSET	1-1/4 (32mm)	4 (102mm)
SPREAD	1-3/8 (35mm)	8 (203mm)

NOTES:

USE ENCLOSED TEMPLATE FOR COUNTERTOP CUTOUT.
FITTINGS NOT INCLUDED WITH FIXTURE AND MUST BE
ORDERED SEPARATELY.

* DIMENSIONS SHOWN FOR LOCATION OF SUPPLIED AND "P" TRAP ARE SUGGESTED.

▼ UNDERCOUNTER MOUNTING KIT SUPPLIED WITH SINK.
PLEASE NOTE MINIMUM INTERIOR CLEARANCE DIMENSION (K).
SEALING COMPOUND SUPPLIED BY OTHERS.

IMPORTANT: Dimensions of fixtures are nominal and may vary within the range of tolerances established by ANSI Standard A112.19.2. These measurements are subject to change or cancellation. No responsibility is assumed for use of superseded or voided pages



**MEETS THE AMERICANS WITH DISABILITIES ACT
GUIDELINES AND ANSI A117.1 ACCESSIBLE AND
USABLE BUILDINGS AND FACILITIES -
CHECK LOCAL CODES.**

Countertop 864mm (34") from finished floor. Lavatory
installed 51mm (2") from front edge of countertop.
Countertop thickness to be 25mm (1") maximum.

