



PARIC CORPORATION
77 Westport Plaza Suite 250
St. Louis, MO 63146
TEL: 636-561-9500
FAX: 636-561-9501

REQUEST FOR INFORMATION DATE: June 13, 2017 NO.: RFI-563

To: Cannon Design

Attn: Kelvin Patel

From: Paric Corporation

Requested By: Ryan Tune

Project Name: 15051-Webster University Interdisciplinary Science Building Project No.: 15051

Subject: Dimensions of Handrail in Lecture Hall

Response Required By: June 20, 2017

Drawing / Spec Reference:

Information Requested:

See attached markup. The dimensions of the handrail in the lecture hall are not called out on the plans. We have come up with a markup that includes what we think the dimensions are supposed to be (3 3/16" from the face of concrete to center of handrail). Please review and confirm the dimensions.

Response:


Locate per markups (magenta color).

ARCHITECT'S RESPONSE:

This information is provided as an interpretation of the Contract Documents for implementation. It is not an authorization for change to the Contract Sum or Contract Time. If this information results in a claim for a change to the Contract, the Contractor shall notify the [Construction Manager][Architect] of a change through the change process.

Answered By: Kelvin Patel

Date: 06/19/2017

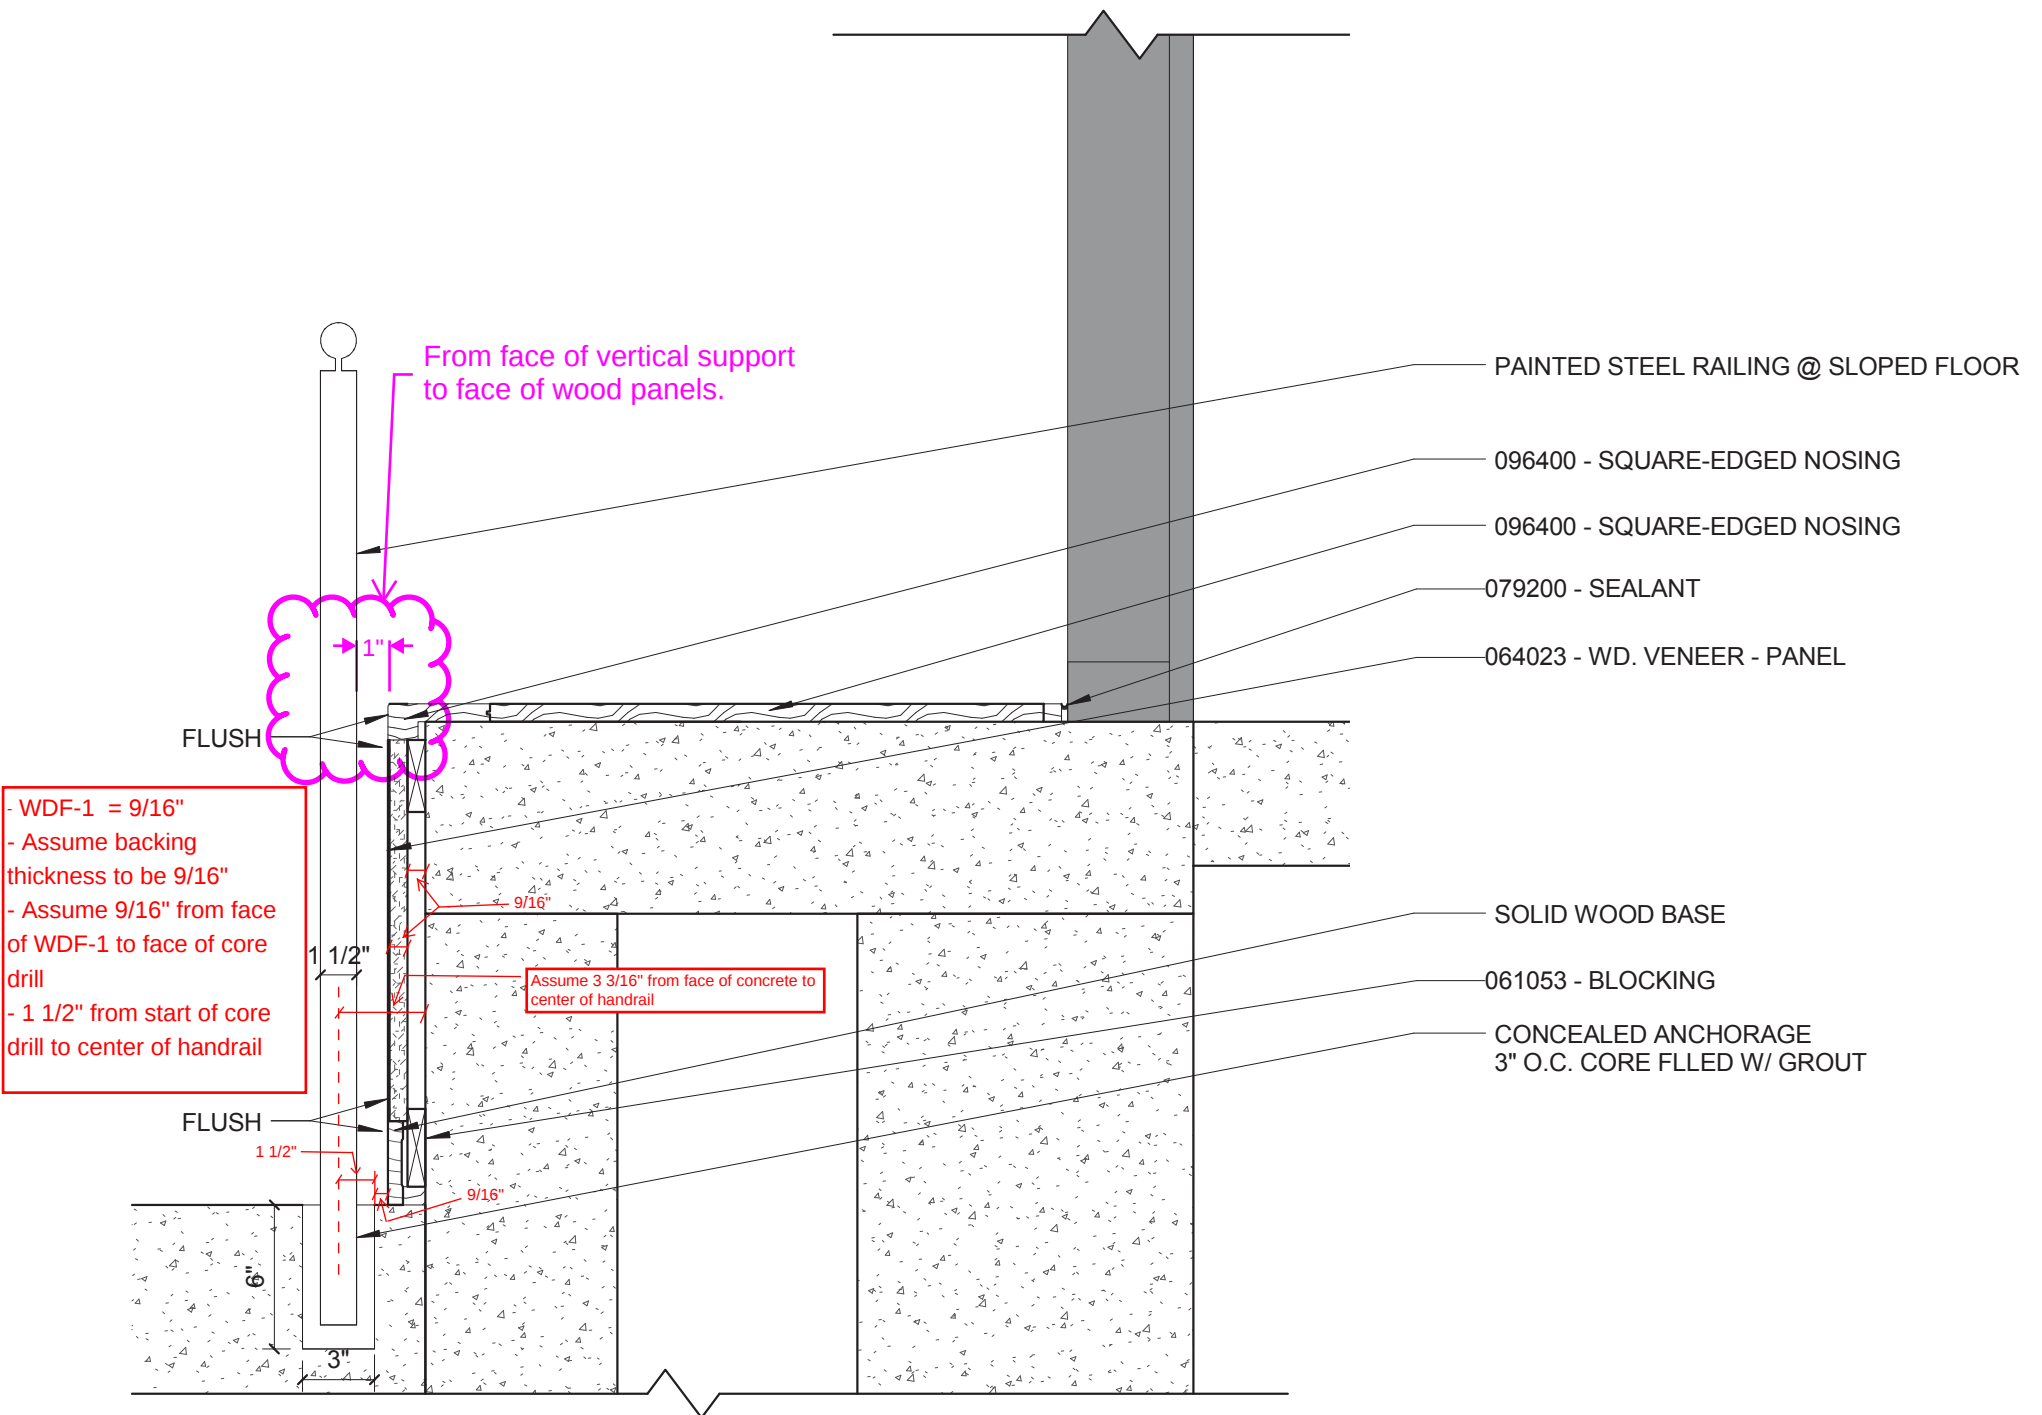

1 SILL DETAIL AT LECTURE HALL

1 1/2" = 1'-0"