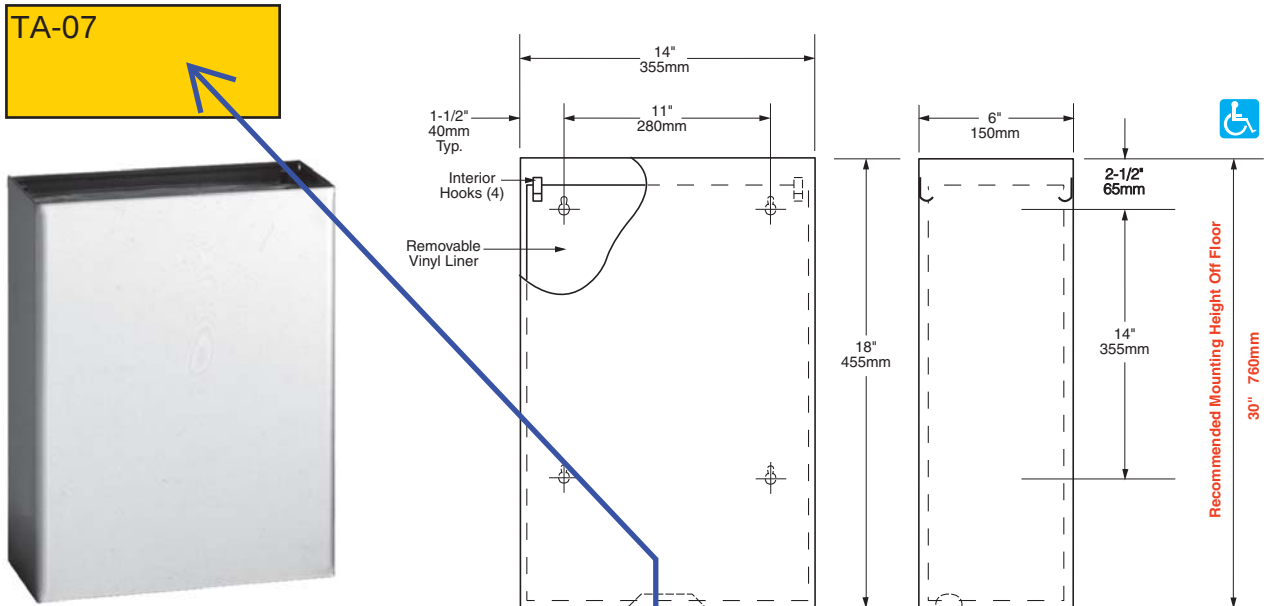


BOBRICK

Technical Data

**SURFACE-MOUNTED
WASTE RECEPTACLE****B-279**

TA-07 (279)
is not
required,
provide credit

MATERIALS:

Receptacle — 18-8, type-304 stainless steel with satin finish. Front and sides are one-piece, 22 gauge (0.8mm); back and bottom are one-piece, 26 gauge (0.5mm). All-welded construction. Top edge hemmed and bottom has recessed finger grip for safe handling. Equipped with four spot-welded interior hooks for attaching the vinyl liner. Capacity: 6.4-gal. (24.2-L).

Liner — Heavy-gauge vinyl with four grommets. Removable for servicing.

OPERATION:

Removable vinyl liner attaches to four interior hooks of waste receptacle. Space between bottom of receptacle and floor, when unit is properly mounted on wall, facilitates floor cleaning.

INSTALLATION:

Mount unit on wall with four sheet-metal screws (not furnished) at points indicated by an S. For plaster or dry wall construction, provide concealed backing to comply with local building codes, then secure unit with sheet-metal screws. For other wall surfaces, provide fiber plugs or expansion shields for use with sheet-metal screws, or provide 1/8" (3mm) toggle bolts or expansion bolts.

SPECIFICATION:

Surface-mounted waste receptacle shall be type-304 stainless steel with all-welded construction; exposed surfaces shall have satin finish. Front and sides of waste receptacle shall be one-piece, 22 gauge (0.8mm); back and bottom shall be one-piece, 26 gauge (0.5mm). Top edge shall be hemmed and bottom of waste receptacle shall have recessed finger grip. Waste receptacle shall be equipped with four interior hooks, furnished with a removable heavy-gauge vinyl liner, and shall have a minimum capacity of 6.4-gal. (24.2-L).

Surface-Mounted Waste Receptacle shall be Model B-279 of Bobrick Washroom Equipment, Inc., Clifton Park, New York; Jackson, Tennessee; Los Angeles, California; Bobrick Washroom Equipment Company, Scarborough, Ontario; Bobrick Washroom Equipment Pty. Ltd., Australia; and Bobrick Washroom Equipment Limited, United Kingdom.



Bobrick Washroom Equipment, Inc.

Washroom Accessory Submittal

Quote: 1766579

Quote Date: 4/13/2016

Job Name: Webster University - ISB

Item	Description	Qty
5806X18	STRAIGHT GRAB BAR	10
5806X36	STRAIGHT GRAB BAR	10
5806X42	STRAIGHT GRAB BAR	10
2888	SURF MTD. TP DISP	22
254	SUR MTD FEM NAPKIN DISPOSAL	14
6717	SINGLE ROBE HOOK SATIN	20
239X34	SHELF & MOP HOLDER-34 IN	2
3644	WASTE RECEPTACLE	2
2706 25	CLASSIC SURFACE MOUNTED NAPKIN	1
2621	PAPER TOWEL DISPENSER	1
279	WASTE RECEPTACLE	1

2706 25 is
not required,
provide credit

279 is not
required,
provide credit



77 Westport Plaza
Suite 250
St. Louis, MO 63146

TRANSMITTAL

No. 15051-0479

Paric Corporation

PROJECT: 15051-Webster University Interdisciplinary Science Building

DATE: 02/07/2017

TO: Cannon Design
1100 Clark Ave
St Louis MO 63102

Fax;
314-241-2203

RE: Bathroom Accessories Product Data 2

ATTN: Kelvin Patel

JOB: 15051

WE ARE SENDING:	SUBMITTED FOR:	ACTION TAKEN:
☐ Shop Drawings	☒ Approval	☐ Approved as Submitted
☐ Letter	☐ Your Use	☐ Approved as Noted
☐ Prints	☐ As Requested	☐ Returned After Loan
☐ Change Order	☐ Review and Comment	☐ Resubmit
☐ Plans		☐ Submit
☐ Samples	SENT VIA:	☐ Returned
☐ Specifications	☐ Attached	☐ Returned for Corrections
☒ Other: Product Data	☐ Separate Cover Via:	☐ Due Date:

Item	Package	Code	Rev.	Copies	Date	Description	Status
Submittal		102800-002	1		02/07/2017	Bathroom Accessories Product Data 2	Submitted

NOTES:

CC:

Signed: _____
Devin Gates