



Letter of Transmittal No. 0008

Harris Rebar-Ambassador Steel-St. Louis Branch
 150 Tyler Street
 St. Louis, MO 63102
 Phone: 1-314-382-9855 Fax: 1-314-382-1711

To: KCI Construction
 Webster ISB Phase 1

0
 0 0 0

Attn: KCI Construction

Transmittal date: 05/20/16

AMB Project no: 00916023

Project name: Webster ISB Phase 1

Project location: 0

Customer: KCI Construction

We are sending the following:		No. required
☒ Placing drawings	☒ Sending via: Email	☐ Bond(s)
☐ Copy of a letter	☐ Plans	☐ Vellum(s)
☐ Specifications	☐ Contract drawings	☐ CD of drawings
☐ Samples/Brochures	☐ Other (Please specify):	

Drawing No.	Revision No.	Placing drawing description
R04-00	0	SOG Plan Sections & Details
R04-01	0	Wall Elevation & Sections
R04-02	0	Wall Elevation & Sections
R04-03	0	Wall Elevation & Sections

The above items are transmitted as follows:





☒ For approval	☒ Please return 1 corrected\marked-up print(s)
☐ For final approval	☒ As requested
☐ For field use	☐ Other (Please specify):
☐ For review only	

Remarks and/or notes:


Copy to:
 1) File and project folder

Prepared by: Byron Edrington (Ext. 2236)

Email address: bedrington@harrisrebar.com

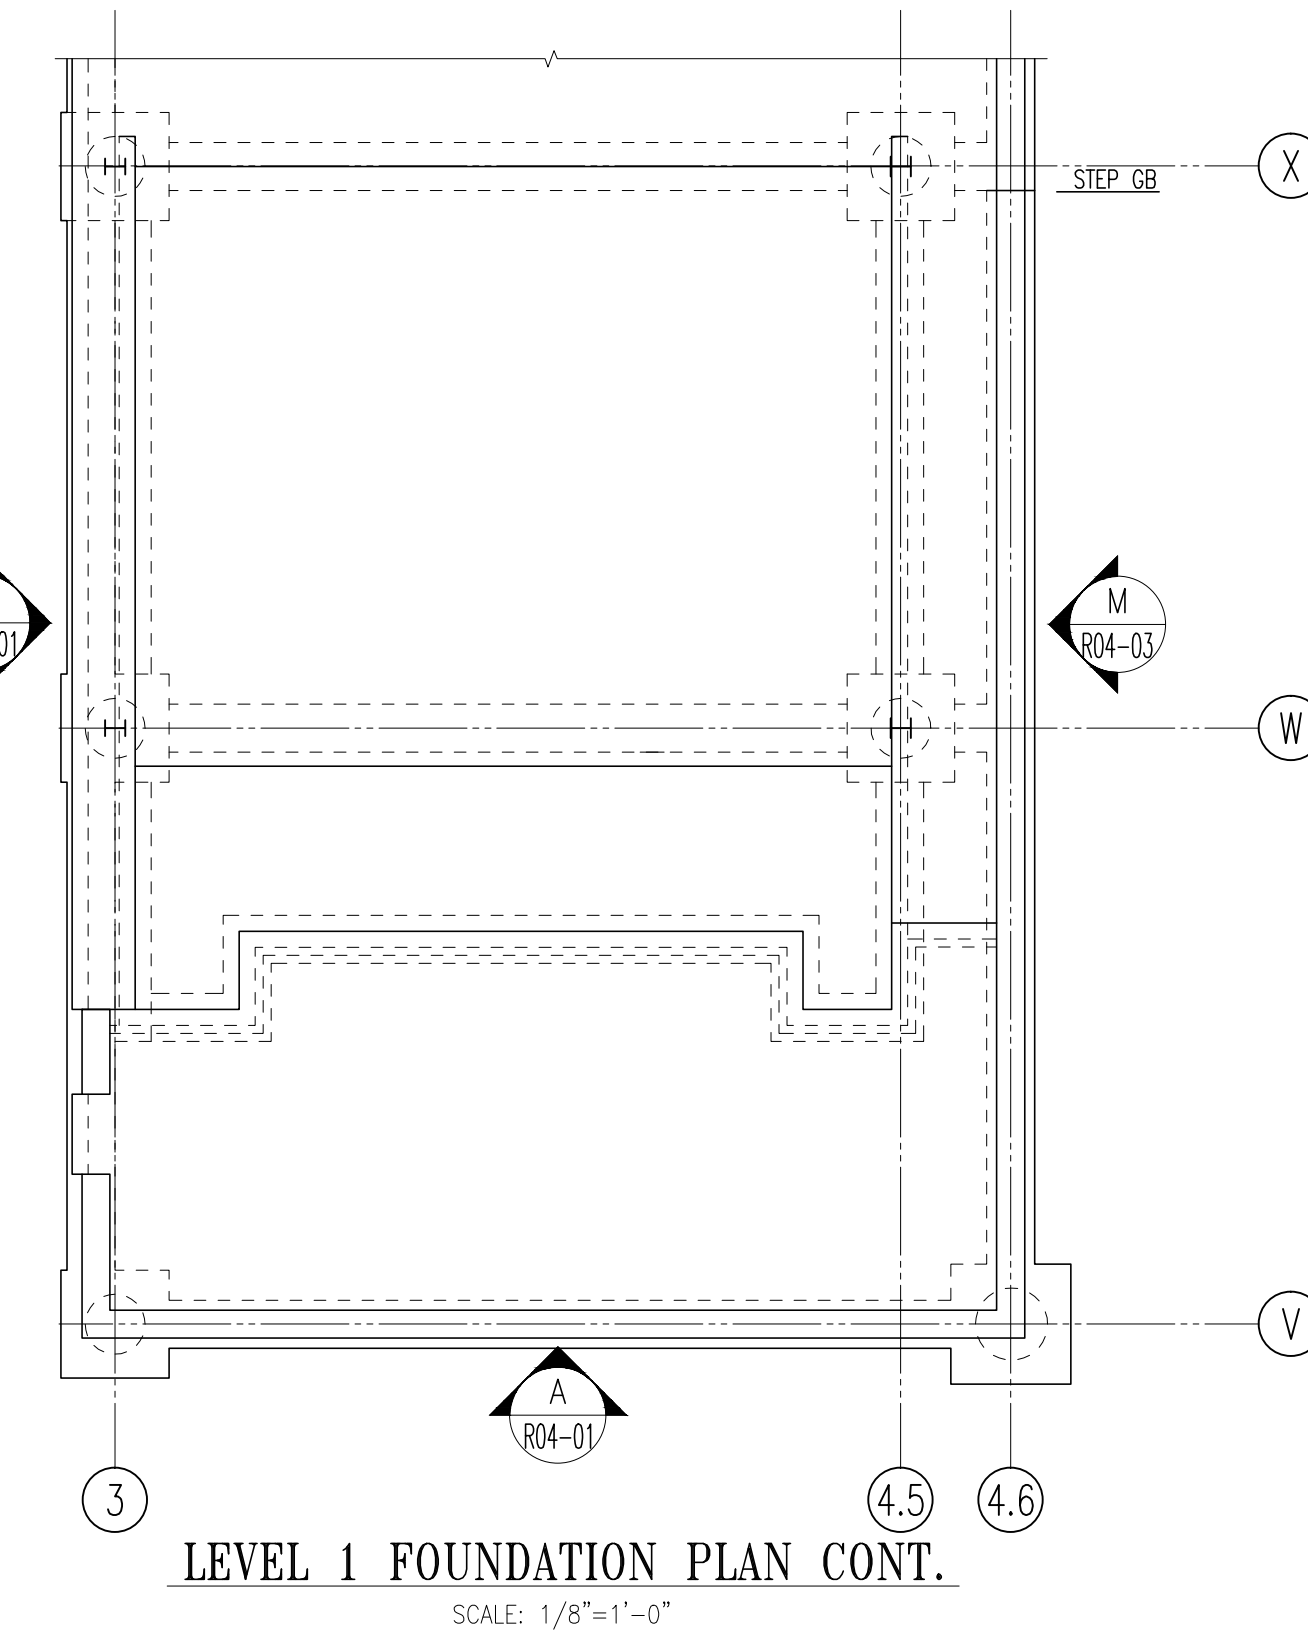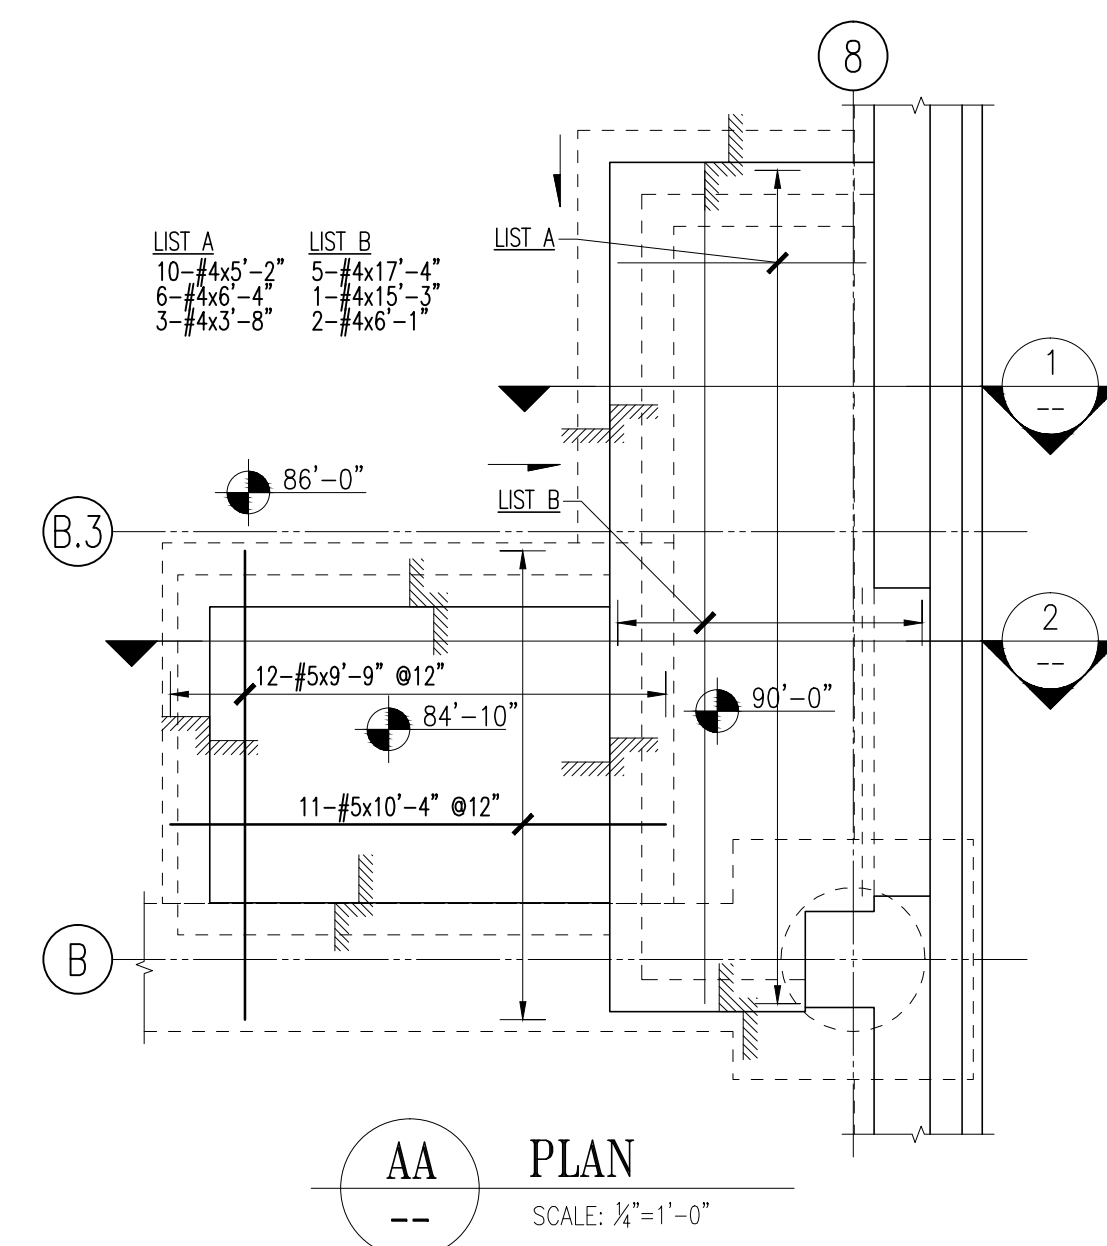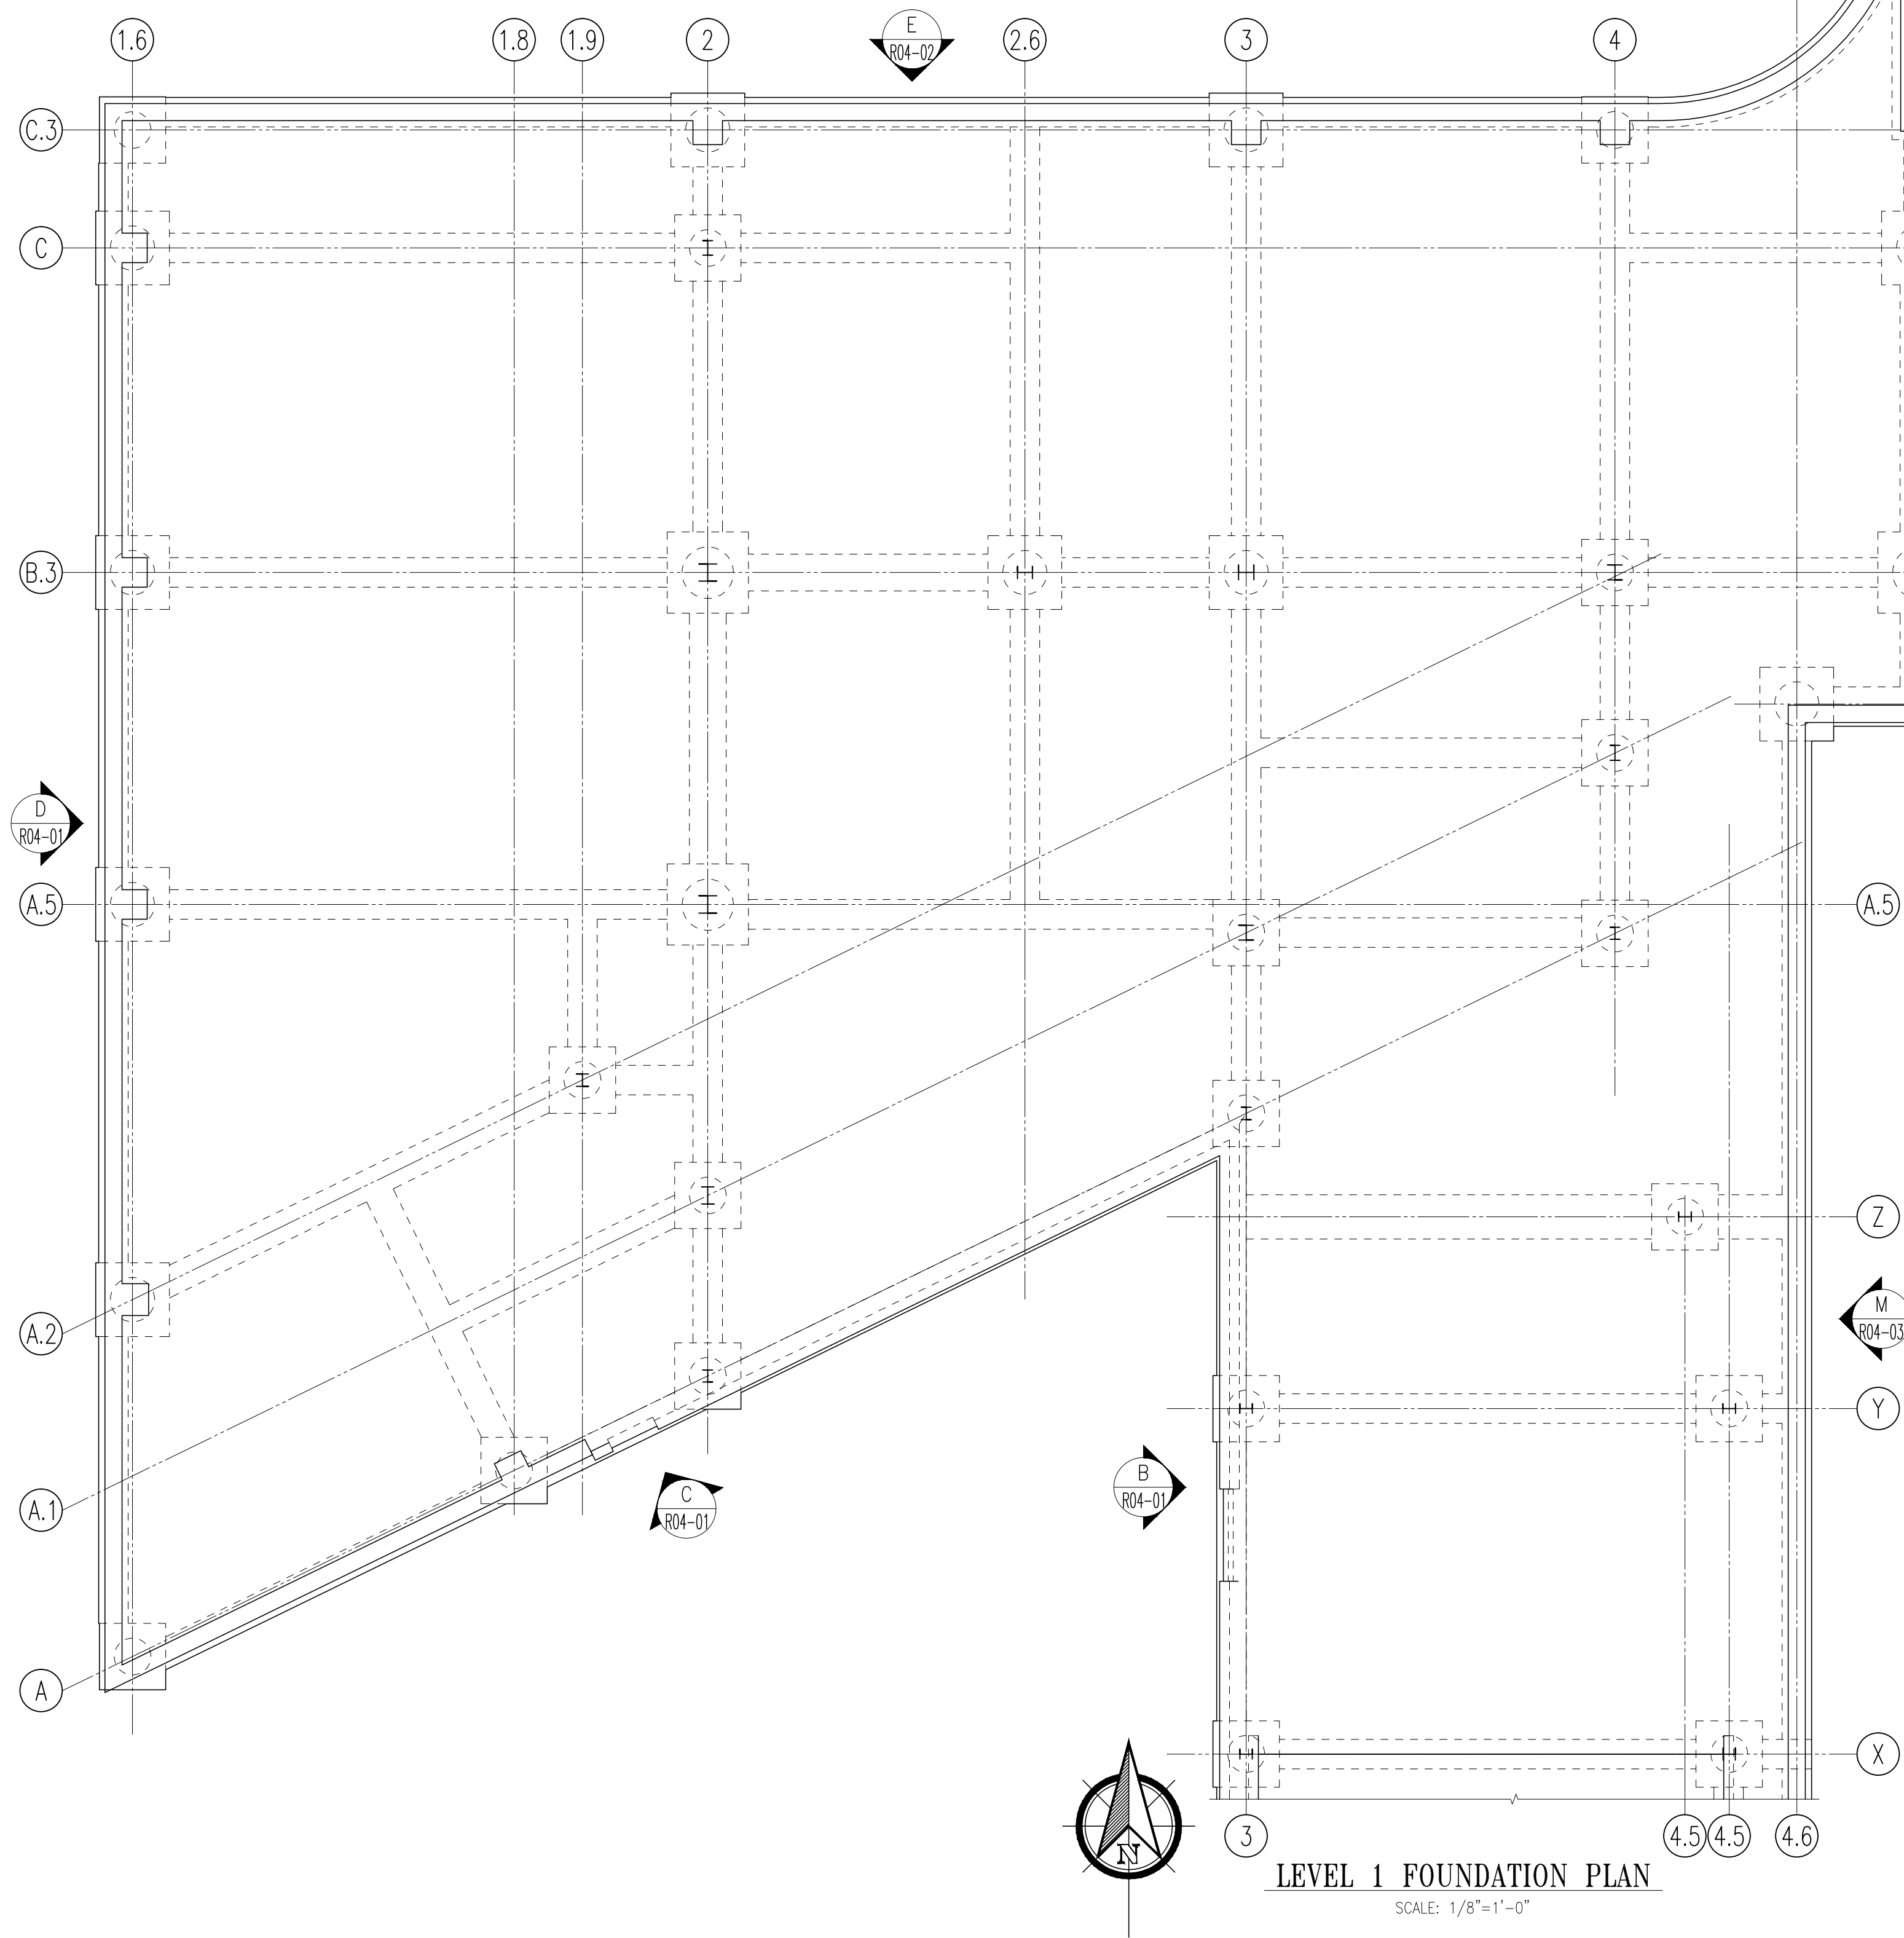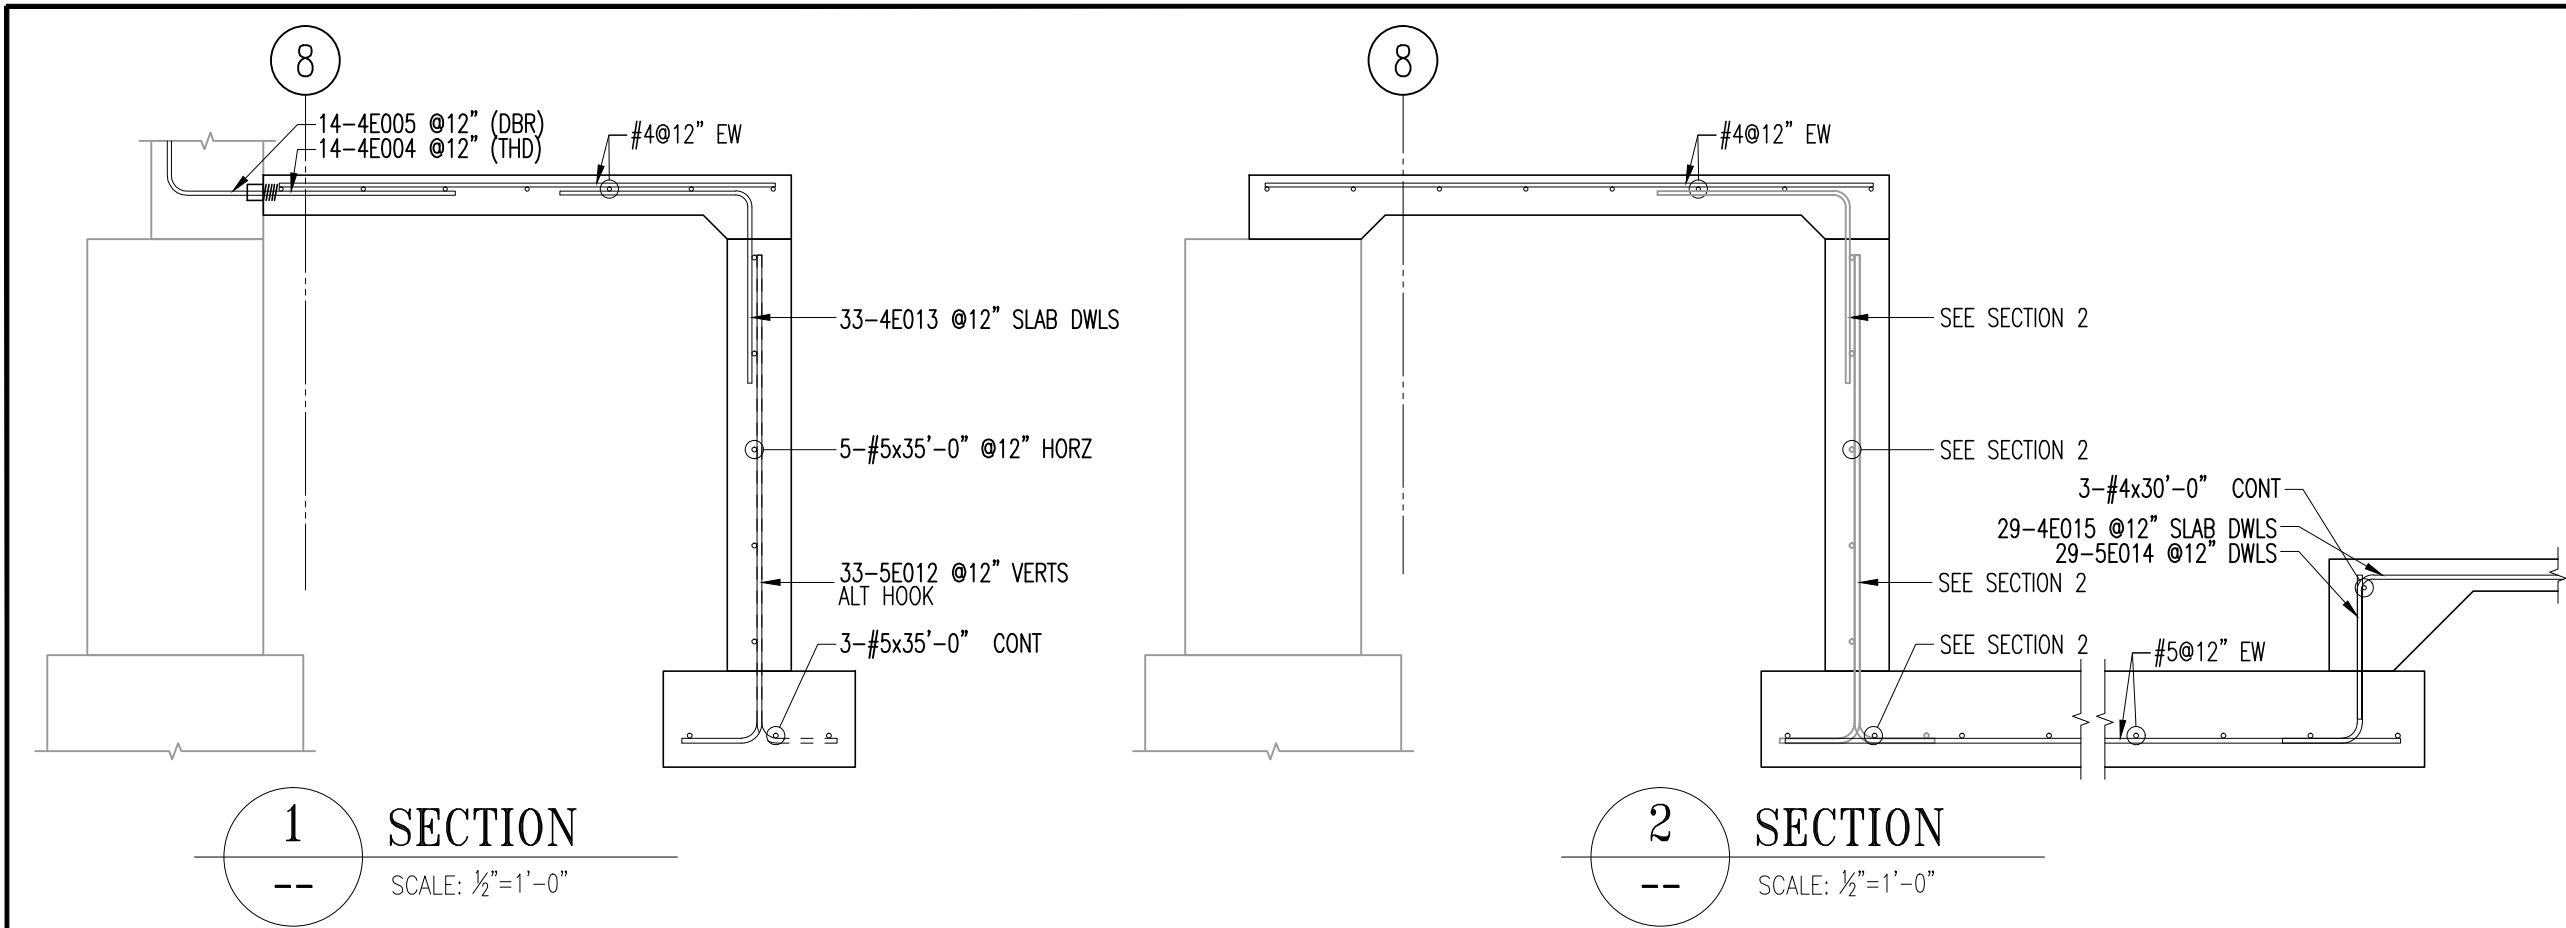


BENDING DETAILS											
Bar Mark	Size	Total Length	Type	Y	Y	Y	Y	Y	Y	Y	Y
52012	#5	5'-11"	2	0'-10"	1'-3"						
52014	#5	2'-2"	2	0'-10"	1'-3"						
42004	#4	2'-2"	183		2'-2"						
42005	#4	3'-0"	183	1'-0"	2'-0"						
42013	#4	4'-0"	17		2'-0"						
42015	#4	4'-0"	17		1'-5"	3'-0"					

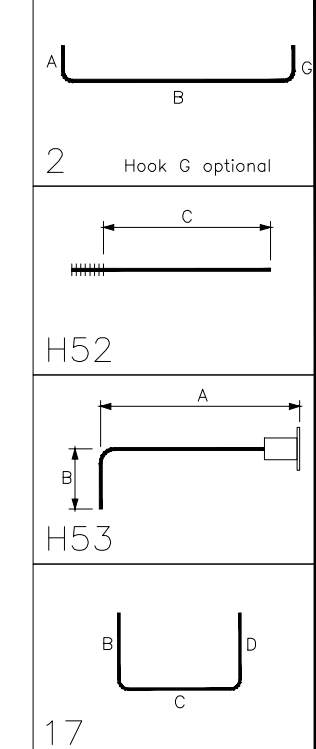


Revisions and Issue Record			
No.	Description	Date	By
0	FOR APPROVAL	05/20/16	JLH
The full intent and purpose of this drawing is the placing of reinforcing steel bars ONLY. It is NOT to be used as a means of communication between the Architect, Engineer, Contractor or any other Sub-trades.			
THIS DRAWING IS NOT TO BE SCALED.			
ST. LOUIS, MO.			
DETAILED AT: ROCHELLE, IL. PHONE: 615-561-1771			
Project: WEBSTER ISB PHASE 1			
Drawing: SOG PLAN SECTIONS & DETAILS			
Customer: KCI CONSTRUCTION			
Engineer: DAVID MASON & ASSOCIATES, INC.			
Date	Drawn	Chkd.	JOB No.
05/20/16	JLH		00916023
			Dwg. No.
			R04-00

N:\Detailing\Jobs-Rochelle\2016\JOBS\00916023-Webster ISB Phase 1\Amb CAD Files\Rev 0\00916023 R04-01 Rev 0.dwg

BENDING DETAILS									
Bar Mark	Size	Total Length	Type	X	Y	Z	W	V	U
52008	#5	2'-0"	DBR						
52007	#5	3'-0"	DBR						
52009	#5	5'-0"	DBR						
52010	#5	5'-0"	DBR						
42003	#4	5'-0"	DBR						

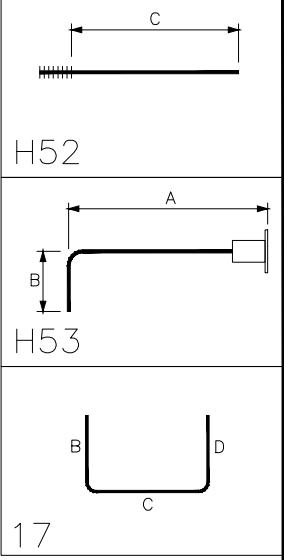


2x150-52041 @12" CB EF

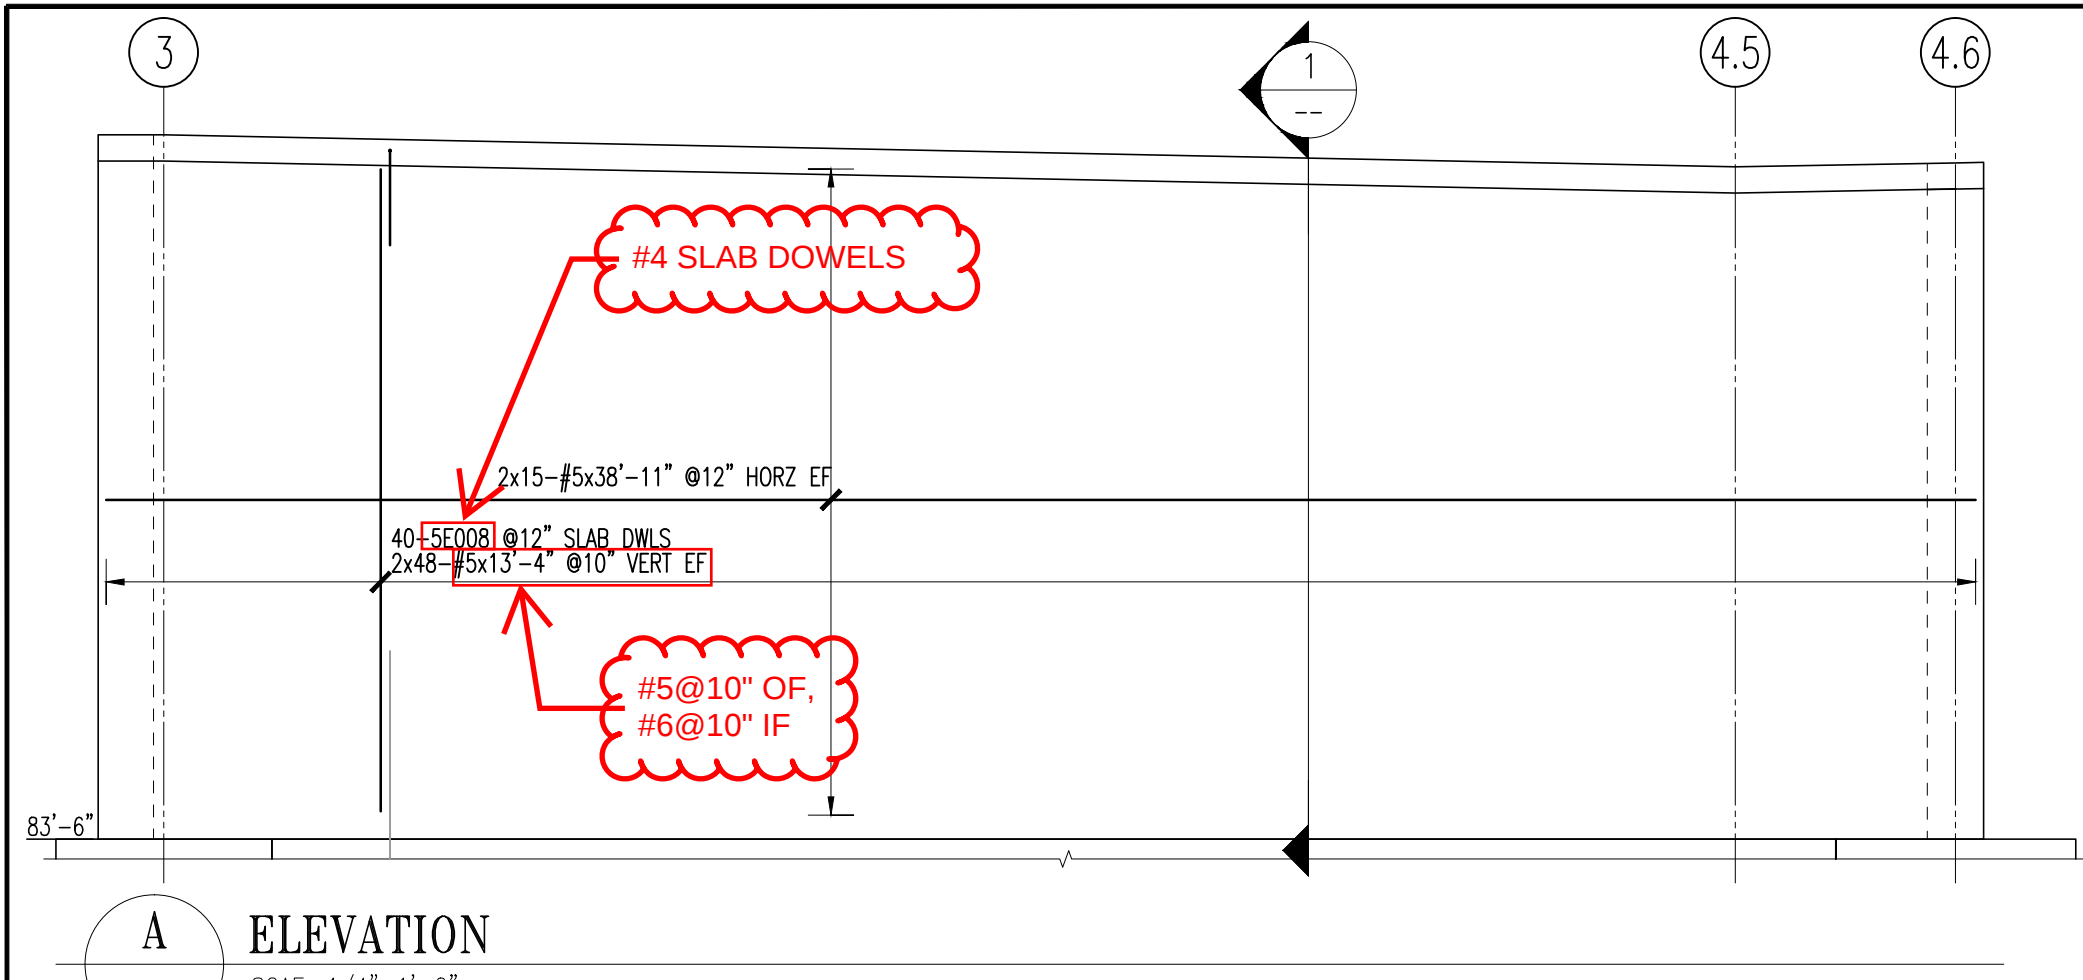


A ELEVATION
SCALE: 1/4"=1'-0"




B ELEVATION
SCALE: 1/4"=1'-0"

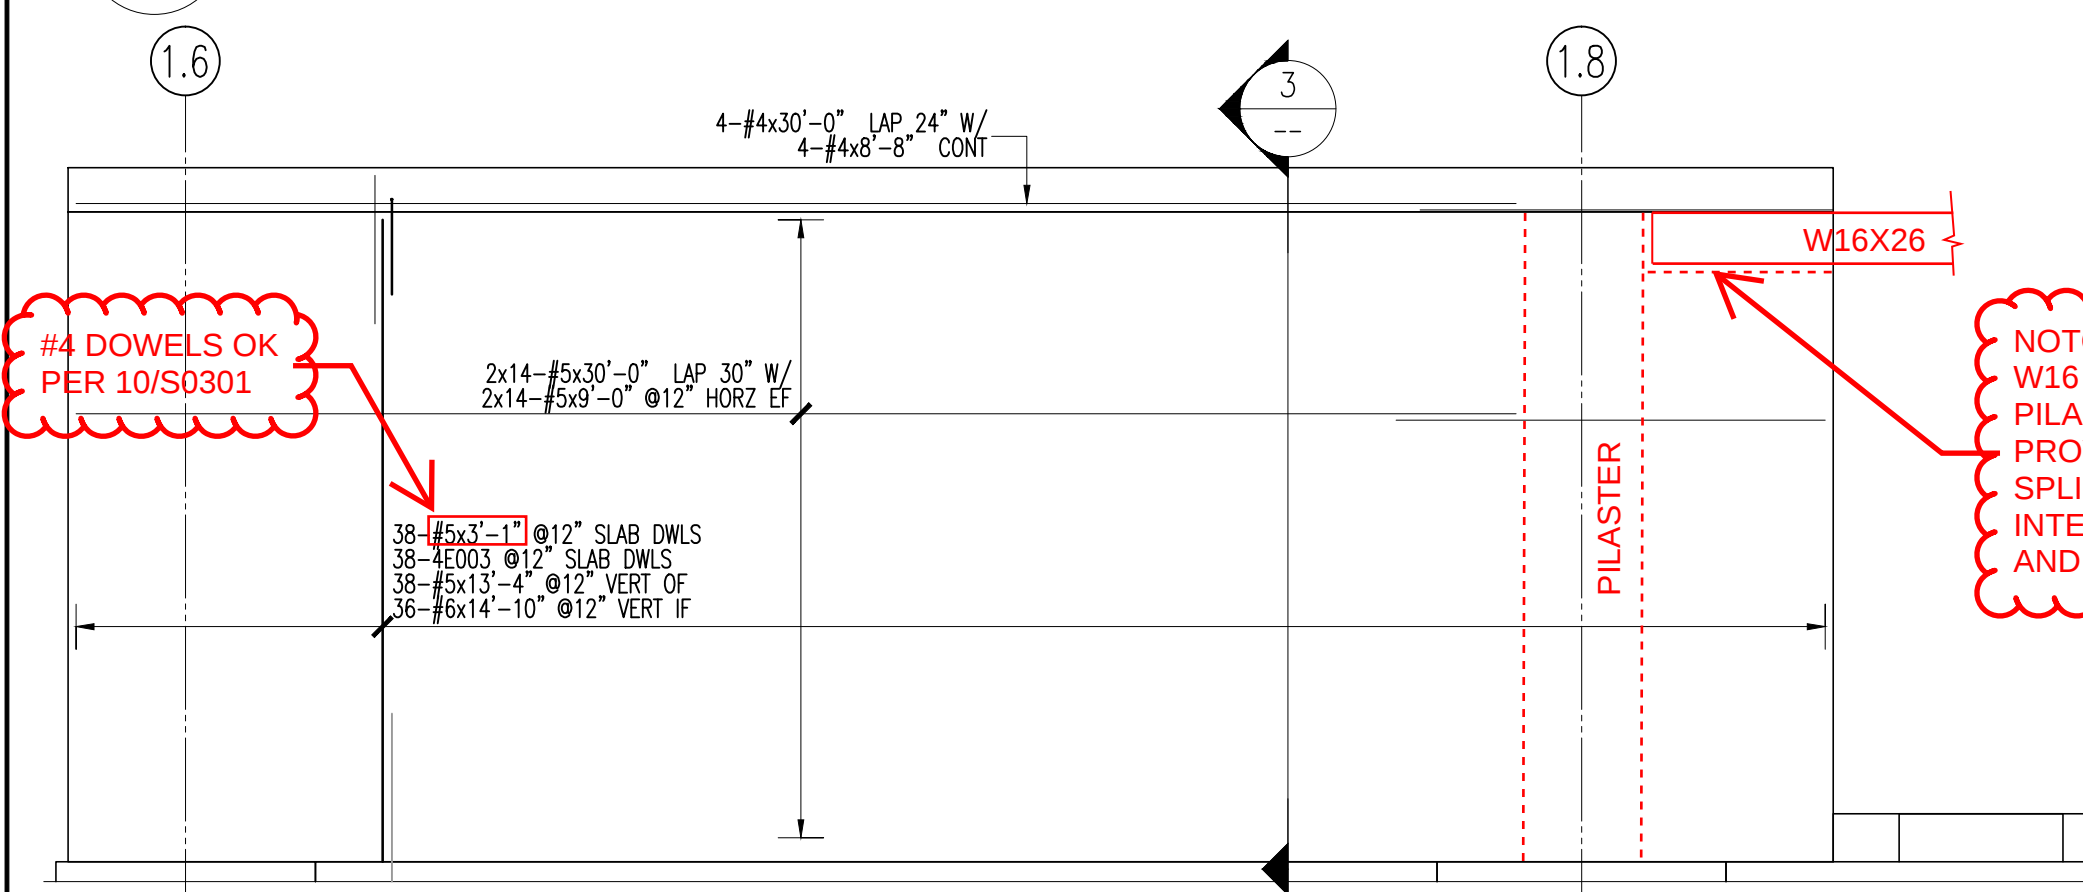

C ELEVATION
SCALE: 1/4"=1'-0"

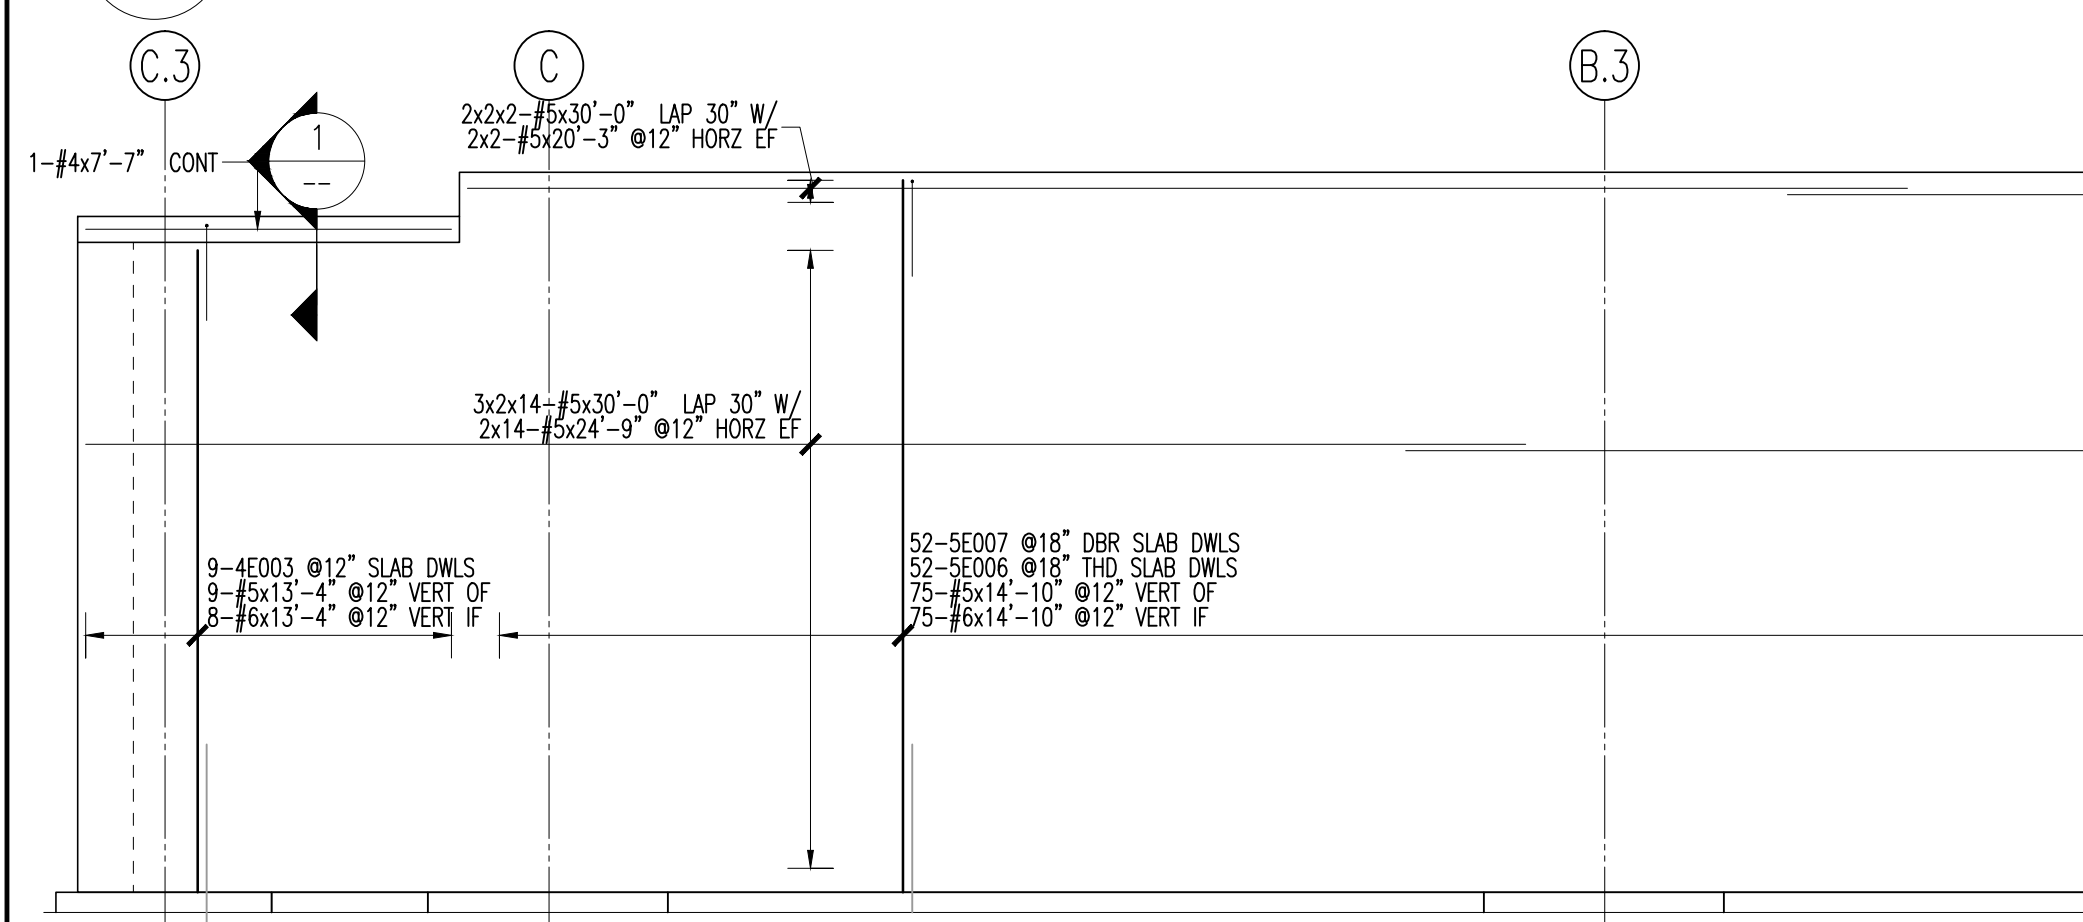

D ELEVATION
SCALE: 1/4"=1'-0"

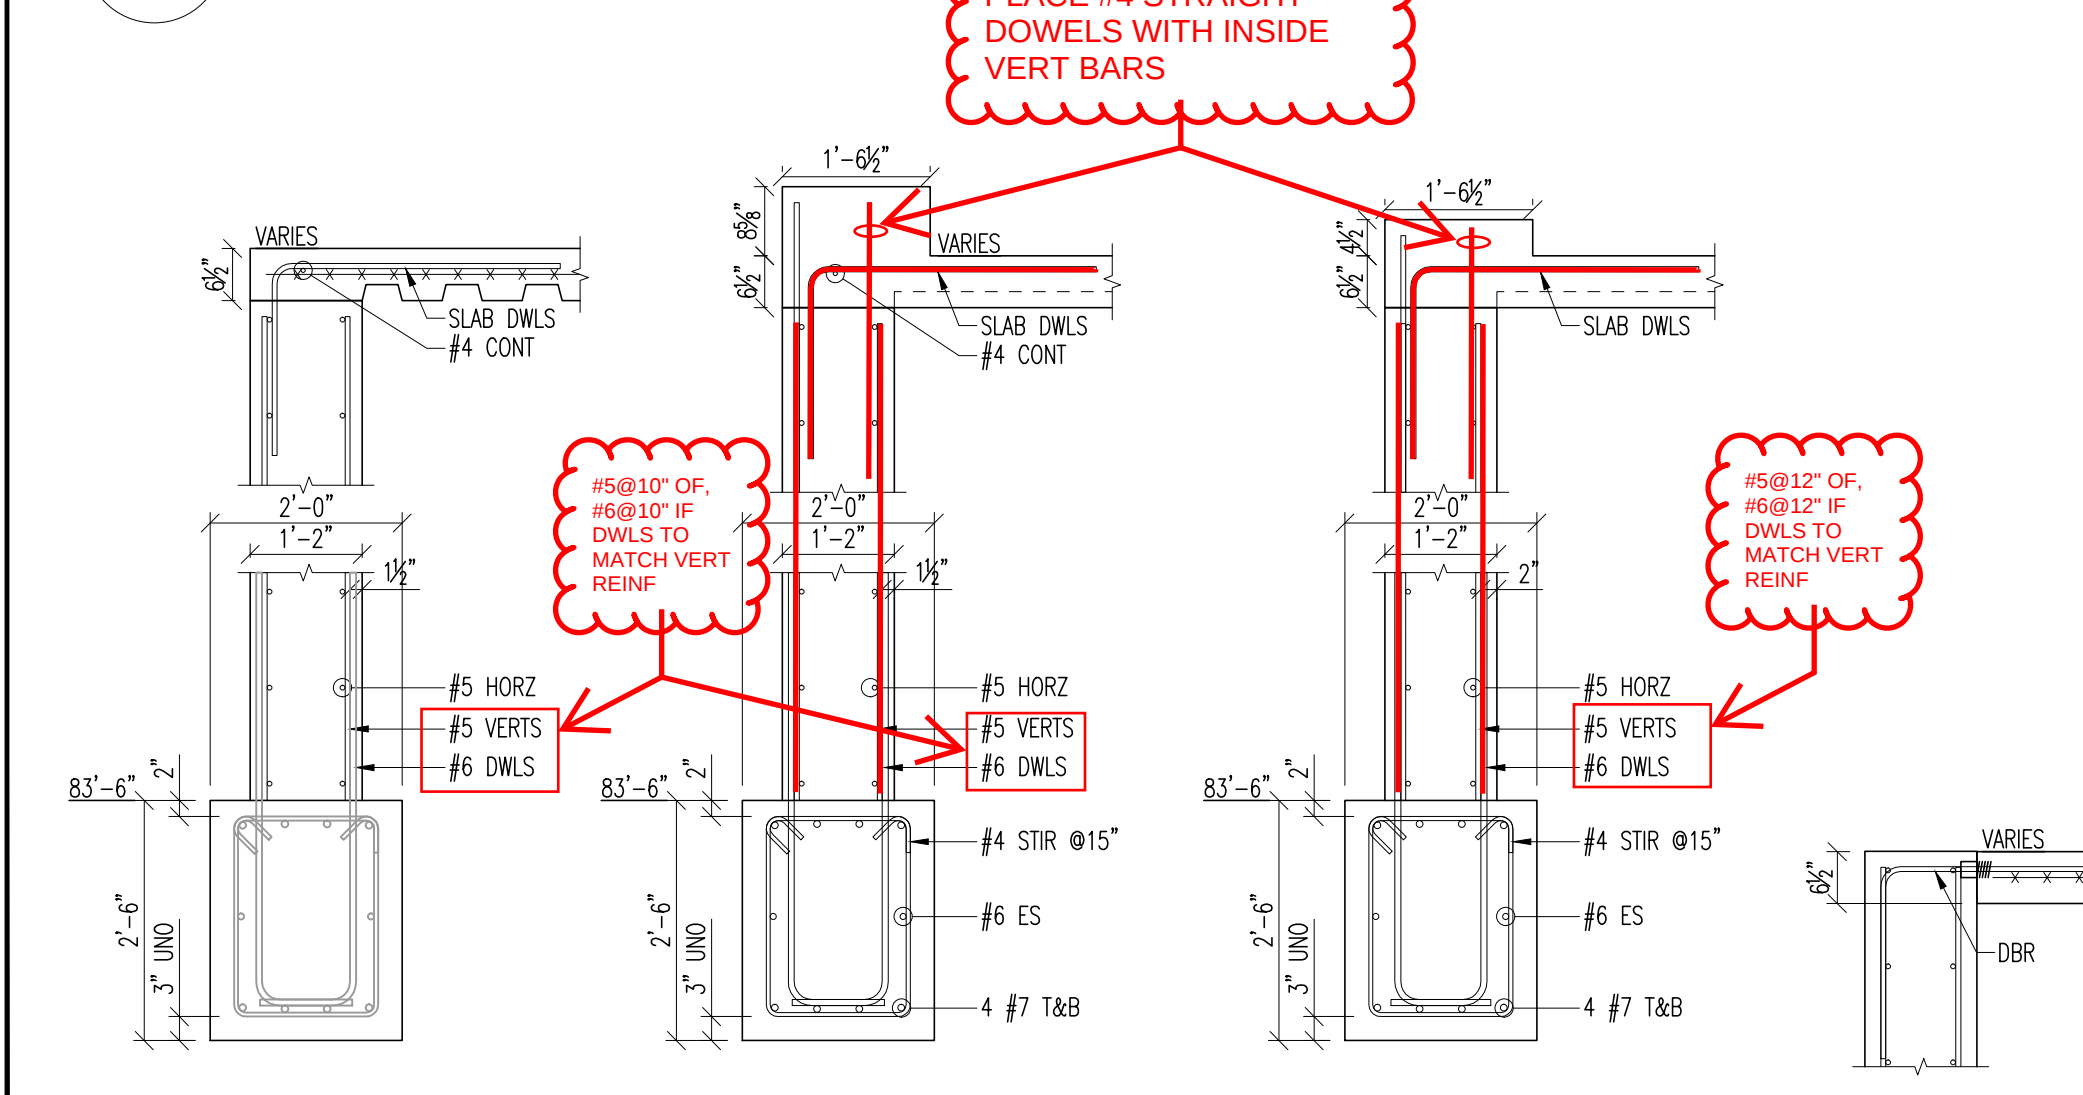


1 SECTION
SCALE: 1/2"=1'-0"


2 SECTION
SCALE: 1/2"=1'-0"

3 SECTION
SCALE: 1/2"=1'-0"


4 SECTION
SCALE: 1/2"=1'-0"

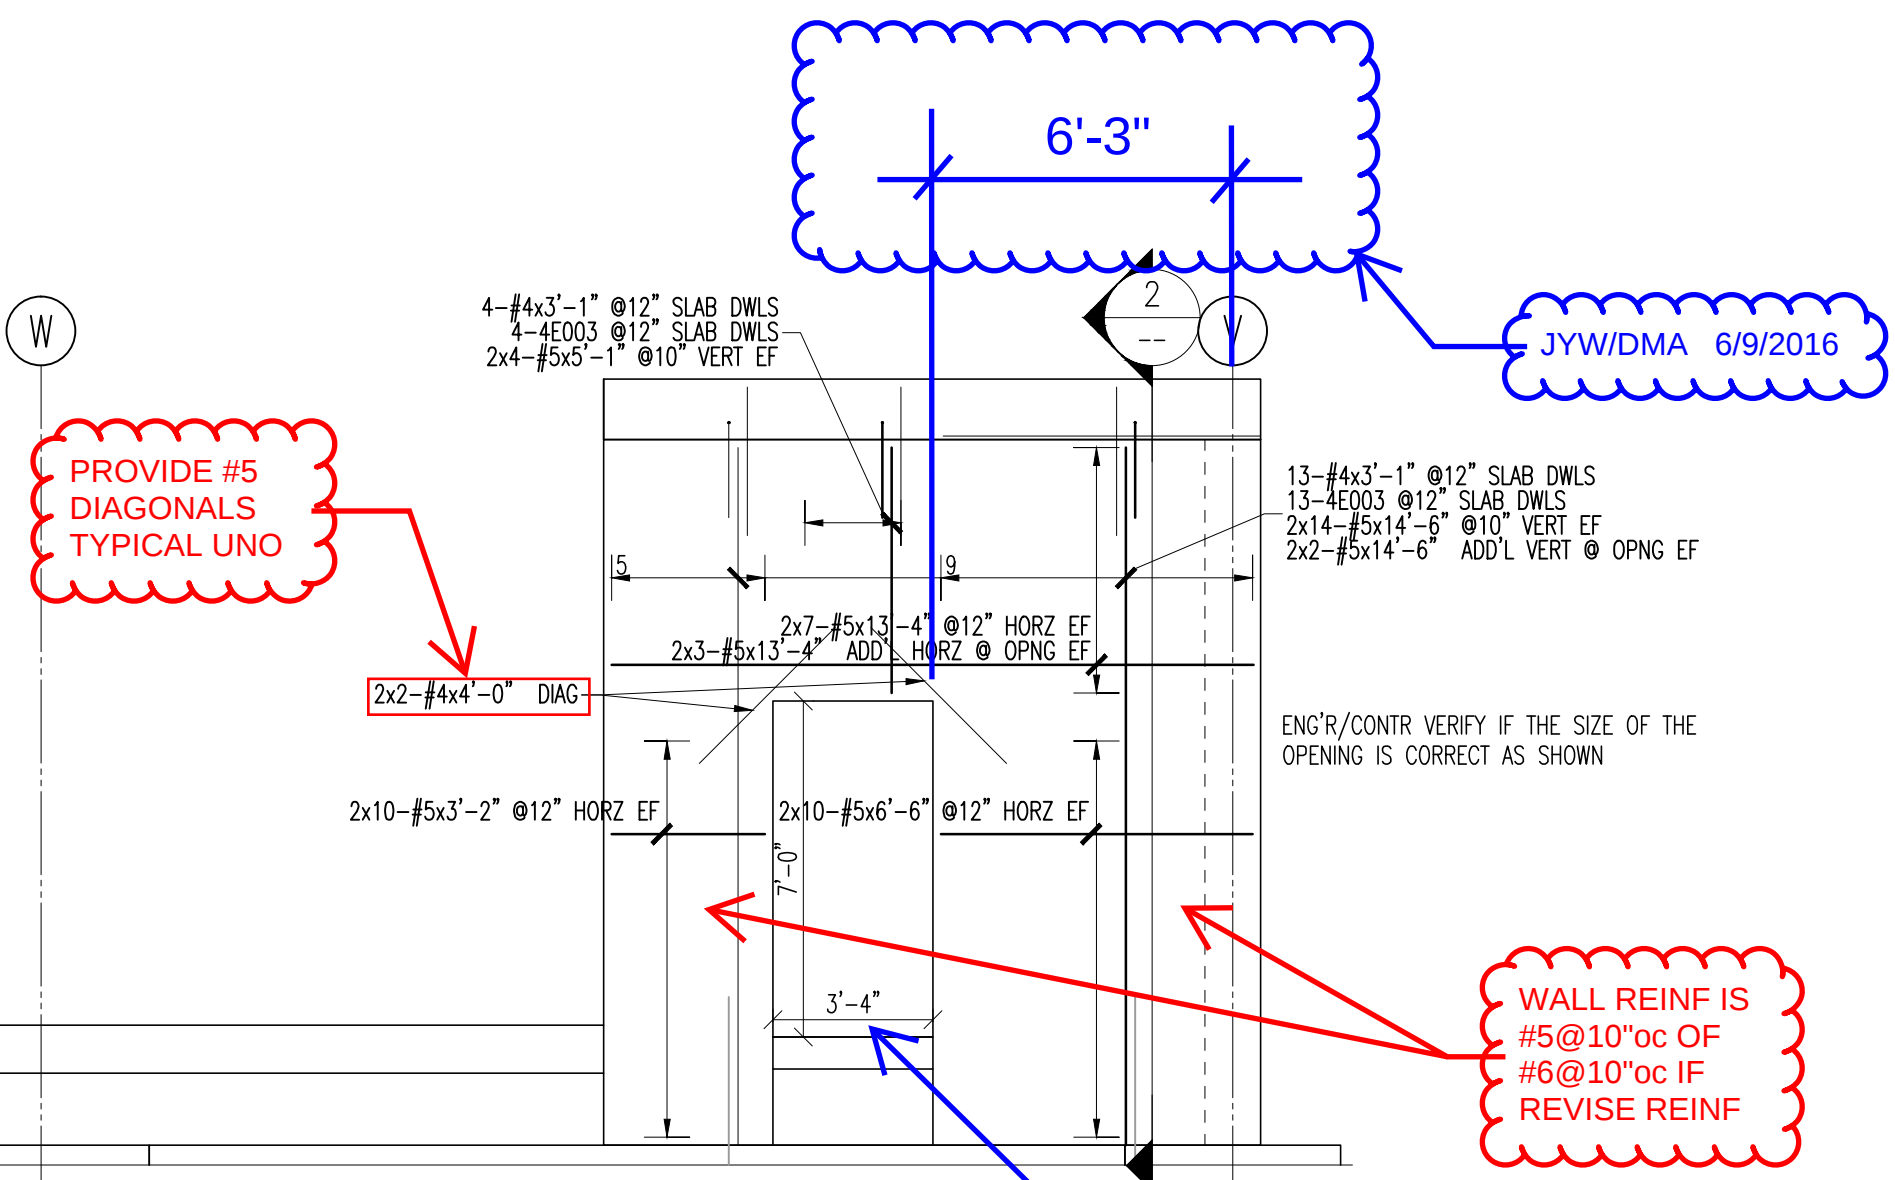

WALL REINFORCEMENT
SCALE: 1/4"=1'-0"

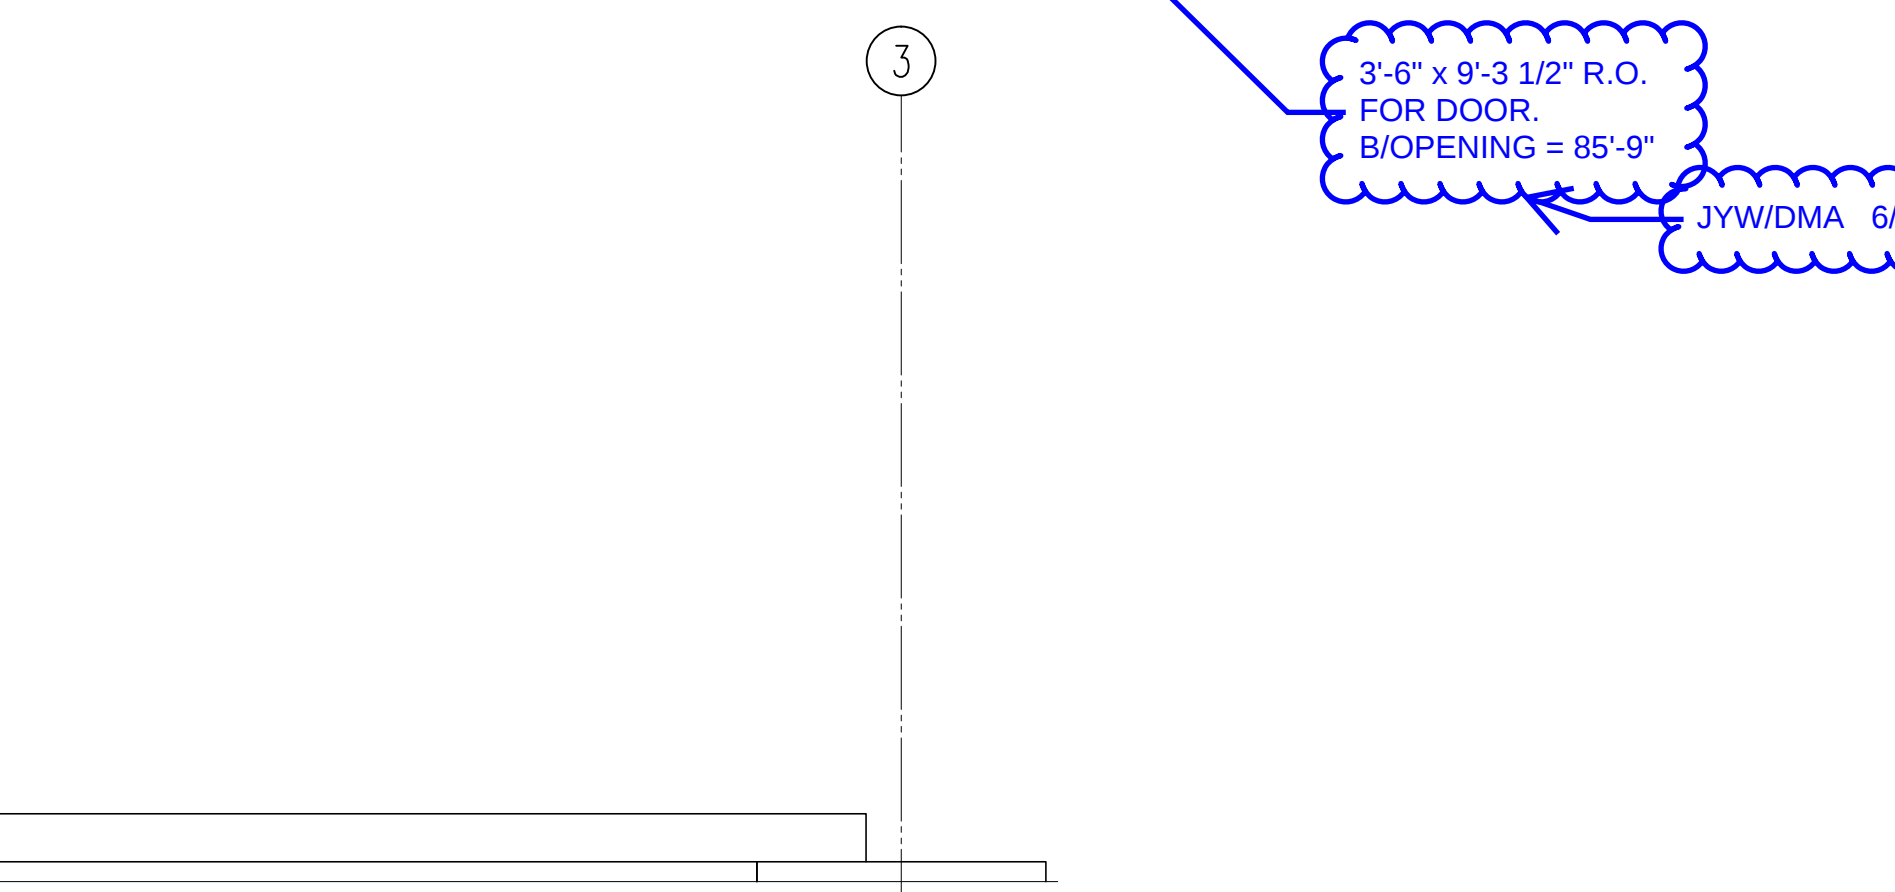

WALL REINFORCEMENT
SCALE: 1/4"=1'-0"

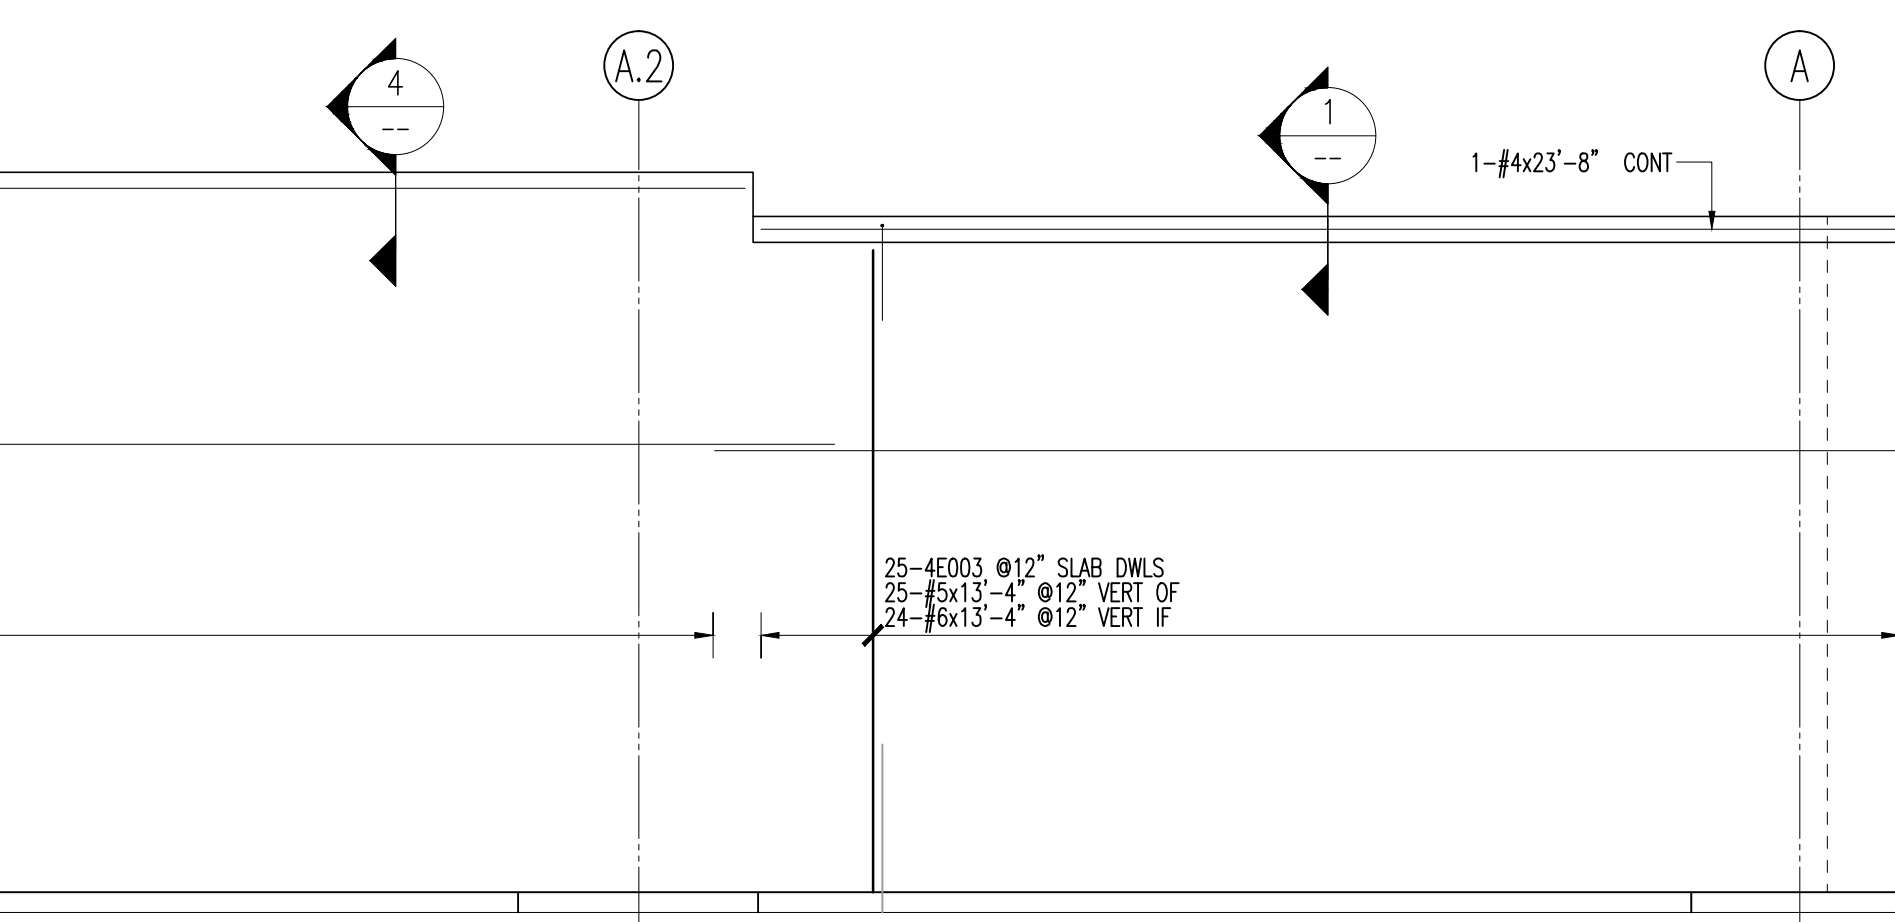









WALL REINFORCEMENT
SCALE: 1/4"=1'-0"



WALL REINFORCEMENT
SCALE: 1/4"=1'-0"

Revisions and Issue Record			
No.	Description	Date	By
0	FOR APPROVAL	05/20/16	JLH
The full intent and purpose of this drawing is the placing of reinforcing steel bars ONLY. It is NOT to be used as a means of communication between the Architect, Engineer, Contractor or any other Sub-trades.			
THIS DRAWING IS NOT TO BE SCALED.			
ST. LOUIS, MO.			
DETAILED AT: ROCHELLE, IL.			
PHONE: 615-561-1771			
Project: WEBSTER ISB PHASE 1			
Drawing: WALL ELEVATIONS & SECTIONS			
Customer: KCI CONSTRUCTION			
Engineer: DAVID MASON & ASSOCIATES, INC.			
Date	Drawn	Chkd.	JOB No.
05/20/16	JLH		00916023
			Dwg. No.
			R04-01

N:\Detailing\Jobs-Rochelle\2016\00916023-Webster ISB Phase 1\Amb CAD Files\Rev 0\00916023 R04-01 Rev 0.dwg

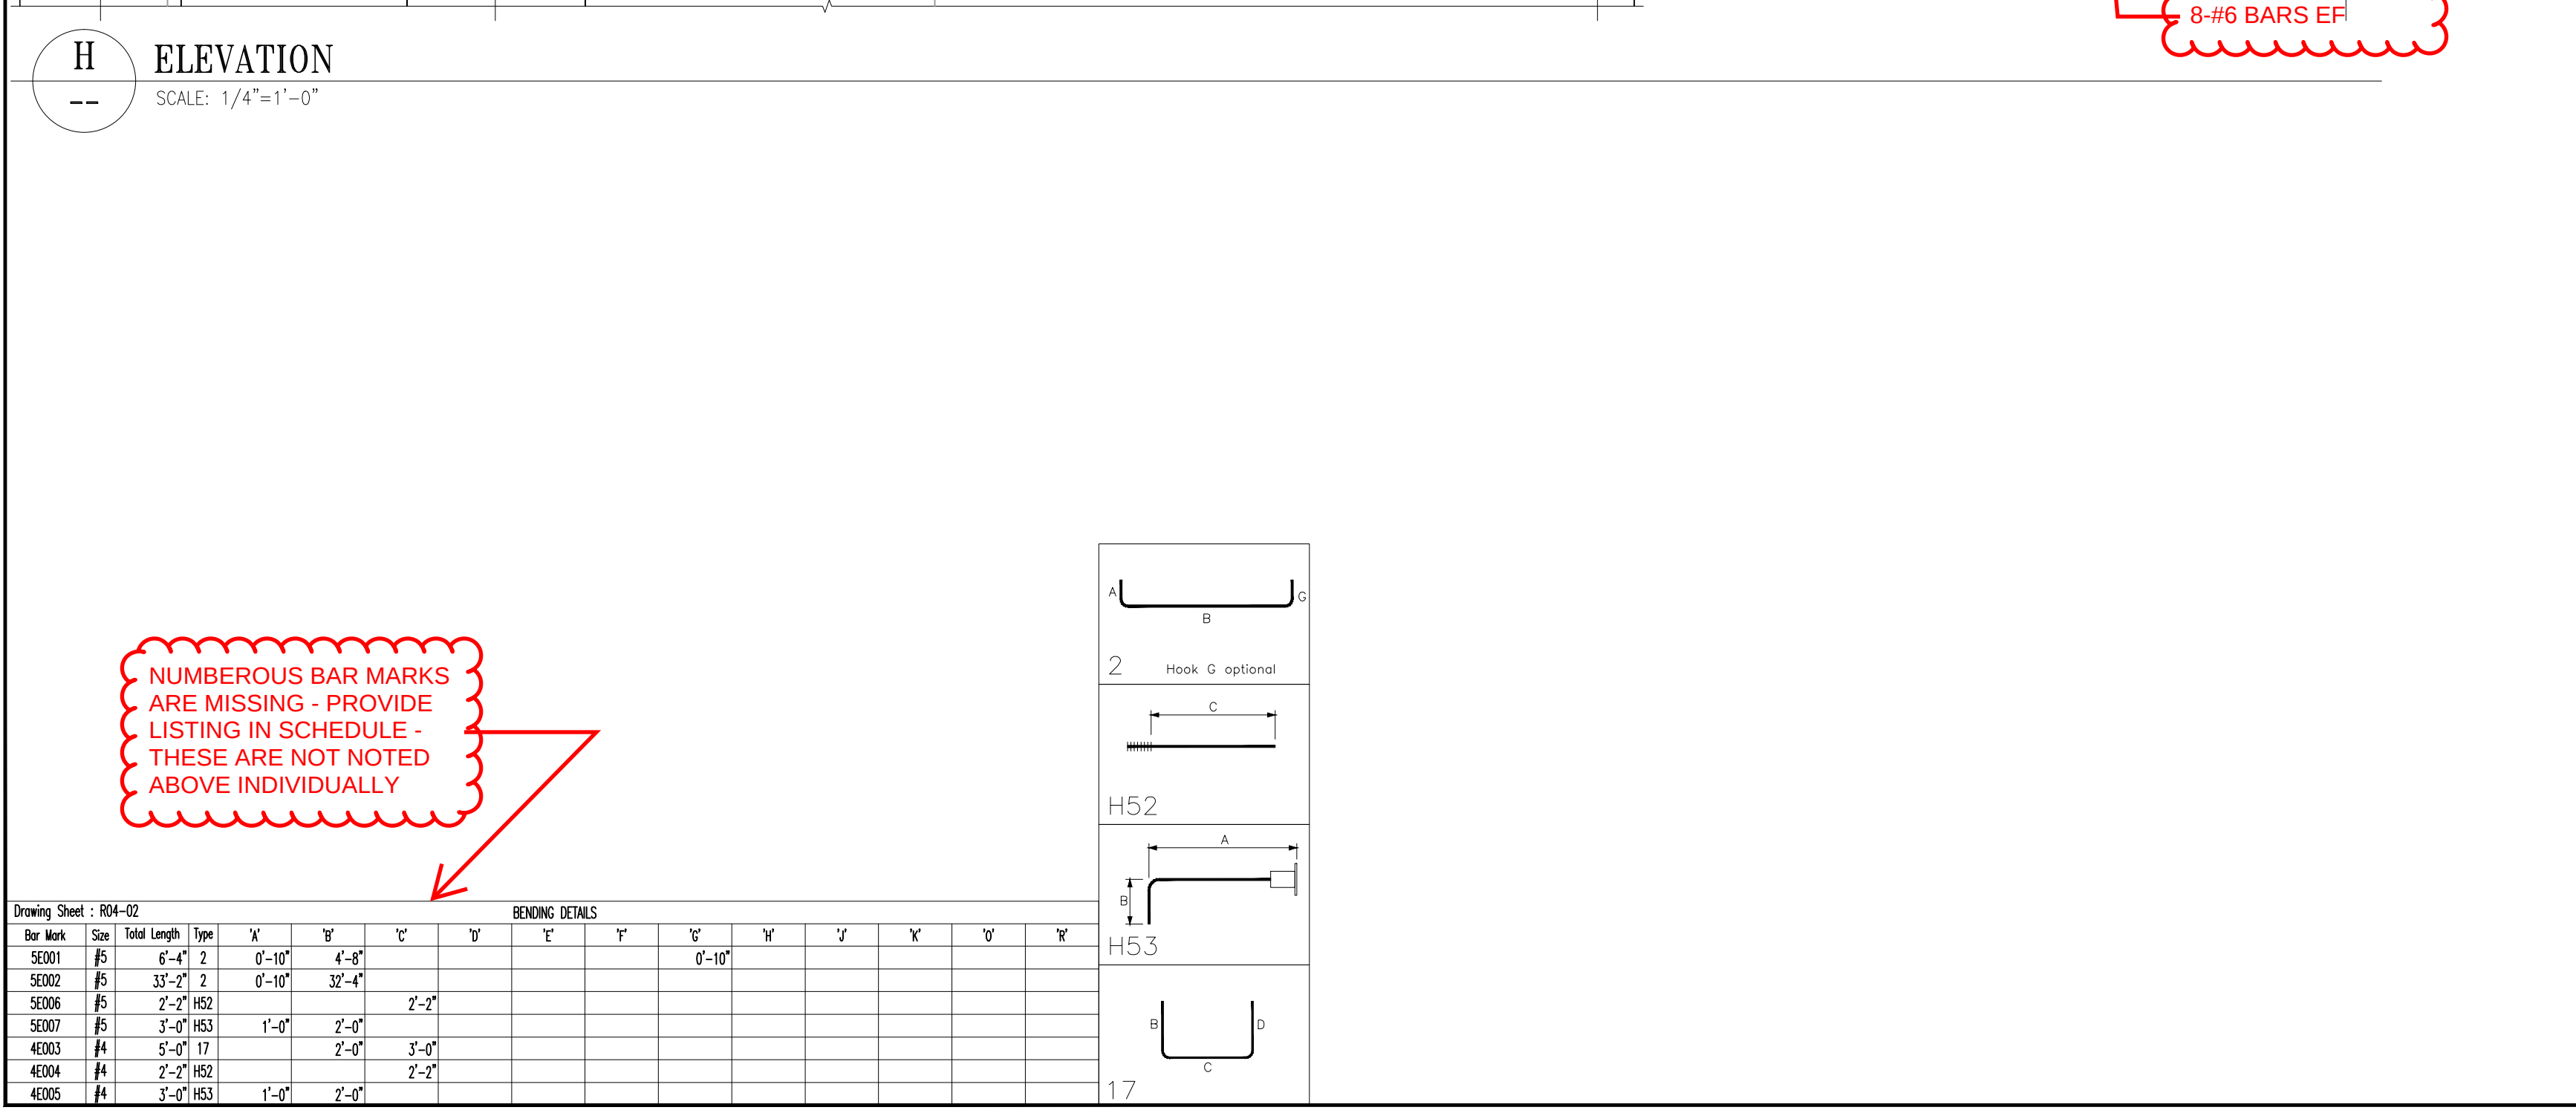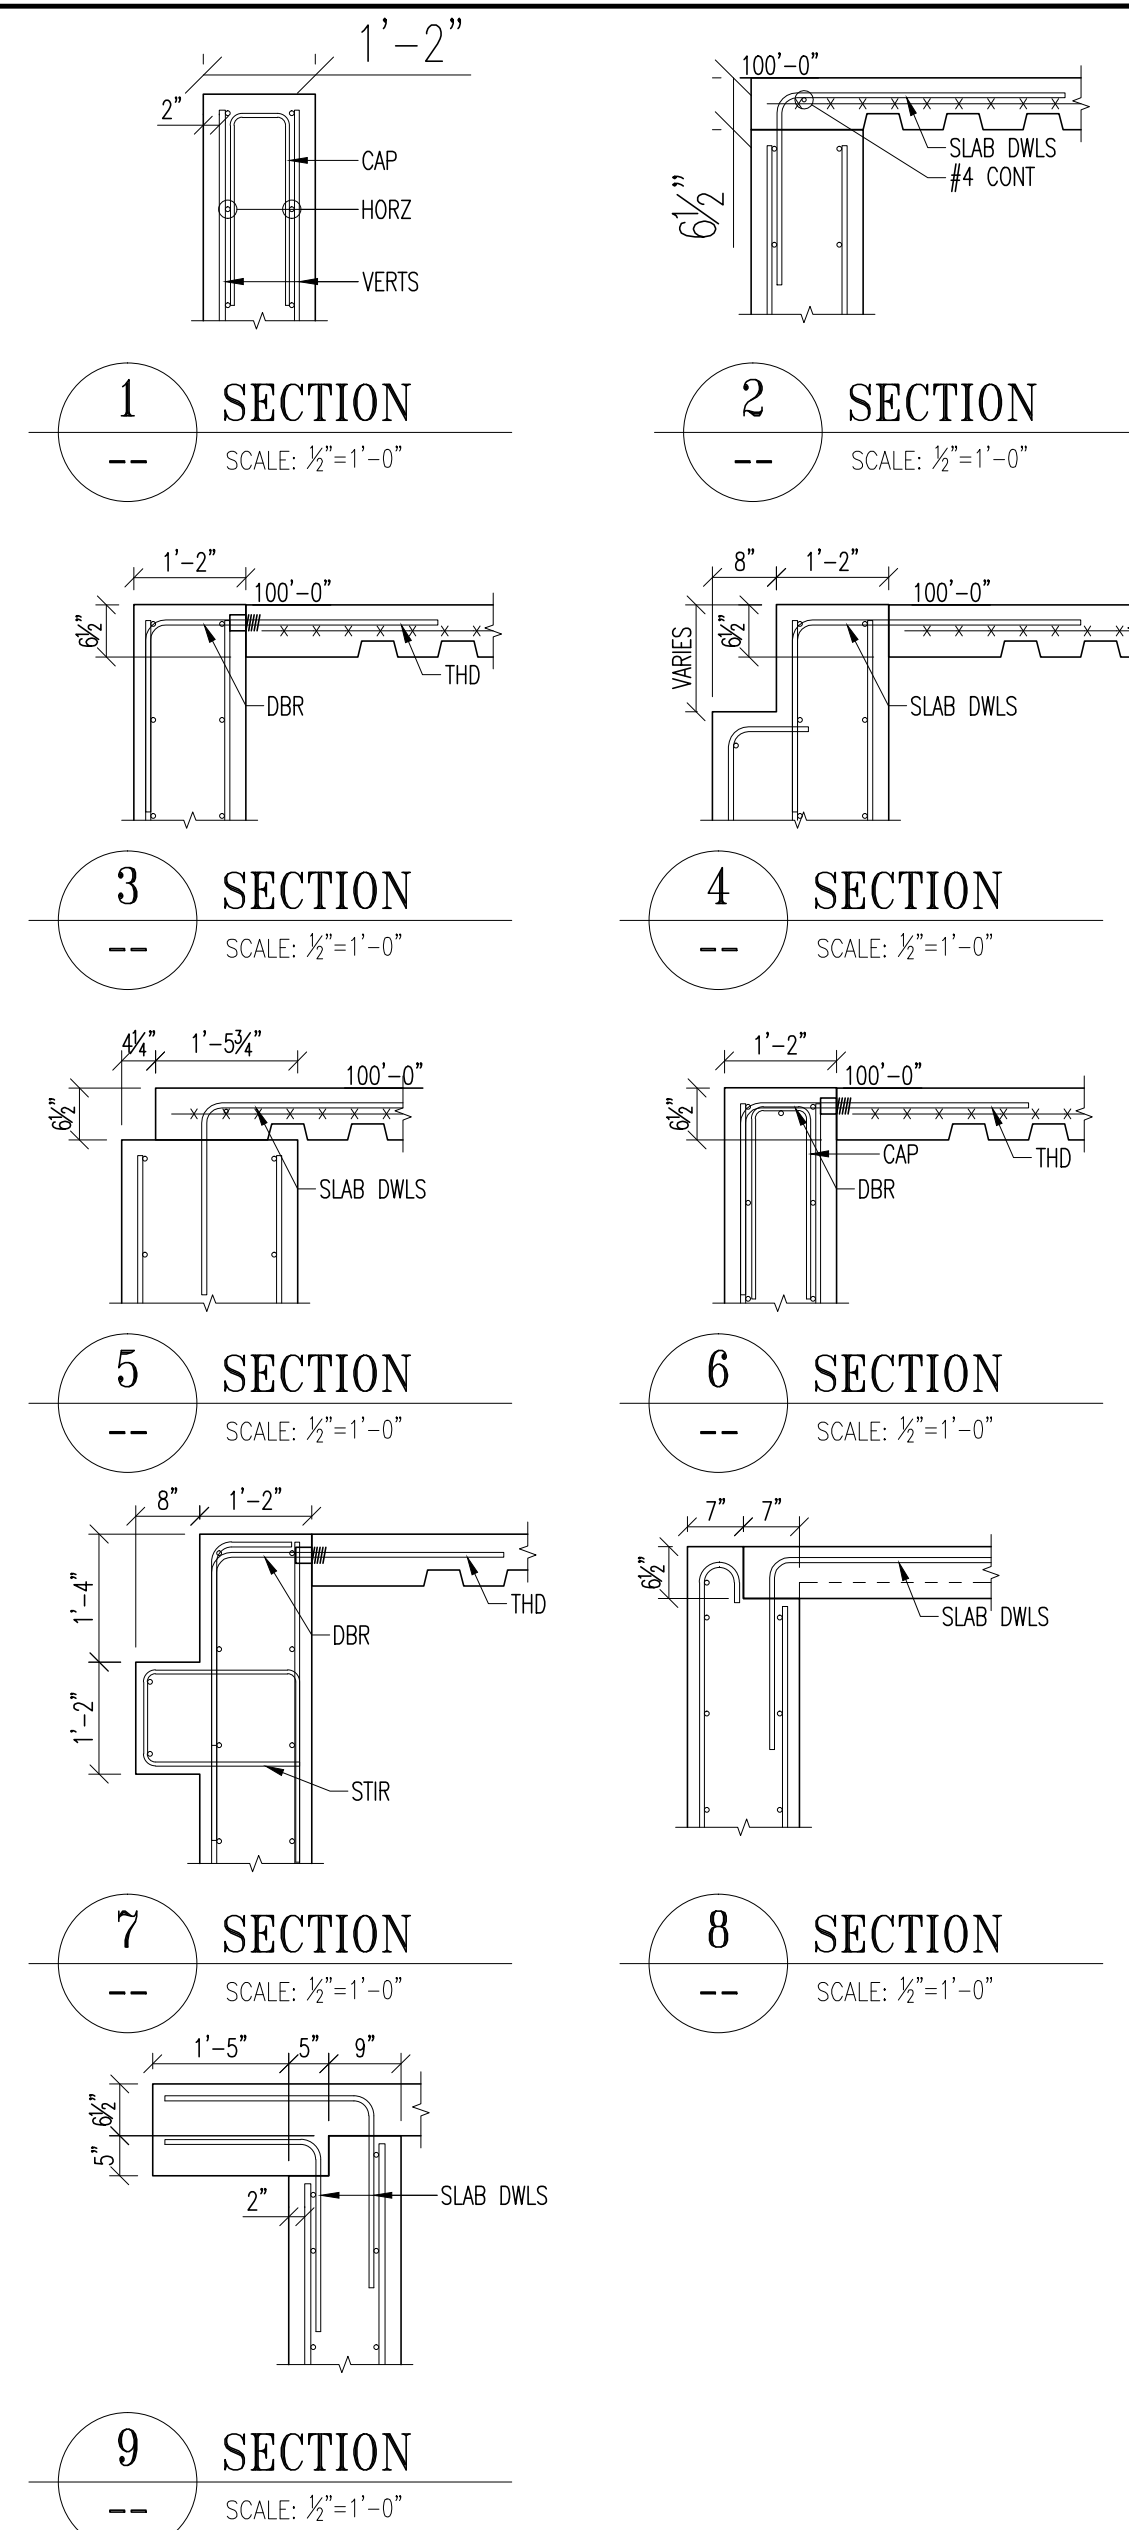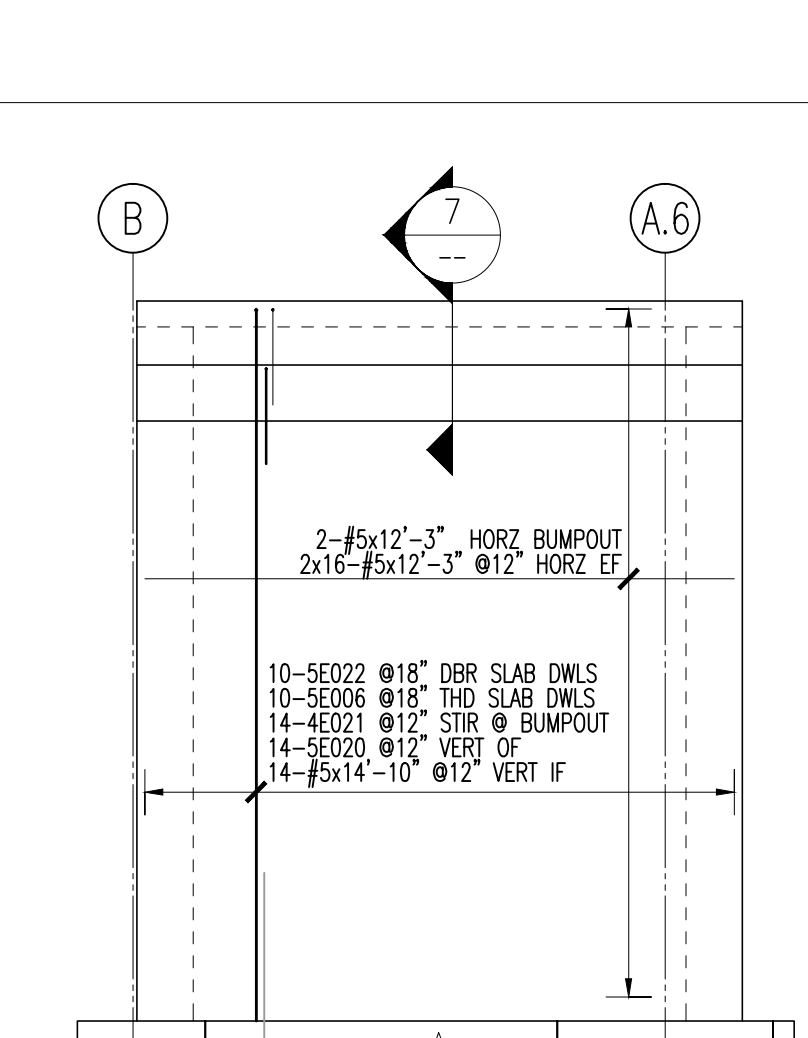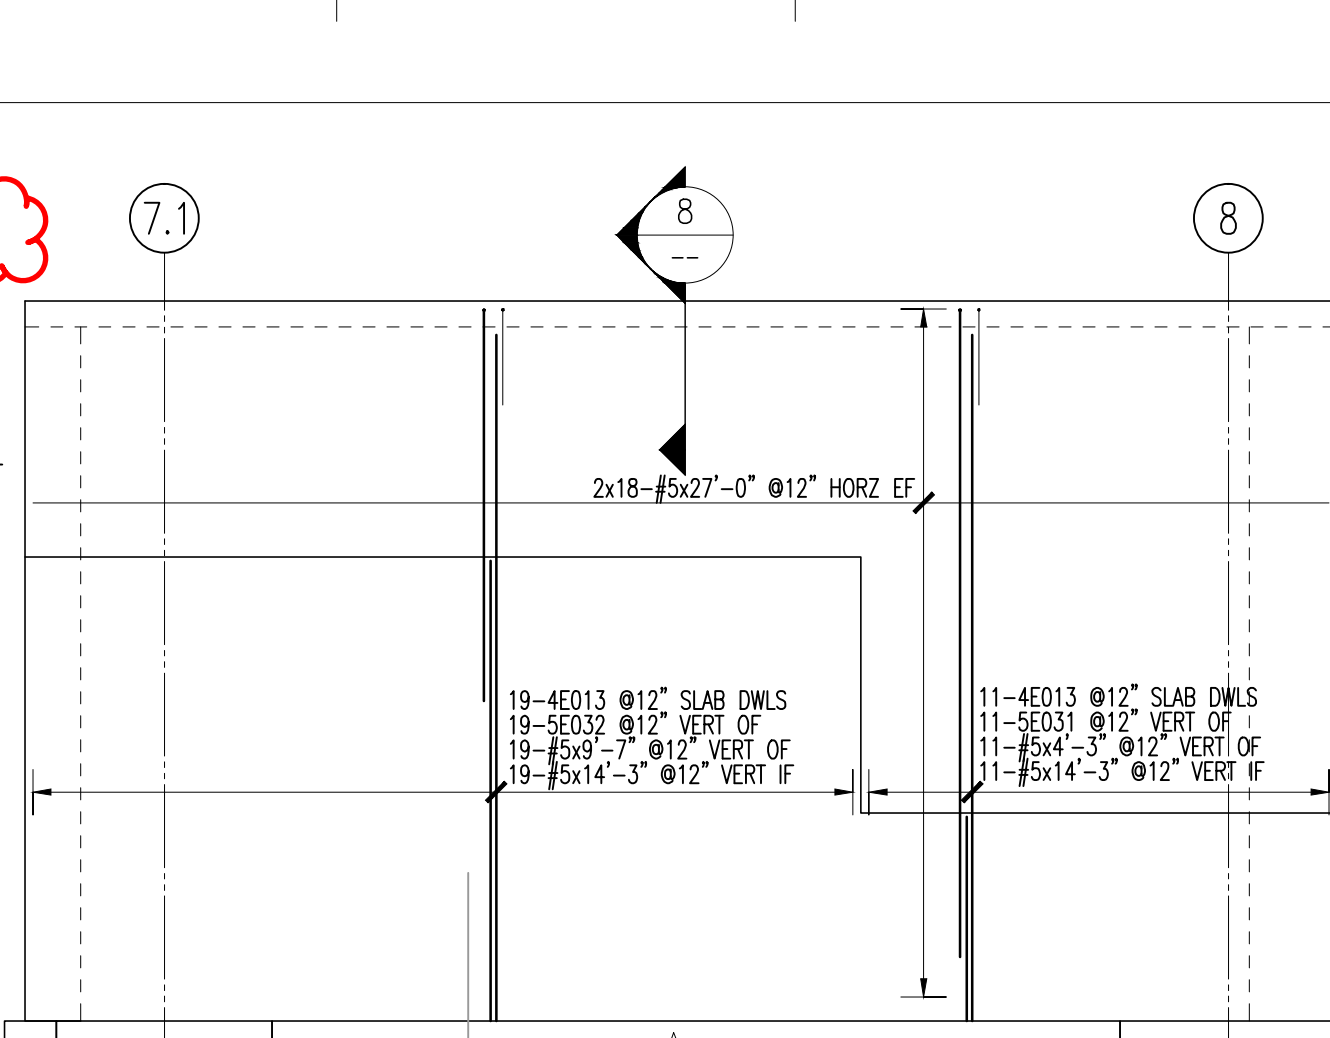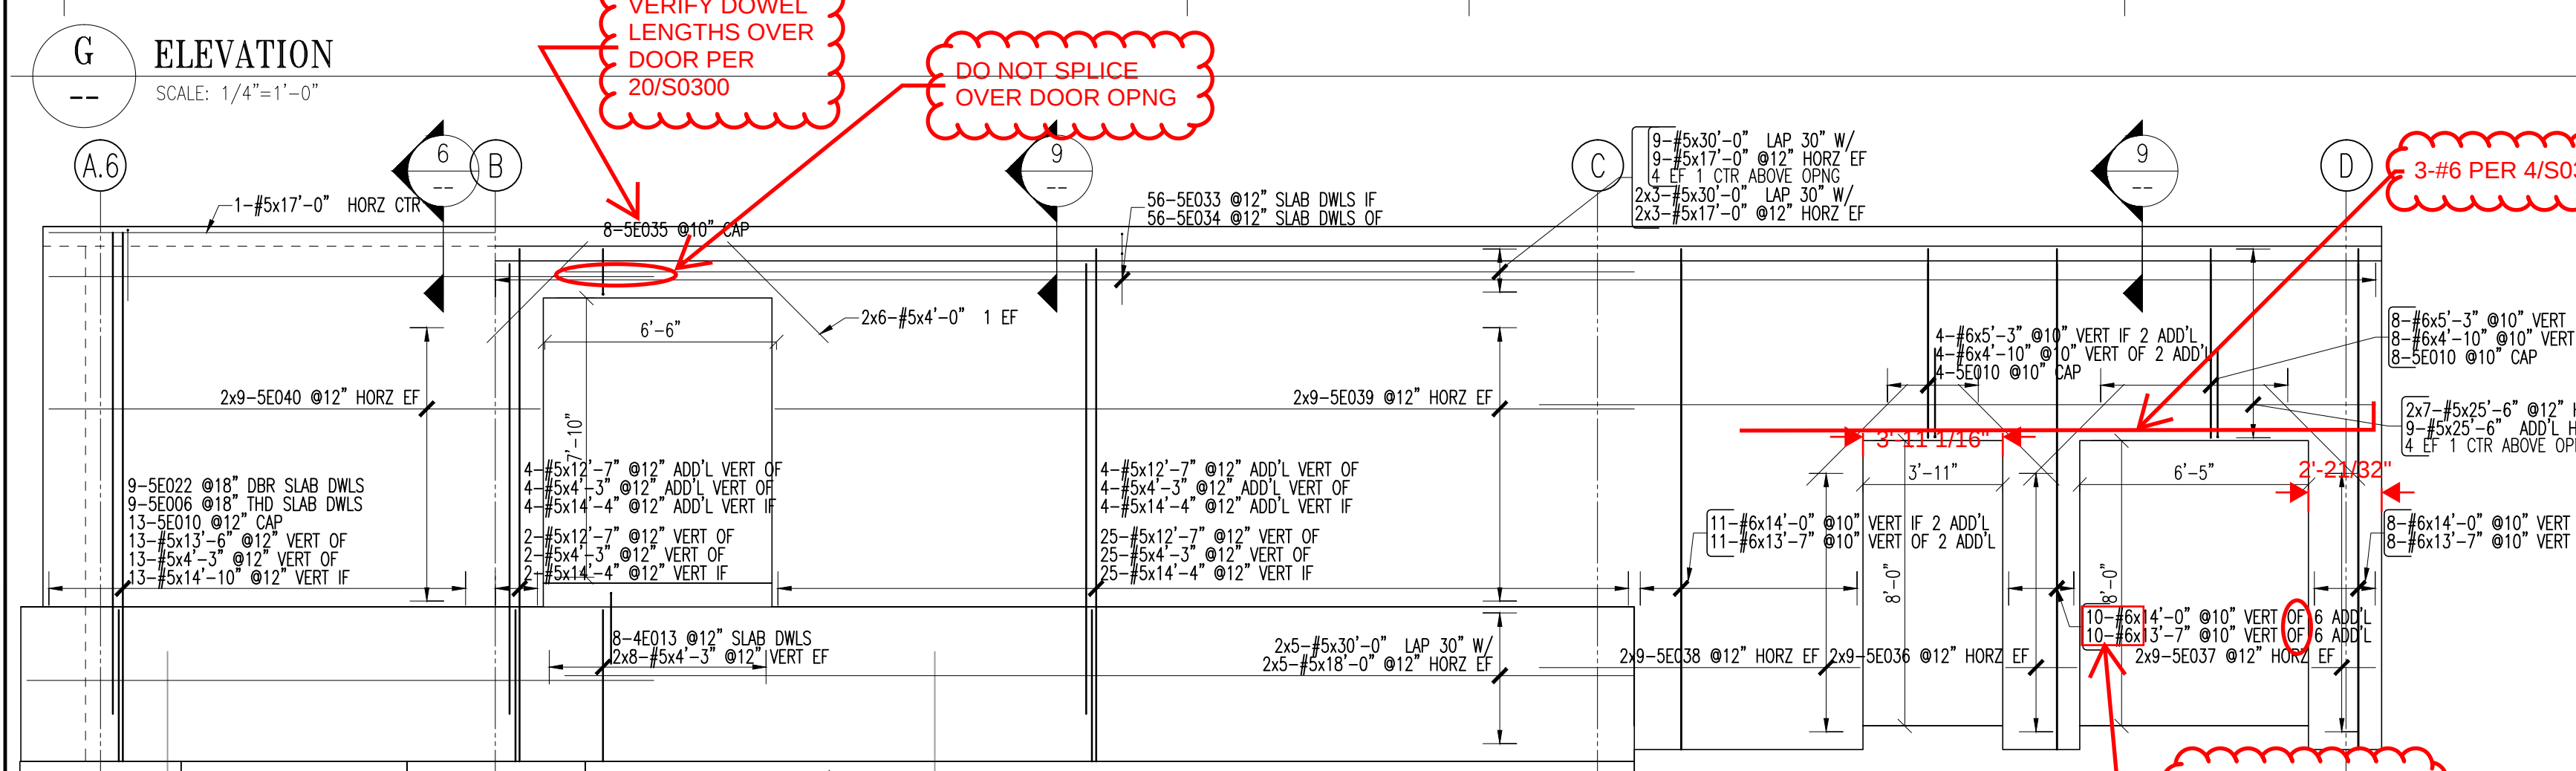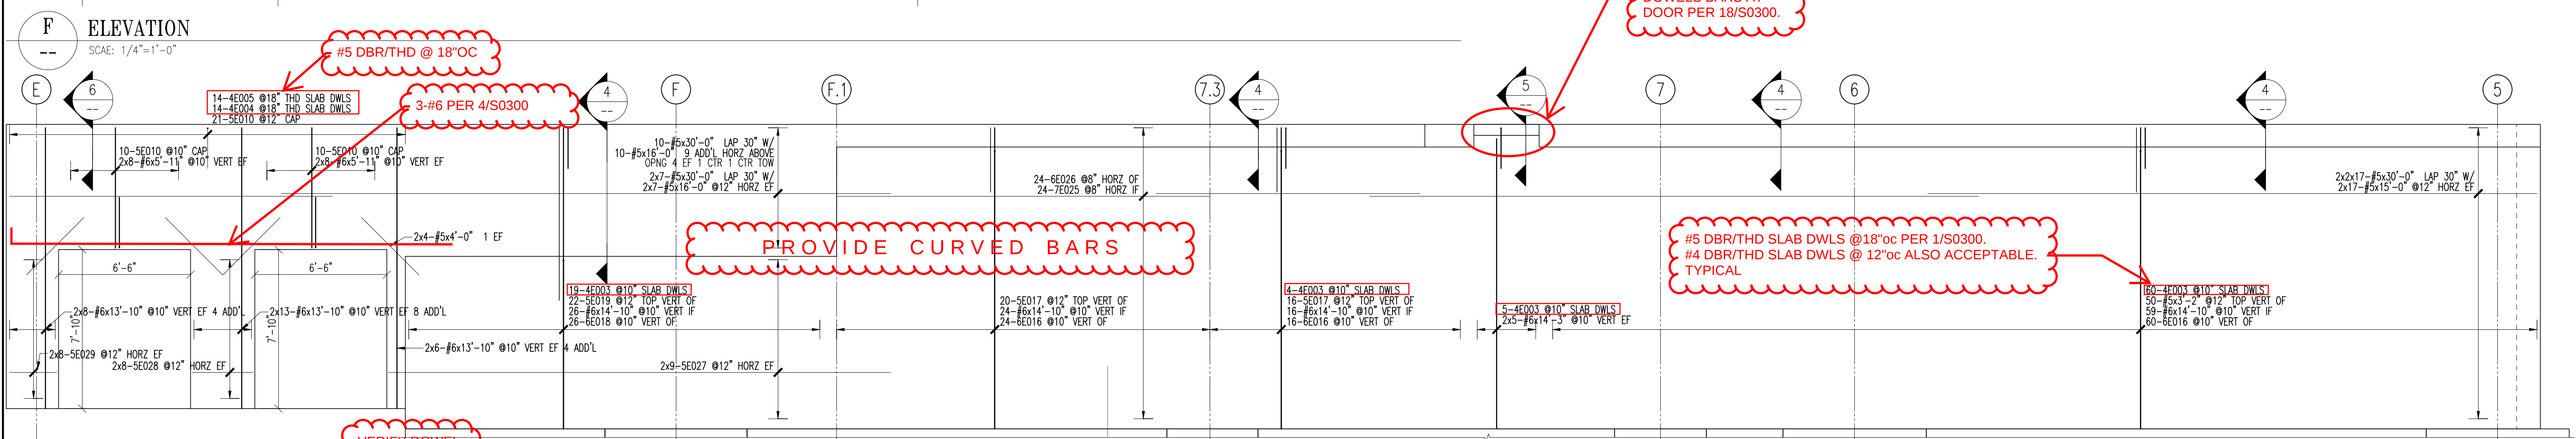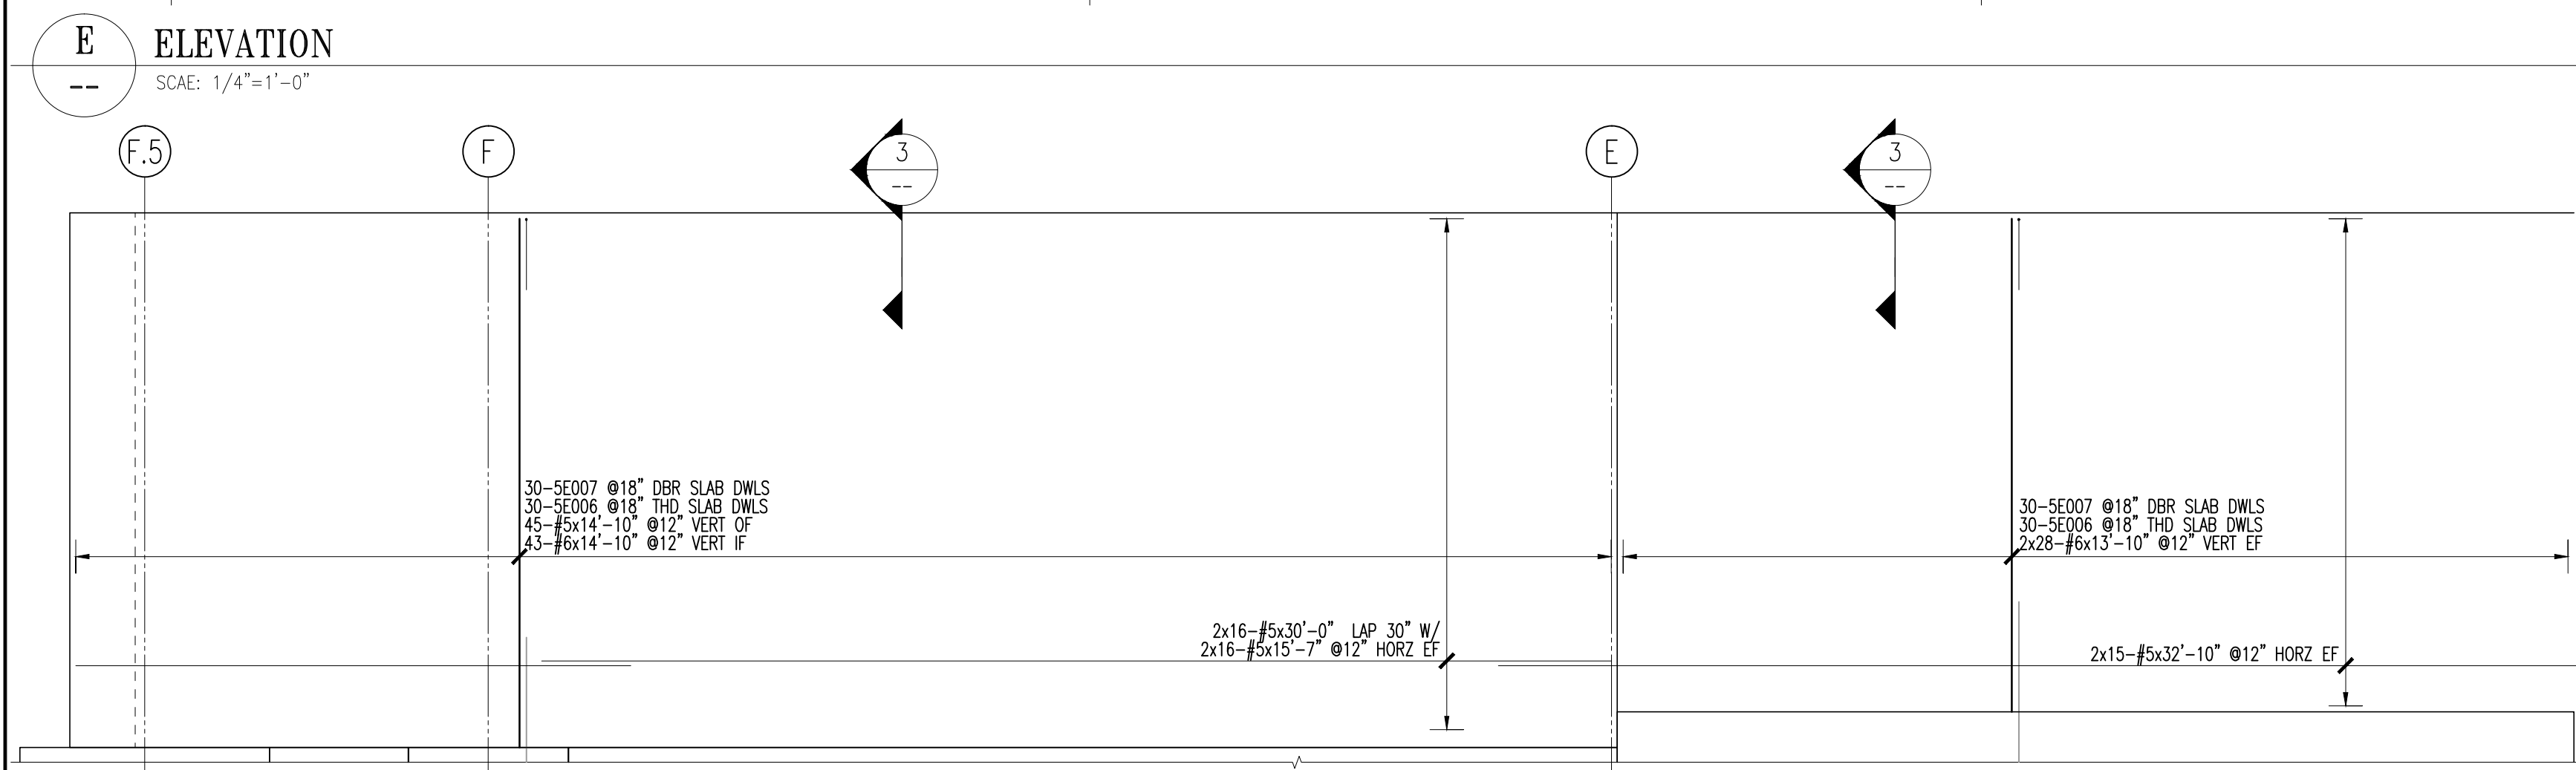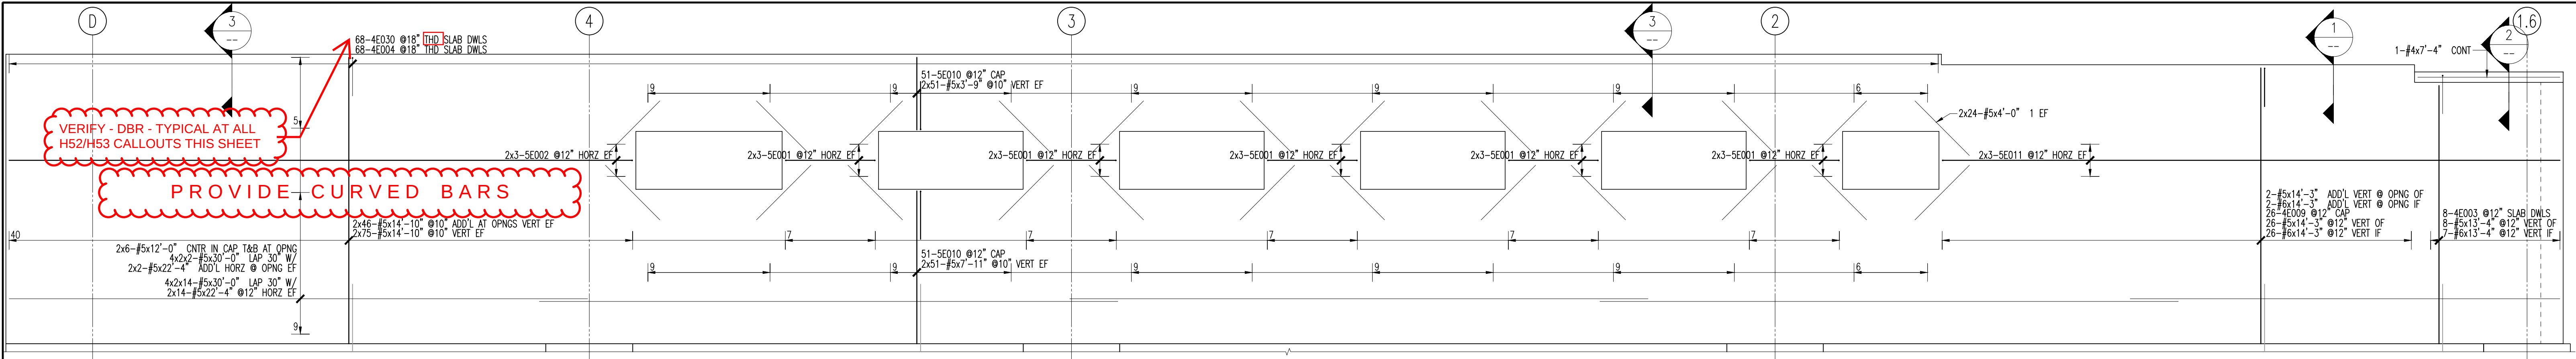

REINFORCING DETAILS



Bar Mark	Size	Total Length	Type	X	Y	Z	W	V	U	T	S	R	Q	P	O	N	M	L	K	J	I	H	G	F	E	D	C	B	A
5001	#5	6'-4"	2	0'-10"	4'-8"																								
5002	#5	3'-0"	2	0'-10"	3'-4"																								
5006	#5	2'-2"	H52		2'-2"																								
5007	#5	2'-0"	H53	1'-0"	2'-0"																								
4003	#4	5'-0"	17		2'-0"																								
4004	#4	2'-0"	H52		2'-0"																								
4005	#4	2'-0"	H53	1'-0"	2'-0"																								

17


0	FOR APPROVAL	05/20/16	JLH
No.	Description	Date	By
Revisions and Issue Record			
The full intent and purpose of this drawing is the placing of reinforcing steel bars ONLY. It is NOT to be used as a means of communication between the Architect, Engineer, Contractor or any other Sub-trades.			
THIS DRAWING IS NOT TO BE SCALED.			
ST. LOUIS, MO.			
DETAILED AT: ROCHELLE, IL.			
Project: WEBSTER ISB PHASE 1			
Drawing: WALL ELEVATIONS & SECTIONS			
Customer: KCI CONSTRUCTION			
Engineer: DAVID MASON & ASSOCIATES, INC.			
Date	Drawn	Chkd.	JOB No.
05/20/16	JLH		00916023
			Dwg. No.
			R04-02

N:\Detailing\Jobs-Rochelle\2016 Jobs\00916023-Webster ISB Phase 1\Amb CAD Files\Rev 0\00916023 R04-01 Rev 0.dwg

Drawing Sheet : R04-03				BENDING DETAILS										
Bar Mark	Size	Total Length	Type	X	Y	Z	W	V	U	T	S	R	Q	P
5E008	#5	2'-0"	183											
5E008	#5	5'-0"	17											
5E023	#5	2'-11"	183											
4E024	#5	6'-0"	11											

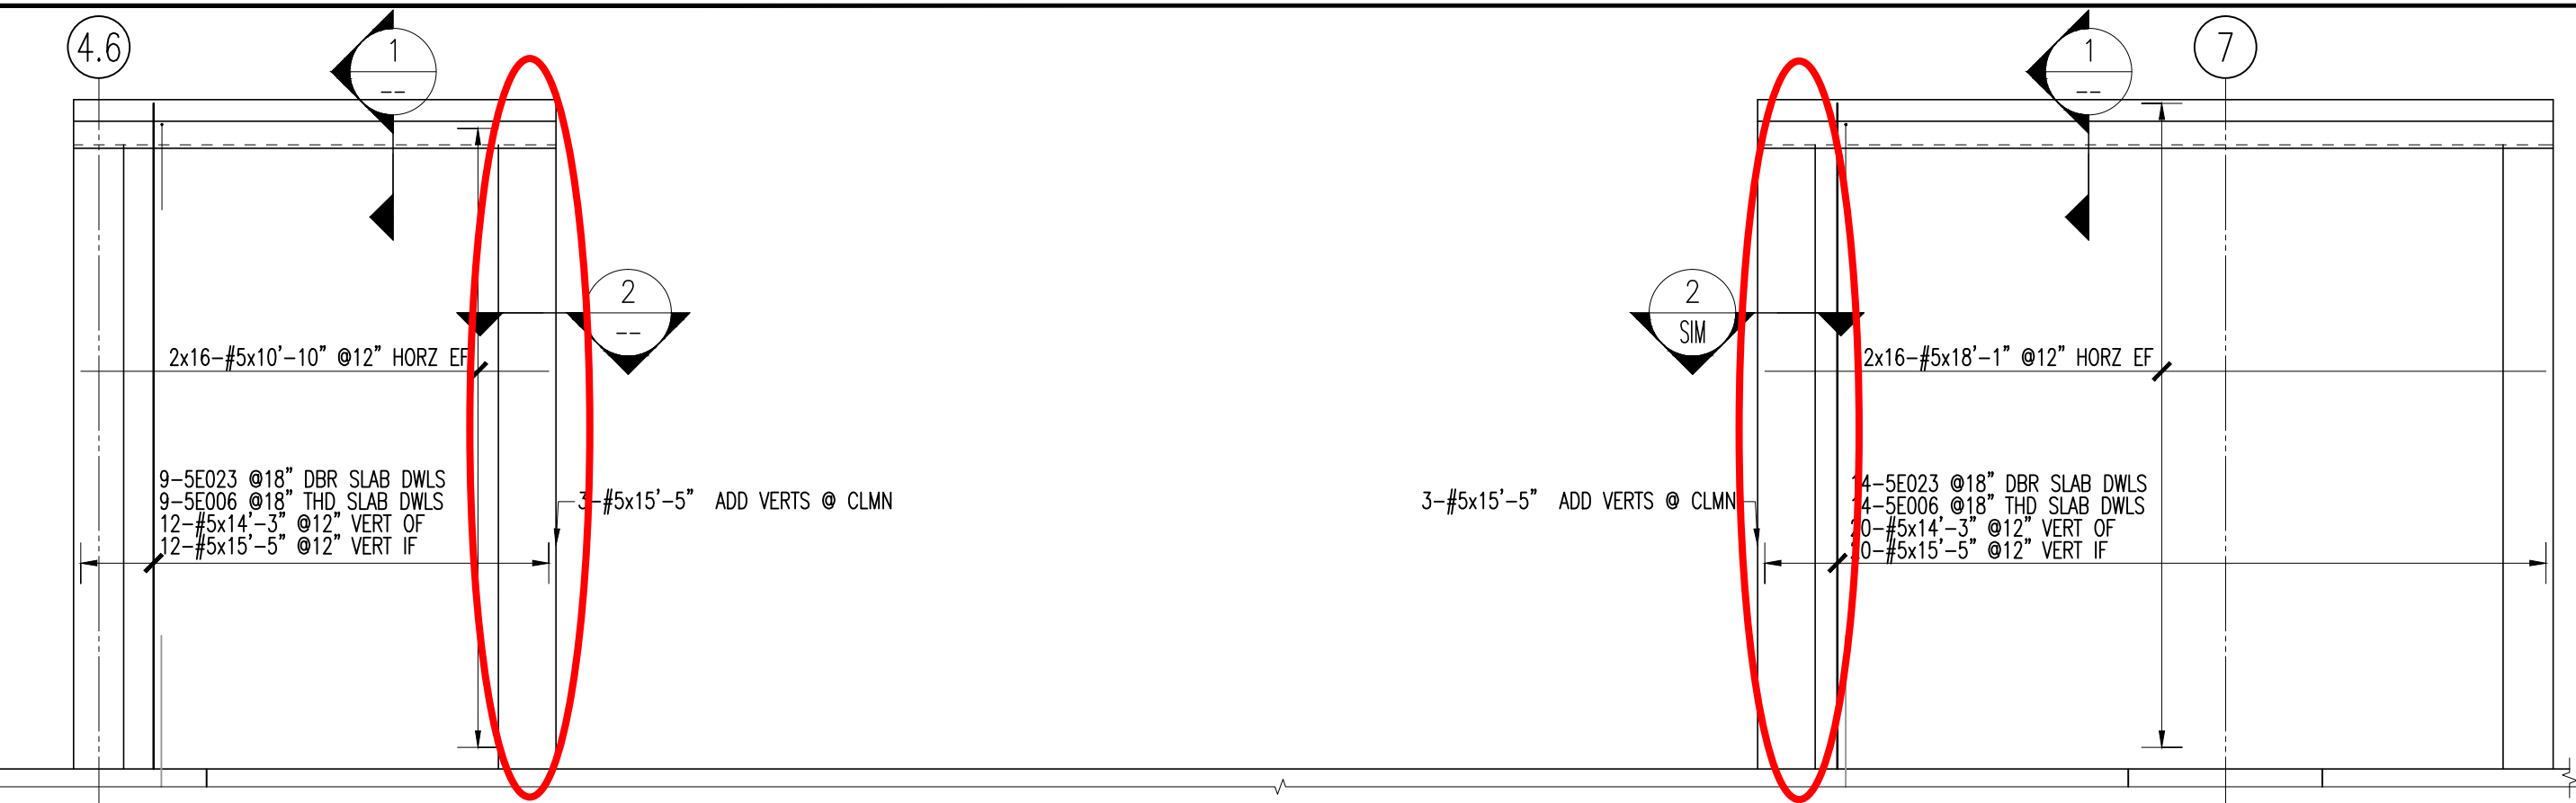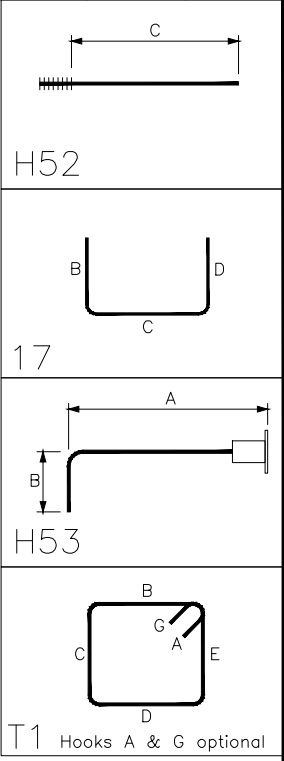


L ELEVATION
SCALE: 1/4"=1'-0"

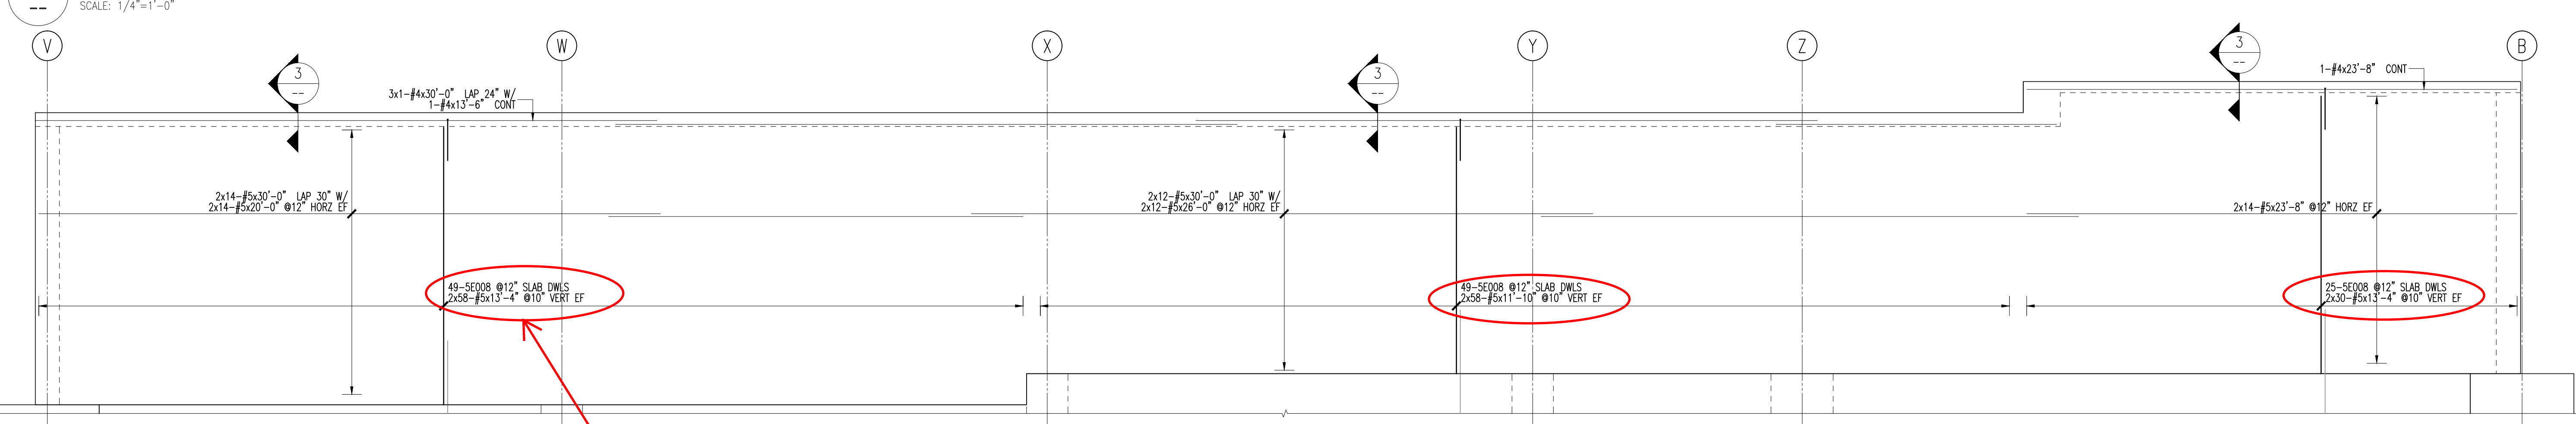

M ELEVATION
SCALE: 1/4"=1'-0"

#4 DWLS @ 12"oc
#5 @ 10"oc OF
#6 @ 10"oc IF
REVISE WALL
TYPICAL

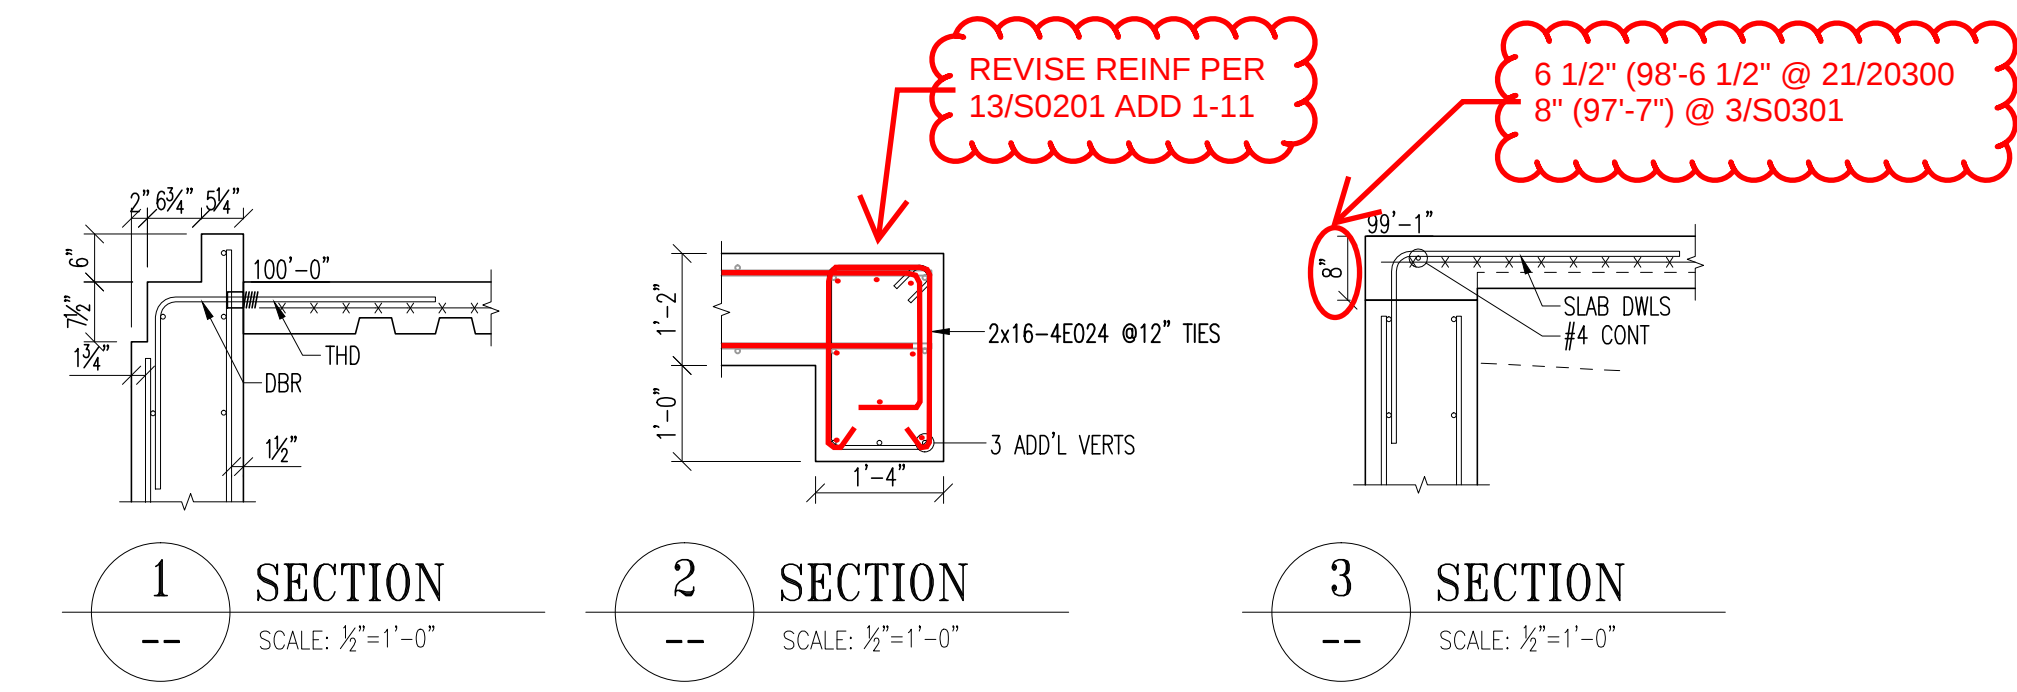

1 SECTION SCALE: 3/8"=1'-0"
2 SECTION SCALE: 3/8"=1'-0"
3 SECTION SCALE: 3/8"=1'-0"

Revisions and Issue Record			
No.	Description	Date	By
0	FOR APPROVAL	05/20/16	JLH
The full intent and purpose of this drawing is the placing of reinforcing steel bars ONLY. It is NOT to be used as a means of communication between the Architect, Engineer, Contractor or any other Sub-trades.			
THIS DRAWING IS NOT TO BE SCALED.			
ST. LOUIS, MO.			
DETAILED AT: ROCHELLE, IL. PHONE: 615-561-1771			
Project: WEBSTER ISB PHASE 1			
Drawing: WALL ELEVATIONS & SECTIONS			
Customer: KCI CONSTRUCTION			
Engineer: DAVID MASON & ASSOCIATES, INC.			
Date	Drawn	Chkd.	JOB No.
05/20/16	JLH		00916023
			Dwg. No.
			R04-03

SUBMITTAL IDENTIFICATION SHEET

To be completed by Contractor/CM

PROJECT NAME

ADDRESS

NUMBER

OWNER

ARCHITECT / ENGINEER

SUBMITTED BY

CONTRACTOR / CM SUBMITTAL NO. CANNON DESIGN SUBMITTAL NO.

DRAWING / DETAIL REFERENCE SPECIFICATION SECTION / PARAGRAPH

MANUFACTURER / SUPPLIER ITEM / PRODUCT ID

REQUIRED DATE PRIORITY CRITICAL

ITEM BEING SUBMITTED (check only one)

- ☐ Shop Drawings
☐ Samples
☐ (____ copies)
☐ LEED Submittal
☐ Other _____
- ☐ Certification / Qualifications
☐ Record Documents
☐ Product Data
- ☐ Coordination Drawing
☐ Calculations
☐ Schedules
☐ O&M Manuals

ITEM BEING SUBMITTED FOR (check only one)

- ☐ Action
☐ Information Only
☐ Record

REMARKS OR DEVIATIONS

SEE ADD'L/REVISED
INFO ON SHEET R04-01
NOTED IN BLUE

CONTRACTOR / CM CERTIFICATION (SUBMITTALS NOT CERTIFIED WILL BE RETURNED WITHOUT REVIEW)



PARIC CORPORATION
SUBMITTAL STAMP

THIS SHOP DRAWING HAS BEEN REVIEWED BY PARIC CORPORATION

Subcontractor remains responsible for dimensions, quantities, coordination with other trades and compliance with contract documents.

By:

Devin D. Gates

JYW
6/9/2016

To be completed by Reviewer

CANNON DESIGN SUBMITTAL NUMBER

RECEIVED DATE

- ☐ A. No Exceptions Taken
No further review of submittal is required.
- ☐ B. Make Corrections Noted
Incorporate corrections in work; resubmission is not required.
- ☐ C. Revise and Resubmit
Revise as noted, and resubmit for review.
- ☐ D. Rejected
Submittal is not in compliance with Contract Documents; provide new submittal.
- ☐ E. For Record / Information Only
Submittal was reviewed for Record / Information purposes only.
- ☐ F. Not Required for Review
Submittal is not required by Contract Documents and has not been reviewed.

Review is for conformance with the design concept of this project and for general compliance with contract documents. Contractor is responsible for quantities, dimensions and compliance with contract documents and for information that pertains to fabrication processes, construction techniques and coordination of this work with all trades which will be affected thereby. This review is null and void if submittal deviates from contract documents and does not indicate or note deviations.

A/E COMMENTS

☐ See attached sheet(s) for additional comments

SHOP DRAWING / SUBMITTAL REVIEW

☐ NO EXCEPTION TAKEN
☐ REJECTED
☐ REVIEWED FOR INFORMATION ONLY

☒ EXCEPTIONS NOTED, RESUBMITTAL NOT REQUIRED
☐ REVISE AND RESUBMIT AS NOTED

Checking is only for general conformance with the design concept of the project and general compliance with the information given in the Contract Documents. Any action shown is subject to the requirements of the plans and specifications. Contractor is responsible for: Dimensions which shall be confirmed and correlated at the job site, fabrication processes and techniques of the construction, coordination of his work with that of all other trades and the satisfactory performance of his work.

DAVID MASON & ASSOCIATES, INC.

REVIEW BY: JYW DATE: 06/09/2016

REVIEWED BY

DATE

REVIEWED BY

DATE



77 Westport Plaza
Suite 250
St. Louis, MO 63146

TRANSMITTAL

No. 15051-0044

Paric Corporation

PROJECT: Webster University Interdisciplinary Science Building

DATE: 05/23/2016

TO: Cannon Design
1100 Clark Ave
St Louis MO 63102

RE: Steel Reinforcing Shop Drawings - Level
01 Walls

ATTN: Kelvin Patel

JOB: 15051

WE ARE SENDING:	SUBMITTED FOR:	ACTION TAKEN:
☒ Shop Drawings	☒ Approval	☒ Approved as Submitted
☐ Letter	☐ Your Use	☐ Approved as Noted
☐ Prints	☐ As Requested	☐ Returned After Loan
☐ Change Order	☐ Review and Comment	☐ Resubmit
☐ Plans		☐ Submit
☐ Samples	SENT VIA:	☐ Returned
☐ Specifications	☐ Attached	☐ Returned for Corrections
☐ Other:	☐ Separate Cover Via:	☐ Due Date:

Item	Package	Code	Rev.	Copies	Date	Description	Status
Submittal		033000-21	1		05/23/2016	Steel Reinforcing Shop Drawings - Level 01 Walls	Submitted

NOTES:

CC: Paric Corporation, Kathy Bathe

Project Coordinator: Paric Corporation, Kathy Bathe

Signed: _____
Devin Gates



KCI Construction Company, Inc.
ST. LOUIS: 10315 Lake Bluff Drive | St. Louis, MO 63123
LEBANON: 119 West Fremont | Lebanon, MO 65536

O: 314.894.8888
F: 314.894.7418
www.kciconstruction.com

SUBMITTAL TRANSMITTAL

Date Sent: 05/20/2016

Project: Webster University –
Interdisciplinary Science Building

Project #: 16-008

Subject: 03 3000 Cast-In-Place Concrete –
Steel Reinforcing Shop Drawings –
Level 01 Walls

Submittal ID: 0009

Type: Submittal

Purpose: For Approval

Sent Via: Email (PDF)

Transmitted To:

Devin Gates
Paric
77 Westport Plaza, Suite 250
St. Louis, MO, 63146
Phone: (636) 561-9592
Email: ddgates@paric.com

Transmitted From:

Kyle Nieman
KCI Construction Company
10315 Lake Bluff Drive
St. Louis, MO 63123
Phone: (314) 200-6486
Email: knieman@kciconstruction.com

Contents:

Qty: 1 Dated: 05/20/2016 Submittal Package No.: 0009 – 03 3000 – 00

Description: 03 3000-00_Cast-In-Place Concrete – Steel Reinforcing Shop Drawings – Level 01 Walls

Remarks: Please review and return at your earliest opportunity. Thanks,

 05/20/16

Kyle Nieman
KCI Construction Company

A BUILDER, NOT A BROKER.

General Building | Design/Build | Heavy Industrial | Transportation



KCI Construction Company, Inc.

ST. LOUIS: 10315 Lake Bluff Drive | St. Louis, MO 63123

LEBANON: 119 West Fremont | Lebanon, MO 65536

O: 314.894.8888

F: 314.894.7418

www.kciconstruction.com

WEBSTER UNIVERSITY – INTERDISCIPLINARY SCIENCE BUILDING

St. Louis, MO

Submittal Description: Cast-In-Place Concrete – Steel Reinforcing Shop Drawings – Level 01 Walls

Submittal #: 0009 – 03 3000 – 00

Notes:

This submittal/drawing has been reviewed and found to be in general conformance with the contract documents.

APPROVED

☒

APPROVED AS NOTED

☐

REVISE AND RESUBMIT

☐

03 3000

SPEC SECTION

05/20/2016

DATE

 05/20/16

KYLE NIEMAN

KCI CONSTRUCTION CO.

A BUILDER, NOT A BROKER.

General Building | Design/Build | Heavy Industrial | Transportation



Letter of Transmittal No. 0008

Harris Rebar-Ambassador Steel-St. Louis Branch
 150 Tyler Street
 St. Louis, MO 63102
 Phone: 1-314-382-9855 Fax: 1-314-382-1711

To: KCI Construction
 Webster ISB Phase 1

0
 0 0 0

Attn: KCI Construction

Transmittal date: 05/20/16

AMB Project no: 00916023

Project name: Webster ISB Phase 1

Project location: 0

Customer: KCI Construction

We are sending the following:		No. required
☒ Placing drawings	☒ Sending via: Email	☐ Bond(s)
☐ Copy of a letter	☐ Plans	☐ Vellum(s)
☐ Specifications	☐ Contract drawings	☐ CD of drawings
☐ Samples/Brochures	☐ Other (Please specify):	

Drawing No.	Revision No.	Placing drawing description
R04-00	0	SOG Plan Sections & Details
R04-01	0	Wall Elevation & Sections
R04-02	0	Wall Elevation & Sections
R04-03	0	Wall Elevation & Sections

The above items are transmitted as follows:





☒ For approval	☒ Please return 1 corrected\marked-up print(s)
☐ For final approval	☒ As requested
☐ For field use	☐ Other (Please specify):
☐ For review only	

Remarks and/or notes:


Copy to:
 1) File and project folder

Prepared by: Byron Edrington (Ext. 2236)

Email address: bedrington@harrisrebar.com

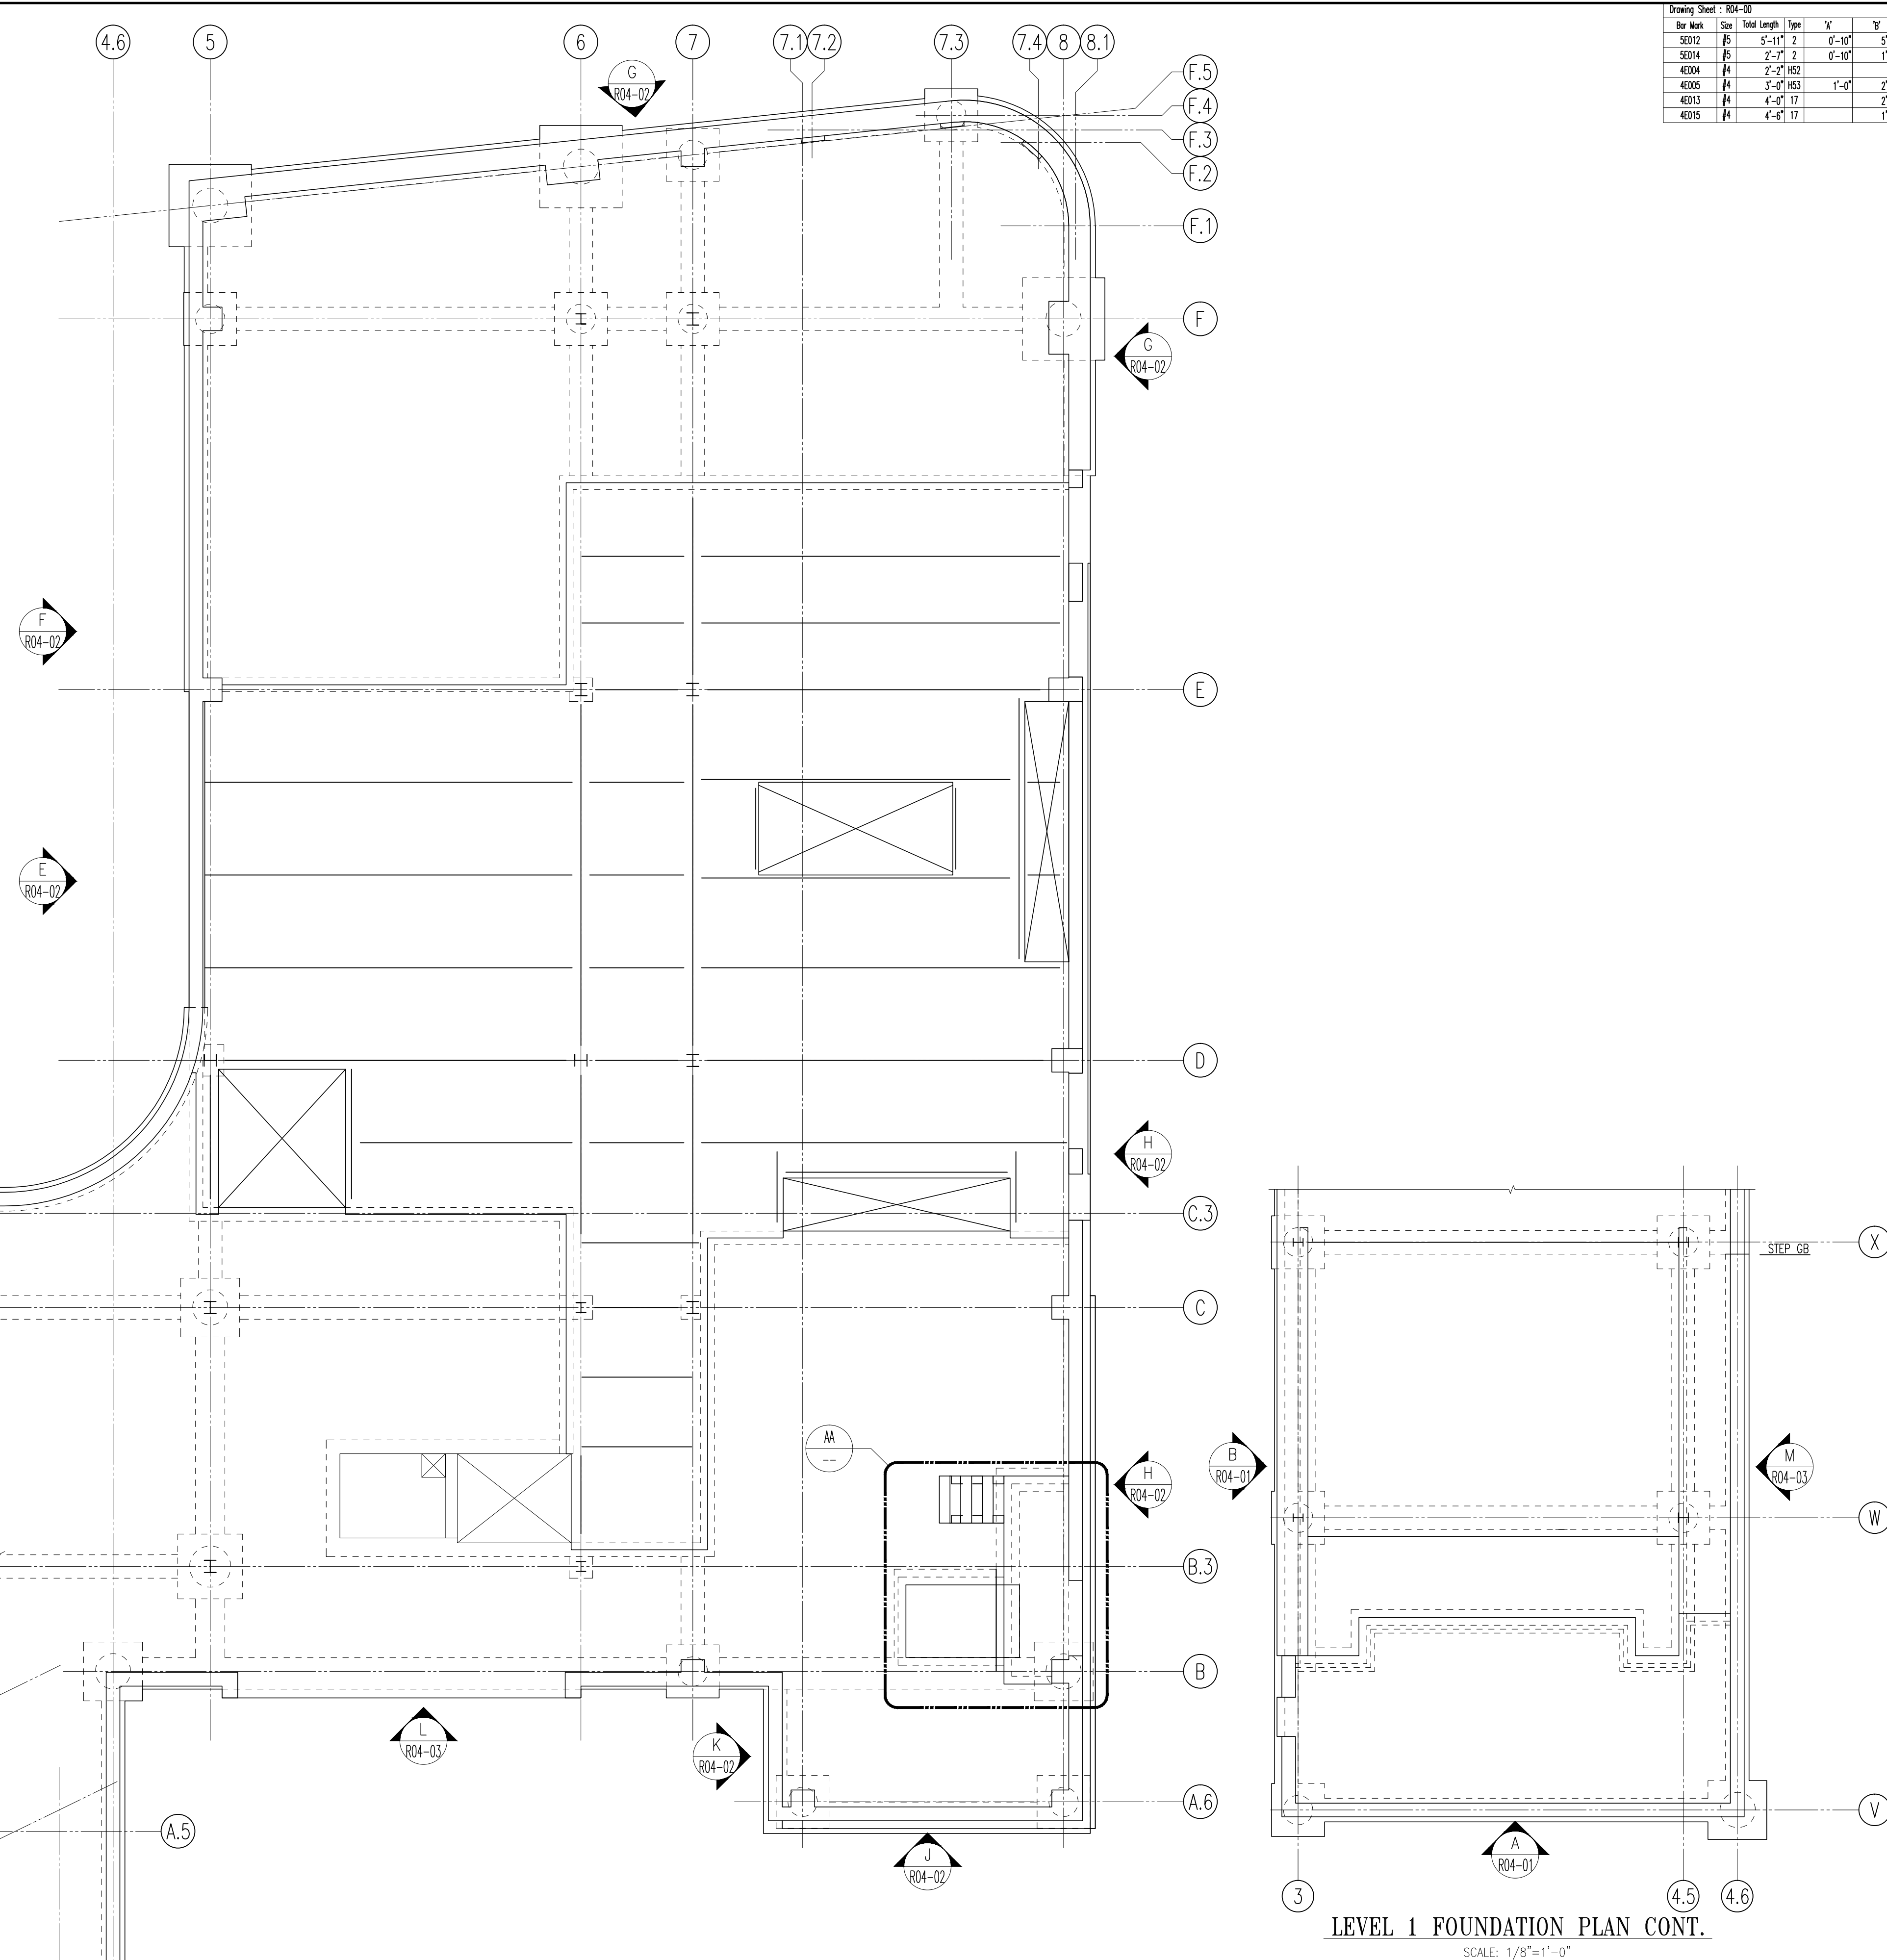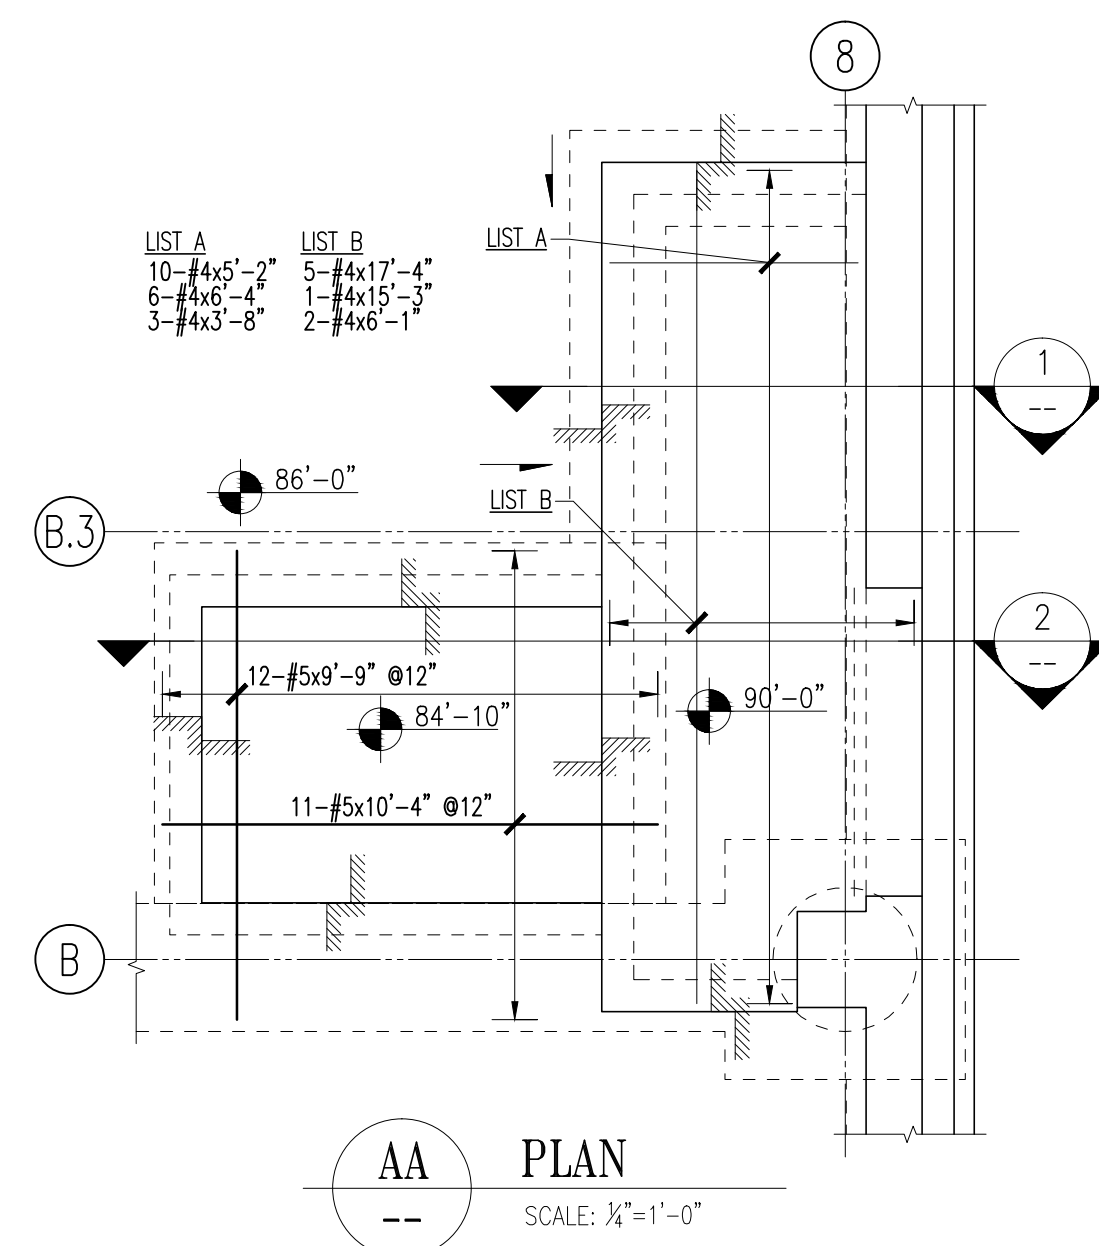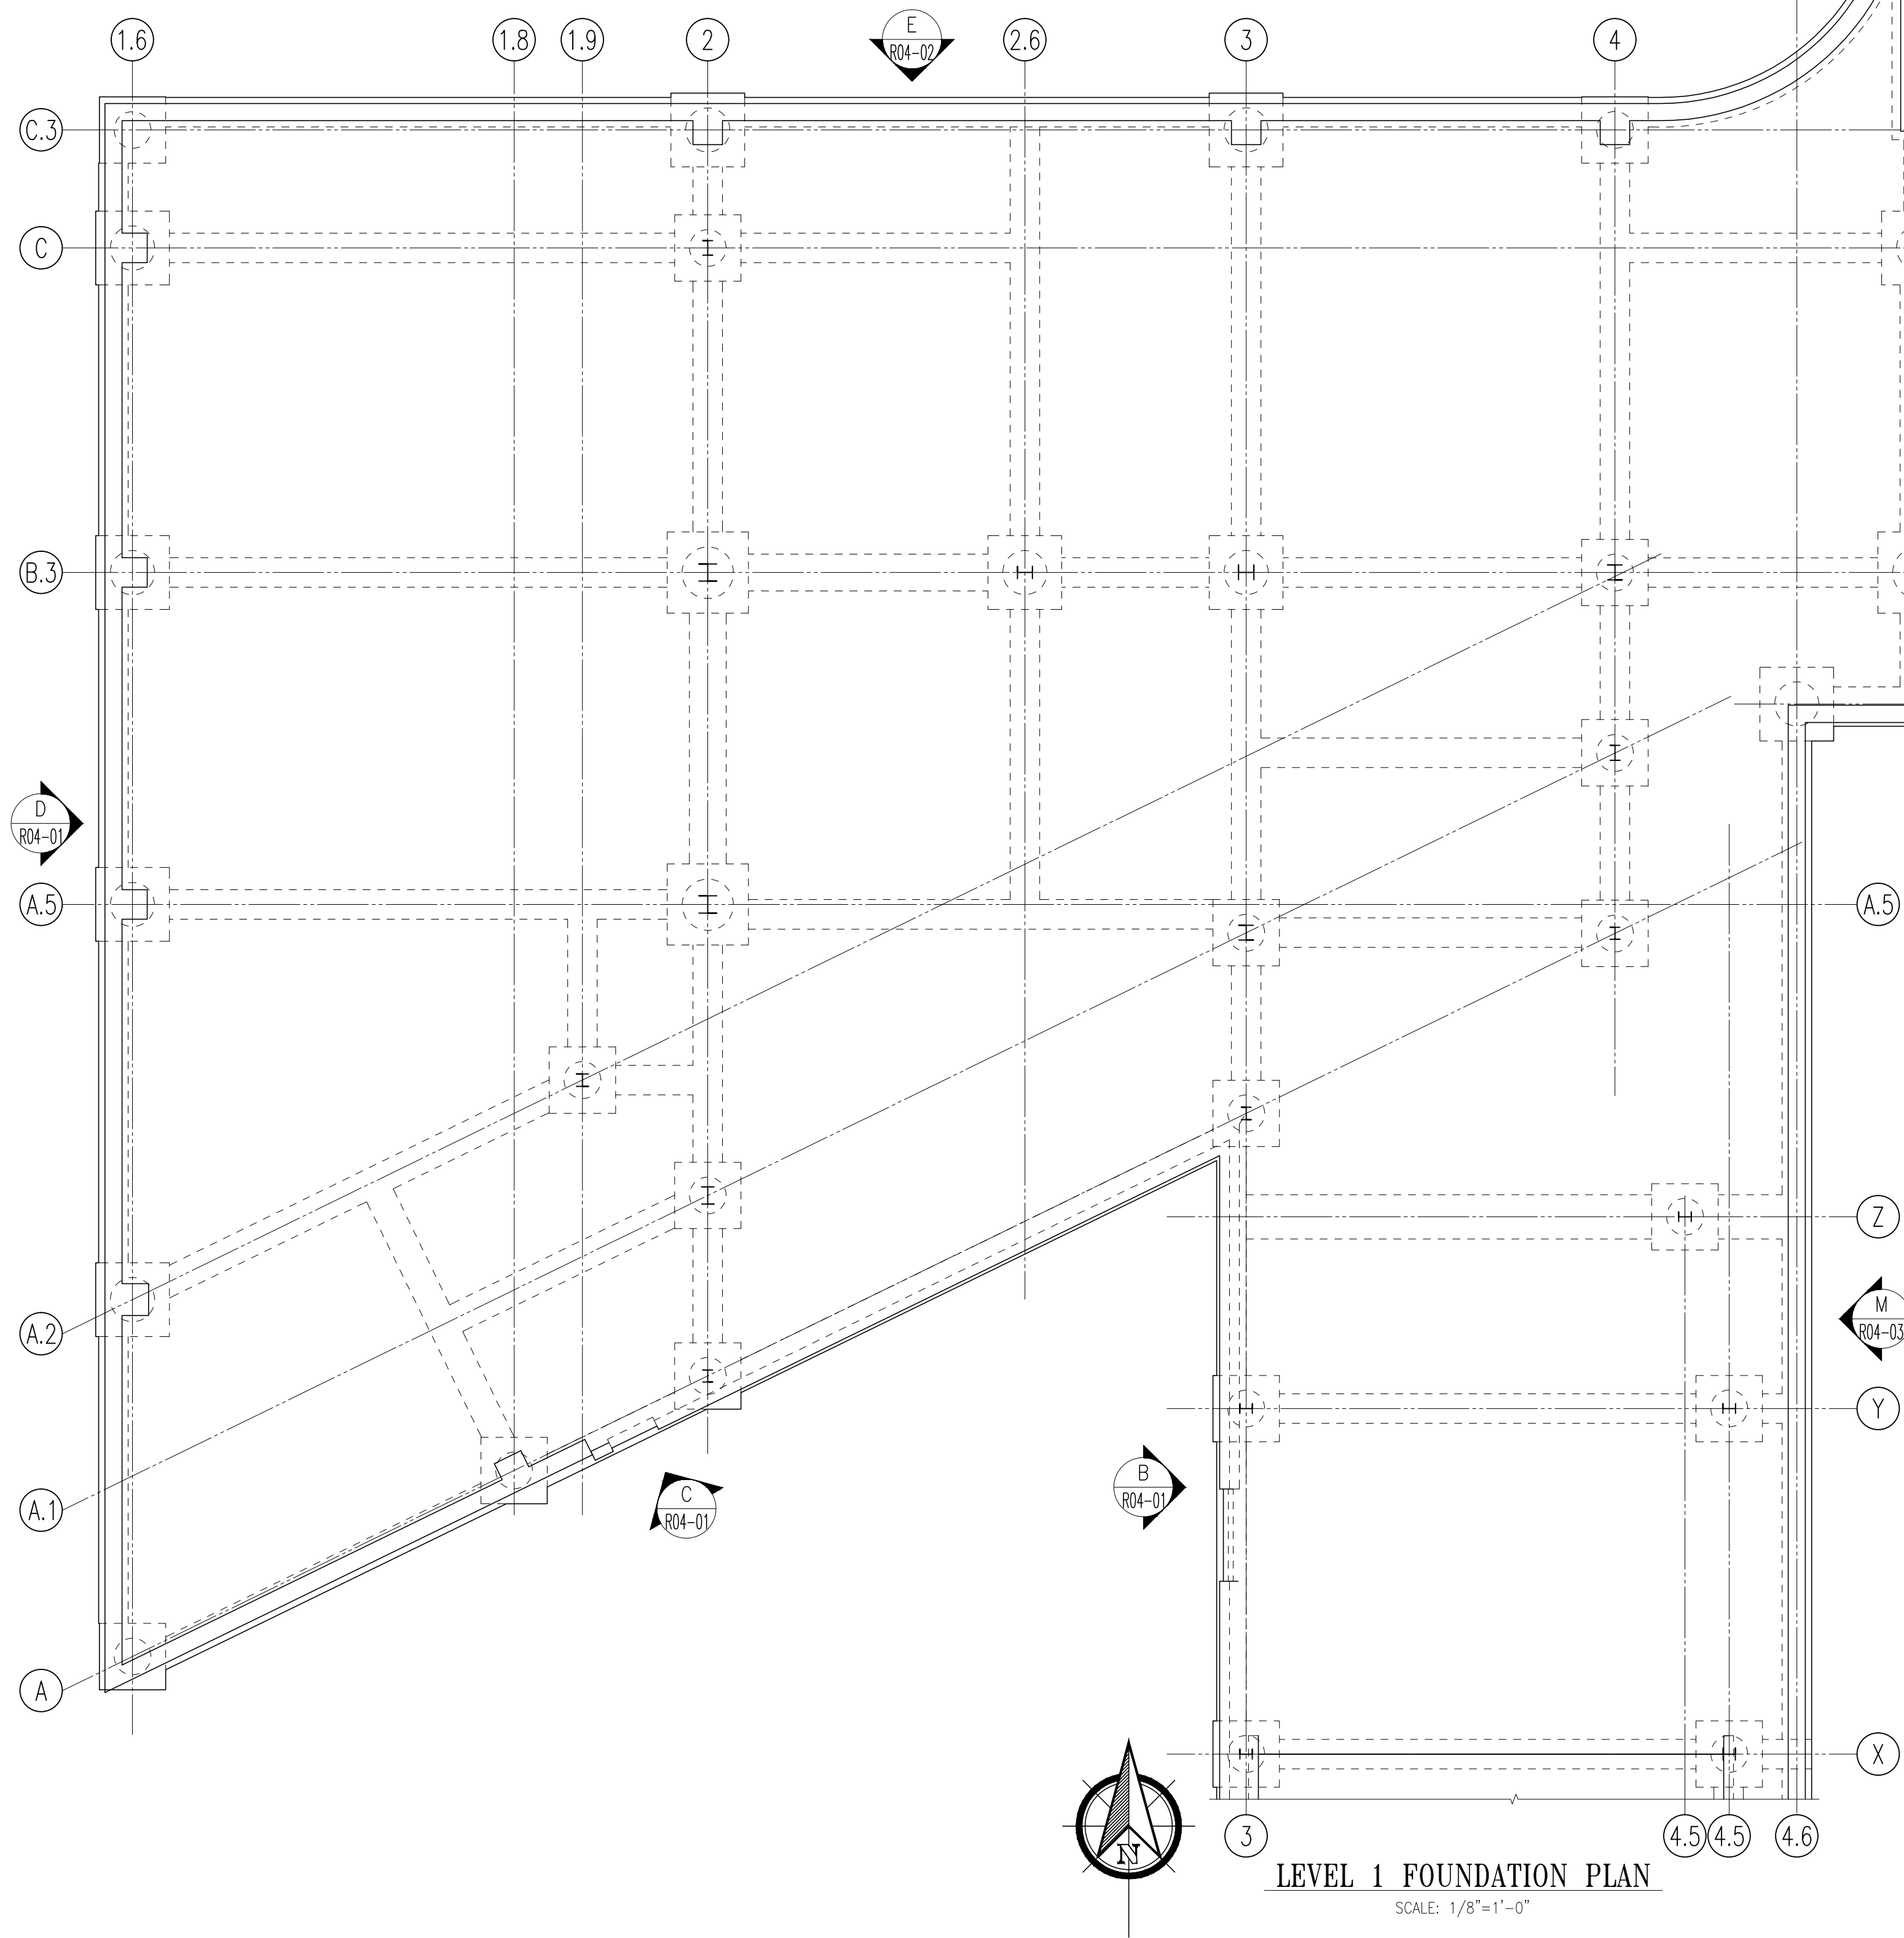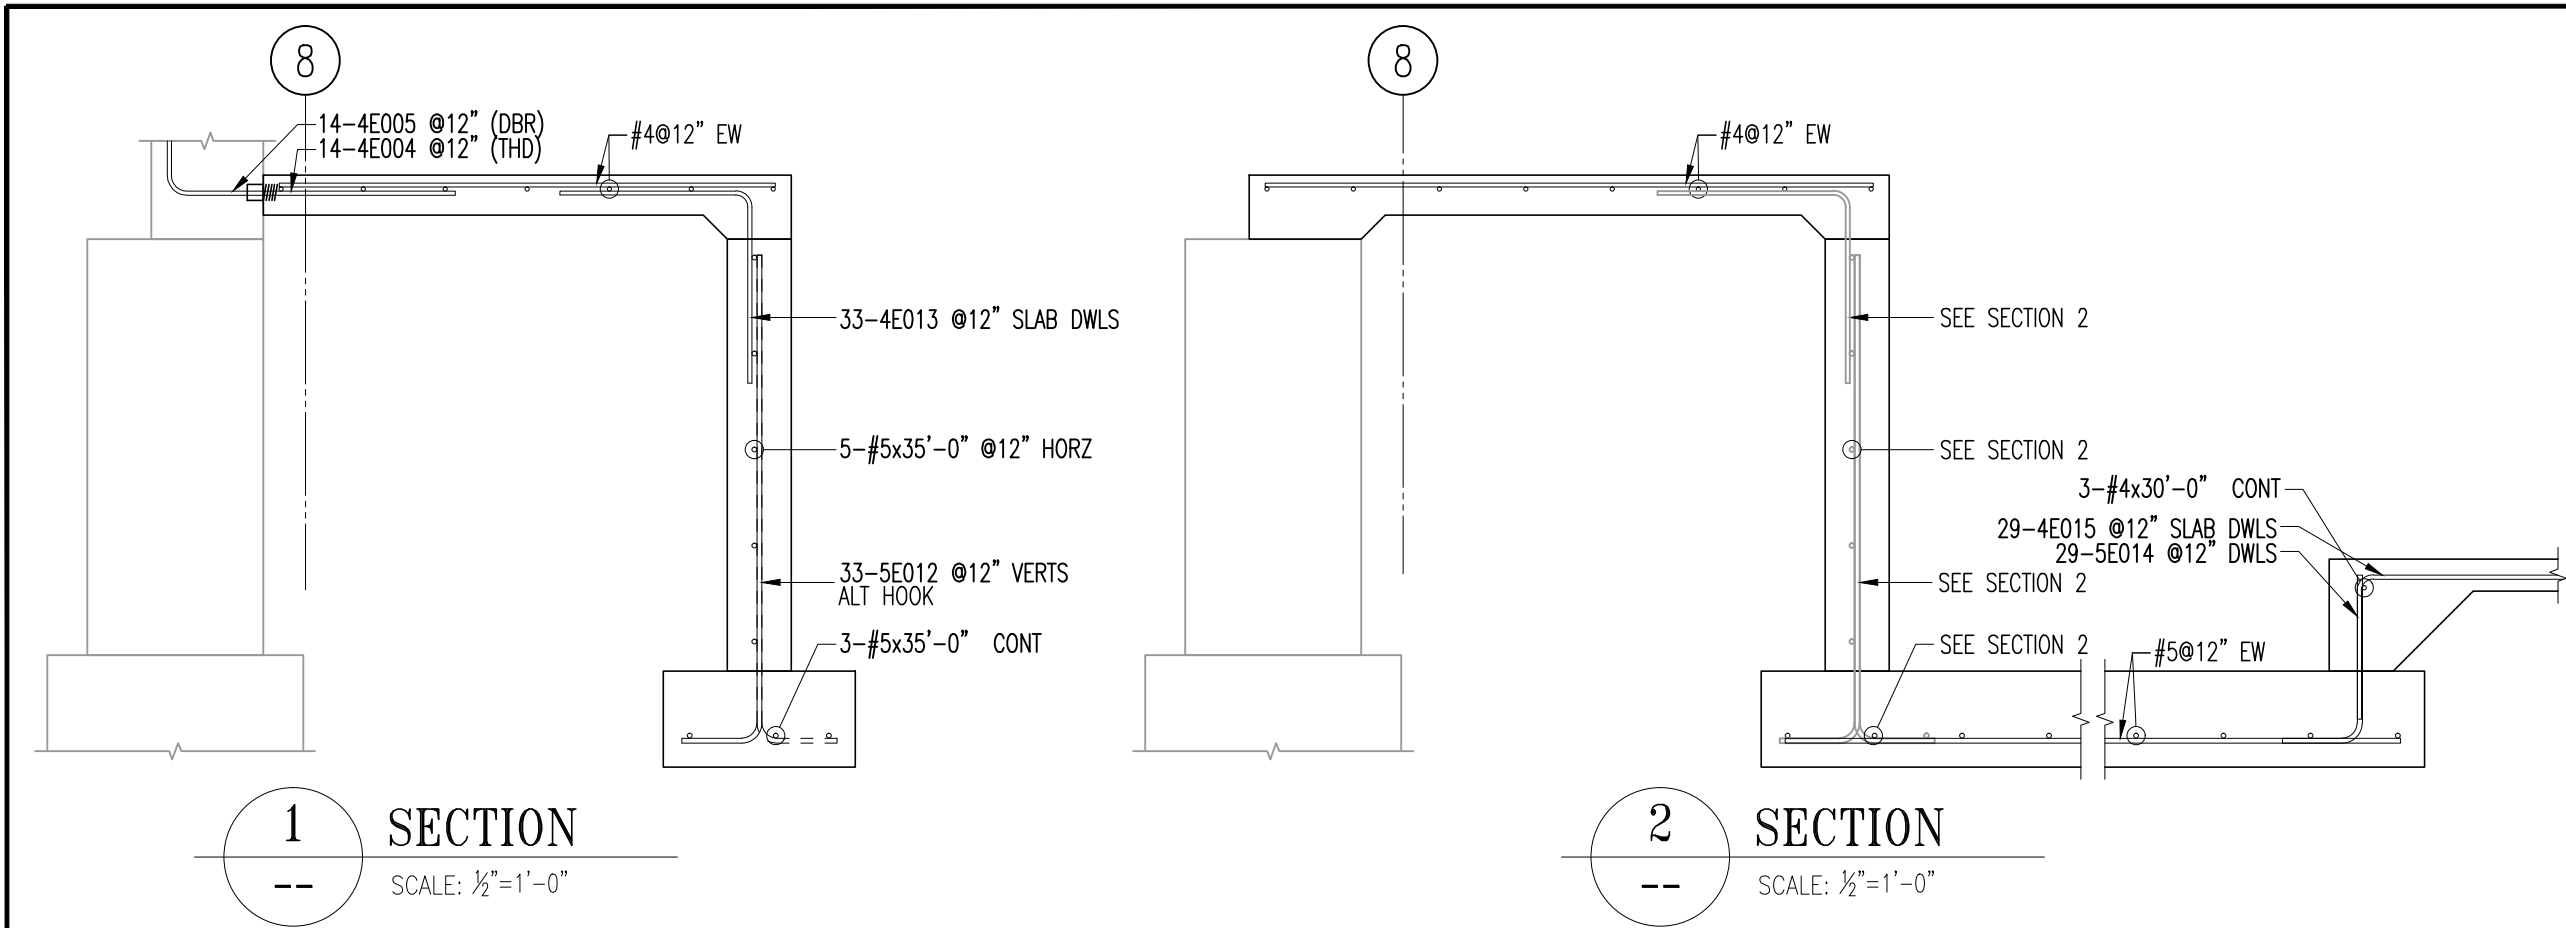


BENDING DETAILS													
Bar Mark	Size	Total Length	Type	X	Y	Z	W	V	U	T	S	R	Q
5E012	#5	5'-11"	2	0'-10"	1'-3"								
5E014	#5	2'-2"	2	0'-10"	1'-3"								
4E004	#4	2'-2" (H2)			2'-2"								
4E005	#4	3'-0" (H3)		1'-0"	2'-0"								
4E013	#4	4'-0"	17		2'-0"								
4E015	#4	4'-0"	17		1'-0"	3'-0"							

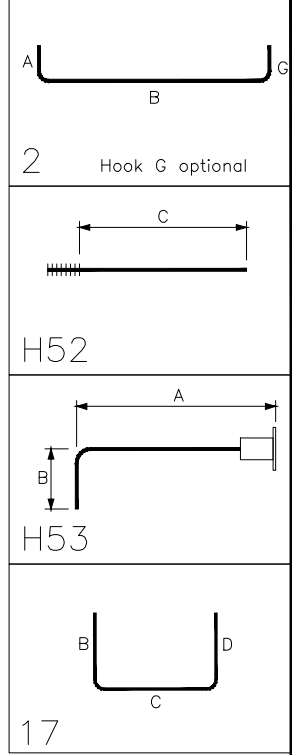


Revisions and Issue Record			
No.	Description	Date	By
0	FOR APPROVAL	05/20/16	JLH
The full intent and purpose of this drawing is the placing of reinforcing steel bars ONLY. It is NOT to be used as a means of communication between the Architect, Engineer, Contractor or any other Sub-trades.			
THIS DRAWING IS NOT TO BE SCALED.			
ST. LOUIS, MO.			
DAVID MASON & ASSOCIATES, INC.			
Project: WEBSTER ISB PHASE 1			
Drawing: SOG PLAN SECTIONS & DETAILS			
Customer: KCI CONSTRUCTION			
Engineer: DAVID MASON & ASSOCIATES, INC.			
Date	Drawn	Chkd.	JOB No.
05/20/16	JLH		00916023
			Dwg. No.
			R04-00


Drawing Sheet : R04-01										BENDING DETAILS									
Bar Mark	Size	Total Length	Type	X	Y	C	D	E	F	G	H	I	J	K	L	M	N	O	P
52008	#5	2'-0"	H3			2'-0"													
52007	#5	3'-0"	H3	1'-0"	2'-0"														
52008	#5	5'-0"	17		2'-0"	3'-0"													
52041	#5	5'-0"	13		2'-0"	2'-0"													
42003	#4	5'-0"	17		2'-0"	3'-0"													

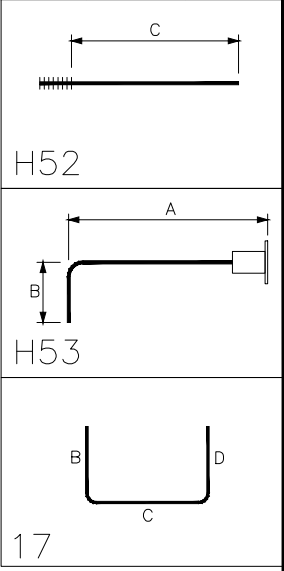


2x150-52041 @12" CB EF

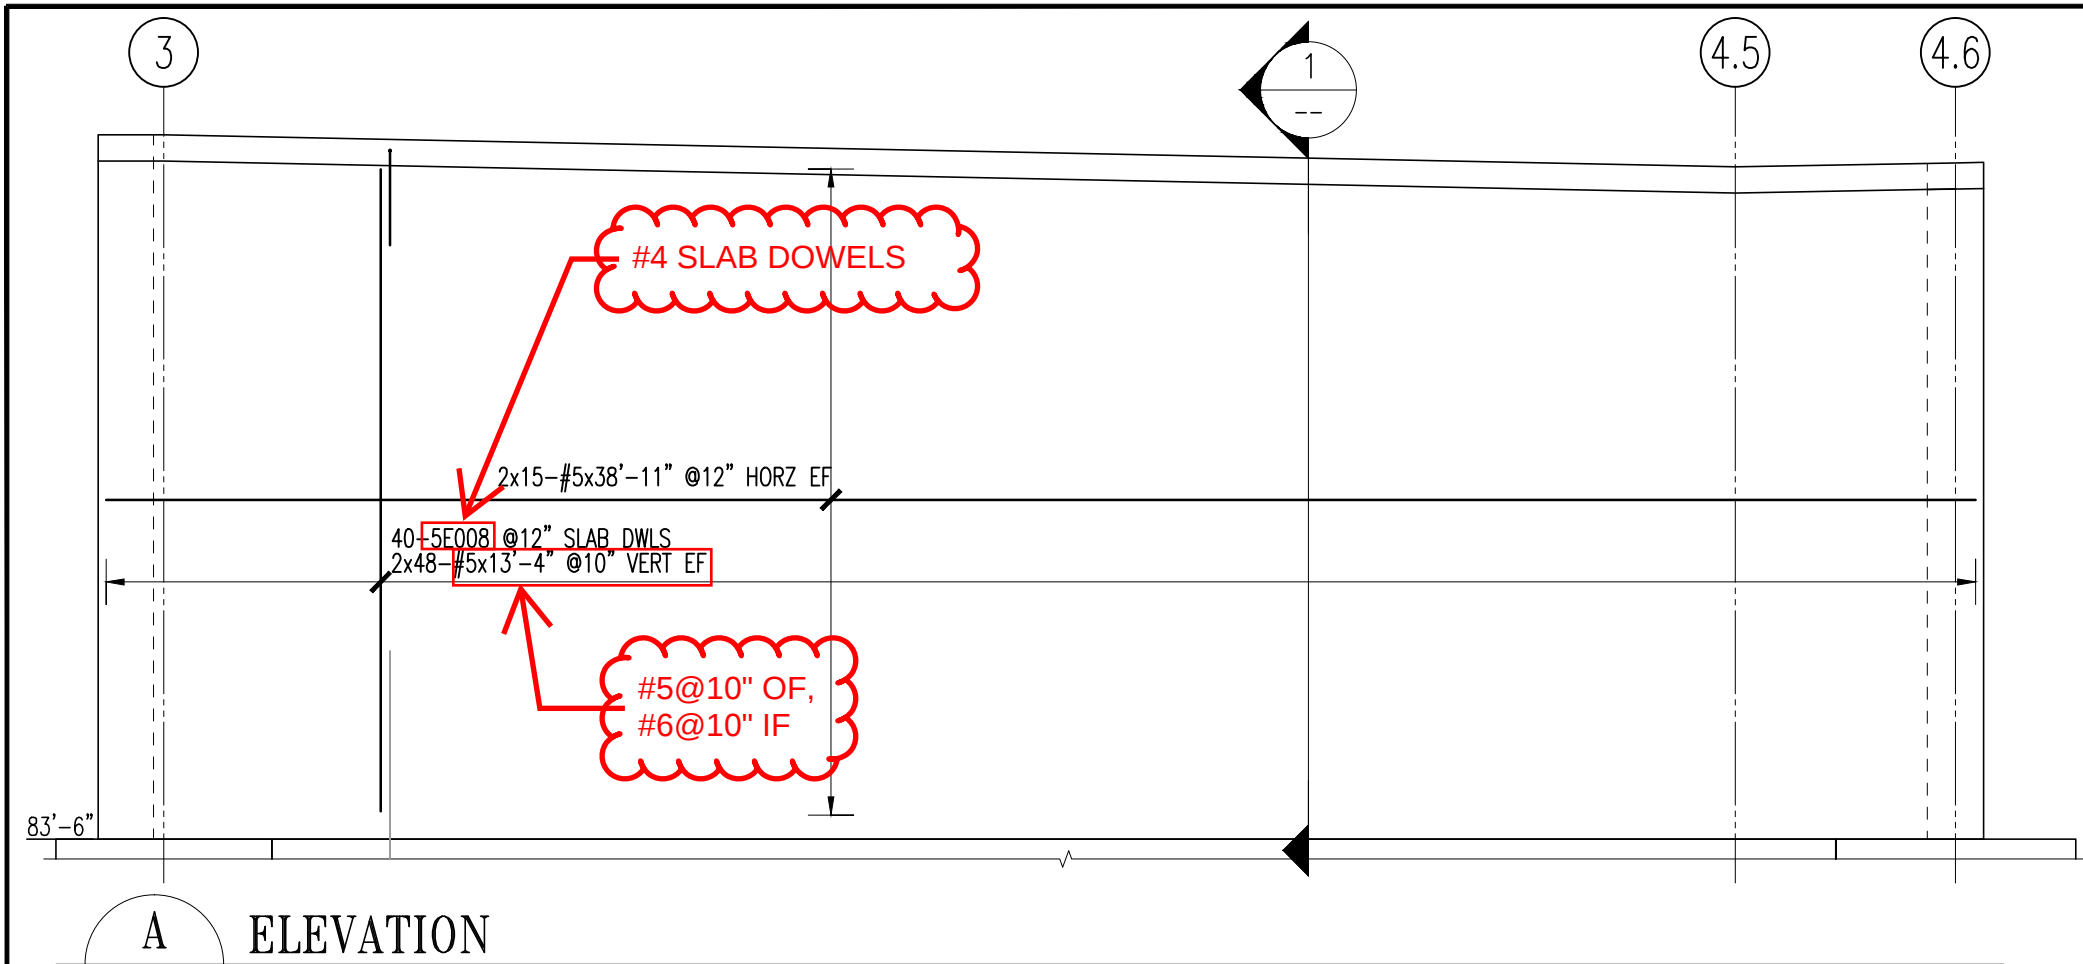


A ELEVATION
SCALE: 1/4"=1'-0"

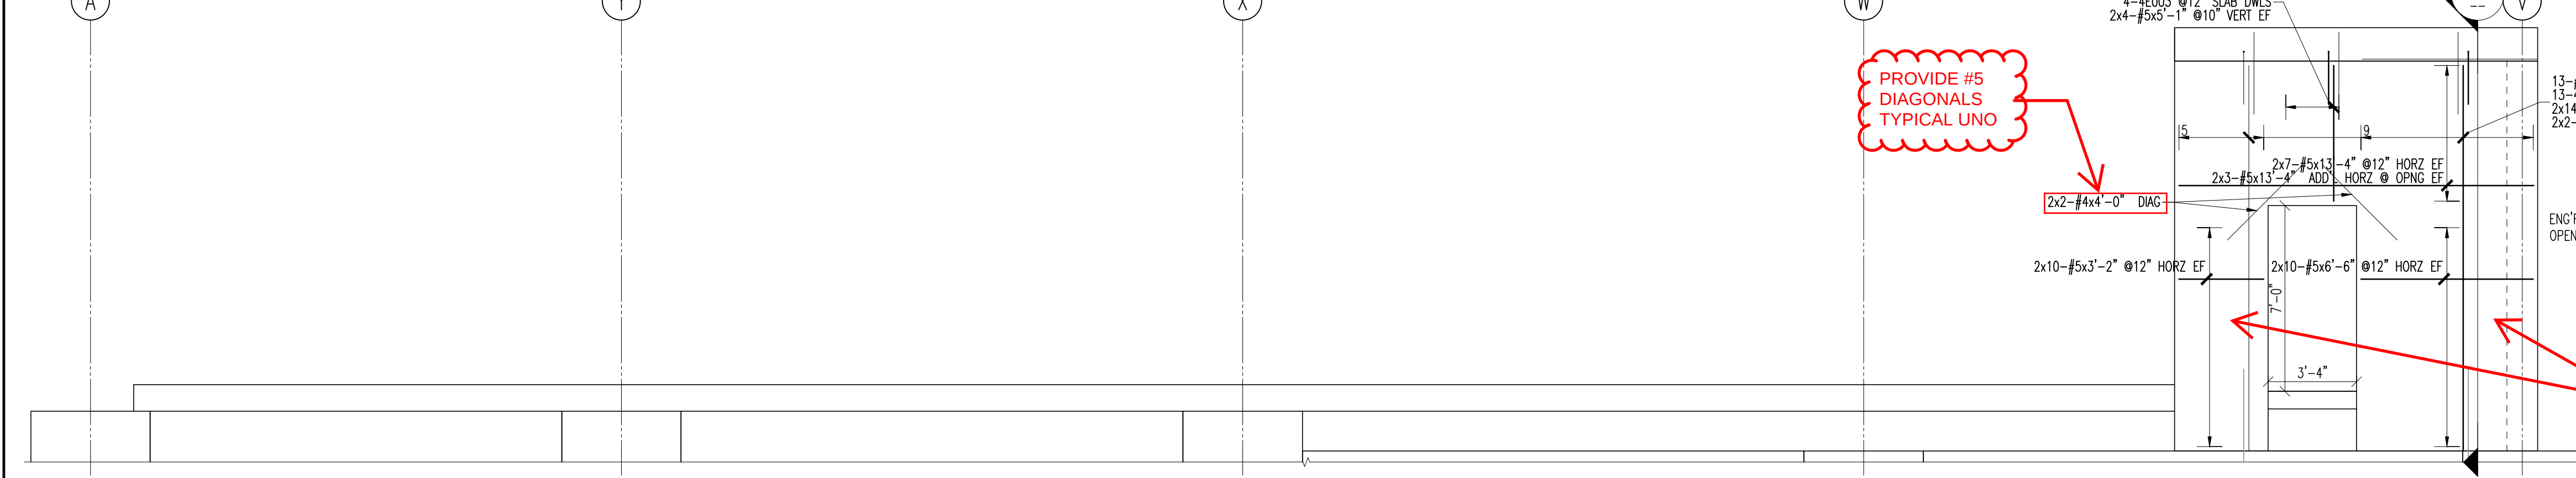


B ELEVATION
SCALE: 1/4"=1'-0"

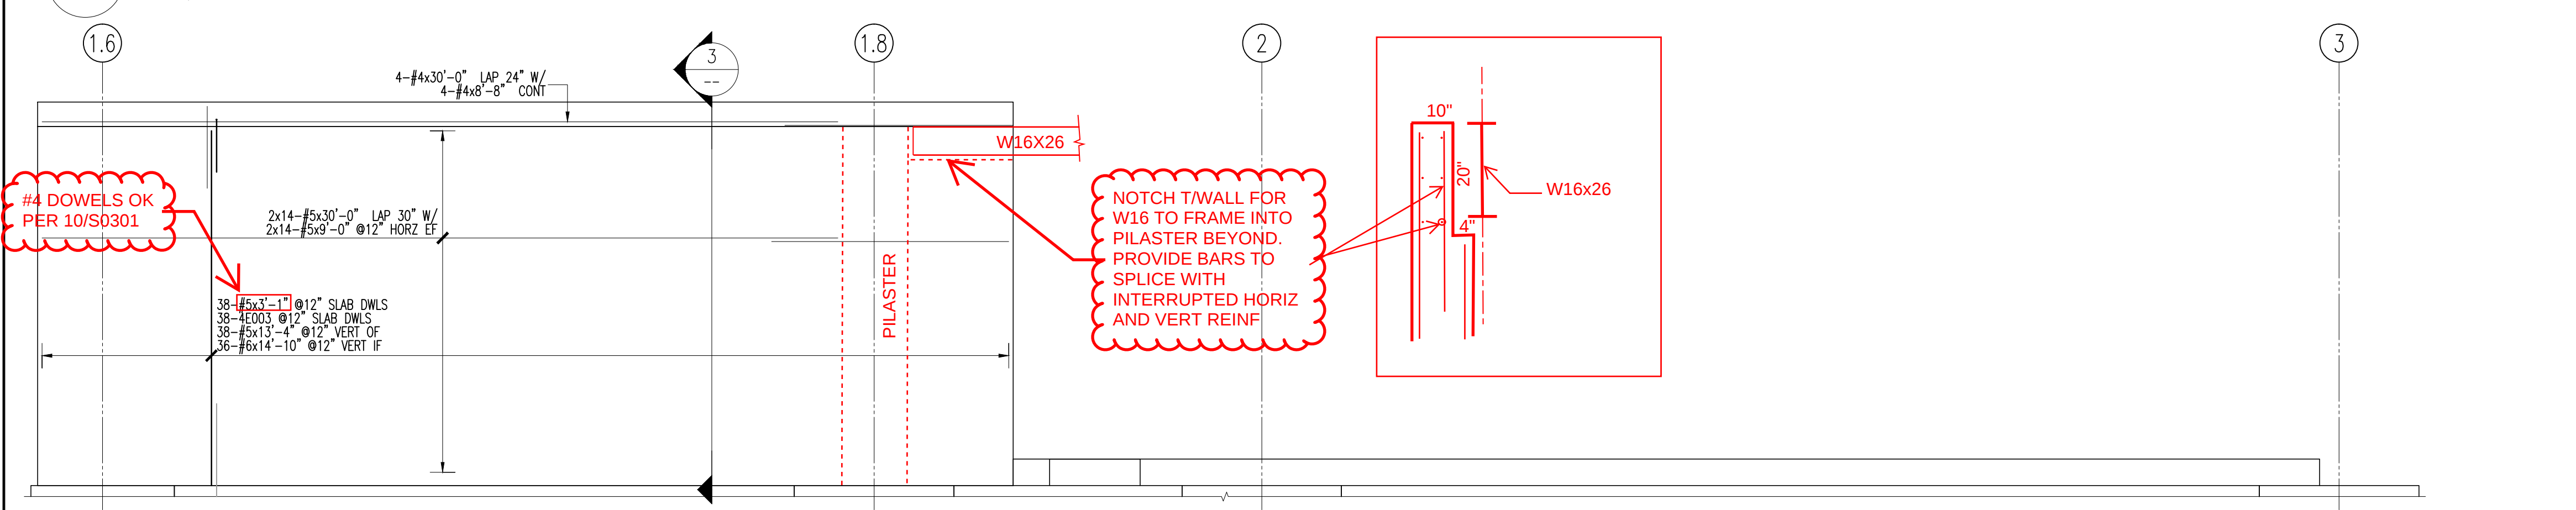

C ELEVATION
SCALE: 1/4"=1'-0"

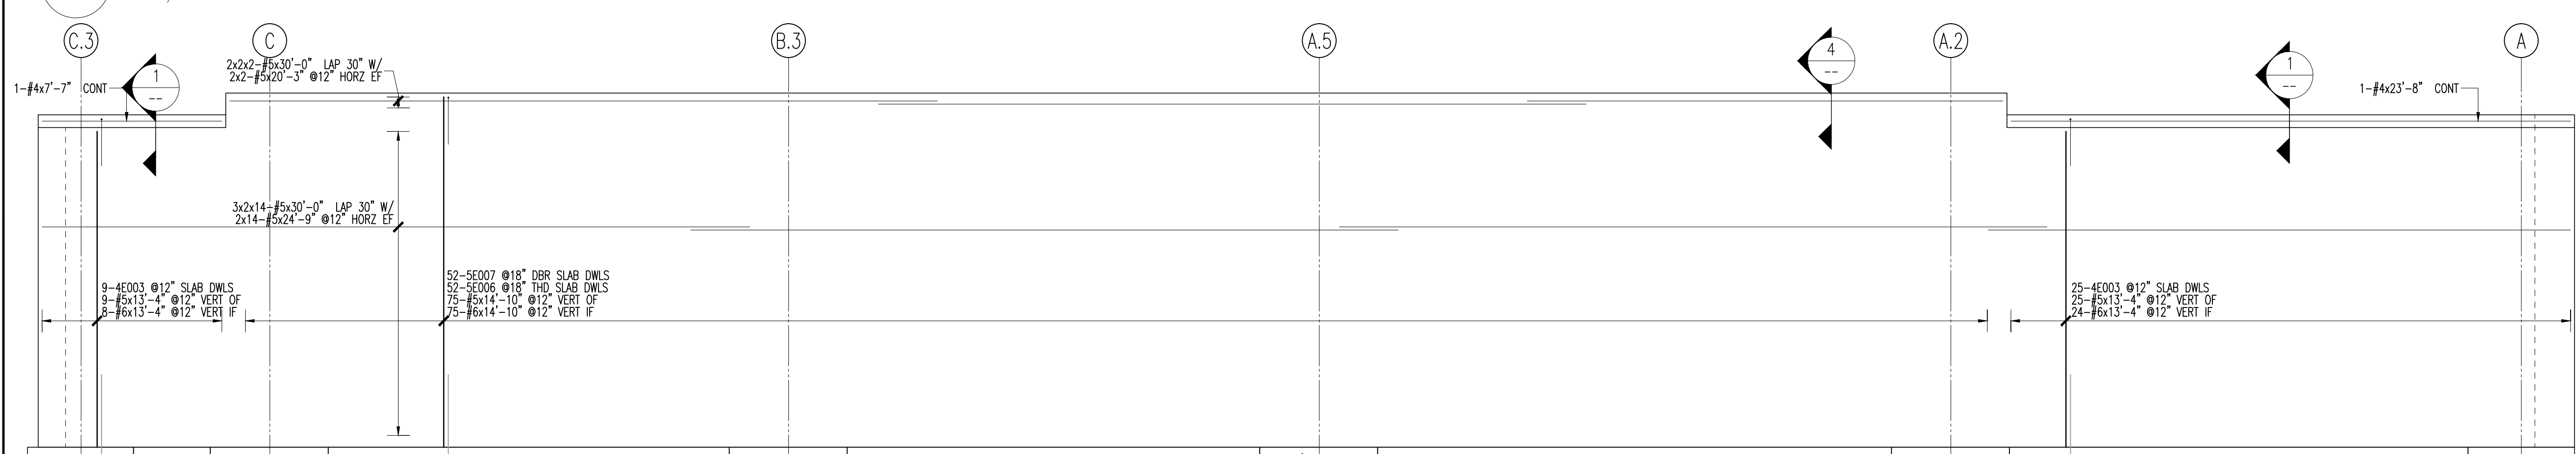

D ELEVATION
SCALE: 1/4"=1'-0"

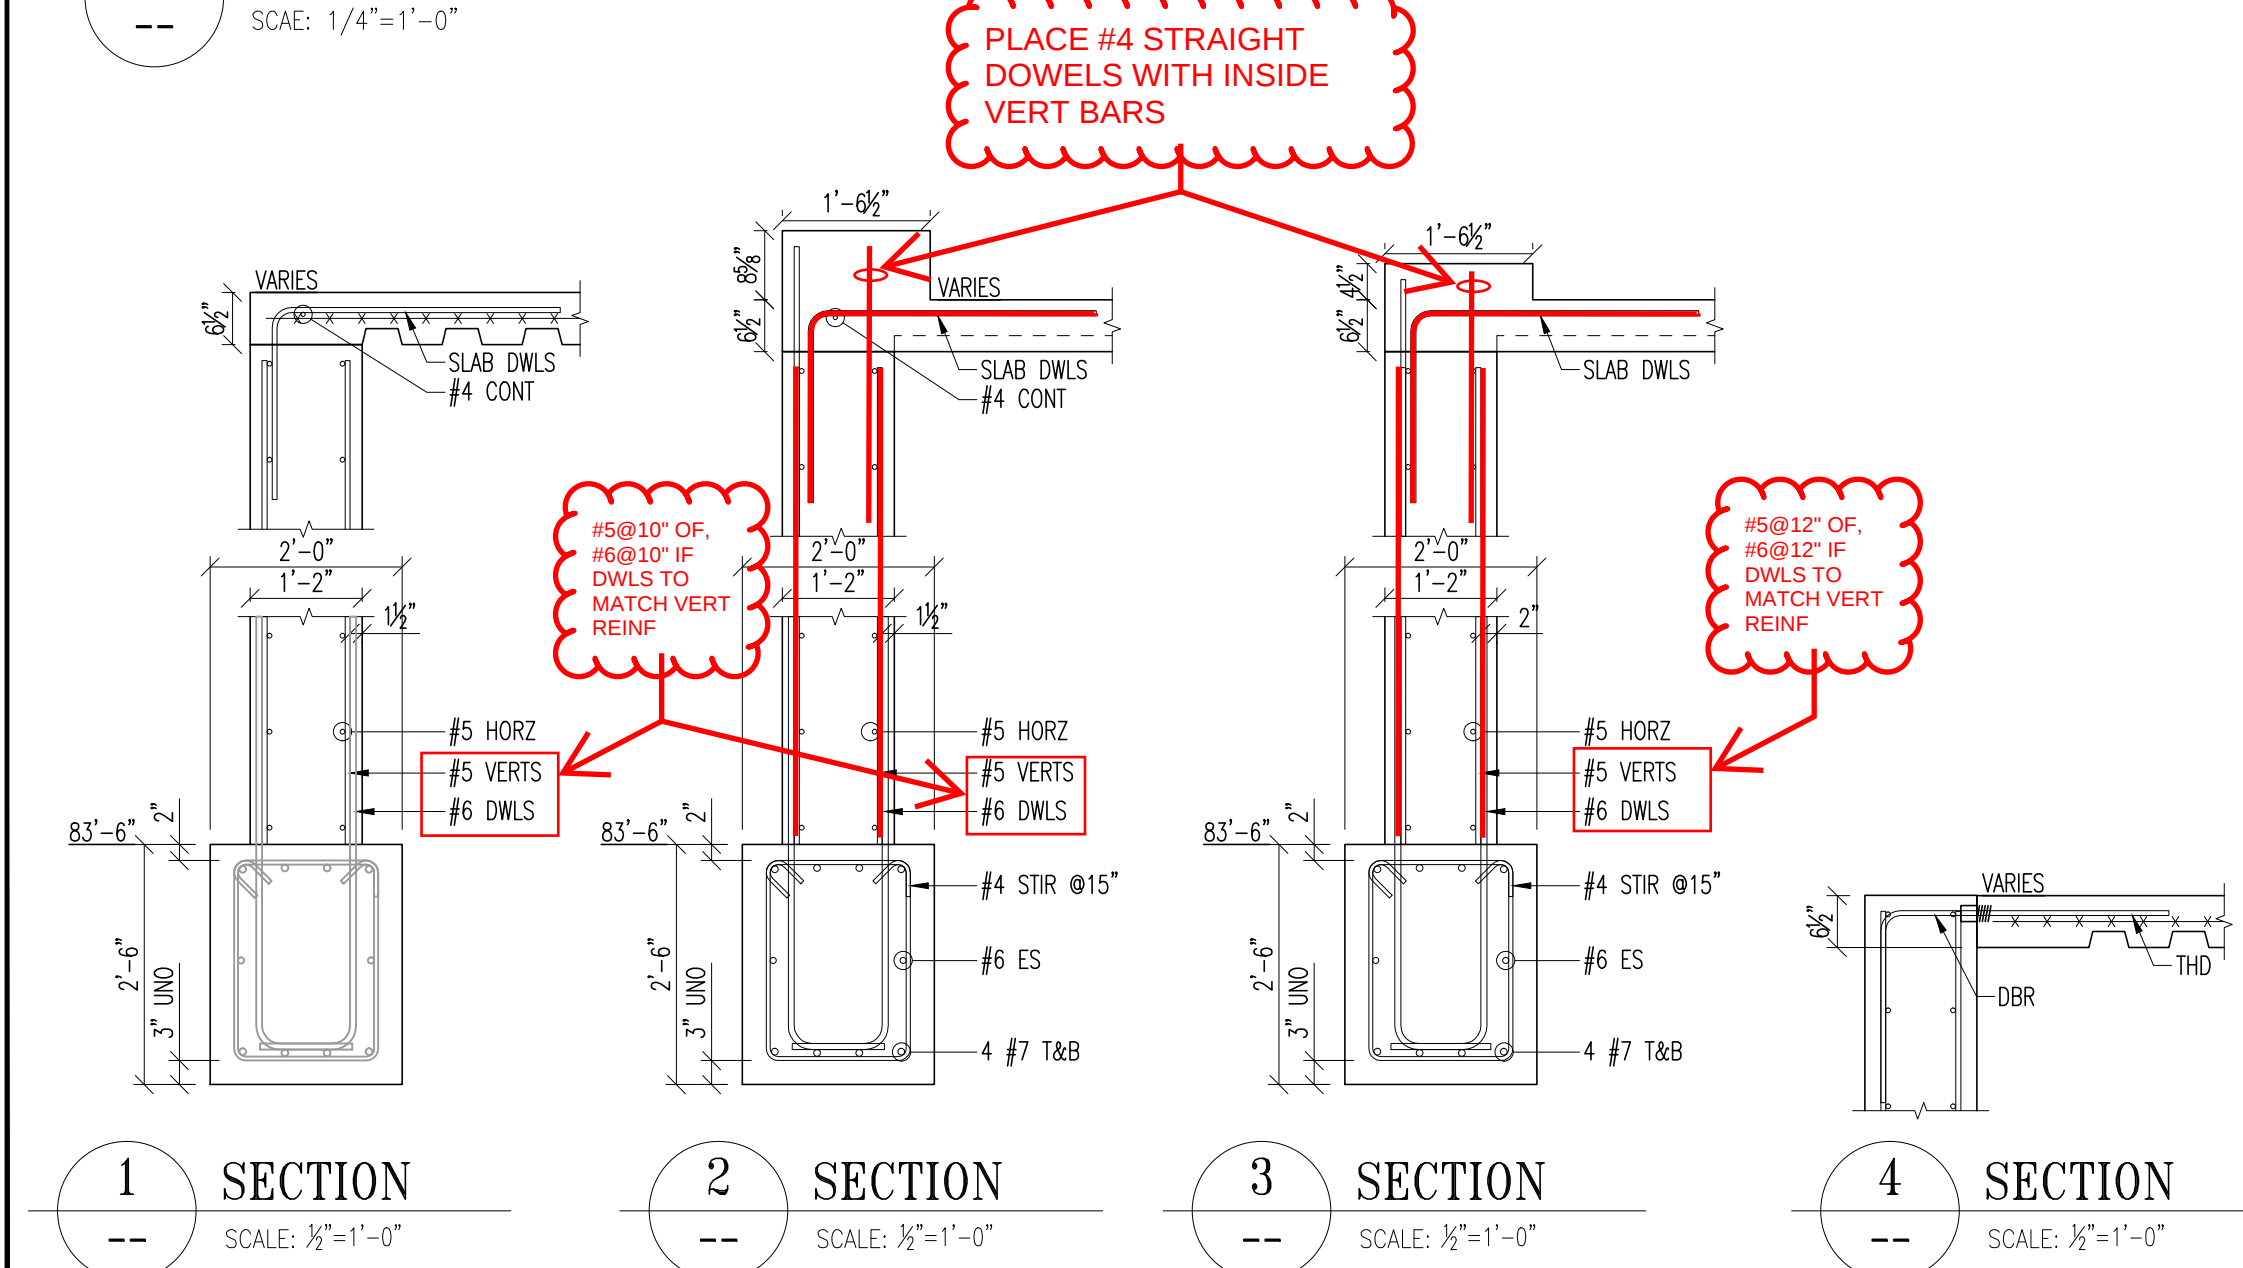

1 SECTION
SCALE: 3/8"=1'-0"

2 SECTION
SCALE: 3/8"=1'-0"





3 SECTION
SCALE: 3/8"=1'-0"

4 SECTION
SCALE: 3/8"=1'-0"

PROVIDE #5 DIAGONALS TYPICAL UNO

WALL REINF IS #5@10"oc OF #6@10"oc IF REVISE REINF

Revisions and Issue Record			
No.	Description	Date	By
0	FOR APPROVAL	05/20/16	JLH
The full intent and purpose of this drawing is the placing of reinforcing steel bars ONLY. It is NOT to be used as a means of communication between the Architect, Engineer, Contractor or any other Sub-trades.			
THIS DRAWING IS NOT TO BE SCALED.			
ST. LOUIS, MO.			
HarrisRebar Reinforcing Steel National Strength. Local Service.			
Project: WEBSTER ISB PHASE 1			
Drawing: WALL ELEVATIONS & SECTIONS			
Customer: KCI CONSTRUCTION			
Engineer: DAVID MASON & ASSOCIATES, INC.			
Date	Drawn	Chkd.	JOB No.
05/20/16	JLH		00916023
			Dwg. No.
			R04-01

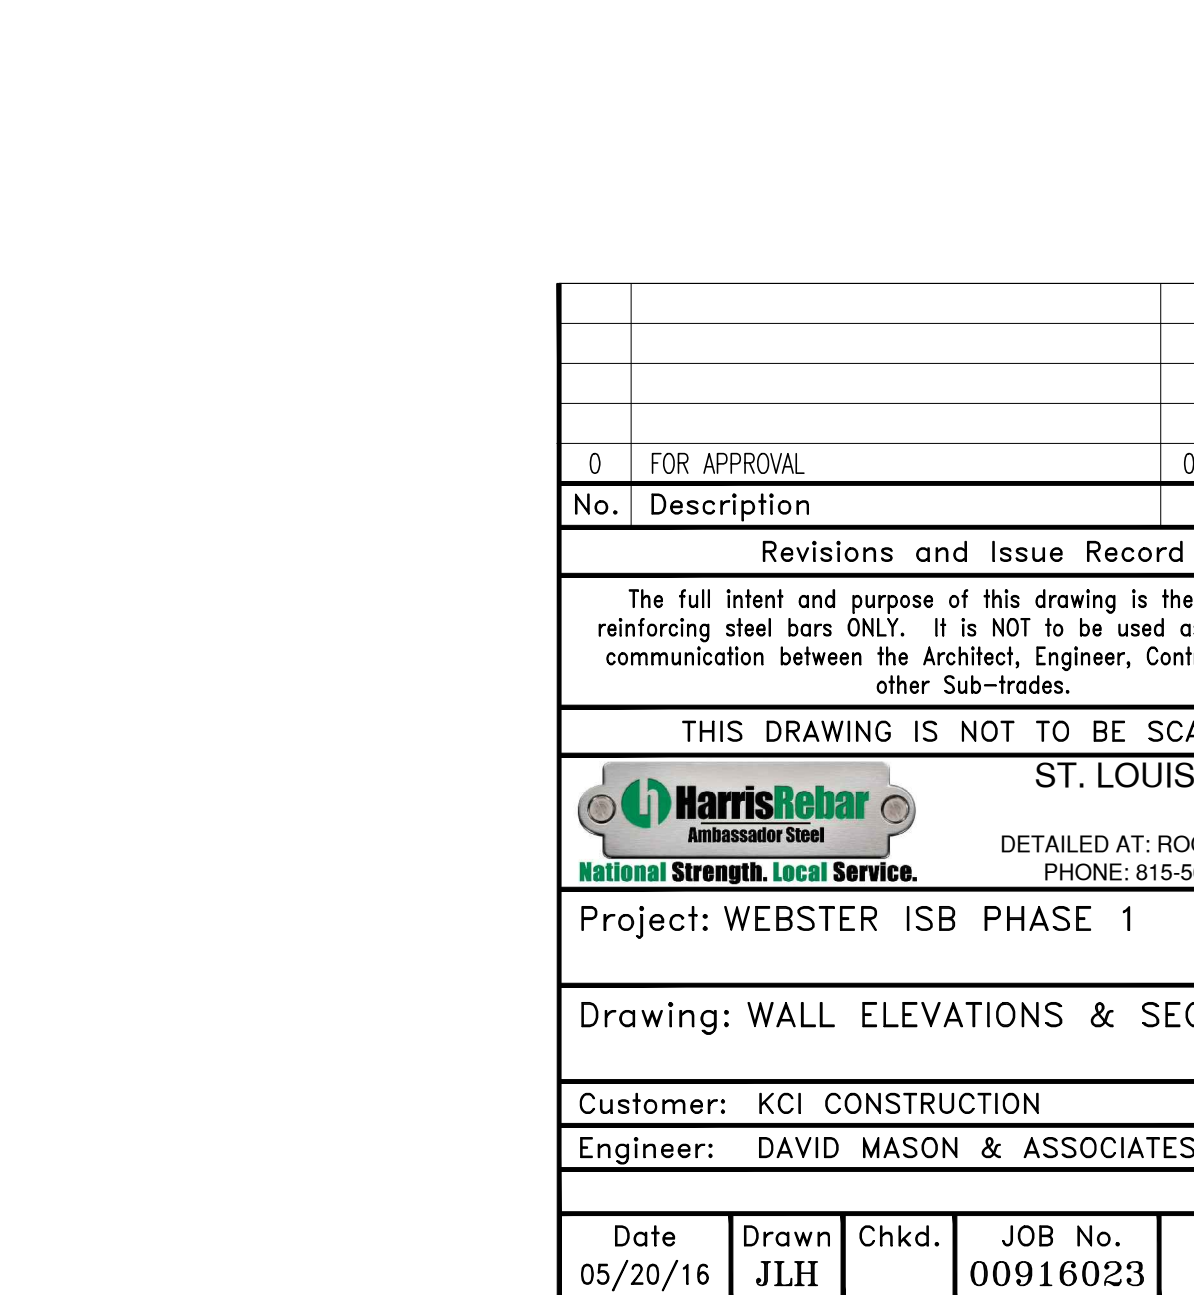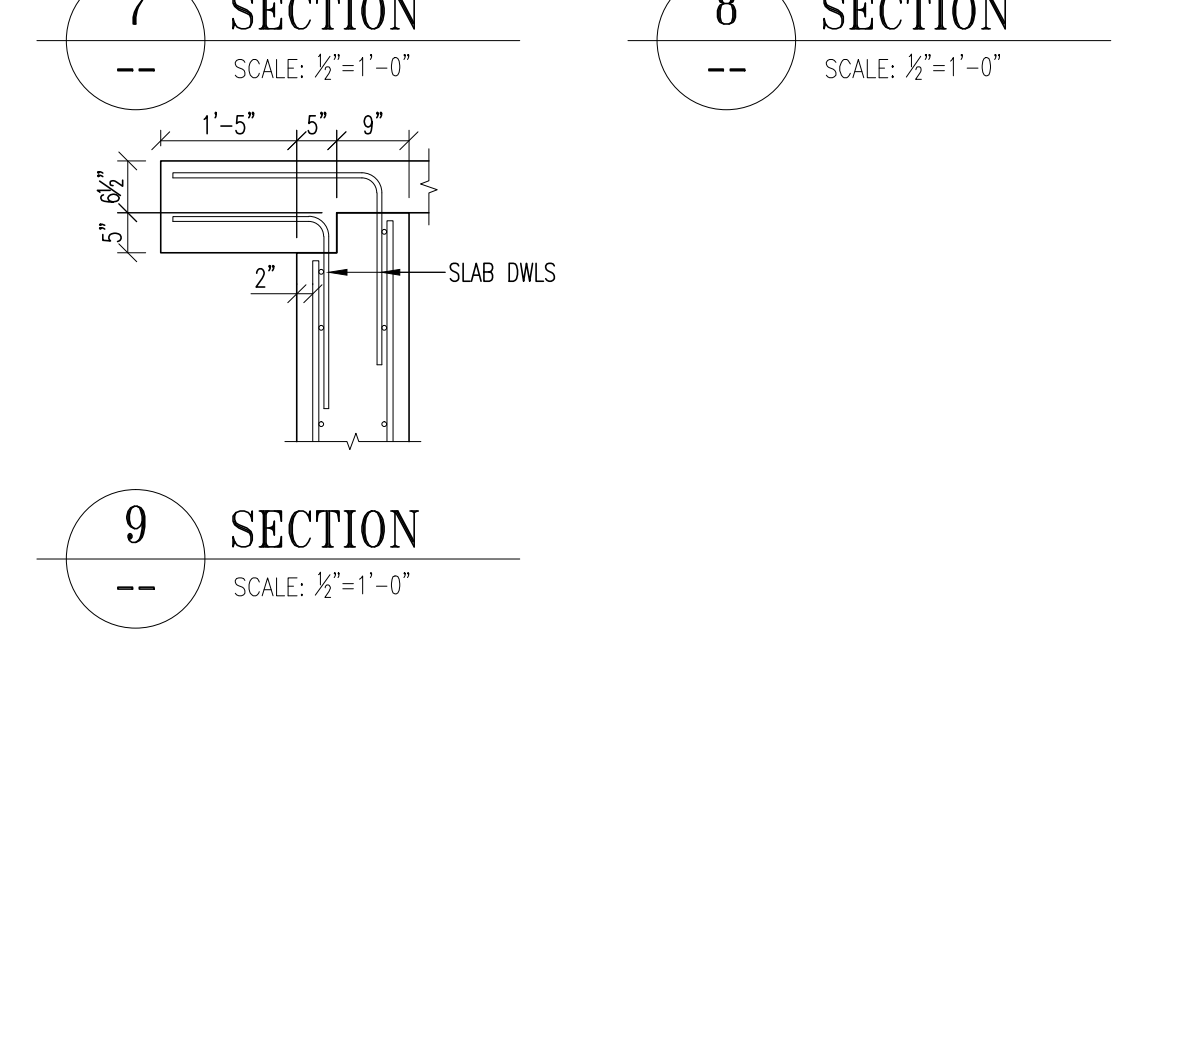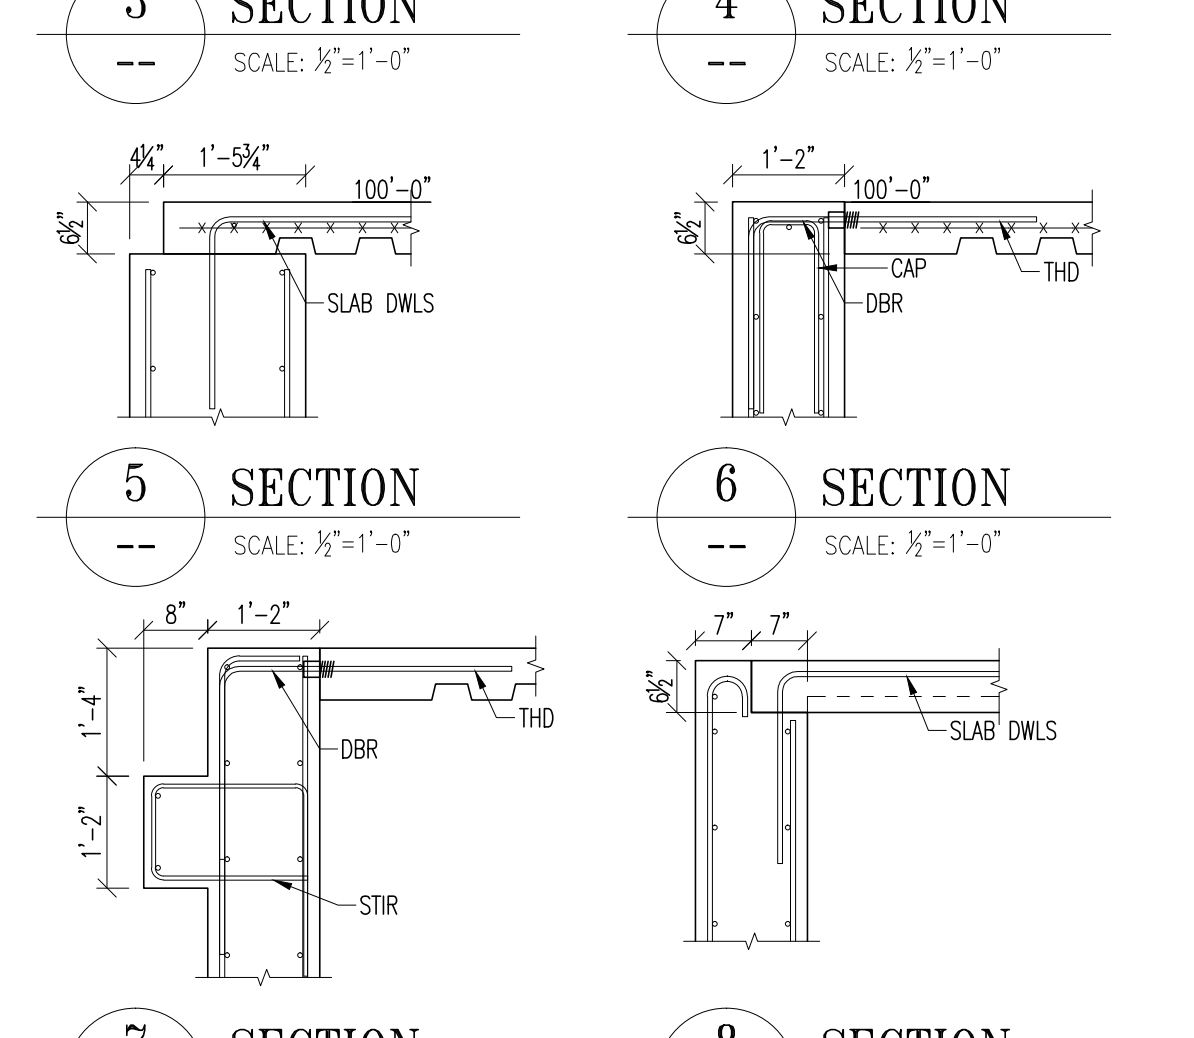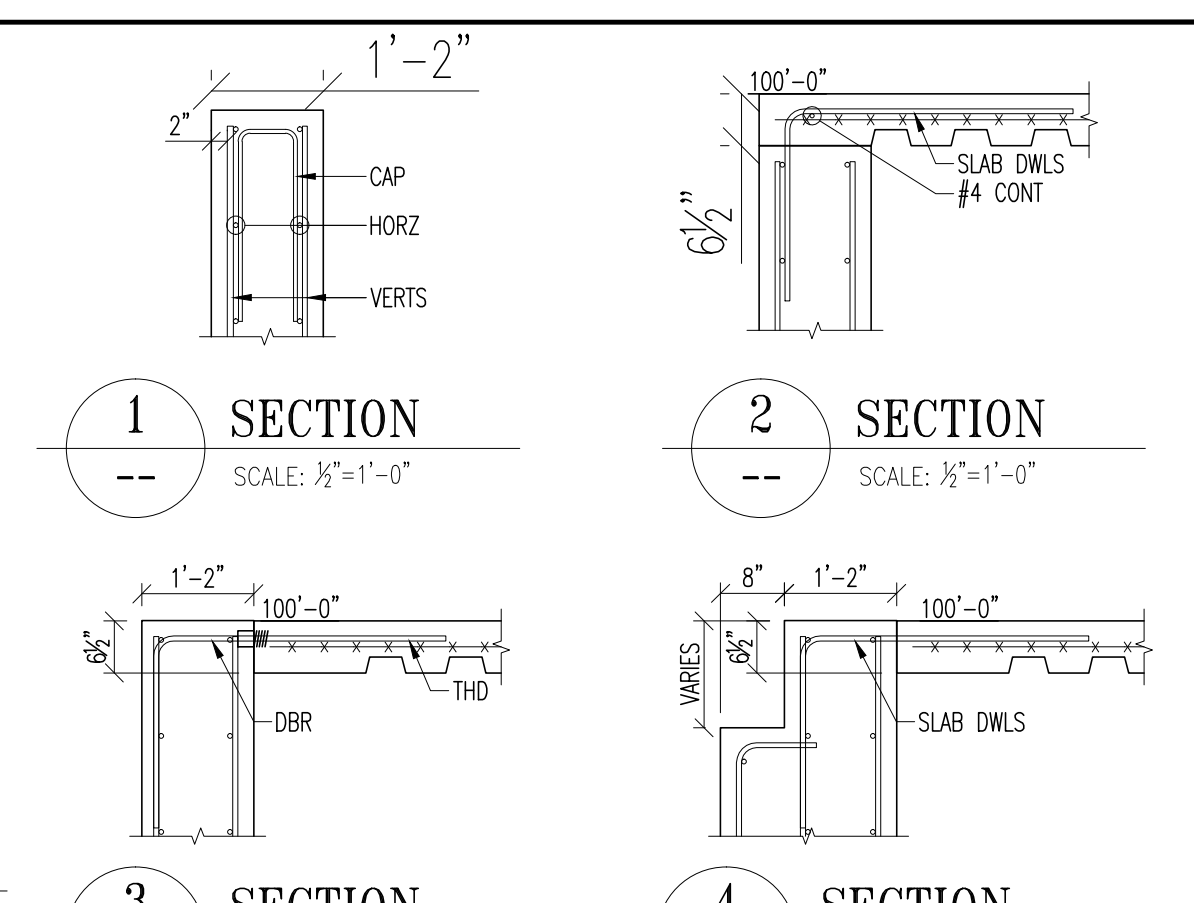[illegible]



 H52





 H53




 17

0	FOR APPROVAL			05/20/16	JLH
No.	Description			Date	By
Revisions and Issue Record					
The full intent and purpose of this drawing is the placing of reinforcing steel bars ONLY. It IS NOT to be used as a means of communication between the Architect, Engineer, Contractor or any other Sub-trades.					
THIS DRAWING IS NOT TO BE SCALED.					
			ST. LOUIS, MO.		
 Anchoring Steel			DETAILED AT : ROCHELLE, IL. PHONE : (815-561-1771)		
National Strength. Local Service.					
Project: WEBSTER ISB PHASE 1					
Drawing: WALL ELEVATIONS & SECTIONS					
Customer: KCI CONSTRUCTION					
Engineer: DARRY MASON & ASSOCIATES, INC.					
					
Date	Drawn	Chkd.	JOB NO.	Dwg. No.	
05/20/16	JLH		09116023	R04-02	

Drawing Sheet : R04-03				BENDING DETAILS												
Bar Mark	Size	Total Length	Type	X	Y	Z	W	V	U	T	S	R	Q	P	O	N
5E008	#5	2'-0"	183													
5E008	#5	5'-0"	17													
5E023	#5	2'-11"	183													
4E024	#6	6'-0"	11													

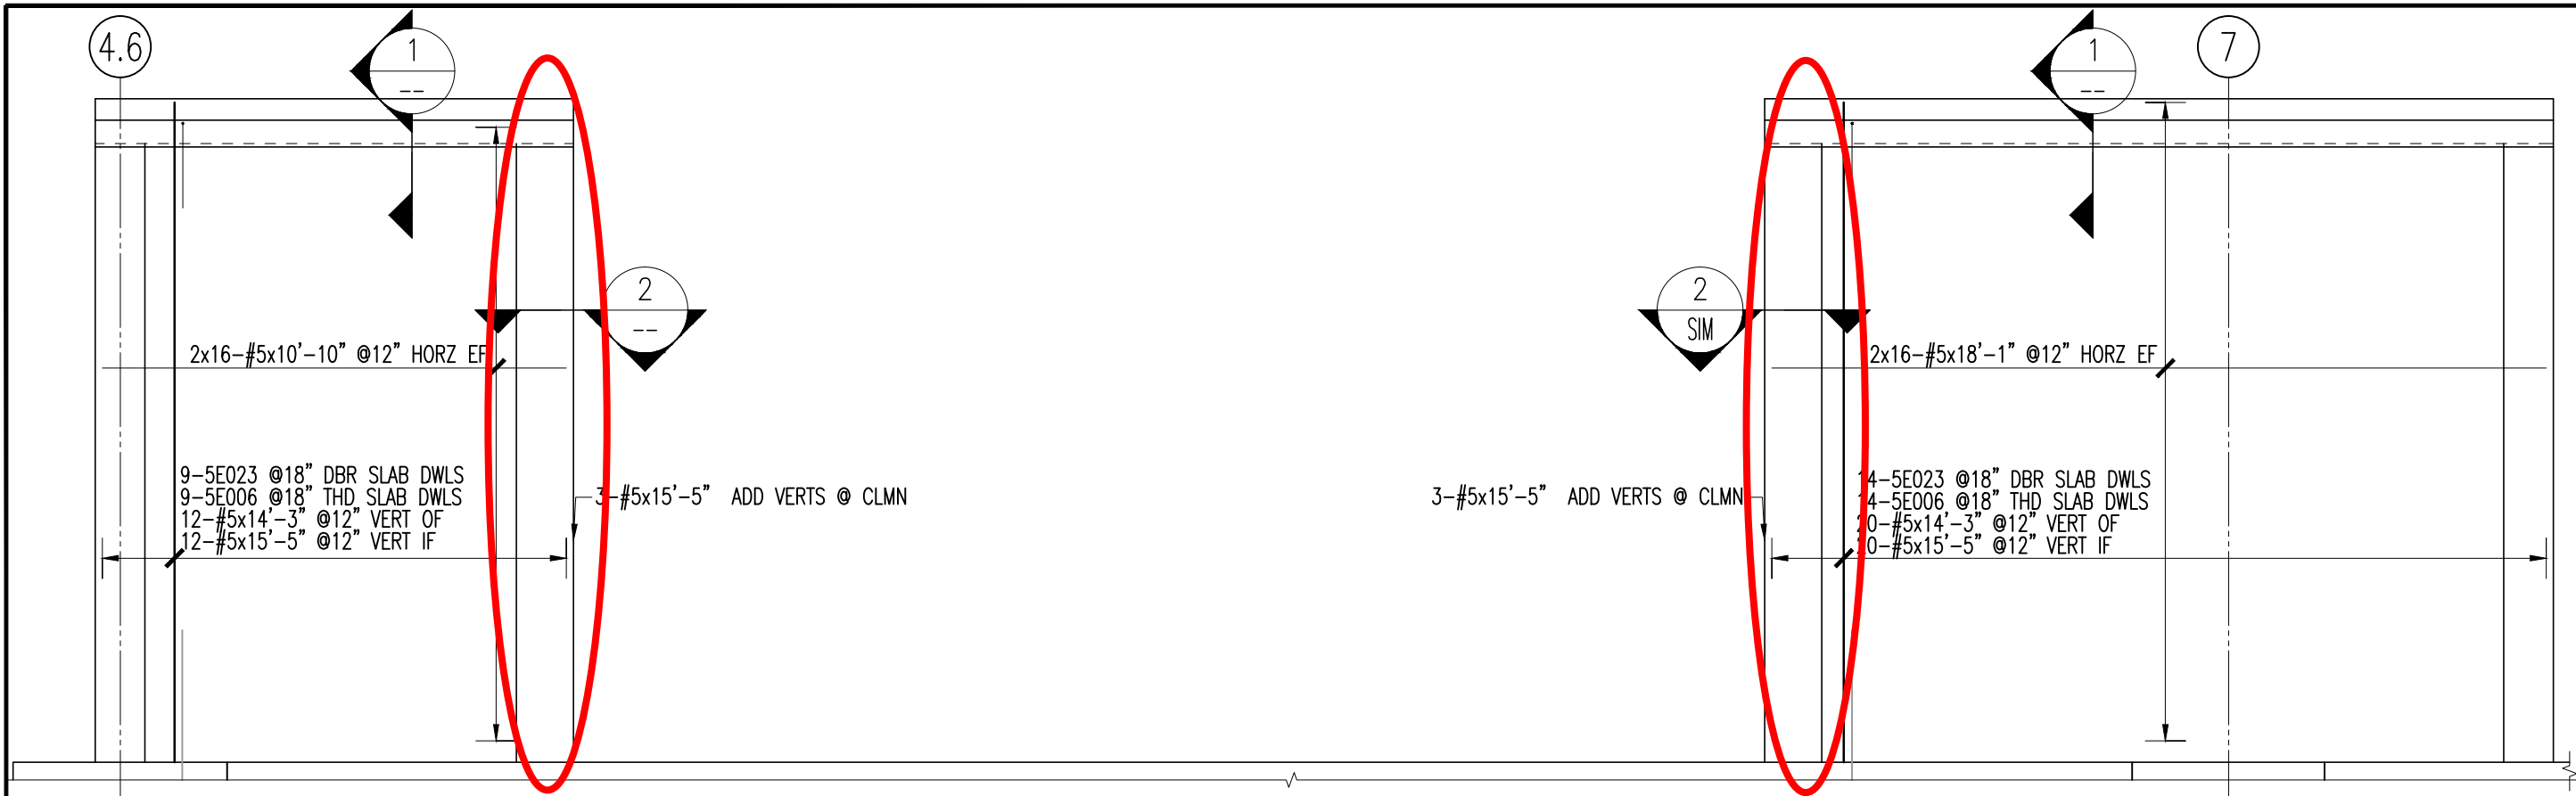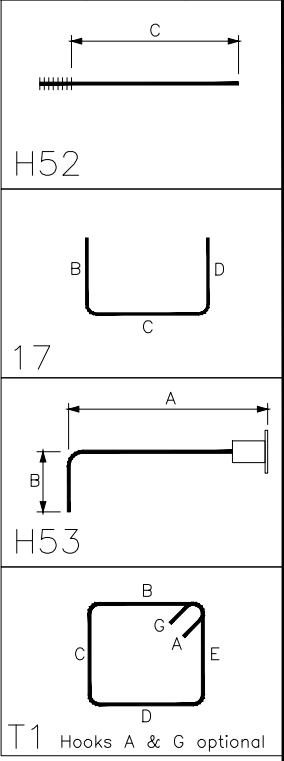


L ELEVATION
SCALE: 1/4"=1'-0"

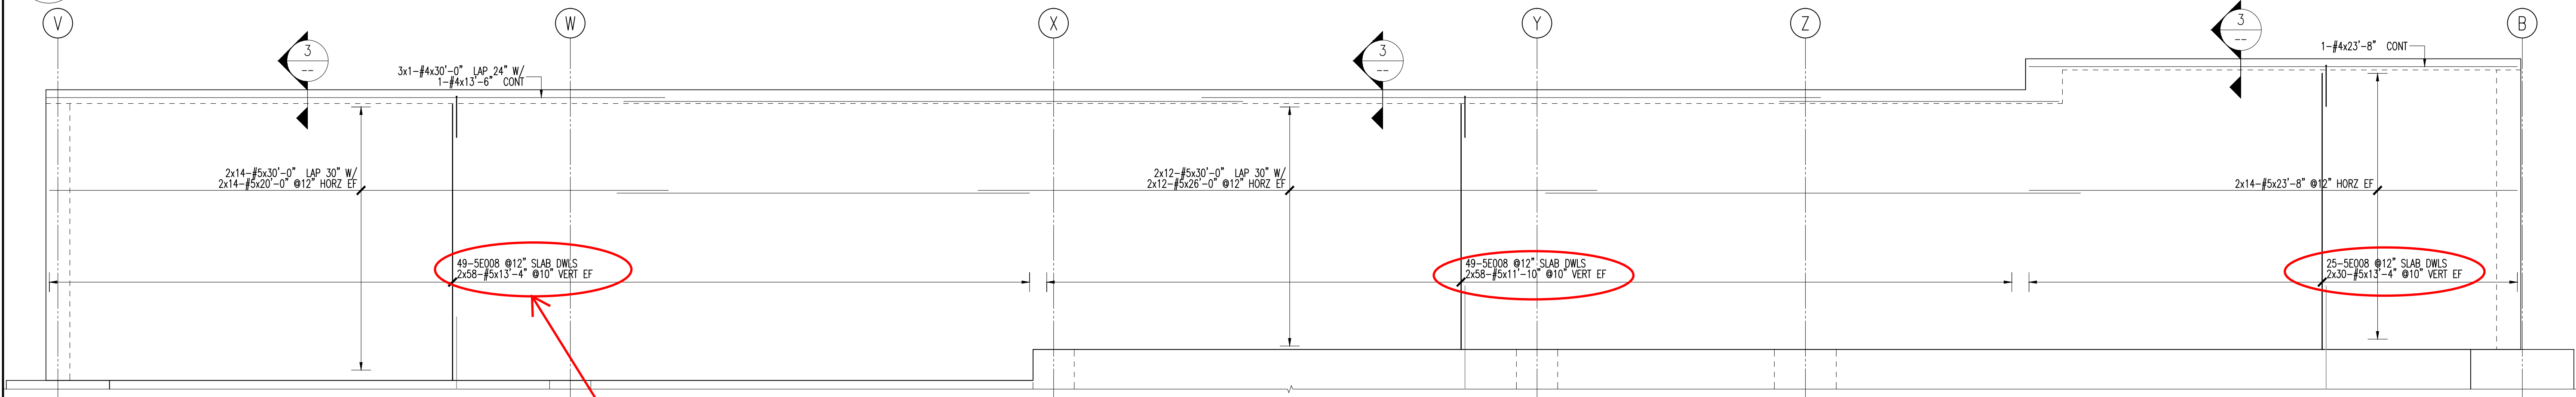

M ELEVATION
SCALE: 1/4"=1'-0"

#4 DWLS @ 12"oc
#5 @ 10"oc OF
#6 @ 10"oc IF
REVISE WALL
TYPICAL

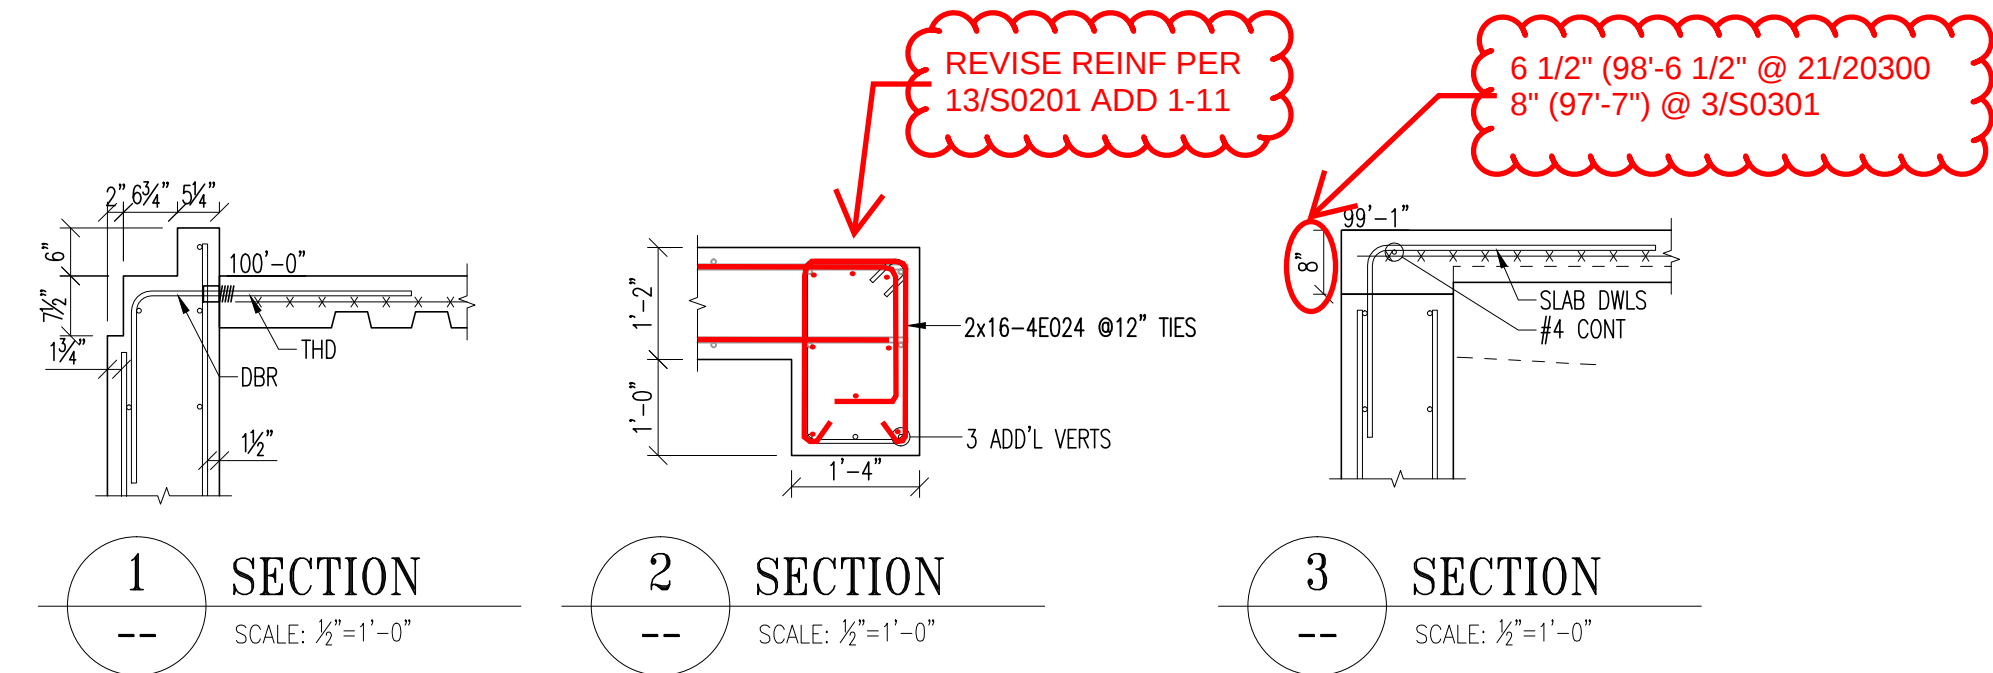

1 SECTION
SCALE: 3/8"=1'-0"

2 SECTION
SCALE: 3/8"=1'-0"

3 SECTION
SCALE: 3/8"=1'-0"

Revisions and Issue Record			
No.	Description	Date	By
0	FOR APPROVAL	05/20/16	JLH
The full intent and purpose of this drawing is the placing of reinforcing steel bars ONLY. It is NOT to be used as a means of communication between the Architect, Engineer, Contractor or any other Sub-trades.			
THIS DRAWING IS NOT TO BE SCALED.			
ST. LOUIS, MO.			
DETAILED AT: ROCHELLE, IL.			
PHONE: 615-561-1771			
Project: WEBSTER ISB PHASE 1			
Drawing: WALL ELEVATIONS & SECTIONS			
Customer: KCI CONSTRUCTION			
Engineer: DAVID MASON & ASSOCIATES, INC.			
Date	Drawn	Chkd.	JOB No.
05/20/16	JLH		00916023
			Dwg. No.
			R04-03

SUBMITTAL IDENTIFICATION SHEET

To be completed by Contractor/CM

PROJECT NAME	
ADDRESS	
NUMBER	
OWNER	
ARCHITECT / ENGINEER	
SUBMITTED BY	
CONTRACTOR / CM SUBMITTAL NO.	CANNON DESIGN SUBMITTAL NO.
DRAWING / DETAIL REFERENCE	SPECIFICATION SECTION / PARAGRAPH
MANUFACTURER / SUPPLIER	ITEM / PRODUCT ID
REQUIRED DATE	PRIORITY
CRITICAL	

ITEM BEING SUBMITTED (check only one)

- | | | |
|---|--|--|
| ☐ Shop Drawings | ☐ Certification / Qualifications | ☐ Coordination Drawing |
| ☐ Samples (____ copies) | ☐ Record Documents | ☐ Calculations |
| ☐ LEED Submittal | ☐ Product Data | ☐ Schedules |
| ☐ Other _____ | ☐ O&M Manuals | |

ITEM BEING SUBMITTED FOR (check only one)

- ☐ Action ☐ Information Only ☐ Record

REMARKS OR DEVIATIONS

CONTRACTOR / CM CERTIFICATION (SUBMITTALS NOT CERTIFIED WILL BE RETURNED WITHOUT REVIEW)



PARIC CORPORATION
SUBMITTAL STAMP

THIS SHOP DRAWING HAS BEEN REVIEWED BY PARIC CORPORATION

Subcontractor remains responsible for dimensions, quantities, coordination with other trades and compliance with contract documents.

By: **Devin D. Gates**

REVIEWED BY

DATE

To be completed by Reviewer

CANNON DESIGN SUBMITTAL NUMBER
RECEIVED DATE
☐ A. No Exceptions Taken No further review of submittal is required.
☐ B. Make Corrections Noted Incorporate corrections in work; resubmission is not required.
☐ C. Revise and Resubmit Revise as noted, and resubmit for review.
☐ D. Rejected Submittal is not in compliance with Contract Documents; provide new submittal.
☐ E. For Record / Information Only Submittal was reviewed for Record / Information purposes only.
☐ F. Not Required for Review Submittal is not required by Contract Documents and has not been reviewed.

Review is for conformance with the design concept of this project and for general compliance with contract documents. Contractor is responsible for quantities, dimensions and compliance with contract documents and for information that pertains to fabrication processes, construction techniques and coordination of this work with all trades which will be affected thereby. This review is null and void if submittal deviates from contract documents and does not indicate or note deviations.

A/E COMMENTS

☐ See attached sheet(s) for additional comments

SHOP DRAWING / SUBMITTAL REVIEW	
☐ NO EXCEPTION TAKEN	☒ EXCEPTIONS NOTED, RESUBMITTAL NOT REQUIRED
☐ REJECTED	
☐ REVIEWED FOR INFORMATION ONLY	☐ REVISE AND RESUBMIT AS NOTED
Checking is only for general conformance with the design concept of the project and general compliance with the information given in the Contract Documents. Any action shown is subject to the requirements of the plans and specifications. Contractor is responsible for: Dimensions which shall be confirmed and correlated at the job site, fabrication processes and techniques of the construction, coordination of his work with that of all other trades and the satisfactory performance of his work.	
DAVID MASON & ASSOCIATES, INC.	
REVIEW BY: JYW	DATE: 06/08/2016

REVIEWED BY

DATE



77 Westport Plaza
Suite 250
St. Louis, MO 63146

TRANSMITTAL

No. 15051-0044

Paric Corporation

PROJECT: Webster University Interdisciplinary Science Building

DATE: 05/23/2016

TO: Cannon Design
1100 Clark Ave
St Louis MO 63102

RE: Steel Reinforcing Shop Drawings - Level
01 Walls

ATTN: Kelvin Patel

JOB: 15051

WE ARE SENDING:	SUBMITTED FOR:	ACTION TAKEN:
☒ Shop Drawings	☒ Approval	☒ Approved as Submitted
☐ Letter	☐ Your Use	☐ Approved as Noted
☐ Prints	☐ As Requested	☐ Returned After Loan
☐ Change Order	☐ Review and Comment	☐ Resubmit
☐ Plans		☐ Submit
☐ Samples	SENT VIA:	☐ Returned
☐ Specifications	☐ Attached	☐ Returned for Corrections
☐ Other:	☐ Separate Cover Via:	☐ Due Date:

Item	Package	Code	Rev.	Copies	Date	Description	Status
Submittal		033000-21	1		05/23/2016	Steel Reinforcing Shop Drawings - Level 01 Walls	Submitted

NOTES:

CC: Paric Corporation, Kathy Bathe

Project Coordinator: Paric Corporation, Kathy Bathe

Signed: _____
Devin Gates



KCI Construction Company, Inc.
ST. LOUIS: 10315 Lake Bluff Drive | St. Louis, MO 63123
LEBANON: 119 West Fremont | Lebanon, MO 65536

O: 314.894.8888
F: 314.894.7418
www.kciconstruction.com

SUBMITTAL TRANSMITTAL

Date Sent: 05/20/2016

Project: Webster University –
Interdisciplinary Science Building

Project #: 16-008

Subject: 03 3000 Cast-In-Place Concrete –
Steel Reinforcing Shop Drawings –
Level 01 Walls

Submittal ID: 0009

Type: Submittal

Purpose: For Approval

Sent Via: Email (PDF)

Transmitted To:

Devin Gates
Paric
77 Westport Plaza, Suite 250
St. Louis, MO, 63146
Phone: (636) 561-9592
Email: ddgates@paric.com

Transmitted From:

Kyle Nieman
KCI Construction Company
10315 Lake Bluff Drive
St. Louis, MO 63123
Phone: (314) 200-6486
Email: knieman@kciconstruction.com

Contents:

Qty: 1 Dated: 05/20/2016 Submittal Package No.: 0009 – 03 3000 – 00

Description: 03 3000-00_Cast-In-Place Concrete – Steel Reinforcing Shop Drawings – Level 01 Walls

Remarks: Please review and return at your earliest opportunity. Thanks,

 05/20/16

Kyle Nieman
KCI Construction Company

A BUILDER, NOT A BROKER.

General Building | Design/Build | Heavy Industrial | Transportation



KCI Construction Company, Inc.

ST. LOUIS: 10315 Lake Bluff Drive | St. Louis, MO 63123

LEBANON: 119 West Fremont | Lebanon, MO 65536

O: 314.894.8888

F: 314.894.7418

www.kciconstruction.com

WEBSTER UNIVERSITY – INTERDISCIPLINARY SCIENCE BUILDING

St. Louis, MO

Submittal Description: Cast-In-Place Concrete – Steel Reinforcing Shop Drawings – Level 01 Walls

Submittal #: 0009 – 03 3000 – 00

Notes:

This submittal/drawing has been reviewed and found to be in general conformance with the contract documents.

APPROVED

☒

APPROVED AS NOTED

☐

REVISE AND RESUBMIT

☐

03 3000

SPEC SECTION

05/20/2016

DATE

 05/20/16

KYLE NIEMAN

KCI CONSTRUCTION CO.

A BUILDER, NOT A BROKER.

General Building | Design/Build | Heavy Industrial | Transportation