

SUBMITTAL IDENTIFICATION SHEET

To be completed by Contractor/CM

PROJECT NAME	
ADDRESS	
NUMBER	
OWNER	
ARCHITECT / ENGINEER	
SUBMITTED BY	
CONTRACTOR / CM SUBMITTAL NO.	CANNON DESIGN SUBMITTAL NO.
DRAWING / DETAIL REFERENCE	SPECIFICATION SECTION / PARAGRAPH
MANUFACTURER / SUPPLIER	ITEM / PRODUCT ID
REQUIRED DATE	PRIORITY
CRITICALITY	

To be completed by Reviewer

CANNON DESIGN SUBMITTAL NUMBER
RECEIVED DATE

- ☐ **A. No Exceptions Taken**
No further review of submittal is required.
- ☐ **B. Make Corrections Noted**
Incorporate corrections in work;
resubmission is not required.
- ☐ **C. Revise and Resubmit**
Revise as noted, and resubmit for review.
- ☐ **D. Rejected**
Submittal is not in compliance with Contract Documents;
provide new submittal.
- ☐ **E. For Record / Information Only**
Submittal was reviewed for Record / Information
purposes only.
- ☐ **F. Not Required for Review**
Submittal is not required by Contract Documents
and has not been reviewed.

Review is for conformance with the design concept of this project and for general compliance with contract documents. Contractor is responsible for quantities, dimensions and compliance with contract documents and for information that pertains to fabrication processes, construction techniques and coordination of this work with all trades which will be affected thereby. This review is null and void if submittal deviates from contract documents and does not indicate or note deviations.

ITEM BEING SUBMITTED (check only one)

- ☐ Shop Drawings ☐ Certification / Qualifications ☐ Coordination Drawing
☐ Samples ☐ Record Documents ☐ Calculations
 (_____ copies) ☐ Product Data ☐ Schedules
☐ LEED Submittal ☐ O&M Manuals
☐ Other

ITEM BEING SUBMITTED FOR (check only one)

- ☐ Action ☐ Information Only ☐ Record

REMARKS OR DEVIATIONS

CONTRACTOR / CM CERTIFICATION
(SUBMITTALS NOT CERTIFIED WILL BE RETURNED WITHOUT REVIEW)



PARIC CORPORATION
SUBMITTAL STAMP

THIS SHOP DRAWING HAS BEEN REVIEWED BY PARIC CORPORATION

Subcontractor remains responsible for dimensions, quantities, coordination with other trades and compliance with contract documents.

Ry:

By:
Devin D. Gates

REVIEWED BY	DATE

A/E COMMENTS

- ☐
- See attached sheet(s) for additional comments

REVIEWED BY	DATE



77 Westport Plaza
Suite 250
St. Louis, MO 63146

TRANSMITTAL

No. 15051-0195

Paric Corporation

PROJECT: 15051-Webster University Interdisciplinary Science Building

DATE: 08/19/2016

TO: Cannon Design
1100 Clark Ave
St Louis MO 63102

RE: Mockup foundation reinforcement shop drawings

ATTN: Kelvin Patel

JOB: 15051

WE ARE SENDING:	SUBMITTED FOR:	ACTION TAKEN:
☒ Shop Drawings	☒ Approval	☐ Approved as Submitted
☐ Letter	☐ Your Use	☐ Approved as Noted
☐ Prints	☐ As Requested	☐ Returned After Loan
☐ Change Order	☐ Review and Comment	☐ Resubmit
☐ Plans		☐ Submit
☐ Samples	SENT VIA:	☐ Returned
☐ Specifications	☐ Attached	☐ Returned for Corrections
☐ Other:	☐ Separate Cover Via:	☐ Due Date:

Item	Package	Code	Rev.	Copies	Date	Description	Status
Submittal		033000-028	1		08/19/2016	Mockup foundation reinforcement shop drawings	Submitted

NOTES:

CC:

Signed: _____
Devin Gates



SUBMITTAL DATA

WEBSTER UNIVERSITY INTERDISCIPLINARY SCIENCE BUILDING WEBSTER GROOVES, MISSOURI

ARCHITECT	CANNON DESIGN
GENERAL CONTRACTOR	PARIC CORPORATION
SUBCONTRACTOR	KCI CONSTRUCTION

ITEM SUBMITTED	REINFORCING STEEL – MOCK UP FOUNDATION A
SPEC SECTION	03 30 00 CAST IN PLACE CONCRETE
MANUFACTURER	HARRIS REBAR
DATE	8/19/16
SUBMISSION NO.	1

SHOP DRAWING / SUBMITTAL REVIEW



☒ REVIEWED ☐ REVIEWED WITH CHANGES NOTED
☐ REVISE AND RESUBMIT ☐ REJECTED / RESUBMIT

This review is for general information with plans and specifications only. Approvals are subject to subcontractors performance within the confines of the contract documents. Review of dimensions will not serve to relieve the subcontractor of contractual responsibility for any deviation from the contract requirements.

By: **Steve Teipe, Project Manager**
KCI Construction, Inc.

10315 Lake Bluff Drive
St. Louis, MO 63123

Date:
08/19/2016

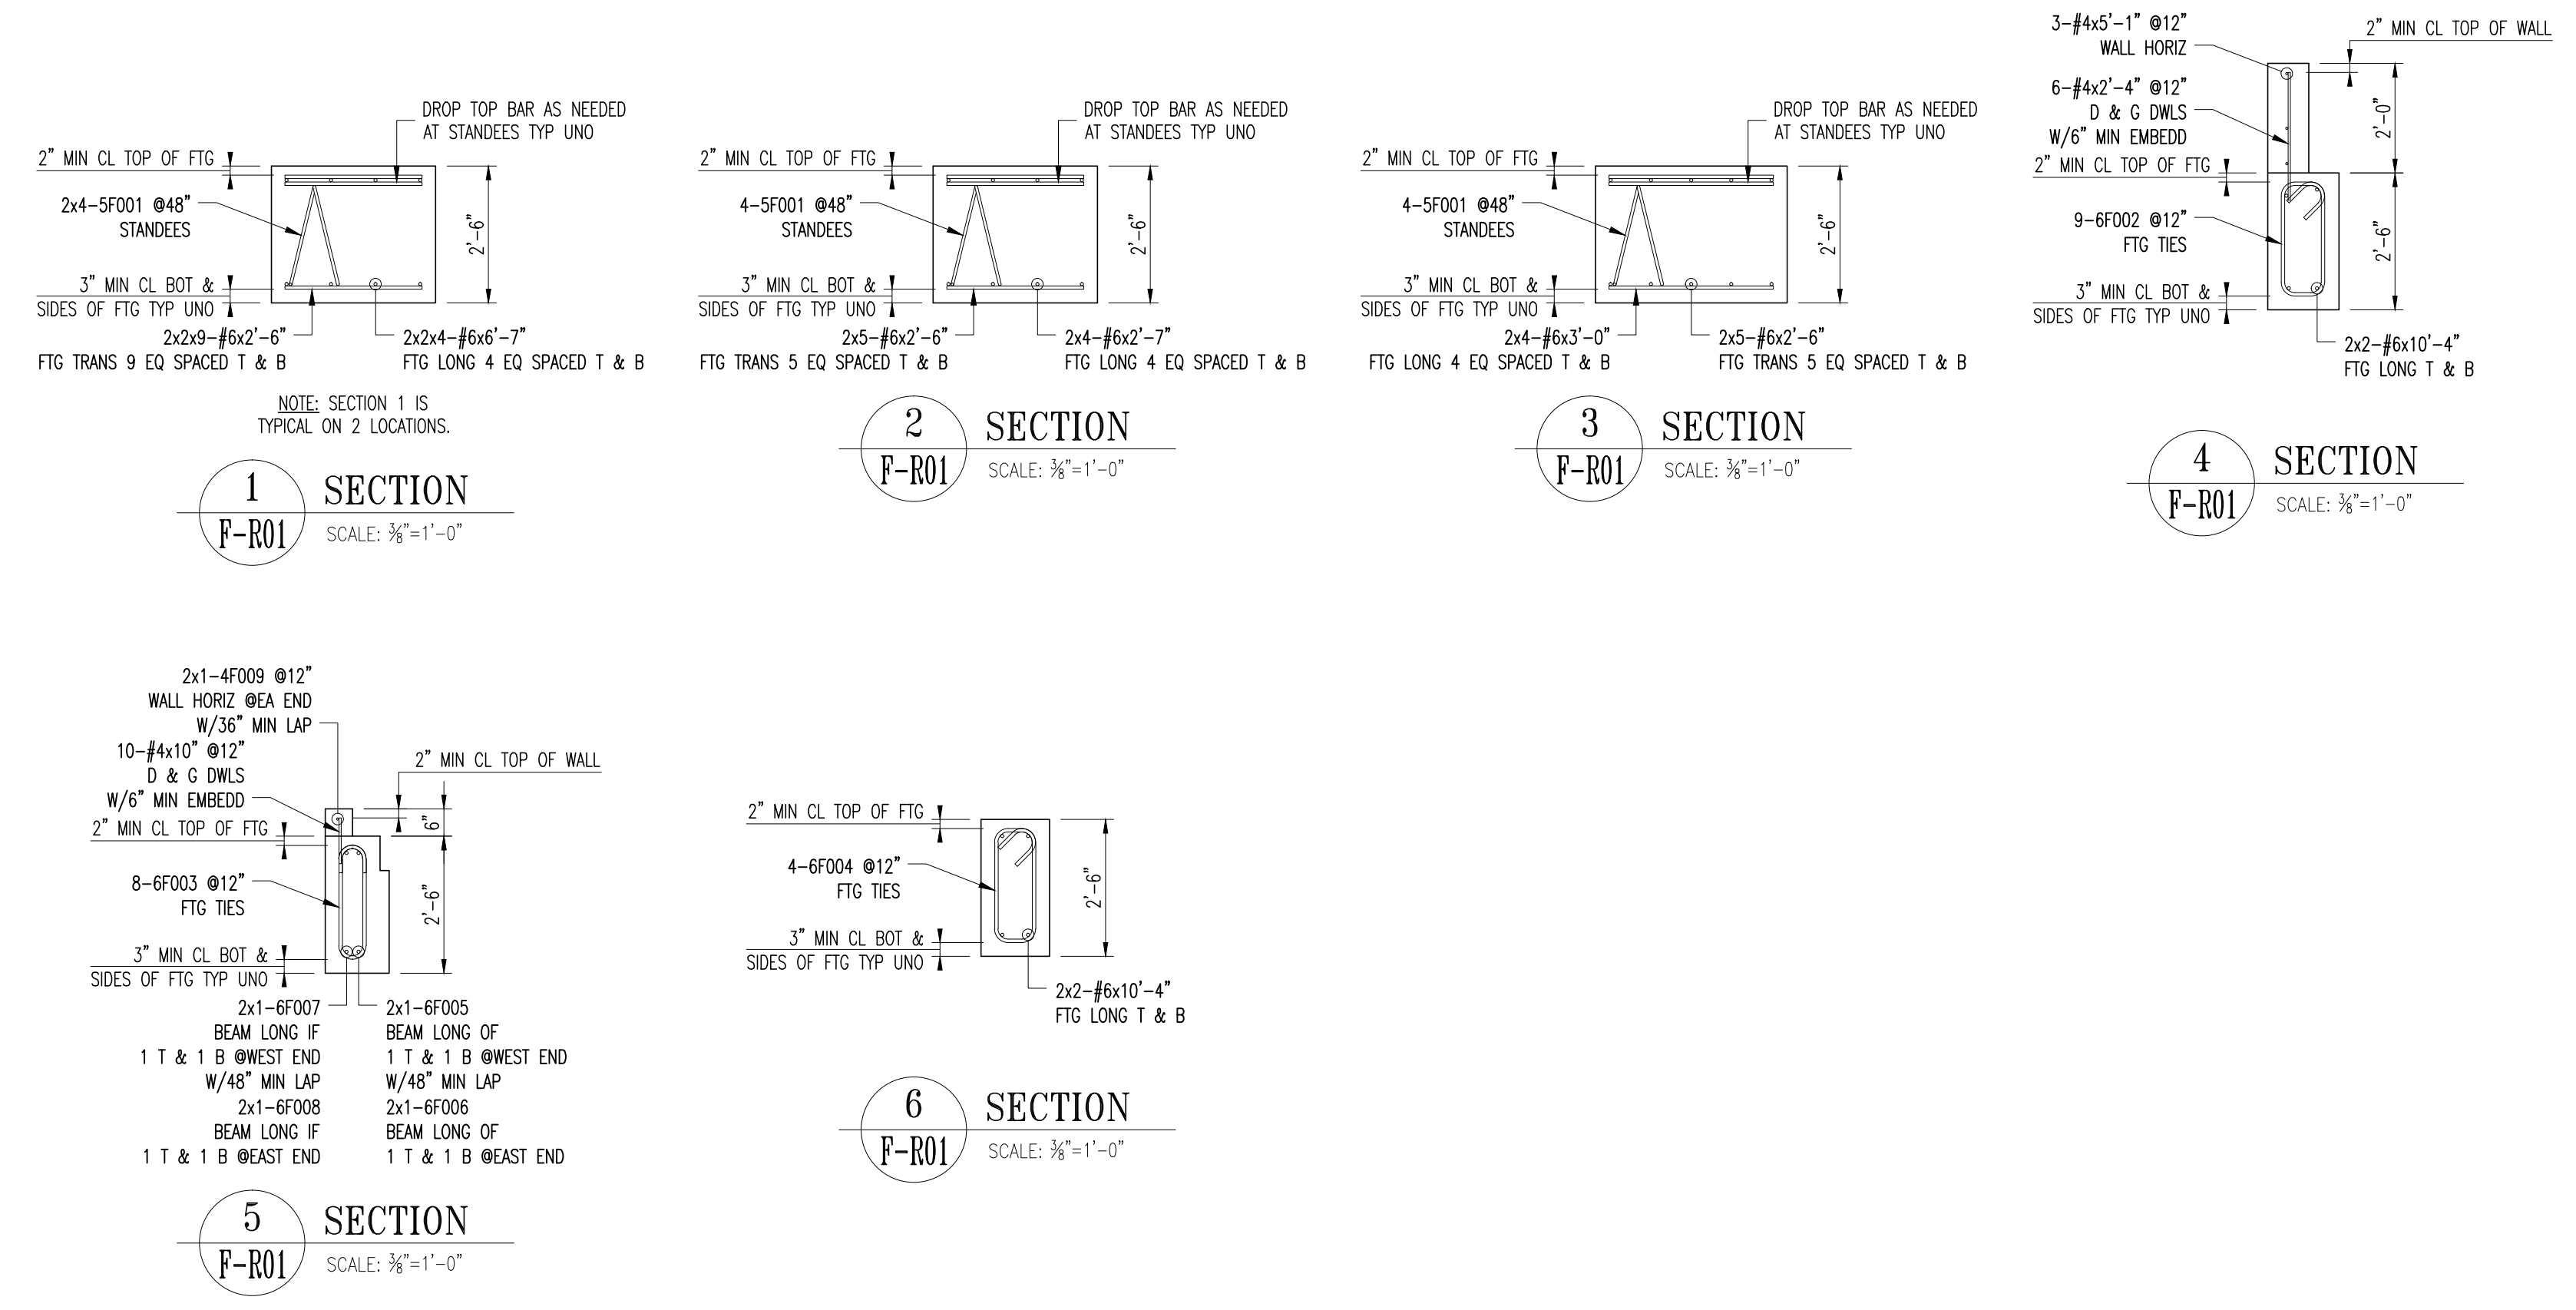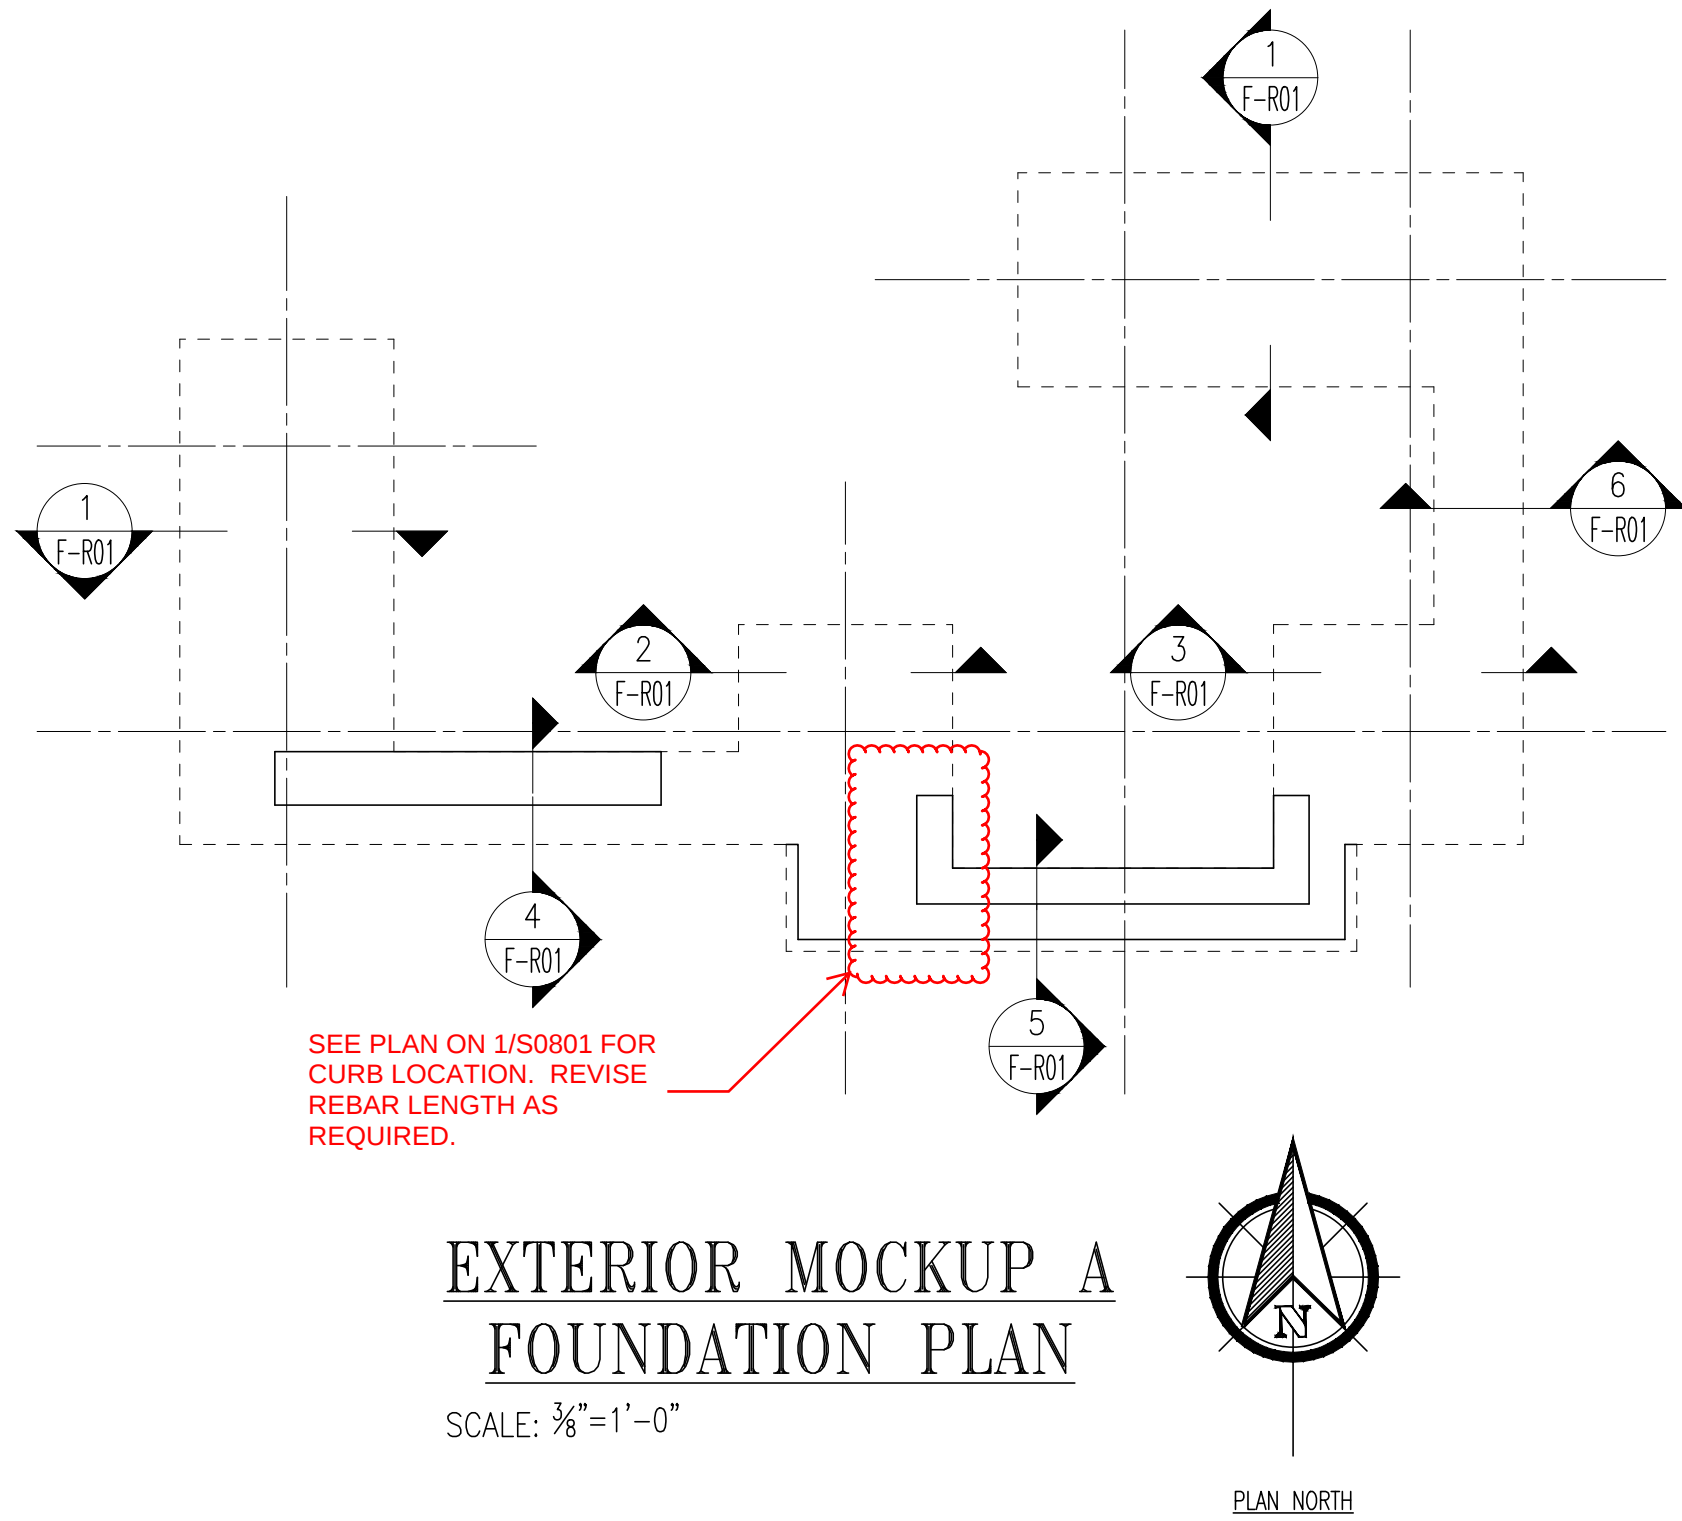

Drawing Sheet : F-R01				BENDING DETAILS											
Bar Mark	Size	Total Length	Type	A'	B'	C'	D'	E'	F'	G'	H'	I'	J'	K'	L'
5F001	#5	7'-7"	25		1'-6"	1'-10 3/4"	0'-10"	1'-10 3/4"	1'-6"						
6F002	#6	7'-7"	11	0'-8"	0'-9 3/4"	2'-1"	0'-9 3/4"	2'-1"		0'-8"	1'-10"		0'-11"		
6F003	#6	4'-0"	59	0'-8"	2'-1"	0'-8"	2'-1"			0'-8"	0'-8"	0'-8"			
6F004	#6	7'-0"	11	0'-8"	0'-9 3/4"	2'-1"	0'-9 3/4"	2'-1"		0'-8"					
6F005	#6	11'-0"	20		5'-6 3/4"	1'-4 3/4"	4'-1"								
6F006	#6	9'-4"	17		5'-6 3/4"	5'-9 3/4"									
6F007	#6	10'-6"	20		4'-9"	1'-8 3/4"	4'-1"								
6F008	#6	8'-4"	17		4'-9"	5'-7"									
4F009	#4	5'-2"	17		1'-1 3/4"	4'-9 3/4"									
Standees (isometric view)															
25															
T1 Hooks A & G optional															
S9															
20															
17															

LAP CHART-U.N.O.	
#11	
#10	
#9	
#8	
#7	
#6	
#5	
#4	
#3	
SIZE	TOP BARS * OTHER BARS
* -Top bars are horiz. bars with more than 12" of concrete cast below the bars.	

ALL MATERIAL ON THIS DRAWING SHALL BE ASTM A615 GRADE 60 U.N.O.

FOR THE BENDING DETAILS ON THIS SHEET, REFER TO DRAWING: F-R01

0 FOR APPROVAL		8-18-16	BJE
No.	Description	Date	By
Revisions and Issue Record			
The full intent and purpose of this drawing is the placing of reinforcing steel bars ONLY. It is NOT to be used as a means of communication between the Architect, Engineer, Contractor or any other Sub-trades.			
THIS DRAWING IS NOT TO BE SCALED.			
ST. LOUIS, MO.			
HarrisRebar Ambassador Steel			
NATIONAL STRENGTH. LOCAL SERVICE. PHONE: 314-382-9855 FAX: 314-382-1711			
Project: WEBSTER ISB PHASE 1			
Drawing: EXTERIOR MOCKUP A FOUNDATION-PLAN / SECTIONS & DETAILS			
Customer: K C I Construction			
Engineer: CANNON DESIGN			
Date	Drawn	Chkd.	JOB No.
8-18-16	BJE		00916023
			Dwg. No.
			F-R01