

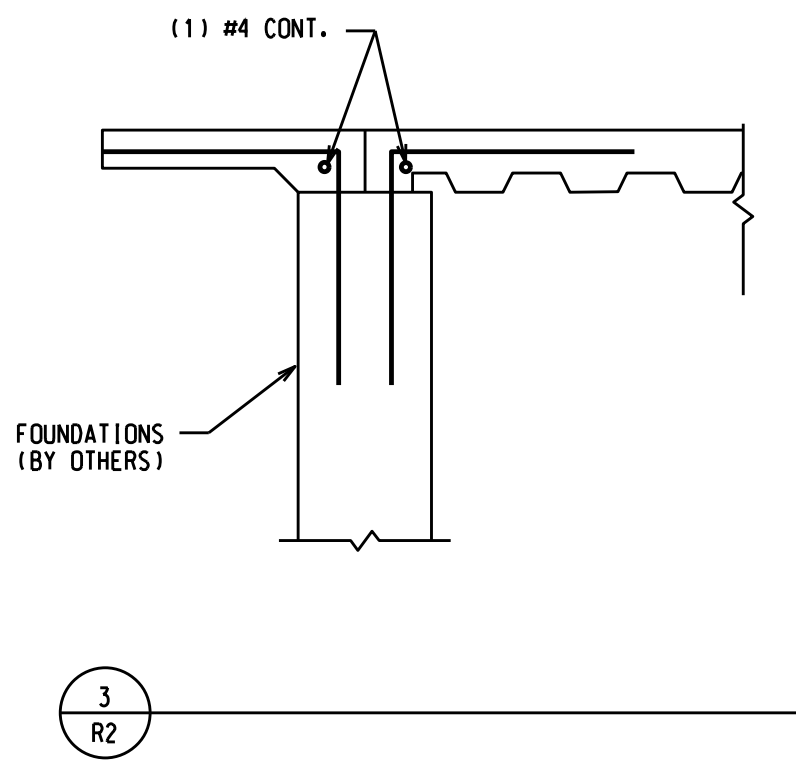
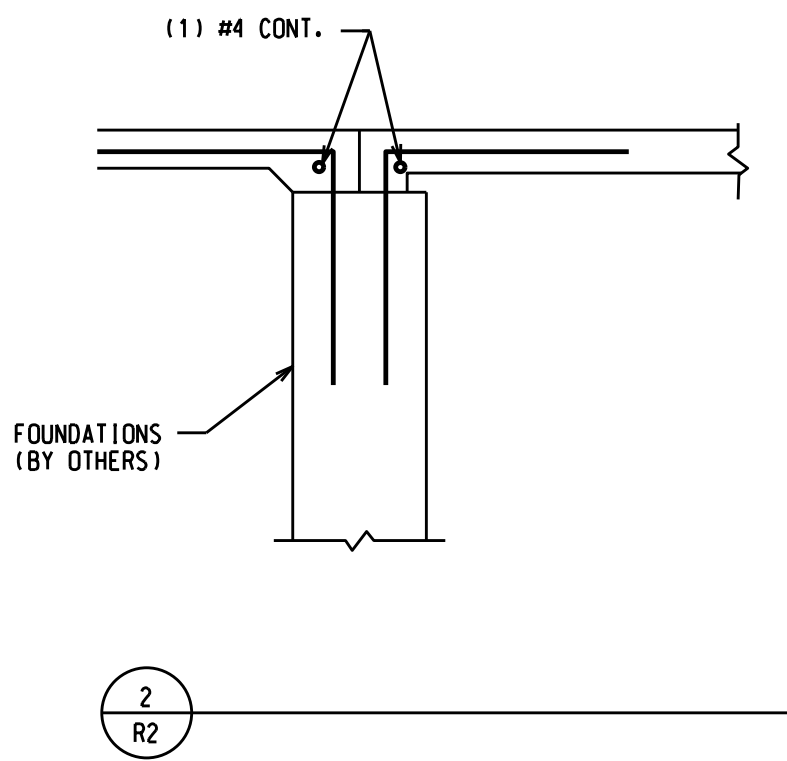
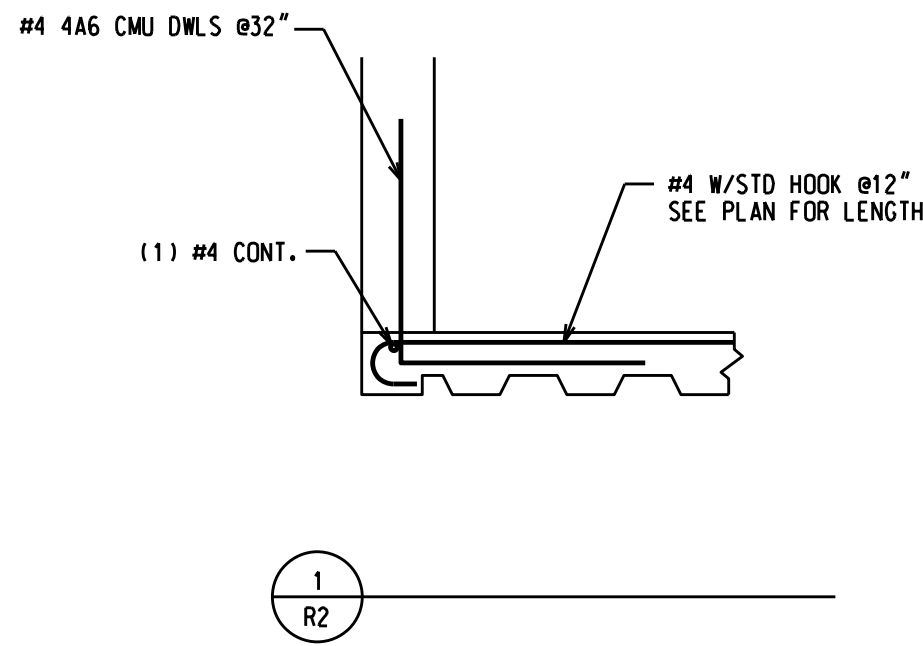
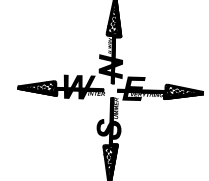
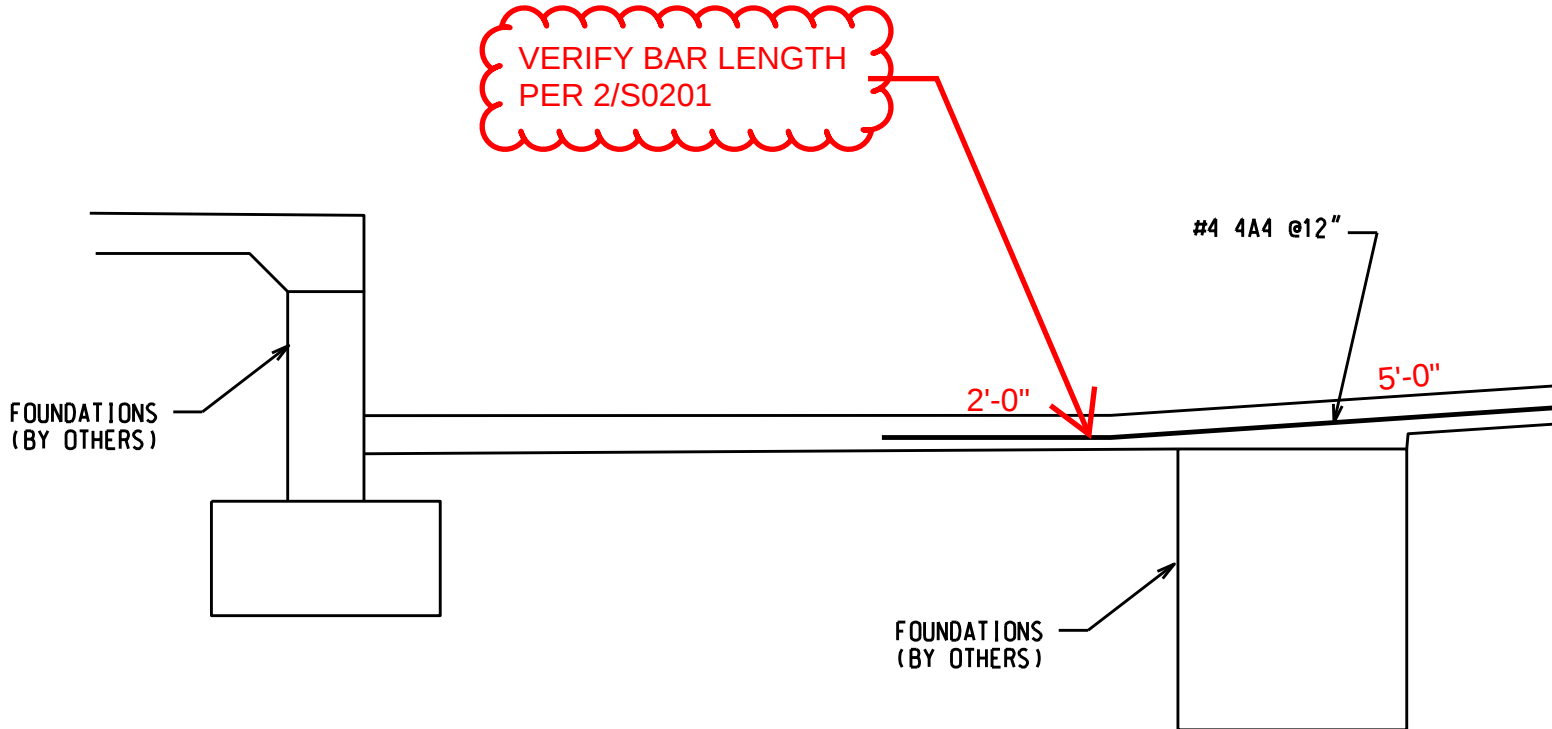
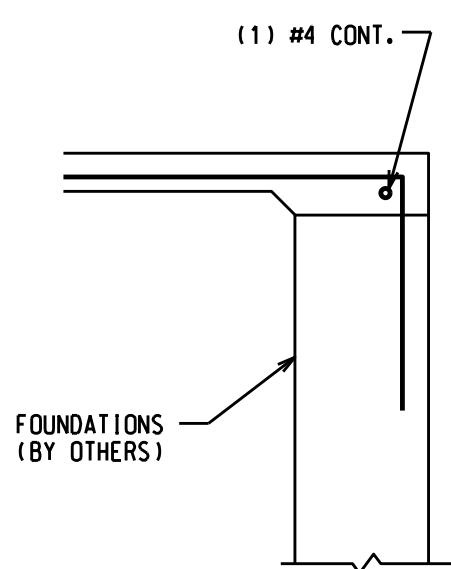
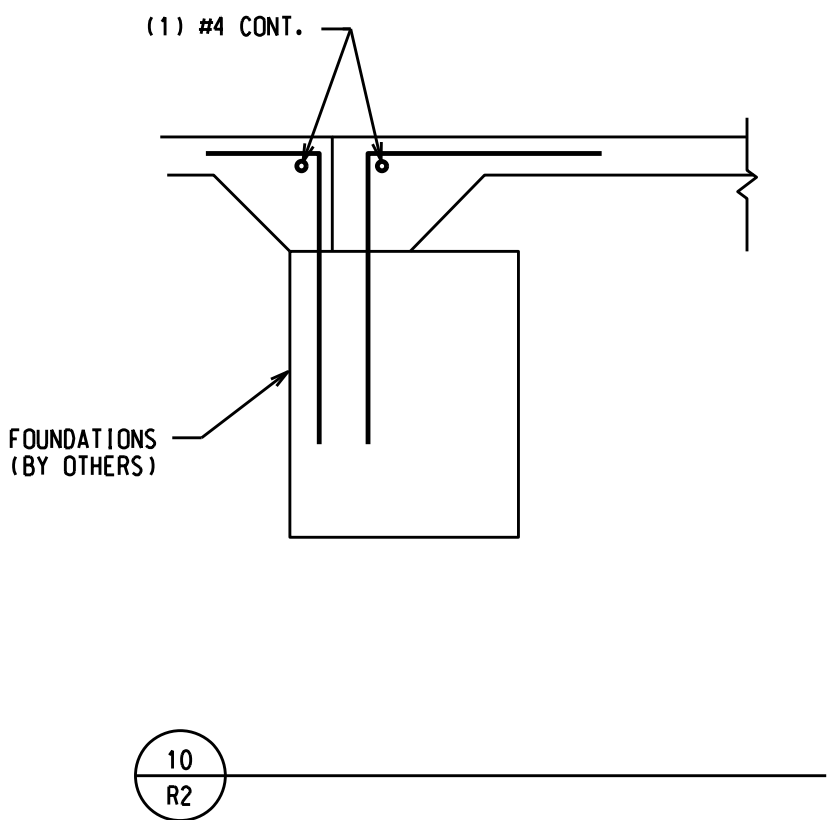
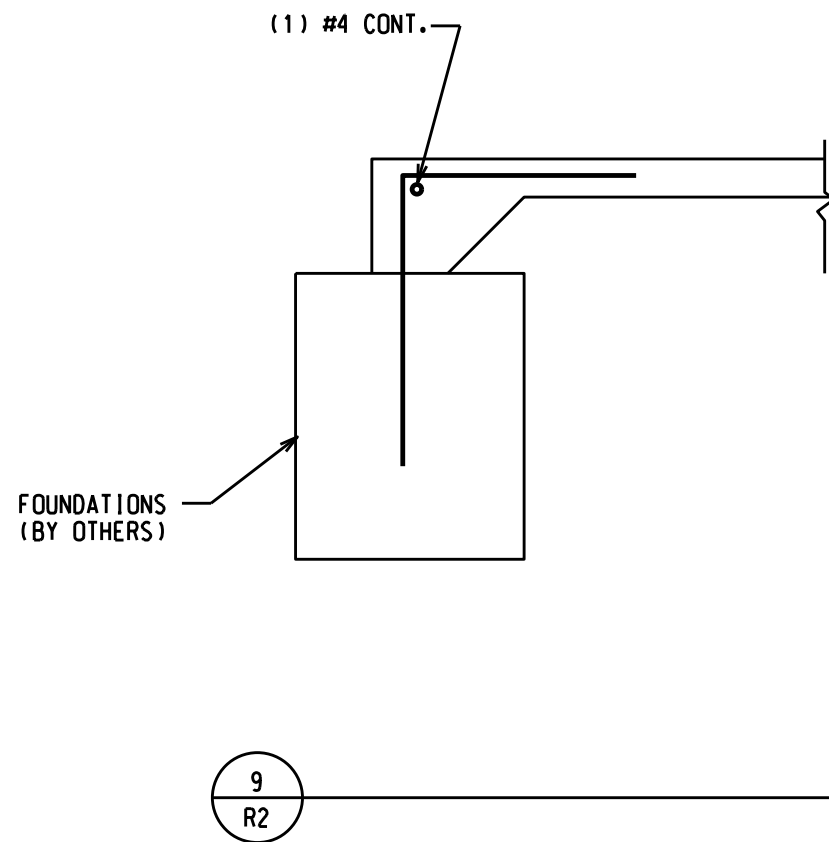
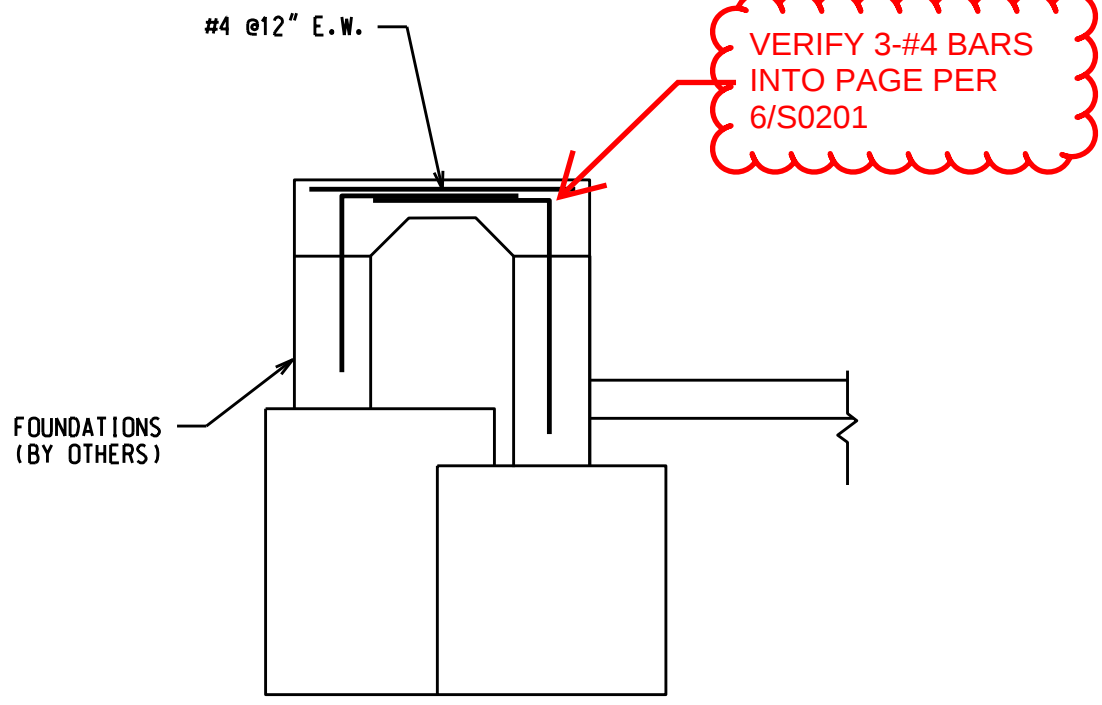
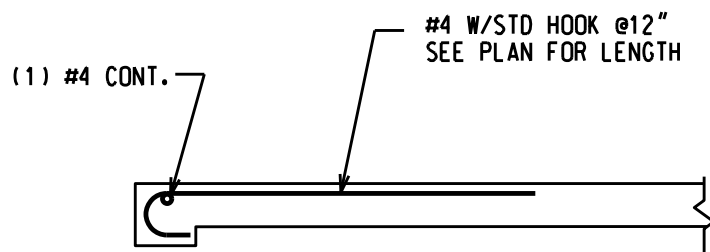


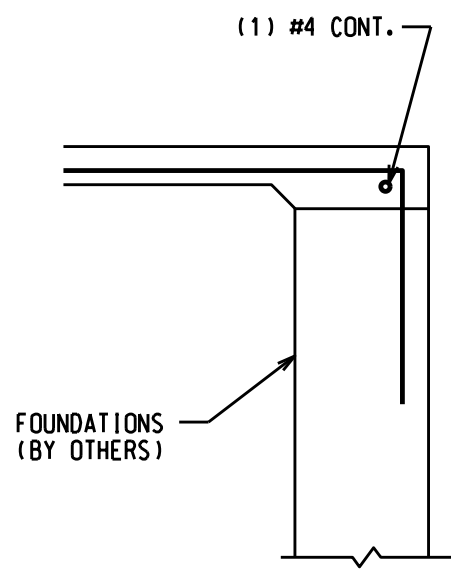

① 	SIZE	EP	BAR MARK	BND TYP	V	CD	BENDING DIMENSIONS										
							A	B	C	D	E	F/R	G	H	J	K	O
② 	4		4A1		1		0-06	2-101									
	4		4A2		1		0-06	4-04									
③ 	4		4A3		1		0-06	3-10									
	4		4A4		31		2-00	4-00						0-031		3-113	6-00
⑤ 	4		4A6		2		2-00	2-06									

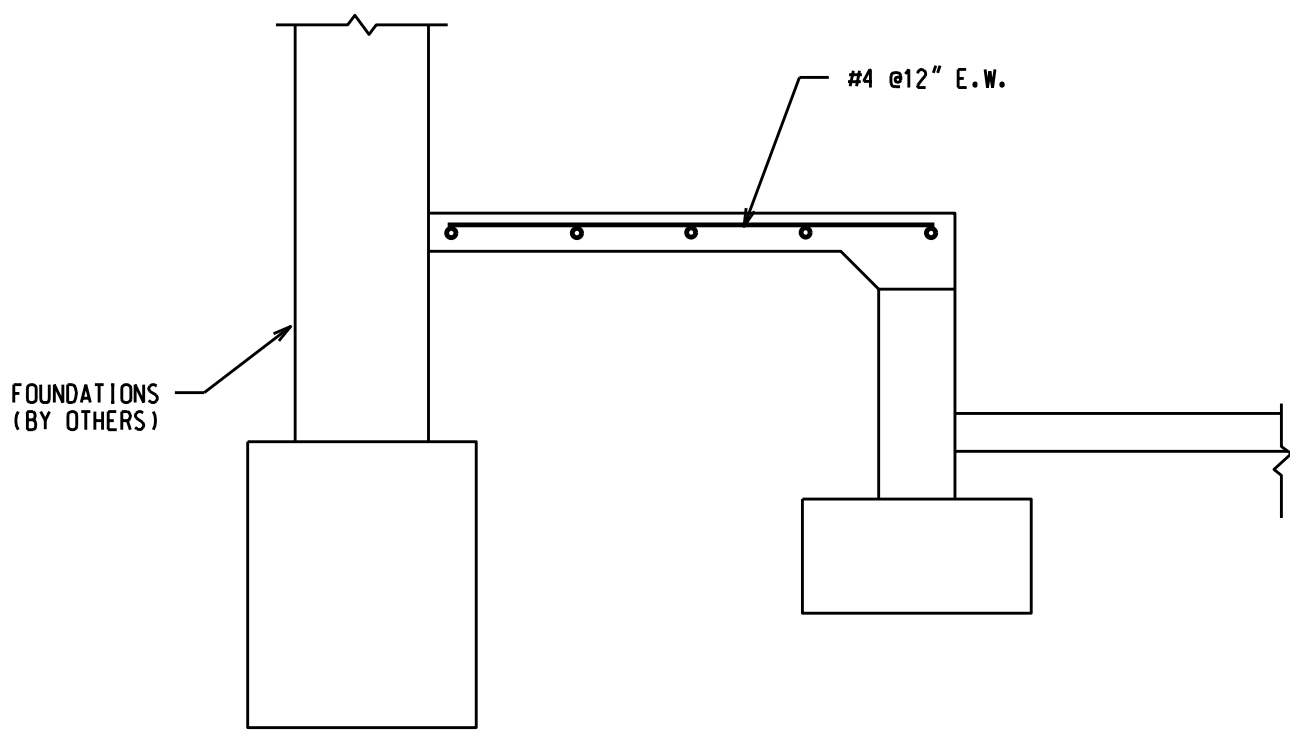

GENERAL CONTRACTOR TO VERIFY ALL QUANTITIES AND DIMENSIONS.
SEE ARCHITECTURAL AND STRUCTURAL PLANS FOR ADDITIONAL INFORMATION.
THESE DRAWINGS ARE FOR REBAR PLACEMENT INFORMATION ONLY.
USE OF THESE DRAWINGS WITHOUT THE PERMISSION OF NUWAY, INC. IS PROHIBITED.

4190 HOFFMEISTER AVE. ST. LOUIS MO 63125 314-544-1214 PHONE 314-544-1656 FAX	nu way Everything for the Contractor™	7651 E. RESOURCE DR. TROY, IL 62294 618-288-3400 PHONE 618-288-3410 FAX	DATE: 08-30-16	CONTRACTOR VEE JAY	DWG. NO. R2
			MATERIAL: GR-60 OWN BY: LJS CHK'D: SCALE: 3/32"=1'-0"	JOB: 1613	

SUBMITTAL IDENTIFICATION SHEET

To be completed by Contractor/CM

PROJECT NAME	
ADDRESS	
NUMBER	
OWNER	
ARCHITECT / ENGINEER	
SUBMITTED BY	
CONTRACTOR / CM SUBMITTAL NO.	CANNON DESIGN SUBMITTAL NO.
DRAWING / DETAIL REFERENCE	SPECIFICATION SECTION / PARAGRAPH
MANUFACTURER / SUPPLIER	ITEM / PRODUCT ID
REQUIRED DATE	PRIORITY
☐ CRITICAL	

ITEM BEING SUBMITTED (check only one)

- | | | |
|---|--|--|
| ☐ Shop Drawings | ☐ Certification / Qualifications | ☐ Coordination Drawing |
| ☐ Samples (____ copies) | ☐ Record Documents | ☐ Calculations |
| ☐ LEED Submittal | ☐ Product Data | ☐ Schedules |
| ☐ Other _____ | ☐ O&M Manuals | |

ITEM BEING SUBMITTED FOR (check only one)

- ☐ Action
 ☐ Information Only
 ☐ Record

REMARKS OR DEVIATIONS

CONTRACTOR / CM CERTIFICATION (SUBMITTALS NOT CERTIFIED WILL BE RETURNED WITHOUT REVIEW)



PARIC CORPORATION
SUBMITTAL STAMP

THIS SHOP DRAWING HAS BEEN REVIEWED BY PARIC CORPORATION

Subcontractor remains responsible for dimensions, quantities, coordination with other trades and compliance with contract documents.

By:

Devin D. Gates

To be completed by Reviewer

CANNON DESIGN SUBMITTAL NUMBER
RECEIVED DATE

- ☐ **A. No Exceptions Taken**
No further review of submittal is required.
- ☐ **B. Make Corrections Noted**
Incorporate corrections in work; resubmission is not required.
- ☐ **C. Revise and Resubmit**
Revise as noted, and resubmit for review.
- ☐ **D. Rejected**
Submittal is not in compliance with Contract Documents; provide new submittal.
- ☐ **E. For Record / Information Only**
Submittal was reviewed for Record / Information purposes only.
- ☐ **F. Not Required for Review**
Submittal is not required by Contract Documents and has not been reviewed.

Review is for conformance with the design concept of this project and for general compliance with contract documents. Contractor is responsible for quantities, dimensions and compliance with contract documents and for information that pertains to fabrication processes, construction techniques and coordination of this work with all trades which will be affected thereby. This review is null and void if submittal deviates from contract documents and does not indicate or note deviations.

A/E COMMENTS

☐ See attached sheet(s) for additional comments

SHOP DRAWING / SUBMITTAL REVIEW	
☐ NO EXCEPTION TAKEN	☒ EXCEPTIONS NOTED, RESUBMITTAL NOT REQUIRED
☐ REJECTED	
☐ REVIEWED FOR INFORMATION ONLY	☐ REVISE AND RESUBMIT AS NOTED
Checking is only for general conformance with the design concept of the project and general compliance with the information given in the Contract Documents. Any action shown is subject to the requirements of the plans and specifications. Contractor is responsible for: Dimensions which shall be confirmed and correlated at the job site, fabrication processes and techniques of the construction, coordination of his work with that of all other trades and the satisfactory performance of his work.	
DAVID MASON & ASSOCIATES, INC.	
REVIEW BY: JYW	DATE: 08/30/2016

REVIEWED BY	DATE
-------------	------



77 Westport Plaza
Suite 250
St. Louis, MO 63146

TRANSMITTAL

No. 15051-0201

Paric Corporation

PROJECT: 15051-Webster University Interdisciplinary Science Building

DATE: 08/30/2016

TO: Cannon Design
1100 Clark Ave
St Louis MO 63102

RE: Level 01 slab on metal deck reinforcement
shop drawings

ATTN: Kelvin Patel

JOB: 15051

WE ARE SENDING:	SUBMITTED FOR:	ACTION TAKEN:
☒ Shop Drawings	☒ Approval	☒ Approved as Submitted
☐ Letter	☐ Your Use	☐ Approved as Noted
☐ Prints	☐ As Requested	☐ Returned After Loan
☐ Change Order	☐ Review and Comment	☐ Resubmit
☐ Plans		☐ Submit
☐ Samples	SENT VIA:	☐ Returned
☐ Specifications	☐ Attached	☐ Returned for Corrections
☐ Other:	☐ Separate Cover Via:	☒ Due Date: 03/07/2016

Item	Package	Code	Rev.	Copies	Date	Description	Status
Submittal		033000-012	1		08/30/2016	Level 01 slab on metal deck reinforcement shop drawings	Submitted

NOTES:

CC:

Signed: _____
Devin Gates