
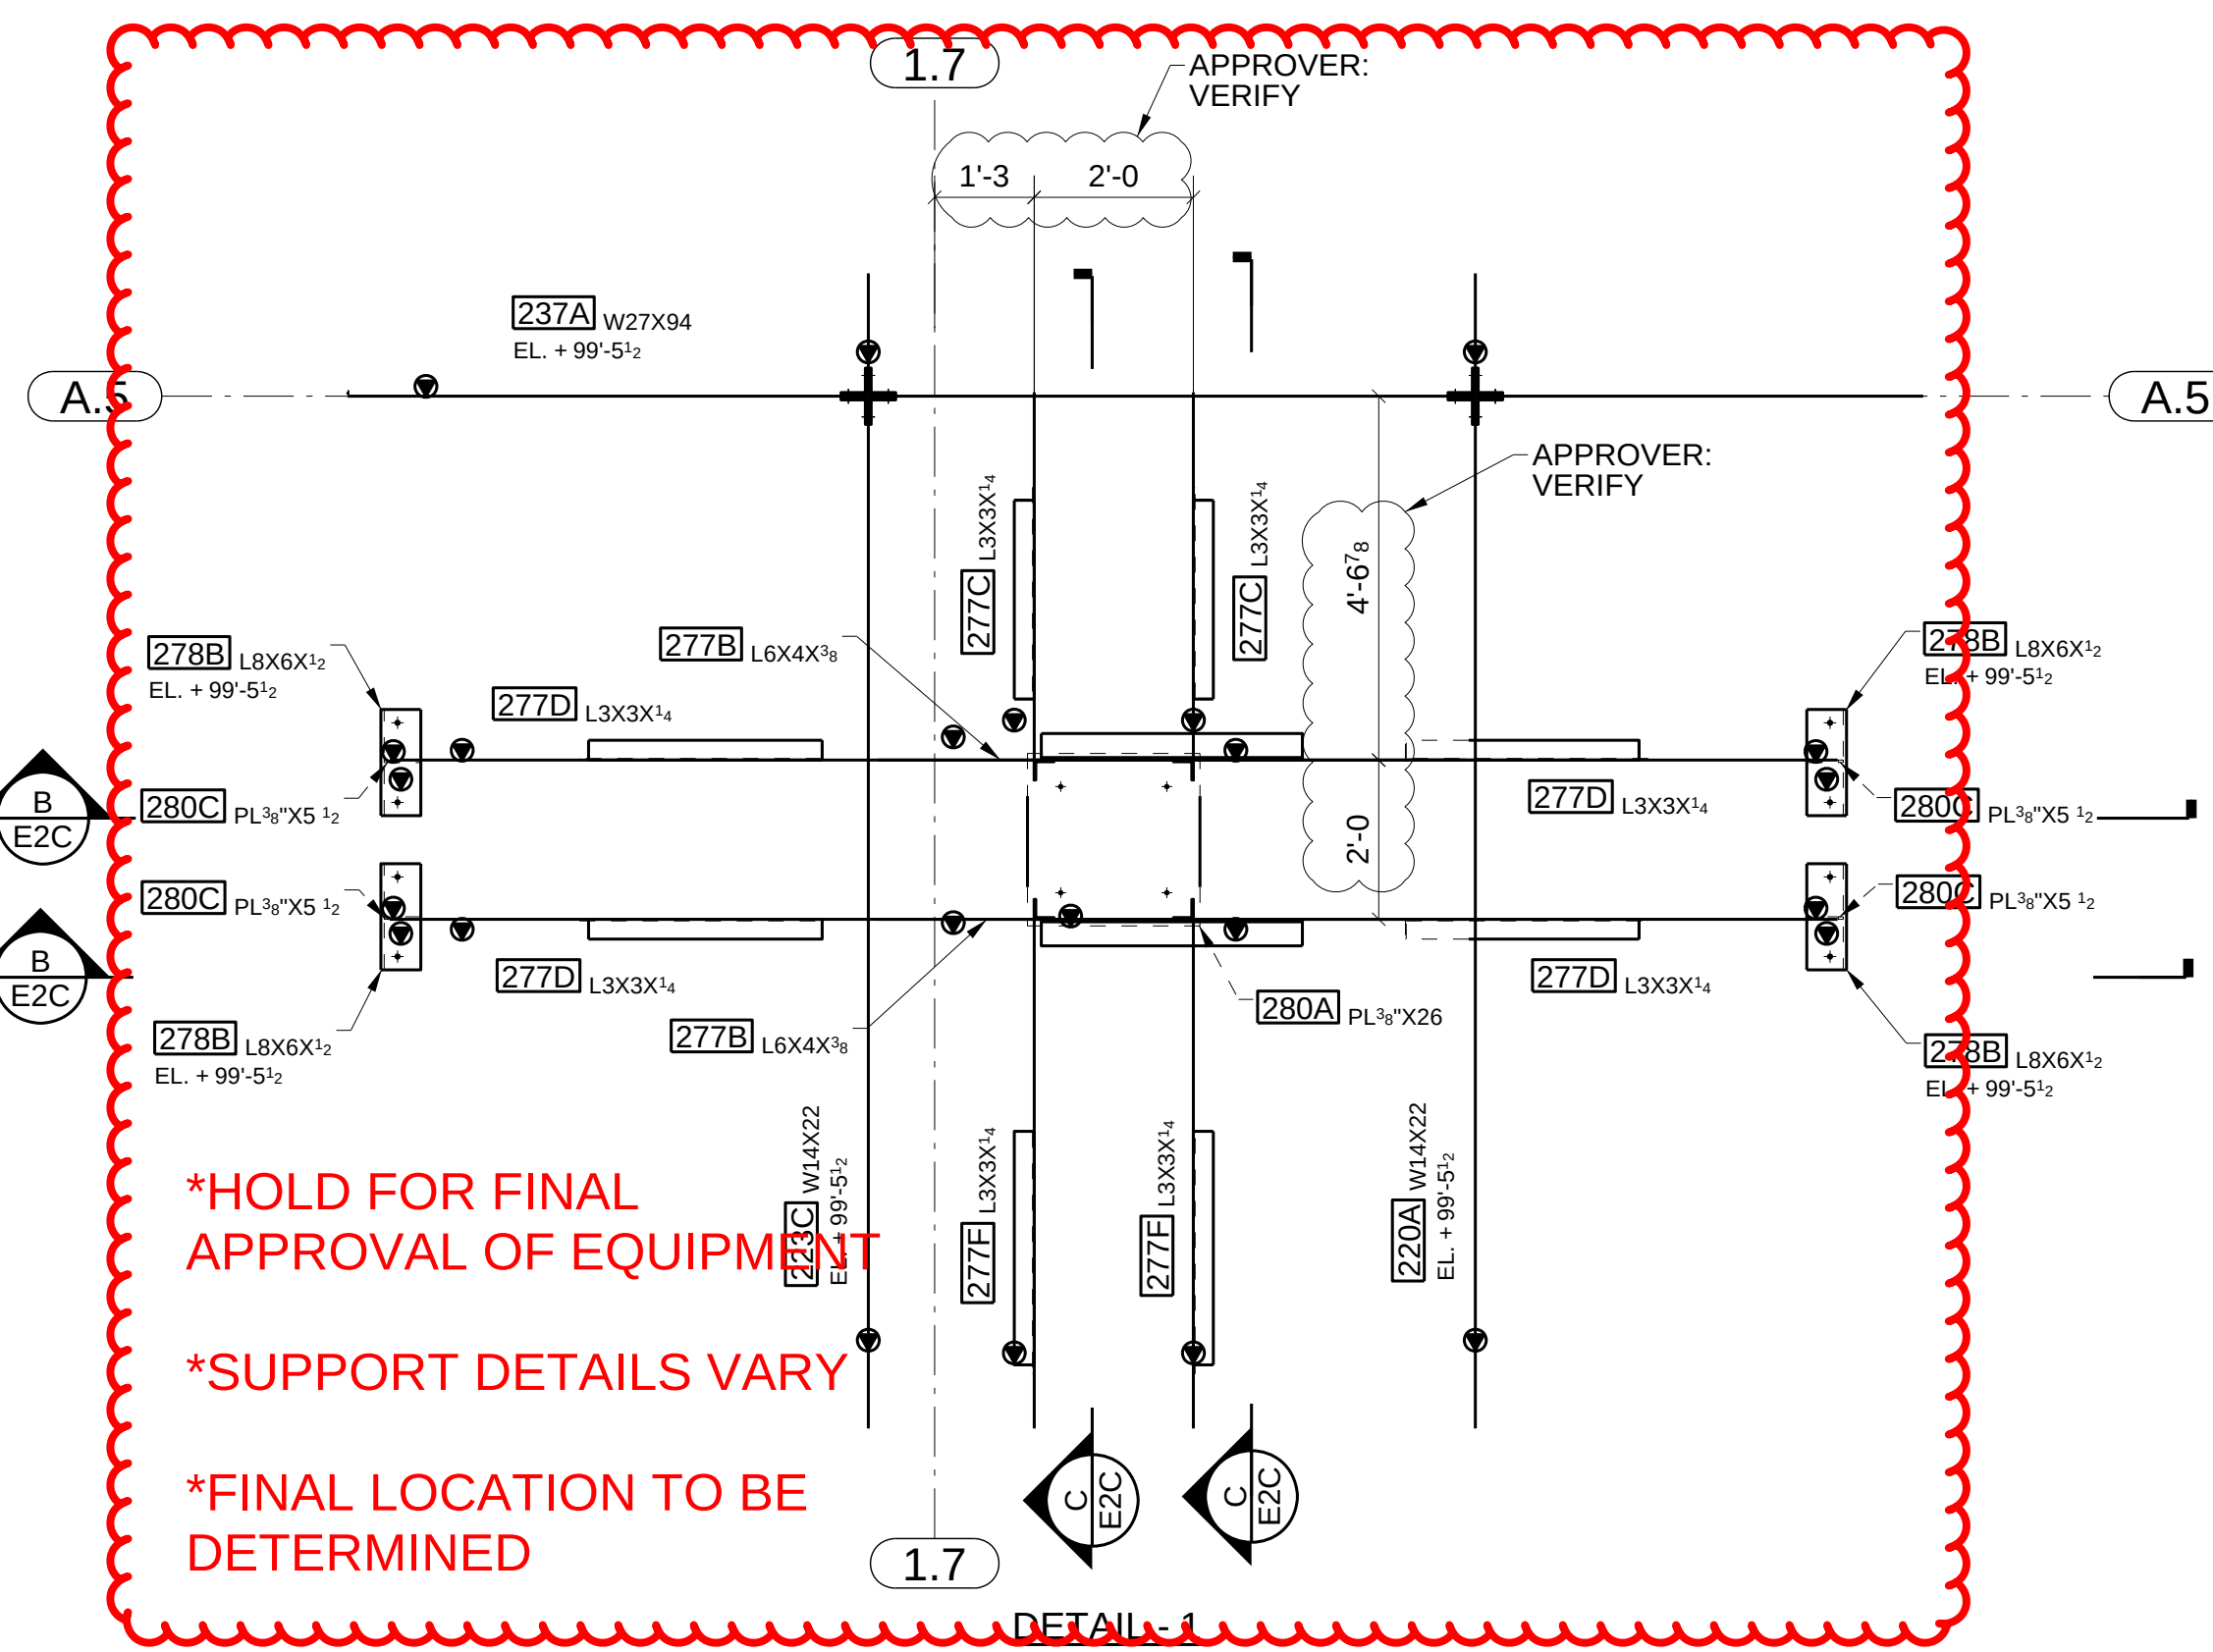
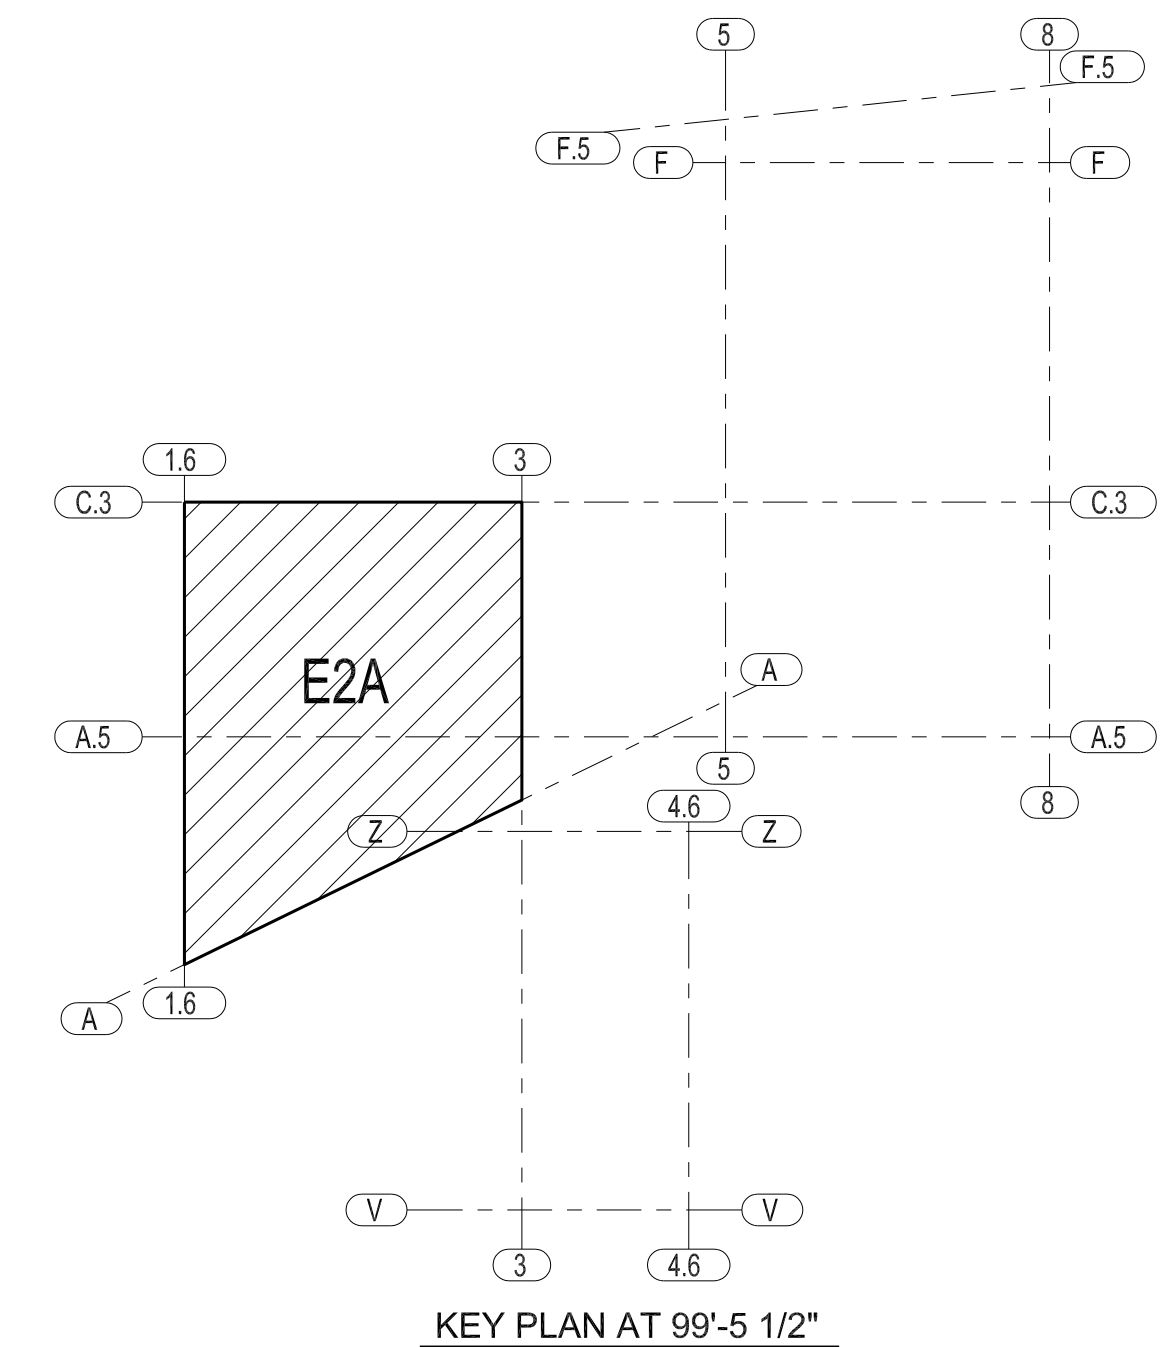
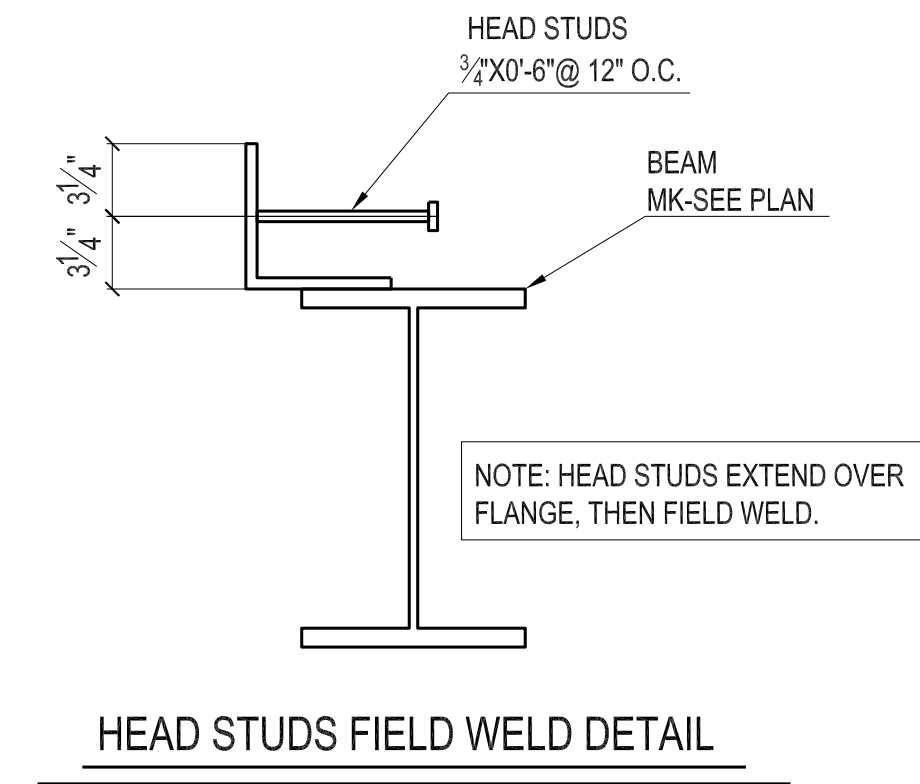


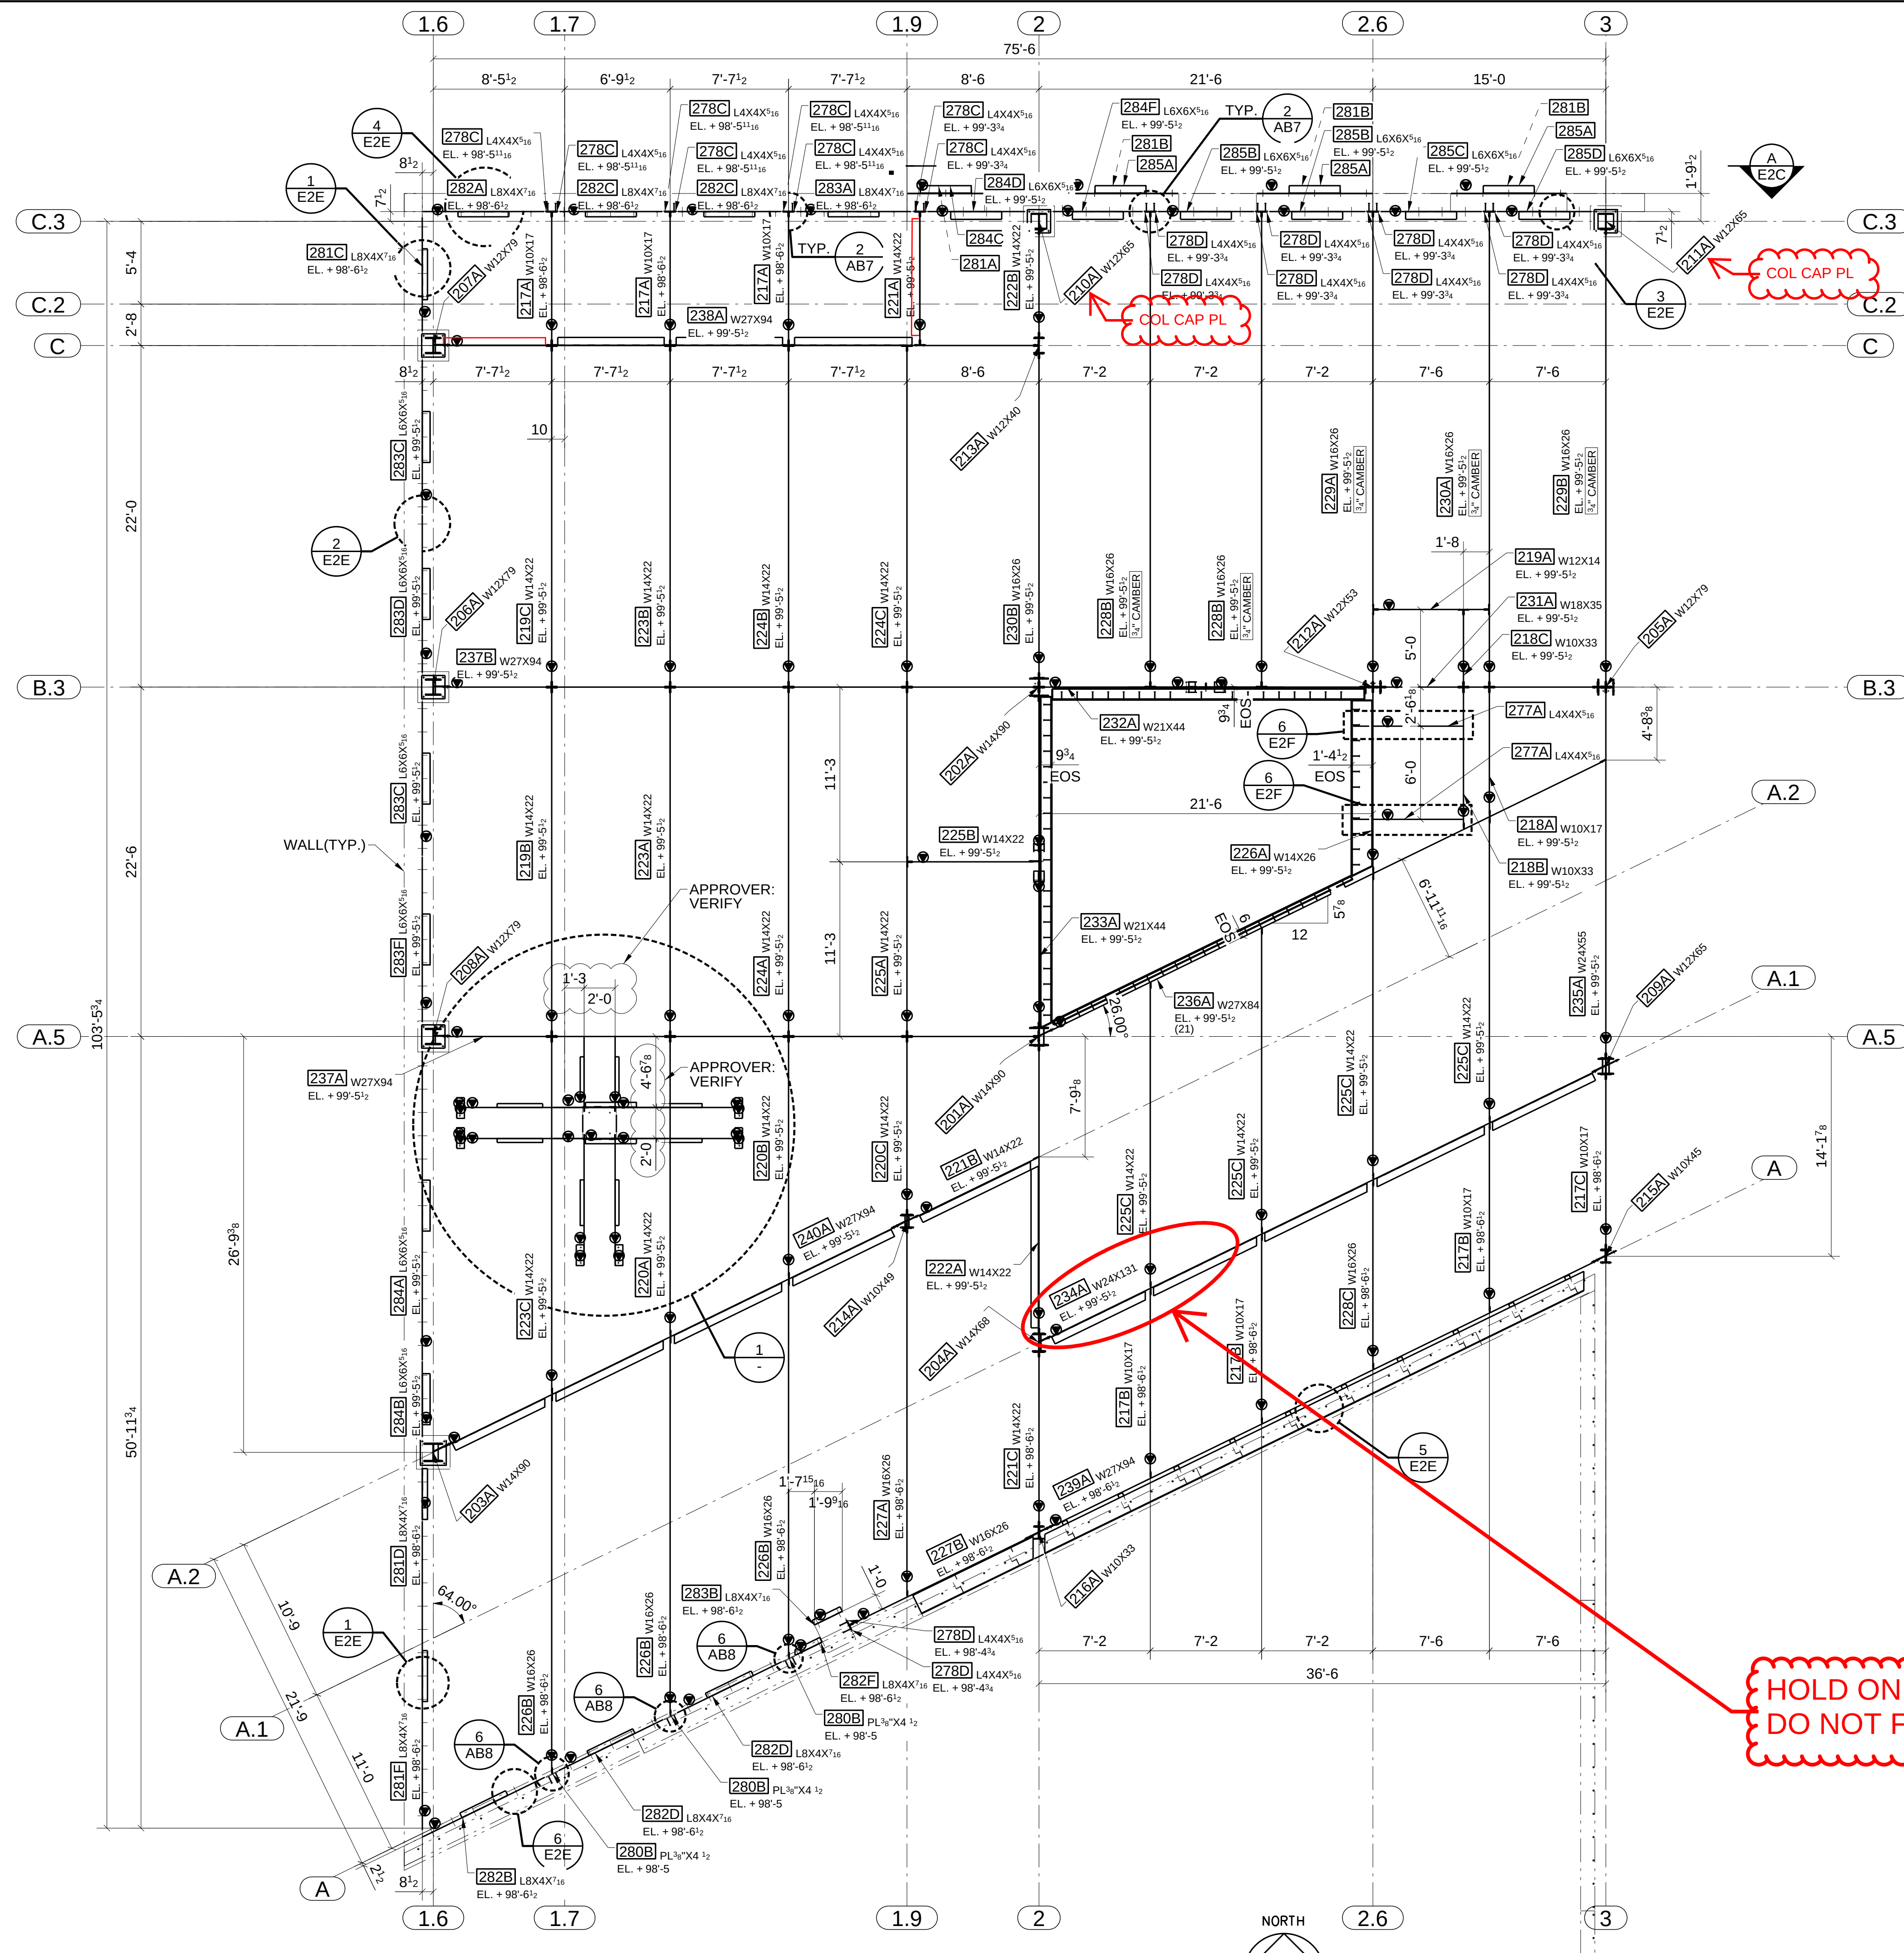


- NOTES:
- #1. (V) DENOTES FOR LOCATION OF SHIPPING MARK.
 - (M) INDICATES MOMENT CONNECTION.
 - (SLOPE 1:12) INDICATES DIRECTION OF SLOPE DOWNWARD.
 - (V) INDICATES VERTICAL BRACE.
 - #2. ALL ELEVATION SHOWN INDICATE MAIN PART TOP LEVEL.
 - #3. U.N.O. () LOCATE THE WEB OF BEAM AT SOUTH OR WEST SIDE OF SHEAR TAB.
 - #4. (X) BELOW THE PART MARK ON FRAMING PLANS INDICATES THE NUMBER OF HEADED STUD PER BENT PLATE TO BE FIELD WELD.

ATLAS IRON WORKS
ST. LOUIS, MO.



Project: WEBSTER UNIVERSITY INTERDISCIPLINARY SCIENCE BUILDING
Customer: PARIC CORPORATION
Owner: WEBSTER UNIVERSITY
Location: WEBSTER GROVES, MO 63119
Dwn: TLI Date: 05/23/2016 Ckd: LJ Date: 05/30/2016
Job No. A16013 BAT: DWG#: E2A

LEVEL 02 FLOOR FRAMING PLAN SEQ2
REF: S0103

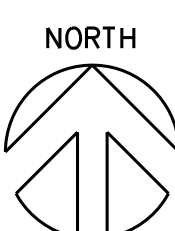


FOR APPROVAL

05/30/16

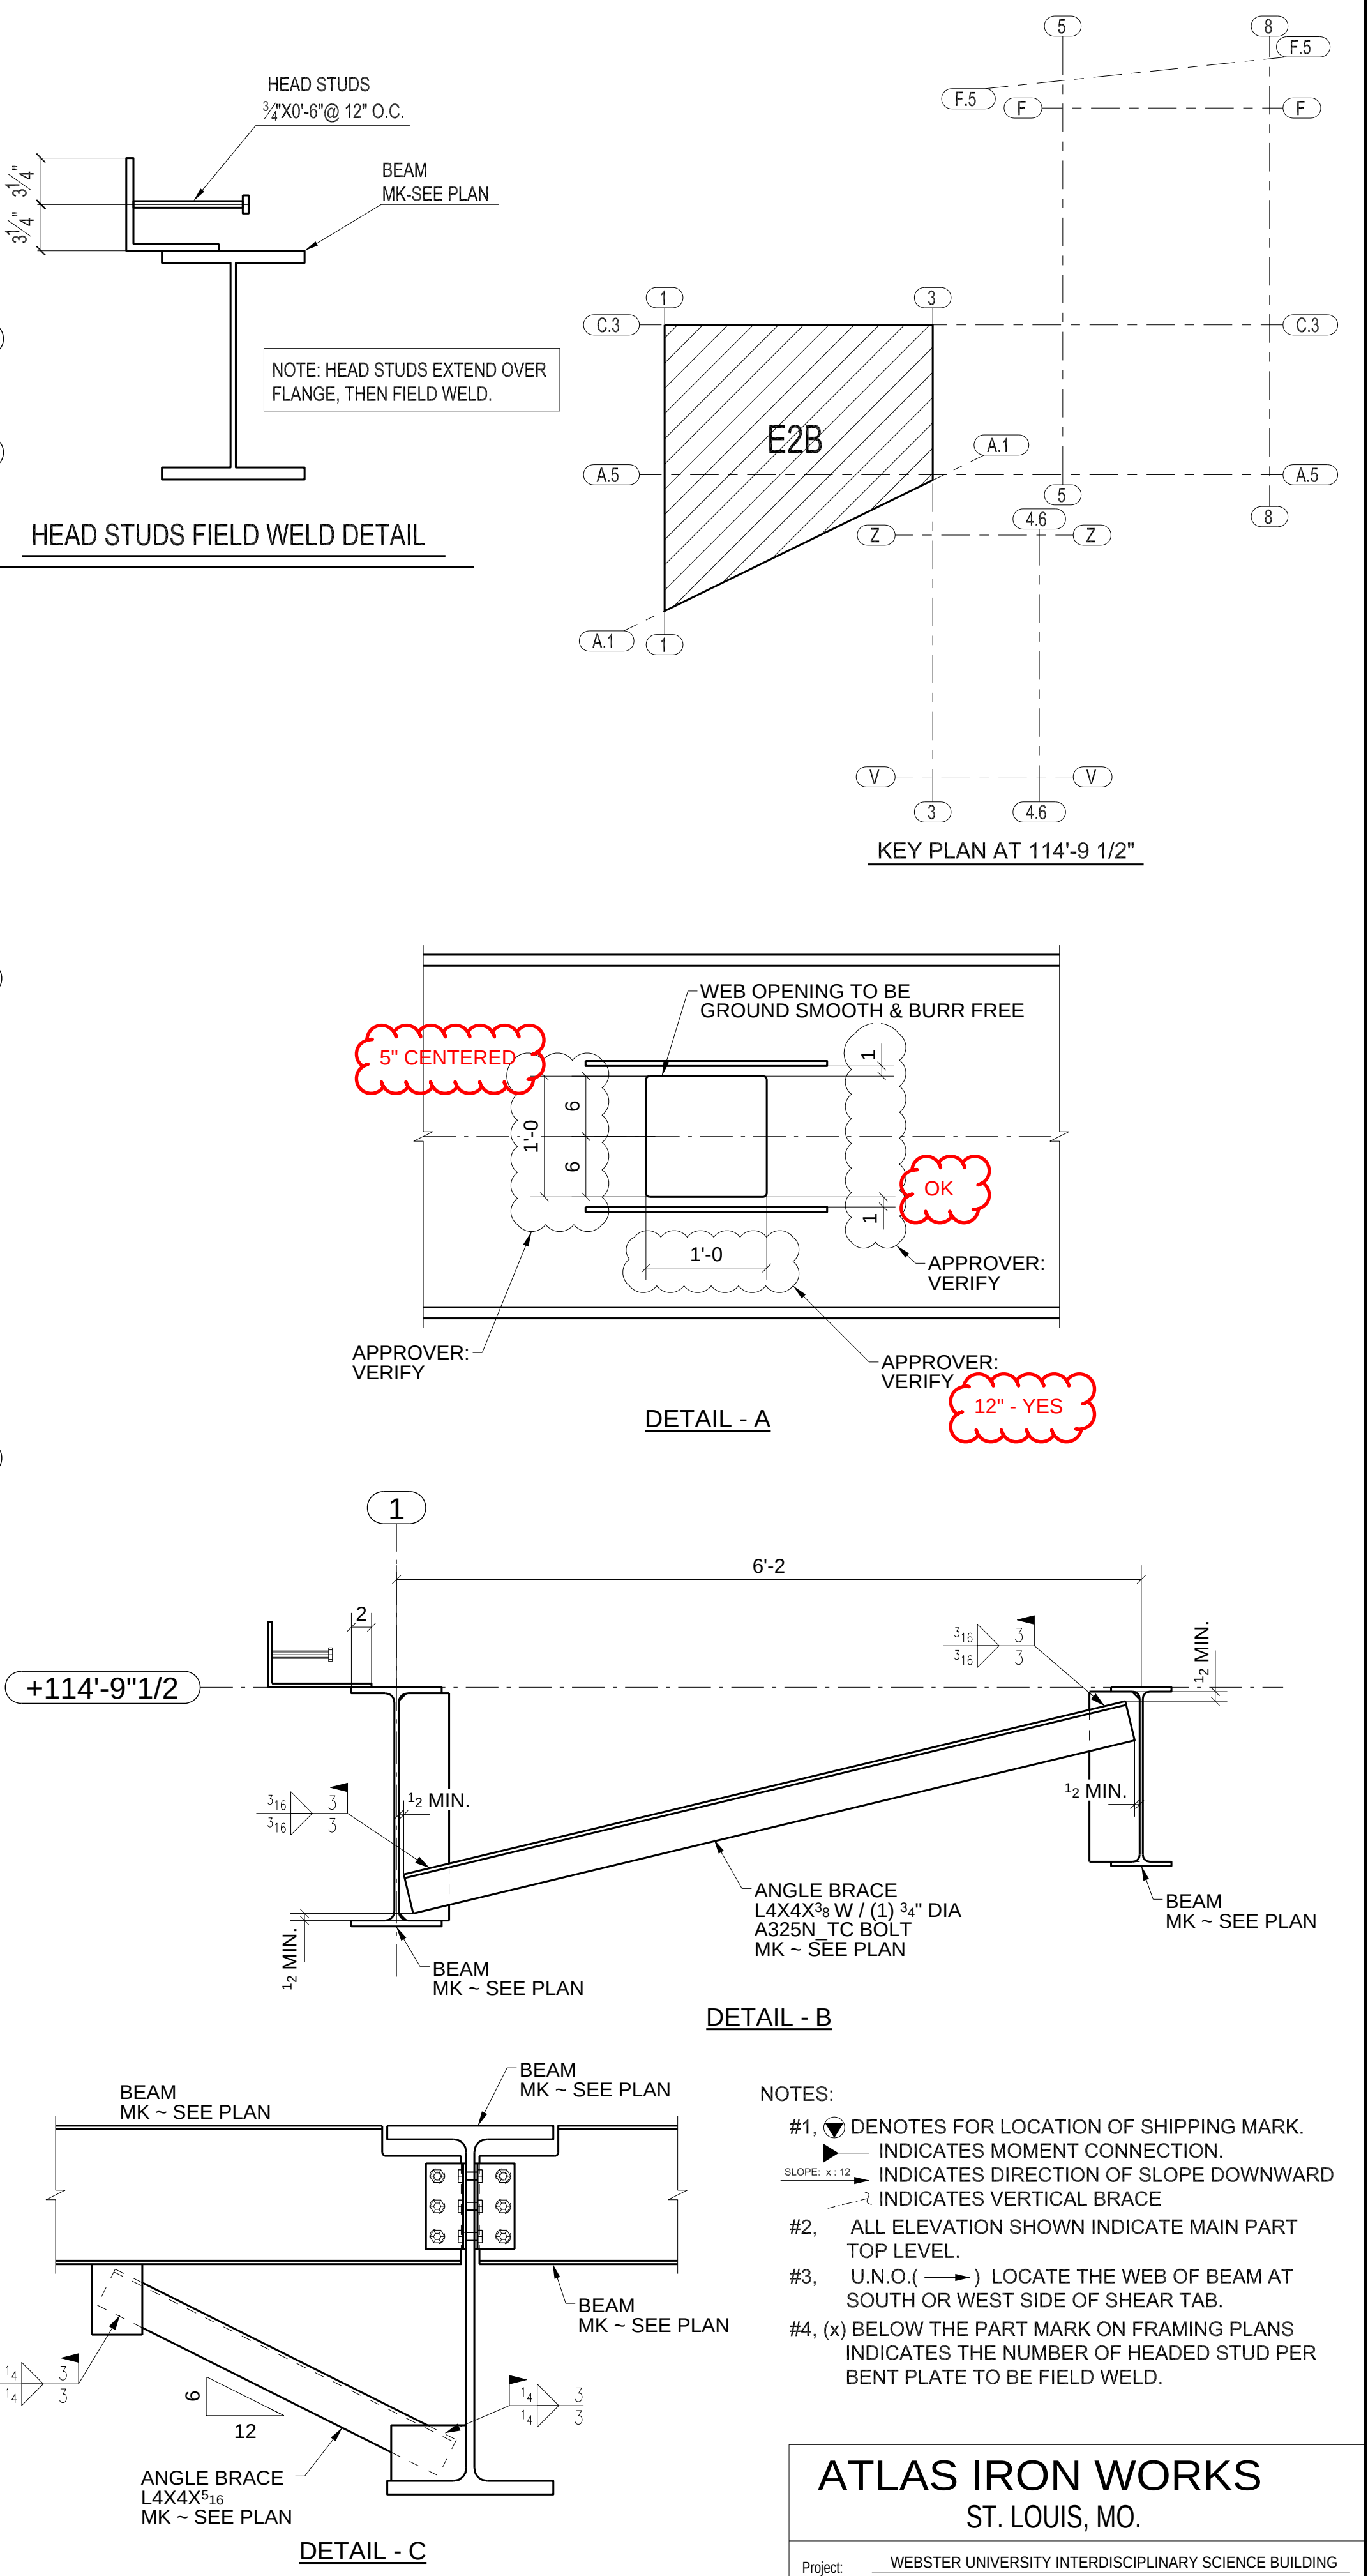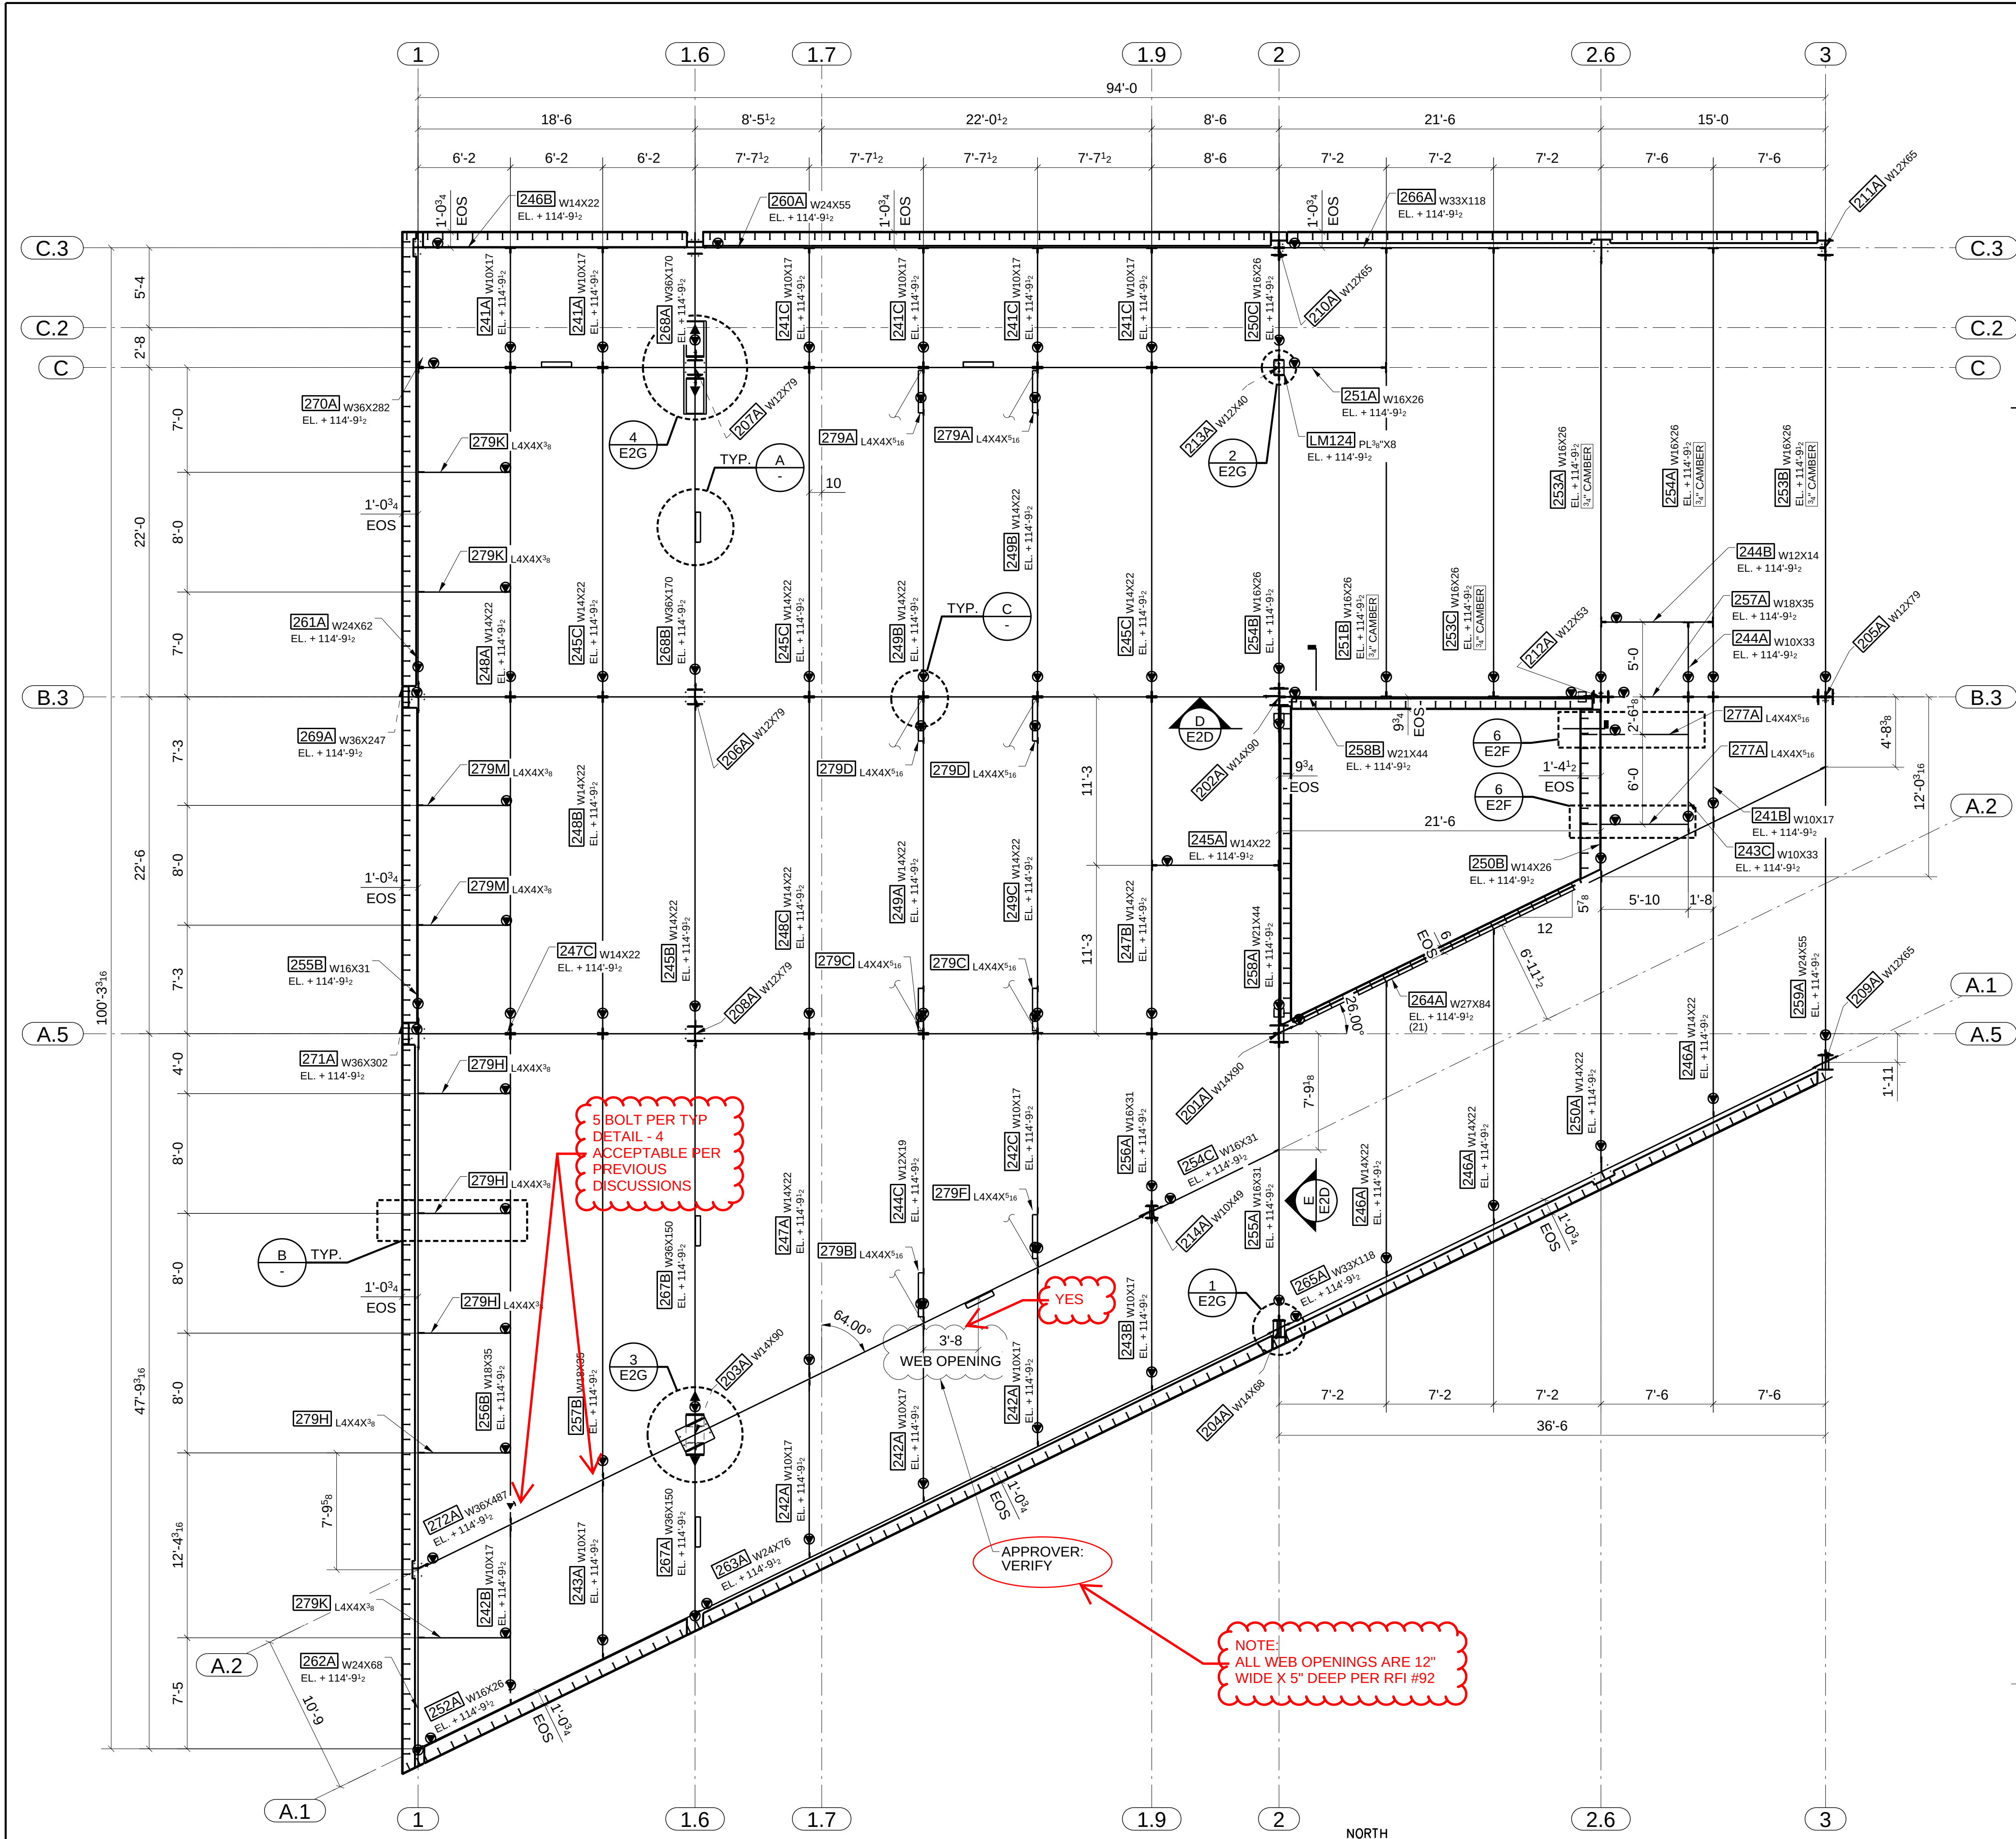

LEVEL 03 FLOOR FRAMING PLAN SEQ2
REF: S0104

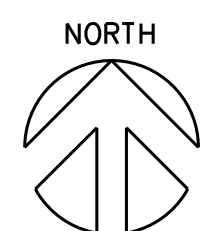

- NOTES:
- #1, ▼ DENOTES FOR LOCATION OF SHIPPING MARK.
 - INDICATES MOMENT CONNECTION.
 - ◄ INDICATES DIRECTION OF SLOPE DOWNWARD
 - INDICATES VERTICAL BRACE
 - #2, ALL ELEVATION SHOWN INDICATE MAIN PART TOP LEVEL.
 - #3, U.N.O.(—) LOCATE THE WEB OF BEAM AT SOUTH OR WEST SIDE OF SHEAR TAB.
 - #4, (x) BELOW THE PART MARK ON FRAMING PLANS INDICATES THE NUMBER OF HEADED STUD PER BENT PLATE TO BE FIELD WELD.

ATLAS IRON WORKS
ST. LOUIS, MO.

Project: WEBSTER UNIVERSITY INTERDISCIPLINARY SCIENCE BUILDING
Customer: PARIC CORPORATION
Owner: WEBSTER UNIVERSITY
Location: WEBSTER GUOVES, MO 63119
Dwn: TLI Date: 05/23/2016 Ckd: LJ Date: 05/30/2016
Job No. A16013 BAT: DWG#: E2B

FOR APPROVAL

05/30/16

William Tao & Associates, Inc.
MEP/FP Engineer
7955 Manchester Road, Suite 125
St. Louis, MO 63143
314-884-7600

David Mason & Associates, Inc.
Structural & Civil Engineer
800 South Vandeventer Avenue
St. Louis, MO 63110
314.534.1053

Faith Group
Technology
3101 S. Hanley Rd. Suite 100
St. Louis, MO 63143
314.991.2229

Kuhnmann Leavitt, Inc.
Environmental Graphics & Signage
7400 Pershing Ave.
St. Louis, MO 63130
314.725.6616


KWA Architects
Architecture
9721 Litzinger Road
St. Louis, MO 63124
314.962.2560

Spellman Brady & Company
Interior Designer
8251 Maryland Avenue, Suite 300
St. Louis, MO 63105
314.862.0070

SWT Design
Landscape Architect
7722 Big Bend Blvd
St. Louis, MO 63119
314.644.5700

Webb Engineering Services, Inc.
Planning & Fire Protection
1400 S. 3rd Street, Suite 201
St. Louis, MO 63104
314.588.0600

ISSUED FOR CONSTRUCTION (BP1) 15 JAN 2016
No. Description Date

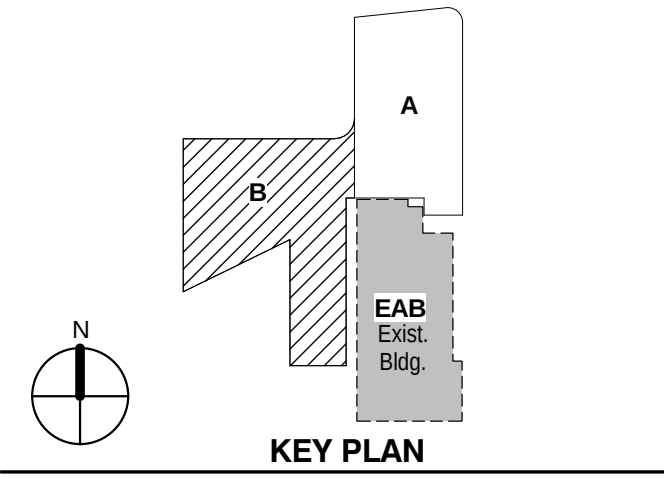


KEY PLAN

EXTERIOR - LEVEL 01
AREA B FLOOR PLAN



Project No.: 04561.01 Checked by:

A0101.EB

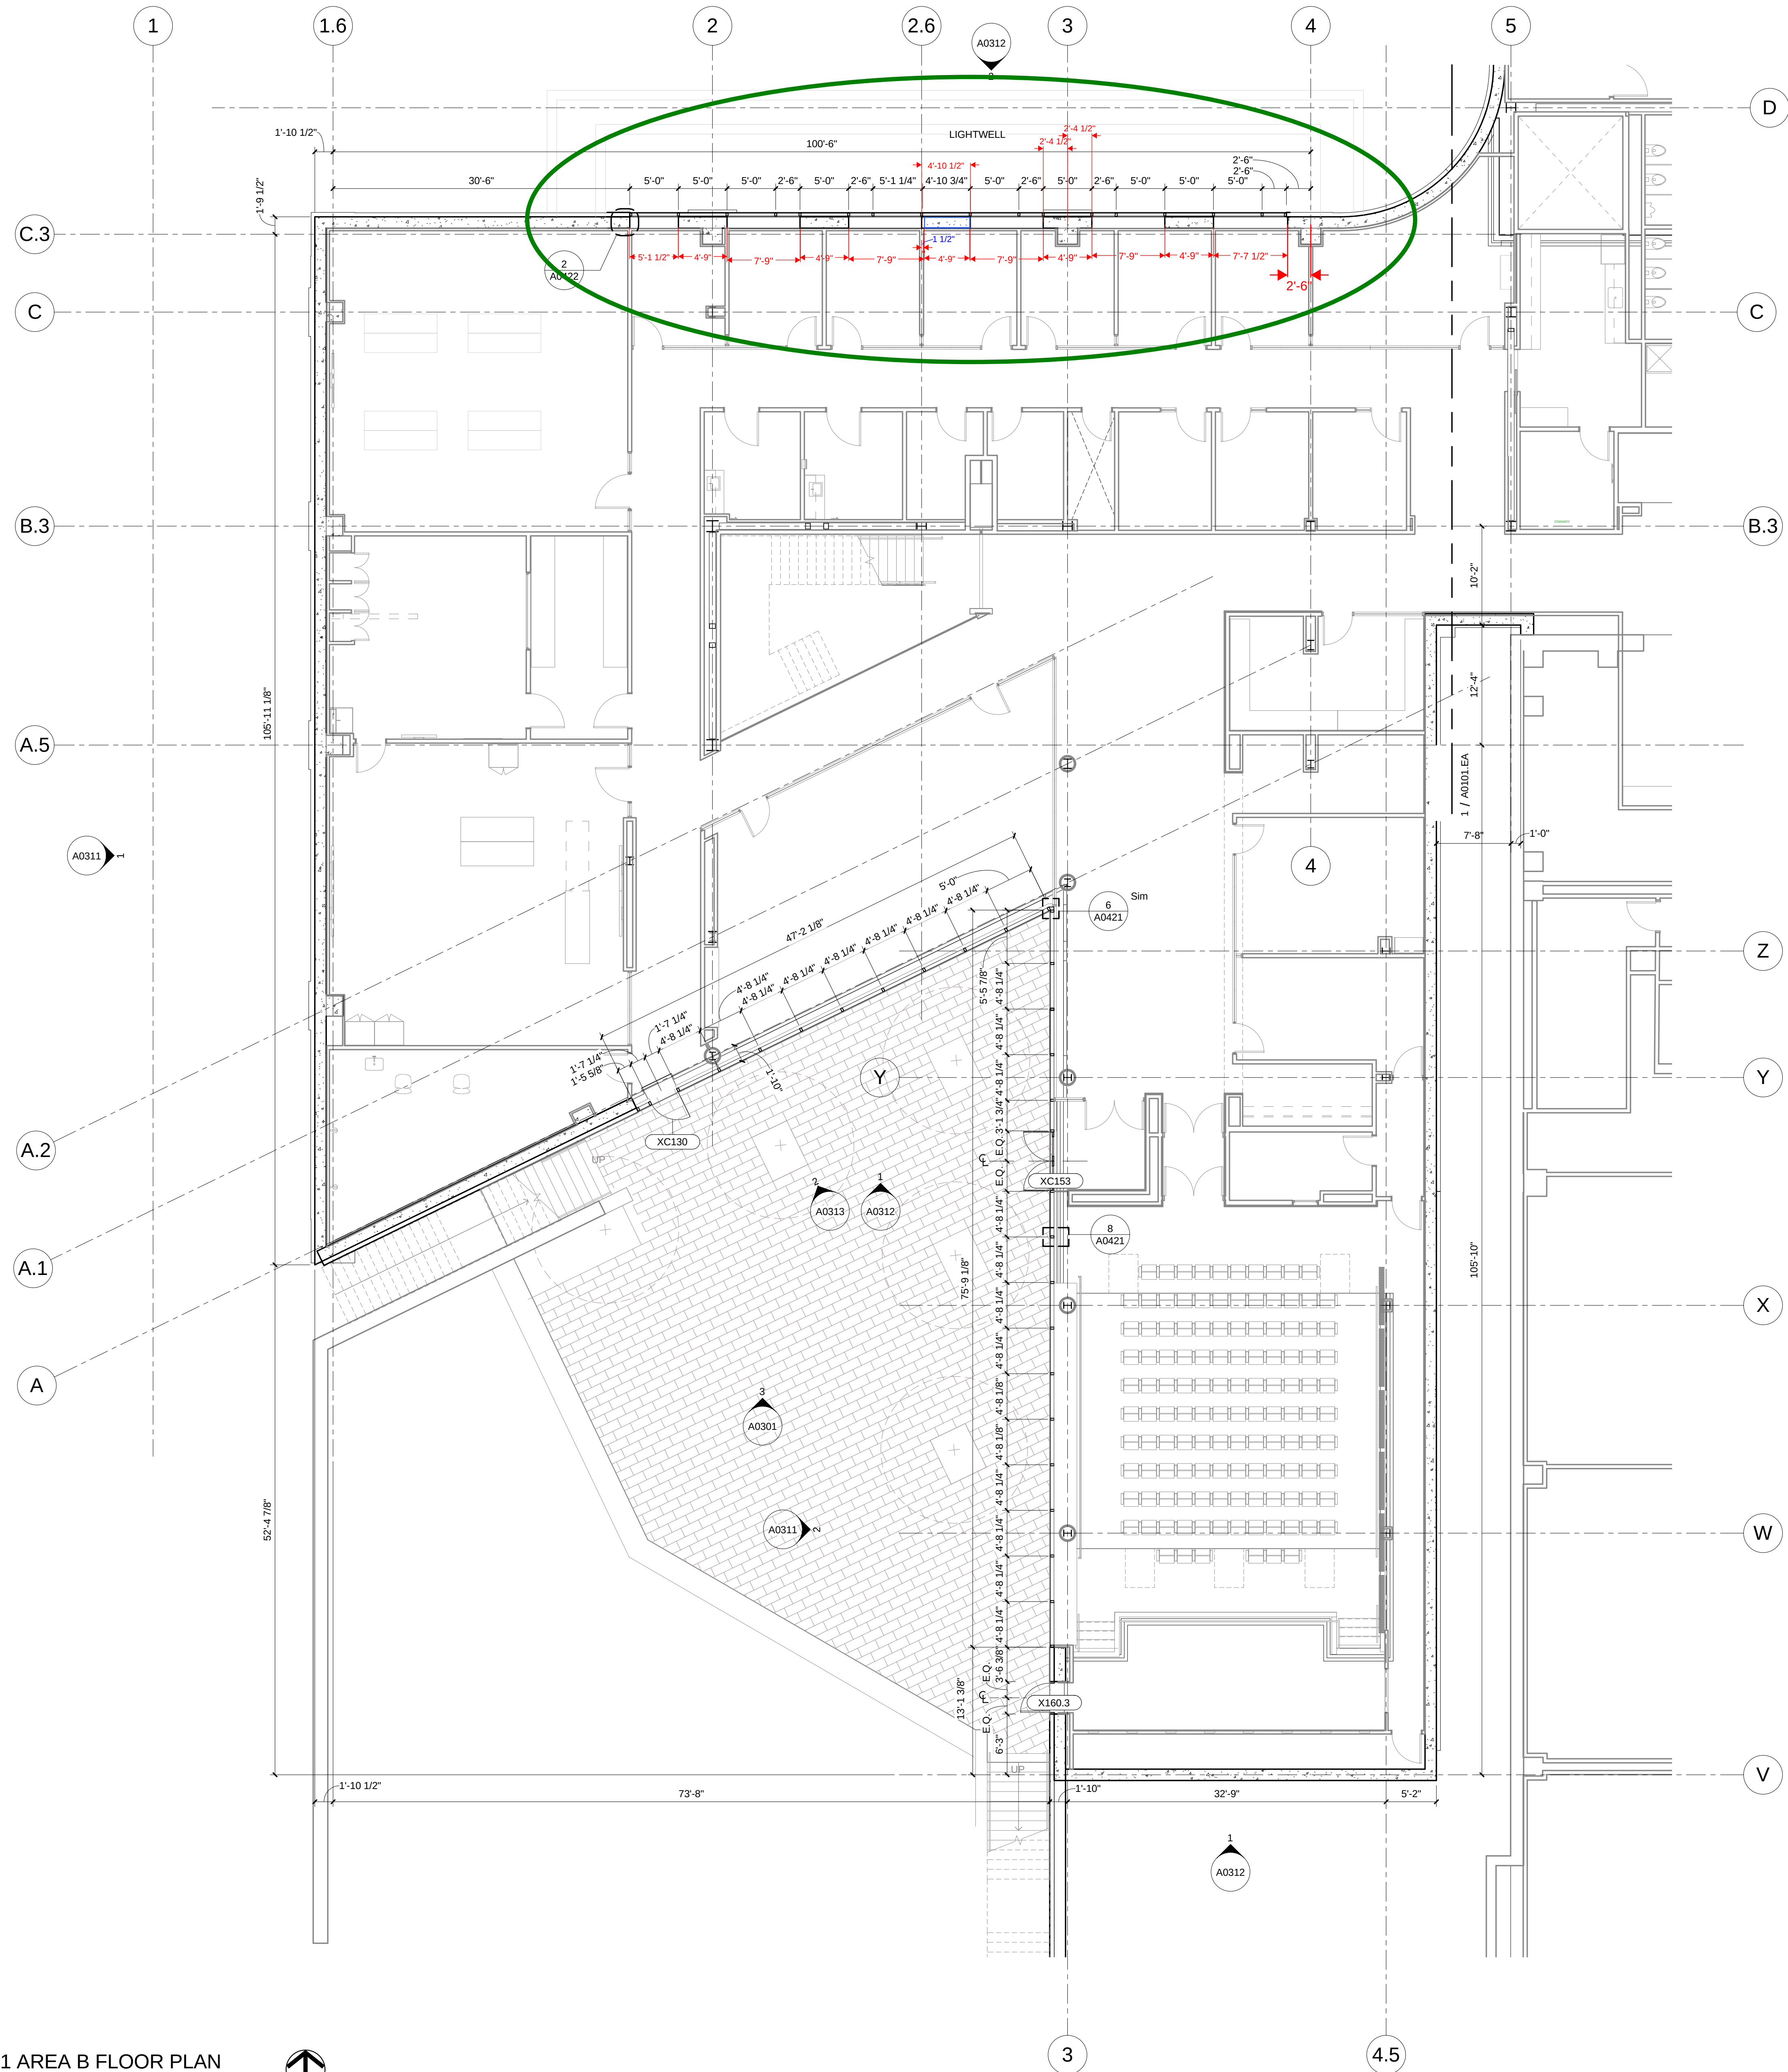

1 LEVEL 01 AREA B FLOOR PLAN
1/8" = 1'-0"









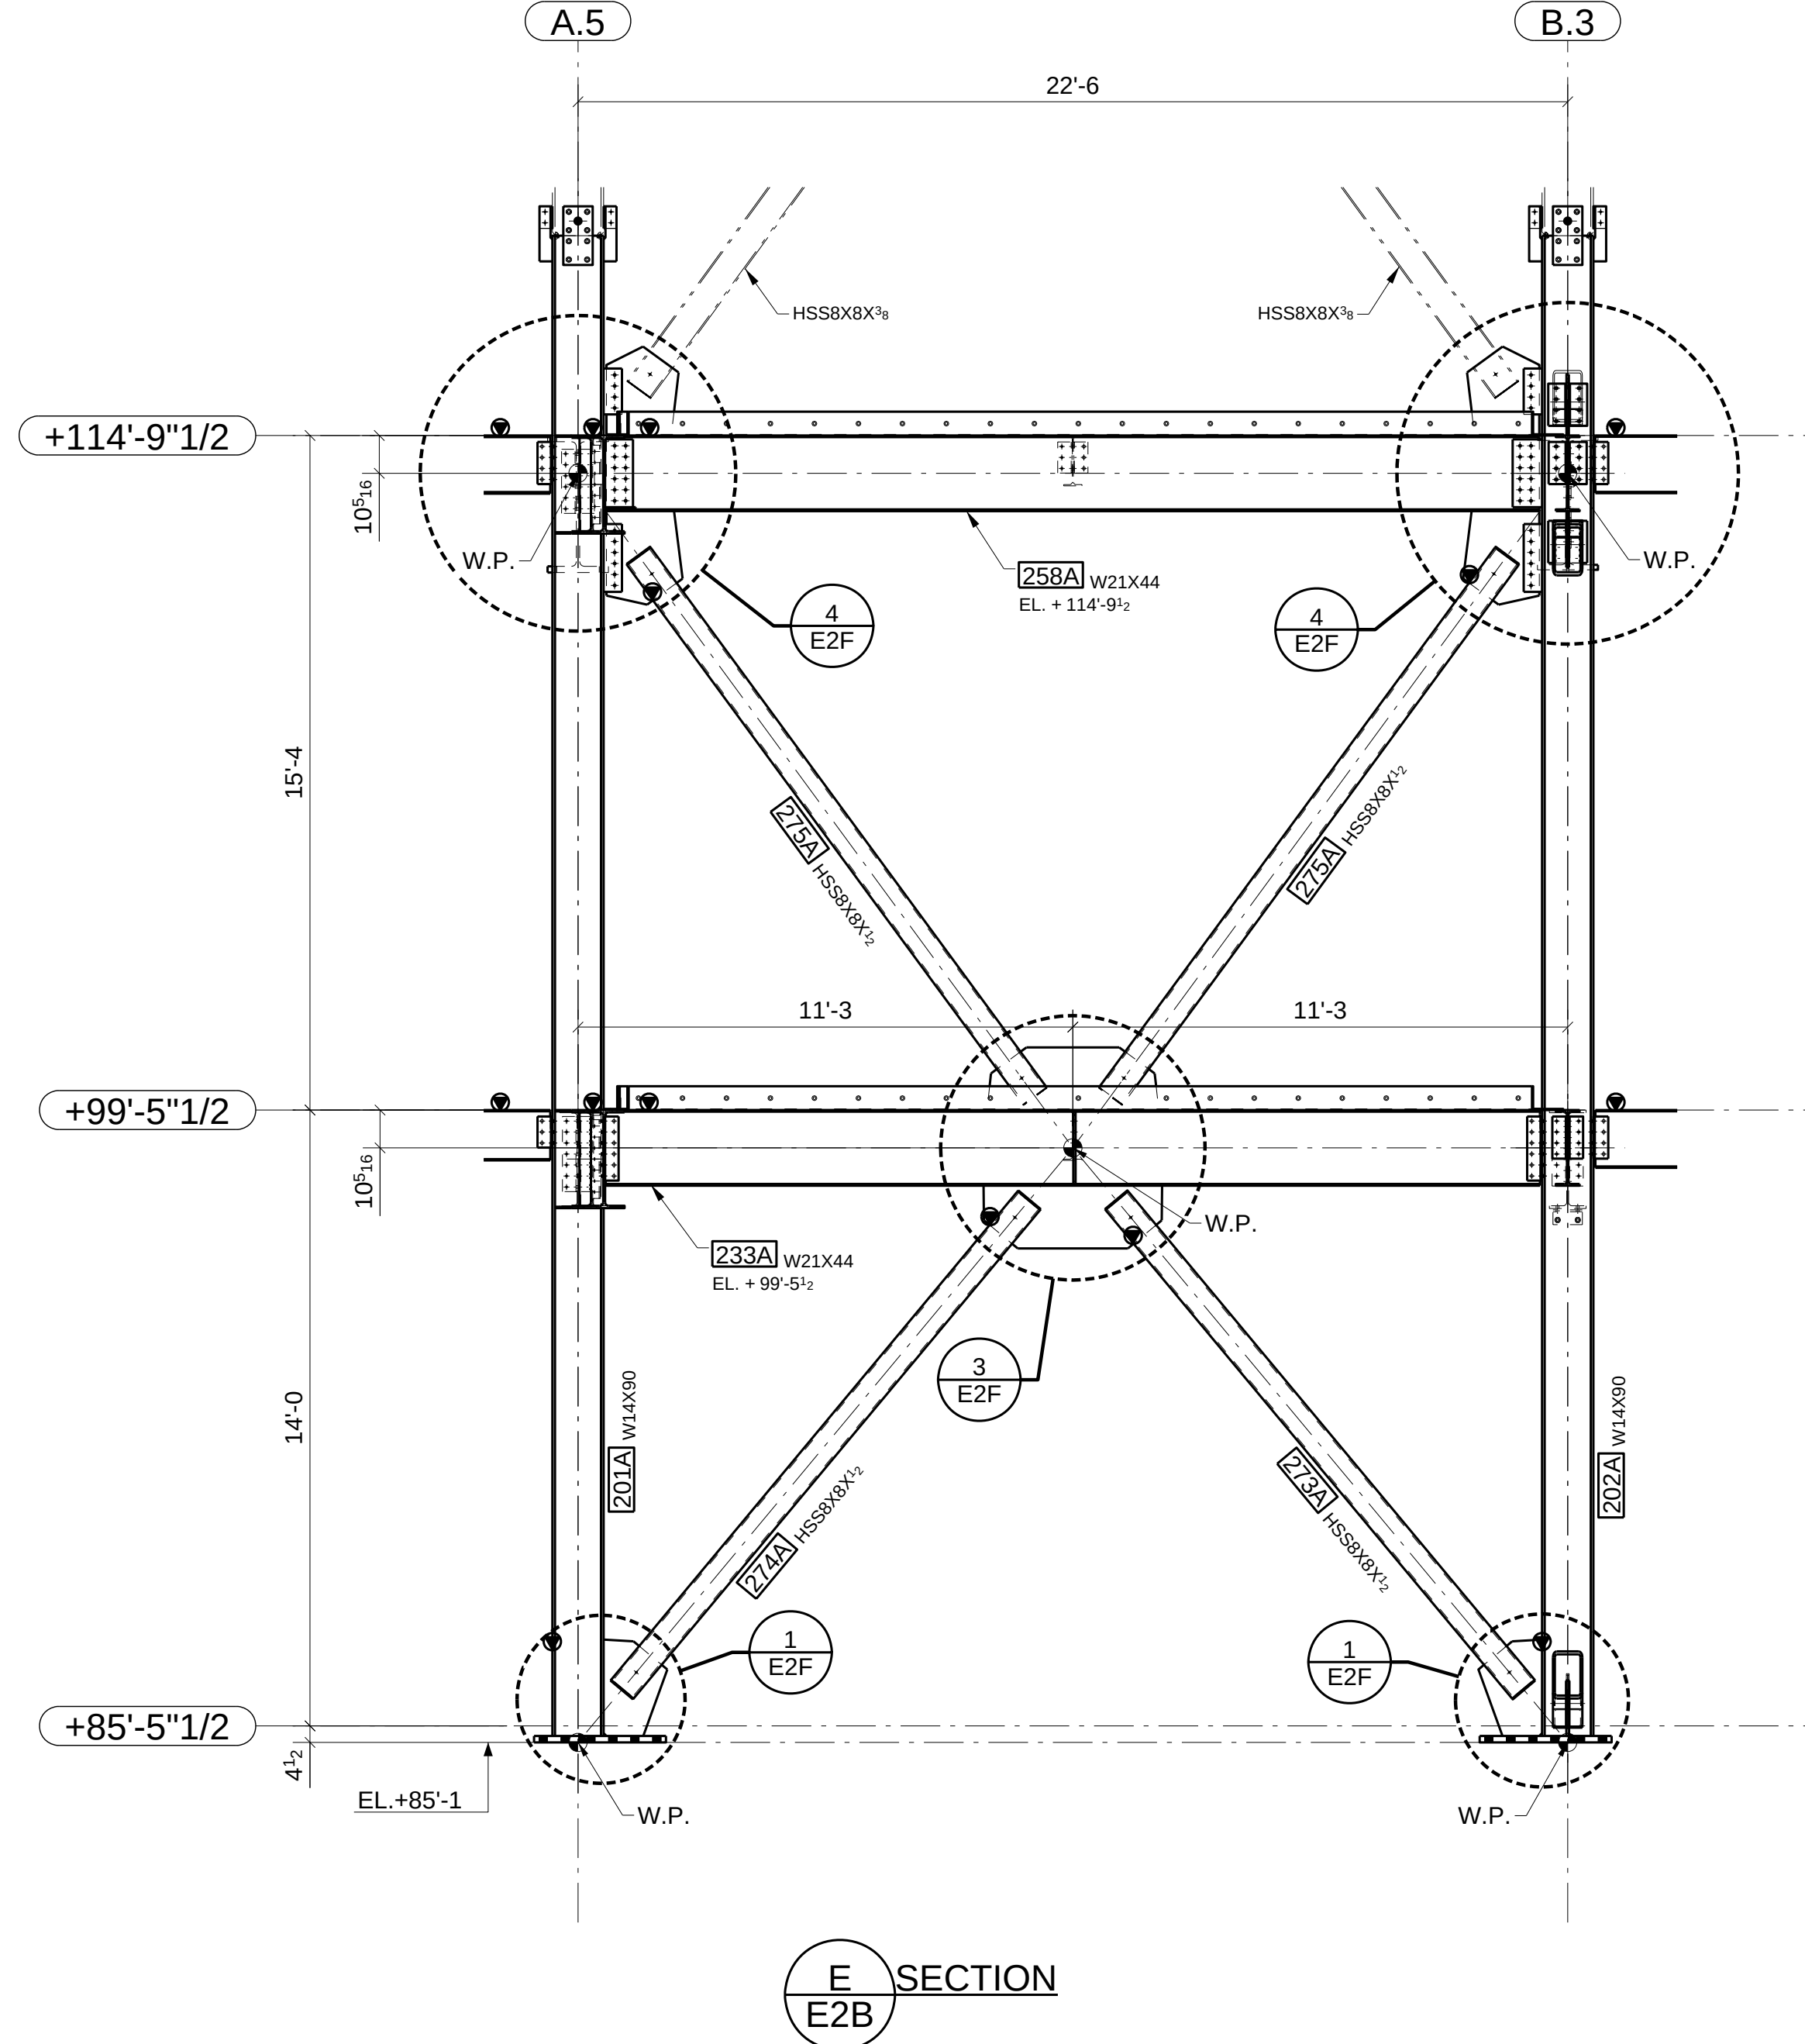
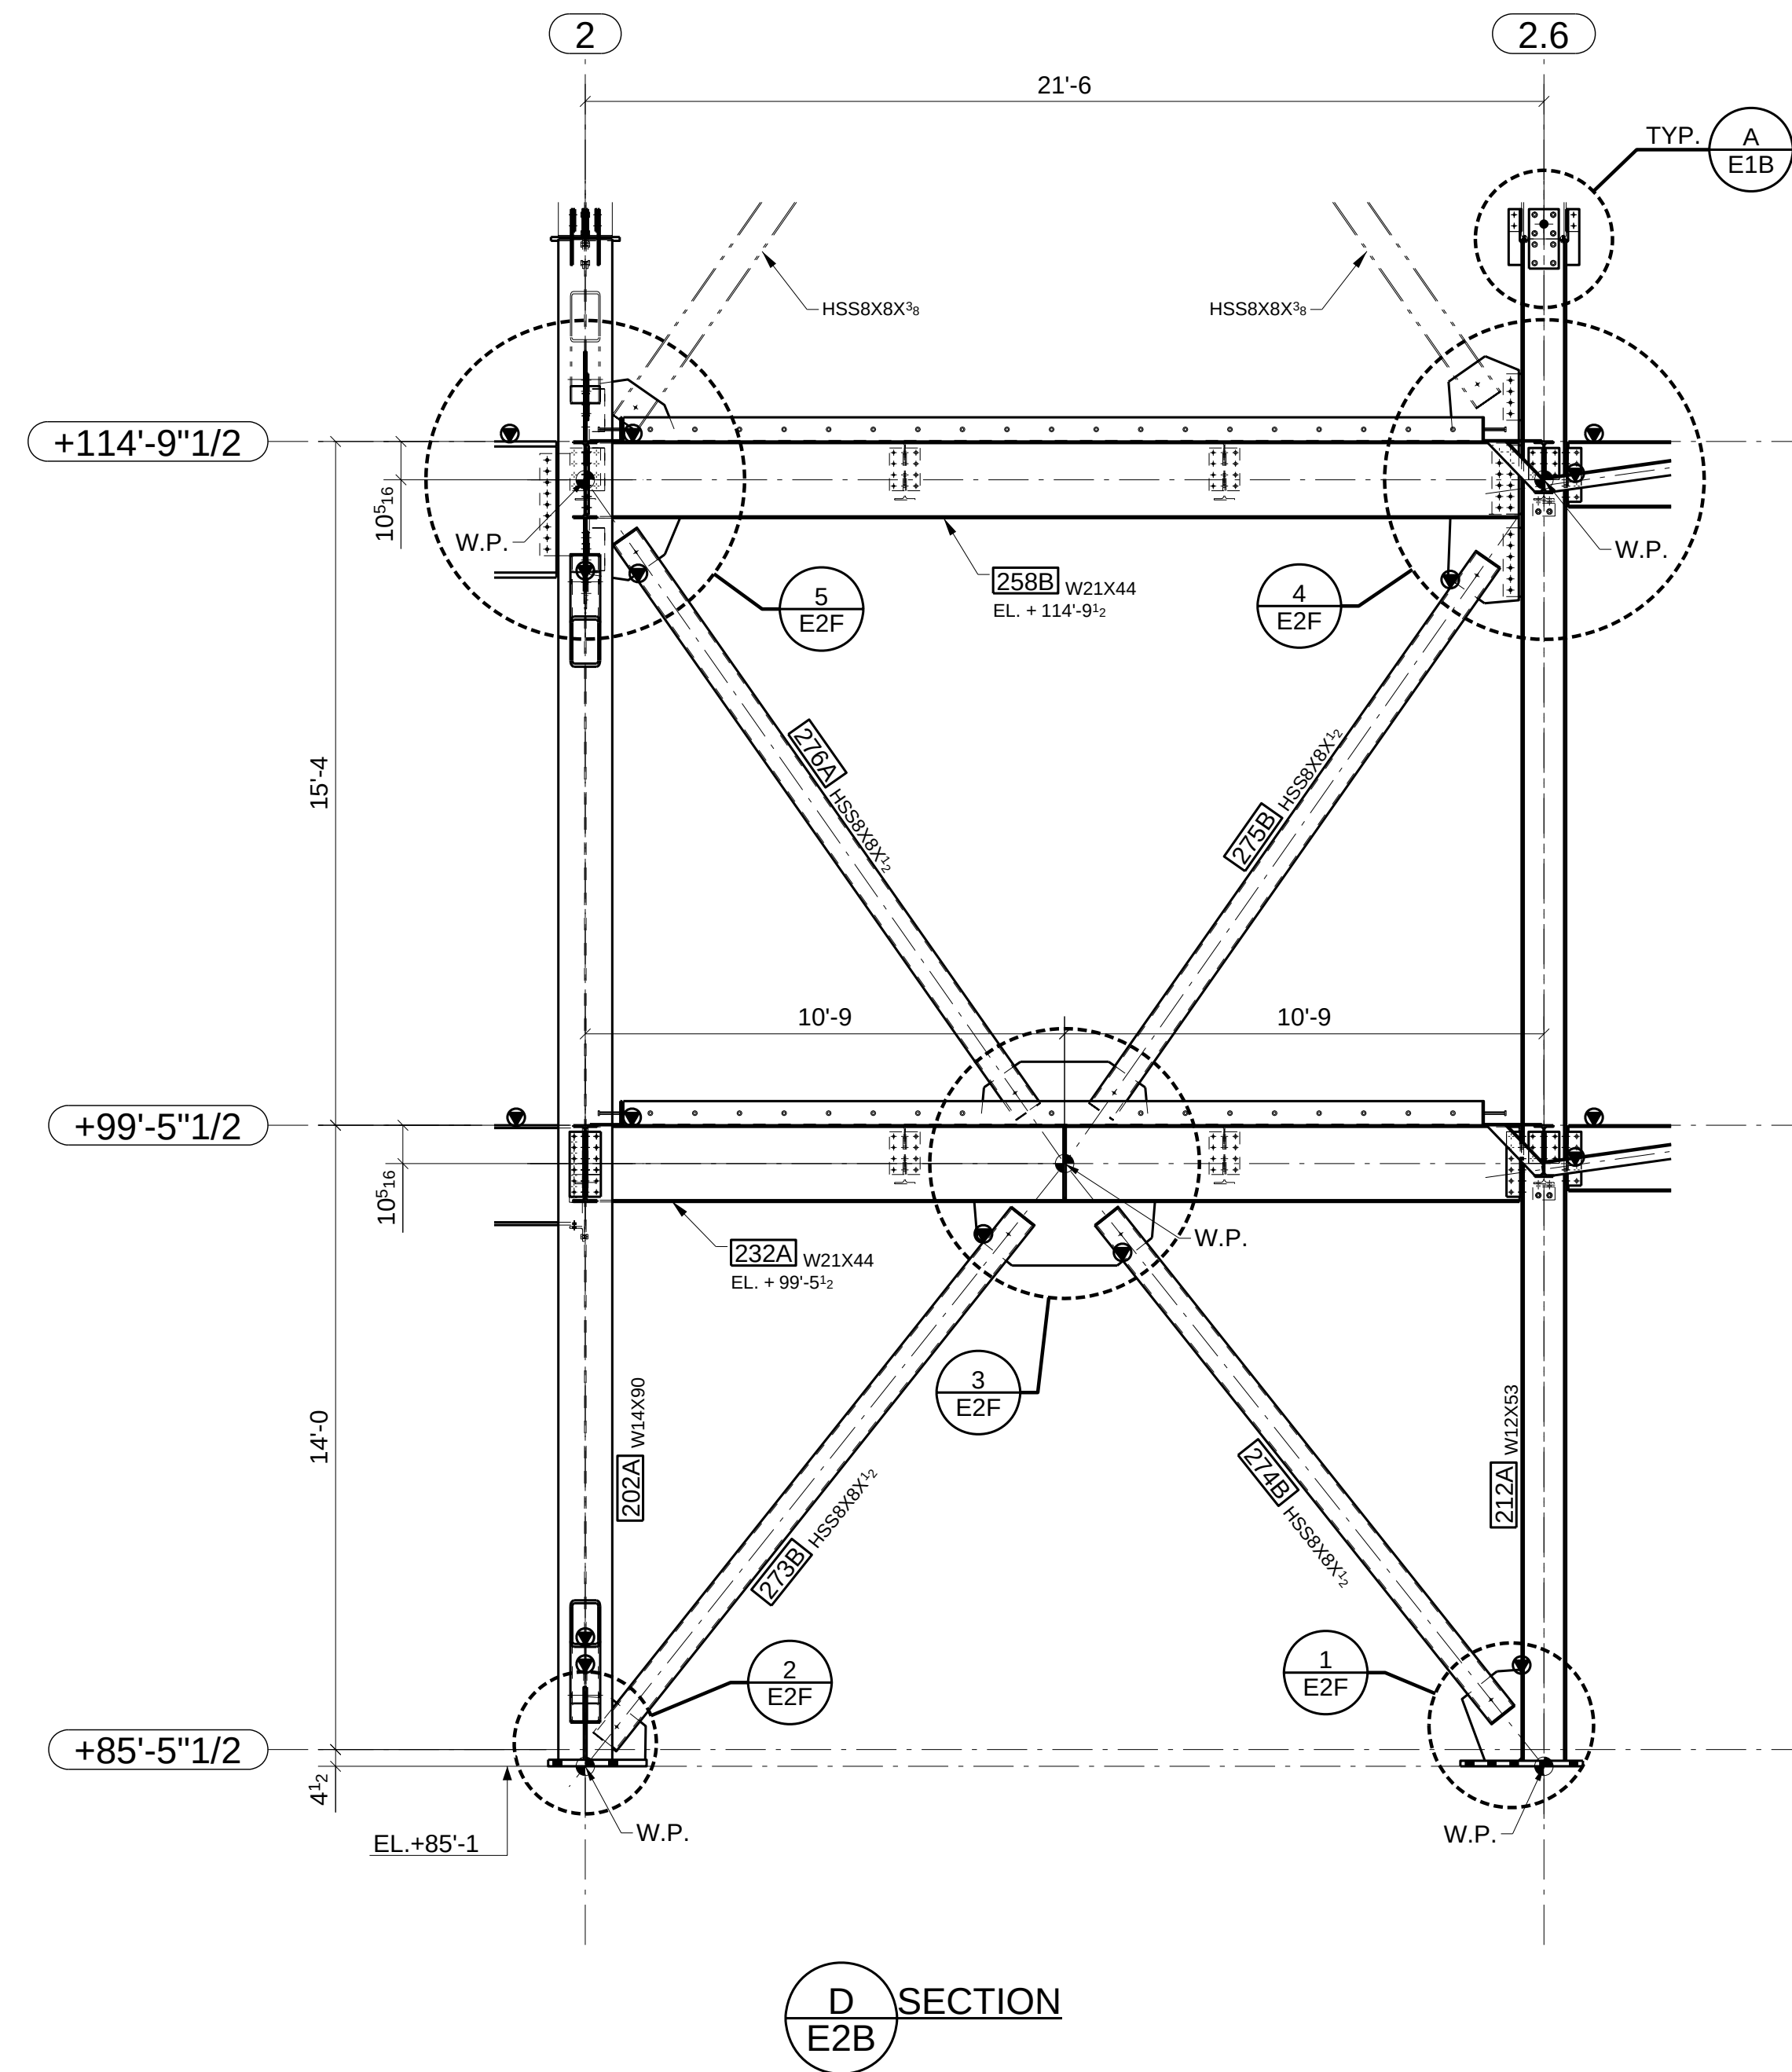


ATLAS IRON WORKS ST. LOUIS, MO.

Project: WEBSTER UNIVERSITY INTERDISCIPLINARY SCIENCE BUILDING
 Customer: PARIC CORPORATION
 Owner: WEBSTER UNIVERSITY
 Location: WEBSTER GUOVES, MO 63119
 Dwn: TLI Date: 05/24/2016 Ckd: LJ Date: 05/30/2016
 Job No. A16013 BAT: DWG#: E2D

FOR APPROVAL

05/30/16

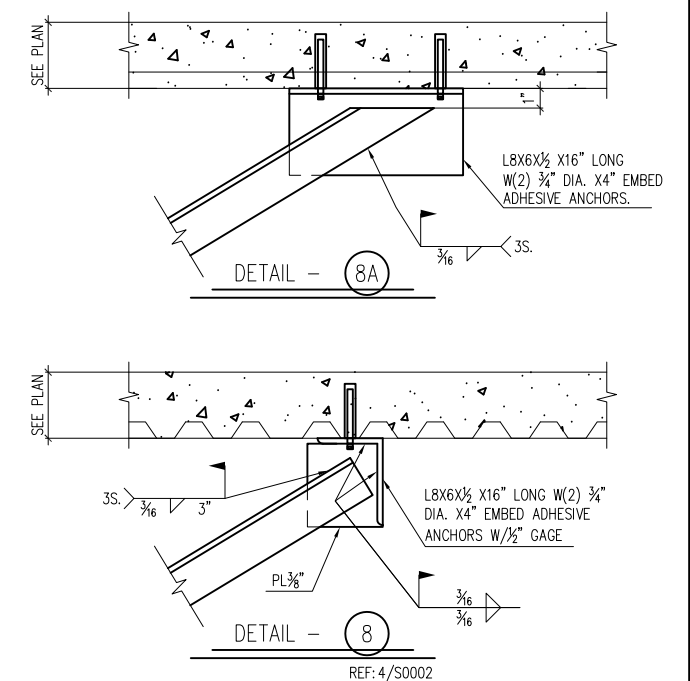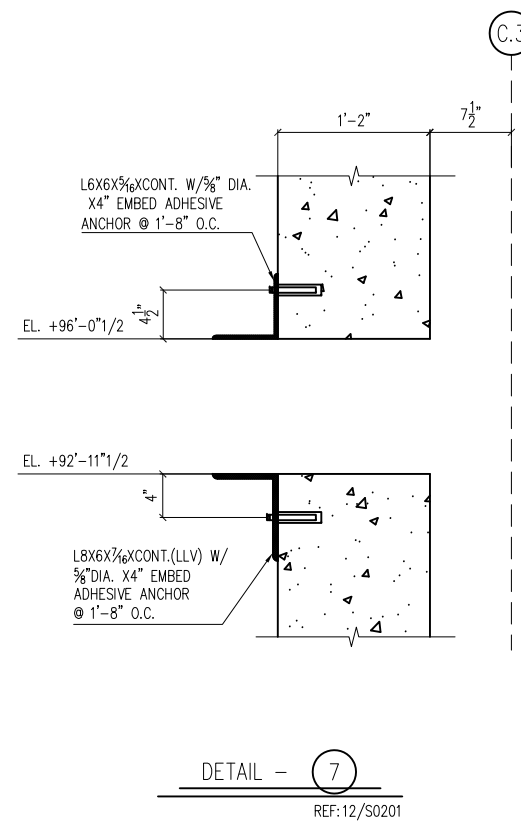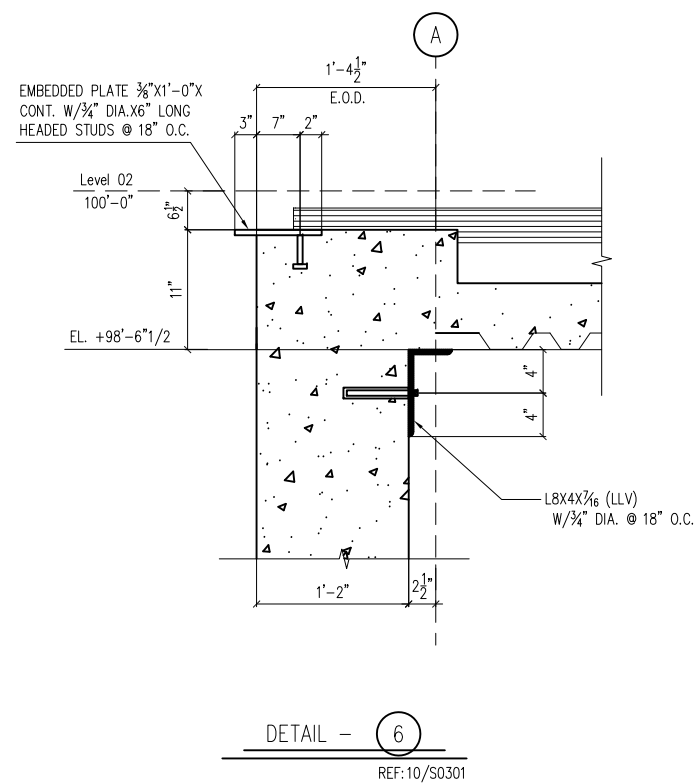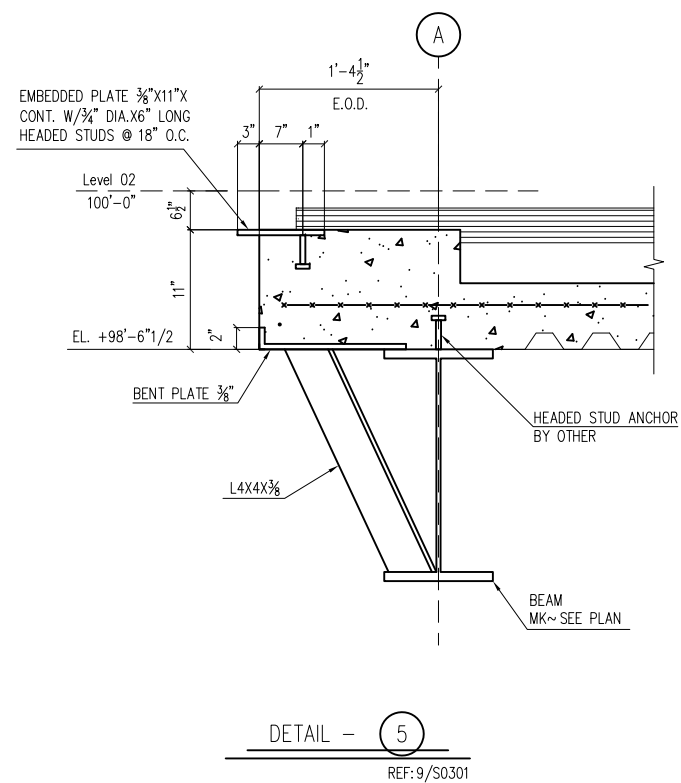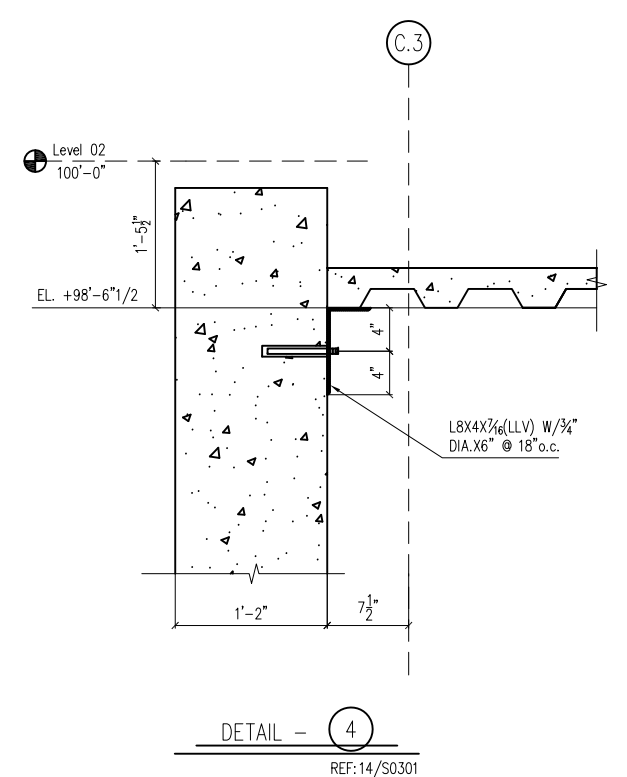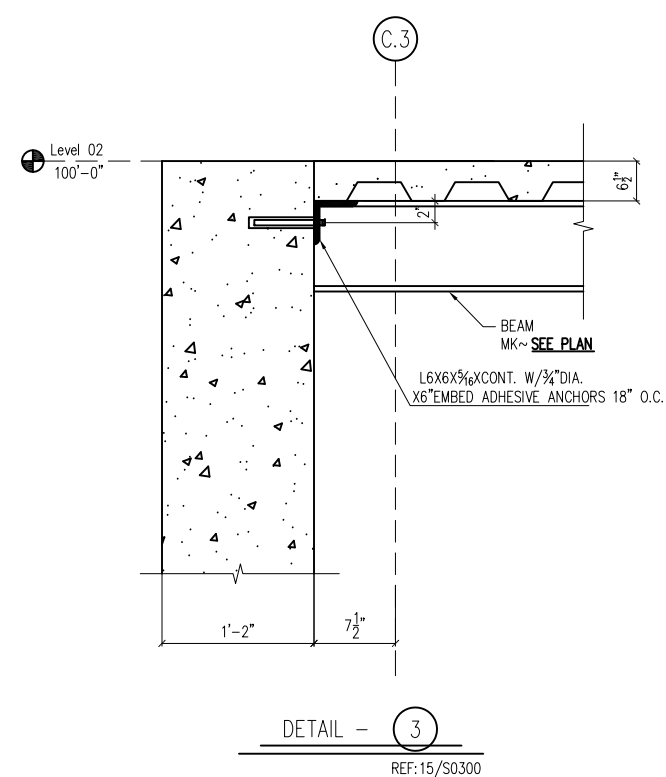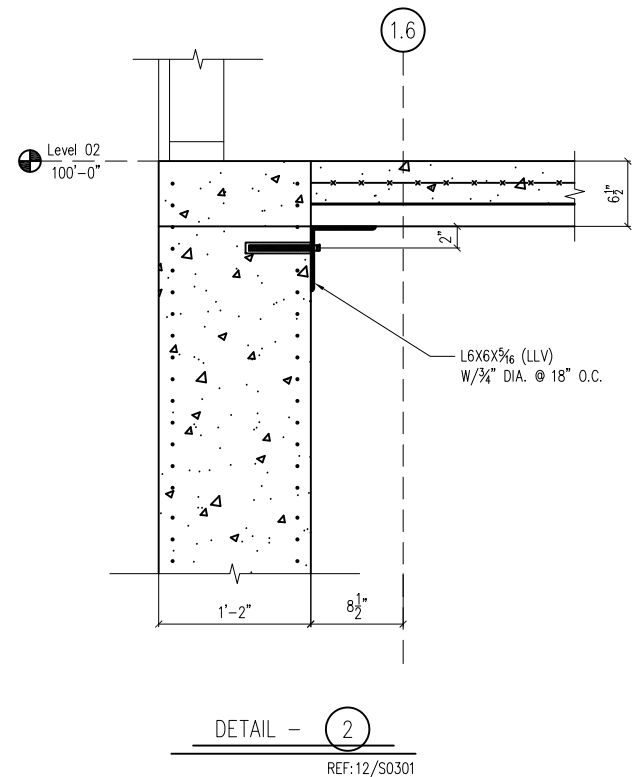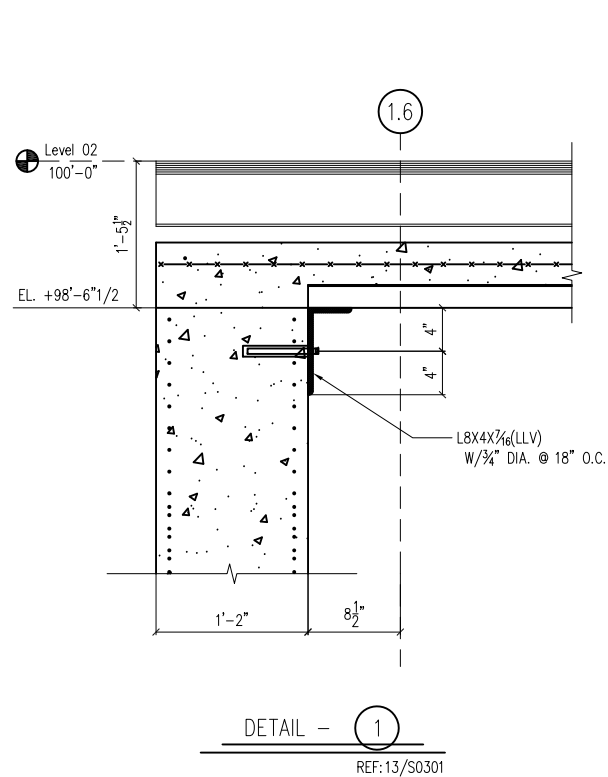


ATLAS IRON WORKS ST. LOUIS, MO.

Project: WEBSTER UNIVERSITY INTERDISCIPLINARY SCIENCE BUILDING
Customer: PARIC CORPORATION
Owner: WEBSTER UNIVERSITY
Location: WEBSTER GUOVES, MO. 63119
Dwn: ZZ Date: 05/30/16 Ckd: LJ Date: 05/30/16
Job No. A16013 BAT: DWG#: E2E


FOR APPROVAL

05-30-16


SCHEDULE 1	
LOCATION	WELD LENGTH
GRID B.3/2-2.6	12"
GRID A.5-B.3/2	12"

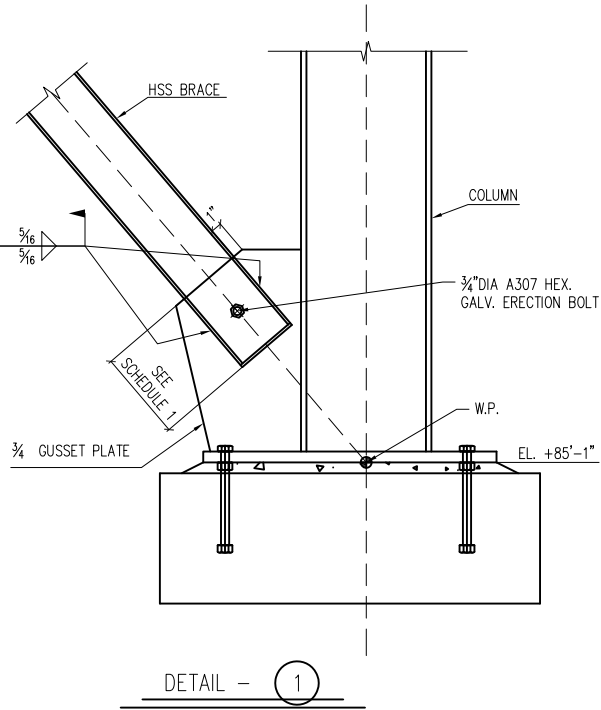


SCHEDULE 2	
LOCATION	WELD LENGTH
GRID B.3/2-2.6	12"

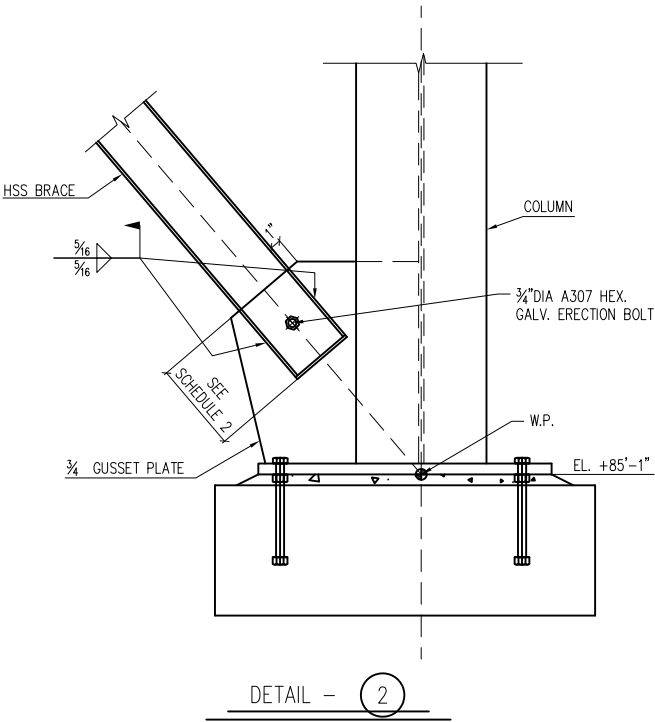



SCHEDULE 3	
LOCATION	WELD LENGTH
GRID B.3/2-2.6	12"
GRID A.5-B.3/2	12"

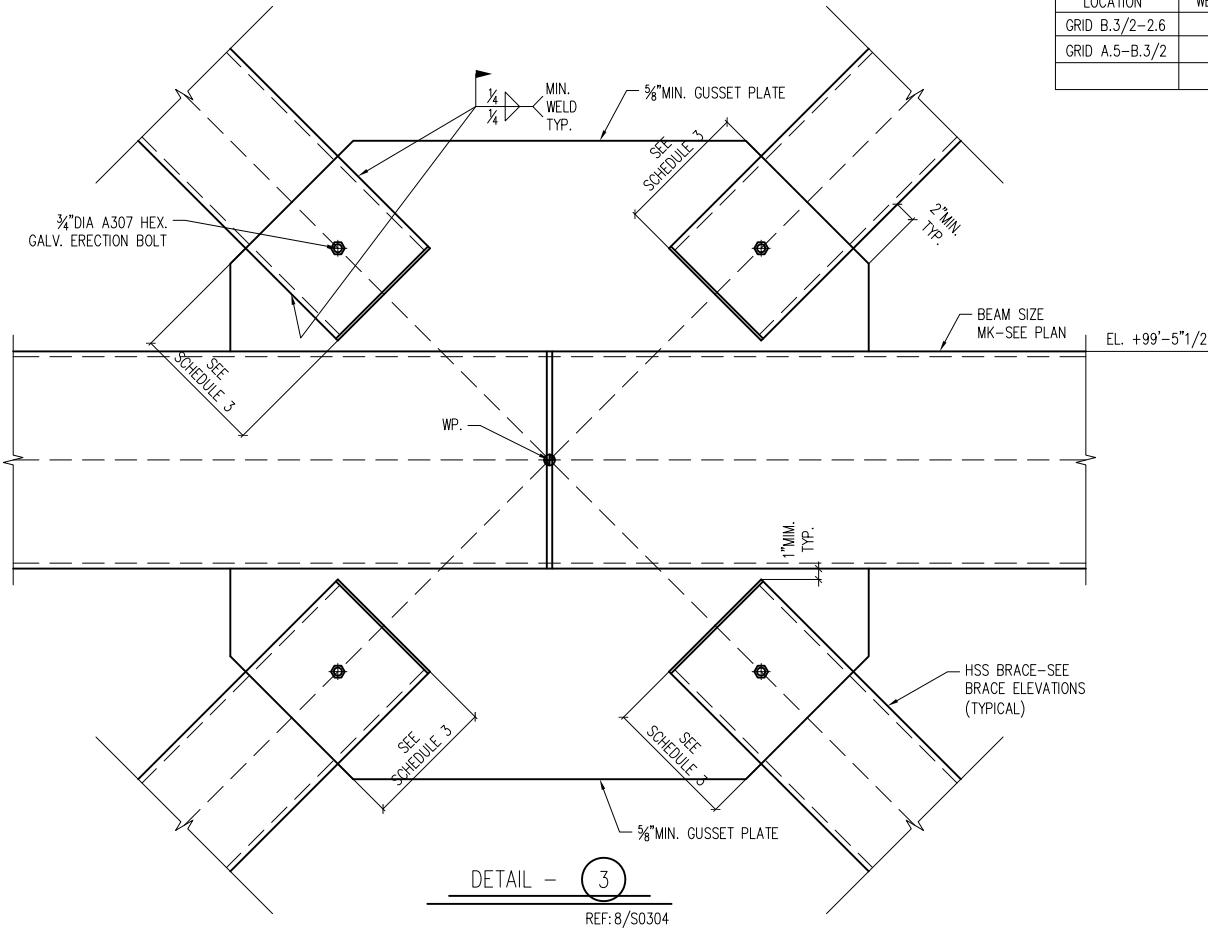

SCHEDULE 4	
LOCATION	WELD LENGTH
GRID B.3/2-2.6	12"
GRID A.5-B.3/2	12"

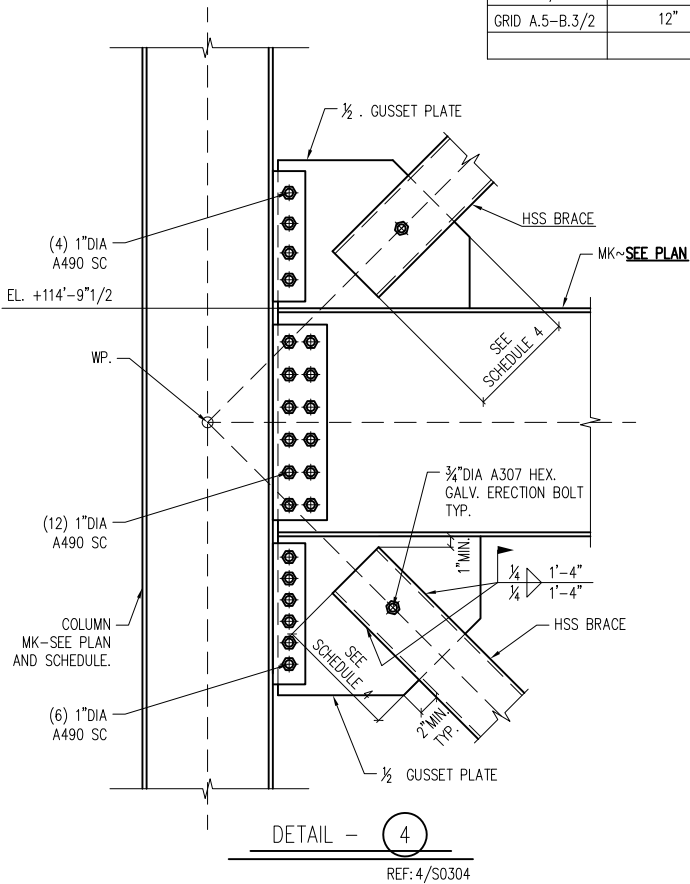

SCHEDULE 5	
LOCATION	WELD LENGTH
GRID B.3/2-2.6	12"

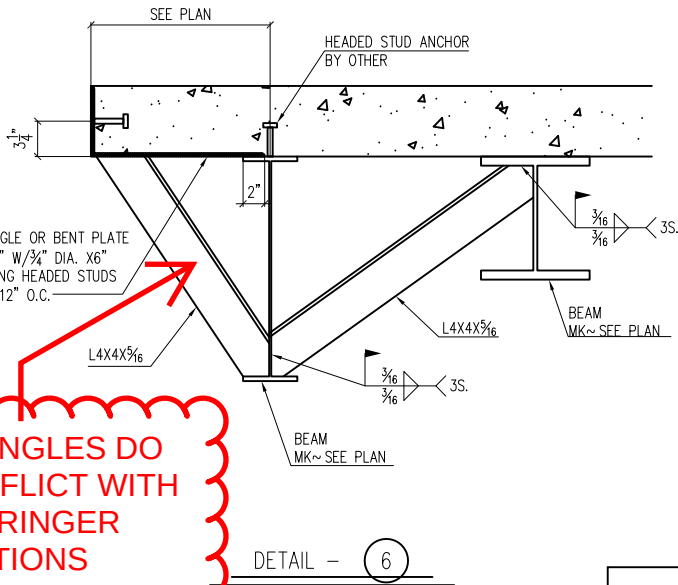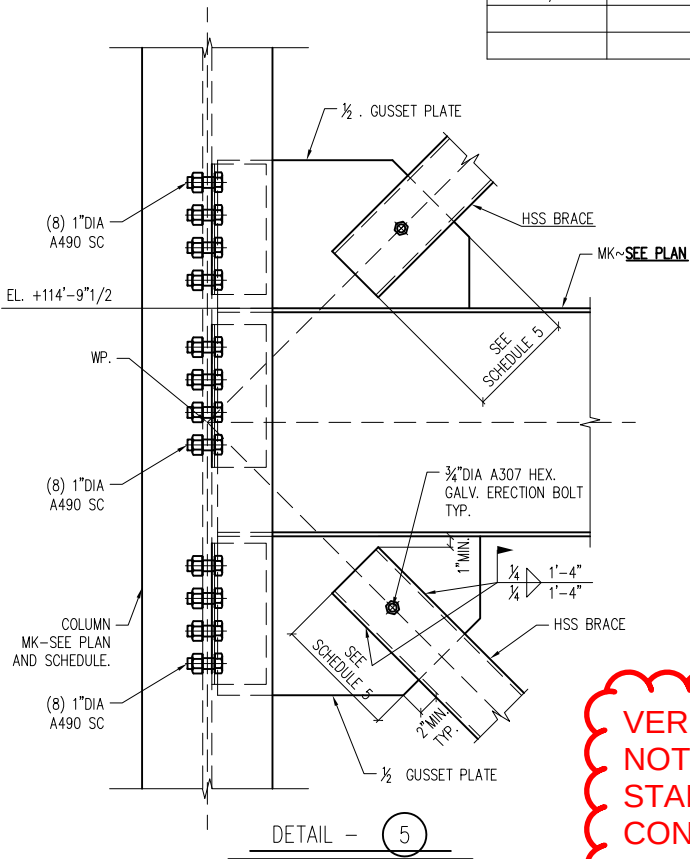





VERIFY ANGLES DO NOT CONFLICT WITH STAIR STRINGER CONNECTIONS

ATLAS IRON WORKS ST. LOUIS, MO.

Project: WEBSTER UNIVERSITY INTERDISCIPLINARY SCIENCE BUILDING
Customer: PARIC CORPORATION
Owner: WEBSTER UNIVERSITY
Location: WEBSTER GROVES, MO 63119
Dwn: ZZ Date: 05/30/16 Ckd: LJ Date: 05/30/16
Job No. A16013 BAT: DWG#: E2F

FOR APPROVAL

05-30-16

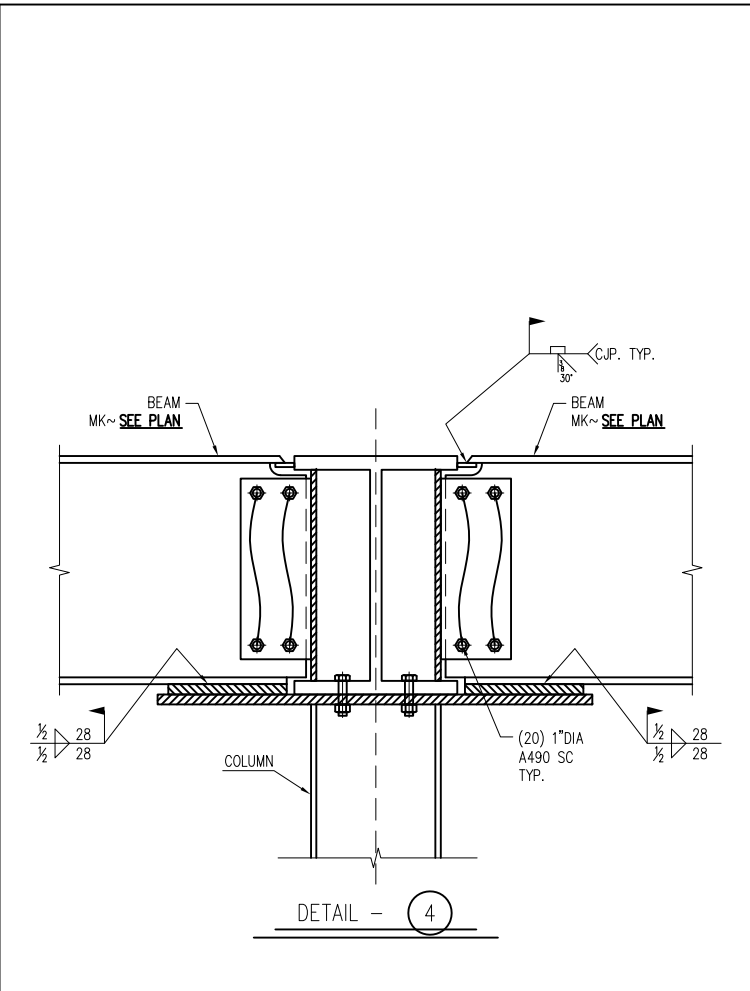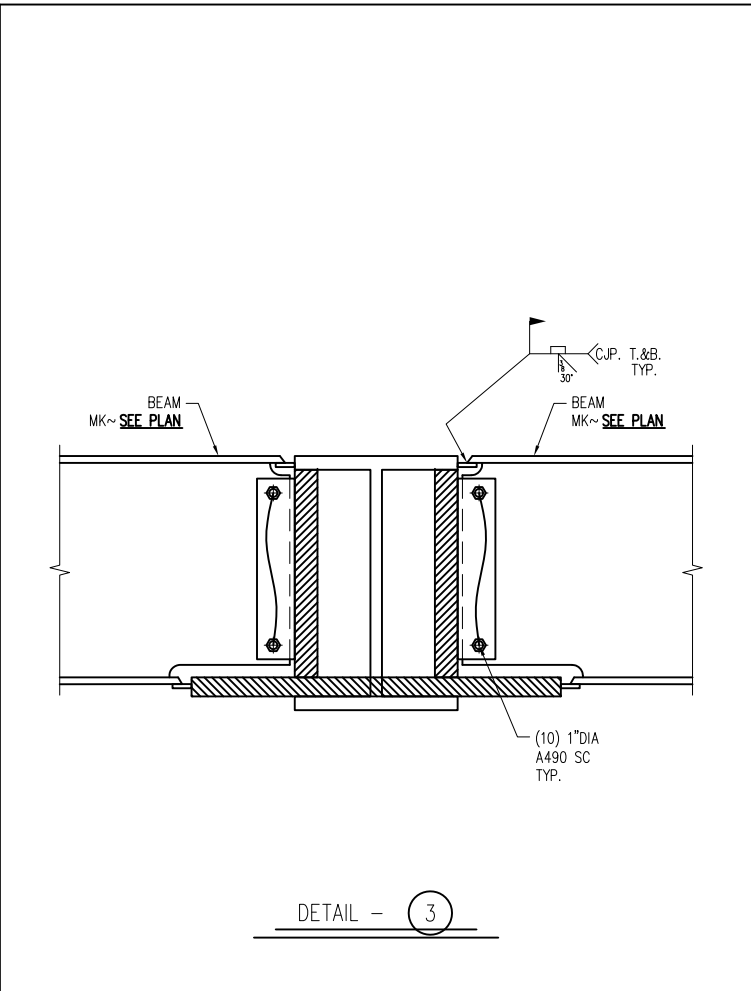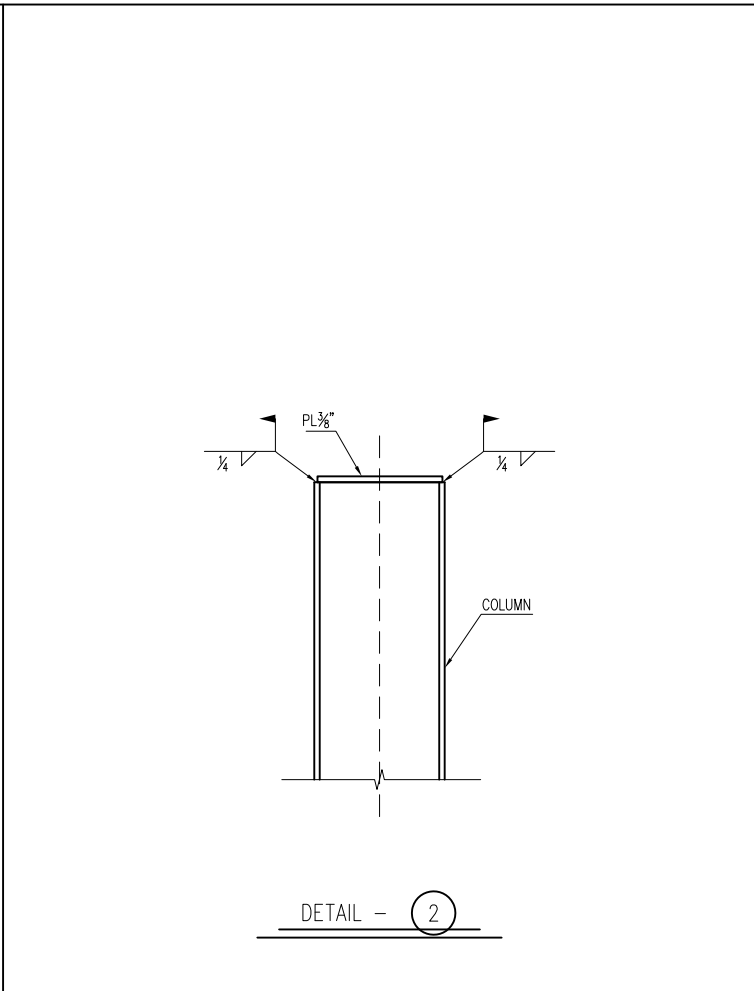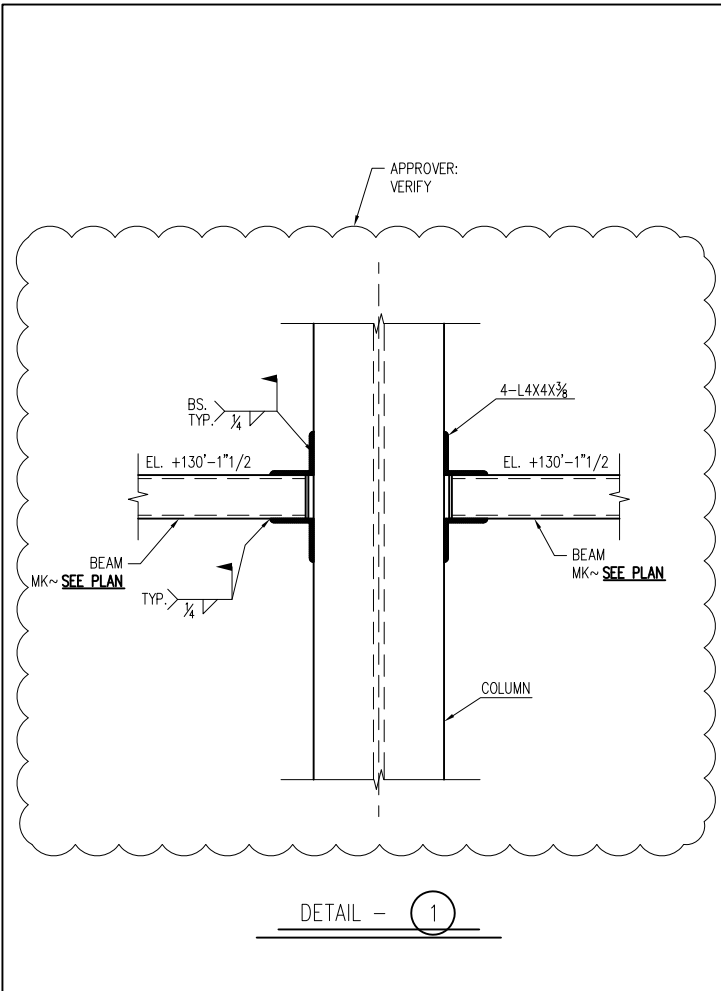


ATLAS IRON WORKS ST. LOUIS, MO.

Project: WEBSTER UNIVERSITY INTERDISCIPLINARY SCIENCE BUILDING
Customer: PARIC CORPORATION
Owner: WEBSTER UNIVERSITY
Location: WEBSTER GROVES, MO 63119
Dwn: ZZ Date: 05/30/16 Ckd: LJ Date: 05/30/16
Job No. A16013 BAT: DWG#: E2G

FOR APPROVAL

05-30-16

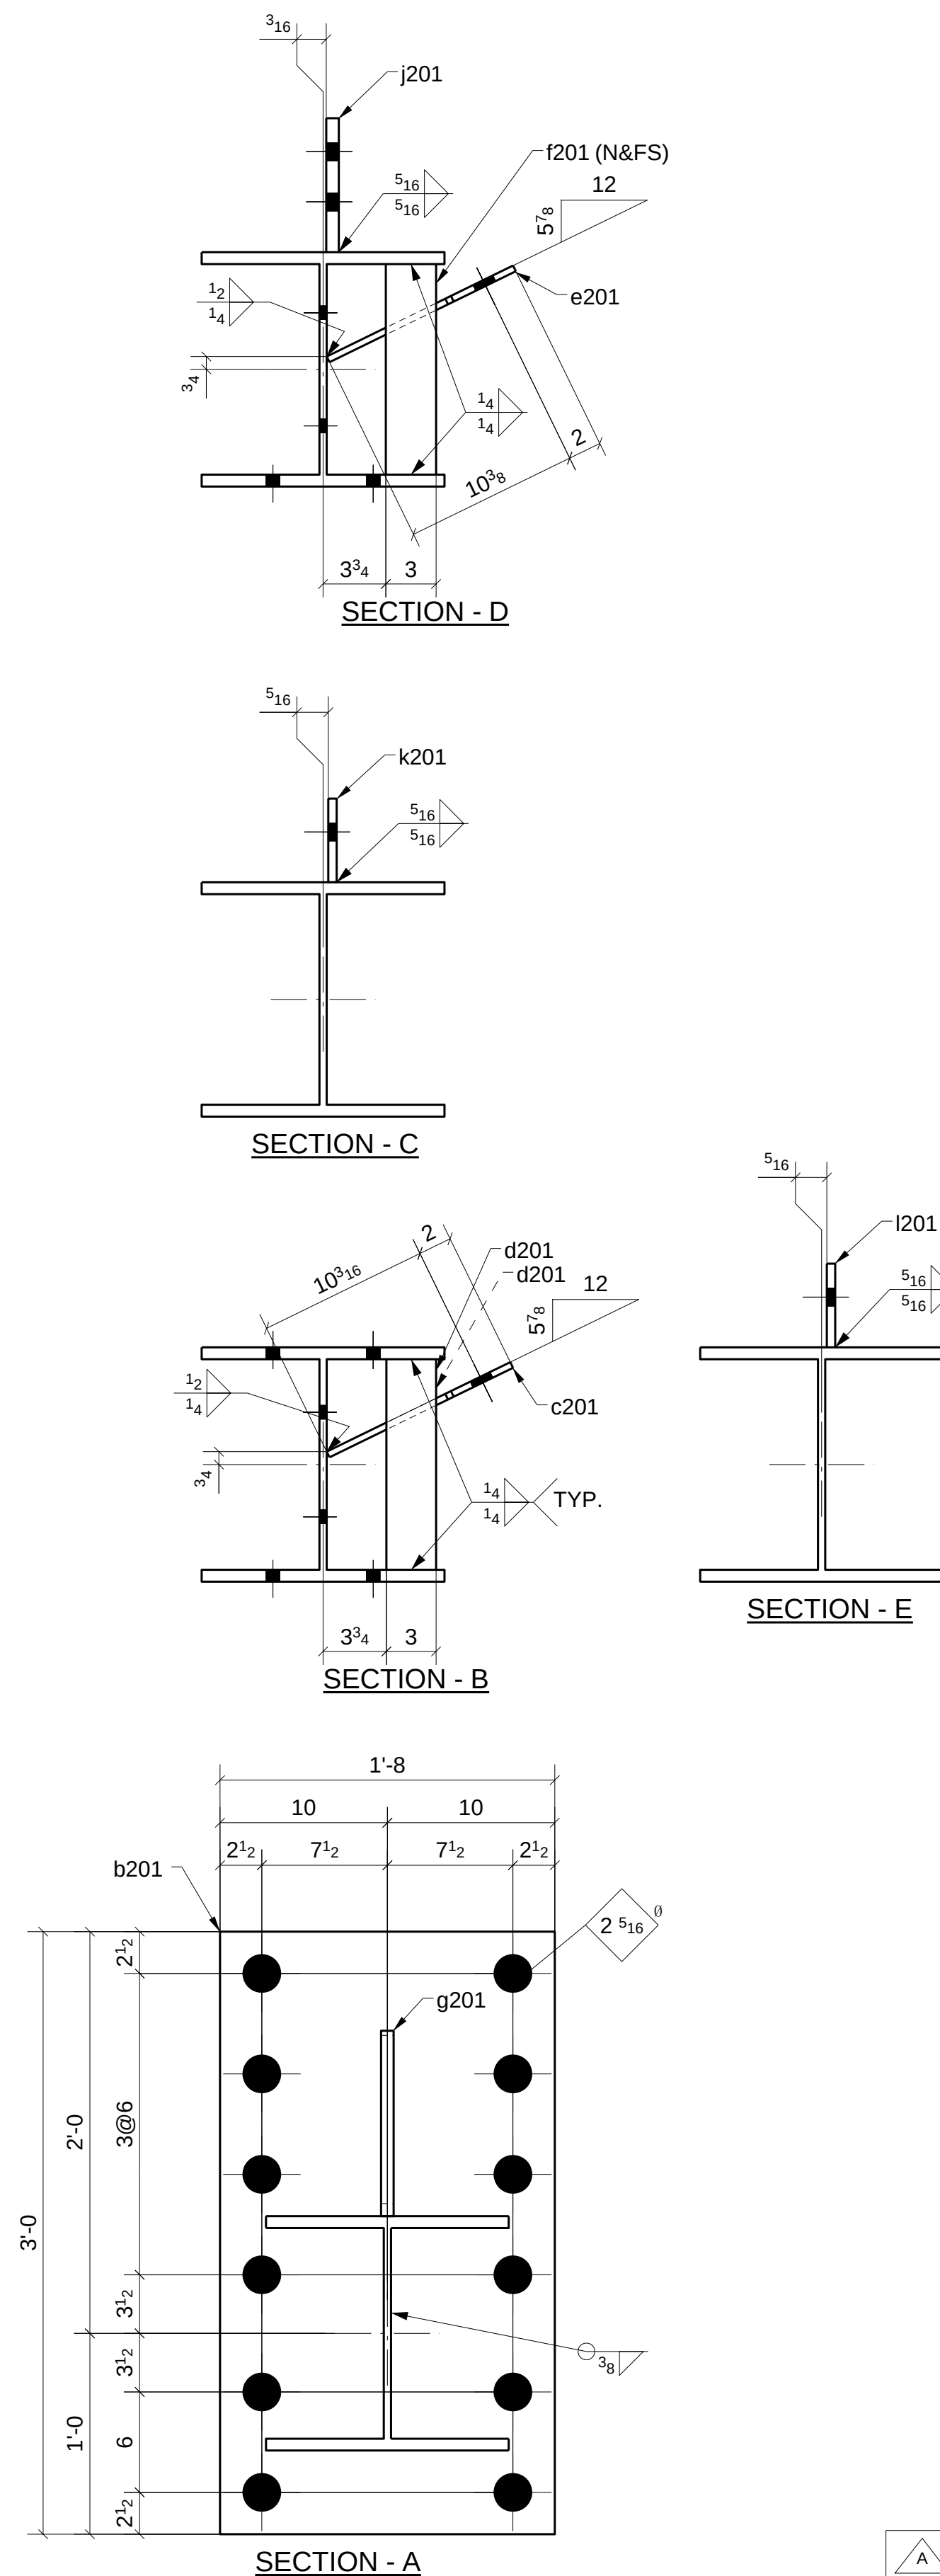

SHOP BOLT IN SLOTTED HOLE
NEED "HAND TIGHTEN"


[illegible]

Romac By: _____ Checked By: _____


Beamline By: _____ Checked By: _____

ATLAS IRON WORKS ST. LOUIS, MO.							
Project:	WEBSTER UNIVERSITY INTERDISCIPLINARY SCIENCE BUILDING						
Customer:	PARIC CORPORATION						
Owner:	WEBSTER UNIVERSITY						
Location:	WEBSTER GUYOVES, MO 63119						
Dwn:	TLI	Date:	05/27/2016	Ckd:	LJ	Date:	05/30/2016
Job No.		A16013		RAT:		DWGS#: 201	

A	FOR APPROVAL		05/30/16
Sequence:	2	Ref. E-Plans:	-
Material:	A992	U.N.O.	Edge Dist.: 1 1/2" U.N.O.
Holes:	13/16" DIA.	Bolts:	NOTED
Cleaning:	NONE		
Paint:	NO		
DFT:		COLOR:	

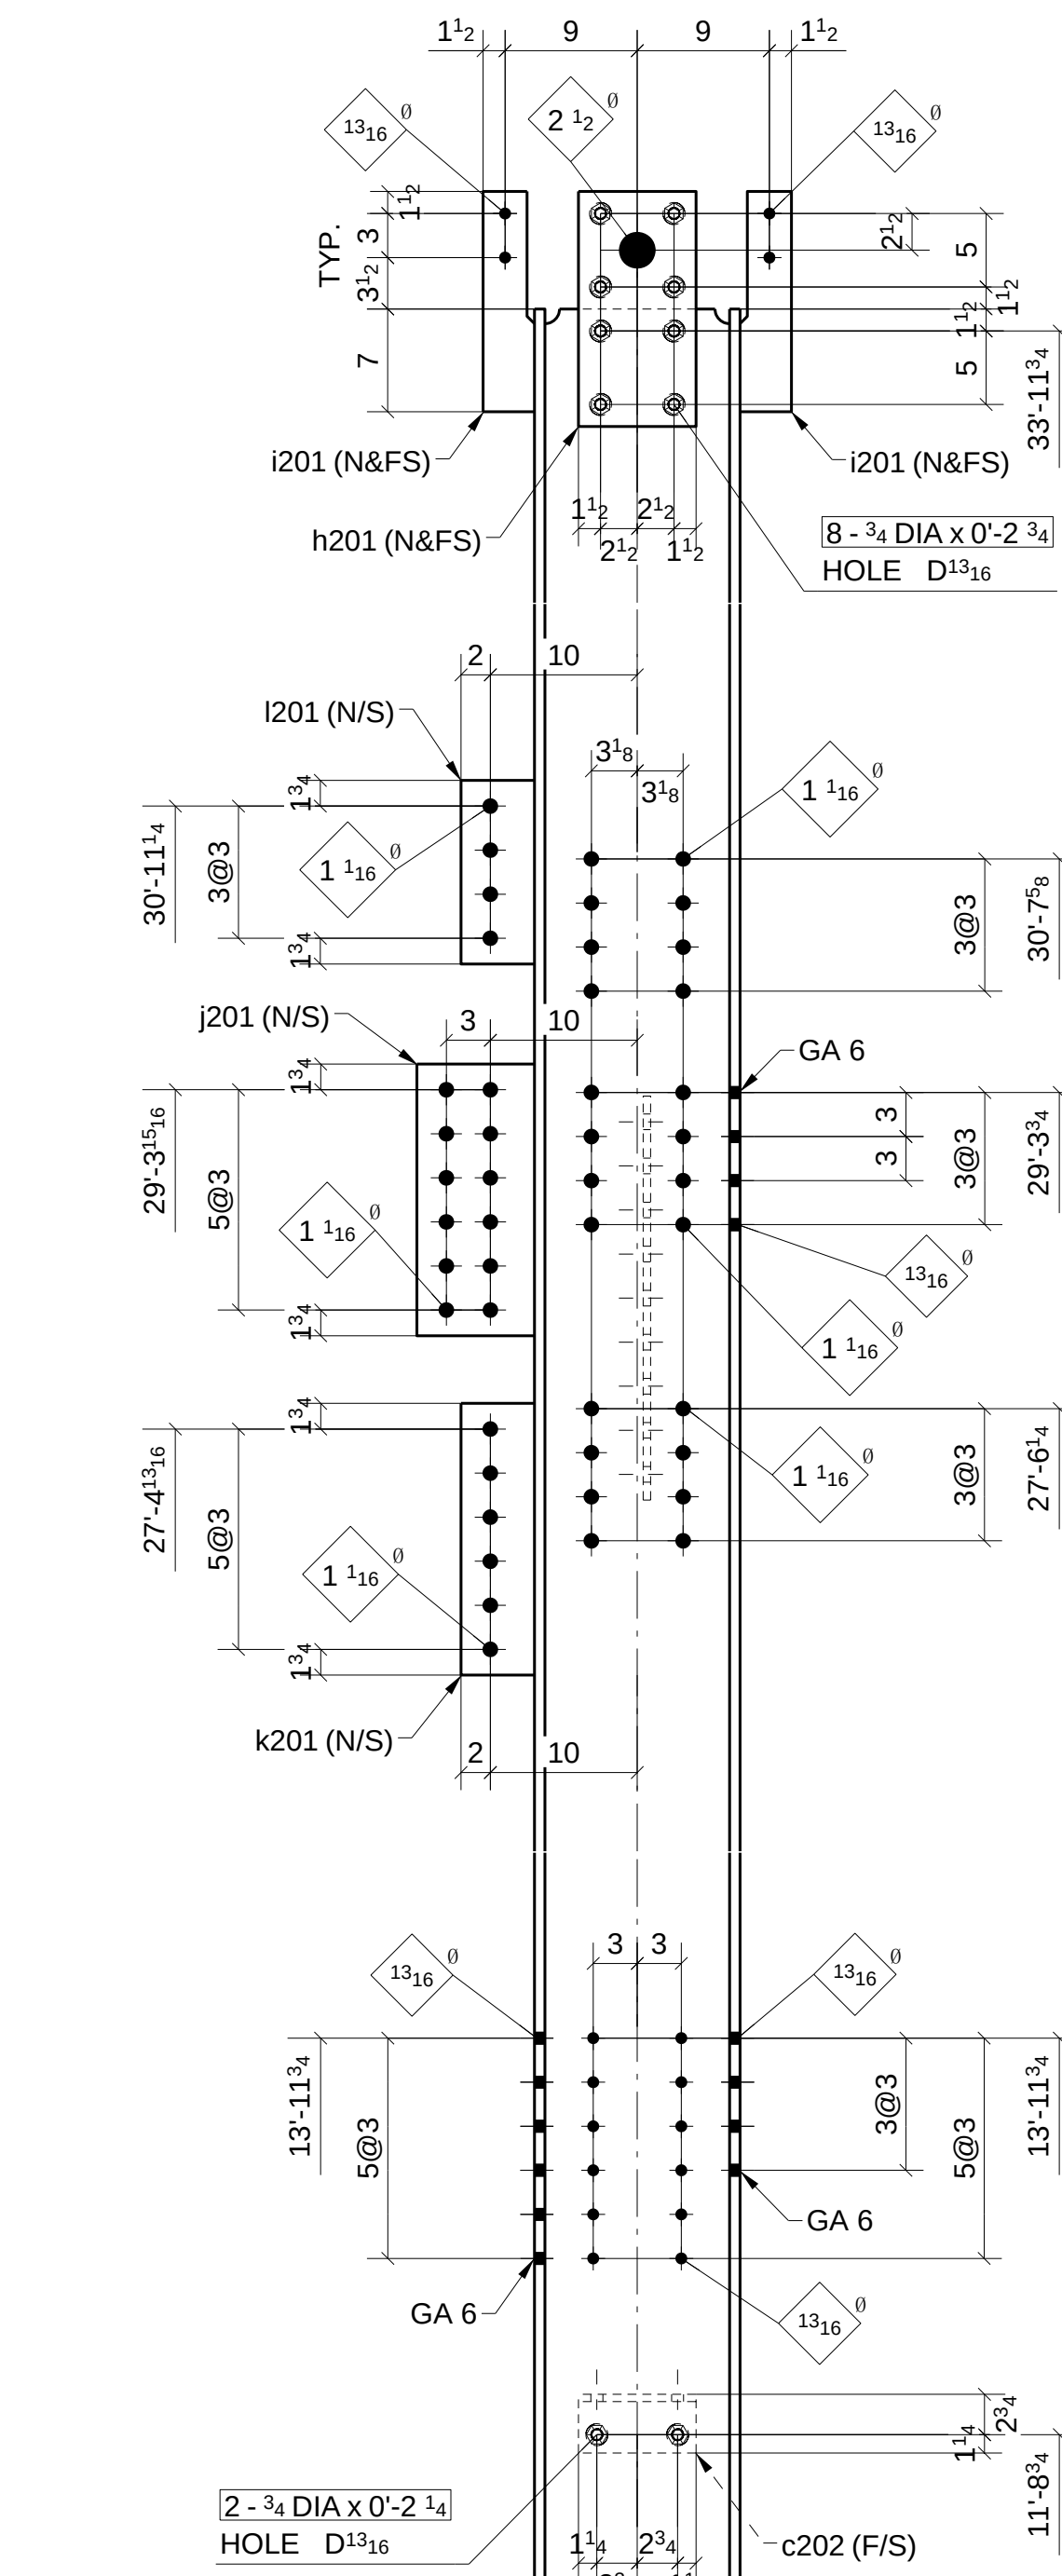

	FOR APPROVAL		05/30/16
	Sequence: 2	Ref. E-Plans: -	
Material: A992	U.N.O.	Edge Dist.: 1 1/2"	U.N.O.
Holes: 13/16" DIA.	Bolts:	NOTED	
Cleaning: NONE			
Paint: NO			
DFT: _____		COLOR: _____	

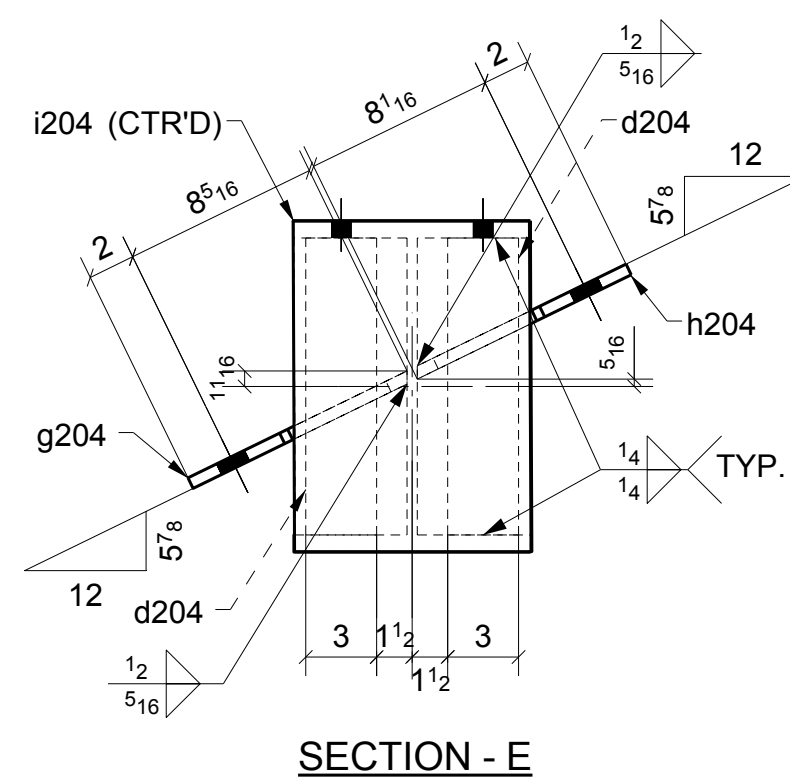

ATLAS IRON WORKS

ST. LOUIS, MO.

Project: WEBSTER UNIVERSITY INTERDISCIPLINARY SCIENCE BUILDING

Customer: PARIC CORPORATION

Owner: WEBSTER UNIVERSITY


Location: WEBSTER GUOVES, MO 63119

Dwn: TLI Date: 05/27/2016 Ckd: LJ Date: 05/30/2016

Job No. A16013 BAT: DWG#: 204

SHOP BOLT IN SLOTTED HOLE
NEED "HAND TIGHTEN"

A	FOR APPROVAL		05/03/16	
Sequence:	2		Ref. E-Plans:	-
Material:	A992	U.N.O.	Edge Dist.:	1 1/2" U.N.O.
Holes:	13/16" DIA.		Bolts:	NOTED
Cleaning:	NONE			
Paint:	NO			
DFT:			COLOR:	

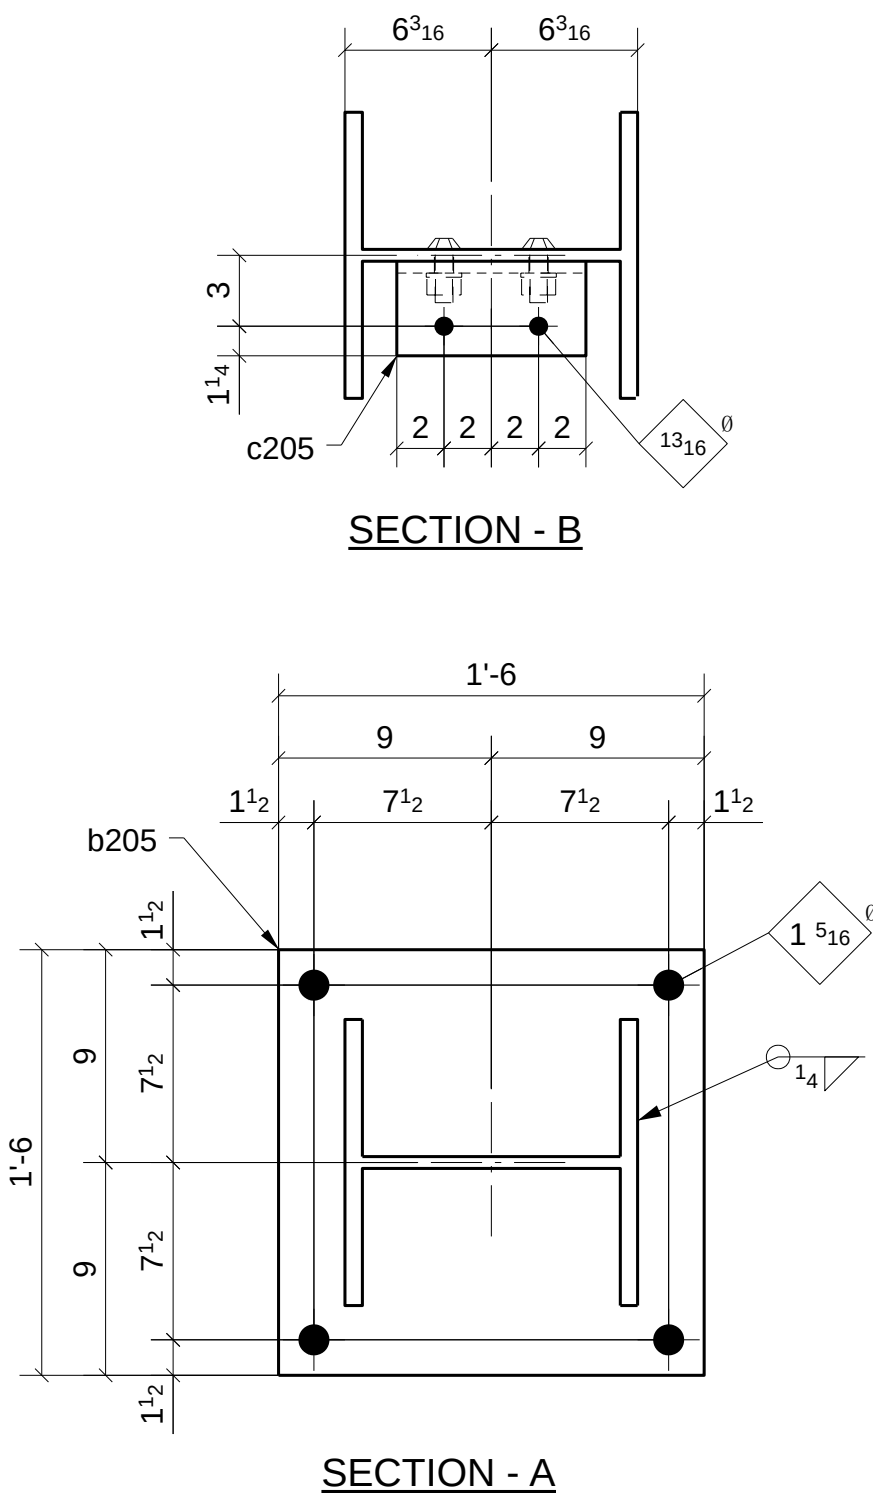


Project:	WEBSTER UNIVERSITY INTERDISCIPLINARY SCIENCE BUILDING						
Customer:	PARIC CORPORATION						
Owner:	WEBSTER UNIVERSITY						
Location:	WEBSTER GUOVES,MO 63119						
Dwn:	TLI	Date:	05/27/2016	Ckd:	LJ	Date:	05/30/2016
Job No.	A16013		BAT:	DWG#:		205	

	FOR APPROVAL	05/30/16
Sequence: <u>2</u>	Ref. E-Plans: <u>—</u>	
Material: <u>A992</u> U.N.O.	Edge Dist.: <u>1 1/2"</u> U.N.O.	
Holes: <u>13/16" DIA.</u>	Bolts: <u>NOTED</u>	
Cleaning: <u>NONE</u>		
Paint: <u>NO</u>		
DFT: _____ COLOR: _____		





SHOP BOLT IN SLOTTED HOLE
NEED "HAND TIGHTEN"

Romac By: _____	Checked By: _____
Beamline By: _____	Checked By: _____

Project: WEBSTER UNIVERSITY INTERDISCIPLINARY SCIENCE BUILDING
Customer: PARIC CORPORATION
Owner: WEBSTER UNIVERSITY
Location: WEBSTER GUOVES,MO 63119
Dwn: TLI Date: 05/27/2016 Ckd: LJ Date: 05/30/2016
Job No. A16013 BAT: DWG#: 206

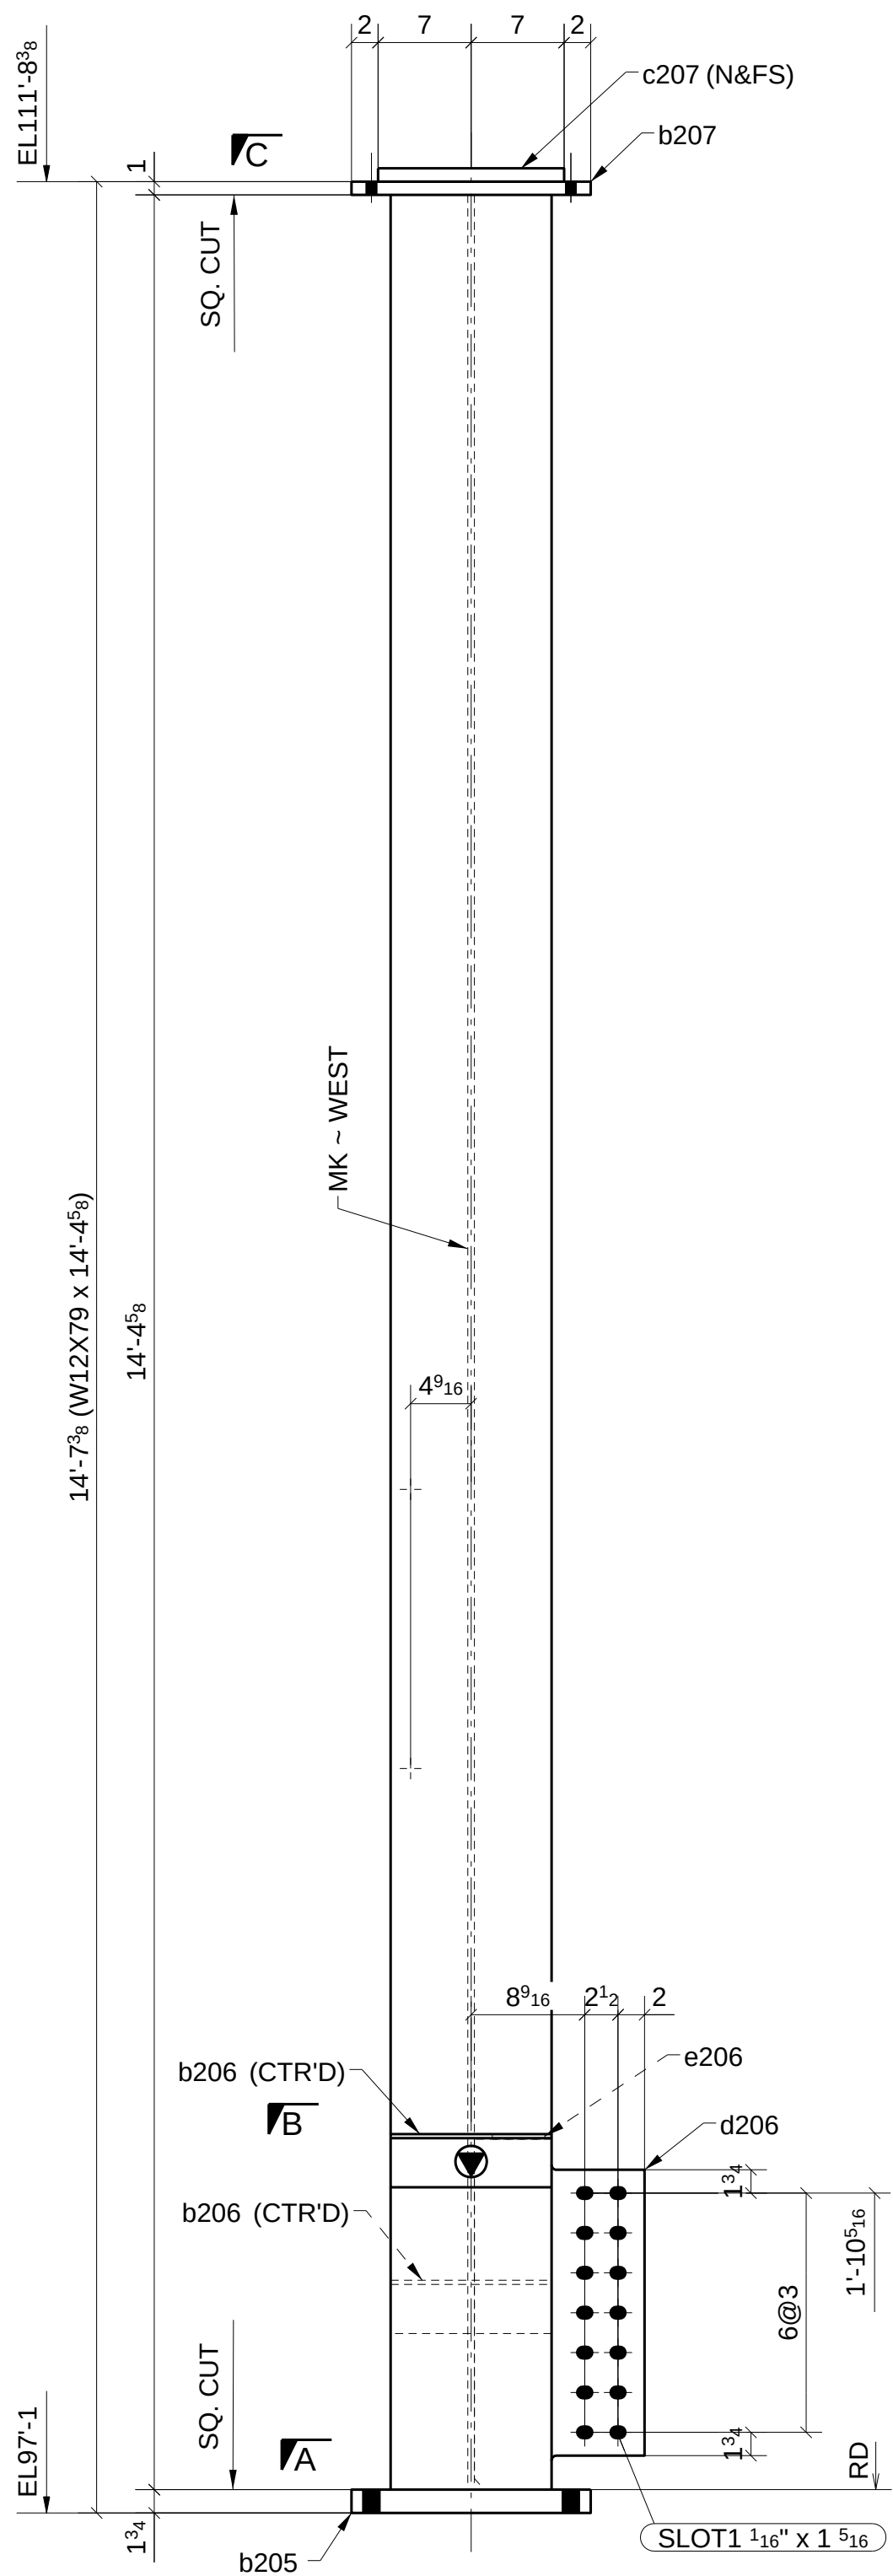

ONE - COLUMN ~ 207A
LOCATION: ONE @ 1.6/C (REF: E2A,E2B)

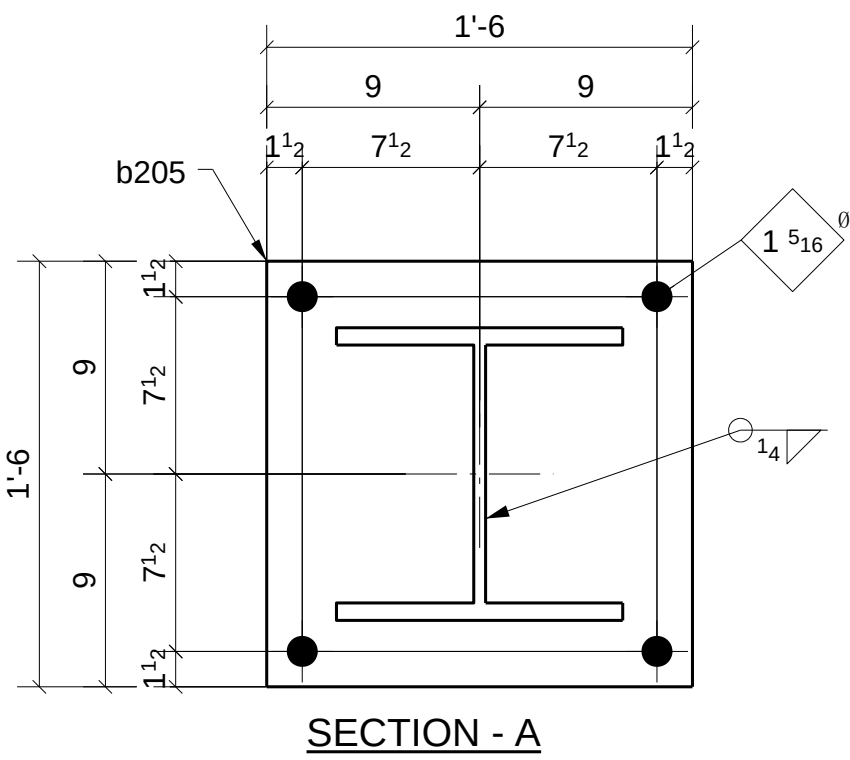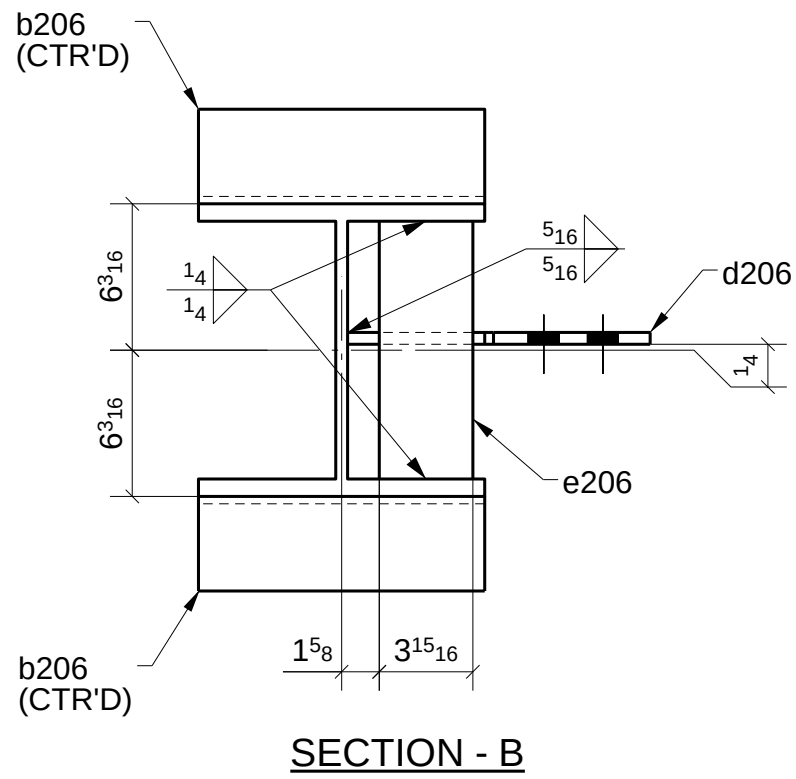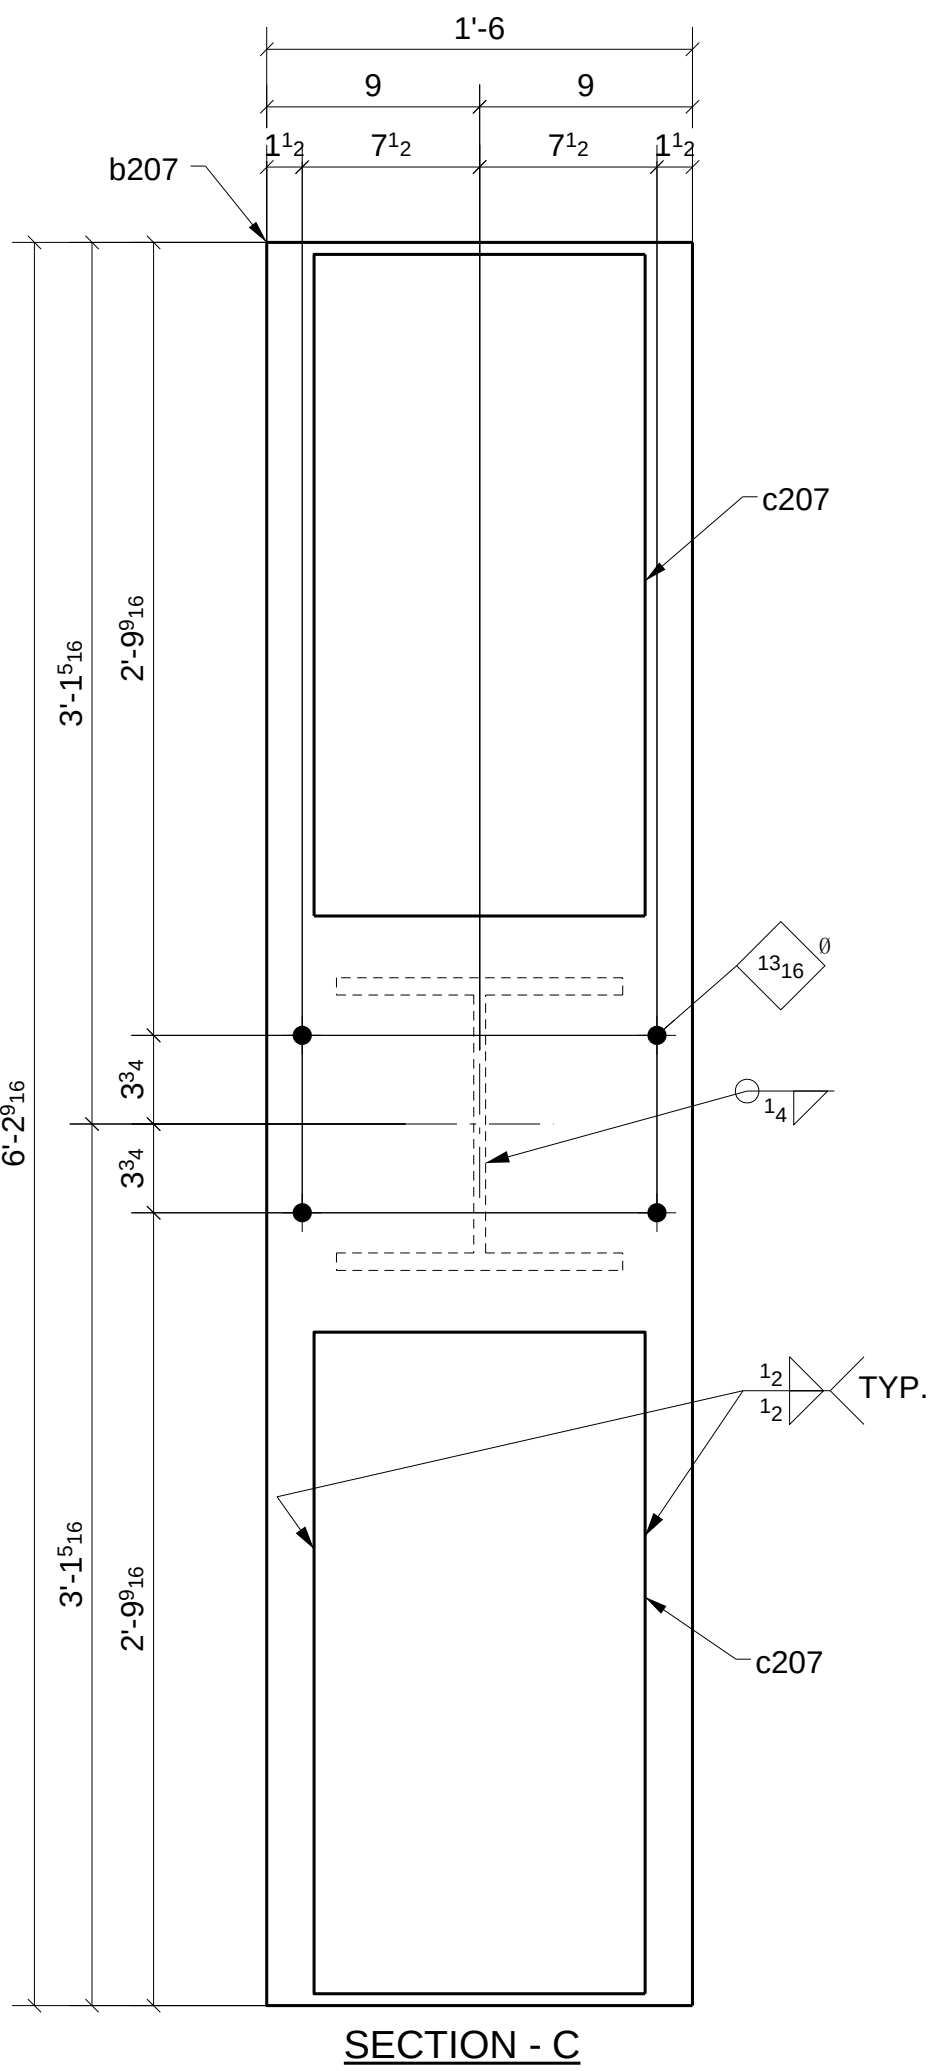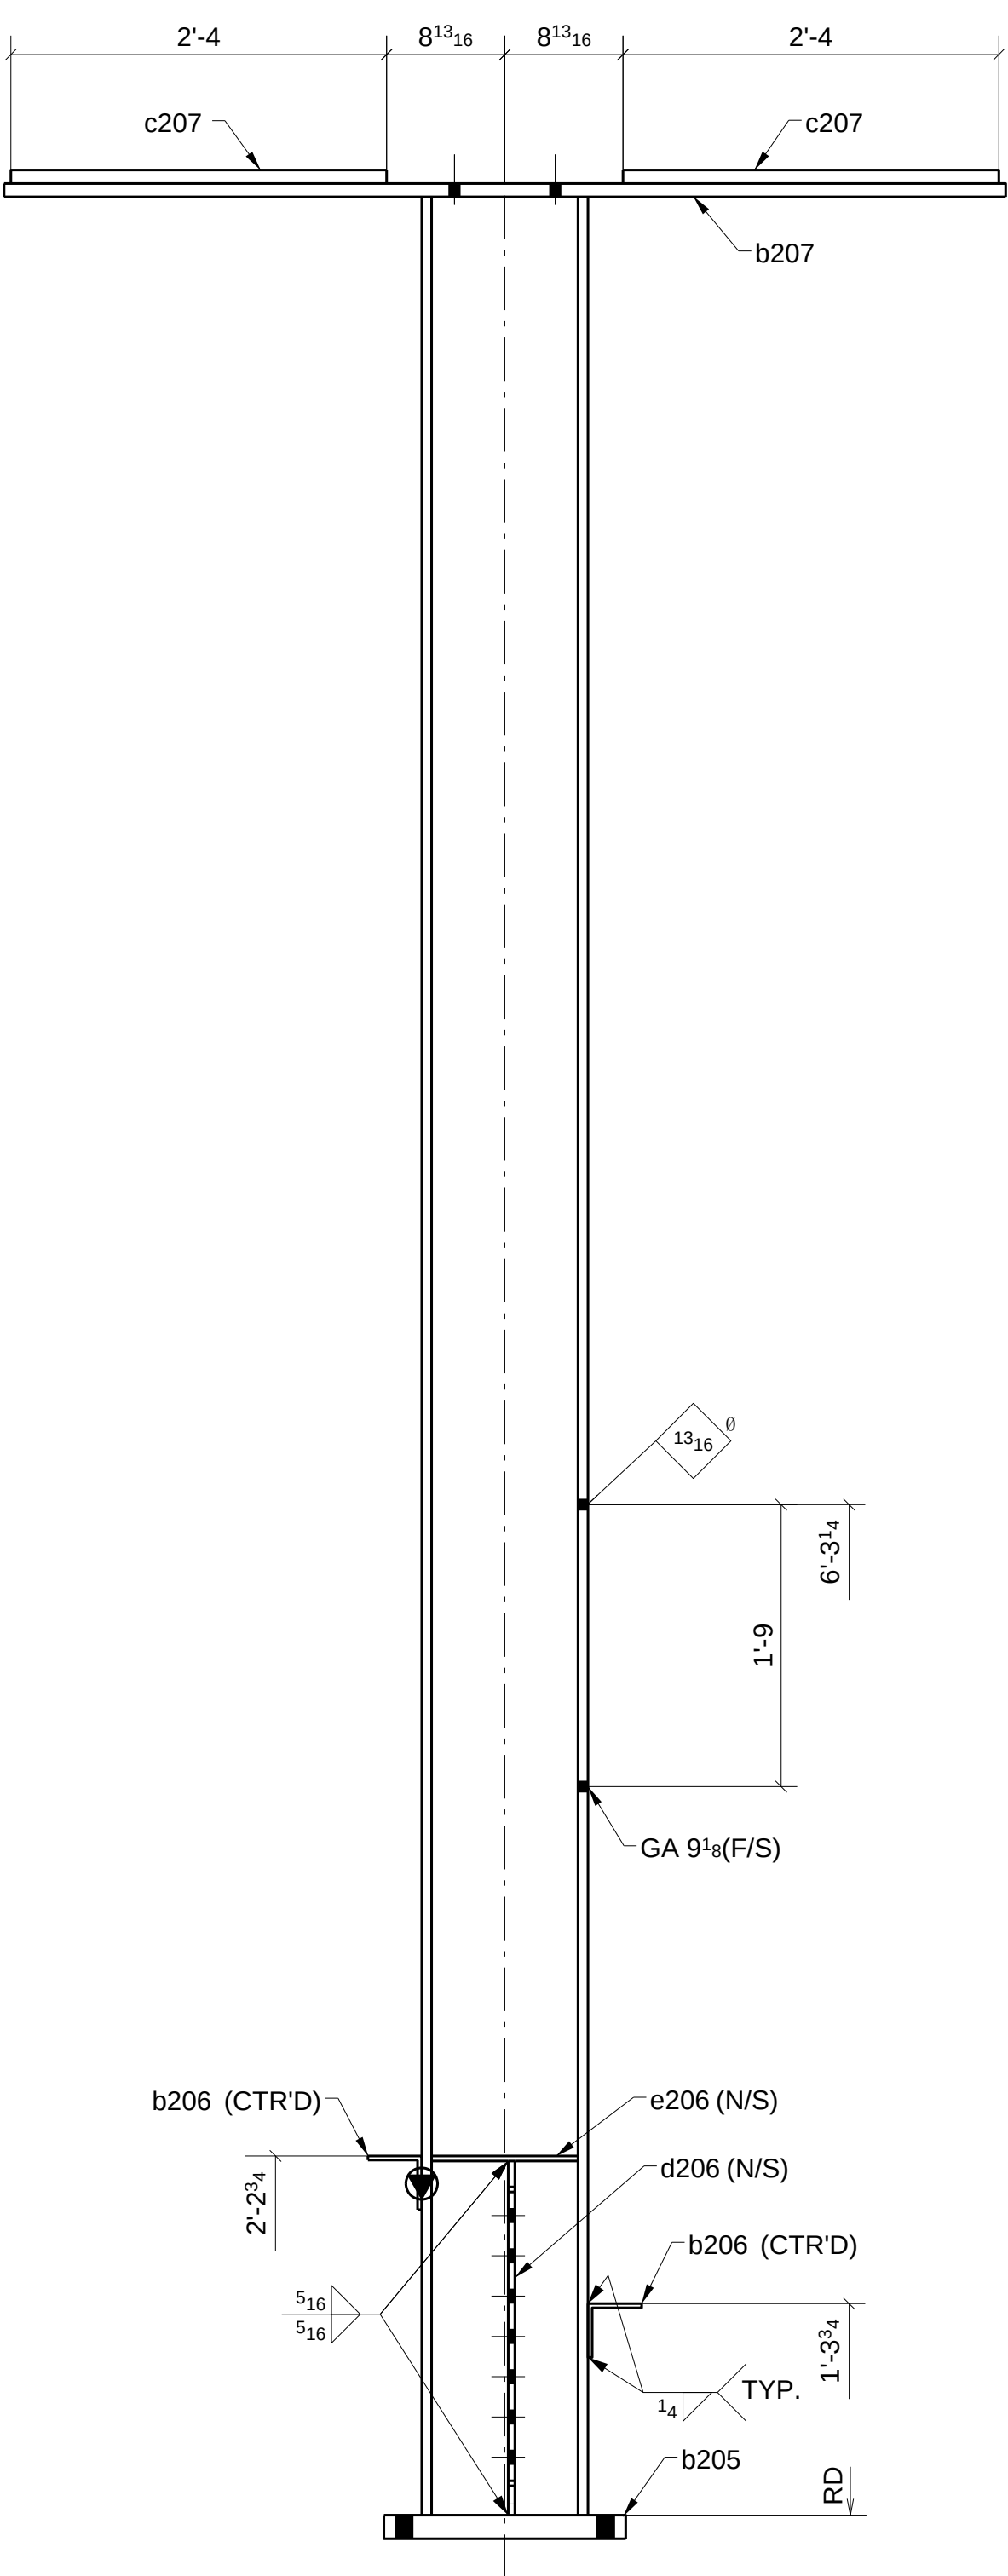

SHOP BOLT IN SLOTTED HOLE
NEED "HAND TIGHTEN"

MATERIAL LIST


QTY	MARK	DESCRIPTION	LENGTH	MATERIAL	NOTES
1	207A	W12X79	14'-4 5/8"	A992	
1	b205	PL 1 3/4"X18"	1'-6"	A36	
2	b206	L 4X4X5/16	1'-0 1/8"	A36	
1	b207	PL 1"X18"	6'-2 9/16"	A36	
2	c207	PL 1"X14"	2'-4"	A36	
1	d206	PL 1/2"X12 13/16"	2'-2 3/8"	A572-GR.50	
1	e206	PL 3/8"X3 15/16"	0'-10 7/8"	A36	

Romac By: _____ Checked By: _____
Beamline By: _____ Checked By: _____

ATLAS IRON WORKS
ST. LOUIS, MO.


Project: WEBSTER UNIVERSITY INTERDISCIPLINARY SCIENCE BUILDING
Customer: PARIC CORPORATION
Owner: WEBSTER UNIVERSITY
Location: WEBSTER GUOVES.MO 63119
Dwn: TLI Date: 05/27/2016 Ckd: LJ Date: 05/30/2016
Job No. A16013 BAT: _____ DWG#: 207

FOR APPROVAL				05/30/16
Sequence:	2	Ref. E-Plans:	-	
Material:	A992 U.N.O.	Edge Dist:	1 1/2"	U.N.O.
Holes:	13/16"DIA.	Bolts:	NOTED	
Cleaning:	NONE			
Paint:	NO			
DFT:		COLOR:		

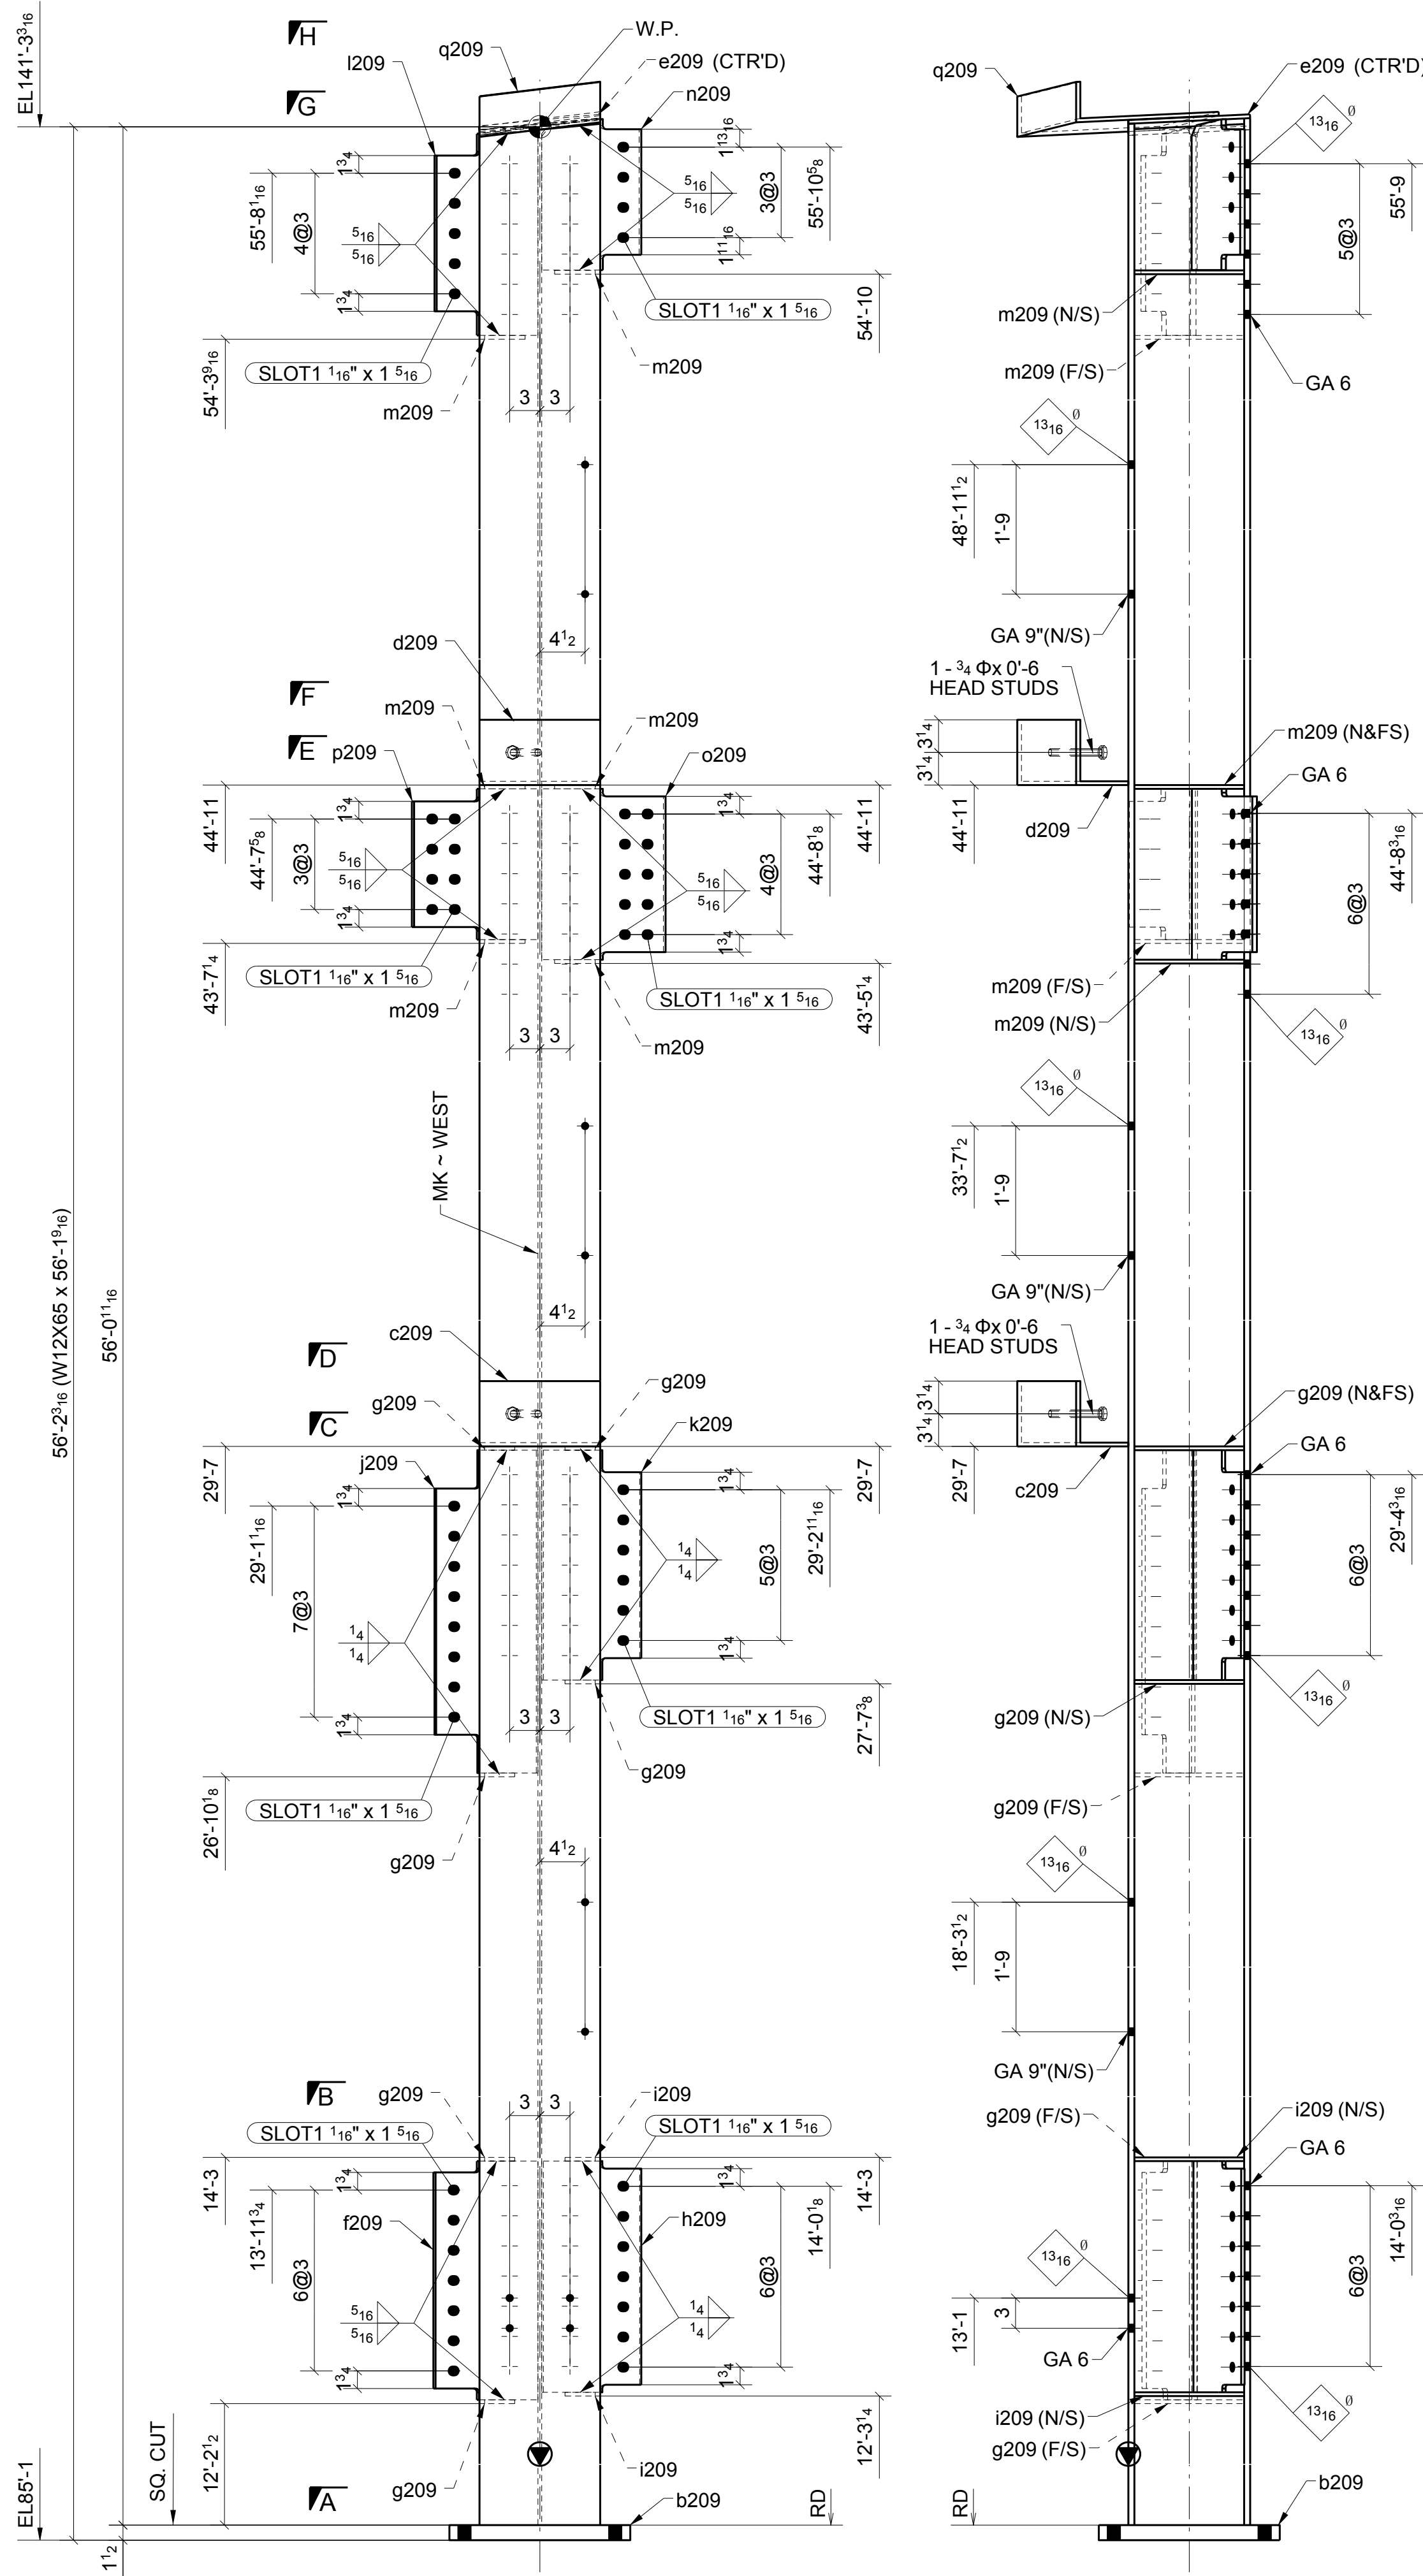


ONE - COLUMN ~ 209A


LOCATION: ONE @ 3/4-A.5 (REF: E2A,E2B)

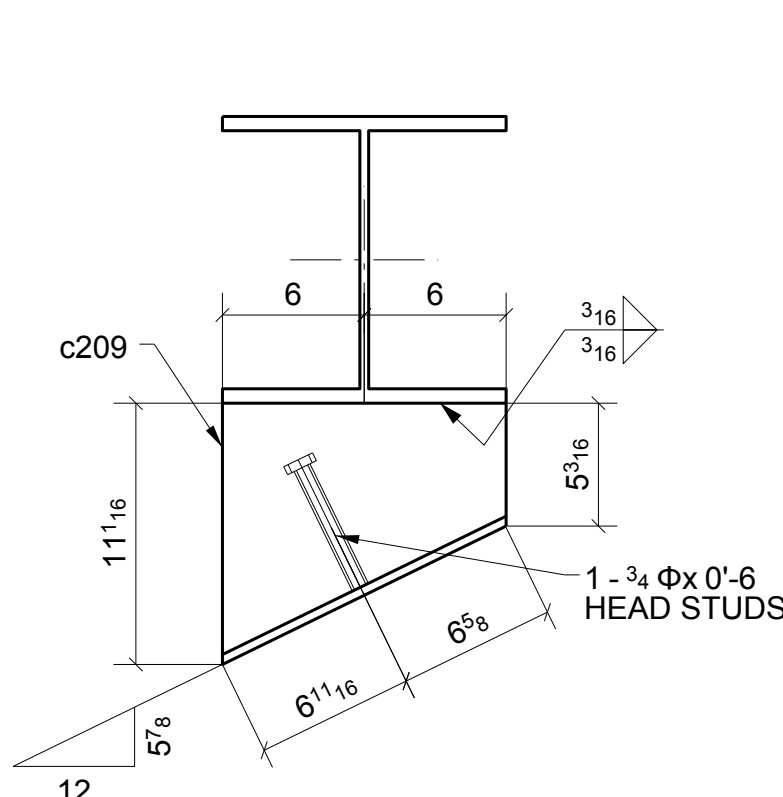


SECTION - D

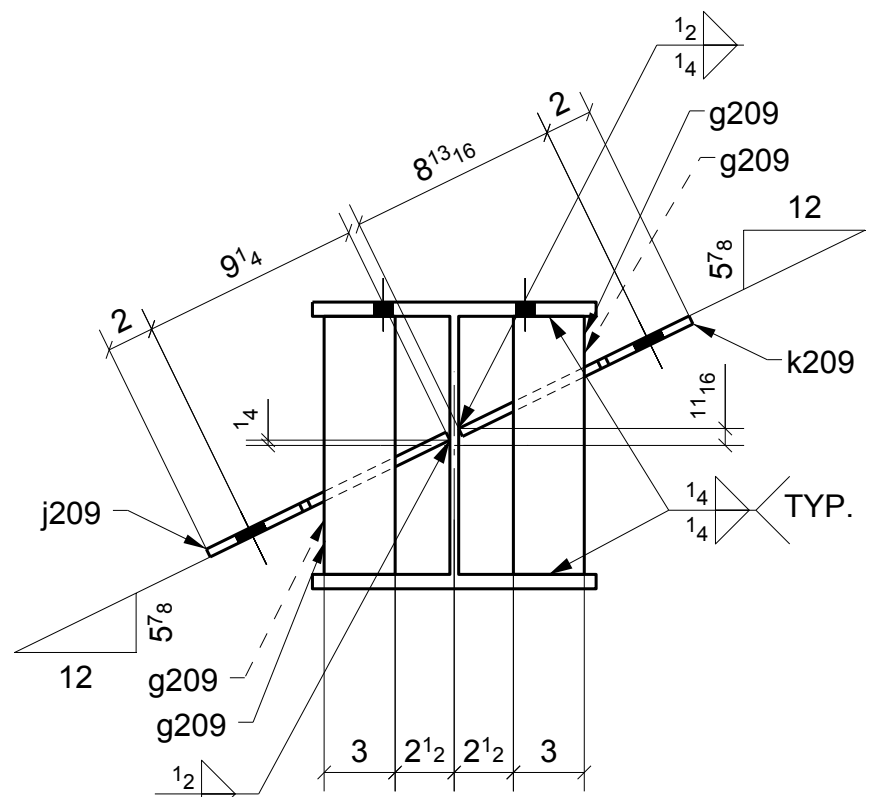


SECTION - C

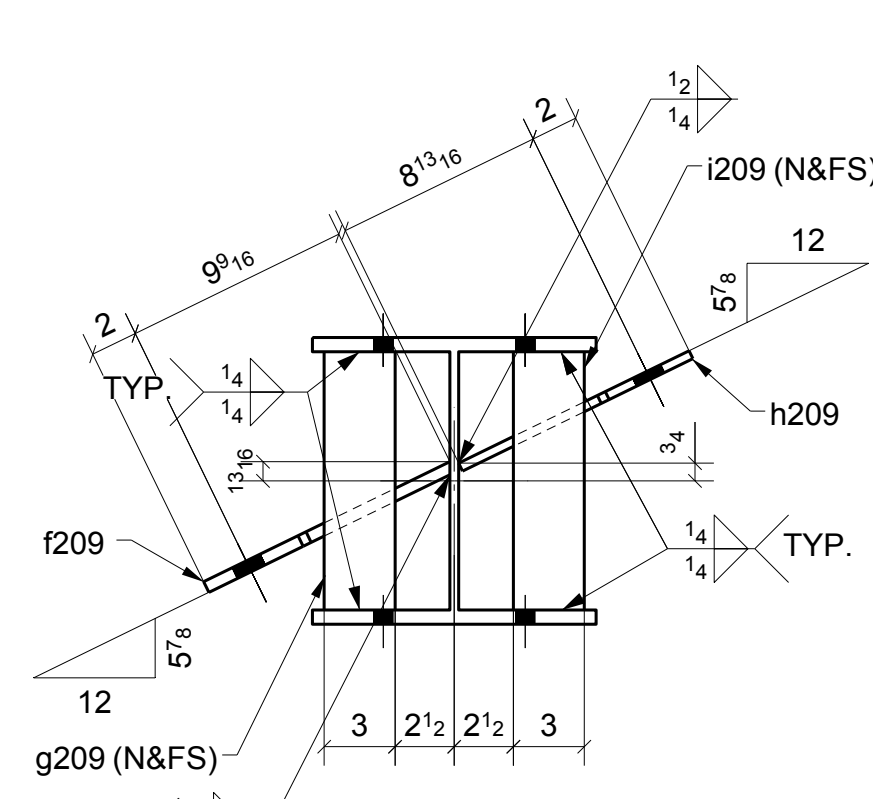


SECTION - B

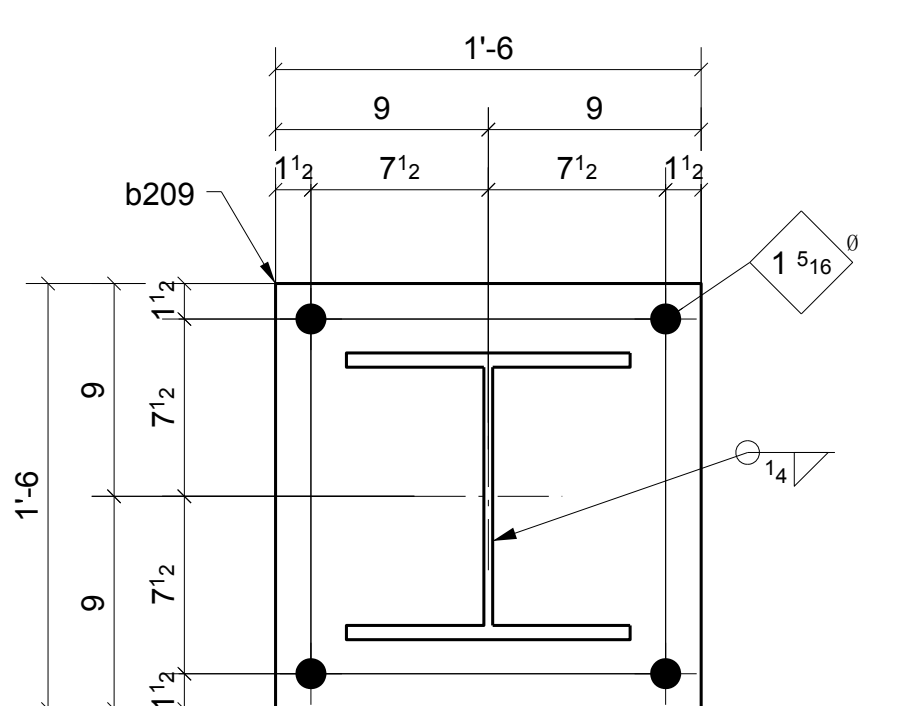


SECTION - A

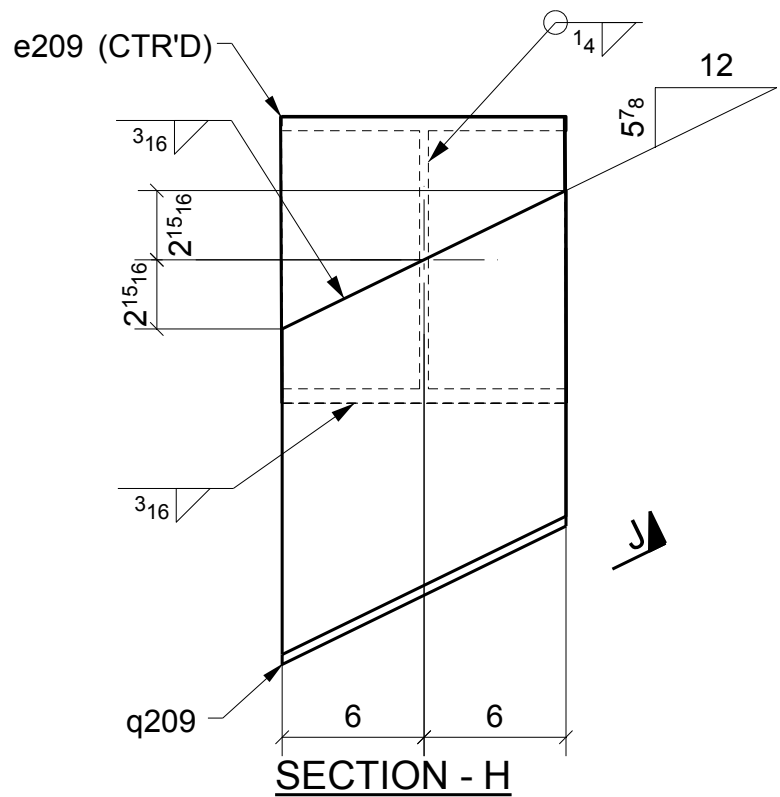


SECTION - H

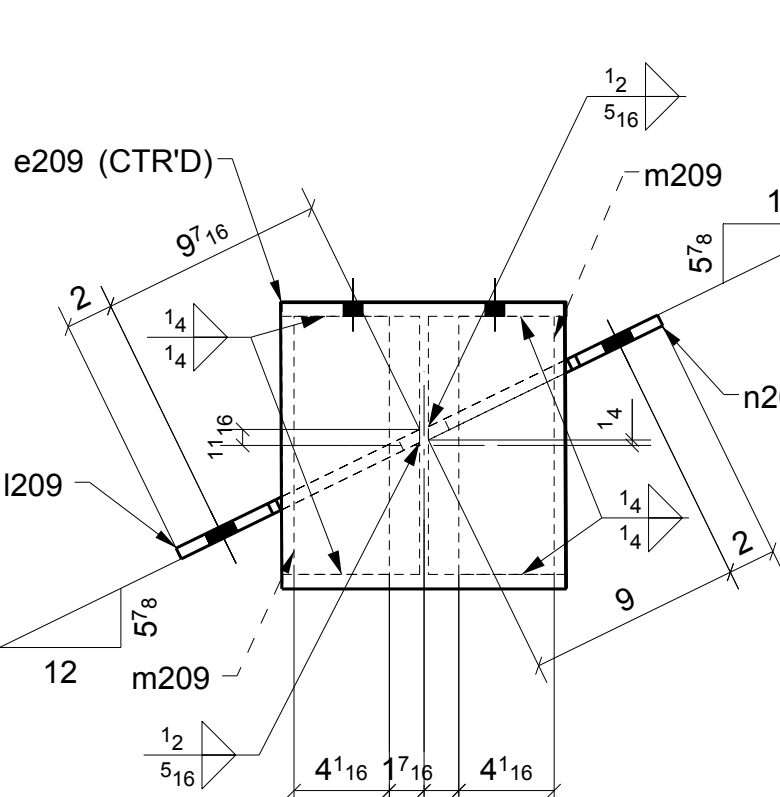


SECTION - G

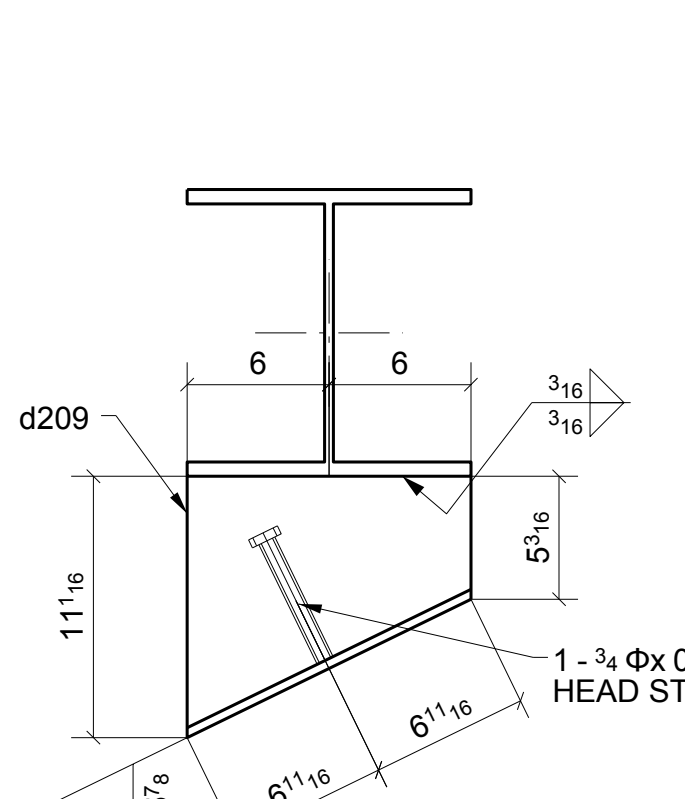

SECTION - F

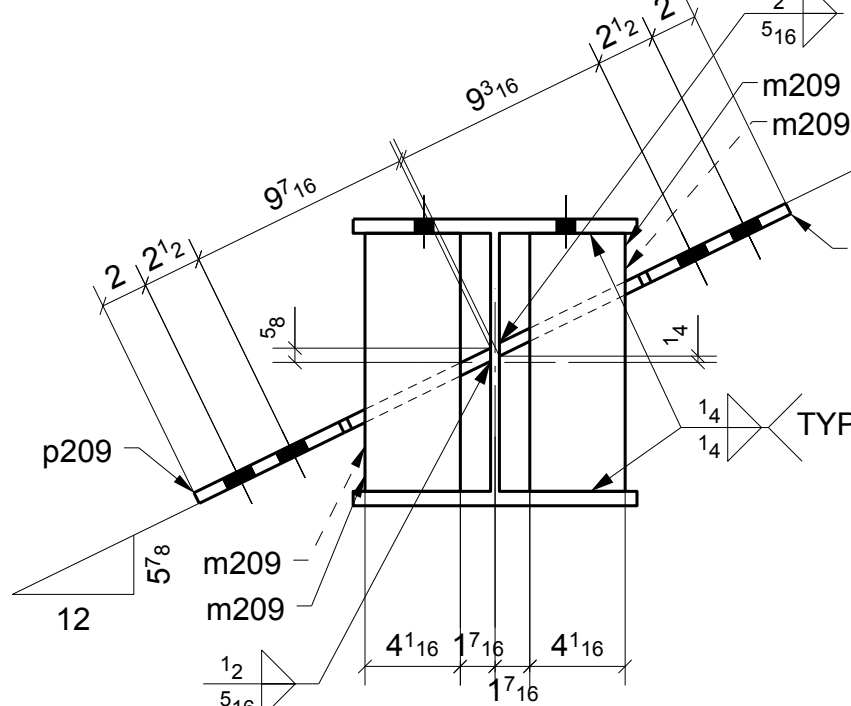

SECTION - E

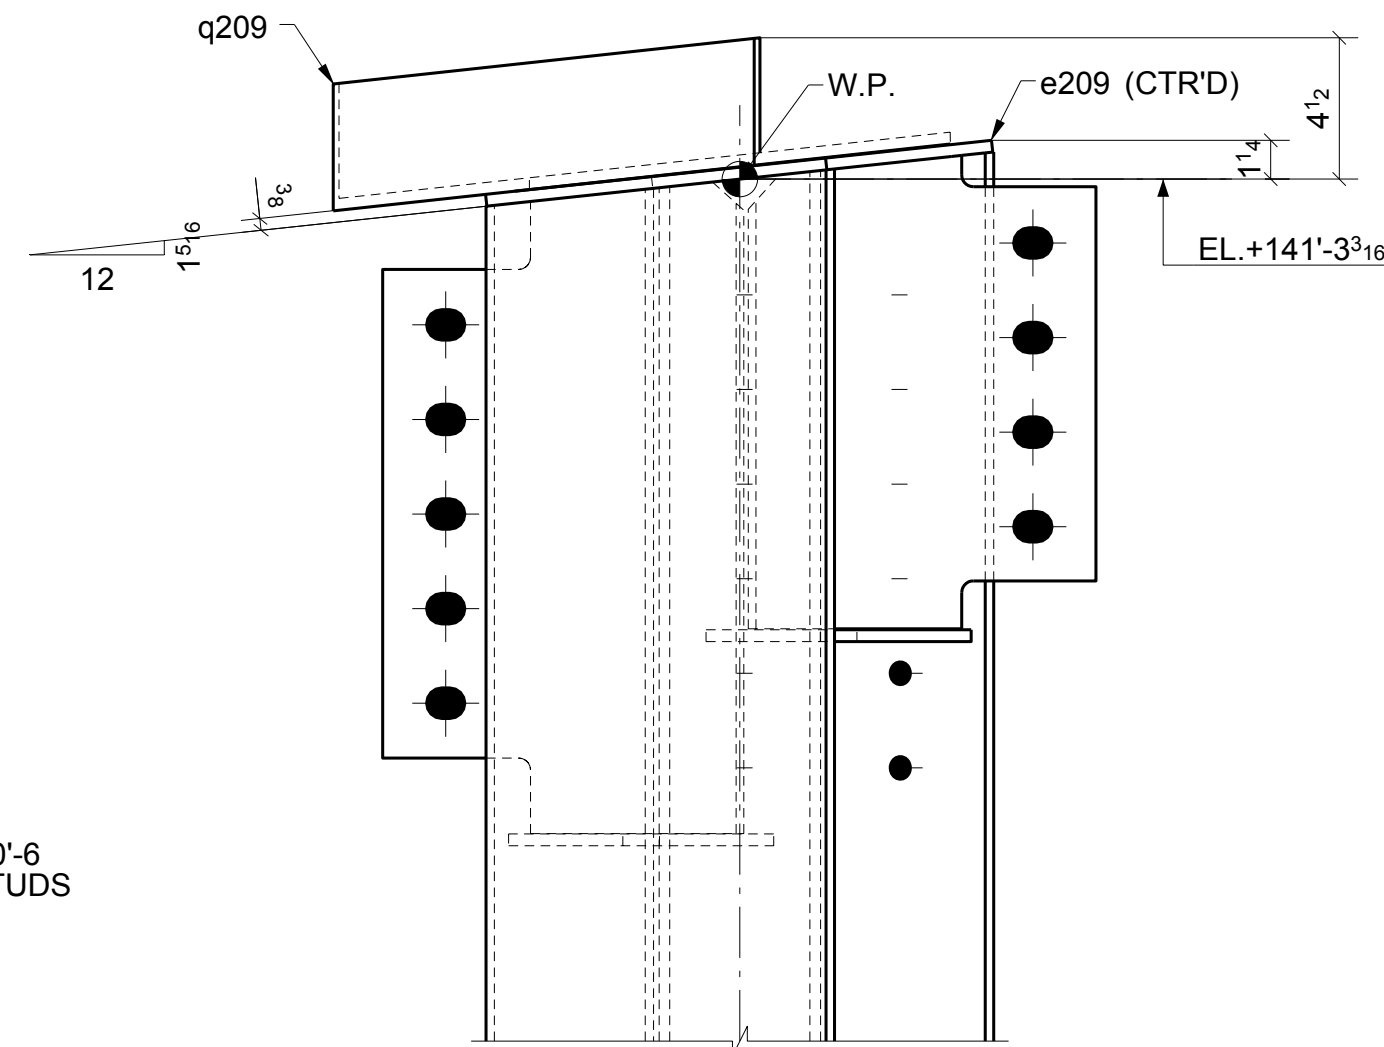

SECTION - J

FOR APPROVAL			
Sequence:	2	Ref. E-Plans:	053016
Material:	A992 U.O.	Edge Dist:	1 1/2" U.O.
Holes:	13/16" DIA.	Bolts:	NOTED
Cleaning:	NONE		
Paint:	NO		
DFT:		COLOR:	






MATERIAL LIST					
QTY	MARK	DESCRIPTION	LENGTH	MATERIAL	NOTES
1	209A	W12X65	56'-1 9/16"	A992	
1	b209	PL 1 1/2"X18"	1'-6"	A36	
1	c209	BPL 3/8"X12 1/16"	1'-3 5/8"	A36	
1	d209	BPL 3/8"X16 7/16"	1'-3 5/8"	A36	
1	e209	PL 3/8"X12 1/16"	1'-0 1/8"	A36	
1	f209	PL 1/2"X11 9/16"	1'-11 3/4"	A36	
6	g209	PL 3/8"X3"	0'-10 15/16"	A36	
1	h209	PL 3/8"X10 13/16"	1'-11"	A36	
2	i209	PL 3/8"X3"	0'-10 15/16"	A36	
1	j209	PL 3/8"X11 1/4"	2'-8 1/8"	A36	
1	k209	PL 3/8"X10 13/16"	1'-10 7/8"	A36	
1	l209	PL 1/2"X11 7/16"	1'-8 11/16"	A36	
6	m209	PL 3/8"X4 1/16"	0'-10 15/16"		
1	n209	PL 1/2"X11"	1'-3"	A36	
1	o209	PL 1/2"X13 11/16"	1'-5"	A36	
1	p209	BPL 1/2"X13 15/16"	1'-3"	A36	
1	q209	BPL 3/8"X16 3/4"	1'-7 3/4"	A36	
2		3/4" STUD	0'-6"		

Romac By: _____ Checked By: _____
Beamline By: _____ Checked By: _____

ATLAS IRON WORKS
ST. LOUIS, MO.

Project: WEBSTER UNIVERSITY INTERDISCIPLINARY SCIENCE BUILDING
Customer: PARIC CORPORATION
Owner: WEBSTER UNIVERSITY
Location: WEBSTER GUOVES, MO 63119
Dwn: TLI Date: 05/27/2016 Ckd: LJ Date: 05/30/2016
Job No. A16013 BAT: _____ DWG#: 209

SHOP BOLT IN SLOTTED HOLE
NEED "HAND TIGHTEN"

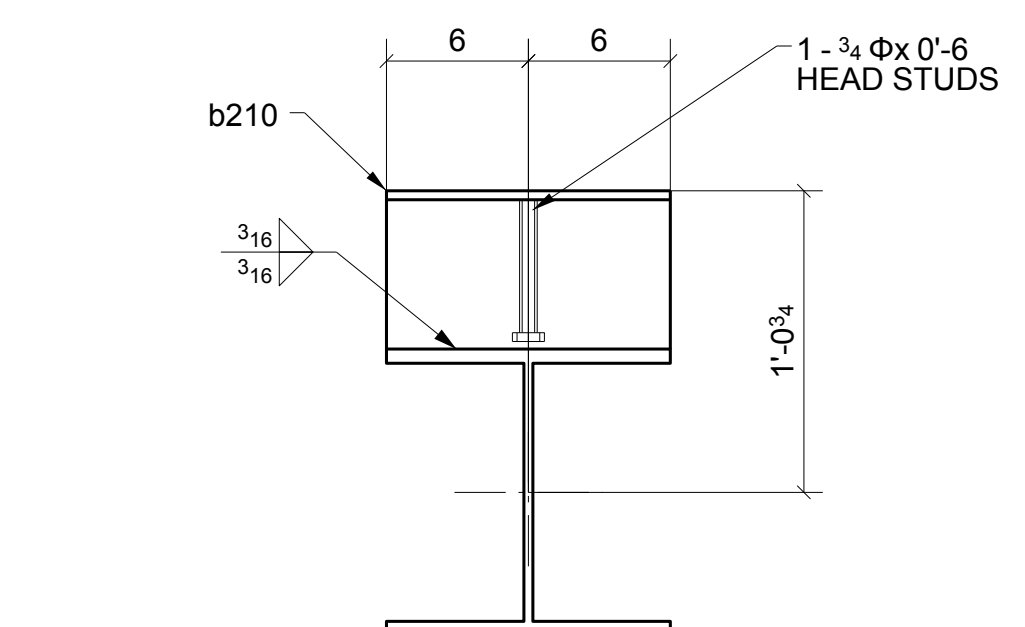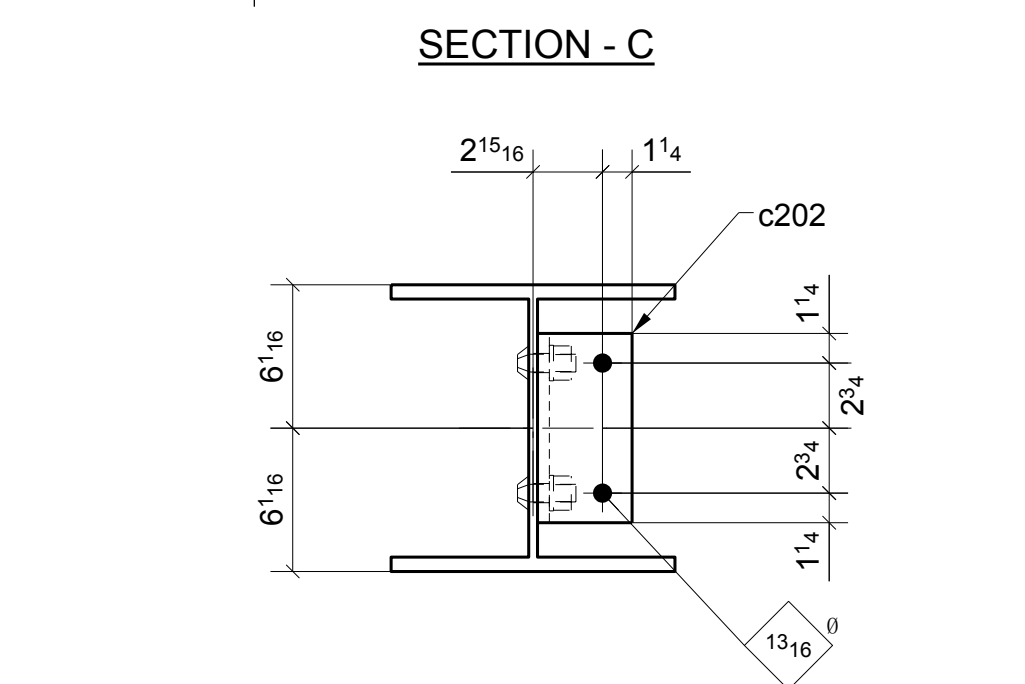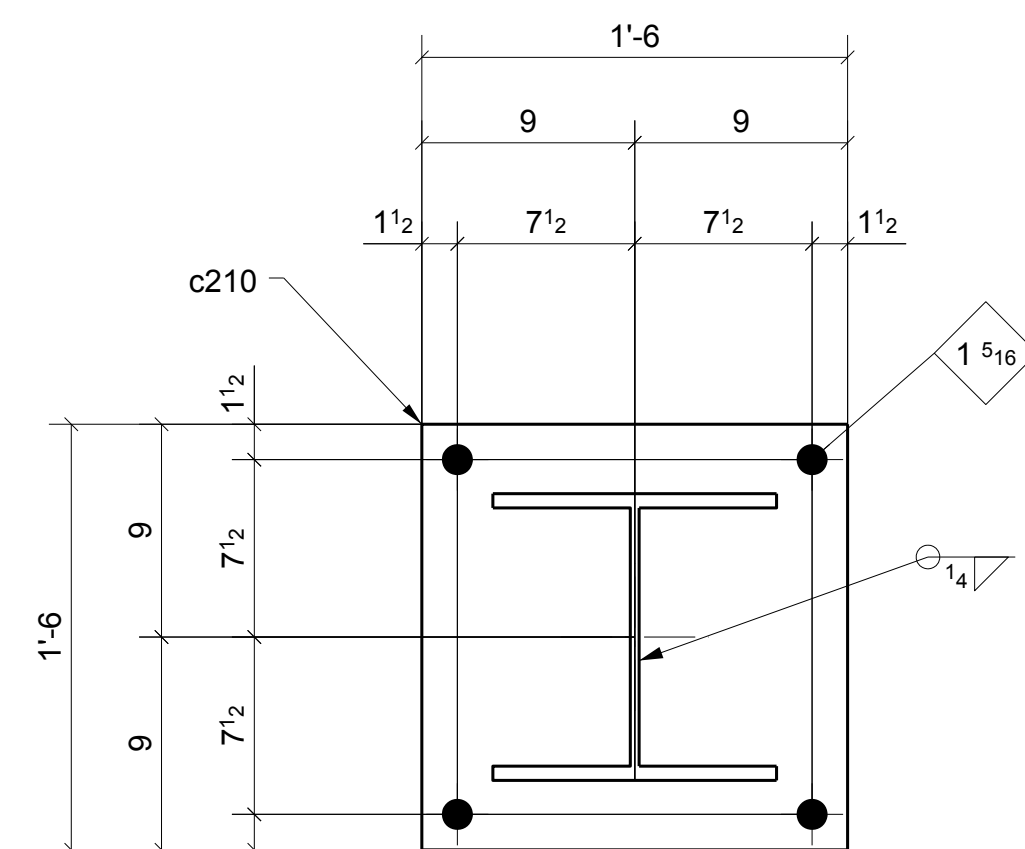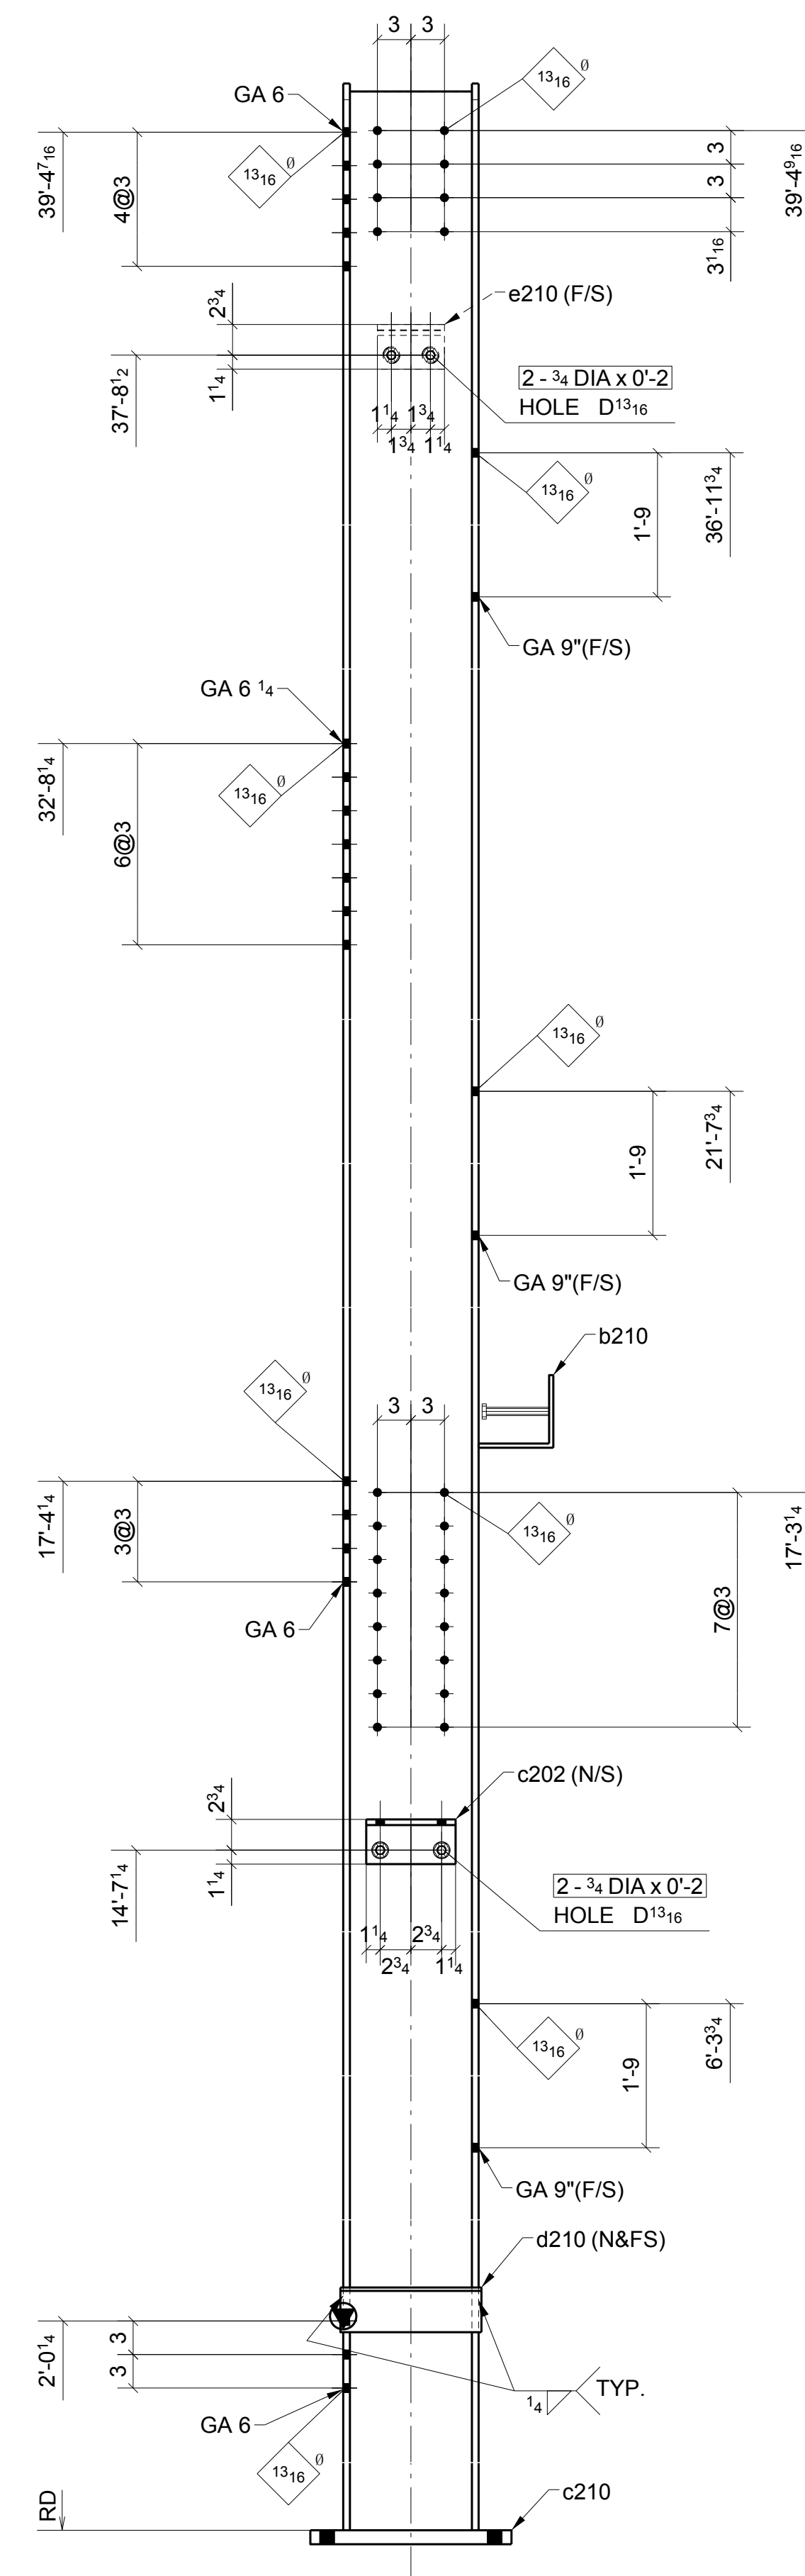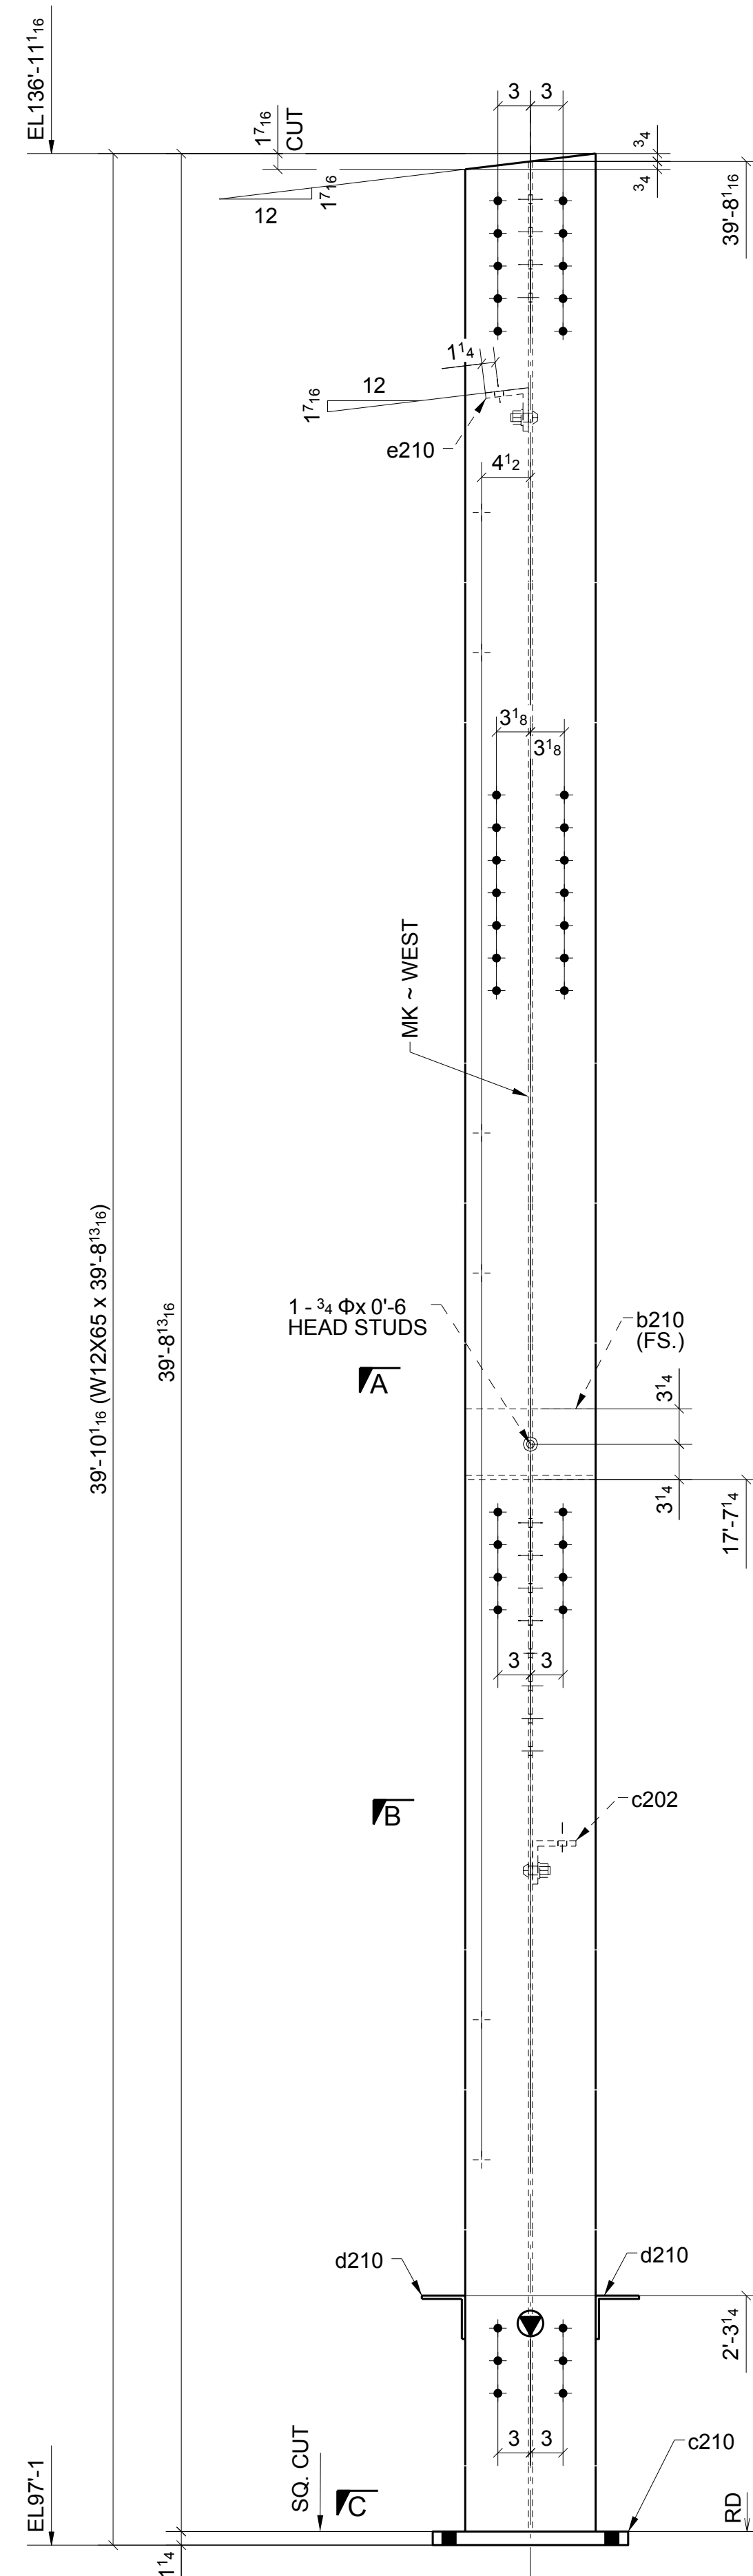

ONE - COLUMN ~ 210A

LOCATION: ONE @ 2/C.3 (REF: E2A,E2B)

SHOP BOLT IN SLOTTED HOLE
NEED "HAND TIGHTEN"

A	FOR APPROVAL		05/30/16
Sequence:	<u>2</u>	Ref. E-Plans:	<u>-</u>
Material:	<u>A992</u>	U.O.	<u>1 1/2"</u> U.O.
Holes:	<u>13/16" DIA.</u>	Bolts:	<u>NOTED</u>
Cleaning:	<u>NONE</u>		
Paint:	<u>NO</u>		
DFT:	<u> </u>	COLOR:	<u> </u>


[illegible]

Romac By: _____ Checked By: _____



Beamline By: _____ Checked By: _____

ATLAS IRON WORKS


ST. LOUIS, MO.

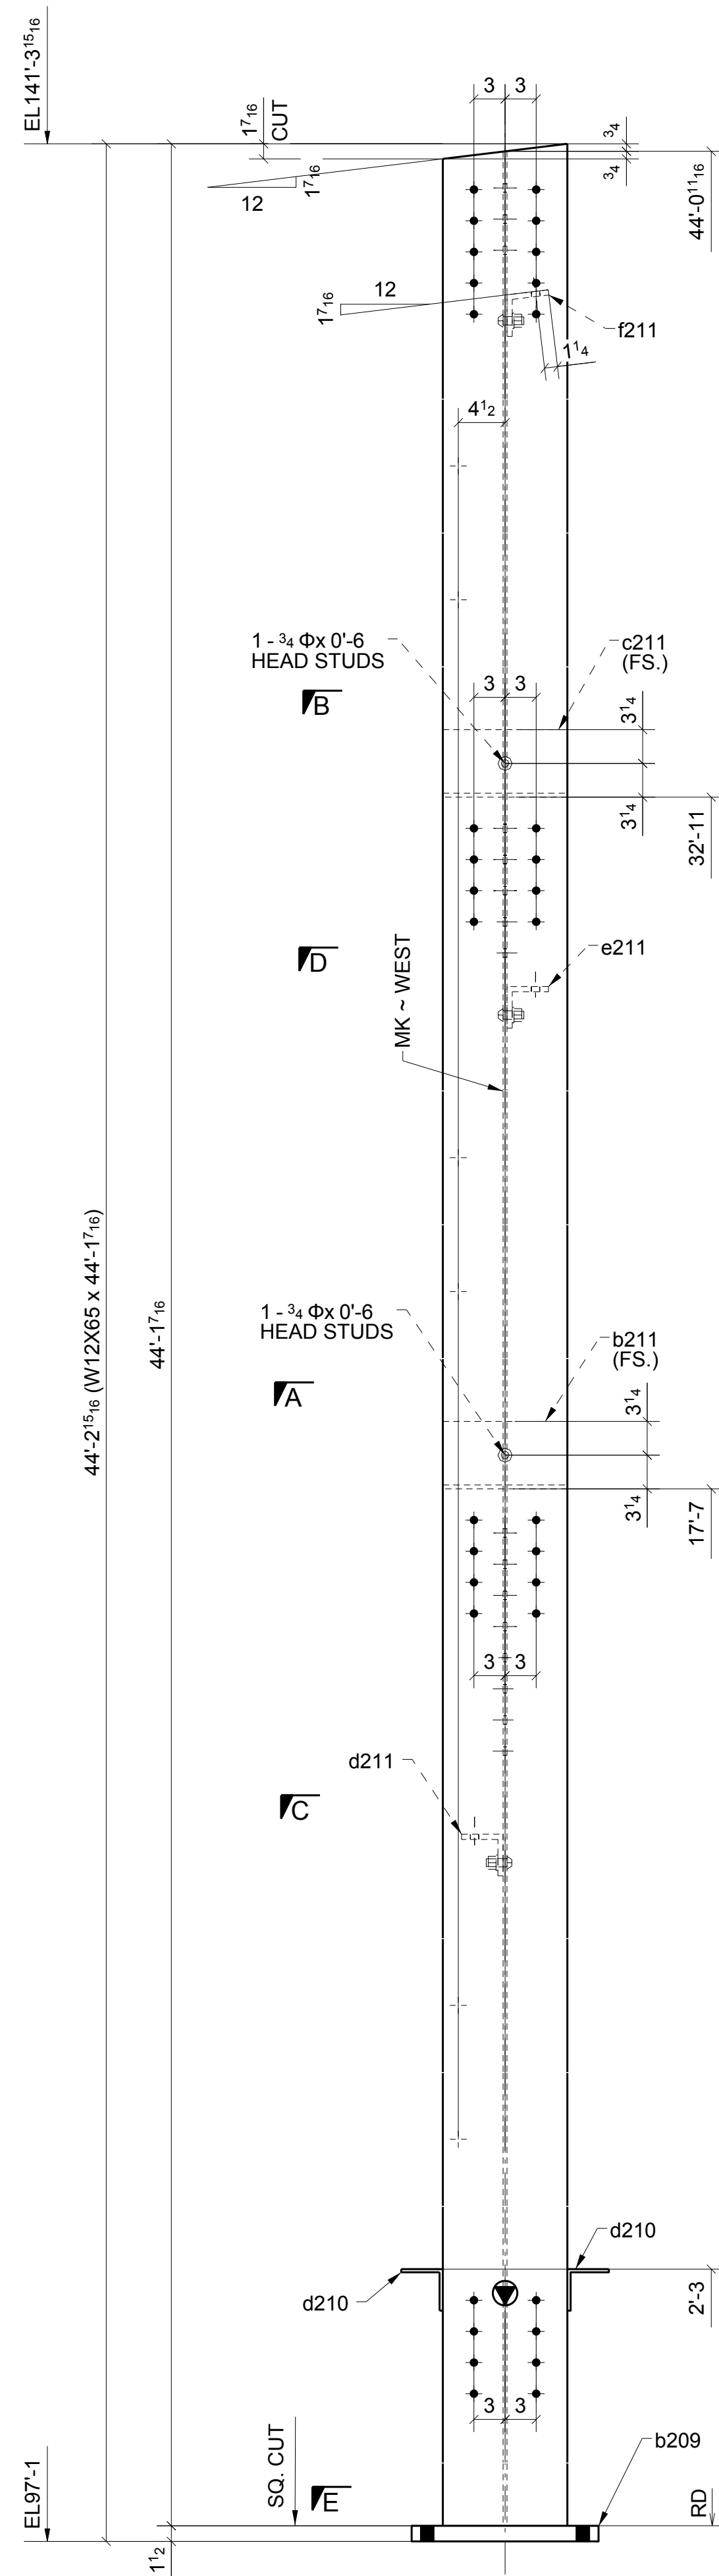


ONE - COLUMN ~ 211A
LOCATION: ONE @ 3/C.3 (REF: E2A,E2B)

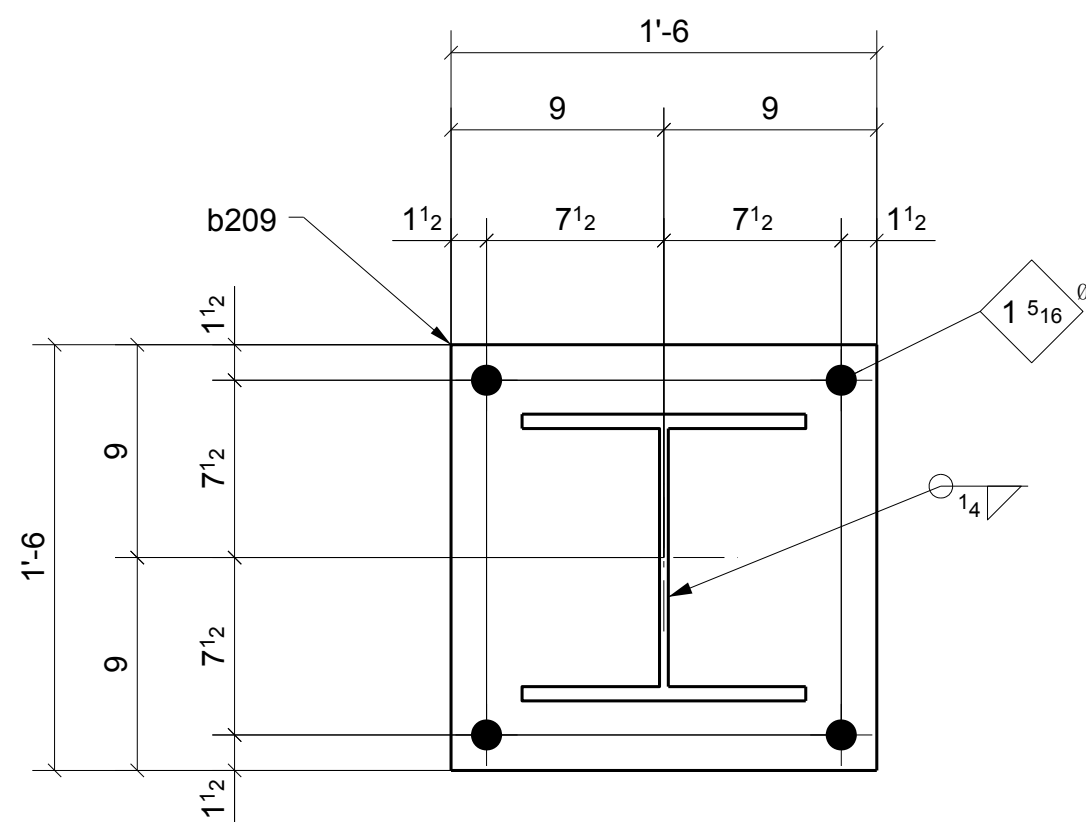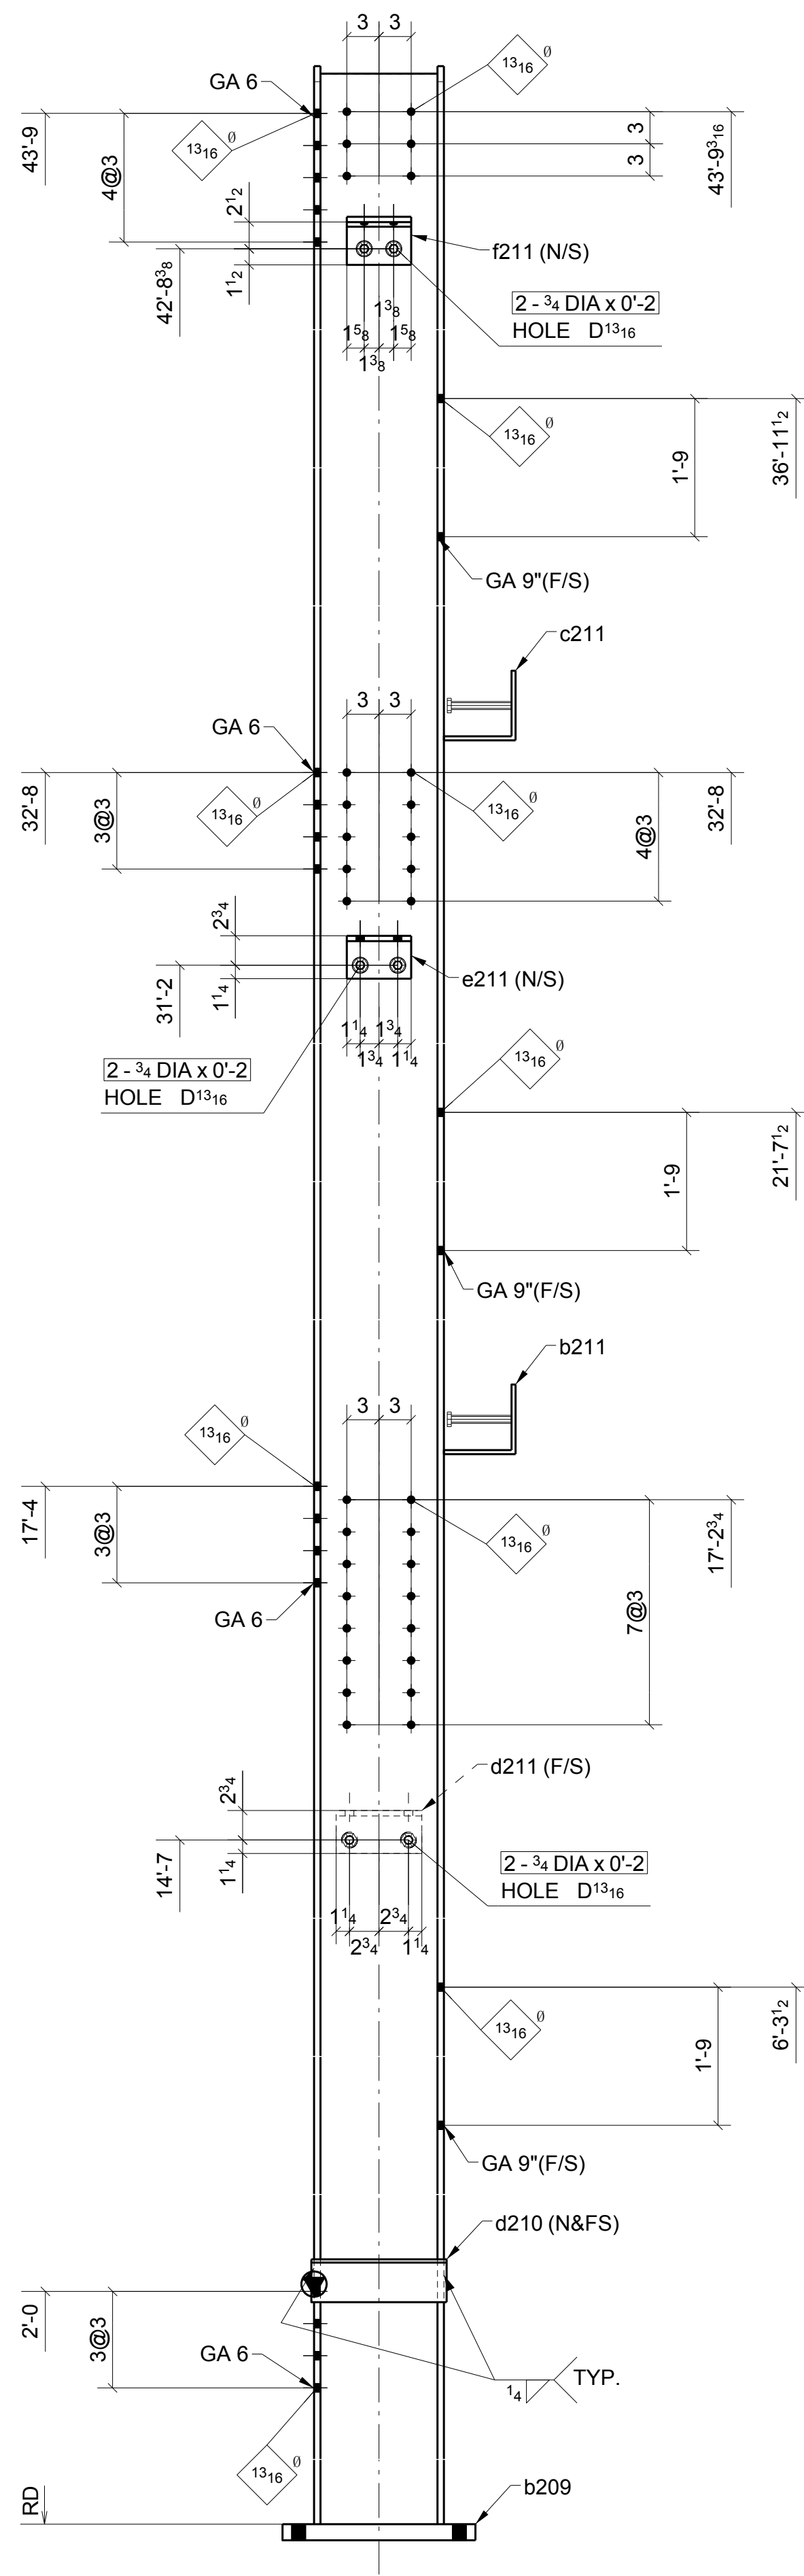


SECTION - E

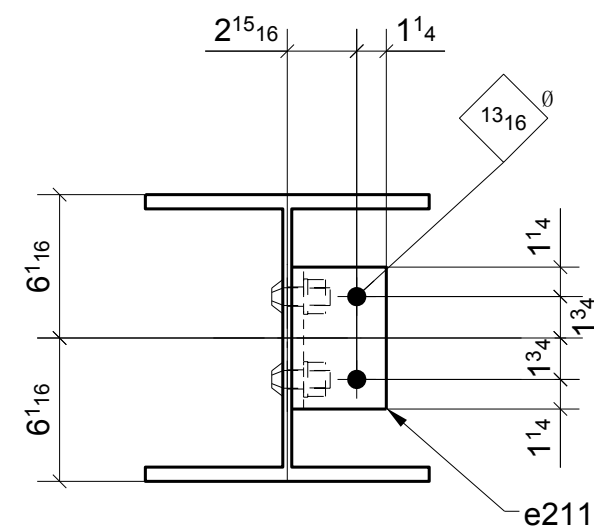


SECTION - D

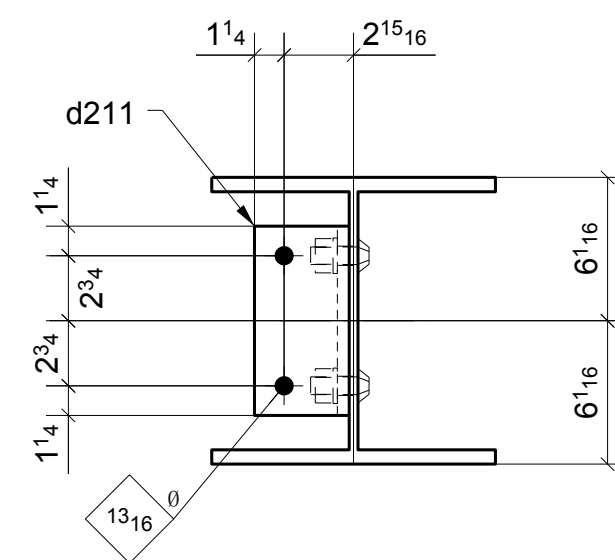

SECTION - C

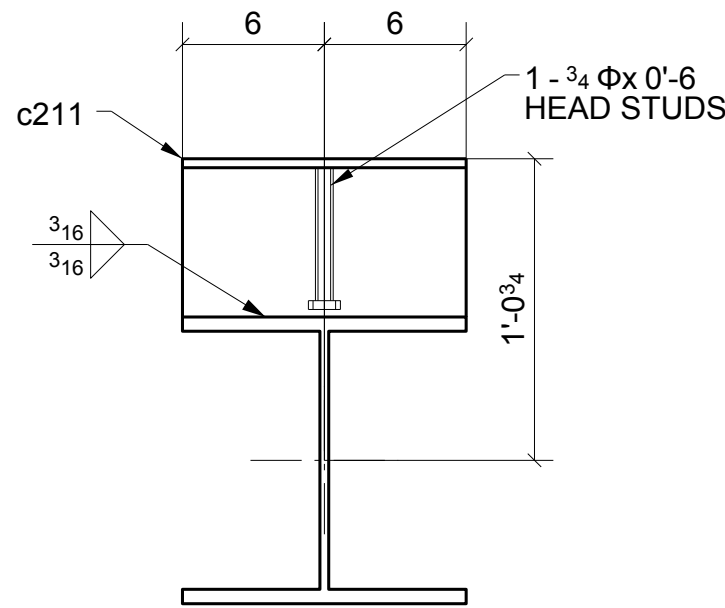

SECTION - B

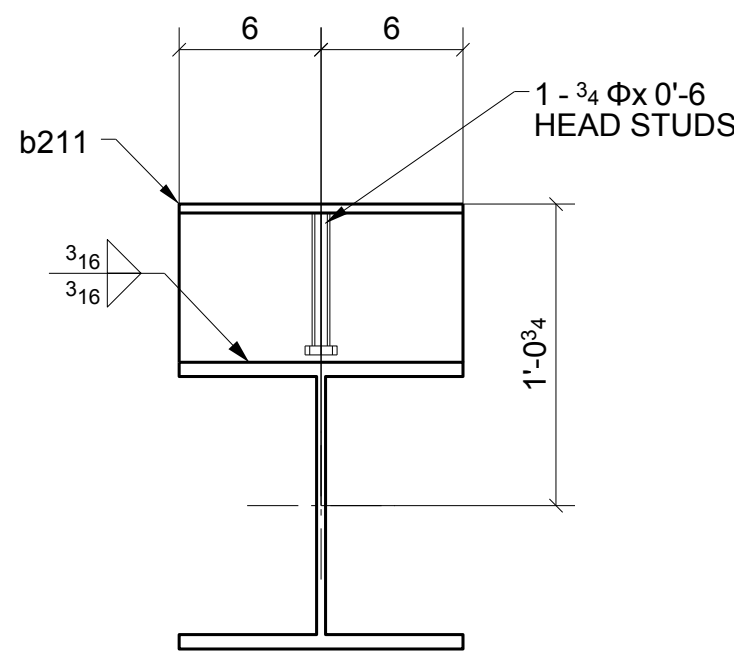

SECTION - A

SHOP BOLT IN SLOTTED HOLE
NEED "HAND TIGHTEN"

MATERIAL LIST


QTY	MARK	DESCRIPTION	LENGTH	MATERIAL	NOTES
1	211A	W12X65	44'-1.7/16"	A992	
1	b209	PL 1 1/2"X18"	1'-6"	A36	
1	b211	BPL 3/8"X12"	1'-1.3/16"	A36	
1	c211	BPL 3/8"X12"	1'-1.3/16"	A36	
2	d210	L4X4X5/16	1'-0.5/8"	A36	
1	d211	L4X4X1/2	0'-8"	A36	
1	e211	L4X4X1/2	0'-6"	A36	
1	f211	BPL 1/2"X8	0'-6"	A36	
6		3/4" DIA. W/N&W	0'-2"	A325N TC	
2		3/4" STUD	0'-6"		

Romac By: _____ Checked By: _____
Beamline By: _____ Checked By: _____

ATLAS IRON WORKS
ST. LOUIS, MO.

Project: WEBSTER UNIVERSITY INTERDISCIPLINARY SCIENCE BUILDING
Customer: PARIC CORPORATION
Owner: WEBSTER UNIVERSITY
Location: WEBSTER GUOVES.MO 63119
Dwn: GQG Date: 05/27/2016 Ckd: LJ Date: 05/30/2016
Job No. A16013 BAT: _____ DWG#: 211

FOR APPROVAL				05/30/16	
Sequence:	2	Ref. E-Plans:	-		
Material:	A992	U.N.O.	Edge Dist.:	1 1/2"	U.N.O.
Holes:	13/16"DIA.		Bolts:	NOTED	
Cleaning:	NONE				
Paint:	NO				
DFT:	COLOR: _____				

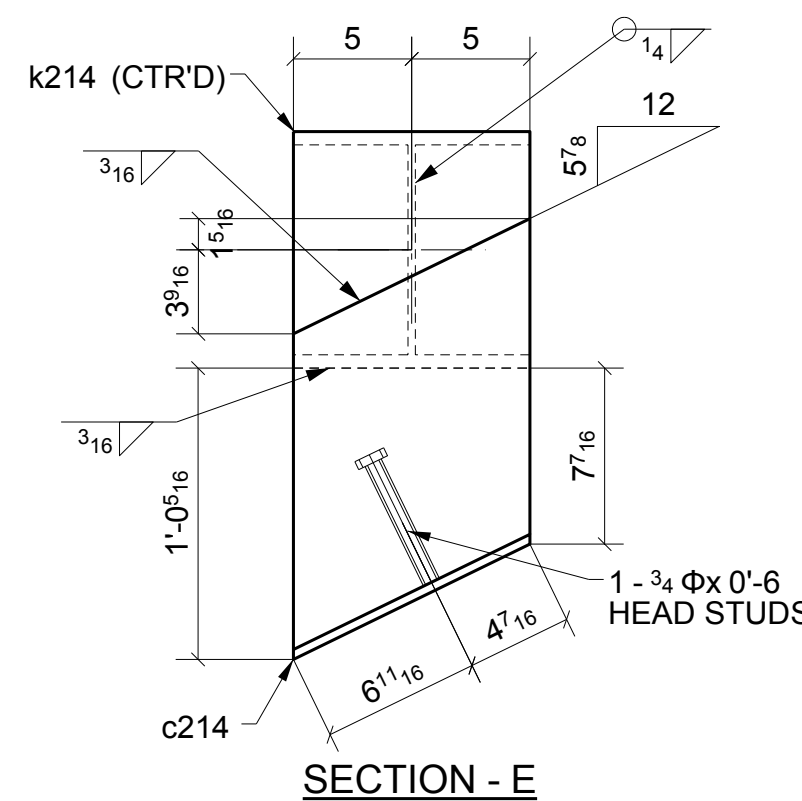

	FOR APPROVAL		05/30/16
	Sequence: 2	Ref. E-Plans:	-
	Material: A992 U.N.O.	Edge Dist:	1 1/2" U.N.O.
	Holes: 13/16" DIA.	Bolts:	NOTED
	Cleaning:	NONE	
	Paint:	NO	
DFT: _____		COLOR: _____	

SHOP BOLT IN SLOTTED HOLE
NEED "HAND TIGHTEN"

Romac By: _____	Checked By: _____
Beamline By: _____	Checked By: _____

ATLAS IRON WORKS

ST. LOUIS, MO.

Project:	WEBSTER UNIVERSITY INTERDISCIPLINARY SCIENCE BUILDING
Customer:	PARIC CORPORATION
Owner:	WEBSTER UNIVERSITY
Location:	WEBSTER GUVOMES, MO 63119

Dwn:	ZZ	Date:	05/27/2016	Ckd:	LJ	Date:	05/30/2016
------	----	-------	------------	------	----	-------	------------

Job No.	A16013	BAT:	DWG#:	217
---------	--------	------	-------	-----



Romac By: _____	Checked By: _____
Beamline By: _____	Checked By: _____
ATLAS IRON WORKS ST. LOUIS, MO.	
Project: _____ WEBSTER UNIVERSITY INTERDISCIPLINARY SCIENCE BUILDING	
Customer: _____ PARIC CORPORATION	
Owner: _____ WEBSTER UNIVERSITY	
Location: _____ WEBSTER GUVOM, MO 63119	
Dwn: ZZ	Date: 05/27/2016
Ckd: LJ	Date: 05/30/2016
Job No. _____ A16013	
BAT: _____	DWG#: 219

Roman By:	_____	Checked By:	_____
Baseline By:	_____	Checked By:	_____
ATLAS IRON WORKS ST. LOUIS, MO.			
Project:	WEBSTER UNIVERSITY INTERDISCIPLINARY SCIENCE BUILDING		
Customer:	PARIC CORPORATION		
Owner:	WEBSTER UNIVERSITY		
Location:	WEBSTER GUVES.MO 63119		
Dwn:	ZZ	Date:	05/27/2016
Ckd:	LJ	Date:	05/30/2016
Job No.	A16013	BAT:	DWG# 221



A	FOR APPROVAL		05/30/16	
Sequence:	<u>2</u>		Ref. E-Plans:	<u>-</u>
Material:	<u>A992</u>	<u>U.N.O.</u>	Edge Dist.:	<u>1 1/2"</u> <u>U.N.O.</u>
Holes:	<u>13/16"DIA.</u>		Bolts:	<u>NOTED</u>
Cleaning:	<u>NONE</u>			
Paint:	<u>NO</u>			
DFT:	<u> </u>		COLOR:	<u> </u>

Romac By: _____	Checked By: _____
Beamline By: _____	Checked By: _____


ATLAS IRON WORKS

ST. LOUIS, MO.

Project:	WEBSTER UNIVERSITY INTERDISCIPLINARY SCIENCE BUILDING
Customer:	PARIC CORPORATION
Owner:	WEBSTER UNIVERSITY
Location:	WEBSTER GUVOMES, MO 63119

Dwn:	ZZ	Date:	05/27/2016	Ckd:	LJ	Date:	05/30/2016
------	----	-------	------------	------	----	-------	------------

Job No.	A16013	BAT:	DWGS:	222
---------	--------	------	-------	-----

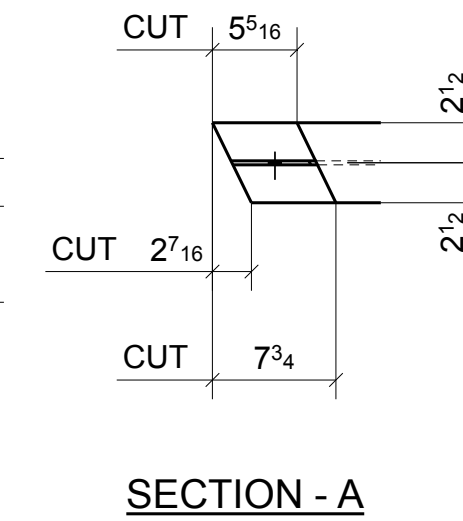

Roman By: _____	Checked By: _____
Beamline By: _____	Checked By: _____
ATLAS IRON WORKS ST. LOUIS, MO.	
Project: _____	WEBSTER UNIVERSITY INTERDISCIPLINARY SCIENCE BUILDING
Customer: _____	PARIC CORPORATION
Owner: _____	WEBSTER UNIVERSITY
Location: _____	WEBSTER GROVES, MO 63119
Dwn: ZZ Date: 05/27/2016 Ckd: LJ Date: 05/30/2016	
Job No. A16013	BAT: _____ DWG#: 223

SHOP BOLT IN SLOTTED HOLE
NEED "HAND TIGHTEN"

A	FOR APPROVAL		05/30/16
	Sequence: <u>2</u>	Ref. E-Plans: <u> </u>	
	Material: <u>A992</u> U.N.O.	Edge Dist.: <u>1 1/2"</u>	U.N.O.
	Holes: <u>13/16" DIA.</u>	Bolts: <u>NOTED</u>	
	Cleaning: <u>NONE</u>		
Paint: <u>NO</u>			
DFT: <u> </u>	COLOR: <u> </u>		

[illegible]

Romac By: _____ Checked By: _____

Beamline By: _____ Checked By: _____

ATLAS IRON WORKS

ST. LOUIS, MO.

Project: WEBSTER UNIVERSITY INTERDISCIPLINARY SCIENCE BUILDING


Customer: PARIC CORPORATION

Owner: WEBSTER UNIVERSITY

Location: WEBSTER GYMNASIUM, MO 63119


Dwn: ZZ Date: 05/27/2016 Ckd: LJ Date: 05/30/2016

Job No. A16013 BAT: DWG#: 224

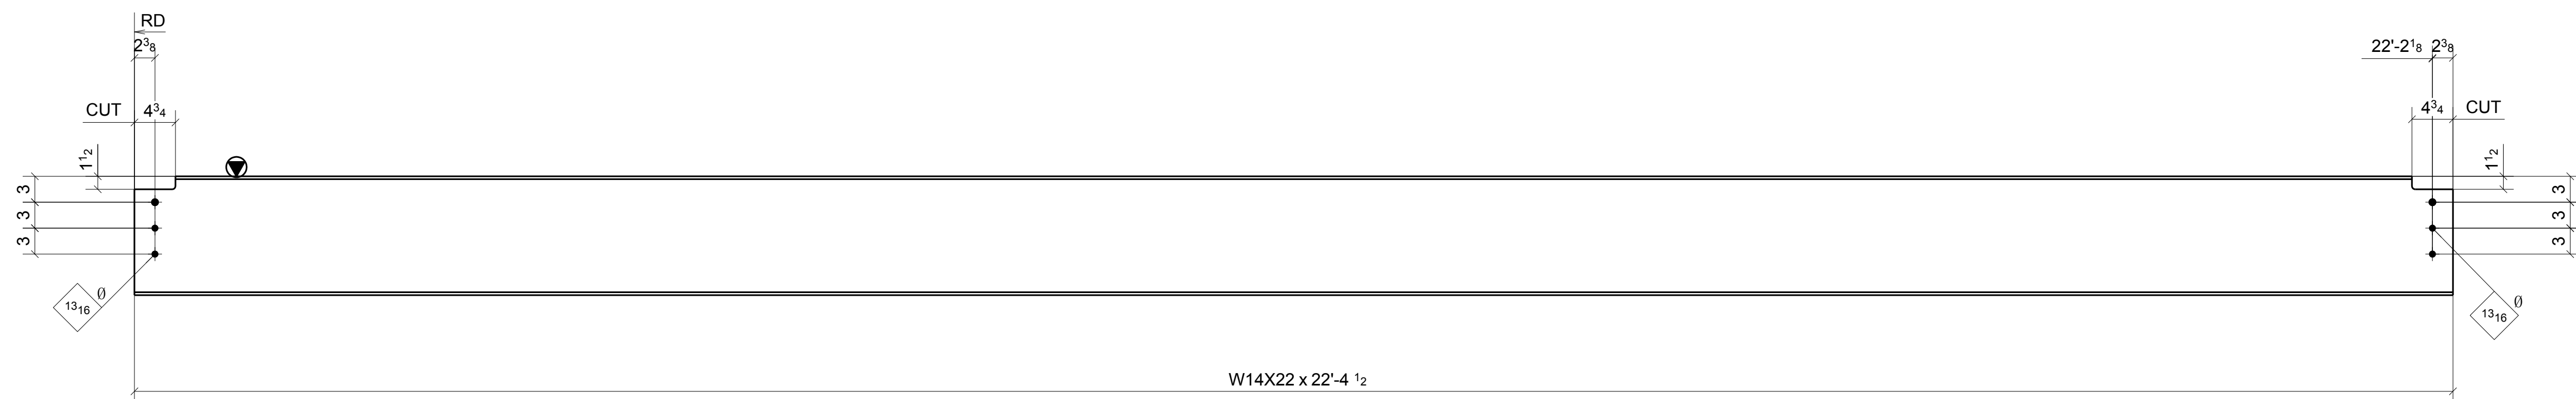


ONE - BEAM ~ 224A

LOCATION: ONE @ 1.7-1.9/A.5-B.3 (REF: E2A)

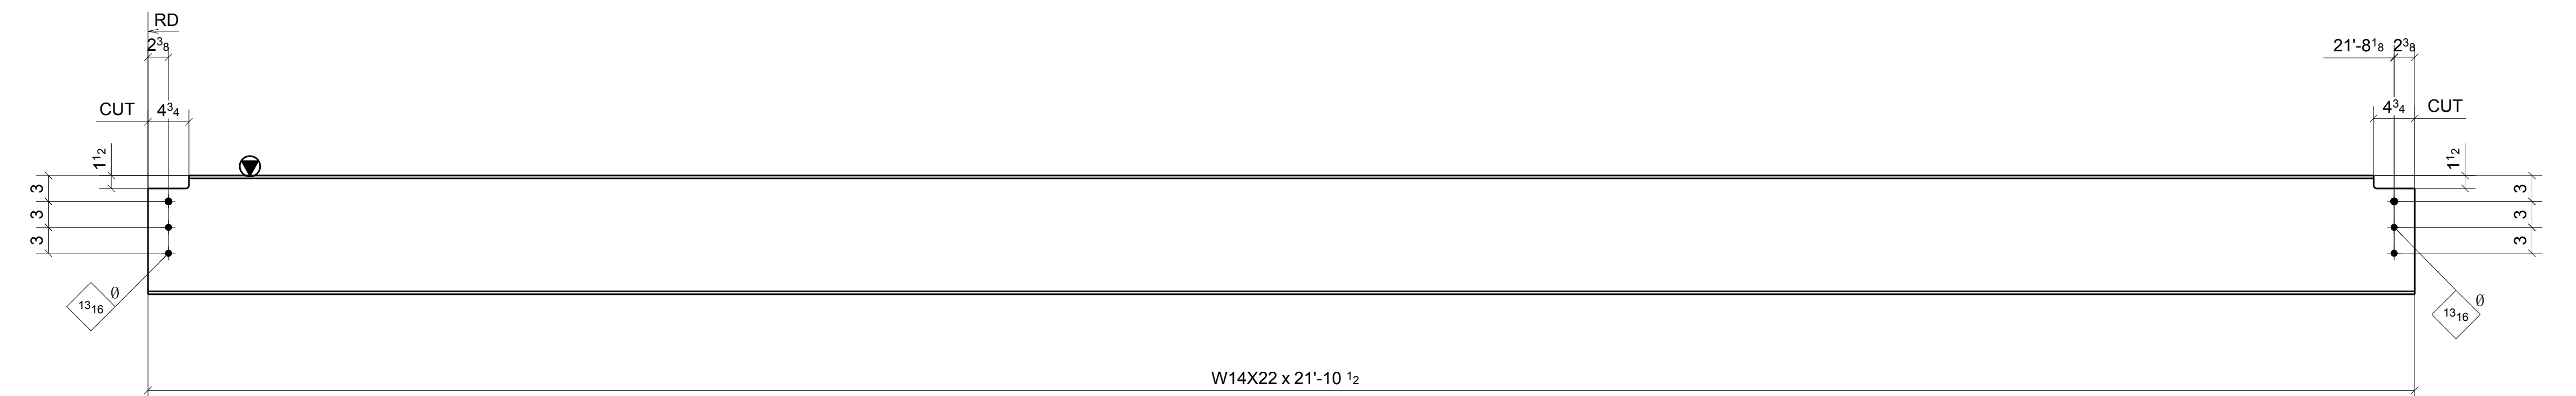

ONE - BEAM ~ 224B
 LOCATION: ONE @ 1.7-1.9/B.3-C (REF: E2A)

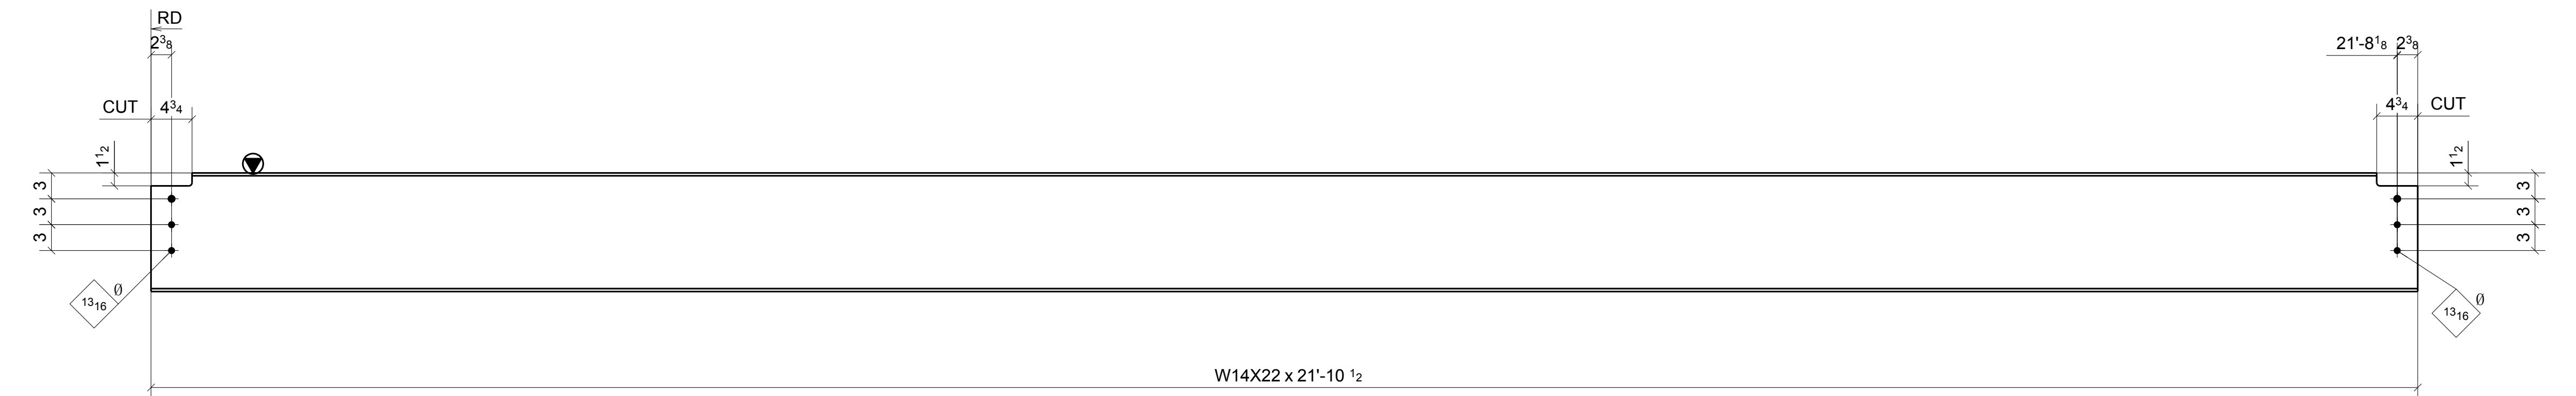

ONE - BEAM ~ 224C


LOCATION: ONE @ 1.9/B.3-C (REF: E2A)

SHOP BOLT IN SLOTTED HOLE
NEED "HAND TIGHTEN"

	FOR APPROVAL		05/30/16	
	Sequence:	2	Ref. E-Plans:	-
	Material:	A992 U.N.O.	Edge Dist.:	1 1/2" U.N.O.
	Holes:	13/16" DIA.	Bolts:	NOTED
	Cleaning:	NONE		
	Paint:	NO		
DFT:		COLOR:		

MATERIAL LIST

QTY	MARK	DESCRIPTION	LENGTH	MATERIAL	NOTES
1	231A	W18X35	13'-10 11/16"	A992	
6	b219	L4X4X5/16	0'-5 1/2"	A36	
2	b225	L4X4X5/16	0'-8 1/2"	A36	
4	b231	L4X4X5/16	1'-2 1/2"	A36	
1		3/4" DIA. W/N&W	0'-1 3/4"	A325N TC	
2		3/4" DIA. W/N&W	0'-2"	A325N TC	
2		3/4" DIA. W/N&W	0'-2 1/4"	A325N TC	
4		3/4" DIA. W/N&W	0'-2 1/4"	A325N TC	
10		3/4" DIA. W/N&W	0'-2 1/4"	A325N TC	

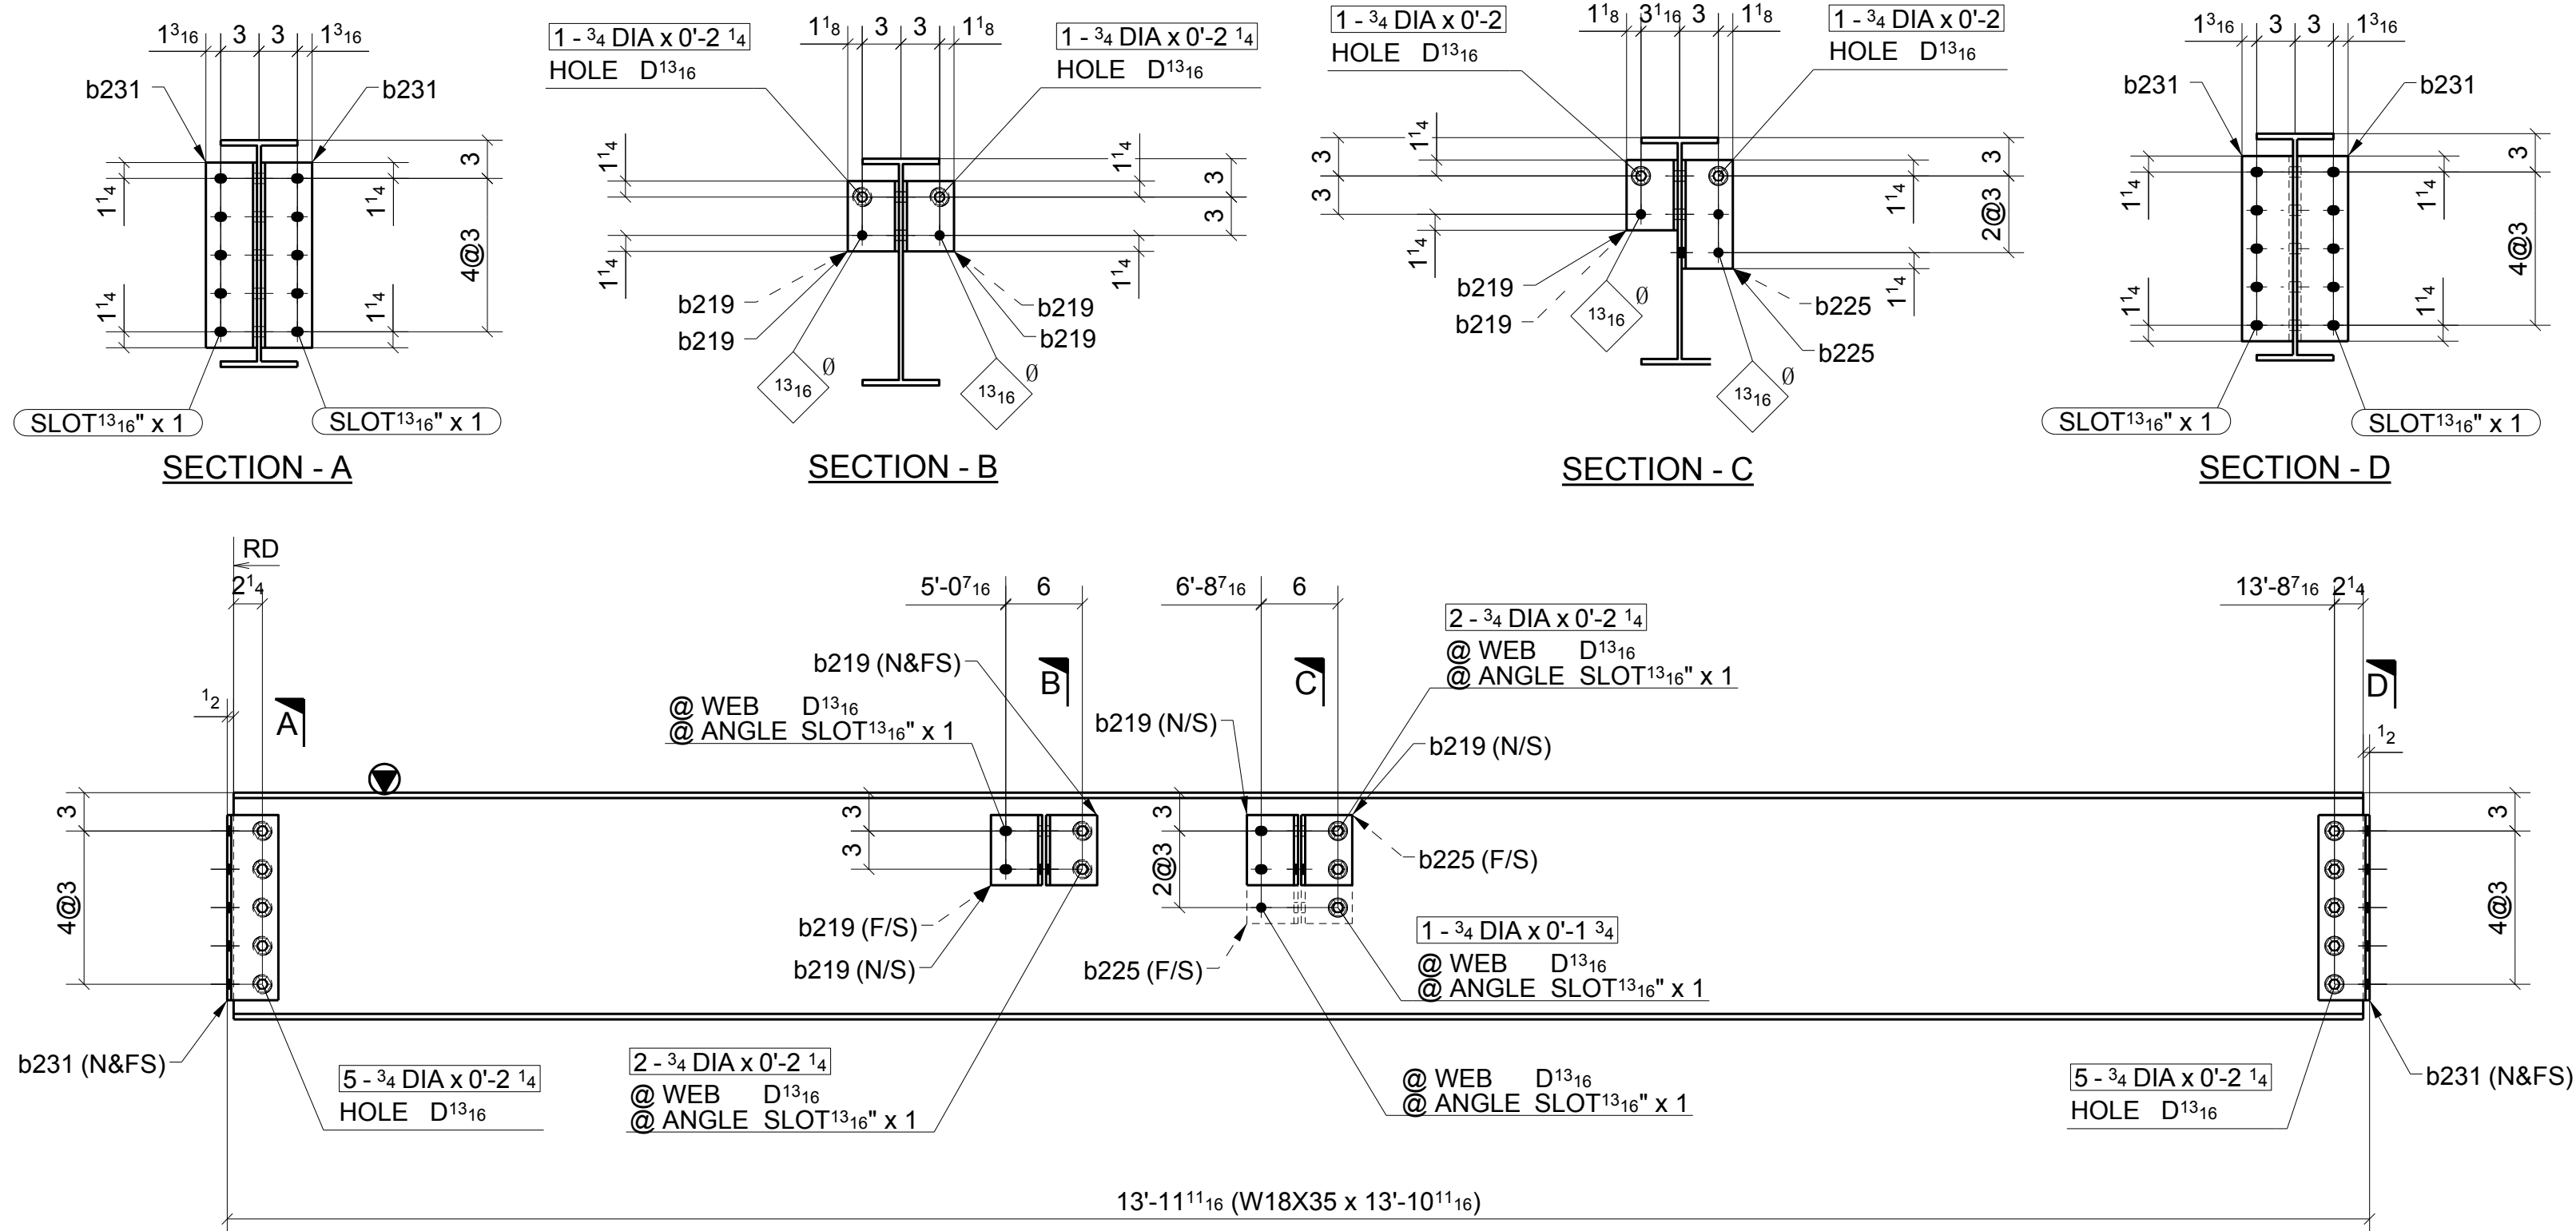

ONE - BEAM ~ 231A

LOCATION: ONE @ 2.6-3/B.3 (REF: E2A)

SHOP BOLT IN SLOTTED HOLE
NEED "HAND TIGHTEN"

Romac By: _____ Checked By: _____
Beamline By: _____ Checked By: _____


ATLAS IRON WORKS
ST. LOUIS, MO.

Project: WEBSTER UNIVERSITY INTERDISCIPLINARY SCIENCE BUILDING
Customer: PARIC CORPORATION
Owner: WEBSTER UNIVERSITY
Location: WEBSTER GUOVES, MO 63119
Dwn: ZZ Date: 05/27/2016 Ckd: L.J. Date: 05/30/2016
Job No. A16013 BAT: _____ DWG#: 231

FOR APPROVAL				06/30/16
Sequence:	2	Ref. E-Plans:	-	
Material:	A992 U.N.O.	Edge Dist.:	1 1/2" U.N.O.	
Holes:	13/16"DIA.	Bolts:	NOTED	
Cleaning:	NONE			
Paint:	NO			
DFT:		COLOR:		

MATERIAL LIST

QTY	MARK	DESCRIPTION	LENGTH	MATERIAL	NOTES
1	232A	W21X44	20'-10 5/8"	A992	
1	b232	BPL5/16""15	20'-1 3/16"	A36	
1	c232	L4X4X5/16	0'-11 1/2"	A36	
1	d232	L4X4X5/16	0'-11 1/2"	A36	
2	e232	L4X4X5/16	1'-5 1/2"	A36	
4	f232	L4X4X5/16	0'-11 1/2"	A36	
1	g232	PL5/8"X17 1/16"	3'-9 3/8"	A572-GR.50	
1	h232	PL5/8"X17 1/8"	4'-0 5/8"	A572-GR.50	
2	i232	PL5/8"X3 1/16"	1'-7 3/4"	A36	
6		3/4" DIA. W/N&W	0'-2 1/4"	A325N TC	
2		3/4" DIA. W/N&W	0'-2"	A325N TC	
4		3/4" DIA. W/N&W	0'-2 1/4"	A325N TC	
8		3/4" DIA. W/N&W	0'-2"	A325N TC	
17		3/4" STUD	0'-6"		

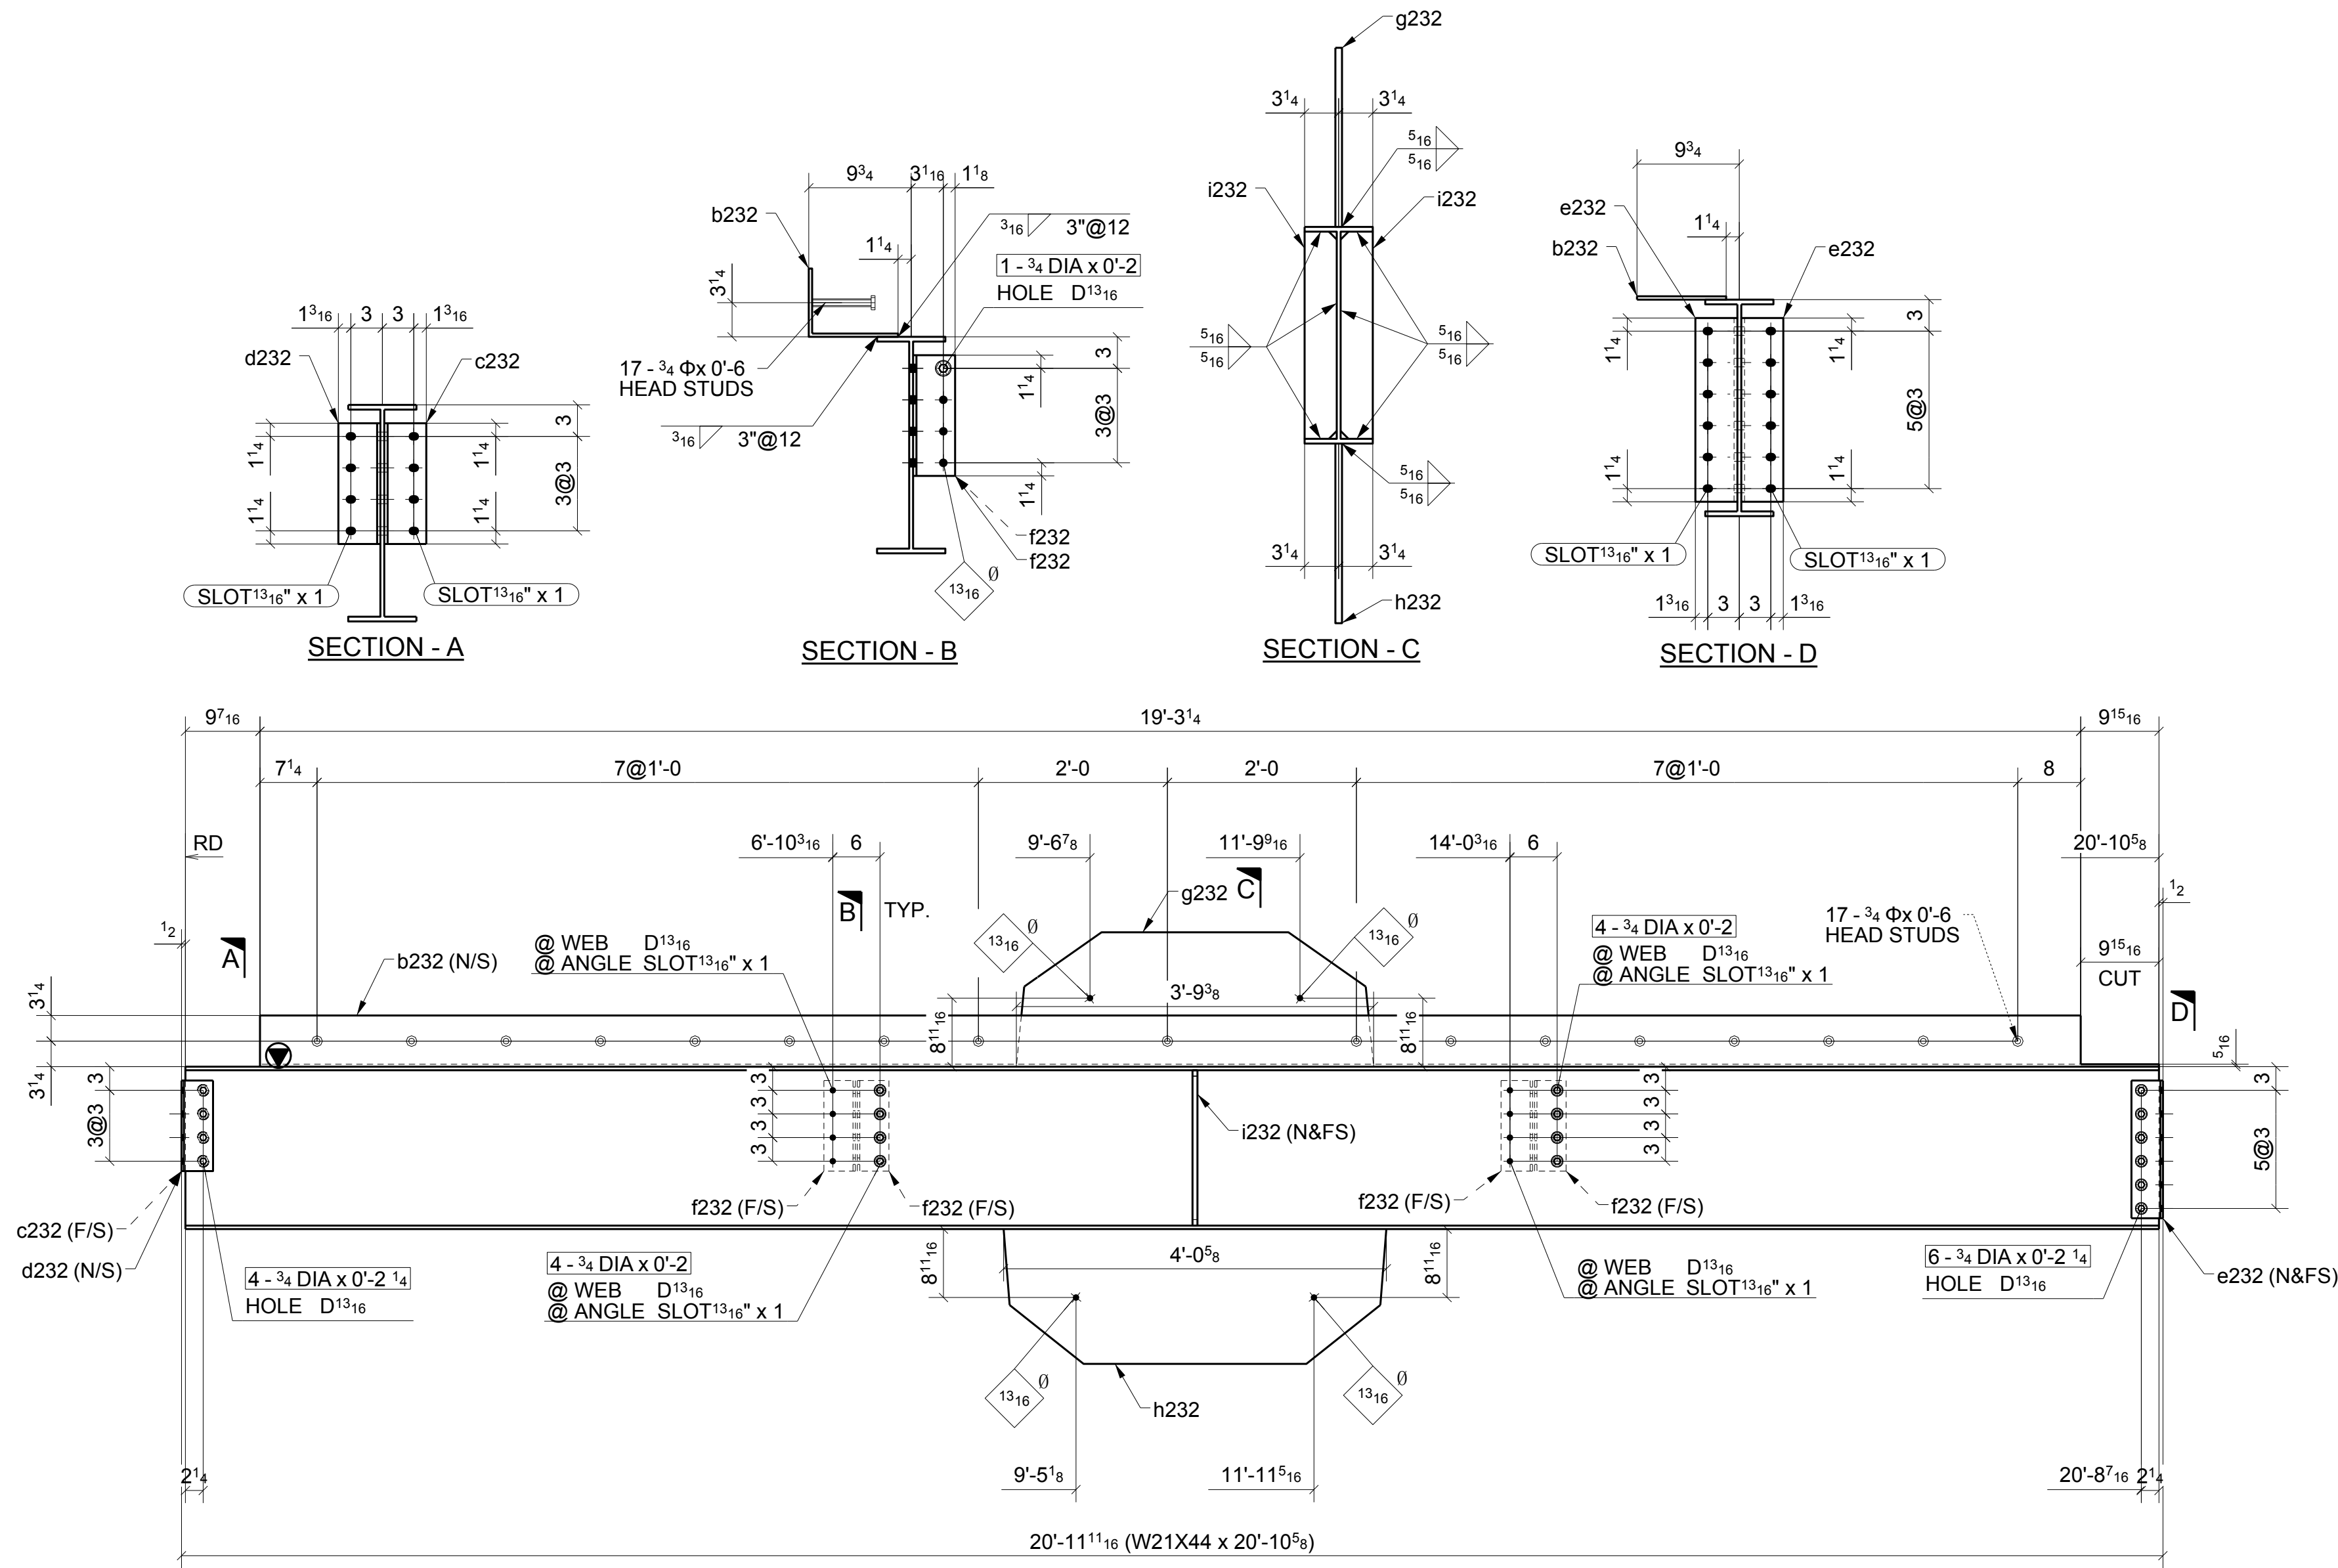

ONE - BEAM ~ 232A

LOCATION: ONE @ 2-2.6/B.3 (REF: E2A)

SHOP BOLT IN SLOTTED HOLE
NEED "HAND TIGHTEN"

FOR APPROVAL				06/30/16
Sequence:	2	Ref. E-Plans:	-	
Material:	A992 U.N.O.	Edge Dist.:	1 1/2" U.N.O.	
Holes:	13/16"DIA.	Bolts:	NOTED	
Cleaning:	NONE			
Paint:	NO			
DFT:		COLOR:		

Romac By: _____ Checked By: _____
Beamline By: _____ Checked By: _____


ATLAS IRON WORKS
ST. LOUIS, MO.

Project: WEBSTER UNIVERSITY INTERDISCIPLINARY SCIENCE BUILDING
Customer: PARIC CORPORATION
Owner: WEBSTER UNIVERSITY
Location: WEBSTER GUOVES, MO 63119
Dwn: ZZ Date: 05/27/2016 Ckd: L.J. Date: 05/30/2016
Job No. A16013 BAT: _____ DWG#: 232

[illegible]

ATLAS IRON WORKS
ST. LOUIS, MO.

Project: WEBSTER UNIVERSITY INTERDISCIPLINARY SCIENCE BUILDING
 Customer: PARIC CORPORATION
 Owner: WEBSTER UNIVERSITY
 Location: WEBSTER GUOVES.MO 63119
 Dwn: ZZ Date: 05/27/2016 Ckd: L.J Date: 05/30/2016
 Job No. A16013 BAT: DWG# 233

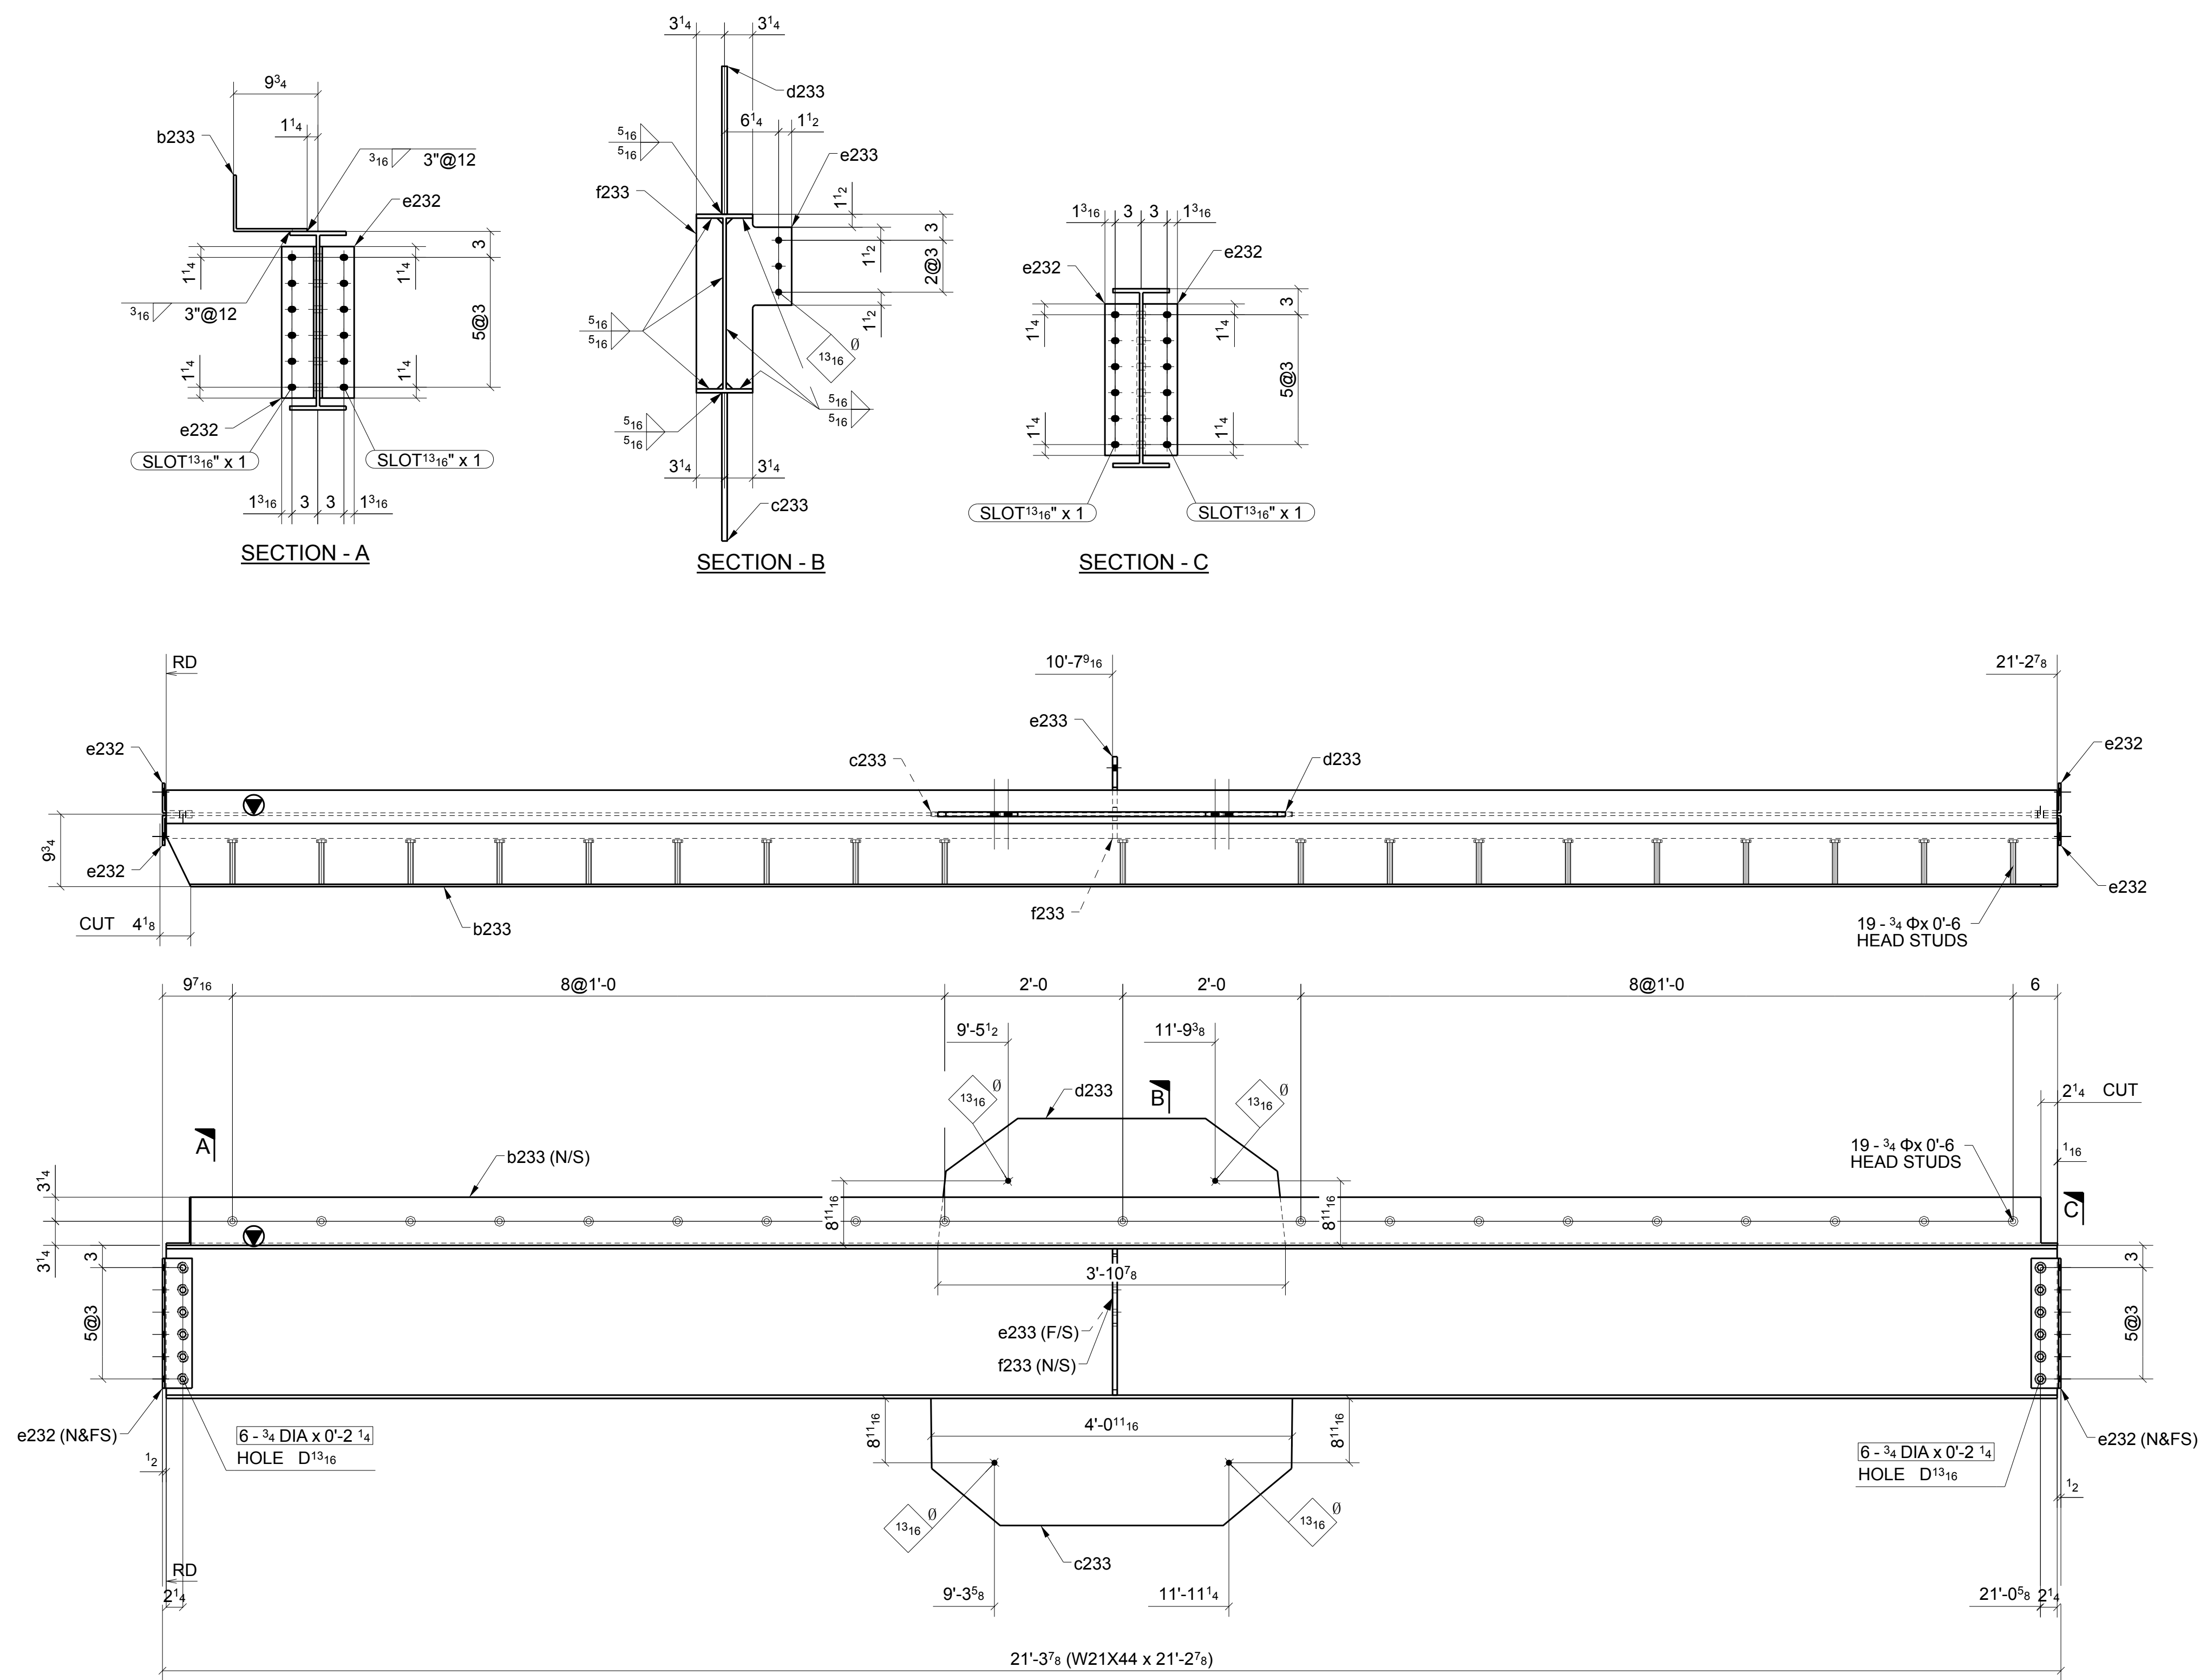

ONE - BEAM ~ 233A


LOCATION: ONE @ 2/A.5-B.3 (REF: E2A)

SHOP BOLT IN SLOTTED HOLE
NEED "HAND TIGHTEN"

	FOR APPROVAL		05/30/16	
	Sequence:	2	Ref. E-Plans:	-
	Material:	A992 U.N.O.	Edge Dist.:	1 1/2" U.N.O.
	Holes:	13/16" DIA.	Bolts:	NOTED
	Cleaning:	NONE		
	Paint:	NO		
DFT:		COLOR:		

MATERIAL LIST

QTY	MARK	DESCRIPTION	LENGTH	MATERIAL	NOTES
1	234A	W24X131	40'-0 1/4"	A992	
1	b234	L6X6X3/8	6'-8 7/16"	A36	
4	c222	PL 3/8"X4 1/2"	0'-9"	A36	
1	c234	L6X6X3/8	7'-7 1/2"	A36	
1	d234	L6X6X3/8	7'-6 11/16"	A36	
1	e234	L6X6X3/8	7'-11 1/8"	A36	
1	f234	L6X6X3/8	7'-4 9/16"	A36	
1	g234	PL 3/8"X4 1/2"	0'-10 3/4"	A36	
3	h234	PL 3/8"X4 1/2"	0'-6"	A36	

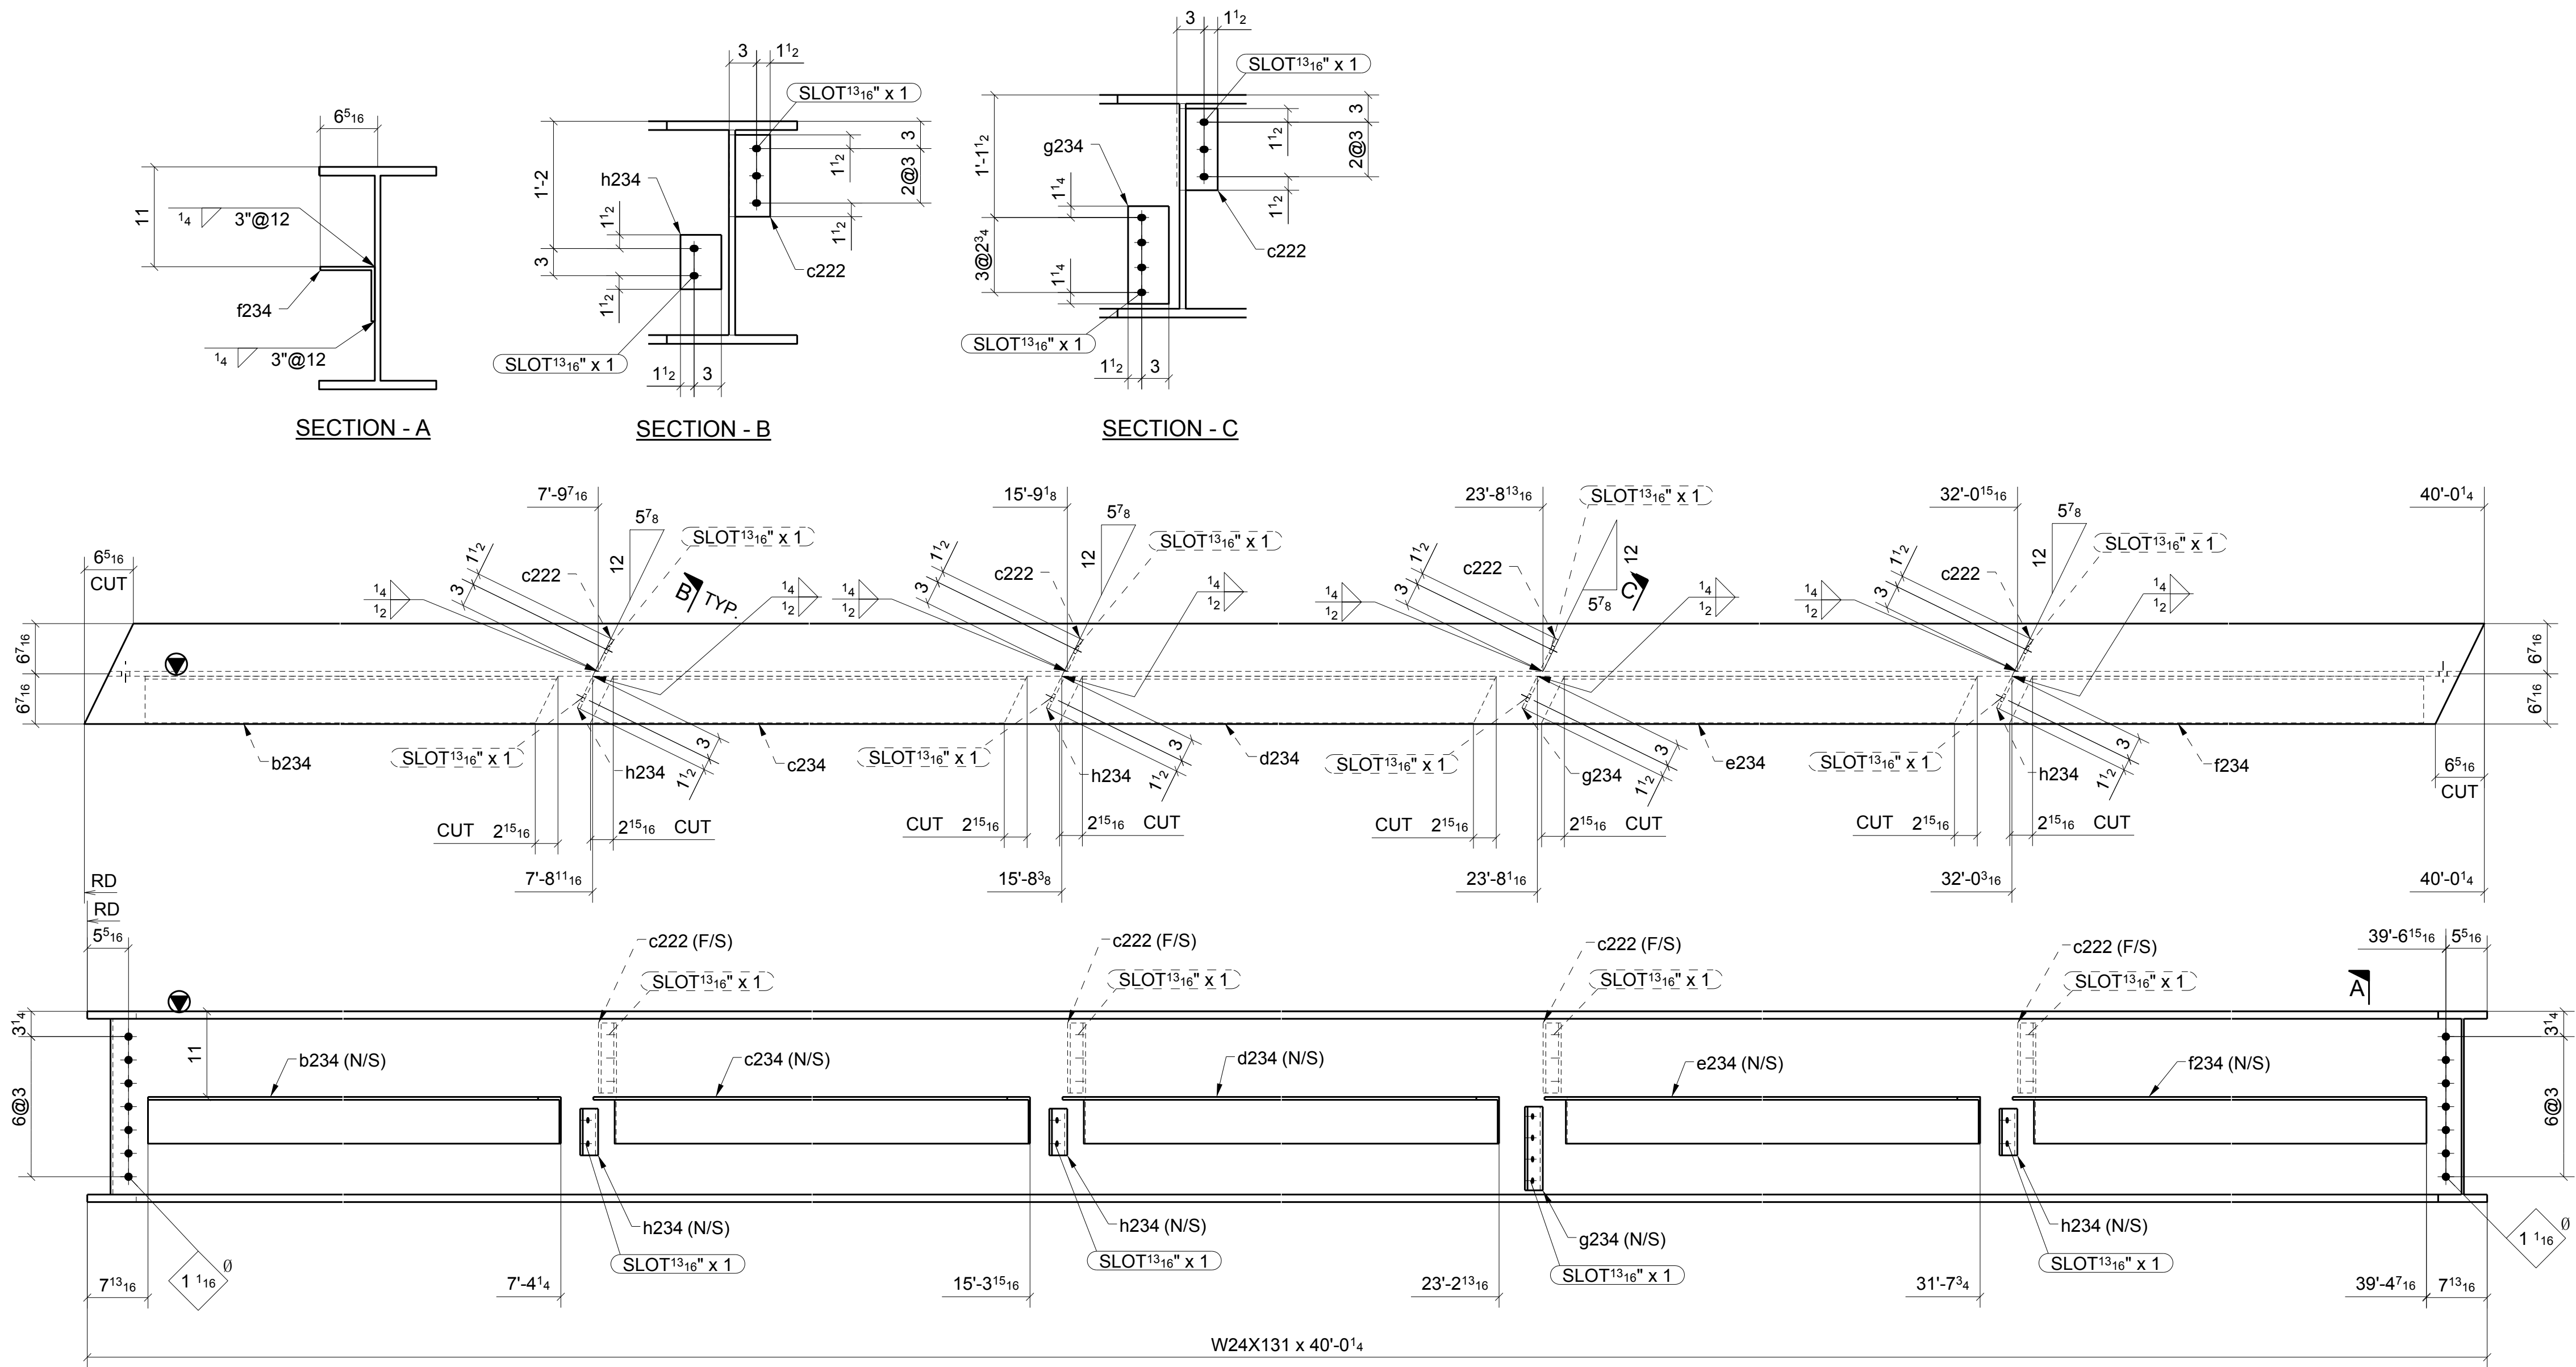

ONE - BEAM ~ 234A
LOCATION: ONE @ 2-3/4-A.5 (REF: E2A)

SHOP BOLT IN SLOTTED HOLE
NEED "HAND TIGHTEN"

FOR APPROVAL				06/30/16
Sequence:	2	Ref. E-Plans:	-	
Material:	A992 U.N.O.	Edge Dist.:	1 1/2"	U.N.O.
Holes:	13/16"DIA.	Bolts:	NOTED	
Cleaning:	NONE			
Paint:	NO			
DFT:		COLOR:		


Romac By: _____ Checked By: _____
Beamline By: _____ Checked By: _____

ATLAS IRON WORKS
ST. LOUIS, MO.

Project: WEBSTER UNIVERSITY INTERDISCIPLINARY SCIENCE BUILDING
Customer: PARIC CORPORATION
Owner: WEBSTER UNIVERSITY
Location: WEBSTER GUOVES, MO 63119
Dwn: ZZ Date: 05/27/2016 Ckd: L.J. Date: 05/30/2016
Job No. A16013 BAT: _____ DWG# 234

MATERIAL LIST

QTY	MARK	DESCRIPTION	LENGTH	MATERIAL	NOTES
1	235A	W24X55	23'-9 9/16"	A992	
2	b235	L4X4X5/16	1'-2 1/2"	A36	
2	c235	L4X4X5/16	1'-8 1/2"	A36	
1	d235	PL 3/8"X4 1/2"	1'-6"	A36	
7		3/4" DIA. W/N&W	0'-2 1/4"	A325N TC	
5		3/4" DIA. W/N&W	0'-2 1/4"	A325N TC	

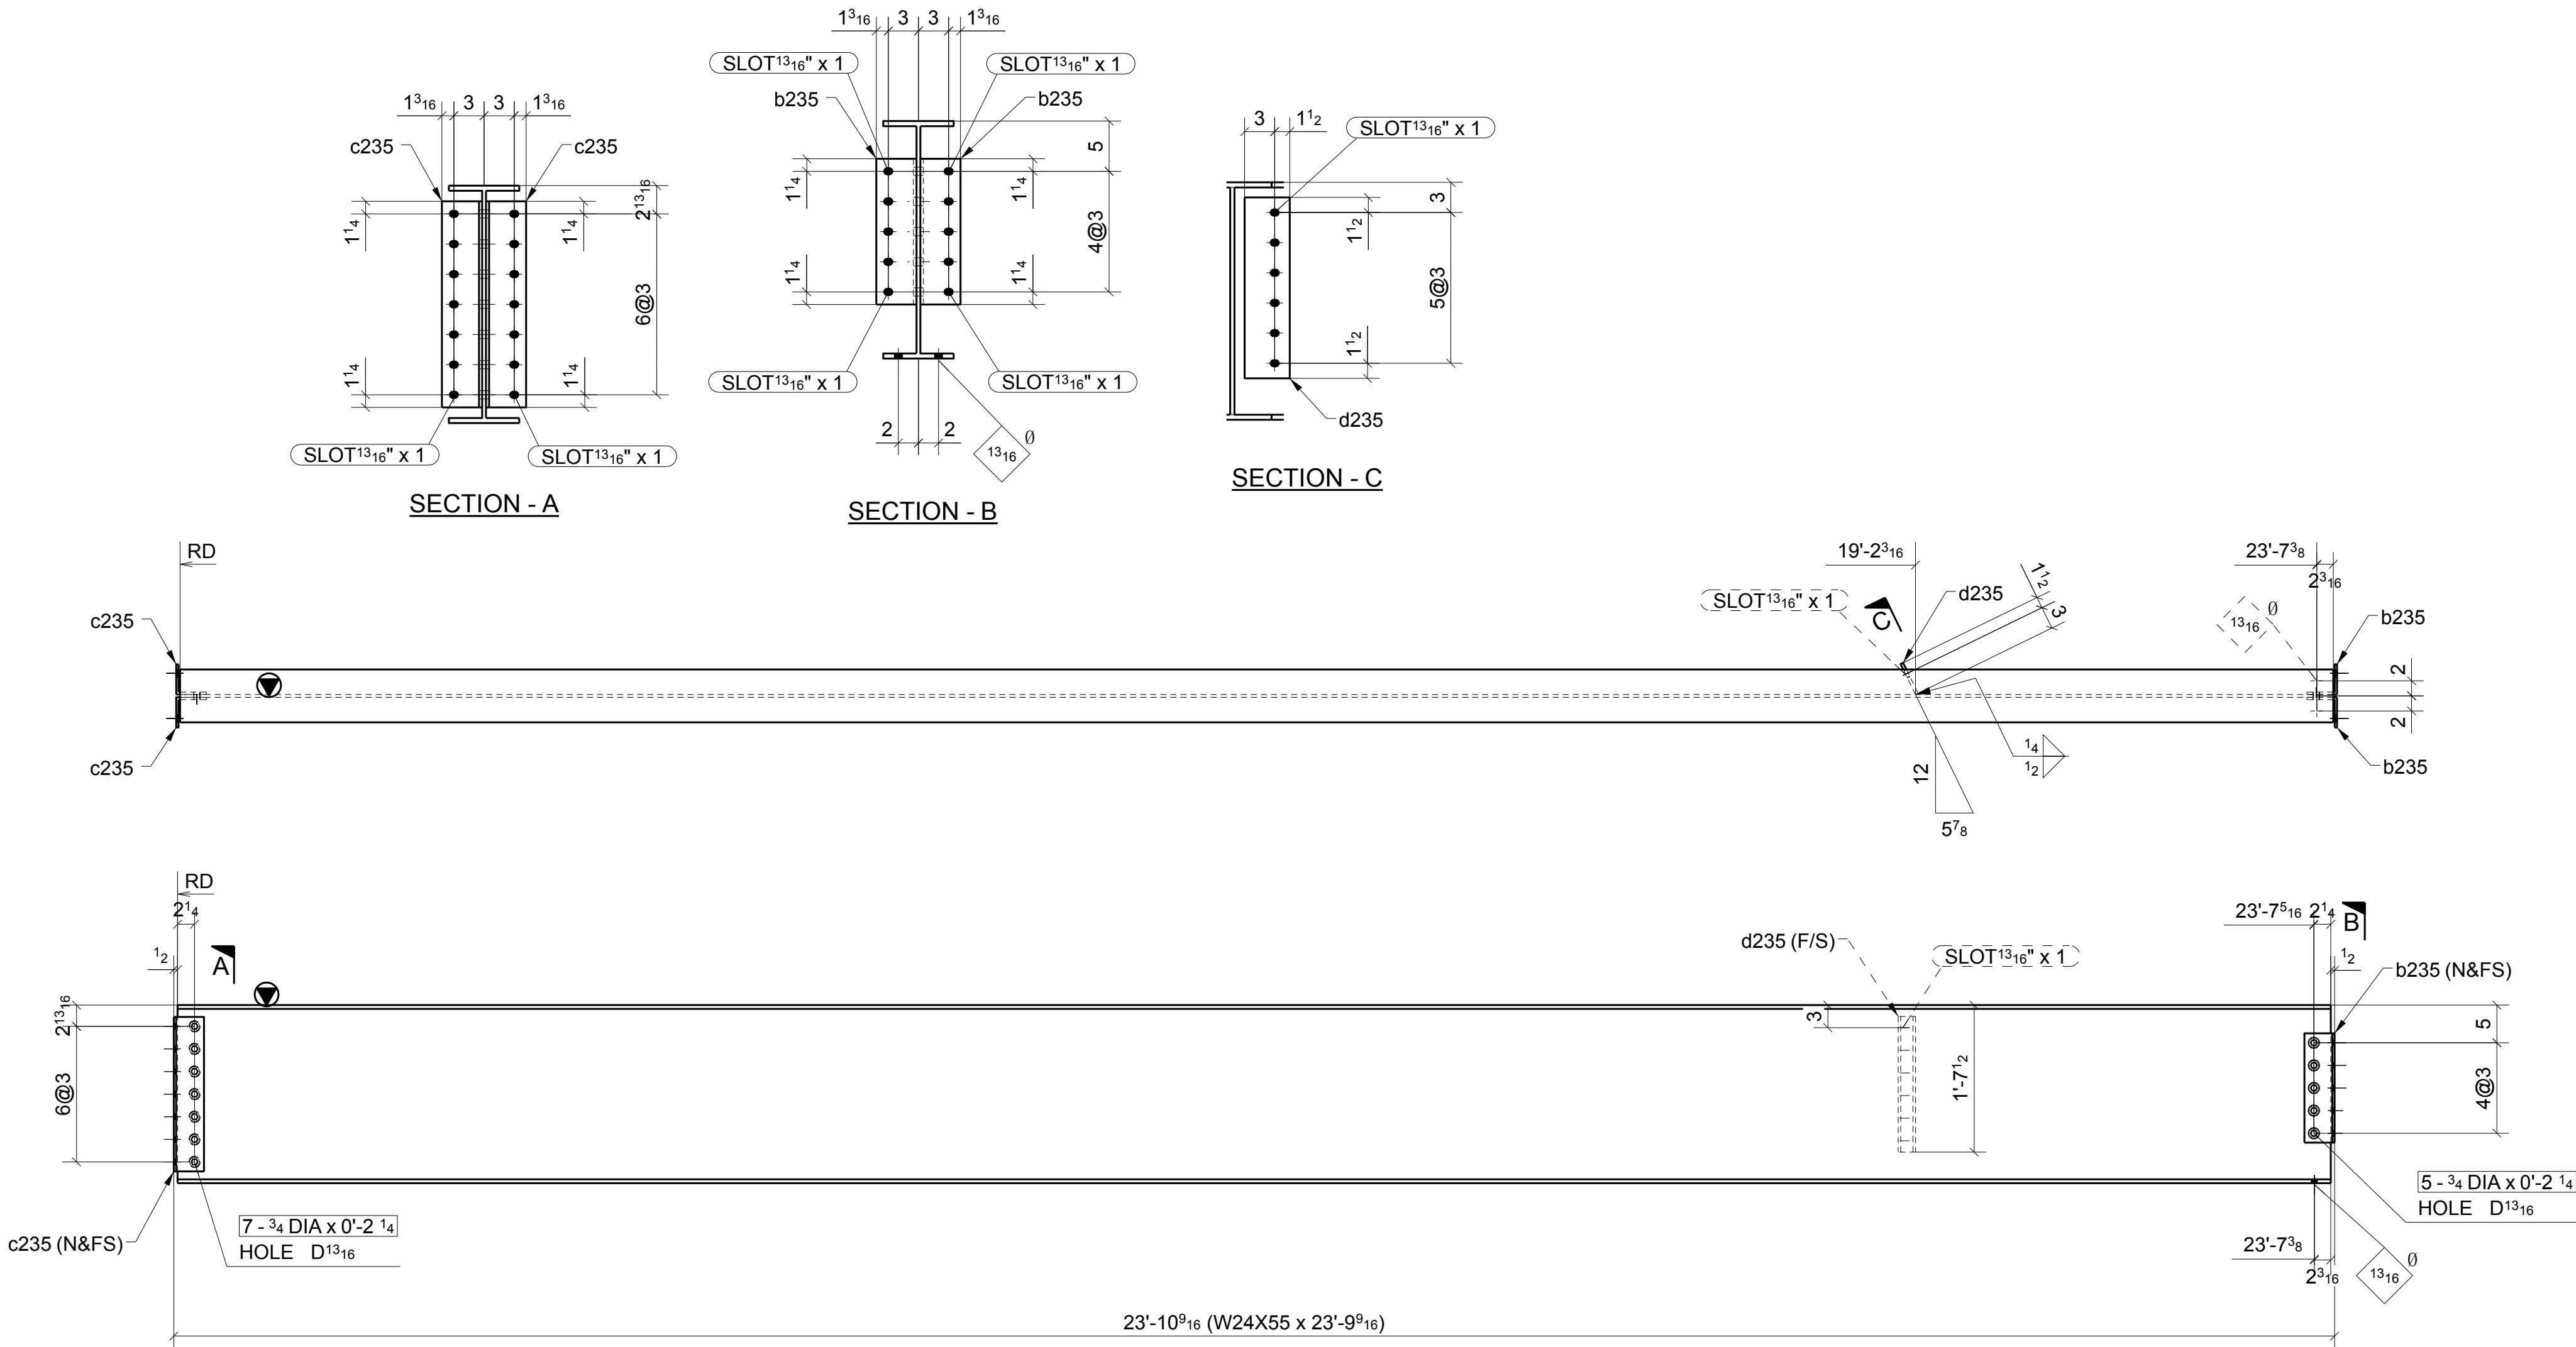

ONE - BEAM ~ 235A

LOCATION: ONE @ 3/A.5-B.3 (REF: E2A)


Romac By: _____ Checked By: _____
Beamline By: _____ Checked By: _____

ATLAS IRON WORKS
ST. LOUIS, MO.

Project: WEBSTER UNIVERSITY INTERDISCIPLINARY SCIENCE BUILDING
Customer: PARIC CORPORATION
Owner: WEBSTER UNIVERSITY
Location: WEBSTER GUOVES,MO 63119
Dwn: ZZ Date: 05/27/2016 Ckd: L.J. Date: 05/30/2016
Job No. A16013 BAT: DWG# 235

A	FOR APPROVAL	06/30/16
Sequence:	2	Ref. E-Plans: -
Material:	A992 U.N.O.	Edge Dist.: 1 1/2" U.N.O.
Holes:	13/16"DIA.	Bolts: NOTED
Cleaning:	NONE	
Paint:	NO	
DFT:	COLOR:	

SHOP BOLT IN SLOTTED HOLE
NEED "HAND TIGHTEN"

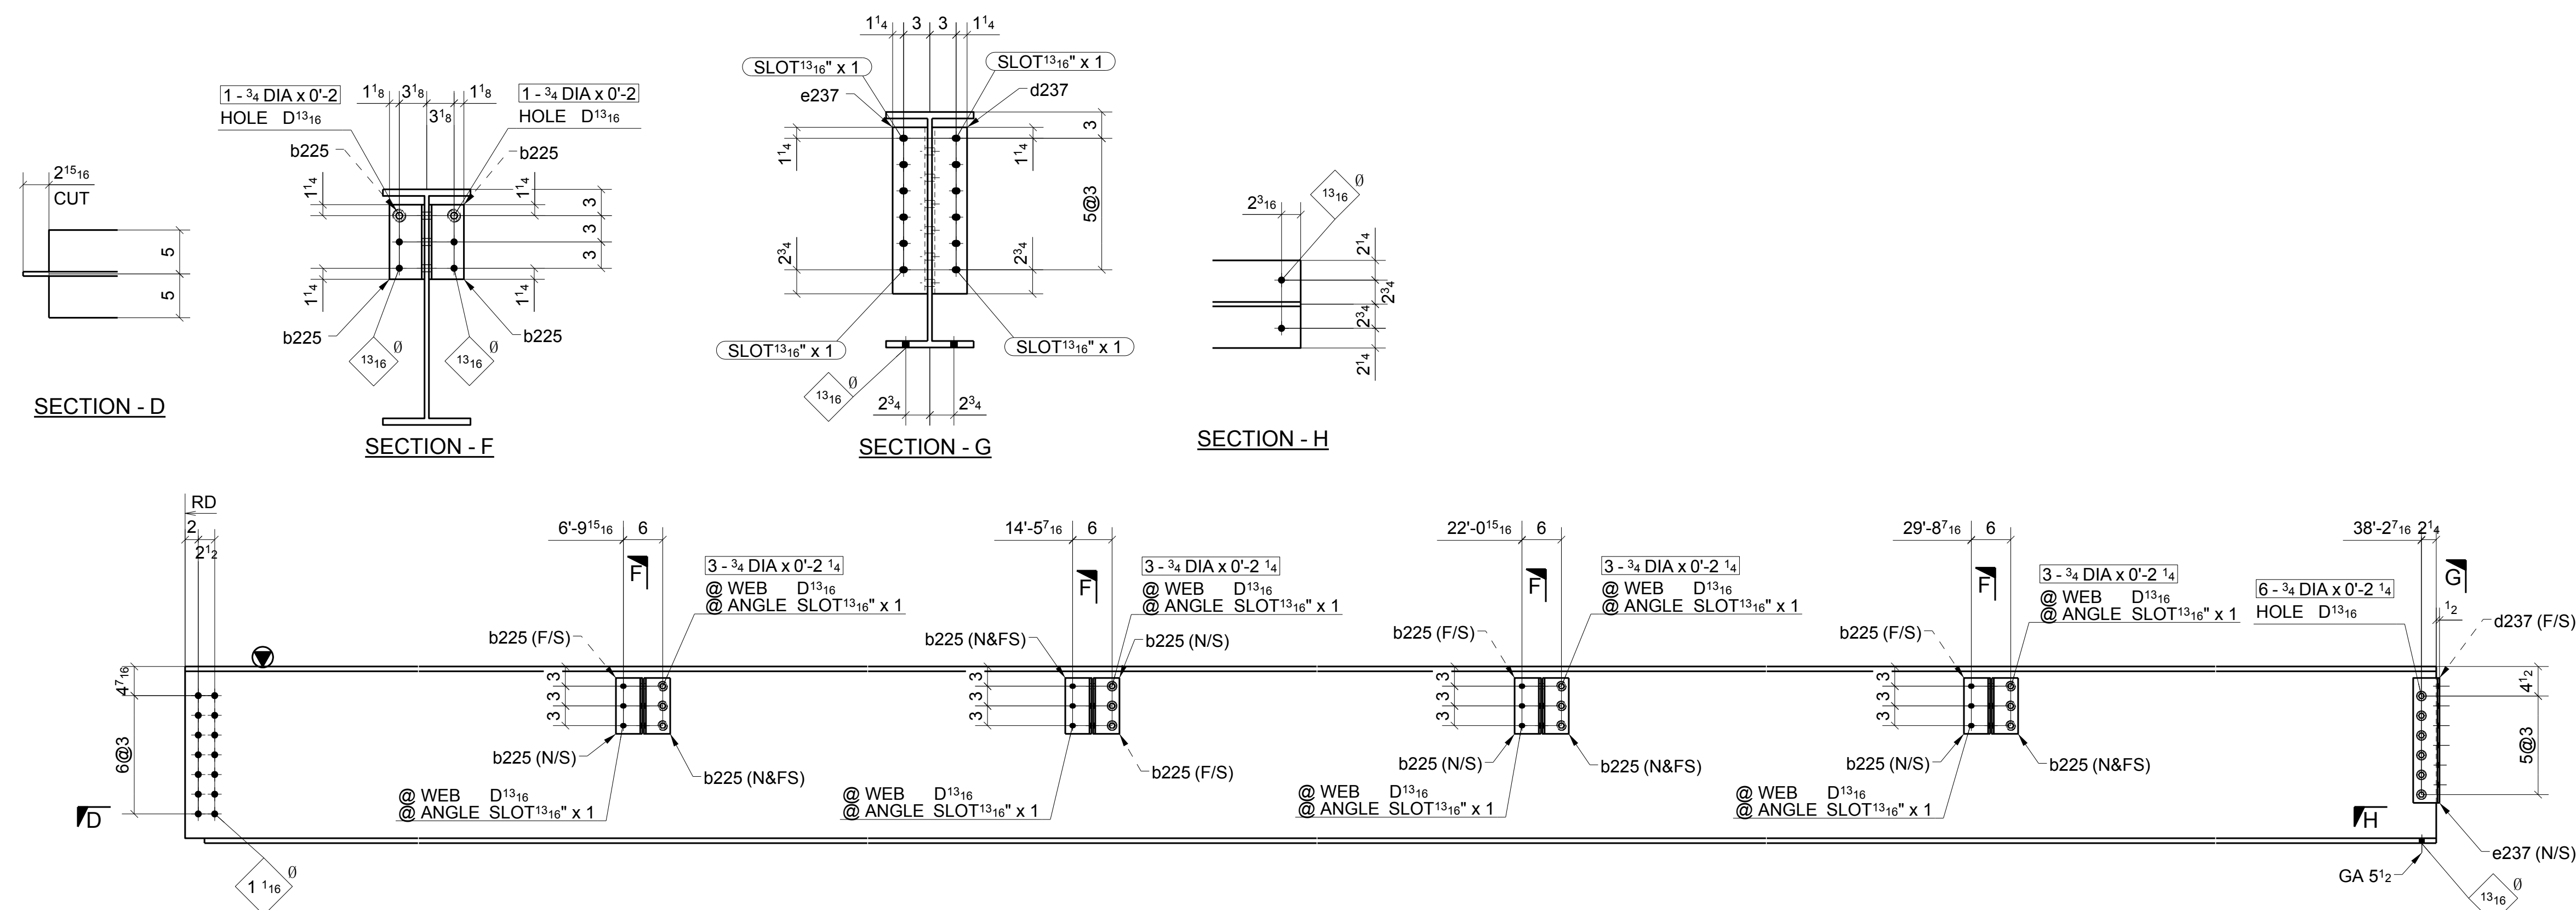


ONE - BEAM ~ 237B
 LOCATION: ONE @ 1.6-2/B.3 (REF: E2A)

	FOR APPROVAL		05/30/16	
	Sequence:	2	Ref. E-Plans:	-
	Material:	A992 U.N.O.	Edge Dist.:	1 1/2" U.N.O.
	Holes:	13/16" DIA.	Bolts:	NOTED
	Cleaning:	NONE		
	Paint:	NO		
	DFT:		COLOR:	

[illegible]

MATERIAL LIST

QTY	MARK	DESCRIPTION	LENGTH	MATERIAL	NOTES
1	238A	W27X94	38'-4 3/4"	A992	
6	b219	L4X4X5/16	0'-5 1/2"	A36	
10	b225	L4X4X5/16	0'-8 1/2"	A36	
2	b237	L4X4X5/16	1'-8 1/2"	A36	
1	b238	L6X6X3/8	7'-6 3/4"	A36	
1	c238	L6X6X3/8	6'-10 1/4"	A36	
1	d238	L6X6X3/8	6'-10 1/4"	A36	
1	e238	L6X6X3/8	6'-1 5/16"	A36	
7		3/4" DIA. W/N&W	0'-2 1/4"	A325N TC	
6		3/4" DIA. W/N&W	0'-2"	A325N TC	
8		3/4" DIA. W/N&W	0'-2"	A325N TC	
15		3/4" DIA. W/N&W	0'-2"	A325N TC	

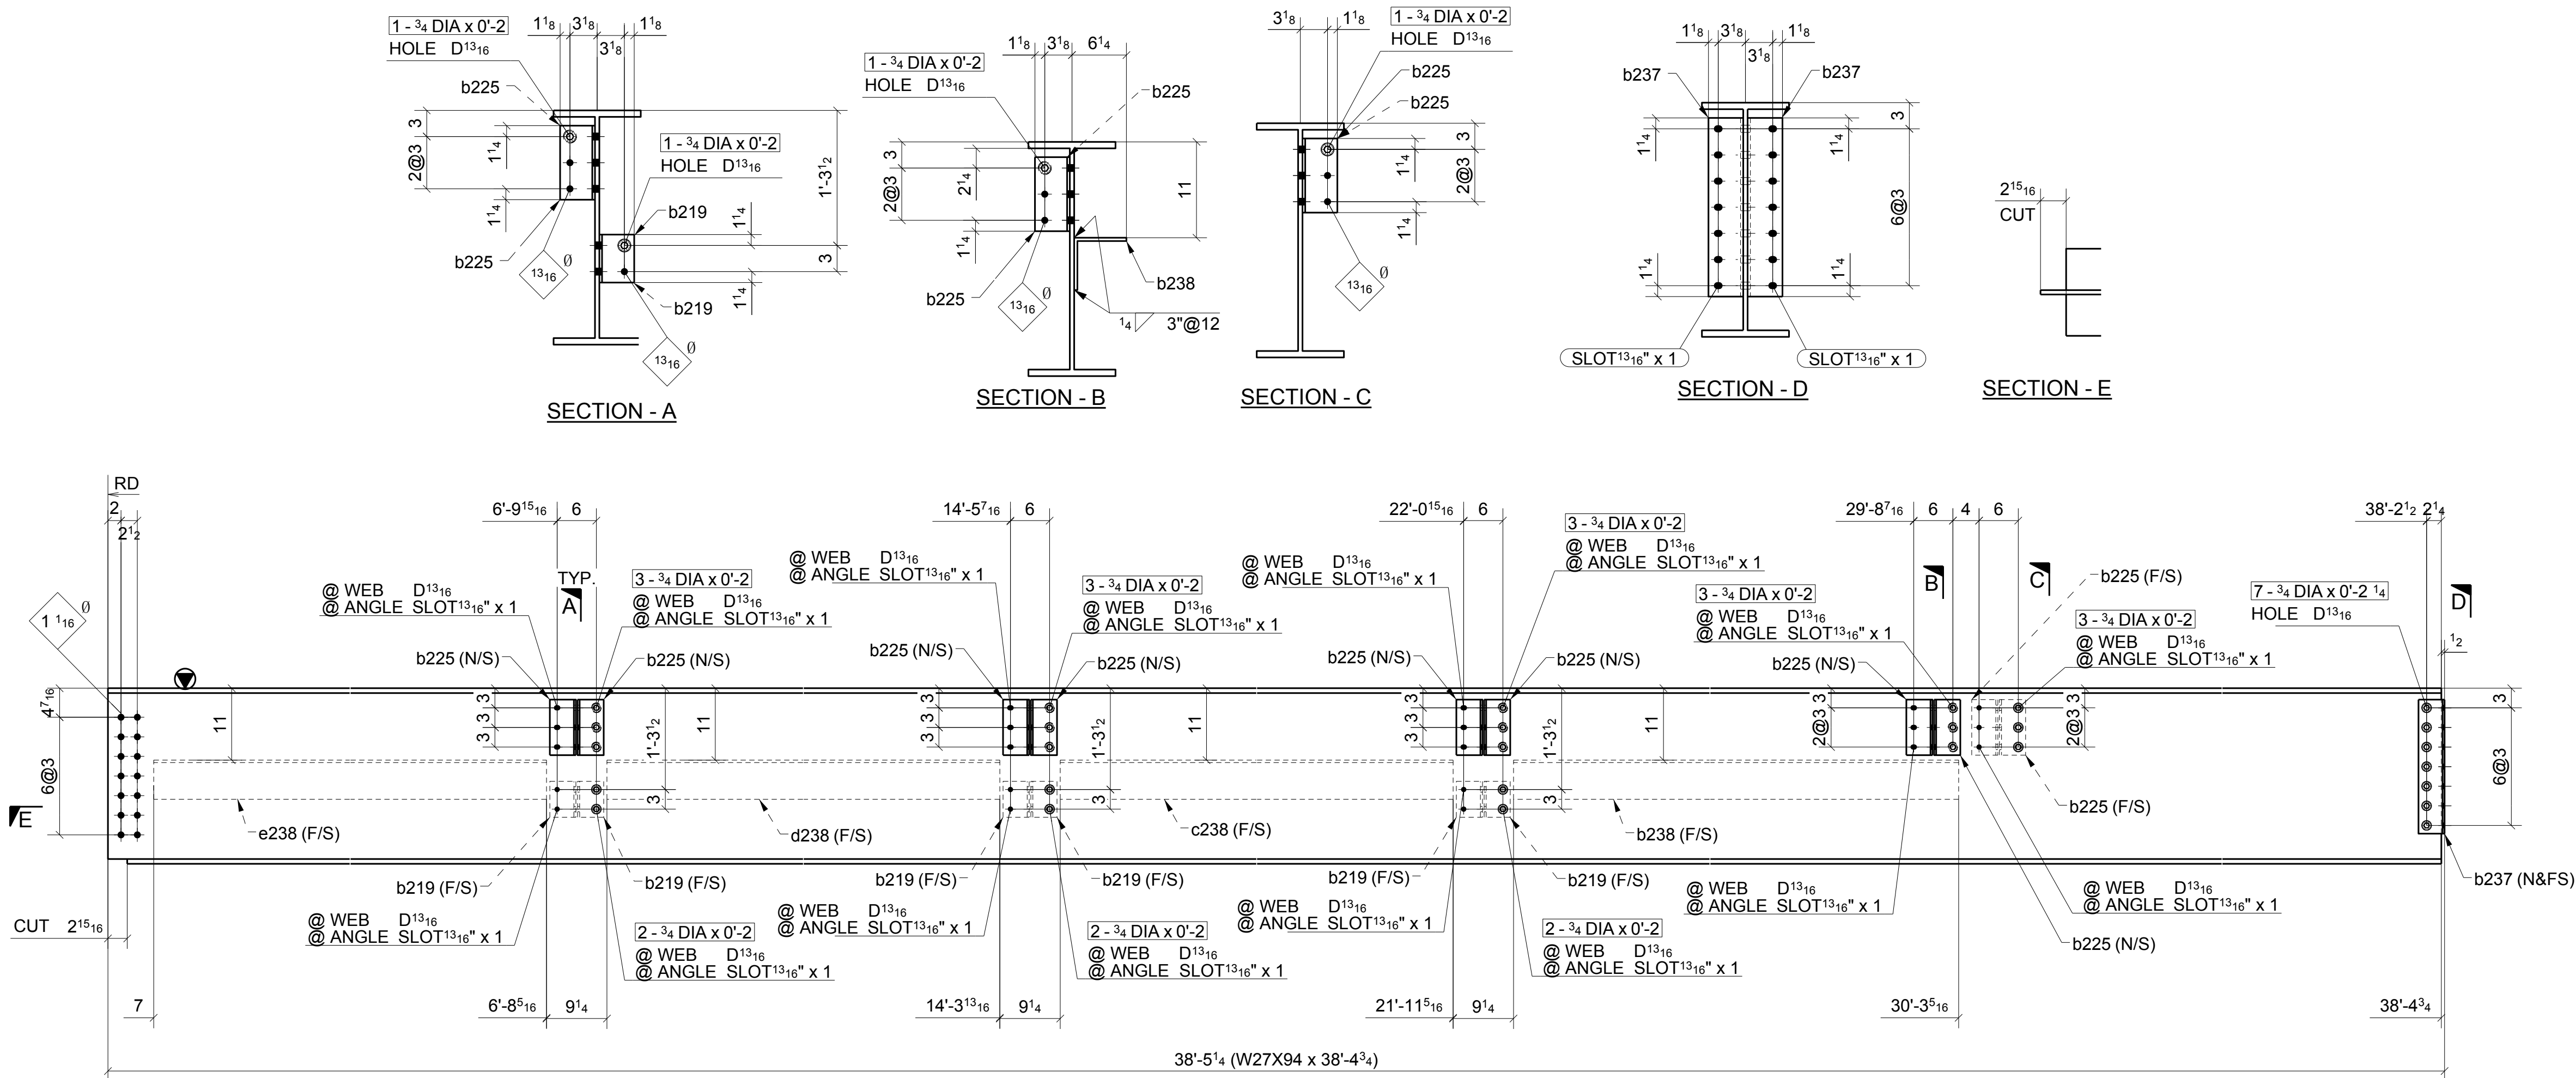

ONE - BEAM ~ 238A

LOCATION: ONE @ 1.6-2/C (REF: E2A)

SHOP BOLT IN SLOTTED HOLE
NEED "HAND TIGHTEN"

FOR APPROVAL				06/30/16
Sequence:	2	Ref. E-Plans:	-	
Material:	A992 U.N.O.	Edge Dist.:	1 1/2" U.N.O.	
Holes:	13/16"DIA.	Bolts:	NOTED	
Cleaning:	NONE			
Paint:	NO			
DFT:		COLOR:		

Romac By: _____ Checked By: _____
Beamline By: _____ Checked By: _____

ATLAS IRON WORKS
ST. LOUIS, MO.

Project: WEBSTER UNIVERSITY INTERDISCIPLINARY SCIENCE BUILDING
Customer: PARIC CORPORATION
Owner: WEBSTER UNIVERSITY
Location: WEBSTER GUOVES, MO 63119
Dwn: ZZ Date: 05/30/2016 Ckd: L.J. Date: 05/30/2016
Job No. A16013 BAT: _____ DWG#: 238

Romac By: _____	Checked By: _____
Beamline By: _____	Checked By: _____
ATLAS IRON WORKS ST. LOUIS, MO.	
Project: <u>WEBSTER UNIVERSITY INTERDISCIPLINARY SCIENCE BUILDING</u>	
Customer: <u>PARIC CORPORATION</u>	
Owner: <u>WEBSTER UNIVERSITY</u>	
Location: <u>WEBSTER GUVOM, MO 63119</u>	
Dwn: <u>ZZ</u>	Date: <u>05/30/2016</u>
Ckd: <u>LJ</u>	Date: <u>05/30/2016</u>
Job No. <u>A16013</u> BAT: _____ DWG#: <u>239</u>	




SHOP BOLT IN SLOTTED HOLE
NEED "HAND TIGHTEN"

A	FOR APPROVAL		05/30/16	
Sequence:	<u>2</u>		Ref. E-Plans:	<u>-</u>
Material:	<u>A992</u>	<u>U.N.O.</u>	Edge Dist.:	<u>1 1/2"</u> <u>U.N.O.</u>
Holes:	<u>13/16"DIA.</u>		Bolts:	<u>NOTED</u>
Cleaning:	<u>NONE</u>			
Paint:	<u>NO</u>			
DFT:	<u> </u>		COLOR:	<u> </u>

MATERIAL LIST

QTY	MARK	DESCRIPTION	LENGTH	MATERIAL	NOTES
1	240A	W27X94	33'-1 3/8"	A992	
1	b240	L6X6X3/8	7'-3 1/2"	A36	
3	c222	PL 3/8"X4 1/2"	0'-9"	A36	
1	c240	L6X6X3/8	6'-7 7/16"	A36	
2	e234	L6X6X3/8	7'-11 1/8"	A36	
3	g227	PL 3/8"X4 1/2"	1'-0"	A36	

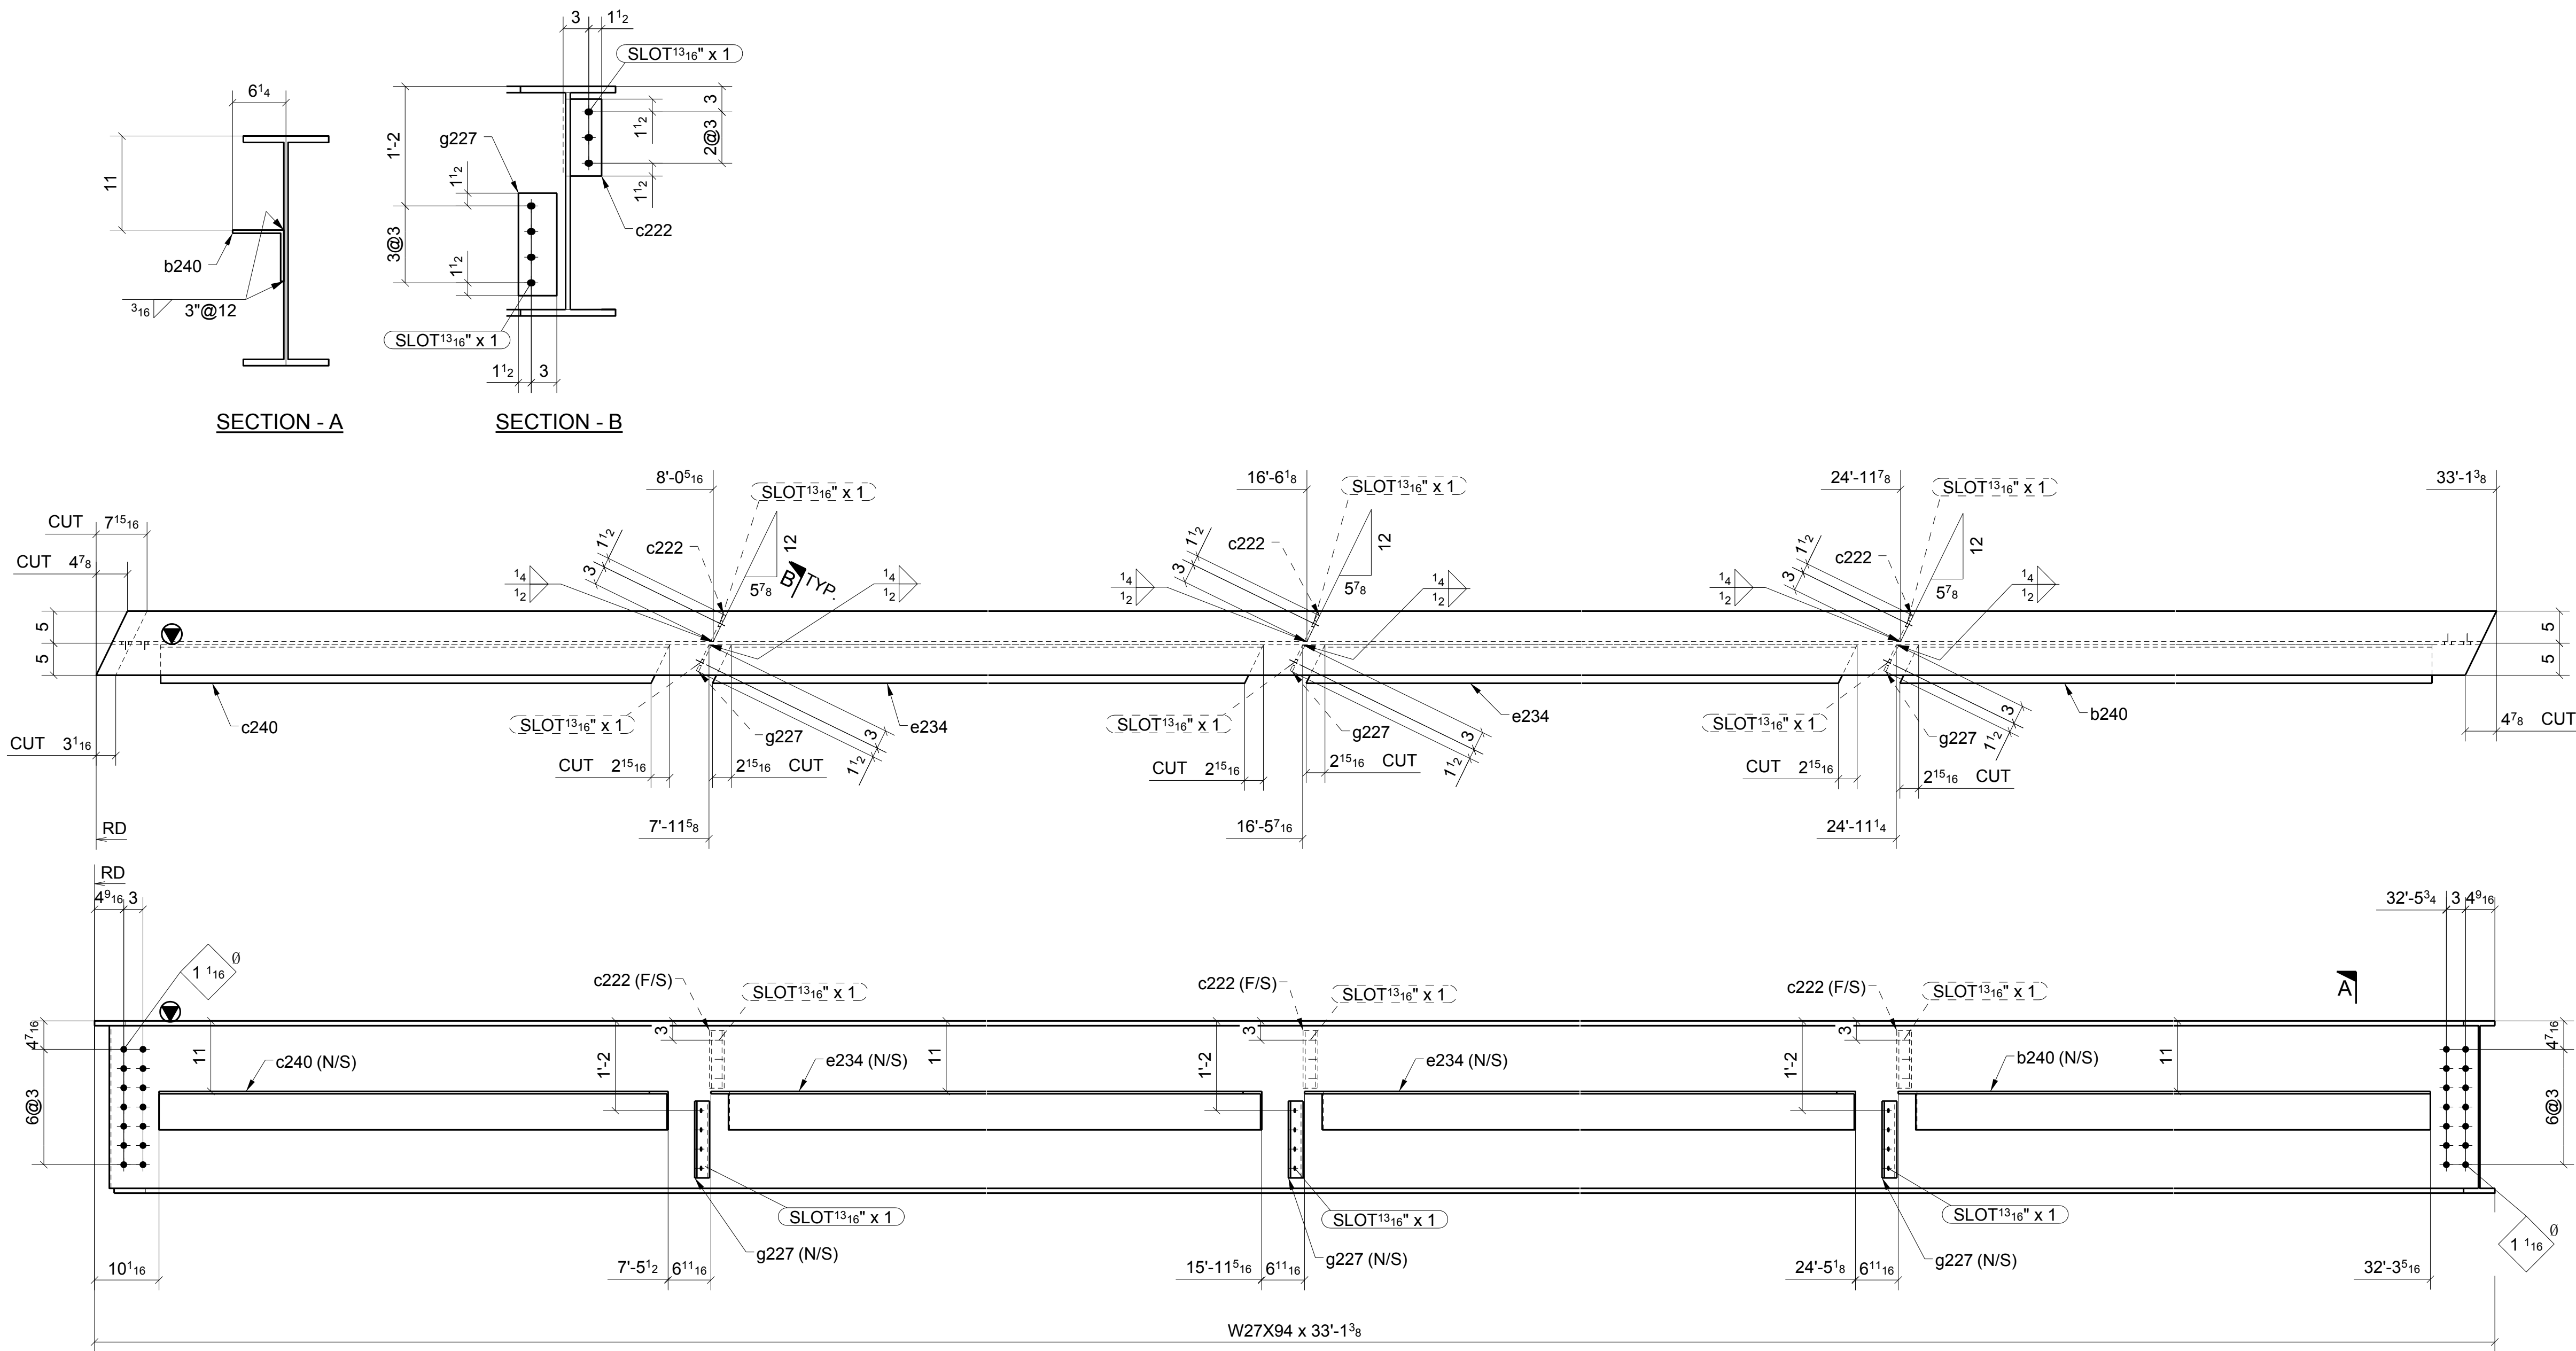

ONE - BEAM ~ 240A

LOCATION: ONE @ 1.6-1.9/4-A.5 (REF: E2A)

SHOP BOLT IN SLOTTED HOLE
NEED "HAND TIGHTEN"

FOR APPROVAL			
Sequence:	2	Ref. E-Plans:	-
Material:	A992 U.N.O.	Edge Dist.:	1 1/2" U.N.O.
Holes:	13/16"DIA.	Bolts:	NOTED
Cleaning:	NONE		
Paint:	NO		
DFT:		COLOR:	

Romac By: _____ Checked By: _____
Beamline By: _____ Checked By: _____

ATLAS IRON WORKS
ST. LOUIS, MO.

Project: WEBSTER UNIVERSITY INTERDISCIPLINARY SCIENCE BUILDING
Customer: PARIC CORPORATION
Owner: WEBSTER UNIVERSITY
Location: WEBSTER GUOVES, MO 63119
Dwn: ZZ Date: 05/30/2016 Ckd: L.J. Date: 05/30/2016
Job No. A16013 BAT: _____ DWG#: 240


[illegible]

Romac By: _____ Checked By: _____

Beamline By: _____ Checked By: _____

ATLAS IRON WORKS
ST. LOUIS, MO.

Project:	WEBSTER UNIVERSITY INTERDISCIPLINARY SCIENCE BUILDING				
Customer:	PARIC CORPORATION				
Owner:	WEBSTER UNIVERSITY				
Location:	WEBSTER GUOVES,MO 63119				
Dwn:	ZZ	Date:	05/30/2016	Ckd:	LJ
		Date:	05/30/2016		
Job No.	A16013	RAT		DWG#	242

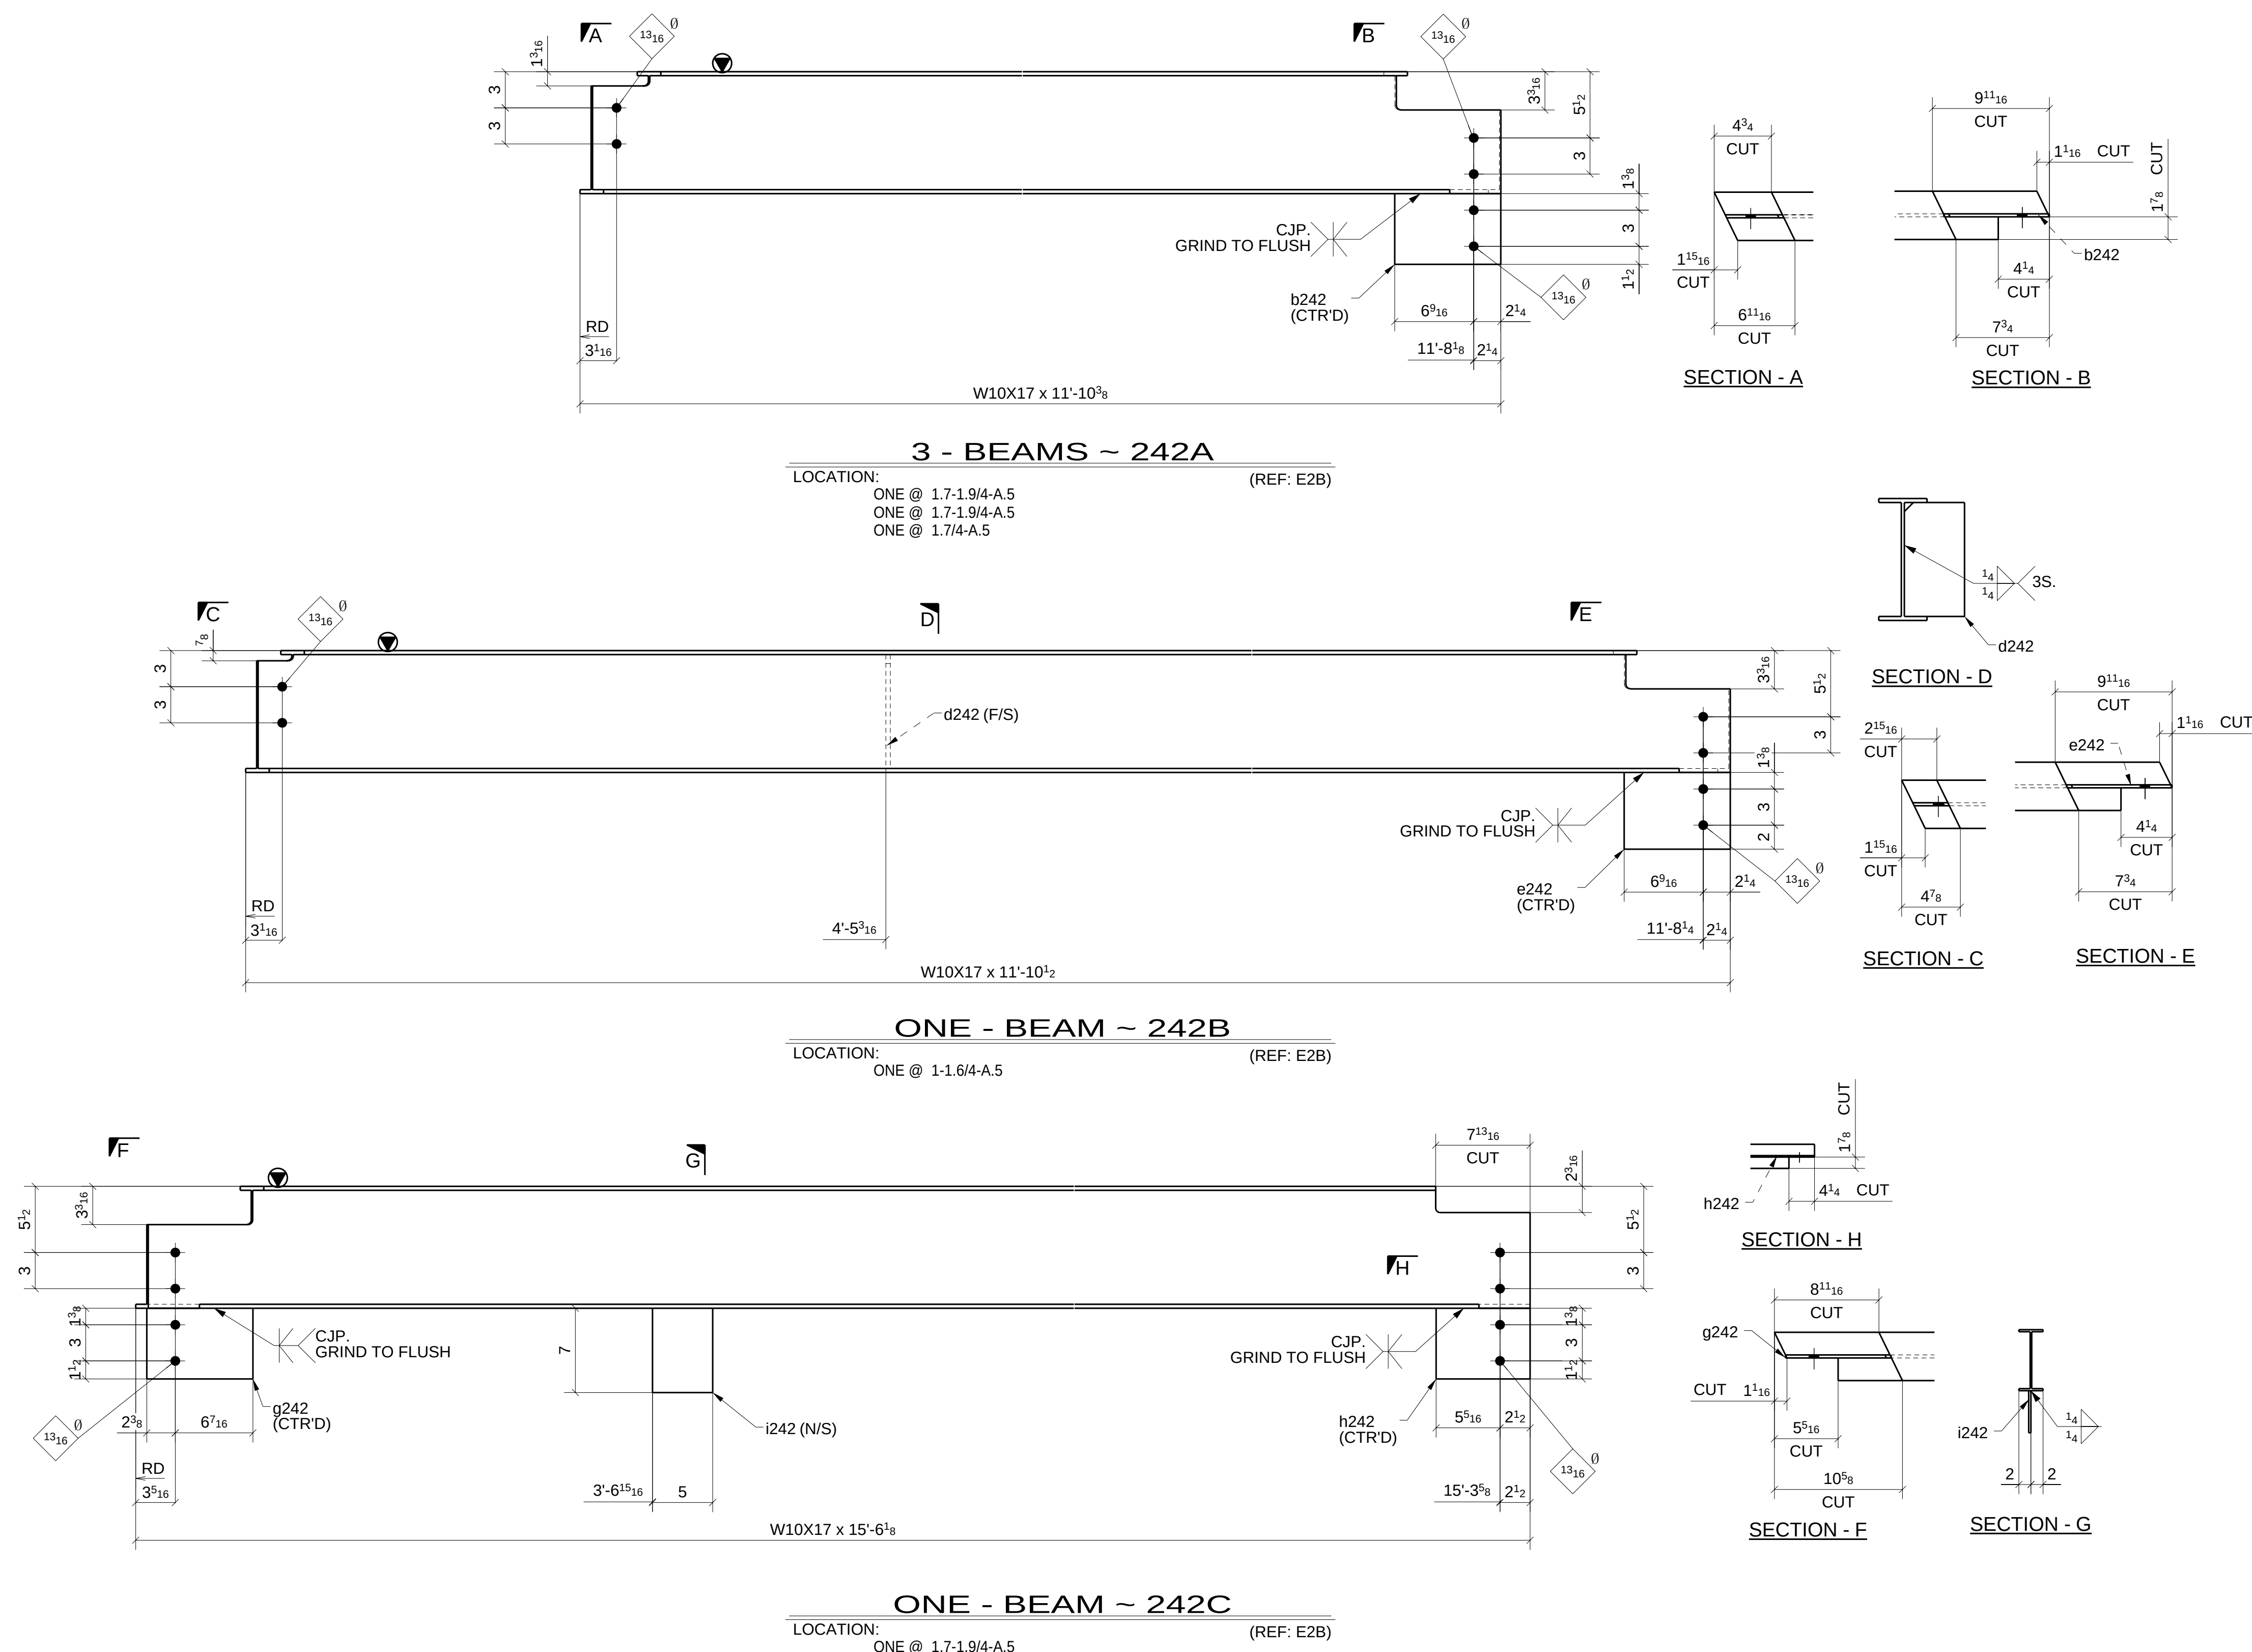


SHOP BOLT IN SLOTTED HOLE
NEED "HAND TIGHTEN"

	FOR APPROVAL		05/30/16
	Sequence: 2	Ref. E Plans: -	
Material: A992	U.N.O.	Edge Dist.: 1 1/2"	U.N.O.
Holes: 13/16" DIA.	Bolts:	NOTED	
Cleaning: NONE			
Paint: NO			
DFT: _____	COLOR: _____		

Romac By: _____	Checked By: _____
Beamline By: _____	Checked By: _____


ATLAS IRON WORKS
ST. LOUIS, MO.

Project: WEBSTER UNIVERSITY INTERDISCIPLINARY SCIENCE BUILDING
 Customer: PARIC CORPORATION
 Owner: WEBSTER UNIVERSITY
 Location: WEBSTER GUOVES,MO 63119
 Dwn: ZZ Date: 05/30/2016 Ckd: LJ Date: 05/30/2016
 Job No. A16013 BAT: Dwg#: 243

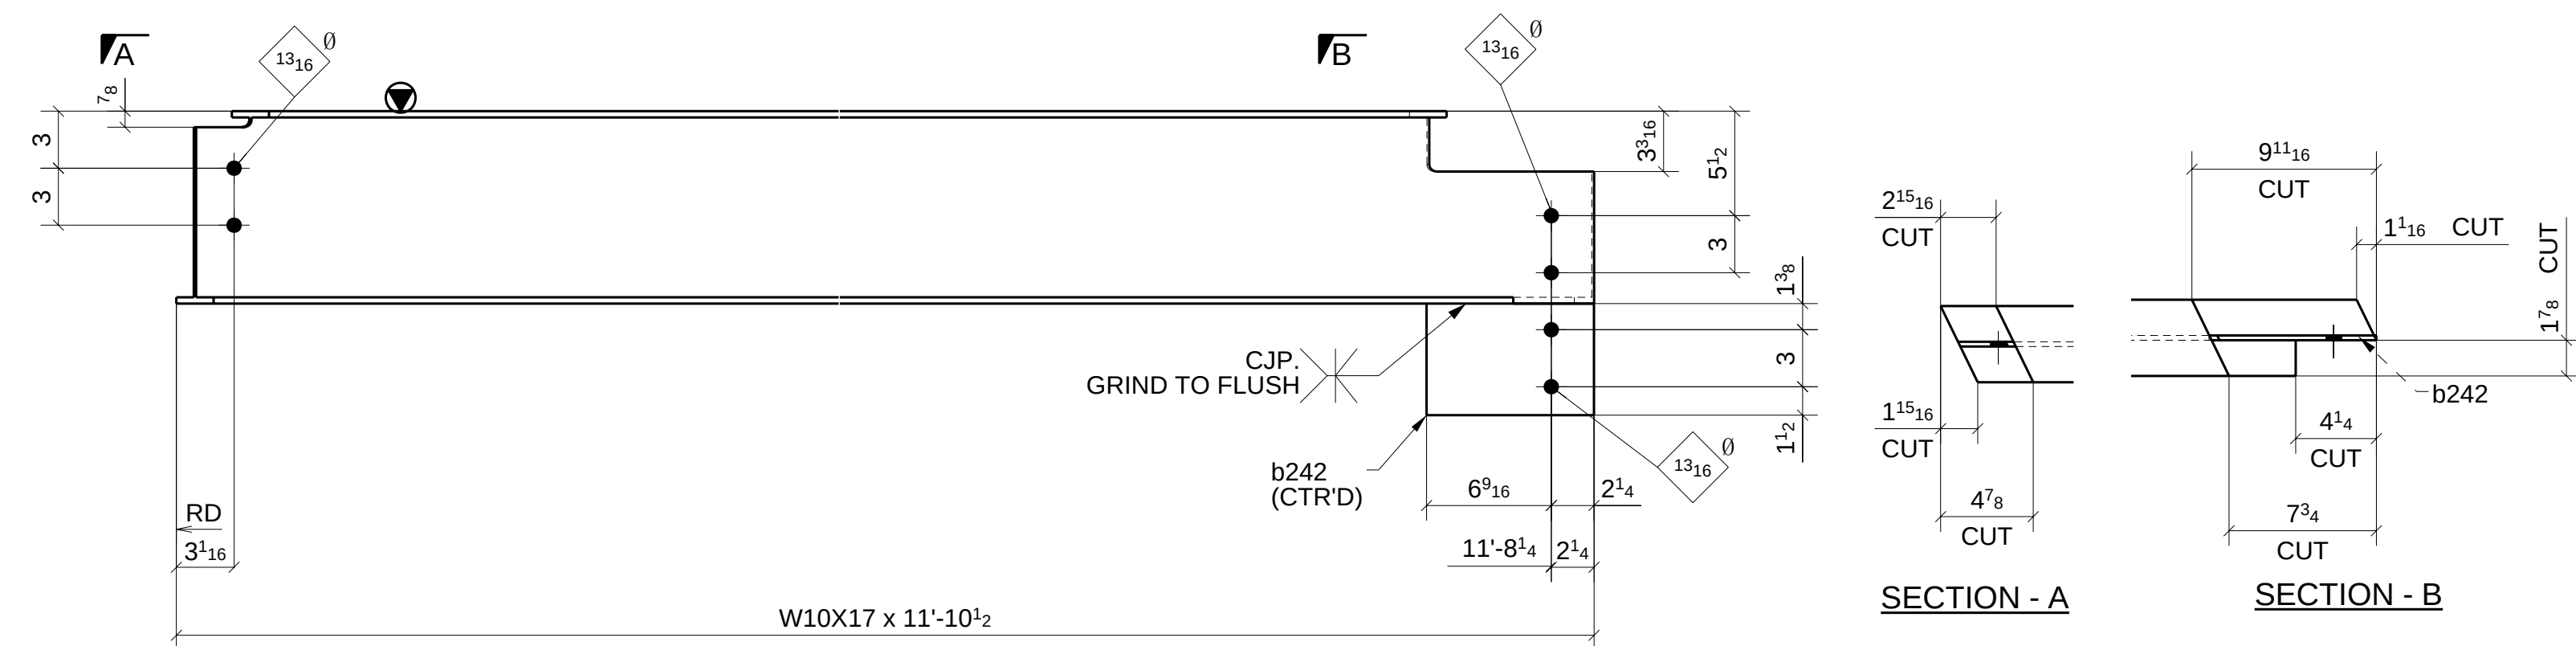


ONE - BEAM ~ 243A

LOCATION: ONE @ 1-1.6/4-A.5 (REF: E2B)

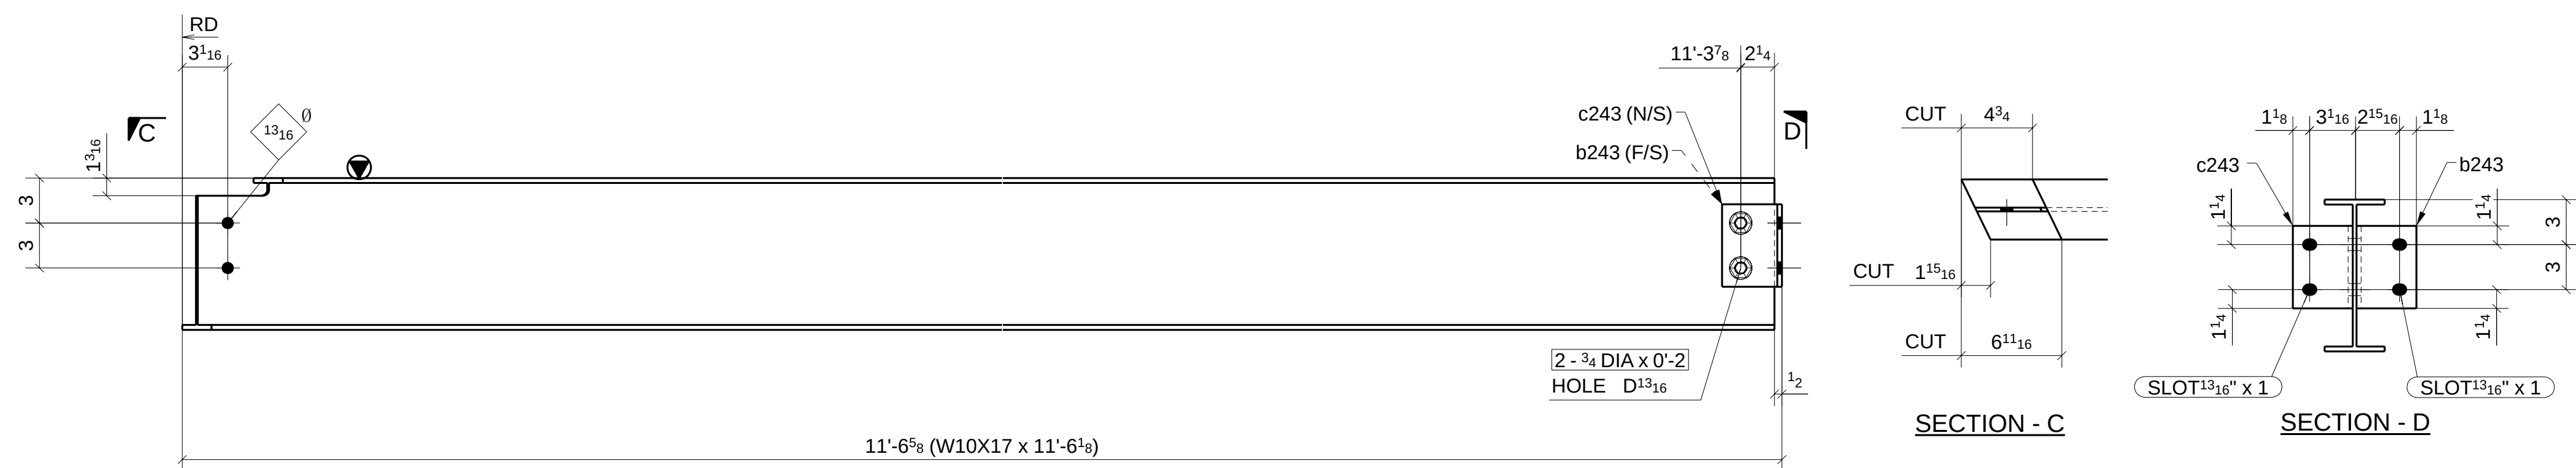

ONE - BEAM ~ 243B
 LOCATION: ONE @ 1.9/4-A.5 (REF: E2B)

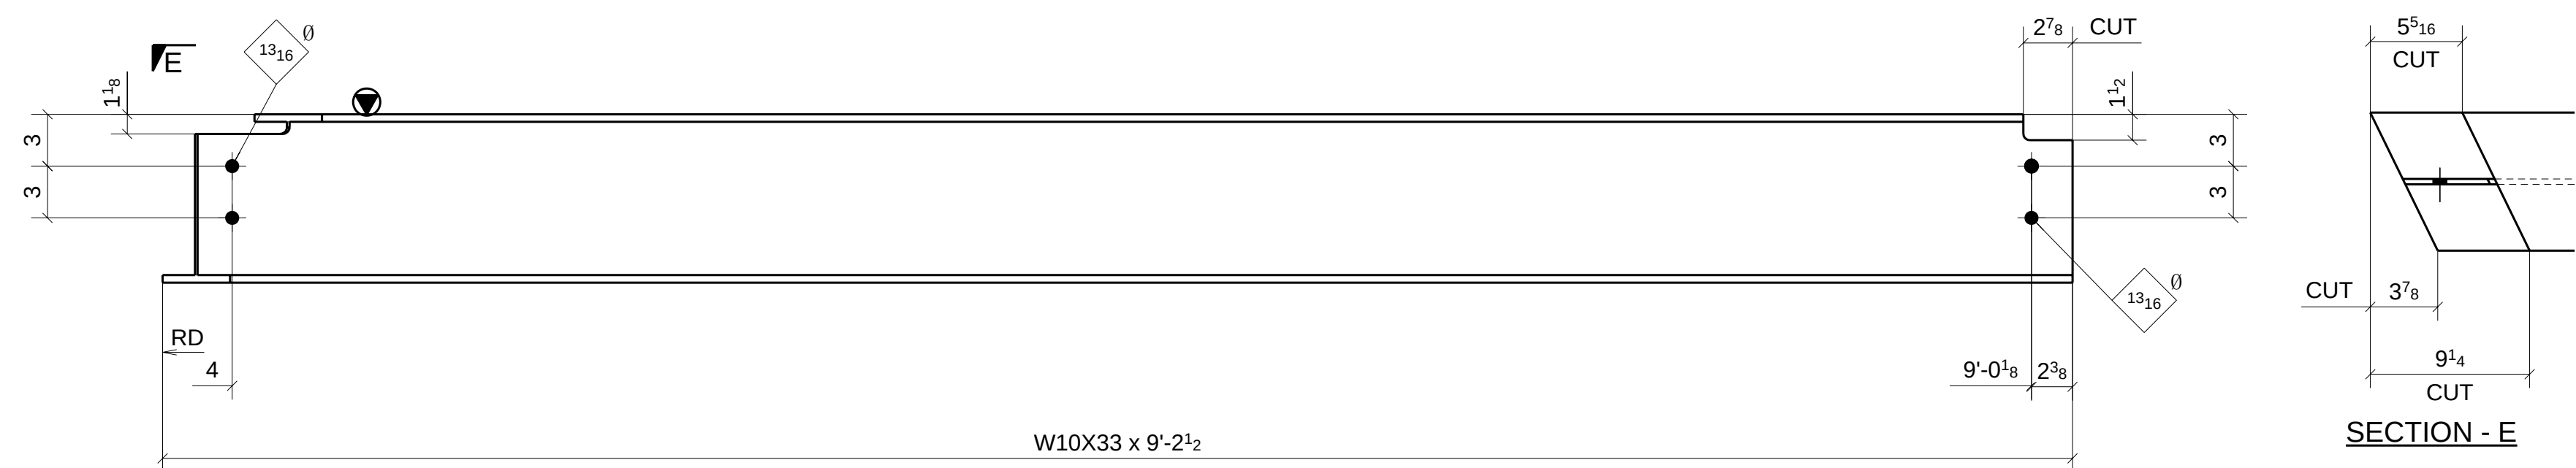

ONE - BEAM ~ 243C
 LOCATION: ONE @ 2.6-3/A.5-B.3 (REF: E2B)

SHOP BOLT IN SLOTTED HOLE
NEED "HAND TIGHTEN"

	FOR APPROVAL		05/30/16
	Sequence: 2	Ref. E-Plans:	-
	Material: A992 U.N.O.	Edge Dist.:	1 1/2" U.N.O.
	Holes: 13/16" DIA.	Bolts:	NOTED
	Cleaning:	NONE	
	Paint:	NO	
DFT:	COLOR:		

COB NO. _____ DAY. _____ DWG# _____



Romac By: _____	Checked By: _____
Beamline By: _____	Checked By: _____

Project:	WEBSTER UNIVERSITY INTERDISCIPLINARY SCIENCE BUILDING				
Customer:	PARIC CORPORATION				
Owner:	WEBSTER UNIVERSITY				
Location:	WEBSTER GUOVES,MO 63119				
Dwn:	ZZ	Date:	05/30/2016	Ckd:	LJ
		Date:	05/30/2016		
Job No.	A16013	BAT:		DWG#:	247

SHOP BOLT IN SLOTTED HOLE
NEED "HAND TIGHTEN"




Romac By: _____ Checked By: _____
Beamline By: _____ Checked By: _____

Project: WEBSTER UNIVERSITY INTERDISCIPLINARY SCIENCE BUILDING
Customer: PARIC CORPORATION
Owner: WEBSTER UNIVERSITY
Location: WEBSTER GROVES, MO 63119
Dwn: ZZ Date: 05/30/2016 Ckd: LJ Date: 05/30/2016
Job No. A16013 BAT: DWG#: 250

SHOP BOLT IN SLOTTED HOLE
NEED "HAND TIGHTEN"

Romac By: _____	Checked By: _____
Beamline By: _____	Checked By: _____
ATLAS IRON WORKS ST. LOUIS, MO.	
Project: _____	WEBSTER UNIVERSITY INTERDISCIPLINARY SCIENCE BUILDING
Customer: _____	PARIC CORPORATION
Owner: _____	WEBSTER UNIVERSITY
Location: _____	WEBSTER GUVOMES, MO 63119
Dwn: ZZ	Date: 05/30/2016
Ckd: LJ	Date: 05/30/2016
Job No. A16013 BAT: DWG#: 251	

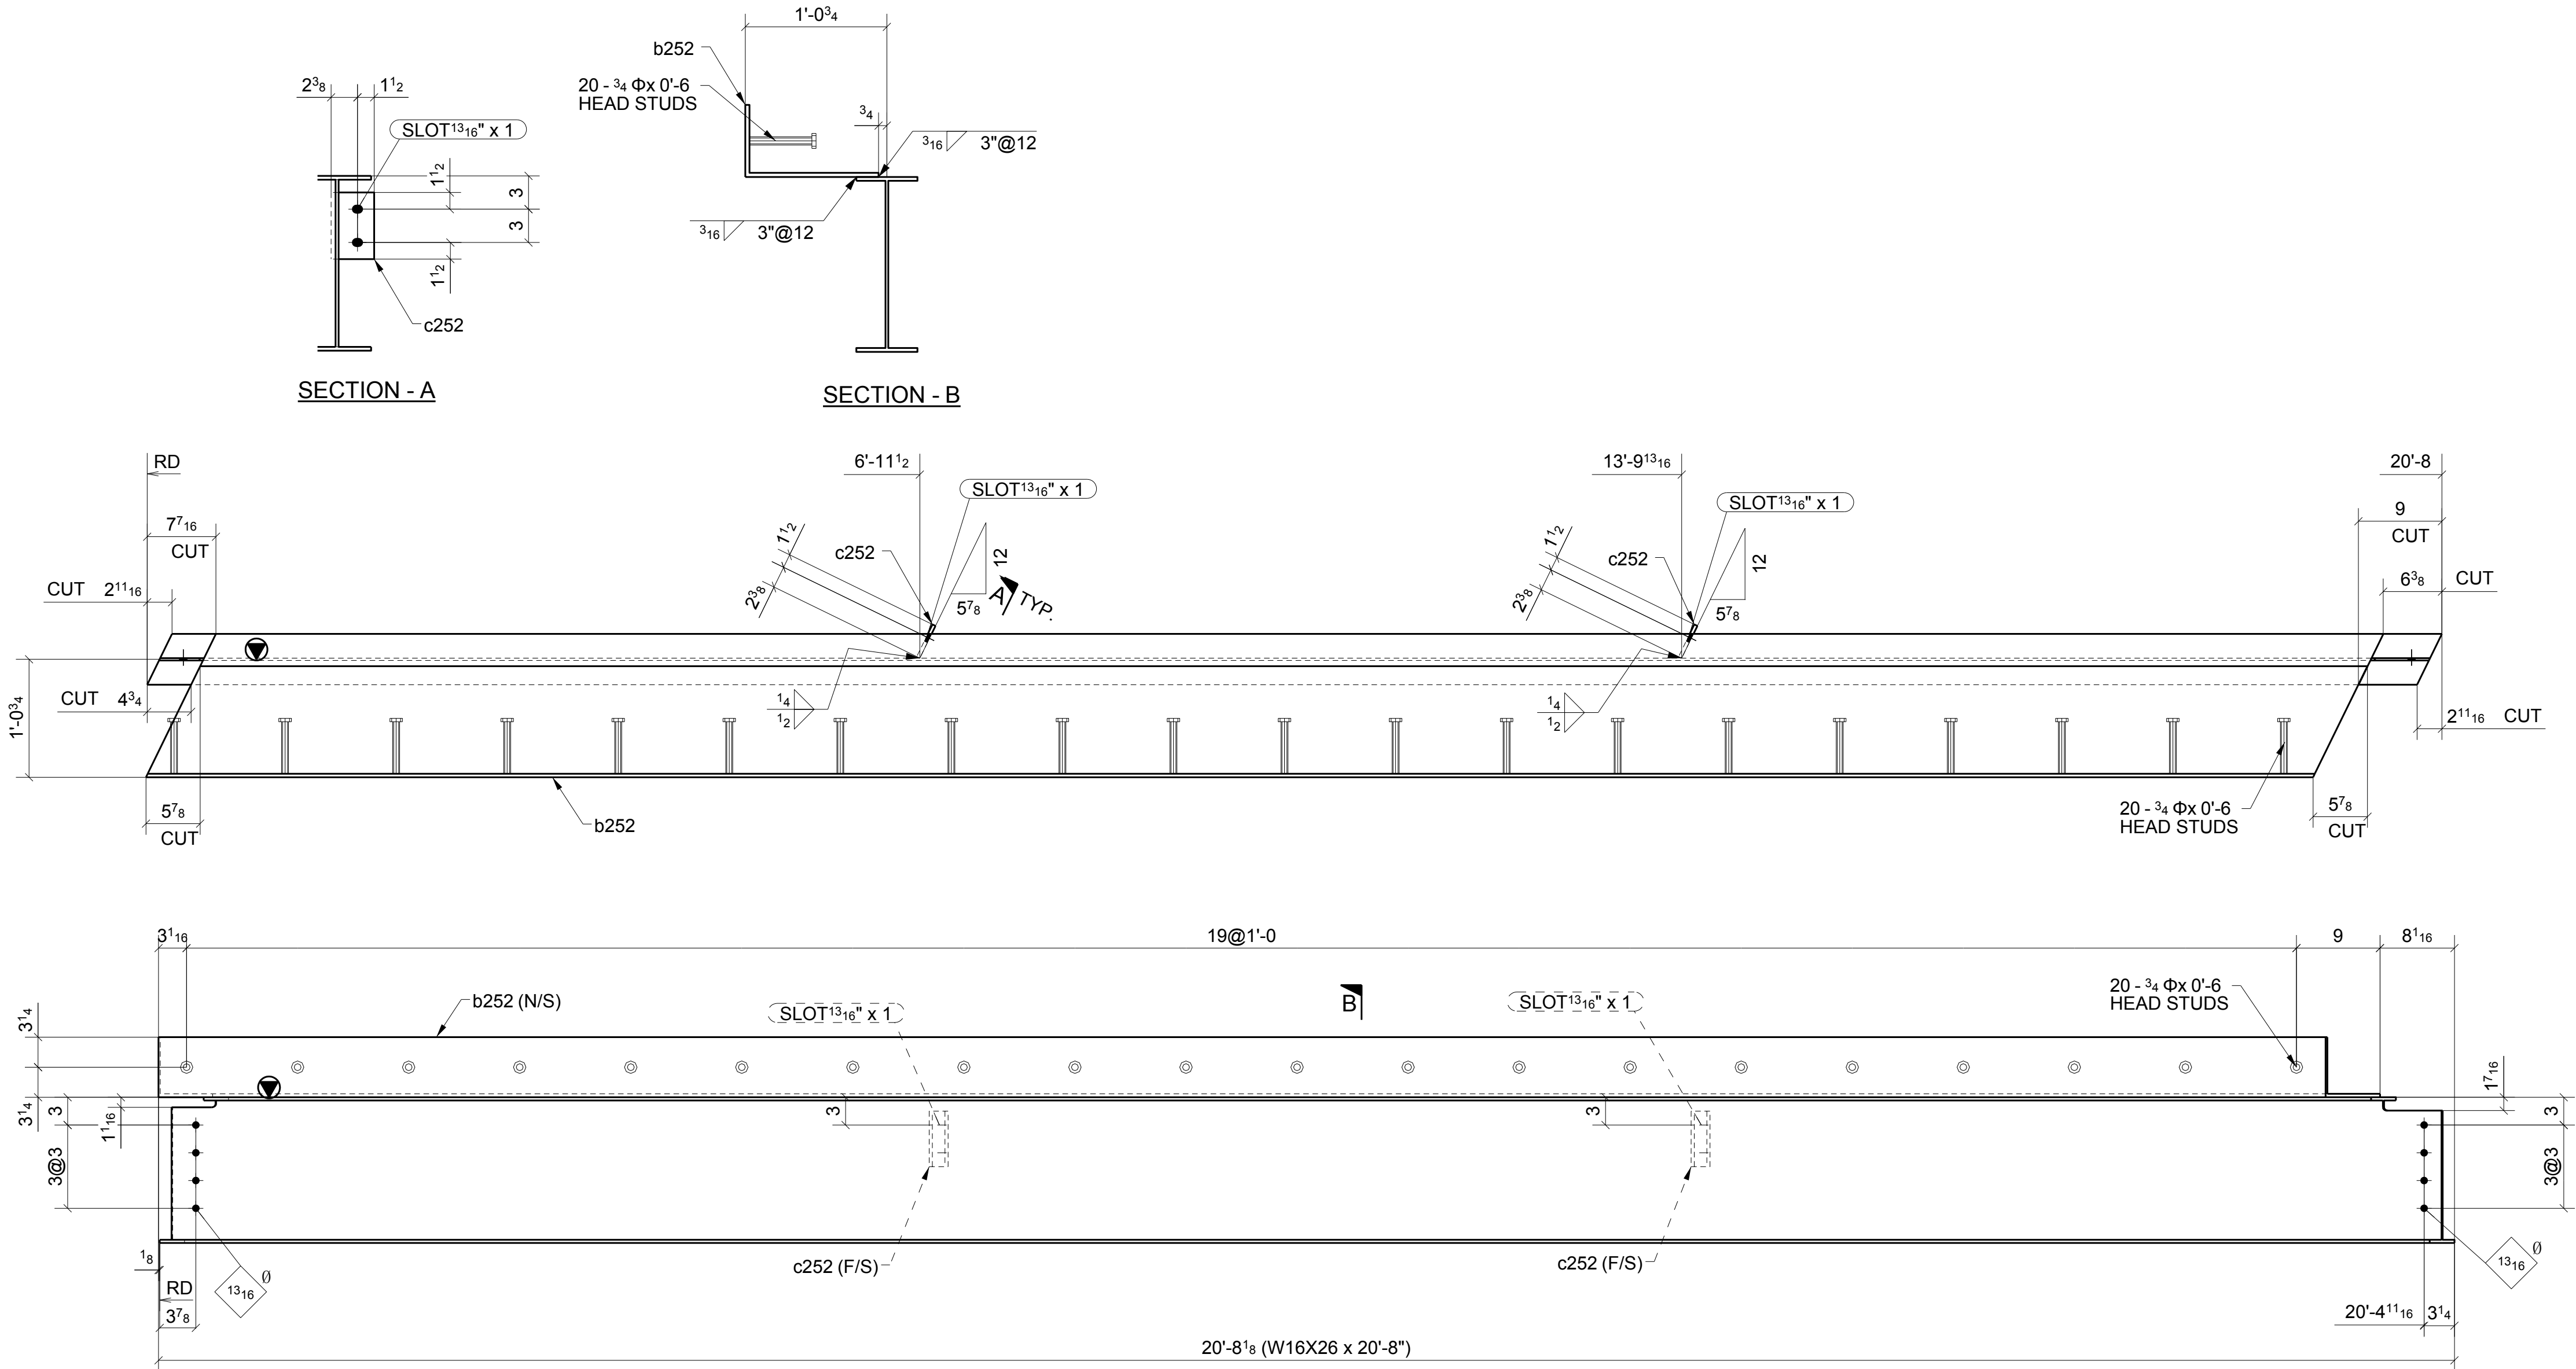

ONE - BEAM ~ 252A
LOCATION: ONE @ 1-1.6/4-A.5 (REF: E2B)

SHOP BOLT IN SLOTTED HOLE
NEED "HAND TIGHTEN"

MATERIAL LIST					
QTY	MARK	DESCRIPTION	LENGTH	MATERIAL	NOTES
1	252A	W16X26	20'-8"	A992	
1	b252	BPL3/8"X18 1/2"	20'-0 1/16"	A36	
2	c252	PL3/8"X3 7/8"	0'-6"	A36	
20		3/4" STUD	0'-6"		

Romac By: _____ Checked By: _____
Beamline By: _____ Checked By: _____

ATLAS IRON WORKS
ST. LOUIS, MO.

Project: WEBSTER UNIVERSITY INTERDISCIPLINARY SCIENCE BUILDING
Customer: PARIC CORPORATION
Owner: WEBSTER UNIVERSITY
Location: WEBSTER GUOVES,MO 63119
Dwn: ZZ Date: 05/30/2016 Ckd: L.J Date: 05/30/2016
Job No. A16013 BAT: _____ DWG#: 252

FOR APPROVAL				06/30/16
Sequence:	2	Ref. E-Plans:	-	
Material:	A992 U.N.O.	Edge Dist.:	1 1/2" U.N.O.	
Holes:	13/16"DIA.	Bolts:	NOTED	
Cleaning:	NONE			
Paint:	NO			
DFT:		COLOR:		



ATLAS IRON WORKS ST. LOUIS, MO.							
Project:	WEBSTER UNIVERSITY INTERDISCIPLINARY SCIENCE BUILDING						
Customer:	PARIC CORPORATION						
Owner:	WEBSTER UNIVERSITY						
Location:	WEBSTER GROUVES, MO 63119						
Dwn:	ZZ	Date:	05/30/2016	Ckd:	LJ	Date:	05/30/2016
Job No.	A16013		BAT:			DWG#:	253

[illegible]



LOCATION: CAMBER=3/4" (REF: E2B)
ONE @ 2.6-3/B.3-C.3



LOCATION: ONE @ 2/B.3-C (REF: E2B)



LOCATION: ONE @ 1.9-2/4-A.5 (REF: E2B)

A	FOR APPROVAL		05/30/16	
Sequence:	2	Ref. E-Plans:	-	
Material:	A992	U.N.O.	Edge Dist:	1 1/2" U.N.O.
Holes:	13/16"DIA.	Bolts:	NOTED	
Clearing:	NONE			
Paint:	NO			
DFT:		COLOR:		


[illegible]

Romac By: _____ Checked By: _____


Beamline By: _____ Checked By: _____

ATLAS IRON WORKS
ST. LOUIS, MO.

Project: WEBSTER UNIVERSITY INTERDISCIPLINARY SCIENCE BUILDING
 Customer: PARIC CORPORATION
 Owner: WEBSTER UNIVERSITY
 Location: WEBSTER GUOVES.MO 63119
 Dwn: ZZ Date: 05/30/2016 Ckd: L.J Date: 05/30/2016
 Job No. A16013 BAT: DWG#: 254

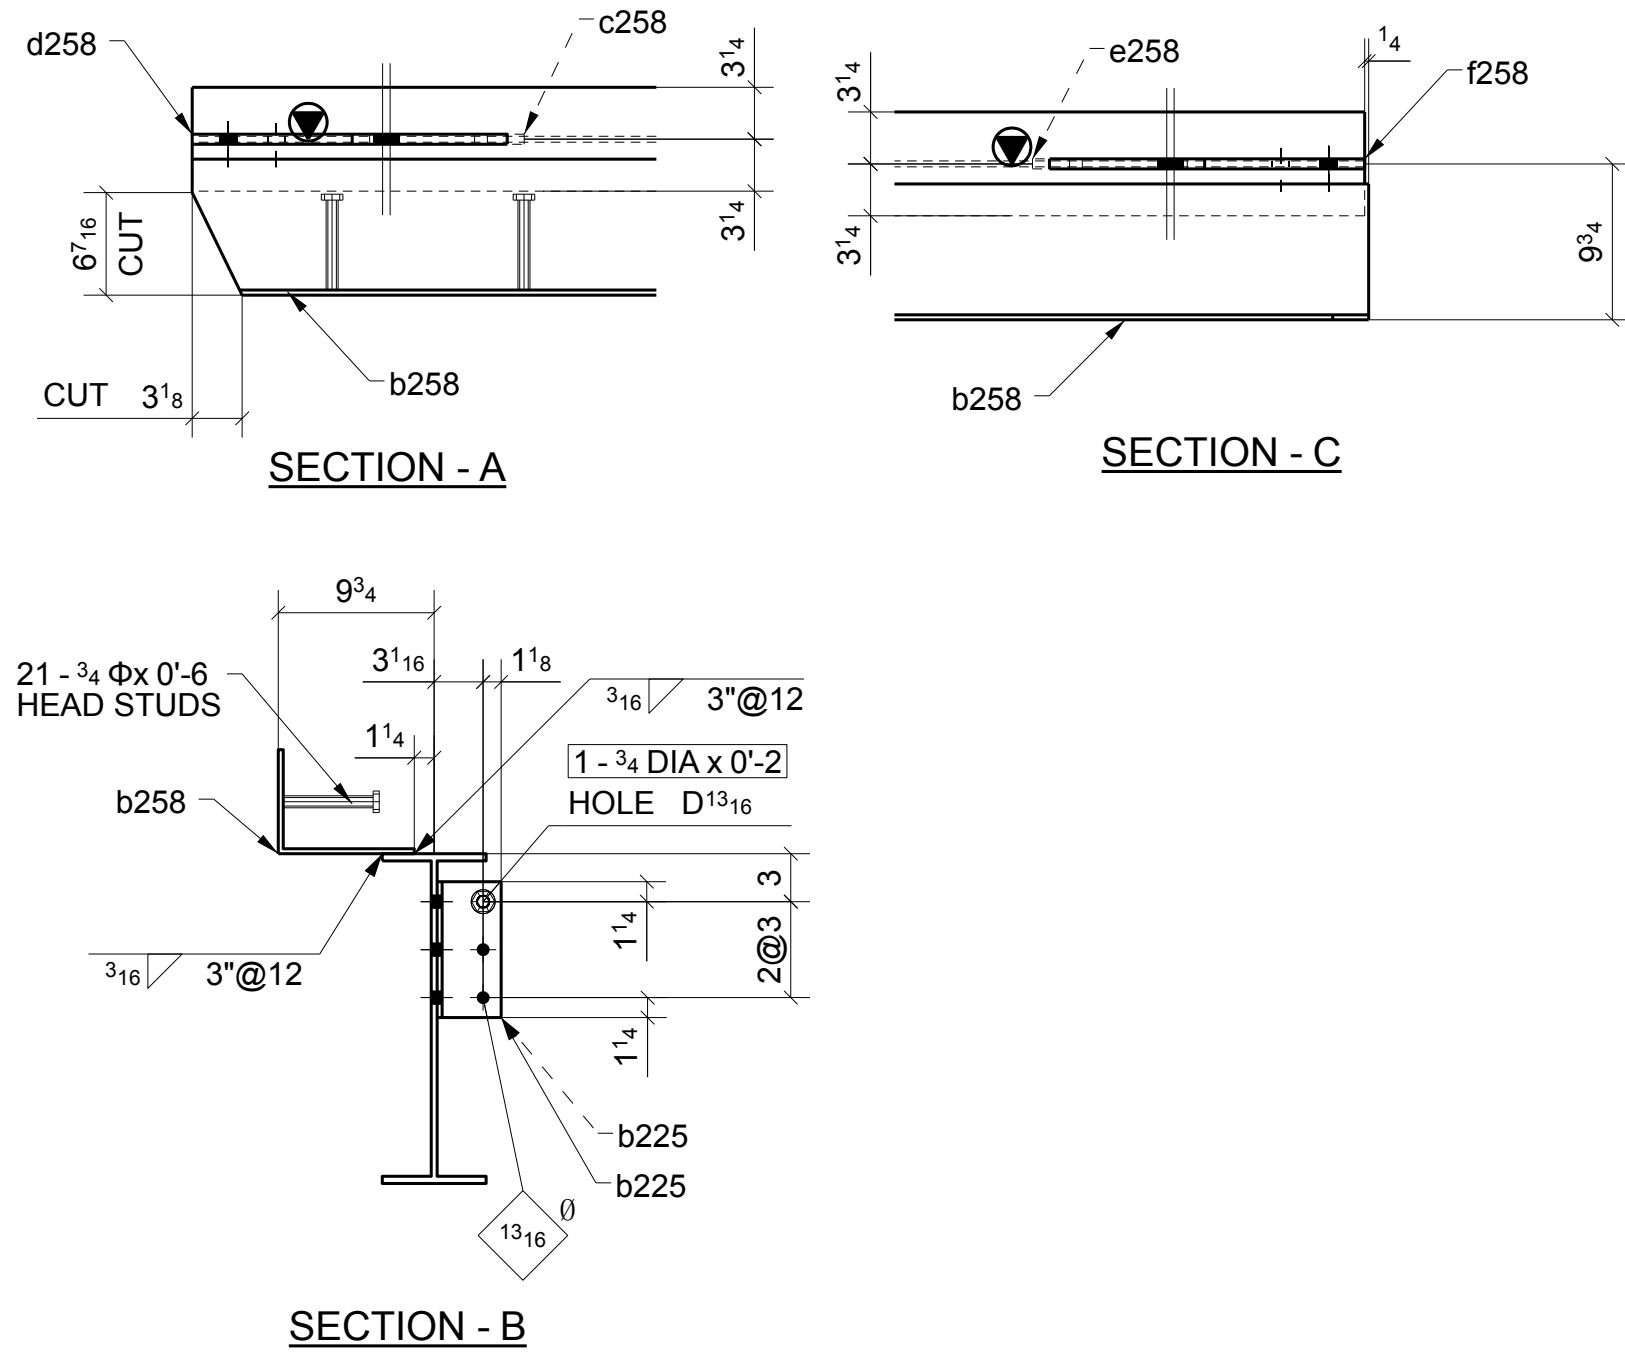

LOCATION: ONE @ 2/A.5-B.3 (REF: E2B)

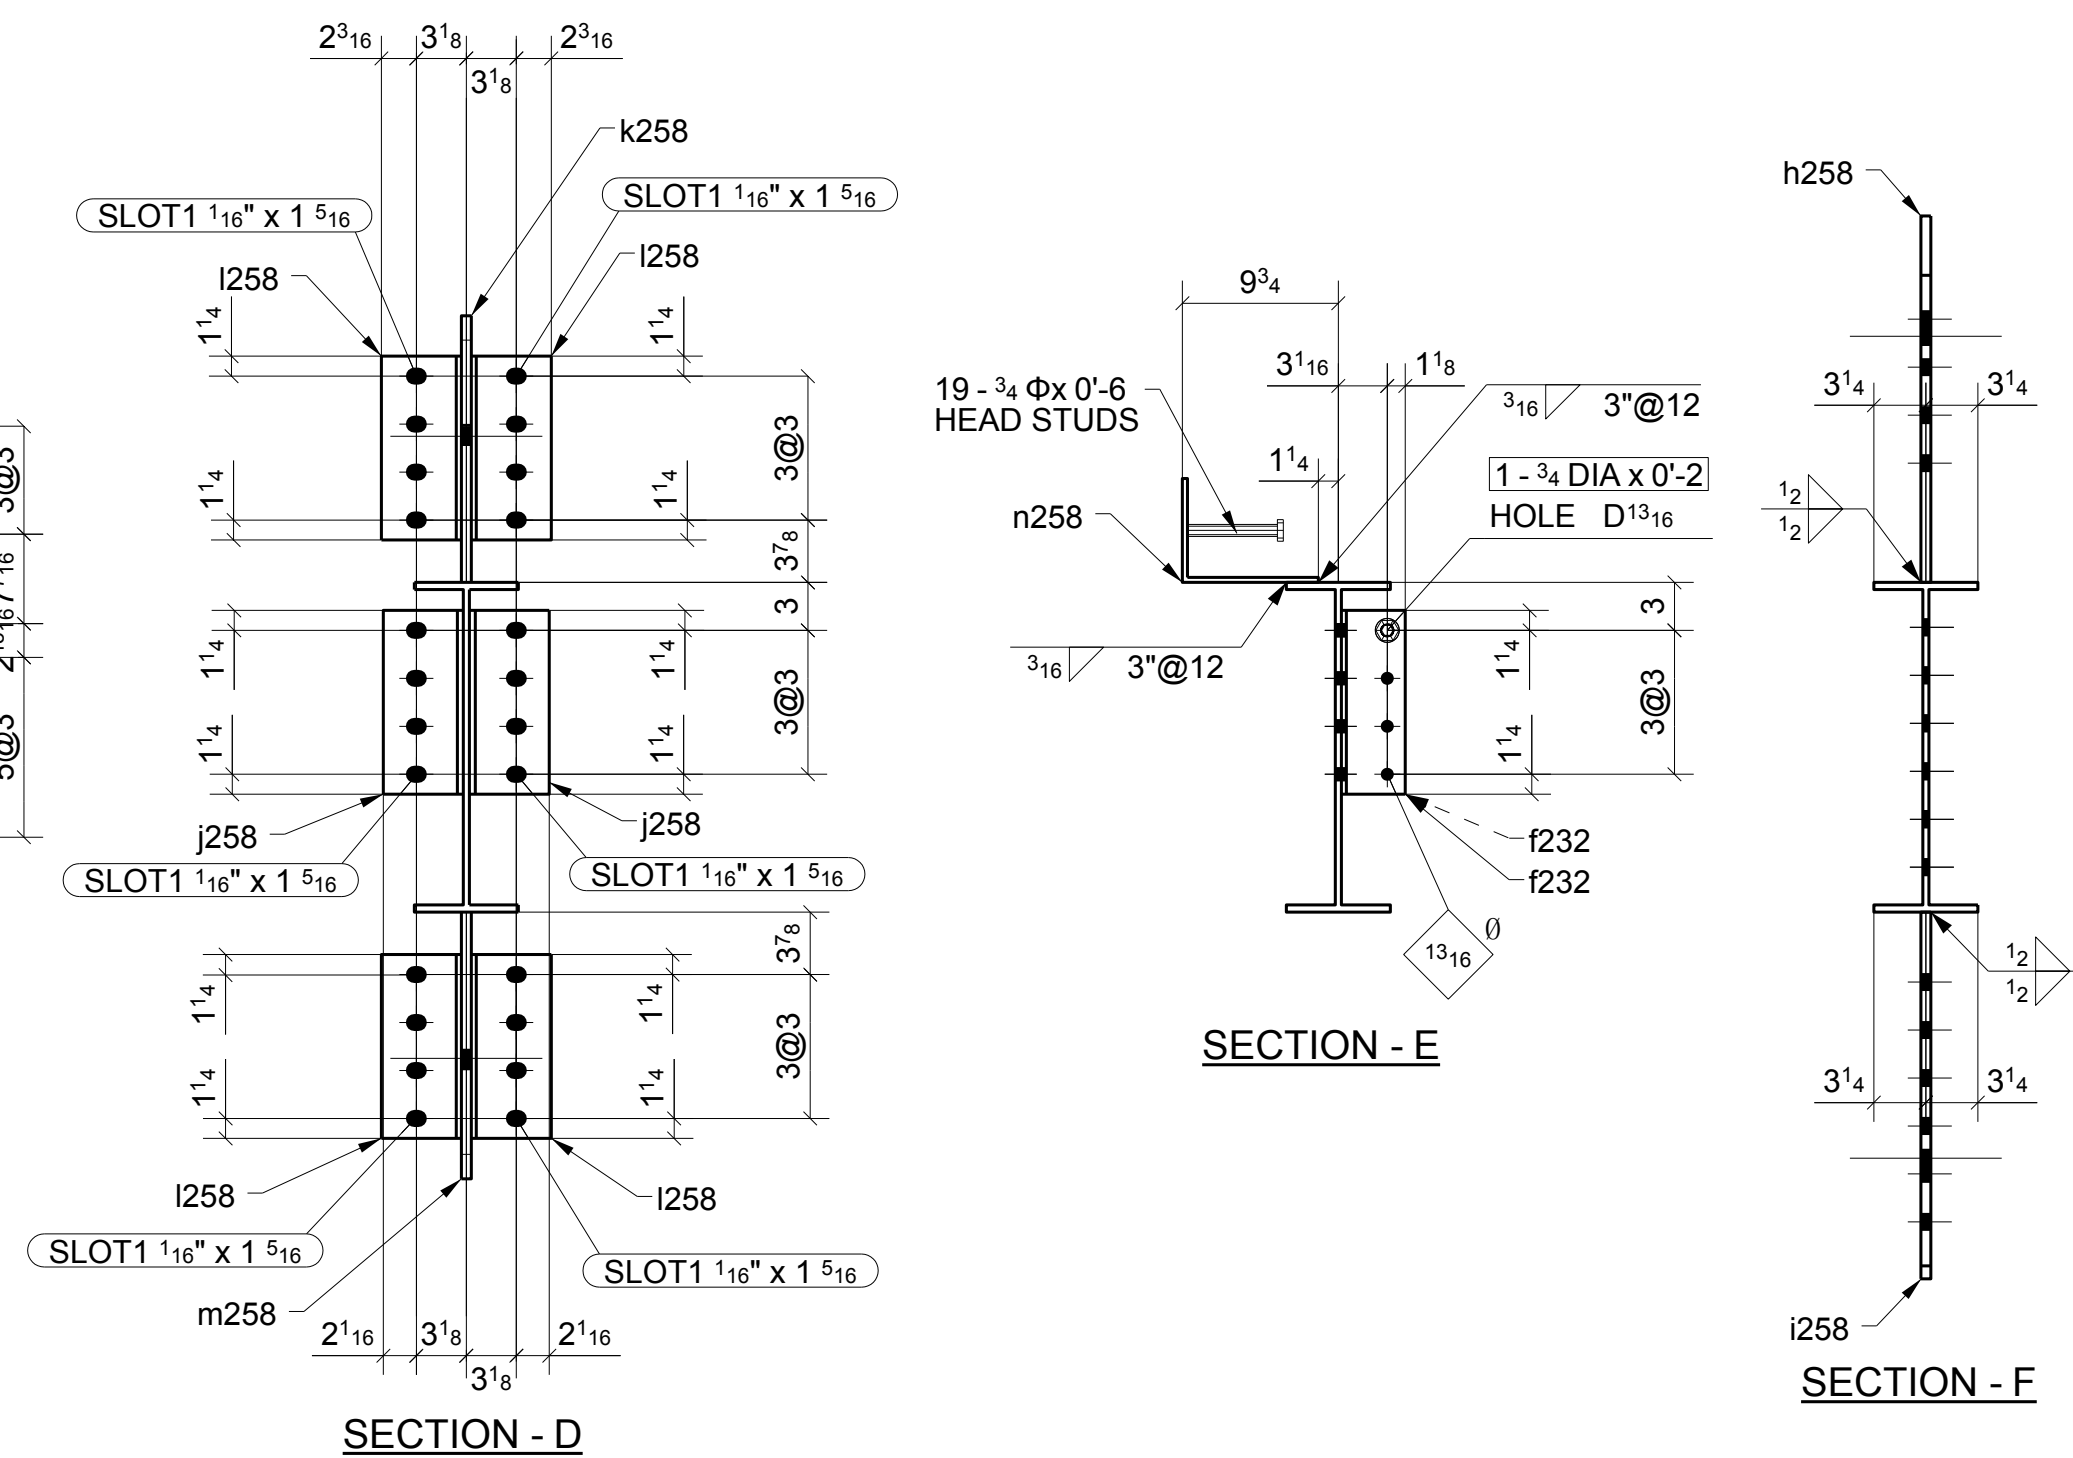

LOCATION: ONE @ 2-2.6/B.3 (REF: E2B)

Romac By: _____ Checked By: _____

Beamline By: _____ Checked By: _____

Project: WEBSTER UNIVERSITY INTERDISCIPLINARY SCIENCE BUILDING
 Customer: PARIC CORPORATION
 Owner: WEBSTER UNIVERSITY
 Location: WEBSTER GUOVES.MO 63119
 Dwn: ZZ Date: 05/30/2016 Ckd: L.J Date: 05/30/2016
 Job No. A16013 BAT: DWG#: 258

A	FOR APPROVAL		05/30/16
	Sequence: <u>2</u>	Ref. E-Plans: <u>—</u>	
	Material: <u>A992</u> U.N.O.	Edge Dist.: <u>1 1/2"</u> U.N.O.	
	Holes: <u>13/16" DIA.</u>	Bolts: <u>NOTED</u>	
	Cleaning: <u>NONE</u>		
	Paint: <u>NO</u>		
DFT: _____	COLOR: _____		

Romac By: _____	Checked By: _____
Beamline By: _____	Checked By: _____
ATLAS IRON WORKS ST. LOUIS, MO.	
Project: <u>WEBSTER UNIVERSITY INTERDISCIPLINARY SCIENCE BUILDING</u>	
Customer: <u>PARIC CORPORATION</u>	
Owner: <u>WEBSTER UNIVERSITY</u>	
Location: <u>WEBSTER GUVOMES, MO 63119</u>	
Dwn: <u>ZZ</u>	Date: <u>05/30/2016</u>
Ckd: <u>LJ</u>	Date: <u>05/30/2016</u>
Job No. <u>A16013</u> BAT: _____ DWG#: <u>259</u>	



SHOP BOLT IN SLOTTED HOLE
NEED "HAND TIGHTEN"

	FOR APPROVAL	05/30/16
Sequence: <u>2</u>	Ref. E-Plans: <u>-</u>	
Material: <u>A992</u> U.N.O.	Edge Dist.: <u>1 1/2"</u> U.N.O.	
Holes: <u>13/16" DIA.</u>	Bolts: <u>NOTED</u>	
Cleaning: <u>NONE</u>		
Paint: <u>NO</u>		
DFT: _____	COLOR: _____	

Romac By: _____	Checked By: _____
Beamline By: _____	Checked By: _____

ATLAS IRON WORKS

ST. LOUIS, MO.

Project:	WEBSTER UNIVERSITY INTERDISCIPLINARY SCIENCE BUILDING
Customer:	PARIC CORPORATION
Owner:	WEBSTER UNIVERSITY
Location:	WEBSTER GUVOMES, MO 63119

Dwn:	ZZ	Date:	05/30/2016	Ckd:	LJ	Date:	05/30/2016
------	----	-------	------------	------	----	-------	------------

Job No.	A16013	BAT:	DWG#:	260
---------	--------	------	-------	-----



SHOP BOLT IN SLOTTED HOLE
NEED "HAND TIGHTEN"


FOR APPROVAL		05/30/16	
Sequence:	2	Ref. E-Plans:	--
Material:	A992 U.N.O.	Edge Dist.:	1 1/2" U.N.O.
Holes:	13/16"DIA.	Bolts:	NOTED
Cleaning:	NONE		
Paint:	NO		
DFT:		COLOR:	

Romac By: _____	Checked By: _____
Beamline By: _____	Checked By: _____
ATLAS IRON WORKS ST. LOUIS, MO.	
Project: <u>WEBSTER UNIVERSITY INTERDISCIPLINARY SCIENCE BUILDING</u>	
Customer: <u>PARIC CORPORATION</u>	
Owner: <u>WEBSTER UNIVERSITY</u>	
Location: <u>WEBSTER GUVOM, MO 63119</u>	
Dwn: <u>ZZ</u>	Date: <u>05/30/2016</u>
Ckd: <u>LJ</u>	Date: <u>05/30/2016</u>
Job No. <u>A16013</u> BAT: _____ DWG#: <u>261</u>	

[illegible]

	FOR APPROVAL	05/30/16
Sequence: <u>2</u>	Ref. E-Plans: <u>—</u>	
Material: <u>A992</u> U.O.	Edge Dist.: <u>1 1/2"</u> U.O.	
Holes: <u>13/16" DIA.</u>	Bolts: <u>NOTED</u>	
Cleaning: <u>NONE</u>		
Paint: <u>NO</u>		
DFT: _____	COLOR: _____	

Romac By: _____	Checked By: _____
Baseline By: _____	Checked By: _____
ATLAS IRON WORKS ST. LOUIS, MO.	
Project: <u>WEBSTER UNIVERSITY INTERDISCIPLINARY SCIENCE BUILDING</u>	
Customer: <u>PARIC CORPORATION</u>	
Owner: <u>WEBSTER UNIVERSITY</u>	
Location: <u>WEBSTER GUVES, MO 63119</u>	
Dwn: <u>ZZ</u>	Date: <u>05/30/2016</u>
Ckd: <u>LJ</u>	Date: <u>05/30/2016</u>
Job No. <u>A16013</u>	BAT: _____ DWG#: <u>262</u>

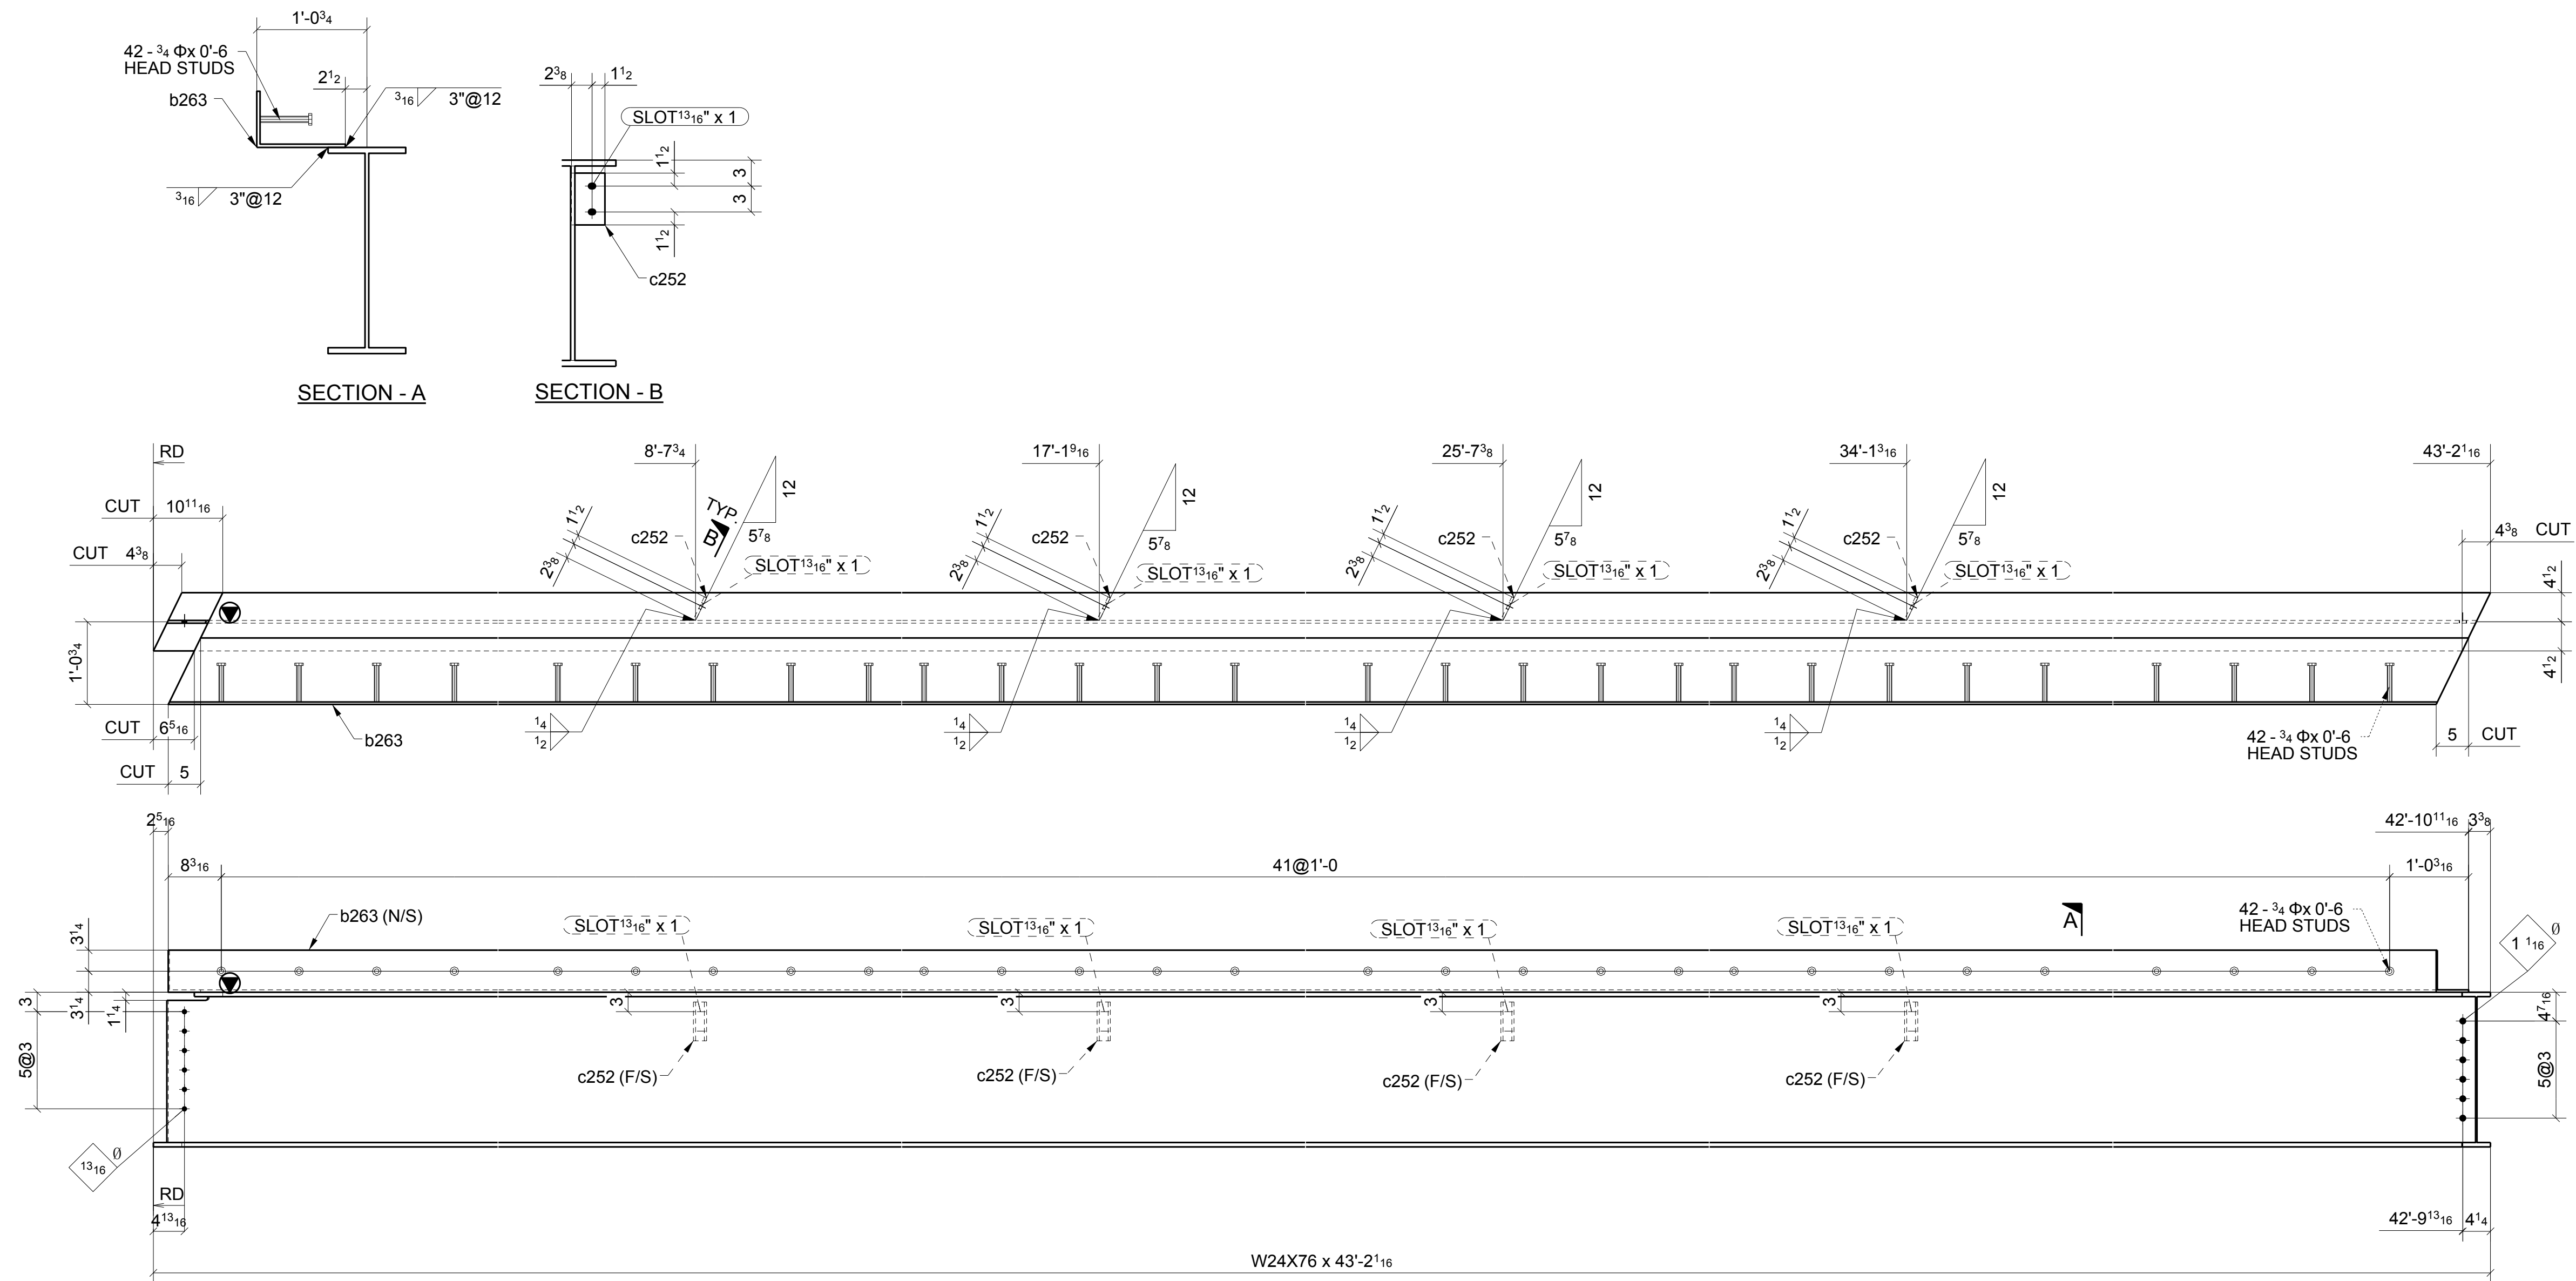

ONE - BEAM ~ 263A
LOCATION: ONE @ 1.6-2/4-A.5 (REF: E2B)

SHOP BOLT IN SLOTTED HOLE
NEED "HAND TIGHTEN"


MATERIAL LIST					
QTY	MARK	DESCRIPTION	LENGTH	MATERIAL	NOTES
1	263A	W24X76	43'-2 1/16"	A992	
1	b263	BPL 3/8" X 16 3/4"	42'-8 3/8"	A36	
4	c252	PL 3/8" X 3 7/8"	0'-6"	A36	
42		3/4" STUD	0'-6"		

Romac By:	Checked By:
Beamline By:	Checked By:
ATLAS IRON WORKS ST. LOUIS, MO.	
Project:	WEBSTER UNIVERSITY INTERDISCIPLINARY SCIENCE BUILDING
Customer:	PARIC CORPORATION
Owner:	WEBSTER UNIVERSITY
Location:	WEBSTER GUOVES, MO 63119
Dwn:	ZZ
Date:	05/30/2016
Ckd:	LJ
Date:	05/30/2016
Job No.	A16013
BAT:	DWCF
DWG#:	263

FOR APPROVAL		06/30/16
Sequence:	2	Ref. E-Plans:
Material:	A992 U.N.O.	Edge Dist.: 1 1/2" U.N.O.
Holes:	13/16" DIA.	Bolts: NOTED
Cleaning:	NONE	
Paint:	NO	
DFT:		COLOR:

MATERIAL LIST

QTY	MARK	DESCRIPTION	LENGTH	MATERIAL	NOTES
1	264A	W27X84	40'-0 1/2"	A992	
1	b236	PL5/16"X9 1/2"	21'-4 1/2"	A36	
4	b264	PL3/8"X4 1/16"	0'-9"	A36	
2	c252	PL3/8"X3 7/8"	0'-6"	A36	
1	c264	PL3/8"X3 7/8"	0'-9"	A36	

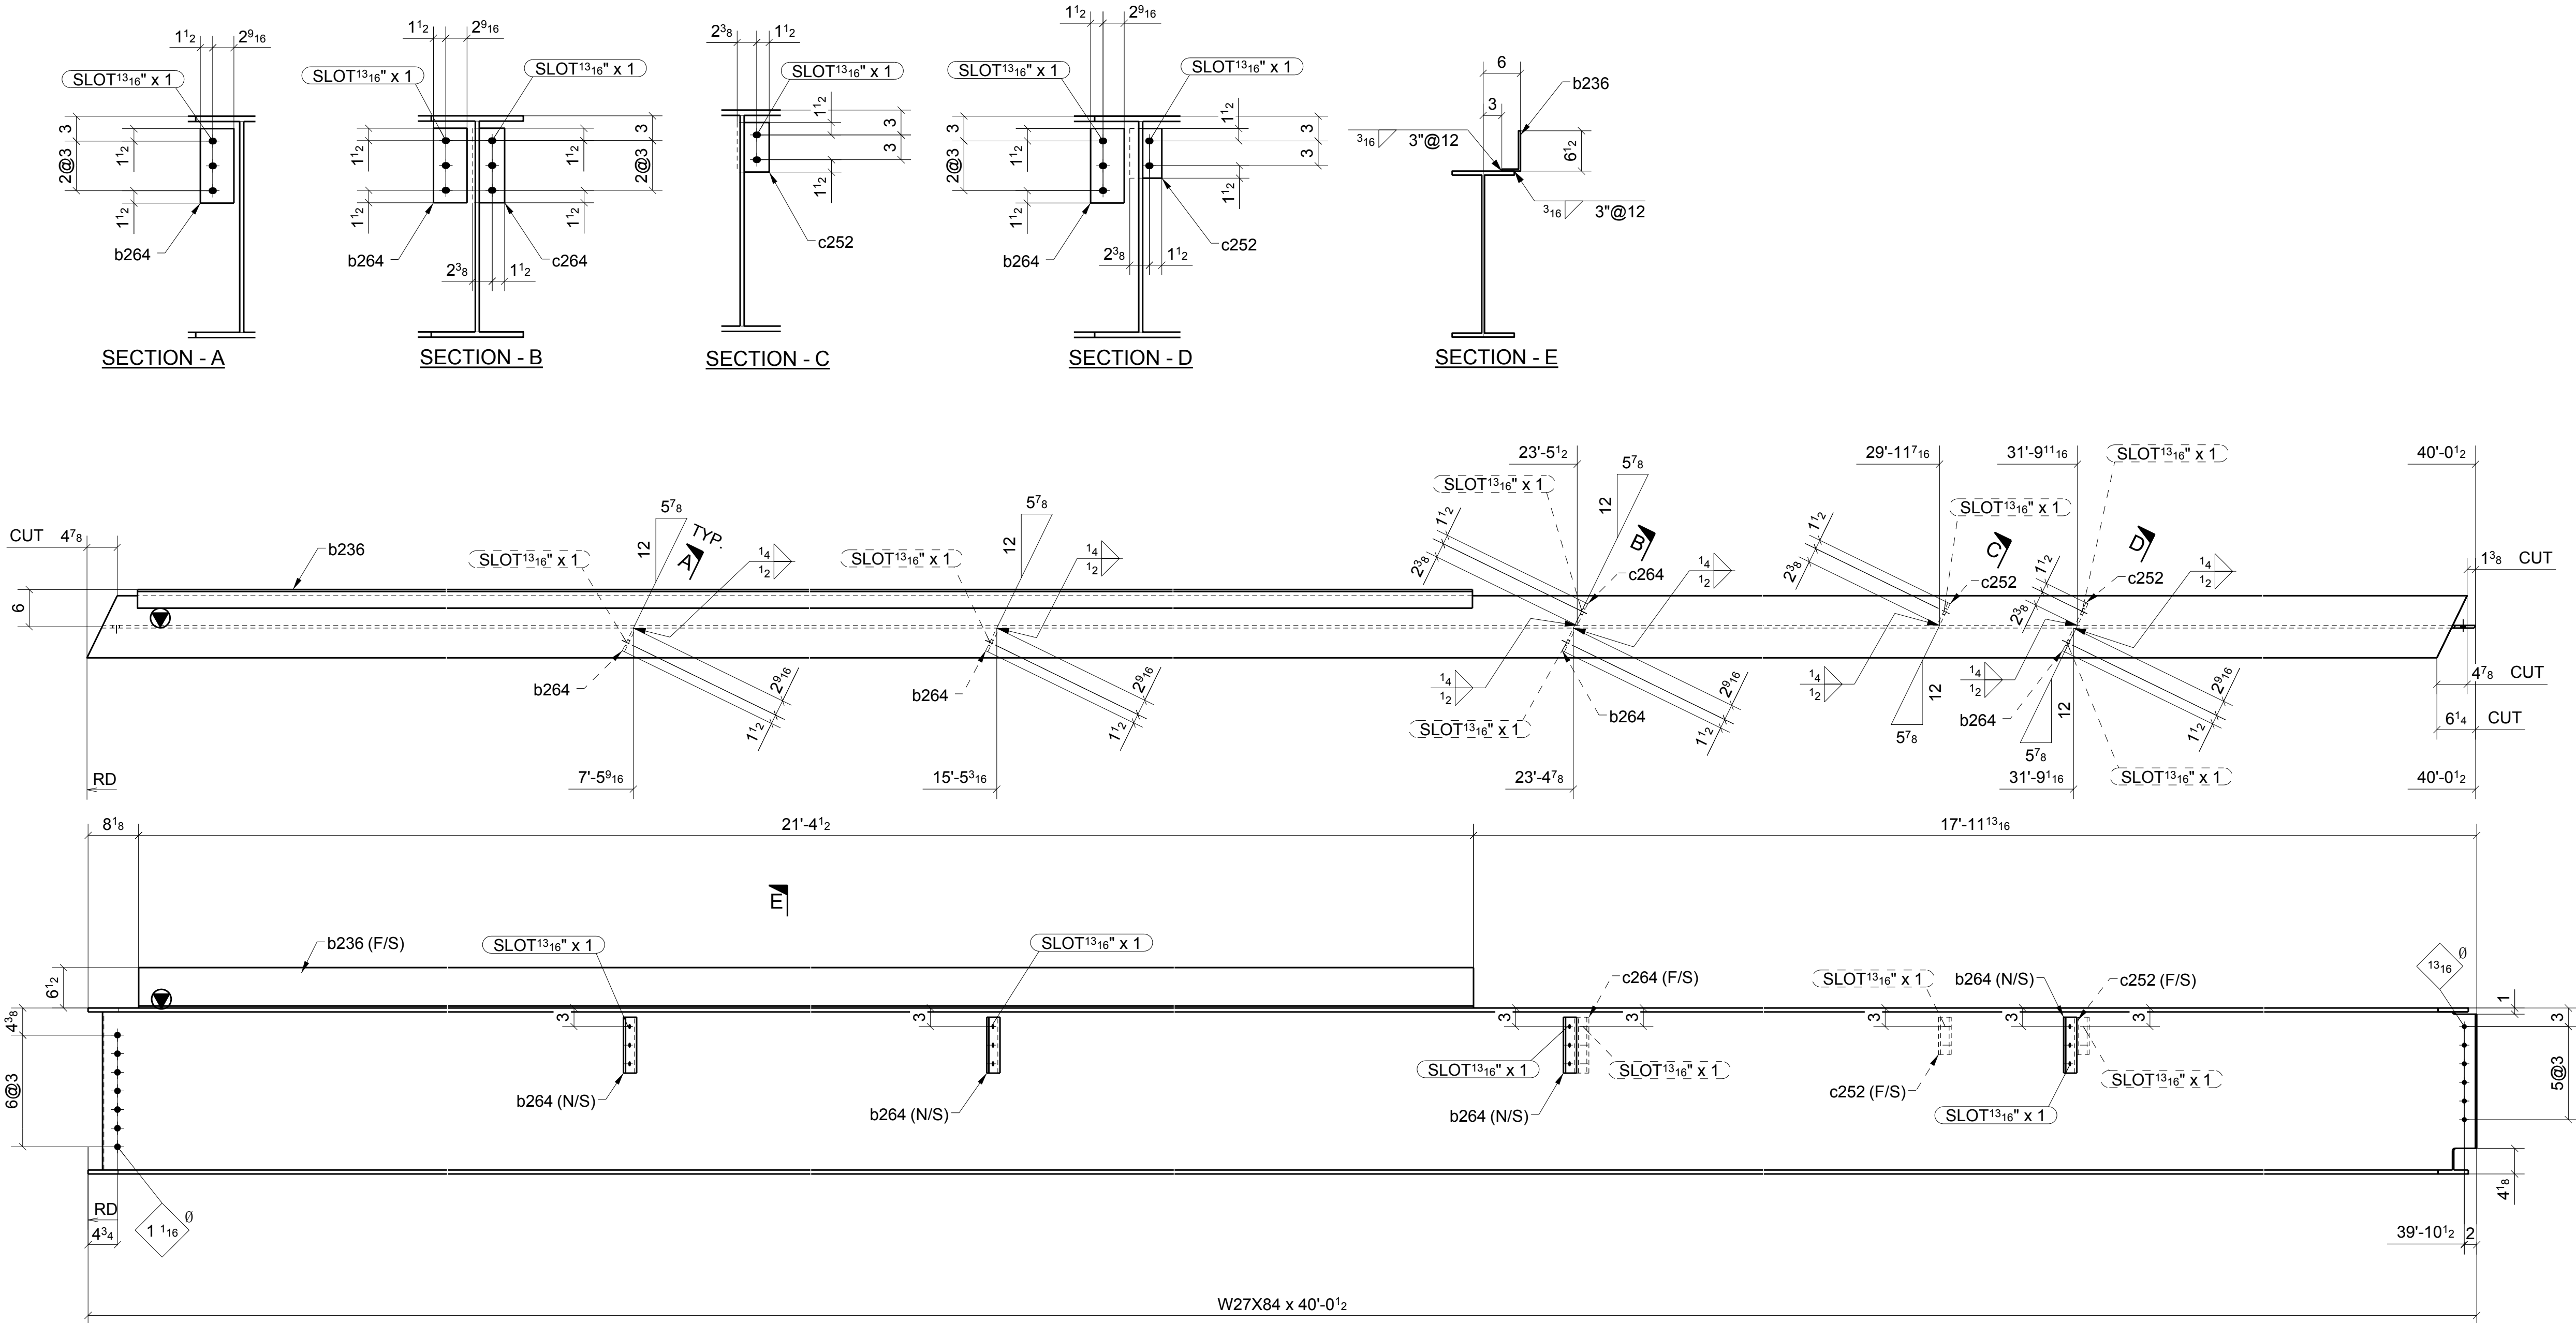

ONE - BEAM ~ 264A
LOCATION: ONE @ 2-3/A.5-B.3 (REF: E2B)

SHOP BOLT IN SLOTTED HOLE
NEED "HAND TIGHTEN"

FOR APPROVAL				06/30/16	
Sequence:	2	Ref. E-Plans:	-		
Material:	A992 U.N.O.	Edge Dist.:	1 1/2" U.N.O.		
Holes:	13/16"DIA.	Bolts:	NOTED		
Cleaning:	NONE				
Paint:	NO				
DFT:		COLOR:			

Romac By: _____ Checked By: _____
Beamline By: _____ Checked By: _____

ATLAS IRON WORKS
ST. LOUIS, MO.


Project: WEBSTER UNIVERSITY INTERDISCIPLINARY SCIENCE BUILDING
Customer: PARIC CORPORATION
Owner: WEBSTER UNIVERSITY
Location: WEBSTER GUVES, MO 63119
Dwn: ZZ Date: 05/30/2016 Ckd: L.J. Date: 05/30/2016
Job No. A16013 BAT: _____ DWG# 264

Romac By: _____	Checked By: _____
Beamline By: _____	Checked By: _____
ATLAS IRON WORKS ST. LOUIS, MO.	
Project: <u>WEBSTER UNIVERSITY INTERDISCIPLINARY SCIENCE BUILDING</u>	
Customer: <u>PARIC CORPORATION</u>	
Owner: <u>WEBSTER UNIVERSITY</u>	
Location: <u>WEBSTER GUVOM, MO 63119</u>	
Dwn: <u>ZZ</u>	Date: <u>05/30/2016</u>
Ckd: <u>LJ</u>	Date: <u>05/30/2016</u>
Job No. <u>A16013</u> BAT: _____ DWG#: <u>265</u>	



SHOP BOLT IN SLOTTED HOLE
NEED "HAND TIGHTEN"

A	FOR APPROVAL		05/30/16	
Sequence:	2		Ref. E-Plans:	-
Material:	A992	U.N.O.	Edge Dist.:	1 1/2" U.N.O.
Holes:	13/16" DIA.		Bolts:	NOTED
Cleaning:	NONE			
Paint:	NO			
DFT:			COLOR:	

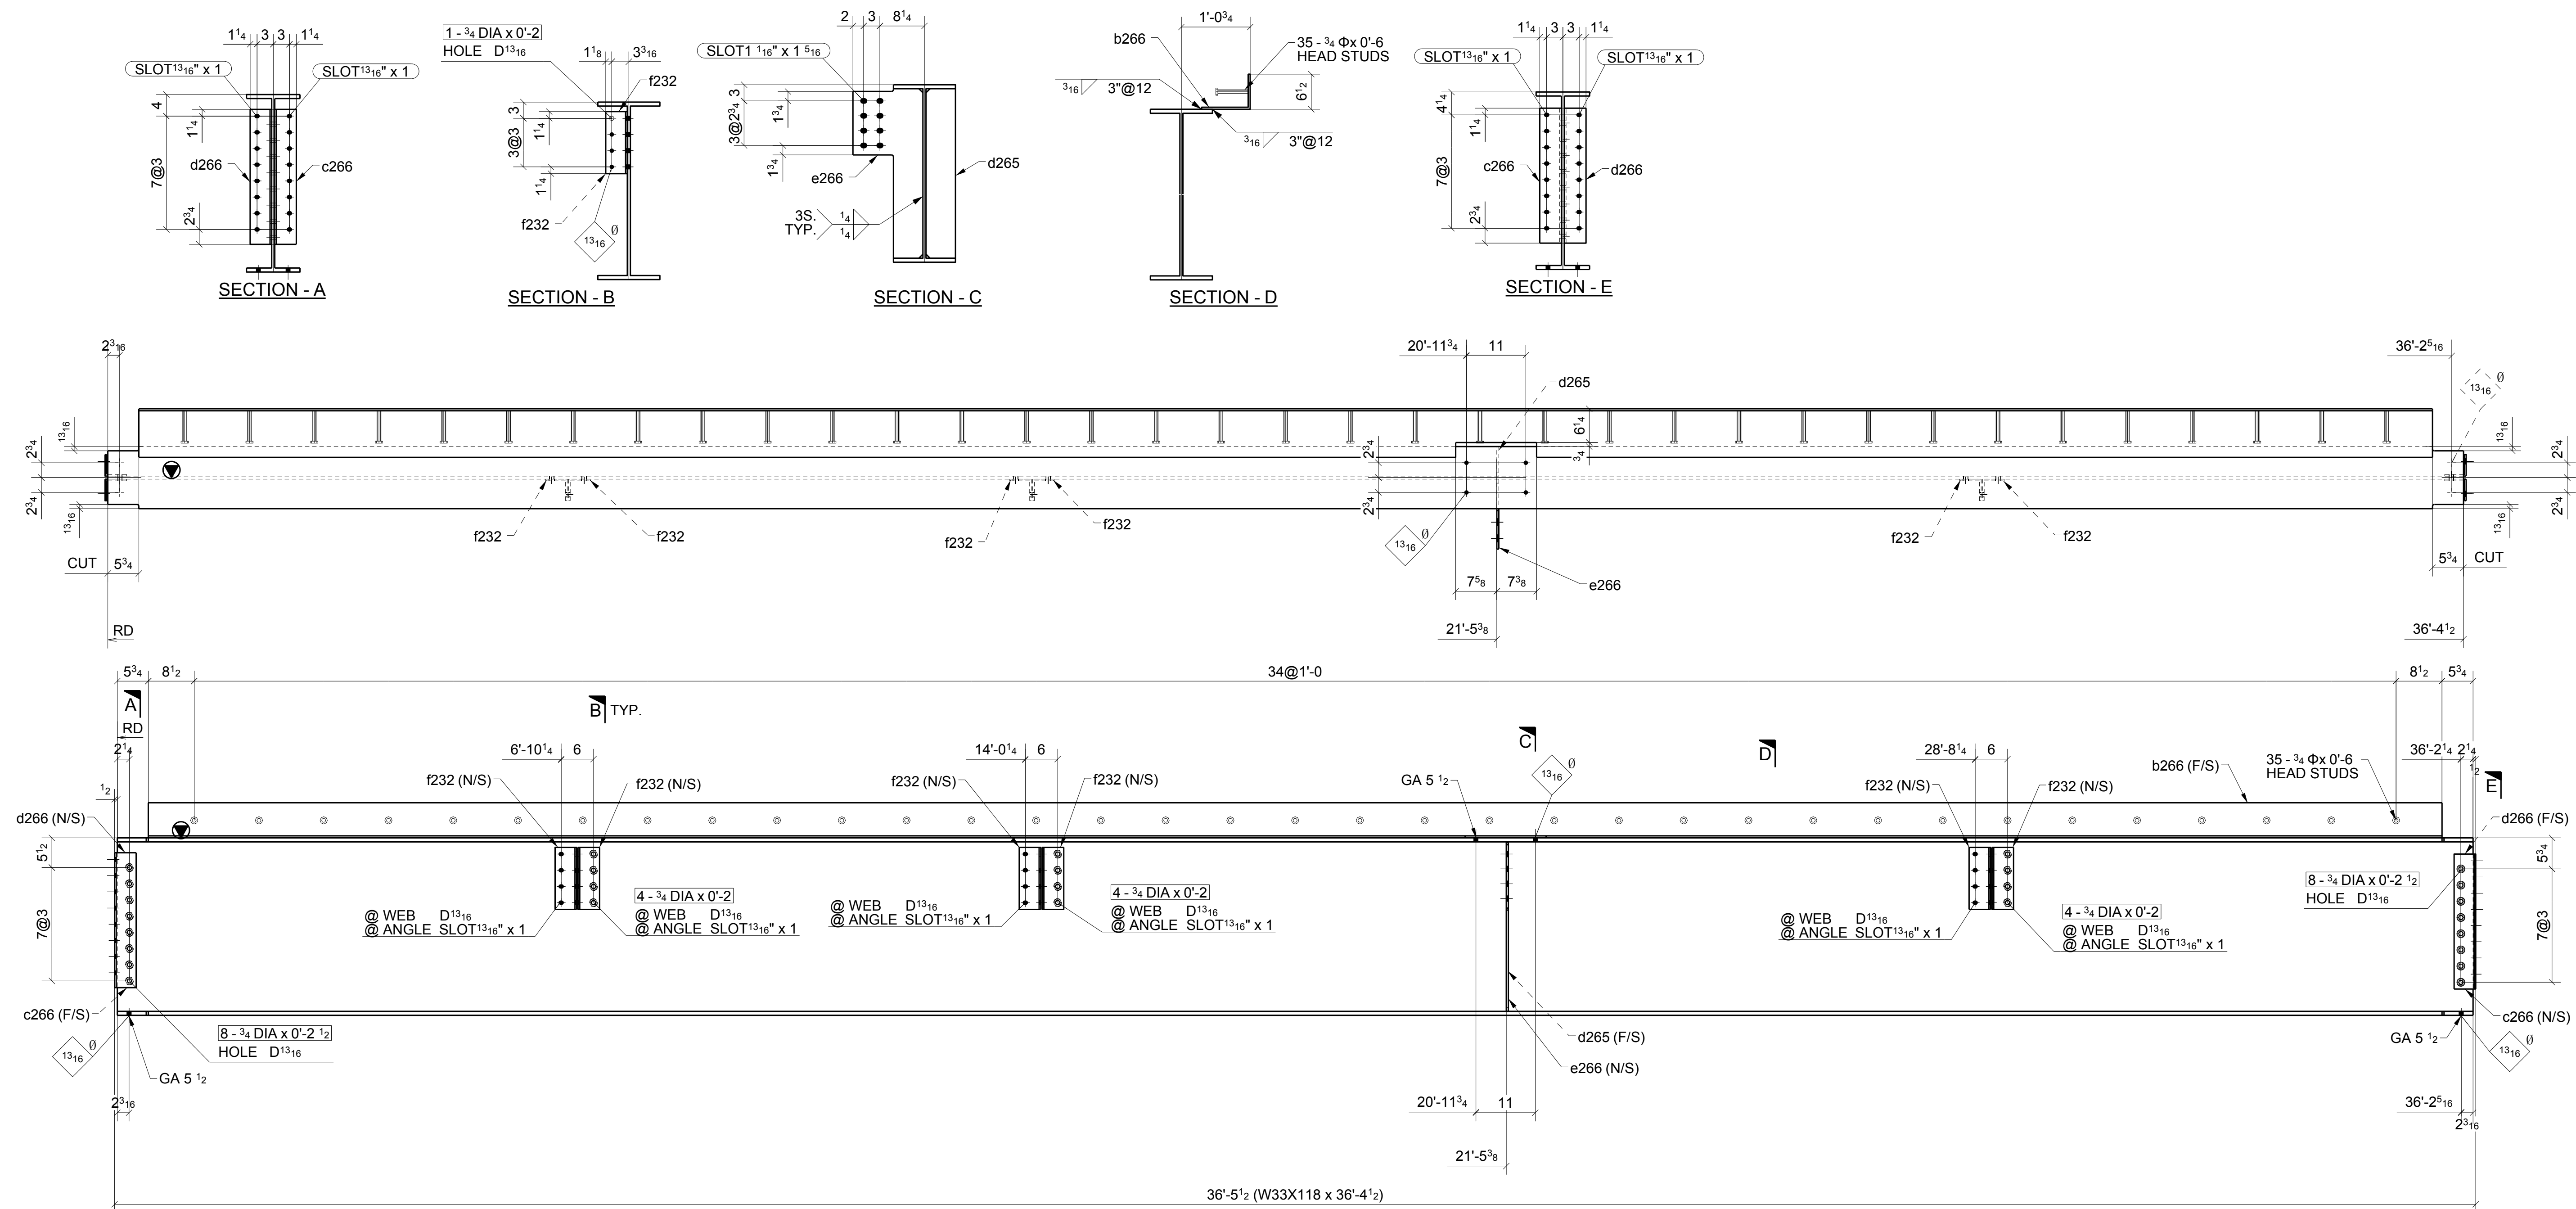





ONE - BEAM ~ 266A

LOCATION: ONE @ 2-3/C.3 (REF: E2B)

SHOP BOLT IN SLOTTED HOLE
NEED "HAND TIGHTEN"



MATERIAL LIST					
QTY	MARK	DESCRIPTION	LENGTH	MATERIAL	NOTES
1	266A	W33X118	36'-4 1/2"	A992	
1	b266	BPL3/8"X15 1/2"	35'-5"	A36	
2	d266	L4X4X5/16	2'-1"	A36	
1	c265	PL3/8"X5 1/2"	2'-7 3/8"	A36	
2	d266	L4X4X5/16	2'-1"	A36	
1	e266	PL3/8"X12 15/16"	2'-7 3/8"	A36	
6	f232	L4X4X5/16	0'-11 1/2"	A36	
3		3/4" DIA. W/N&W	0'-2"	A325N	TC
12		3/4" DIA. W/N&W	0'-2"	A325N	TC
16		3/4" DIA. W/N&W	0'-2 1/2"	A325N	TC
35		3/4" STUD	0'-6"		

Romac By: _____	Checked By: _____
Beamline By: _____	Checked By: _____
ATLAS IRON WORKS ST. LOUIS, MO.	
Project: _____	WEBSTER UNIVERSITY INTERDISCIPLINARY SCIENCE BUILDING
Customer: _____	PARIC CORPORATION
Owner: _____	WEBSTER UNIVERSITY
Location: _____	WEBSTER GUOVES, MO 63119
Dwn: _____	ZZ Date: 05/30/2016 Ckd: L.J. Date: 05/30/2016
Job No. _____	A16013 BAT: _____ DWG#: 266

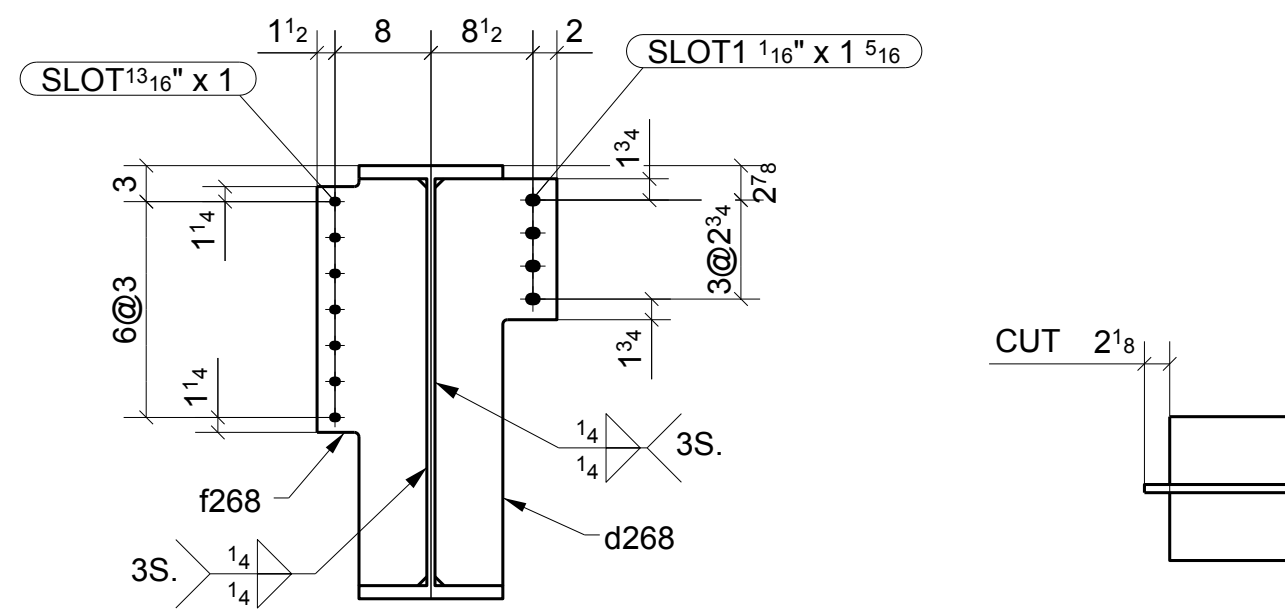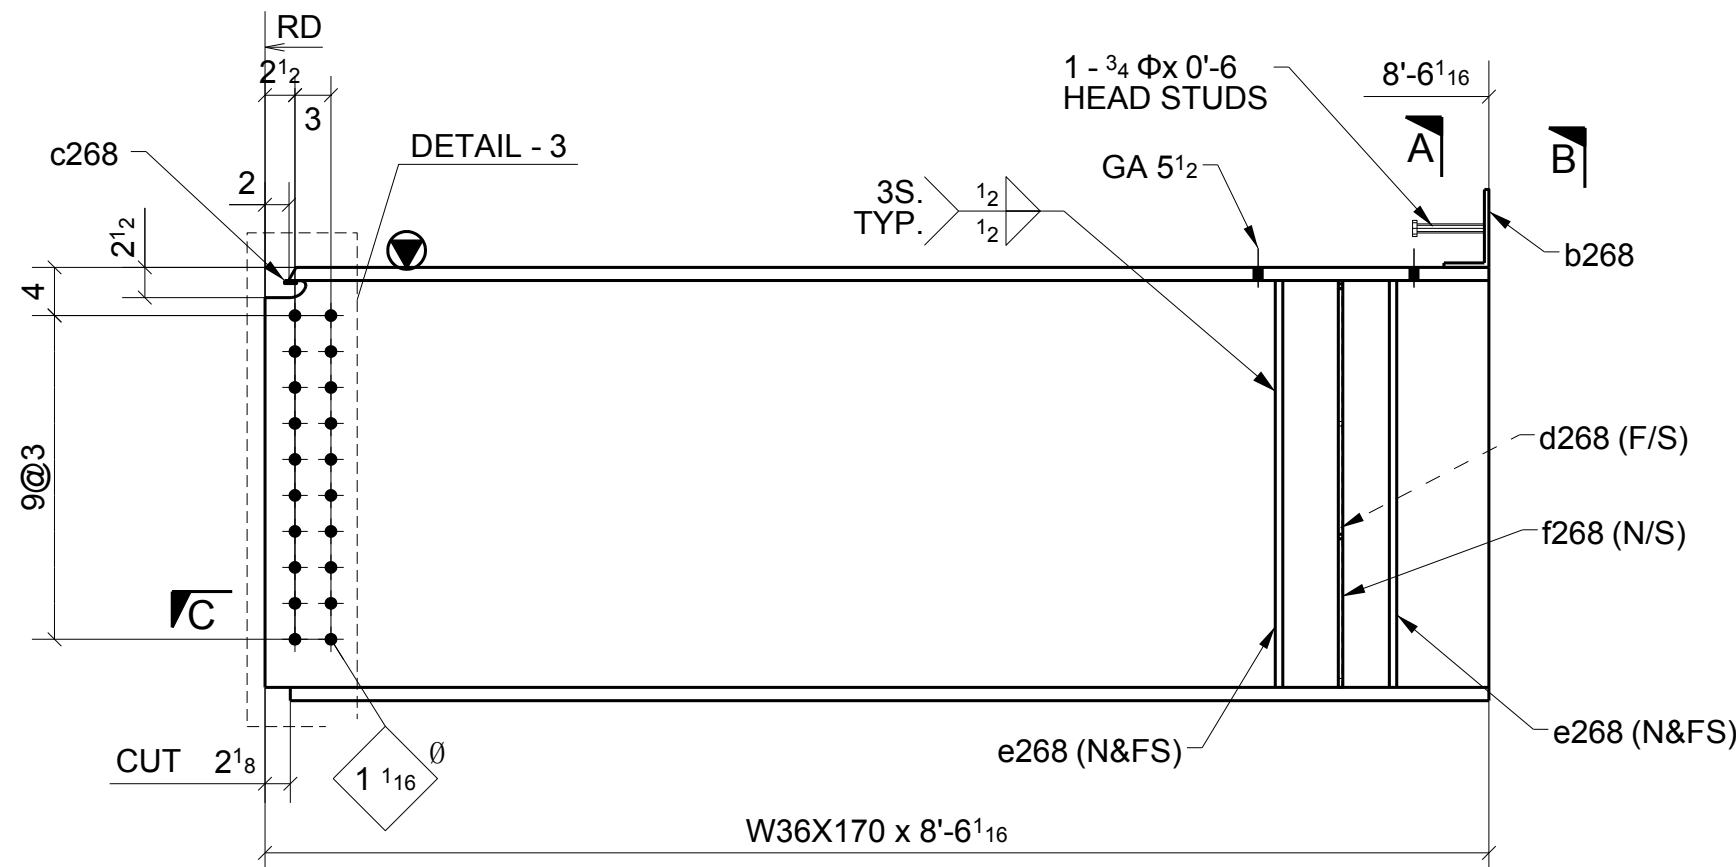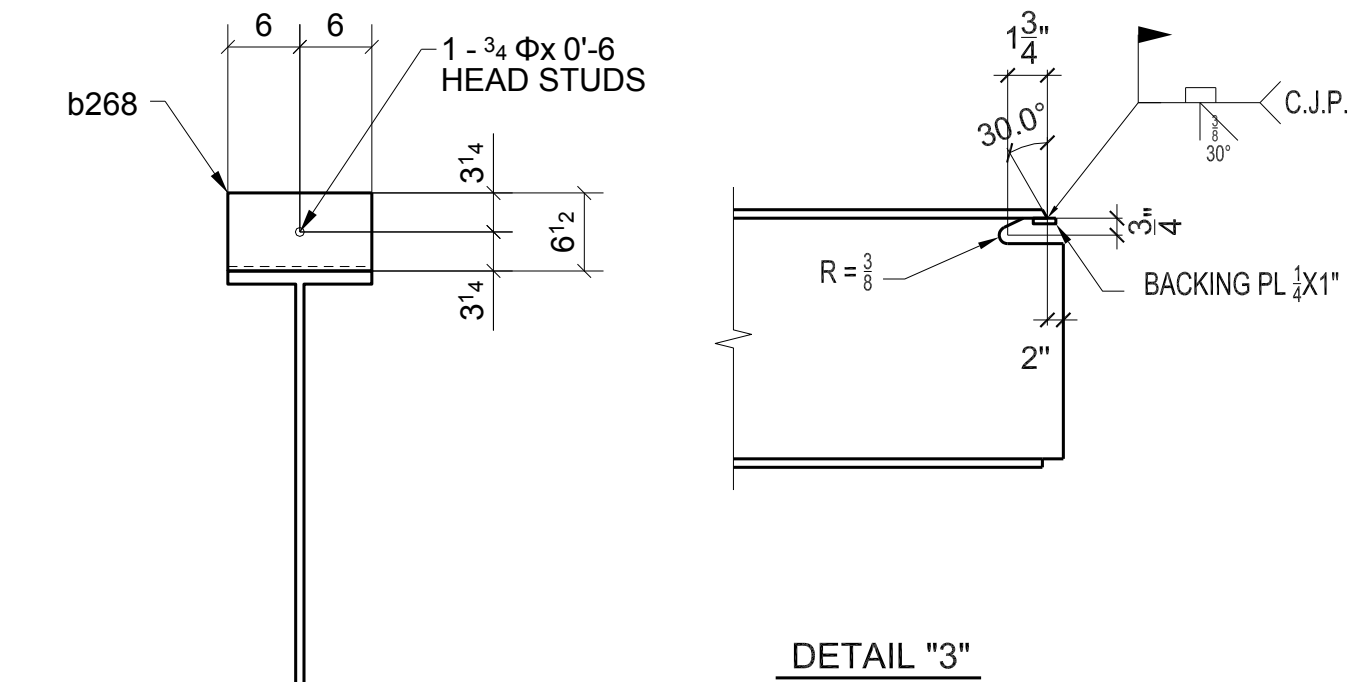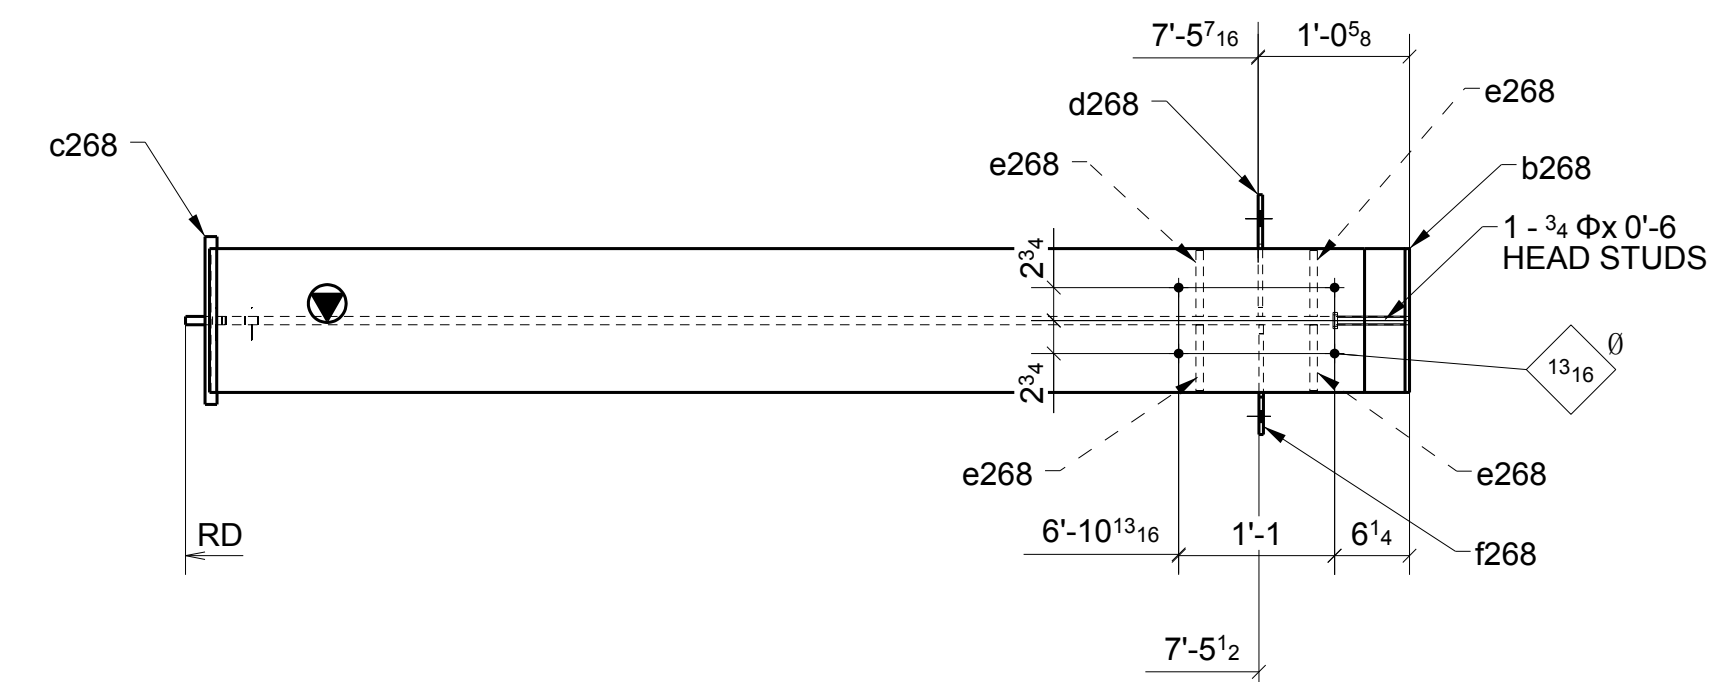


ONE - BEAM ~ 268A


LOCATION: ONE @ 1.6/C-C.3 (REF: E2B)

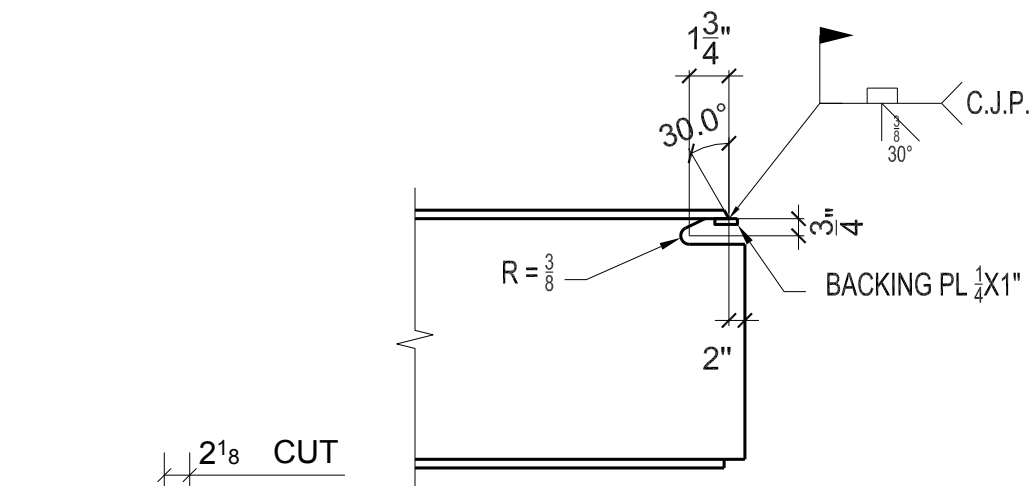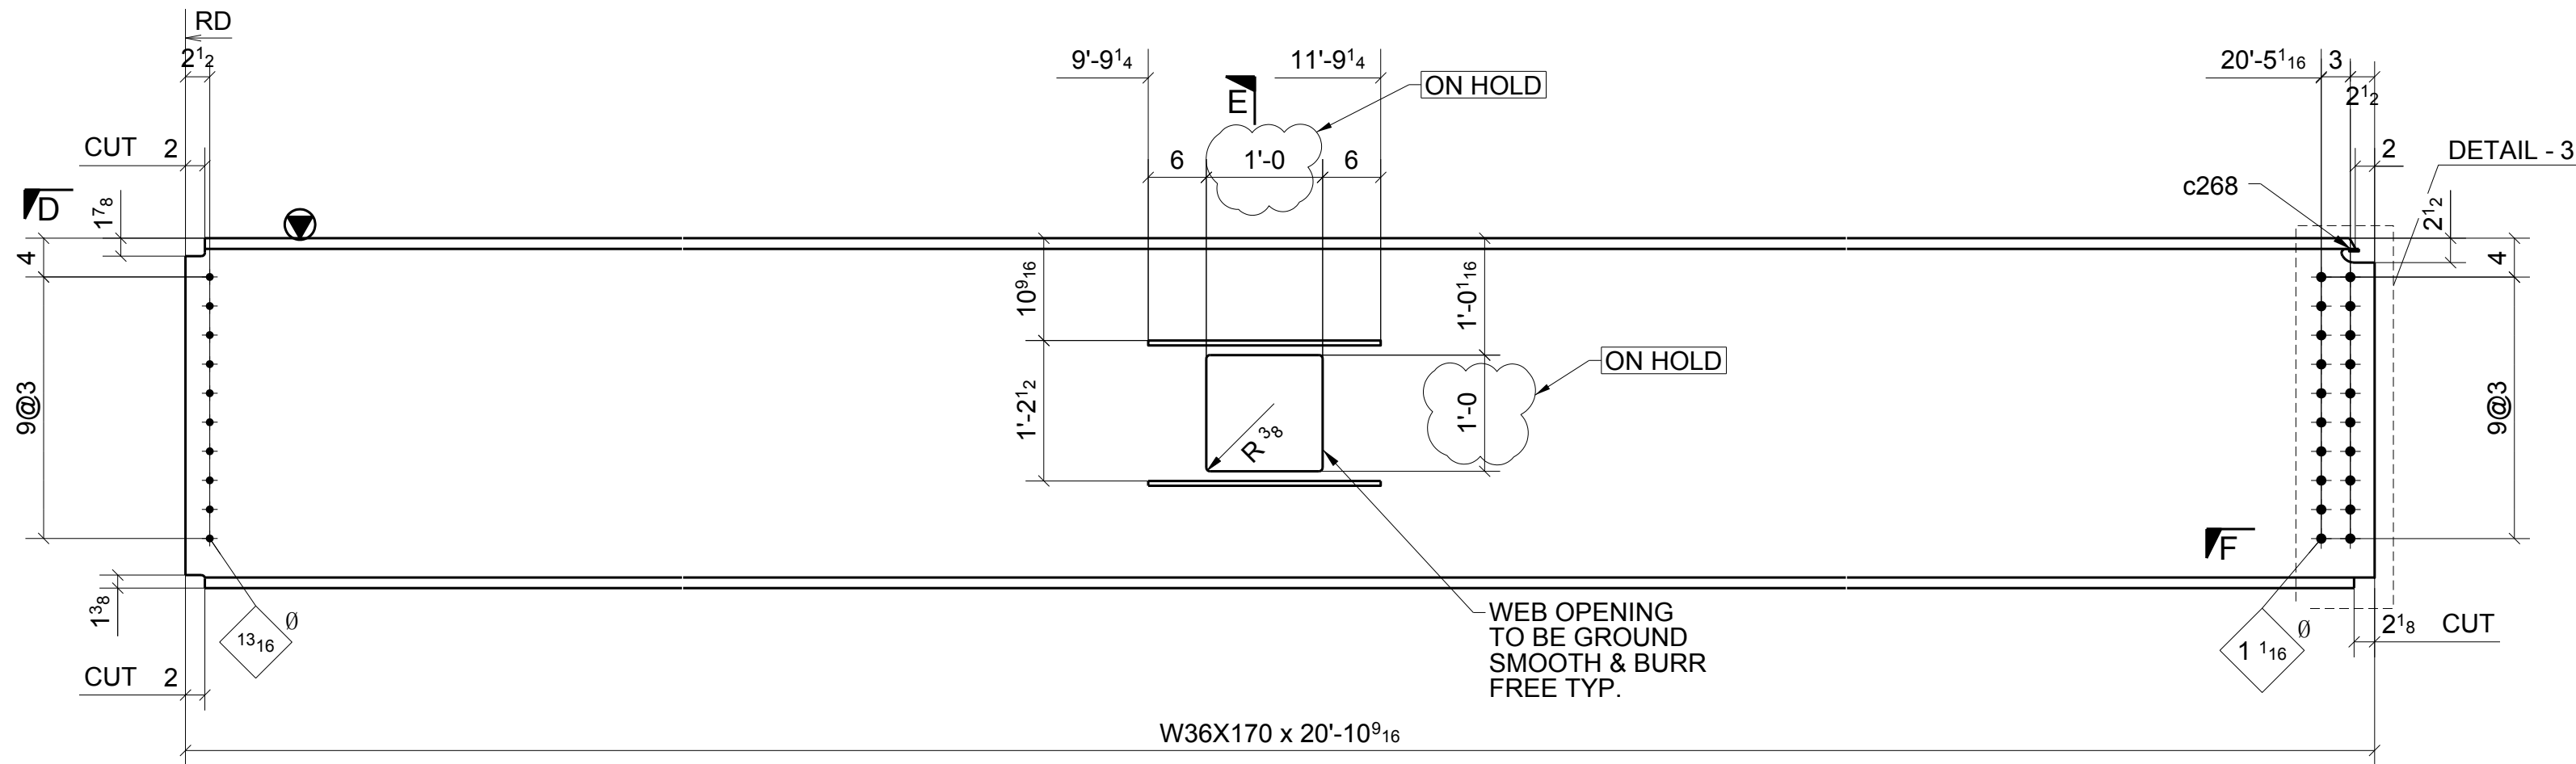

SECTION - F

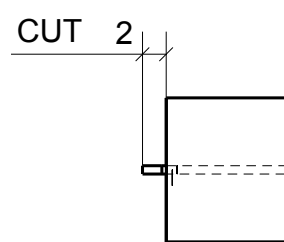

SECTION - D

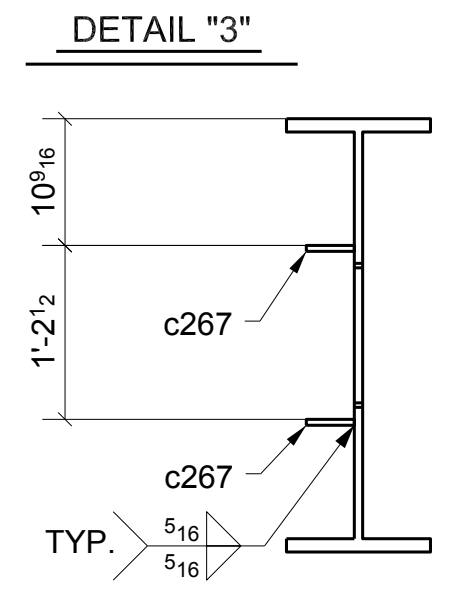

ONE - BEAM ~ 268B

LOCATION: ONE @ 1.6/B.3-C (REF: E2B)

SHOP BOLT IN SLOTTED HOLE
NEED "HAND TIGHTEN"

MATERIAL LIST

QTY	MARK	DESCRIPTION	LENGTH	MATERIAL	NOTES
1	268A	W36X170	8'-6 1/16"	A992	
1	b268	BPL3/8"X10 1/4"	1'-0"	A36	
1	c268	PL1/4"X1"	1'-2"	A36	
1	d268	PL3/8"X10 3/16"	2'-9 15/16"	A36	
4	e268	PL5/8"X5 1/2"	2'-9 15/16"	A36	
1	f268	PL3/8"X9 1/8"	2'-9 15/16"	A36	
1		3/4" STUD	0'-6"		


1	268B	W36X170	20'-10 9/16"	A992	
2	c267	PL1/2"X4"	2'-0"	A36	
1	c268	PL1/4"X1"	1'-2"	A36	

Romac By: _____ Checked By: _____
Beamline By: _____ Checked By: _____

ATLAS IRON WORKS
ST. LOUIS, MO.

Project: WEBSTER UNIVERSITY INTERDISCIPLINARY SCIENCE BUILDING
Customer: PARIC CORPORATION
Owner: WEBSTER UNIVERSITY
Location: WEBSTER GUVES, MO 63119
Dwn: ZZ Date: 05/30/2016 Ckd: L.J. Date: 05/30/2016
Job No. A16013 BAT: _____ DWG# 268

A	FOR APPROVAL	05/30/16
Sequence:	2	Ref. E-Plans: -
Material:	A992 U.N.O.	Edge Dist.: 1 1/2" U.N.O.
Holes:	13/16"DIA.	Bolts: NOTED
Cleaning:	NONE	
Paint:	NO	
DFT:		COLOR: _____

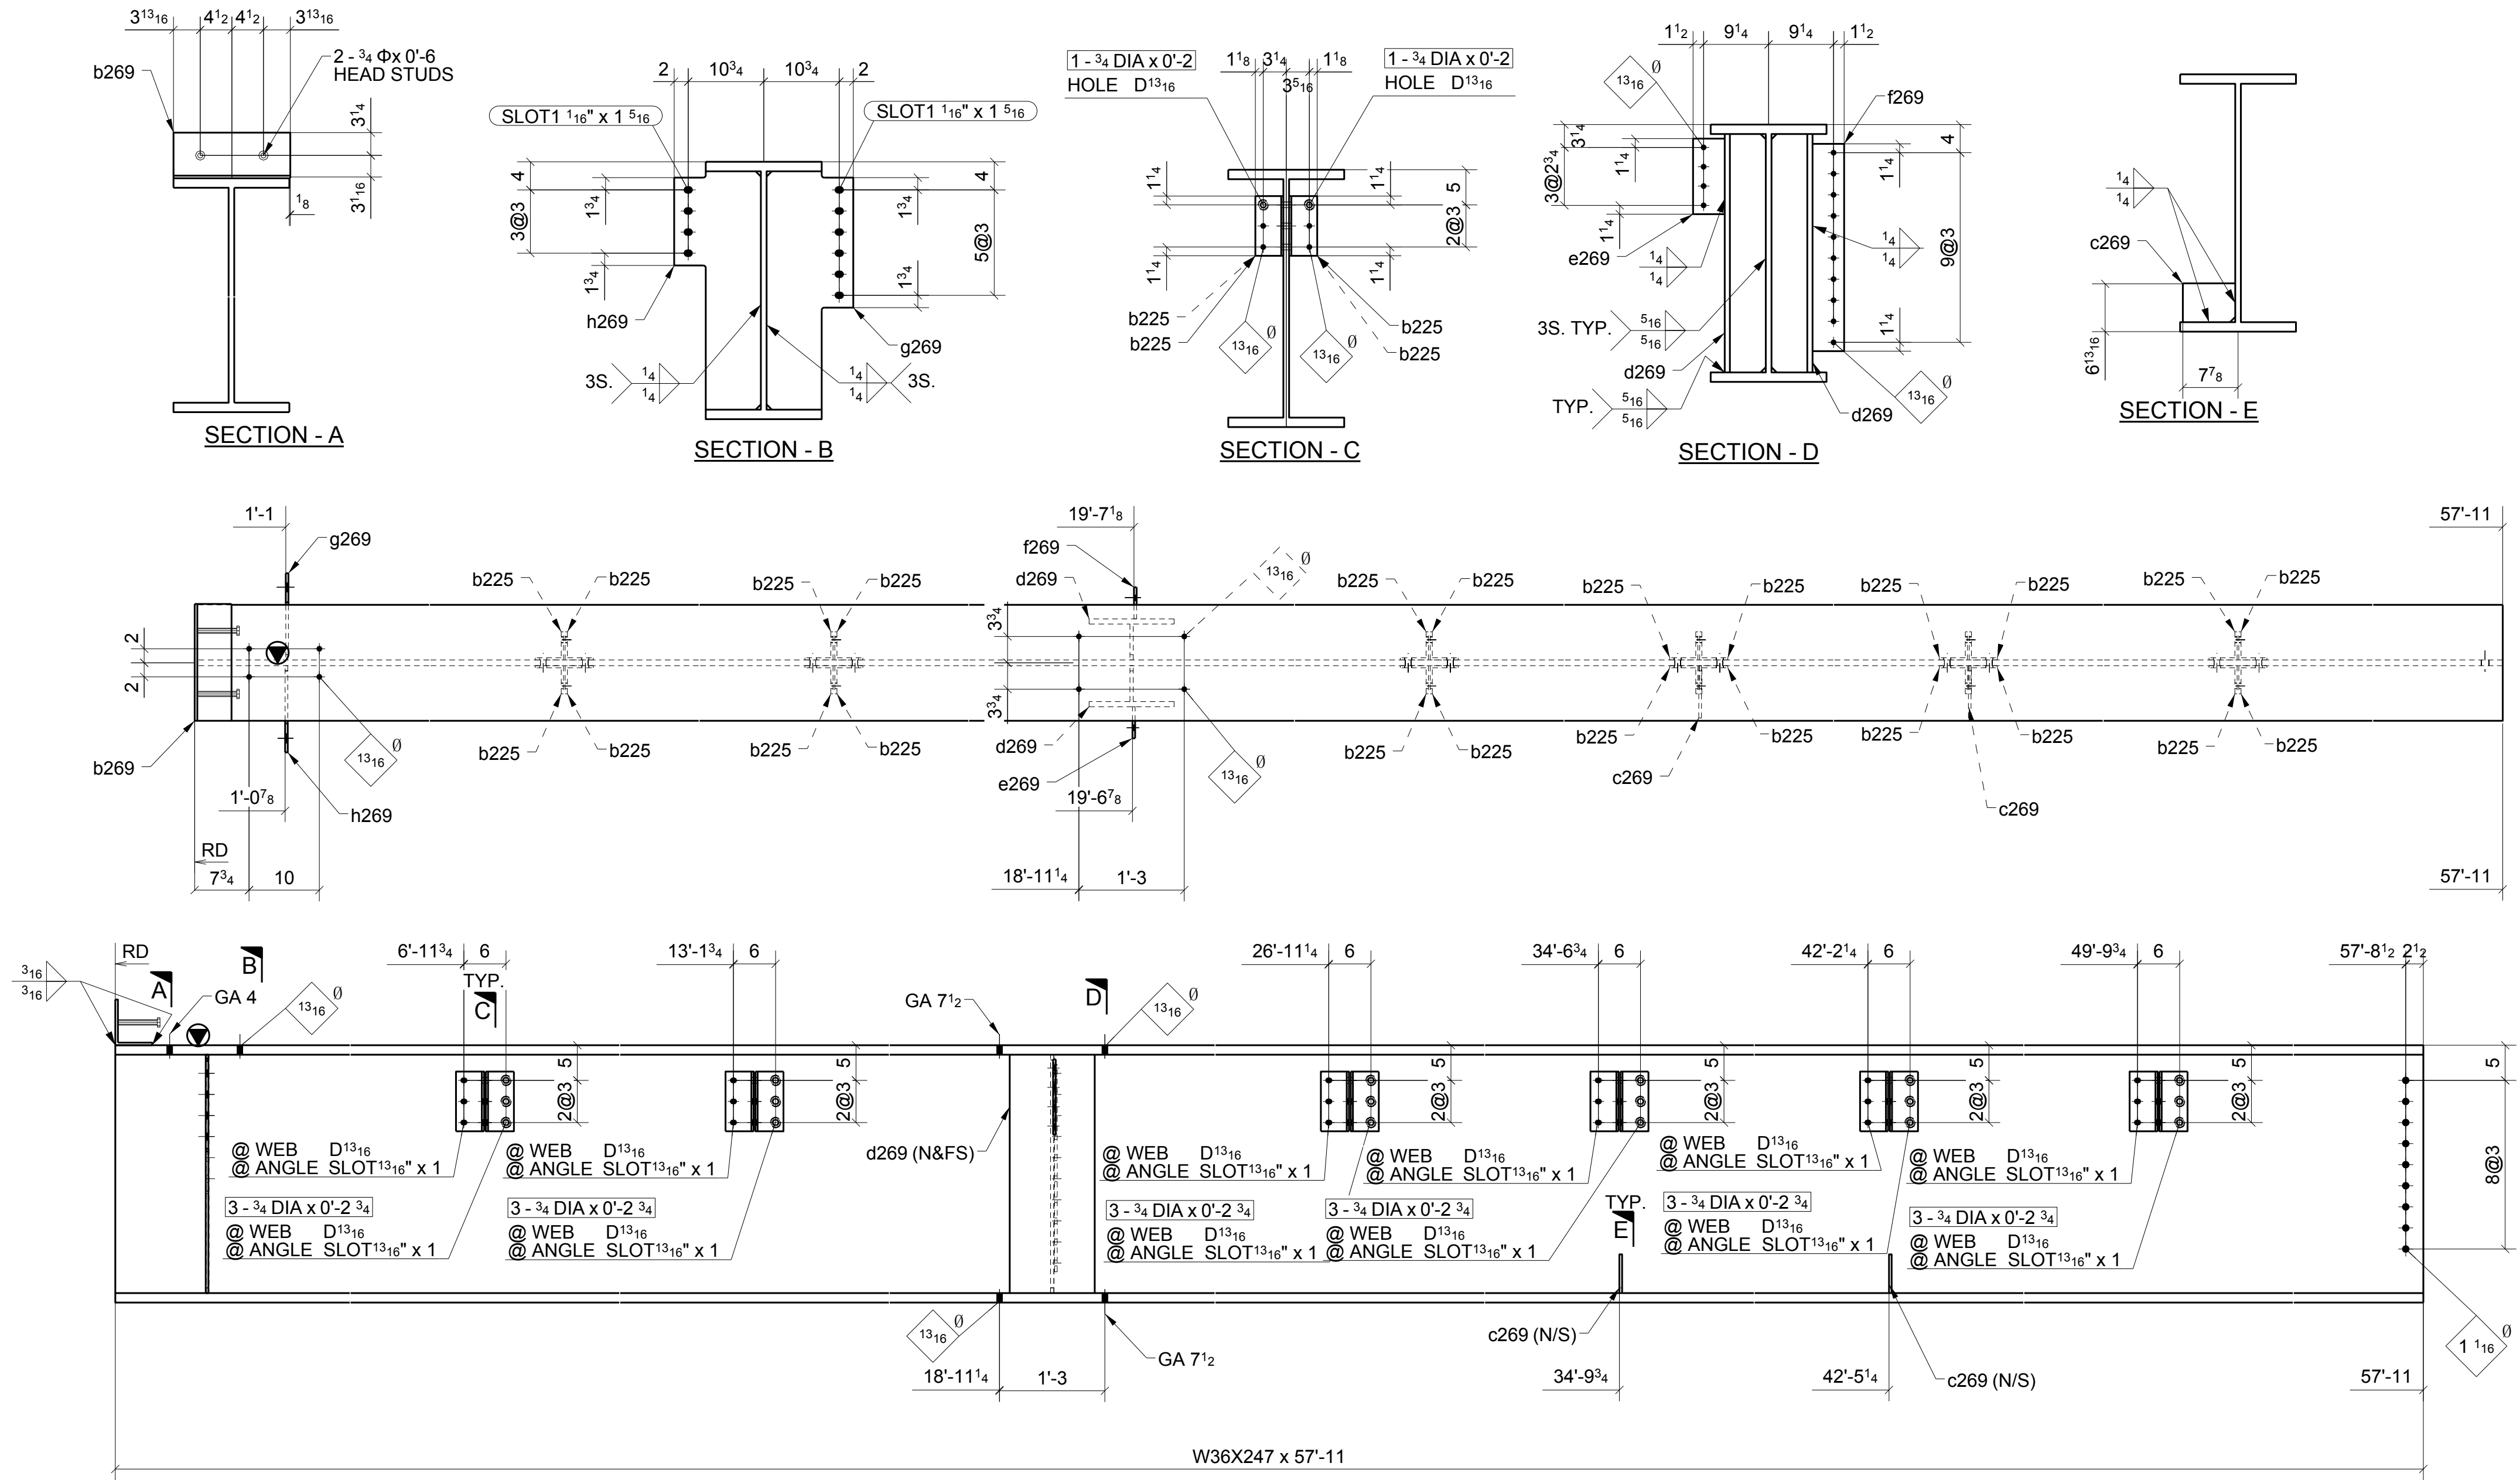

ONE - BEAM ~ 269A

LOCATION: ONE @ 1-2/B.3 (REF: E2B)

SHOP BOLT IN SLOTTED HOLE
NEED "HAND TIGHTEN"

MATERIAL LIST


QTY	MARK	DESCRIPTION	LENGTH	MATERIAL	NOTES
1	269A	W36X247	57'-11"	A992	
24	b225	L4X4X5/16	0'-8 1/2"	A36	
1	b269	BPL3/8"X11 3/4"	1'-4 5/8"	A36	
2	c269	PL3/8"X5 1/2"	0'-7 7/16"	A36	
2	d269	WT6X39.5	2'-9 15/16"	A992	
1	e269	PL3/8"X4 1/2"	0'-10 3/4"	A36	
1	f269	PL3/8"X4 1/2"	2'-5 1/2"	A36	
1	g269	PL3/8"X12 3/8"	2'-9 15/16"	A36	
1	h269	PL3/8"X12 3/8"	2'-9 15/16"	A36	
12		3/4" DIA. W/N&W	0'-2"	A325N TC	
18		3/4" DIA. W/N&W	0'-2 3/4"	A325N TC	
2		3/4" STUD	0'-6"		

Romac By: _____ Checked By: _____
Beamline By: _____ Checked By: _____

ATLAS IRON WORKS
ST. LOUIS, MO.

Project: WEBSTER UNIVERSITY INTERDISCIPLINARY SCIENCE BUILDING
Customer: PARIC CORPORATION
Owner: WEBSTER UNIVERSITY
Location: WEBSTER GUVES, MO 63119
Dwn: ZZ Date: 05/30/2016 Ckd: L.J. Date: 05/30/2016
Job No. A16013 BAT: _____ DWG#: 269

FOR APPROVAL				06/30/16
Sequence:	2	Ref. E-Plans:	-	
Material:	A992 U.N.O.	Edge Dist.:	1 1/2" U.N.O.	
Holes:	13/16"DIA.	Bolts:	NOTED	
Cleaning:	NONE			
Paint:	NO			
DFT:		COLOR:		

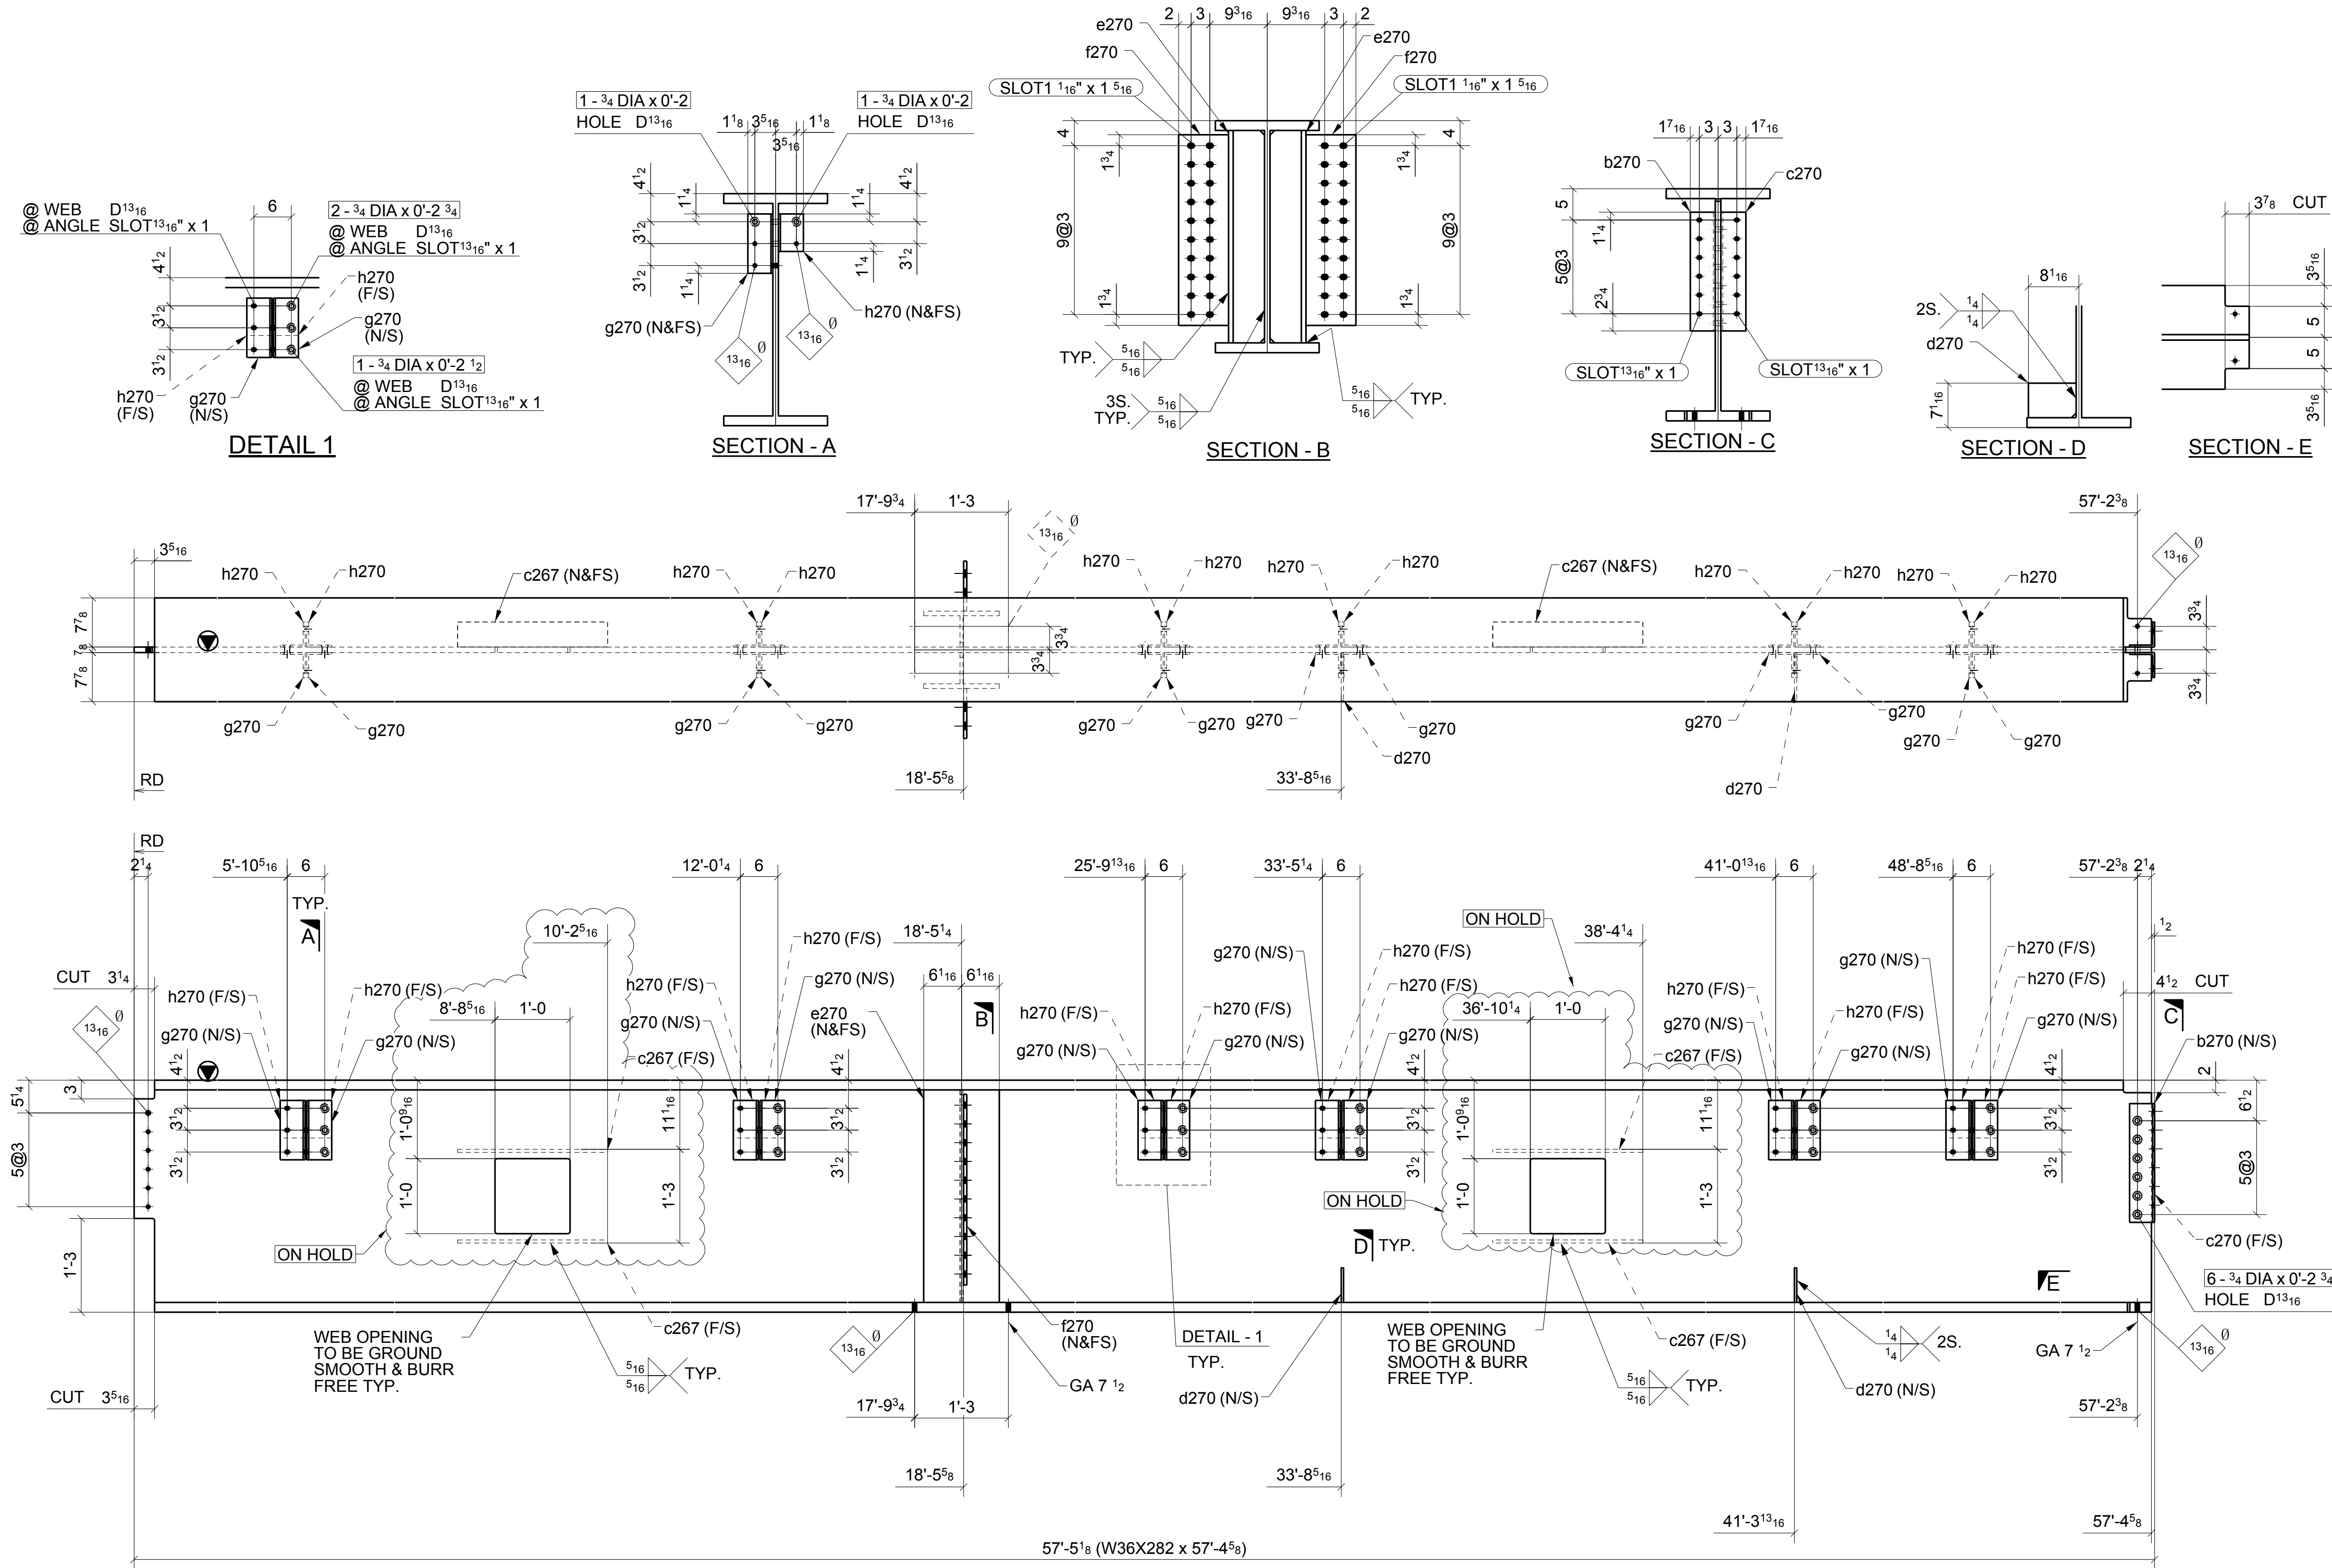

ONE - BEAM ~ 270A
LOCATION: ONE @ 1-2/C (REF: E2B)

SHOP BOLT IN SLOTTED HOLE
NEED "HAND TIGHTEN"

MATERIAL LIST

QTY	MARK	DESCRIPTION	LENGTH	MATERIAL	NOTES
1	270A	W36X282	57'-4 5/8"	A992	
1	b270	L4X4X5/16	1'-7"	A36	
4	c267	PL 1/2"X4"	2'-0"	A36	
1	c270	L4X4X5/16	1'-7"	A36	
2	d270	PL 3/8"X5 1/2"	0'-7 5/8"	A36	
2	e270	WT6X39.5	2'-10"	A992	
2	f270	PL 1/2"X8"	2'-6 1/2"	A572-GR.50	
12	g270	L4X4X5/16	0'-9 1/2"	A36	
12	h270	L4X4X5/16	0'-6"	A36	
6		3/4" DIA. W/N&W	0'-2 3/4"	A325N TC	
6		3/4" DIA. W/N&W	0'-2 1/2"	A325N TC	
12		3/4" DIA. W/N&W	0'-2"	A325N TC	
12		3/4" DIA. W/N&W	0'-2 3/4"	A325N TC	

Romac By: _____ Checked By: _____
Beamline By: _____ Checked By: _____



ATLAS IRON WORKS
ST. LOUIS, MO.

Project: WEBSTER UNIVERSITY INTERDISCIPLINARY SCIENCE BUILDING
Customer: PARIC CORPORATION
Owner: WEBSTER UNIVERSITY
Location: WEBSTER GUVES.MO 63119
Dwn: ZZ Date: 05/30/2016 Ckd: L.J. Date: 05/30/2016
Job No. A16013 BAT: _____ DWG# 270

FOR APPROVAL	05/30/16
Sequence: 2	Ref. E-Plans: -
Material: A992 U.N.O.	Edge Dist.: 1 1/2" U.N.O.
Holes: 13/16"DIA.	Bolts: NOTED
Cleaning: NONE	
Paint: NO	
DFT: _____	COLOR: _____

MATERIAL LIST

QTY	MARK	DESCRIPTION	LENGTH	MATERIAL	NOTES
1	272A	W36X487	54'-2 7/8"	A992	
2	b272	PL3/8"X5 7/16"	0'-8 3/16"	A36	
2	c267	PL1/2"X4"	2'-0"	A36	
2	c272	WT7X45	2'-8 1/4"	A992	
2	d272	PL3/8"X4 3/8"	0'-9"	A36	
5	e272	PL3/8"X4 5/16"	1'-0"	A36	
3	f272	PL3/8"X4 1/8"	1'-0"	A36	
1	g272	PL1 3/4"X14 1/2"	2'-7 3/16"	A36	
2	h272	PL1/2"X5"	2'-6 1/2"	A572-GR.50	

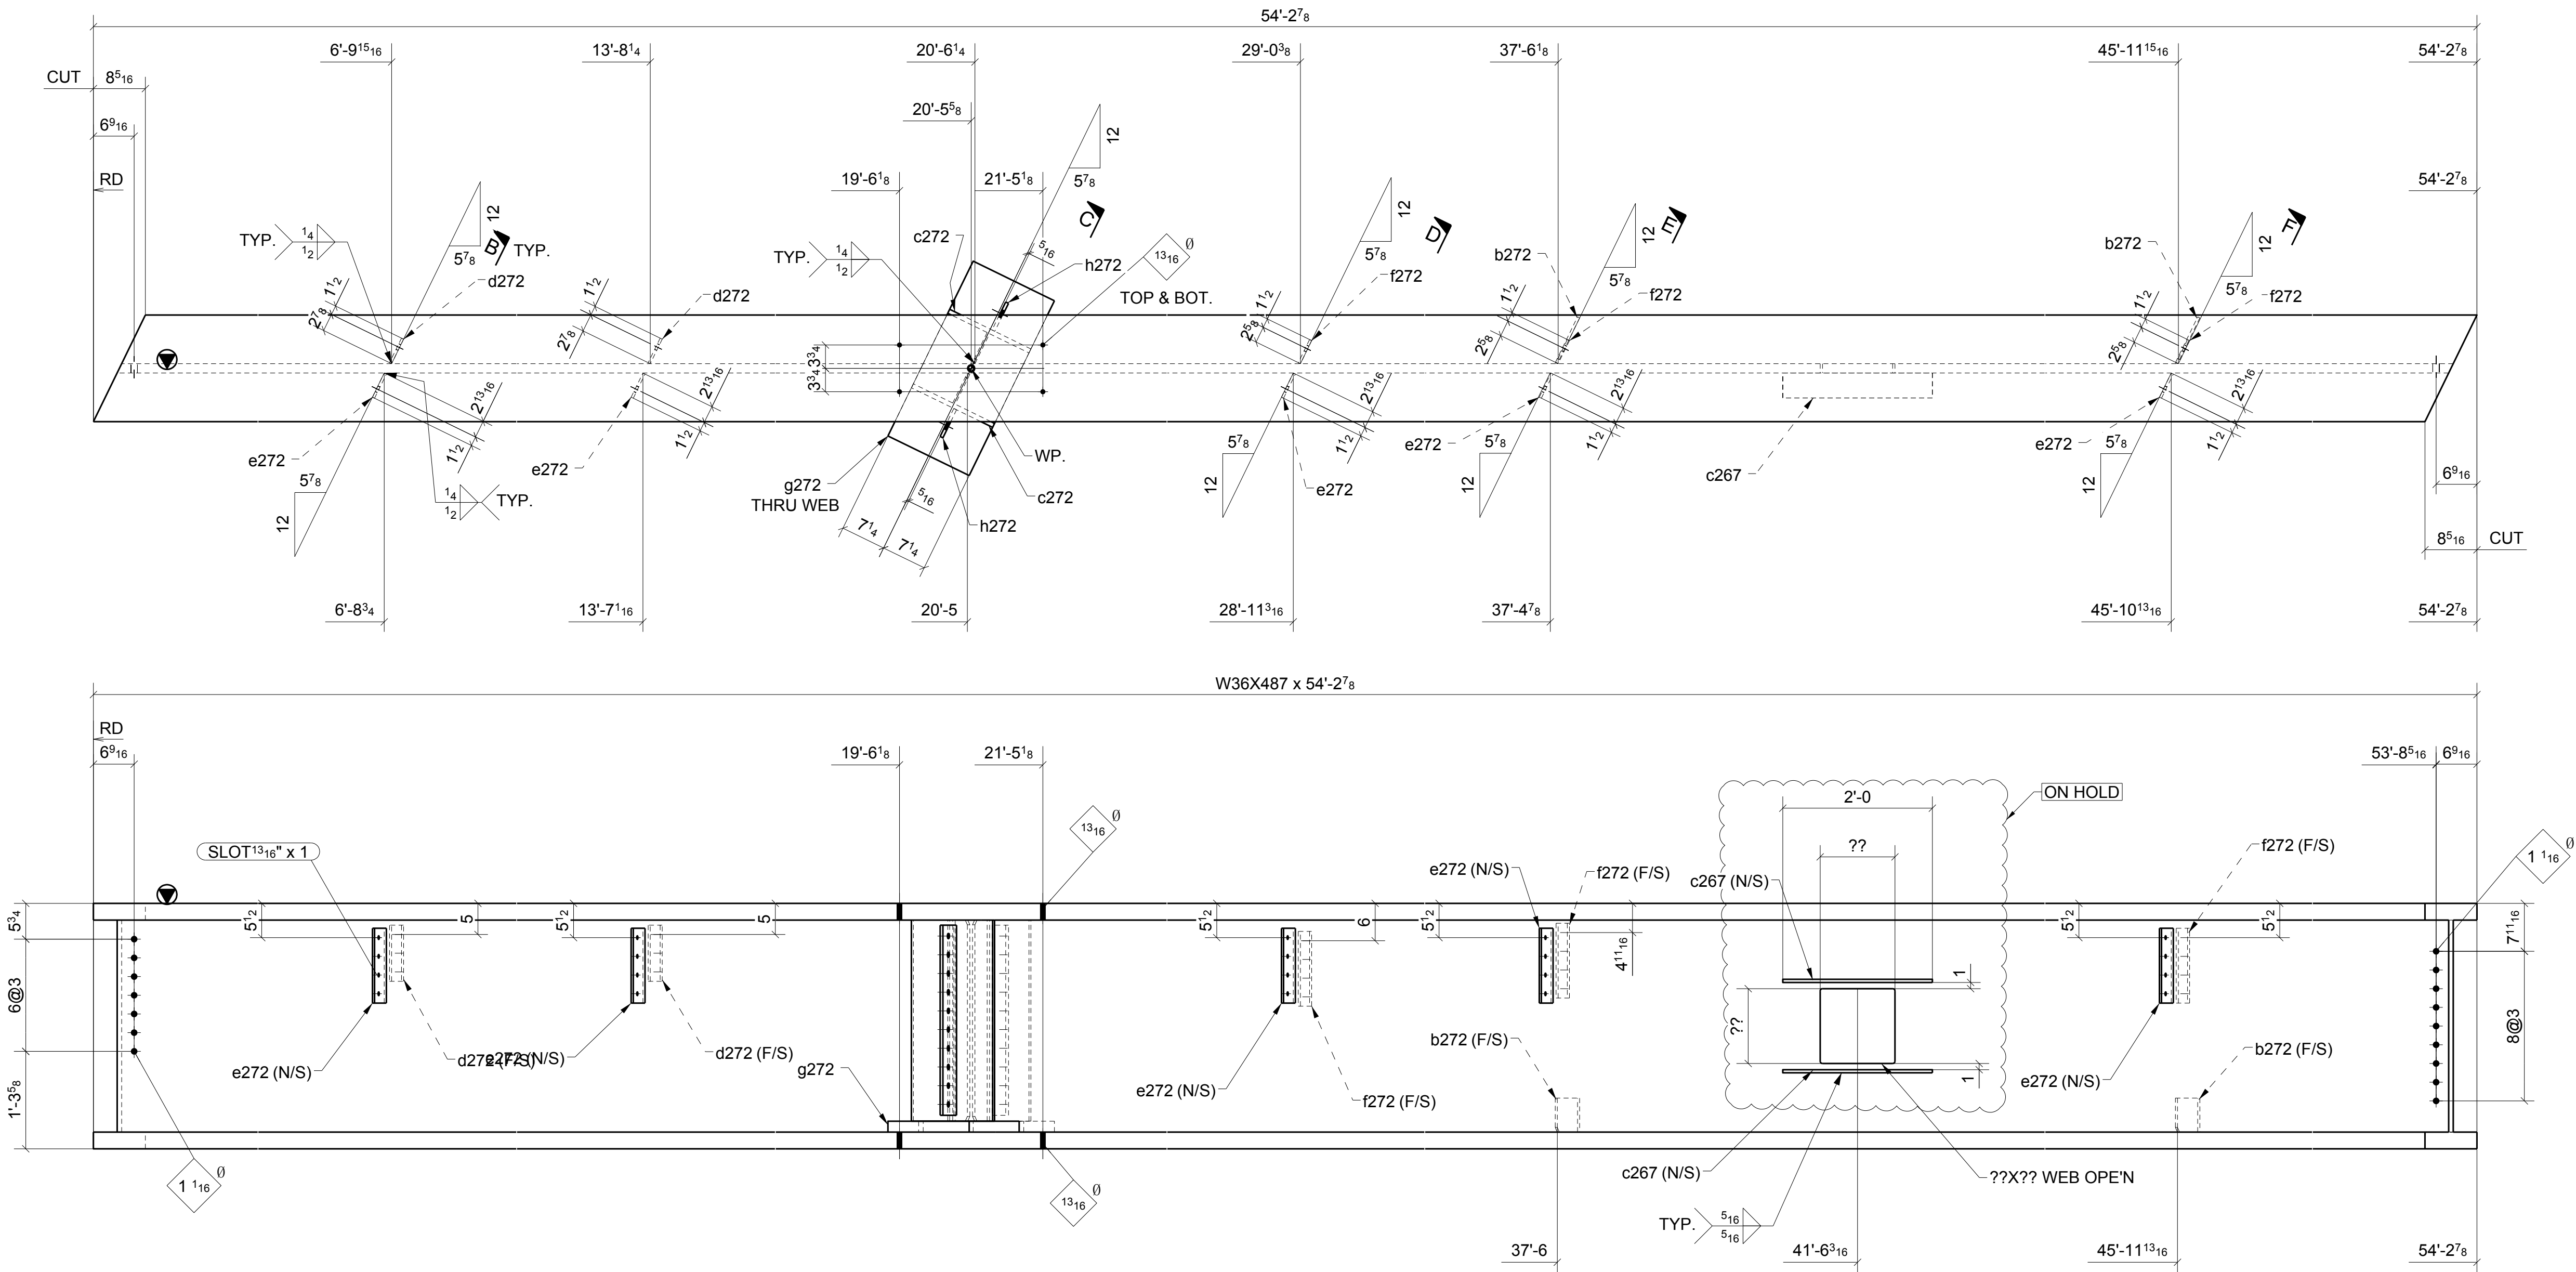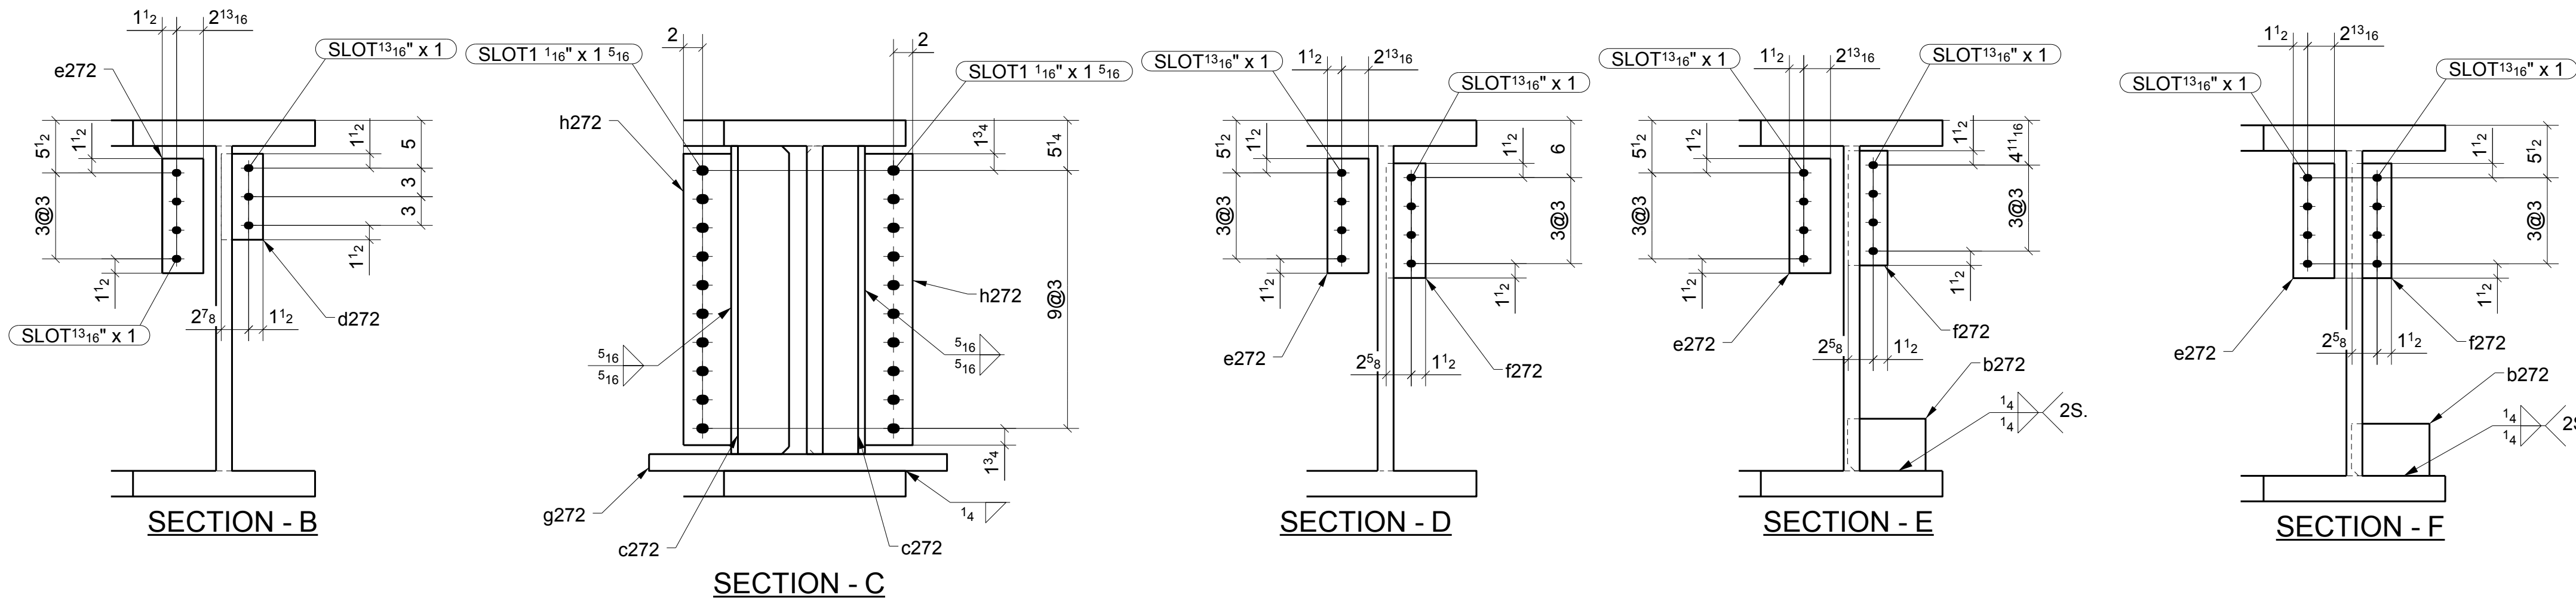

ONE - BEAM ~ 272A
LOCATION: ONE @ 1-1.9/4-A.5 (REF: E2B)

SHOP BOLT IN SLOTTED HOLE
NEED "HAND TIGHTEN"

A	FOR APPROVAL	06/30/16
Sequence:	2	Ref. E-Plans: -
Material:	A992 U.N.O.	Edge Dist.: 1 1/2" U.N.O.
Holes:	13/16"DIA.	Bolts: NOTED
Cleaning:	NONE	
Paint:	NO	
DPT:		COLOR:

Romac By:	Checked By:
Beamline By:	Checked By:
ATLAS IRON WORKS ST. LOUIS, MO.	
Project:	WEBSTER UNIVERSITY INTERDISCIPLINARY SCIENCE BUILDING
Customer:	PARIC CORPORATION
Owner:	WEBSTER UNIVERSITY
Location:	WEBSTER GUVES, MO 63119
Dwn:	ZZ Date: 05/30/2016 Ckd: L.J. Date: 05/30/2016
Job No.	A16013 BAT: DWG#: 272

Romac By: _____	Checked By: _____
Beamline By: _____	Checked By: _____
ATLAS IRON WORKS ST. LOUIS, MO.	
Project: _____	WEBSTER UNIVERSITY INTERDISCIPLINARY SCIENCE BUILDING
Customer: _____	PARIC CORPORATION
Owner: _____	WEBSTER UNIVERSITY
Location: _____	WEBSTER GUOVES, MO 63119
Dwn: ZZ	Date: 05/30/2016
Ckd: LJ	Date: 05/30/2016
Job No. A16013	BAT: _____ DWG#: 273


[illegible]

Romac By: _____ Checked By: _____


Beamline By: _____ Checked By: _____

ATLAS IRON WORKS
ST. LOUIS, MO.

Project: WEBSTER UNIVERSITY INTERDISCIPLINARY SCIENCE BUILDING
Customer: PARIC CORPORATION
Owner: WEBSTER UNIVERSITY
Location: WEBSTER GUOVES.MO 63119
Dwn: ZZ Date: 05/30/2016 Ckd: L.J Date: 05/30/2016
Job No. A16013 BAT: DWG#: 274

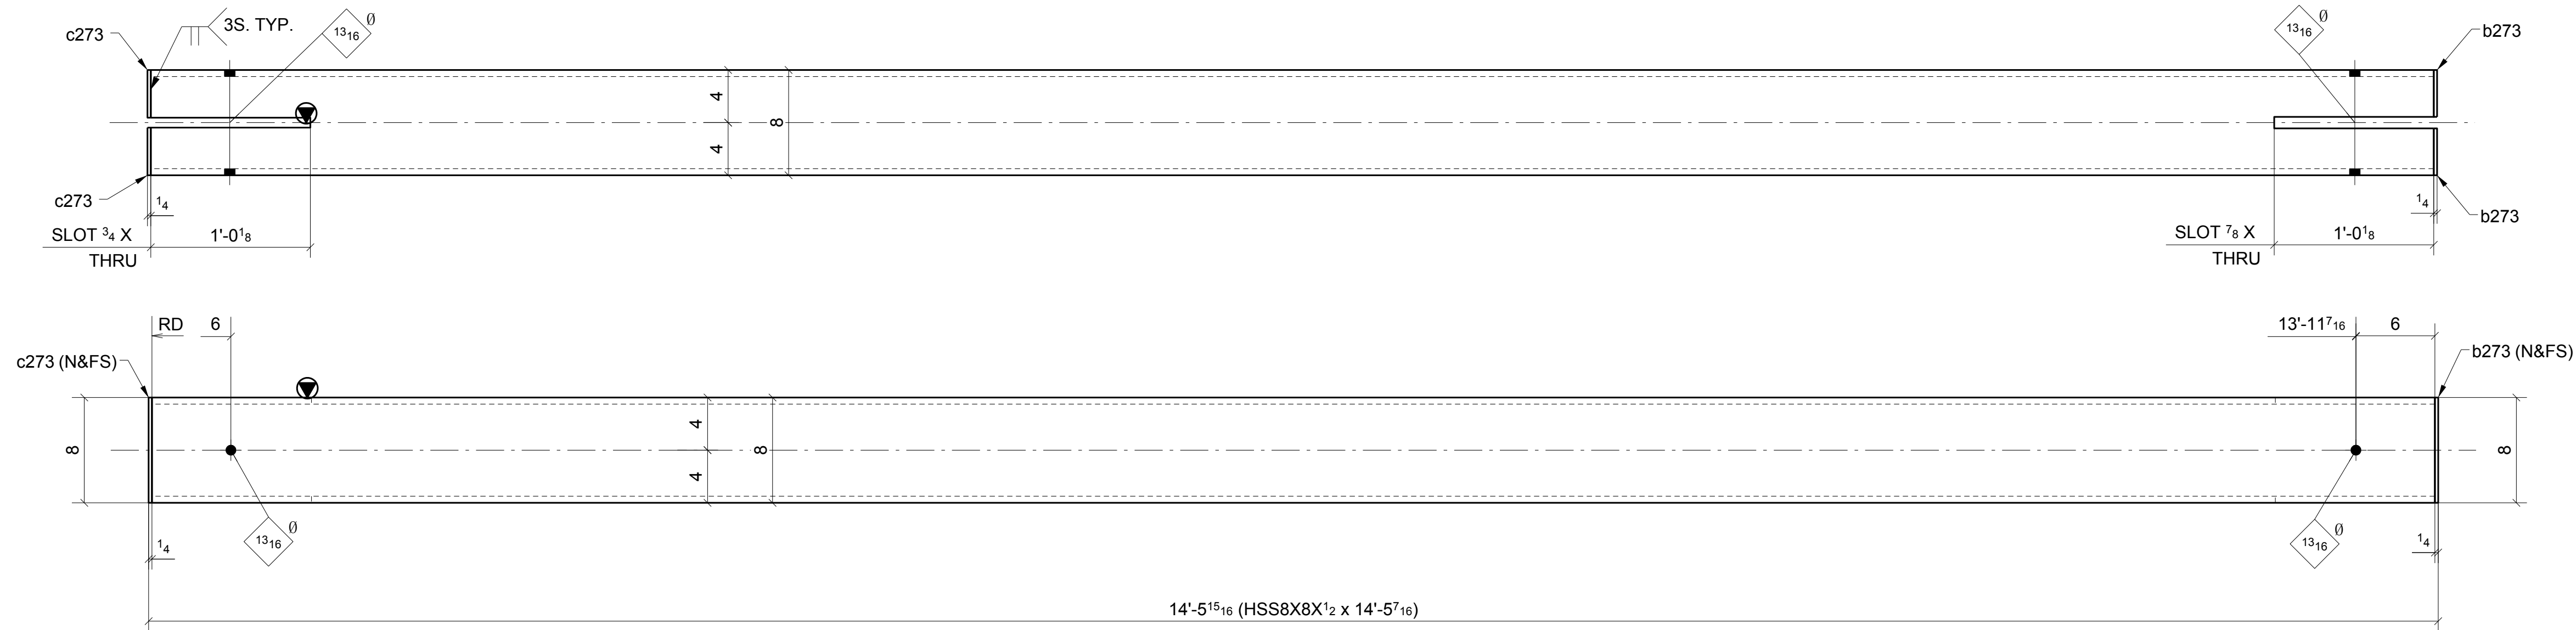

ONE - VERTICAL BRACE ~ 274A
(REF: E2D)

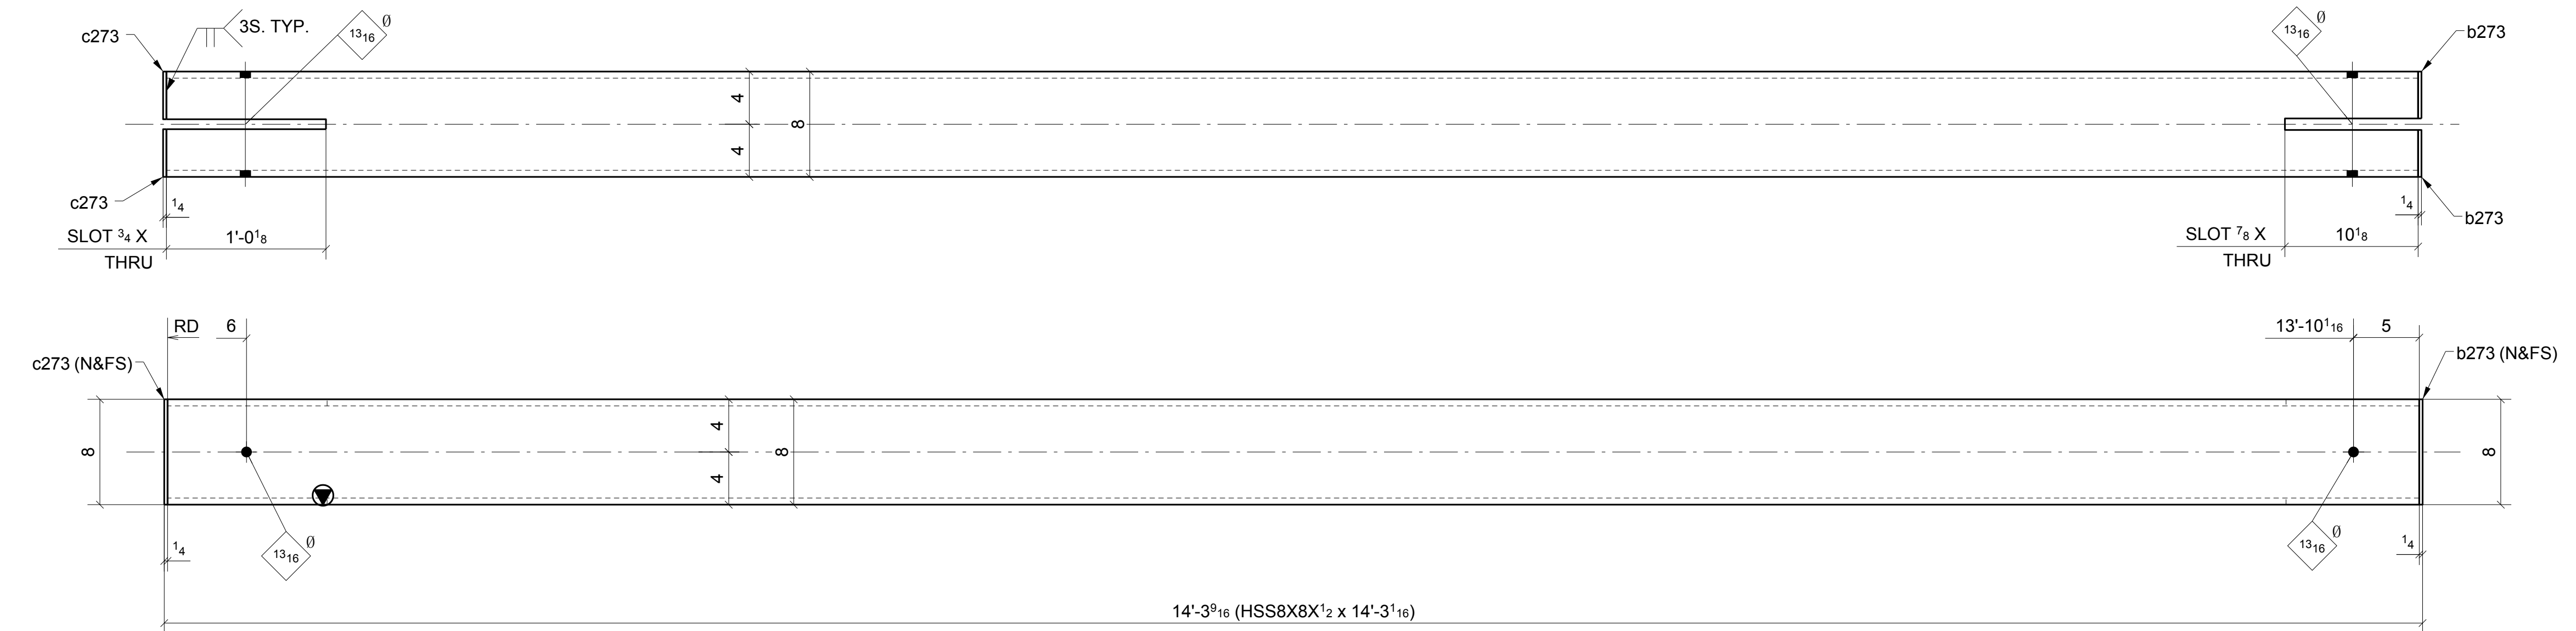

ONE - VERTICAL BRACE ~ 274B

	FOR APPROVAL	05/30/16
Sequence: <u>2</u>	Ref. E-Plans: <u> </u>	
Material: <u>A992</u> U.O.	Edge Dist.: <u>1 1/2"</u> U.O.	
Holes: <u>13/16" DIA.</u>	Bolts: <u>NOTED</u>	
Cleaning: <u>NONE</u>		
Paint: <u>NO</u>		
DFT: <u> </u> COLOR: <u> </u>		


[illegible]

Romac By: _____ Checked By: _____


Beamline By: _____ Checked By: _____

ATLAS IRON WORKS
ST. LOUIS, MO.

Project: WEBSTER UNIVERSITY INTERDISCIPLINARY SCIENCE BUILDING
Customer: PARIC CORPORATION
Owner: WEBSTER UNIVERSITY
Location: WEBSTER GUOVES.MO 63119
Dwn: ZZ Date: 05/30/2016 Ckd: L.J Date: 05/30/2016
Job No. A16013 BAT: DWG#: 275

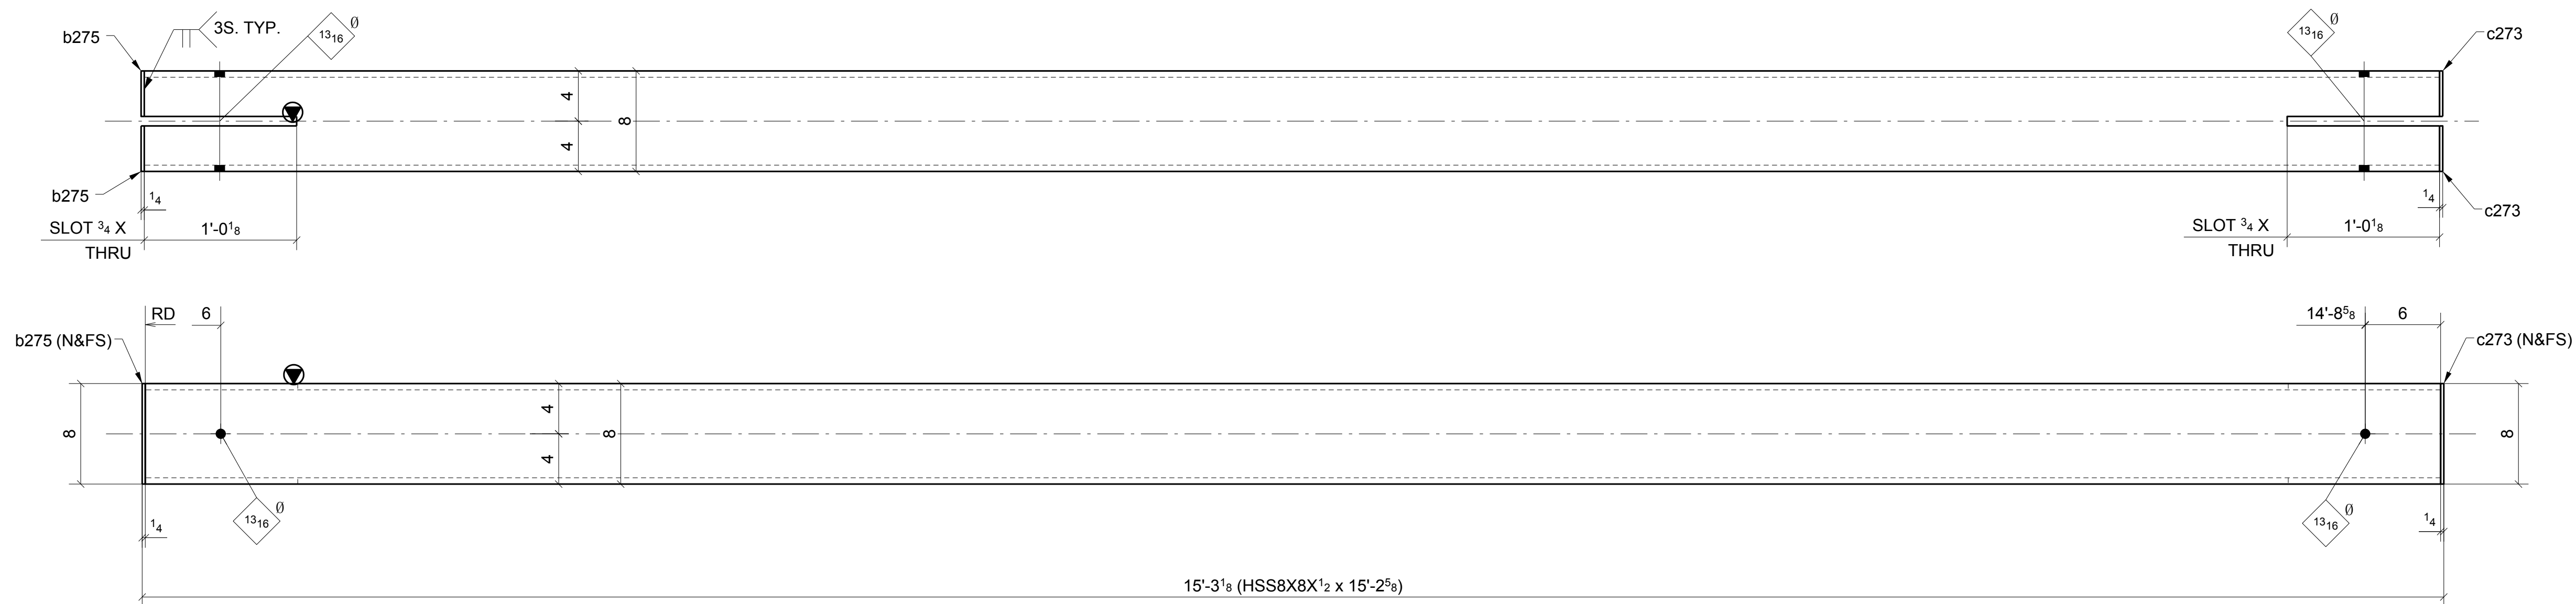


2 - VERTICAL BRACES ~ 275A

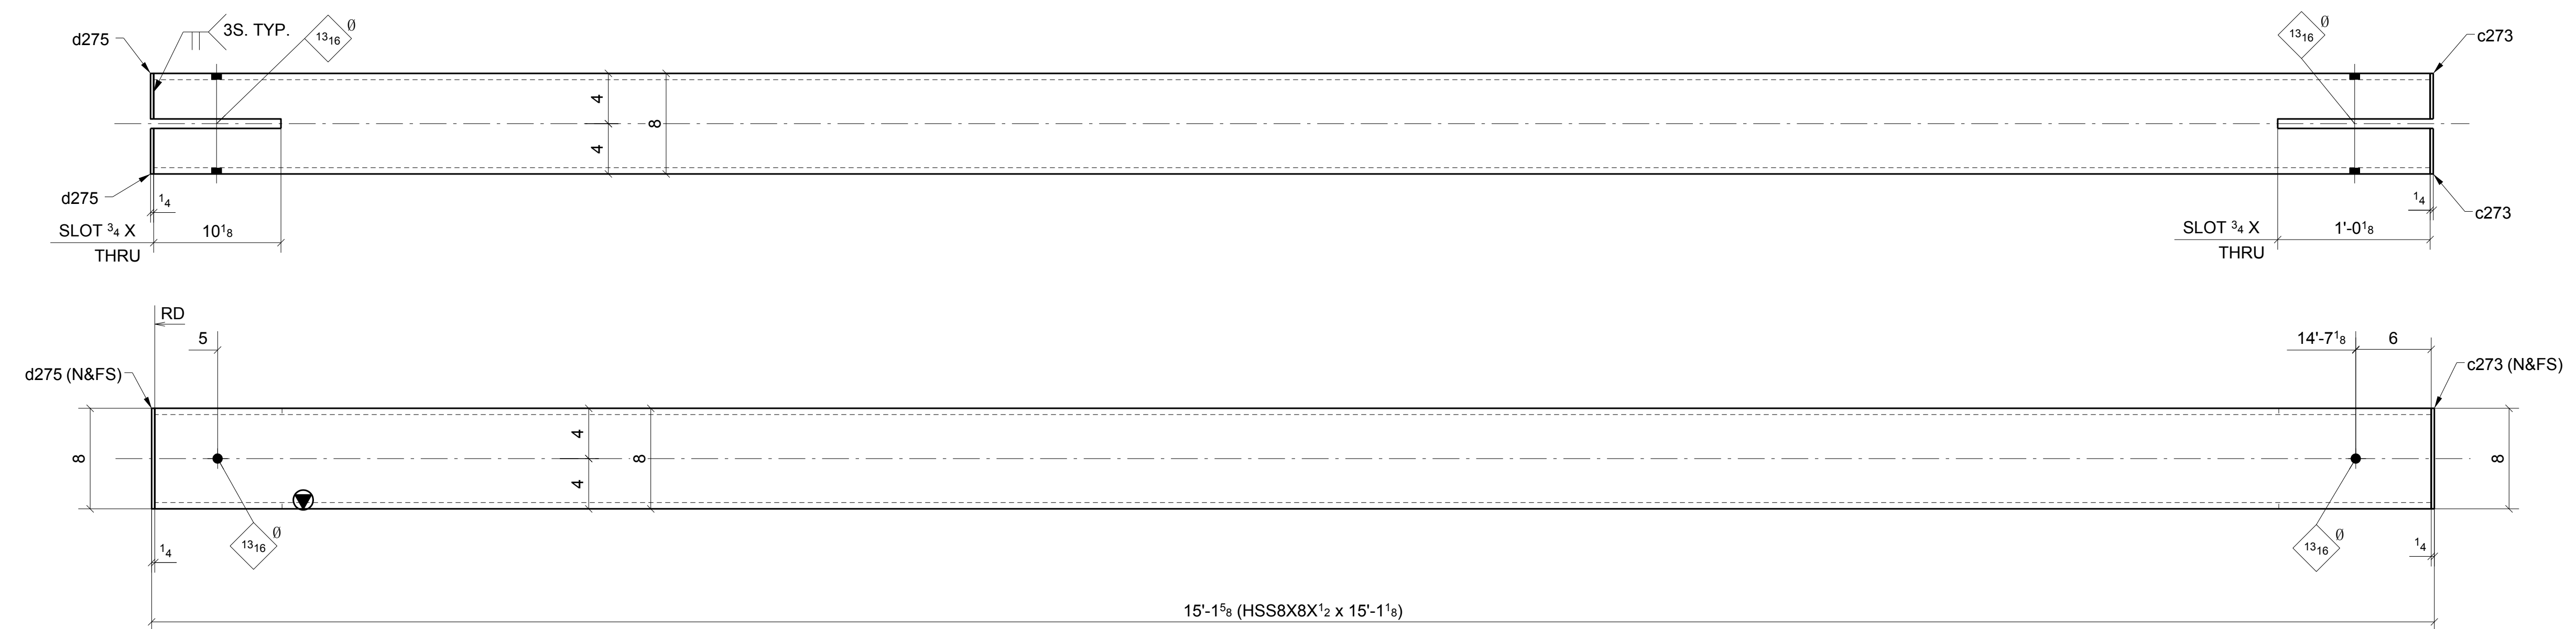

ONE - VERTICAL BRACE ~ 275B
(REF: E2D)


	FOR APPROVAL		05/30/16	
	Sequence: 2		Ref. E-Plans:	-
Material: A992	U.N.O.	Edge Dist.:	1 1/2"	U.N.O.
Holes: 13/16" DIA.		Bolts:	NOTED	
Cleaning:	NONE			
Paint:	NO			
DFT:		COLOR:		

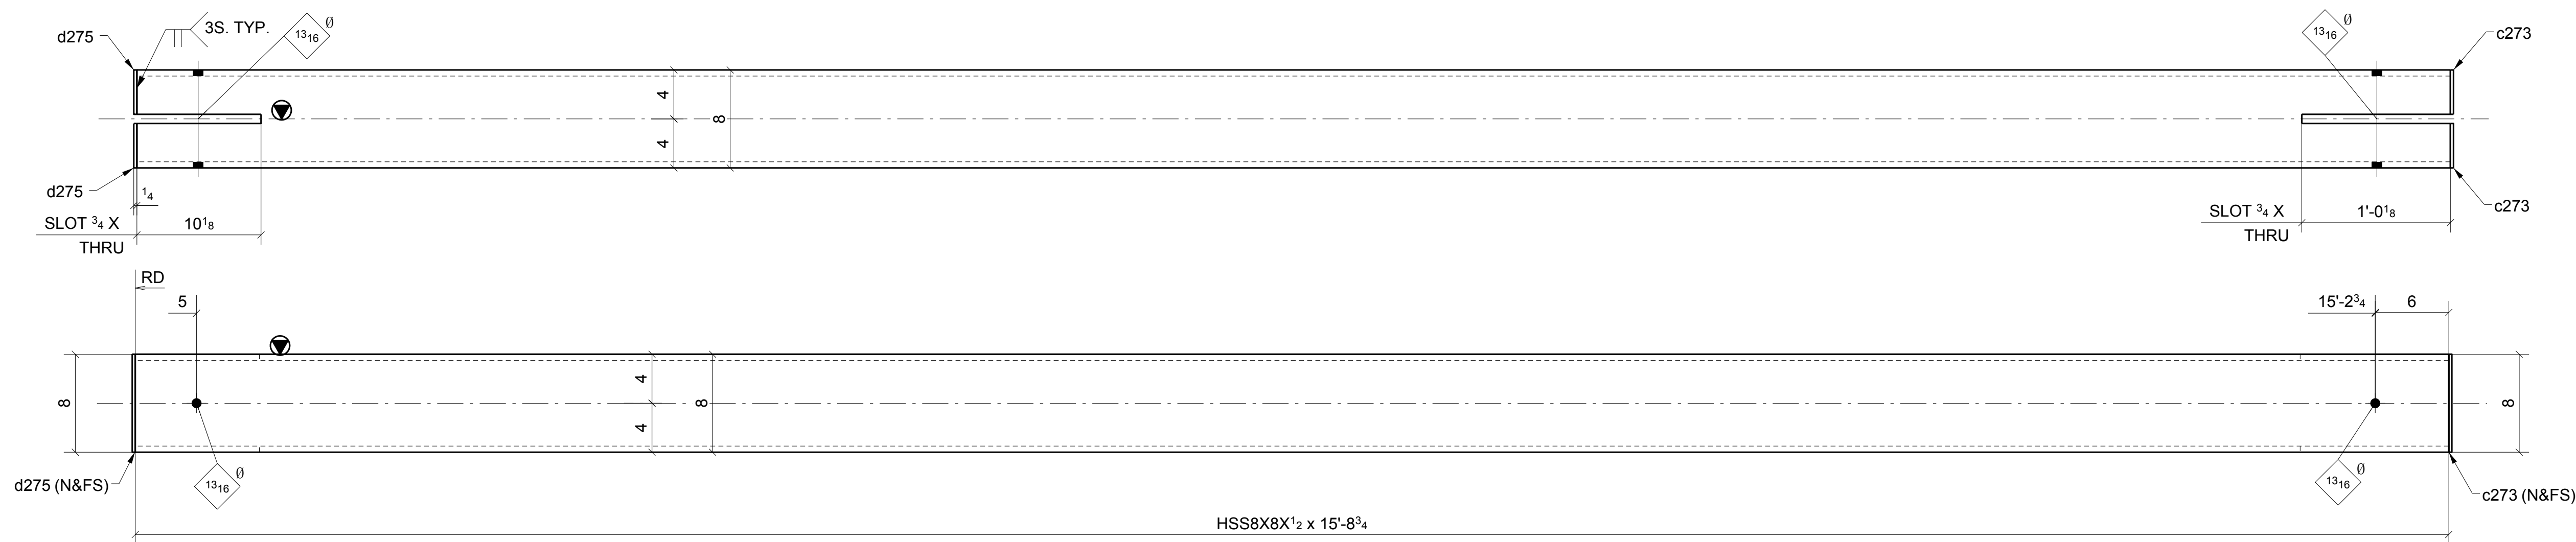[illegible]


ONE - VERTICAL BRACE ~ 276A
(REF: E2D)

	FOR APPROVAL	05/00/16
Sequence: <u>2</u>	Ref. E-Plans: <u>—</u>	
Material: <u>A992</u> U.N.O.	Edge Dist.: <u>1 1/2"</u> U.N.O.	
Holes: <u>13/16"DIA.</u>	Bolts: <u>NOTED</u>	
Cleaning: <u>NONE</u>		
Paint: <u>NO</u>		
DFT: _____	COLOR: _____	


Romac By: _____	Checked By: _____		
Beamline By: _____	Checked By: _____		
ATLAS IRON WORKS ST. LOUIS, MO.			
Project:	WEBSTER UNIVERSITY INTERDISCIPLINARY SCIENCE BUILDING		
Customer:	PARIC CORPORATION		
Owner:	WEBSTER UNIVERSITY		
Location:	WEBSTER GUOVES,MO 63119		
Dwn: ZZ	Date: 05/30/2016	Ckd: L.J	Date: 05/30/2016
Job No.	A16013	BAT:	DWG# 276

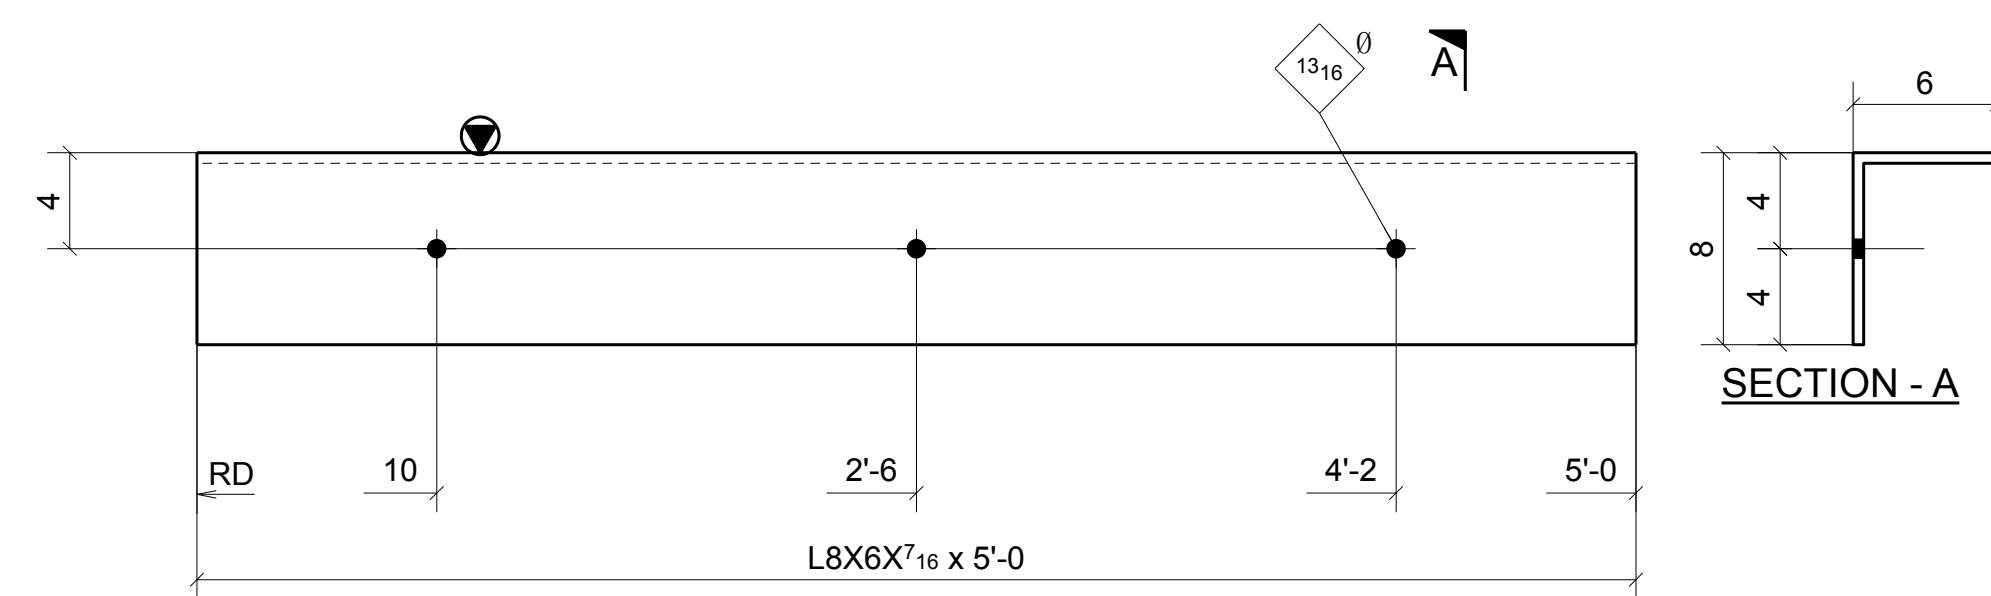


ONE - SUPPORT ANGLE ~ 281A
(REF: E2A)

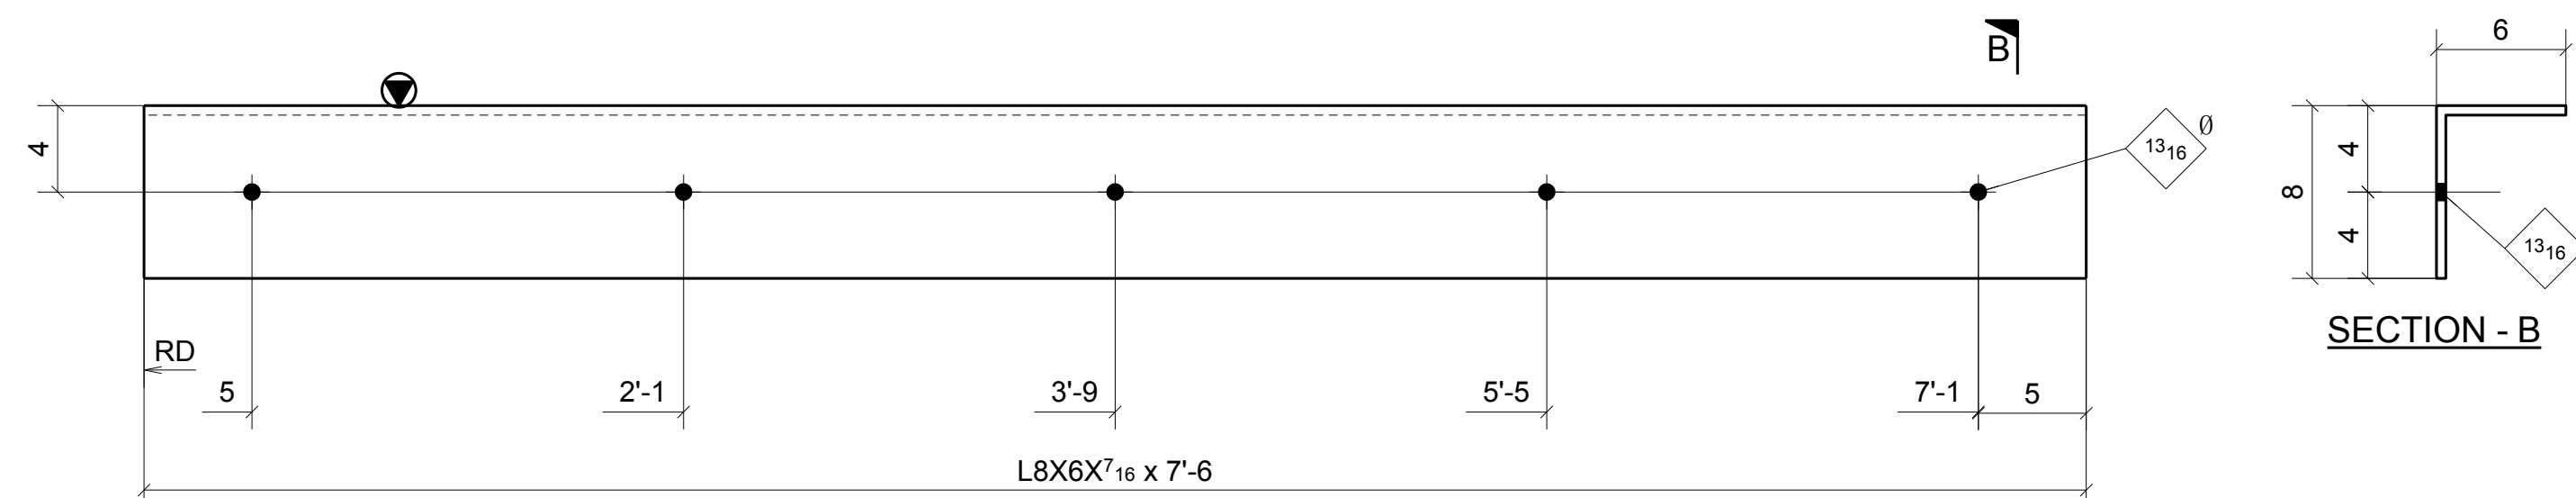


3 - SUPPORT ANGLES ~ 281B

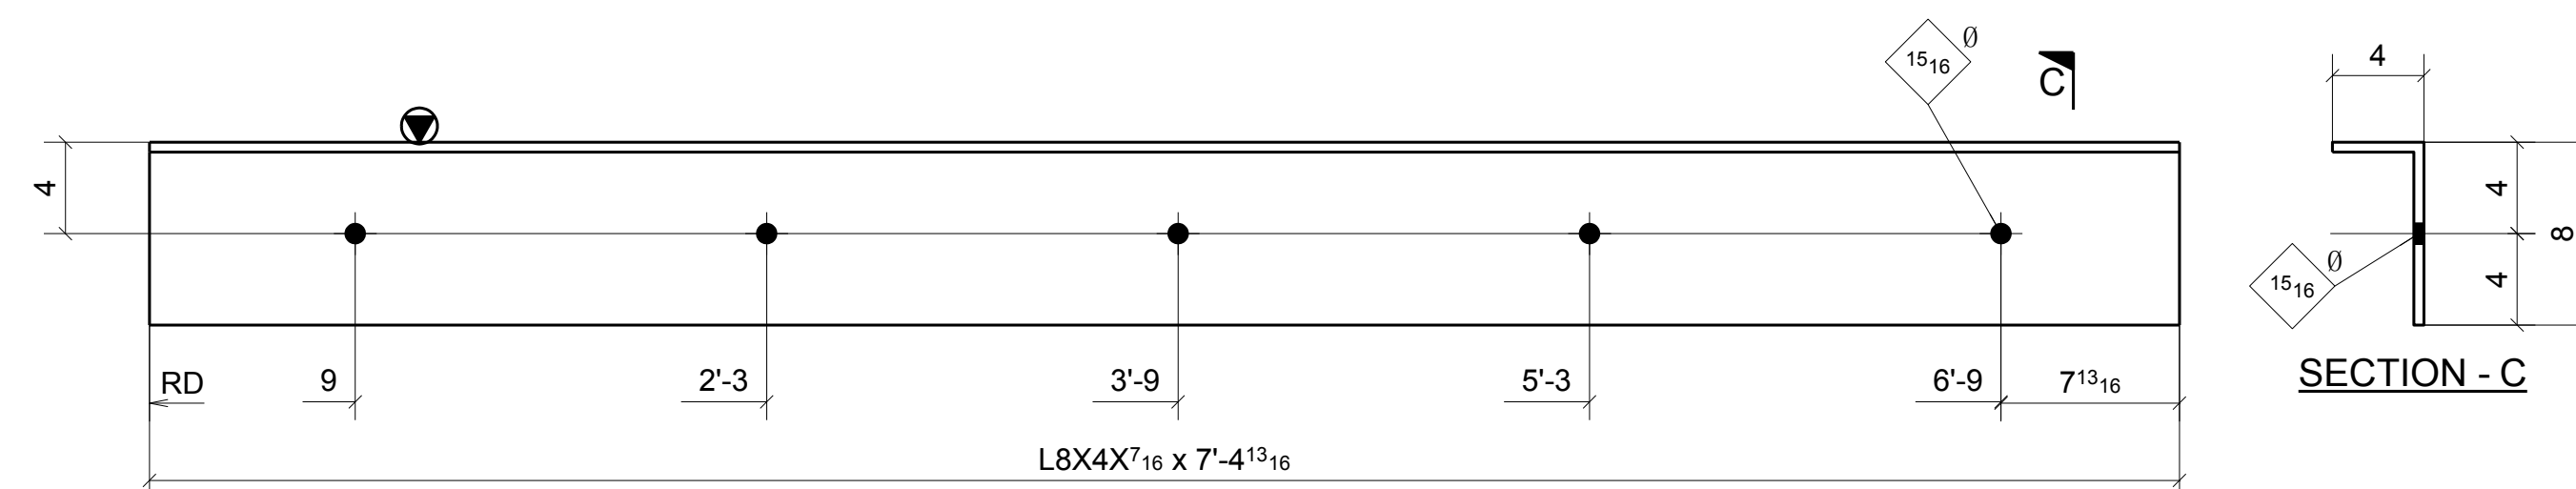

ONE - SUPPORT ANGLE ~ 281C
(REF: E2A)

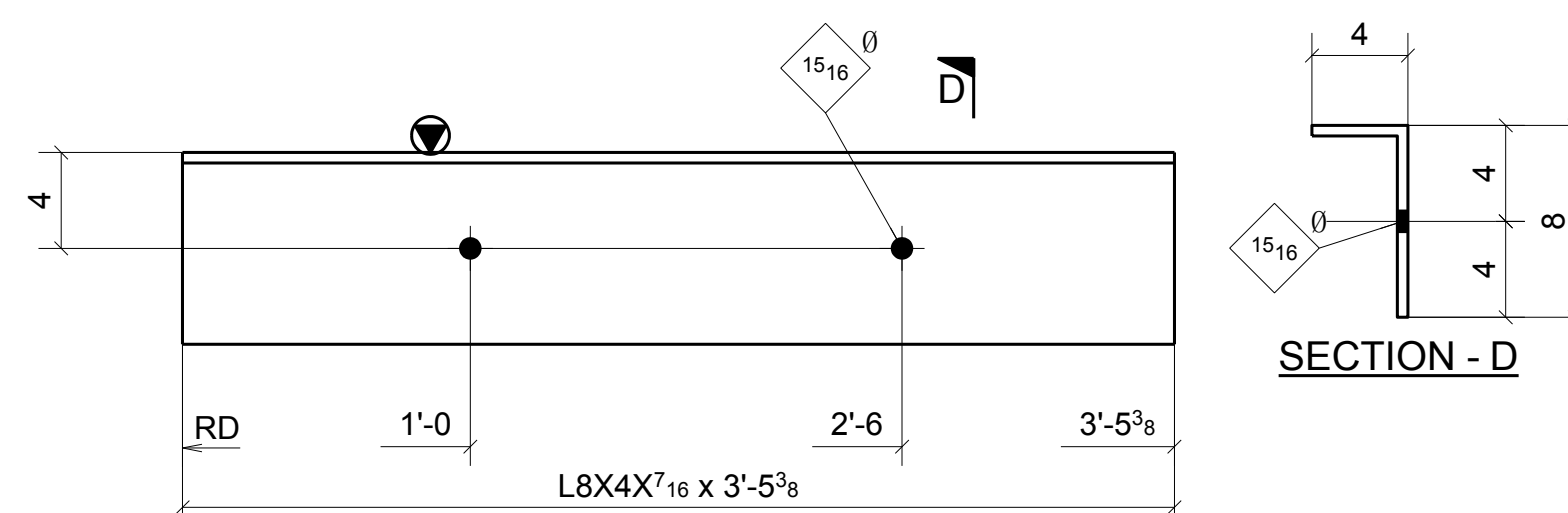

ONE - SUPPORT ANGLE ~ 281D

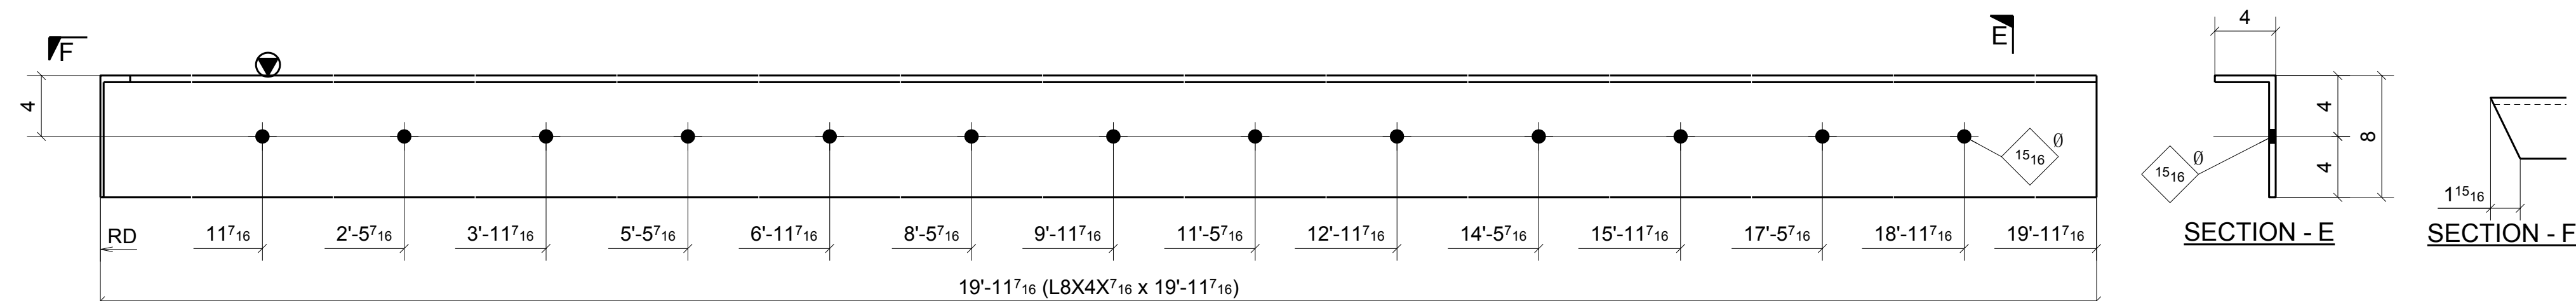

ONE - SUPPORT ANGLE ~ 281F

[illegible]

Romac By: _____	Checked By: _____
Beamline By: _____	Checked By: _____

ATLAS IRON WORKS

ATLAS IRON WORKS
ST. LOUIS, MO.

Project:	WEBSTER UNIVERSITY INTERDISCIPLINARY SCIENCE BUILDING
----------	---

Project:	
Customer:	PARIC CORPORATION

Customer:	
Owner:	WEBSTER UNIVERSITY

Location: WEBSTER GUOVES,MO 63119

Down: TLI Date: 05/30/2016 Ckd: LJ Date: 05/30/2016

Job No	A16013	DAT	DWELL	281
--------	--------	-----	-------	-----

JOB NO. AT6013 BAT: DWG#: 281

A		FOR APPROVAL		05/30/16	
Sequence:	2		Ref. E-Plans:	-	
Material:	A992 U.N.O.		Edge Dist.:	1 1/2" U.N.O.	
Holes:	13/16" DIA.		Bolts:	NOTED	
Cleaning:	NONE				
Paint:	NO				
DFT:	COLOR: _____				

Project:	WEBSTER UNIVERSITY INTERDISCIPLINARY SCIENCE BUILDING
----------	---

Project:	
Customer:	PARIC CORPORATION

Customer:	
Owner:	WEBSTER UNIVERSITY

Location: WEBSTER GUOVES,MO 63119

Down: TLI Date: 05/30/2016 Ckd: LJ Date: 05/30/2016






SWH:	DATE:	ORD:	DATE:
Job No	A16013	PAT	SWH: 281

JOB NO. AT6013 BAT: DWG#: 281







Romic By: _____ Checked By: _____
 Beamline By: _____ Checked By: _____
ATLAS IRON WORKS
ST. LOUIS, MO.
 Project: _____ WEBSTER UNIVERSITY INTERDISCIPLINARY SCIENCE BUILDING
 Customer: _____ PARIC CORPORATION
 Owner: _____ WEBSTER UNIVERSITY
 Location: _____ WEBSTER GUOVES.MO 63119
 Date: _____
 Dm: TLI Date: 05/30/2016 Ckd: LJ Date: 05/30/2016
Job No. A16013 **BAT.** _____ **DWG#** 282

	FOR APPROVAL	05/30/16
Sequence: <u>2</u>	Ref. E-Plans: <u> </u>	
Material: <u>A992</u> U.N.O.	Edge Dist.: <u>1 1/2"</u> U.N.O.	
Holes: <u>13/16" DIA.</u>	Bolts: <u>NOTED</u>	
Cleaning: <u>NONE</u>		
Paint: <u>NO</u>		
DFT: <u> </u> COLOR: <u> </u>		

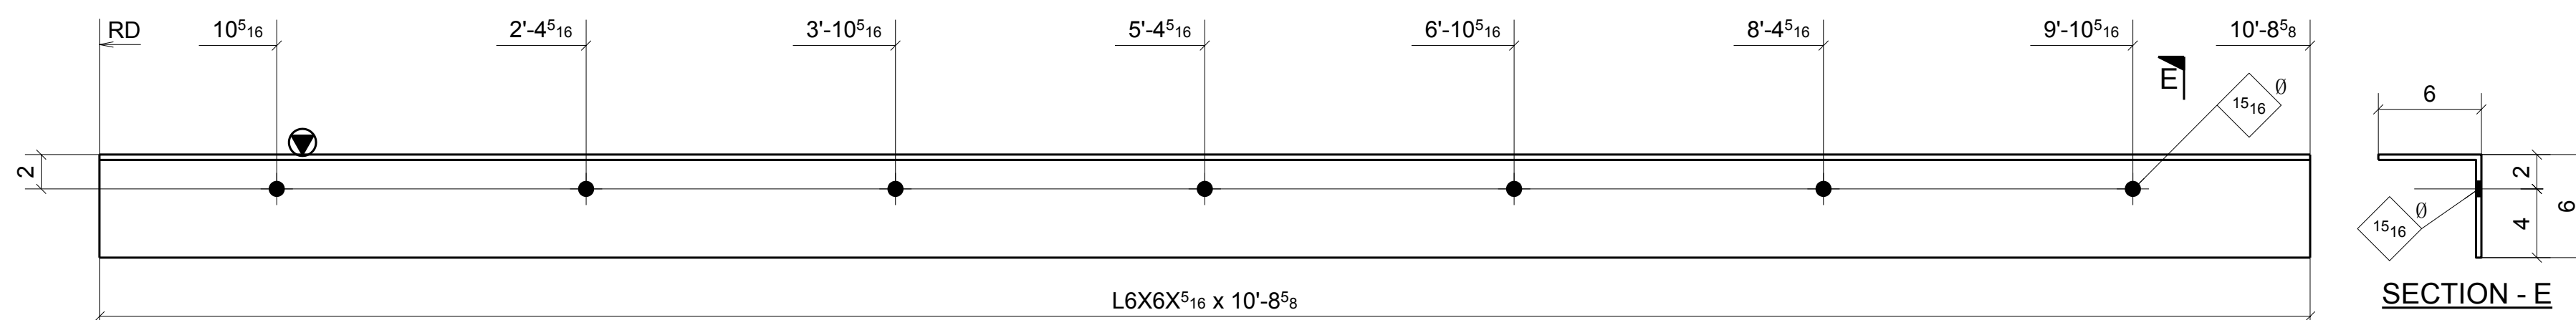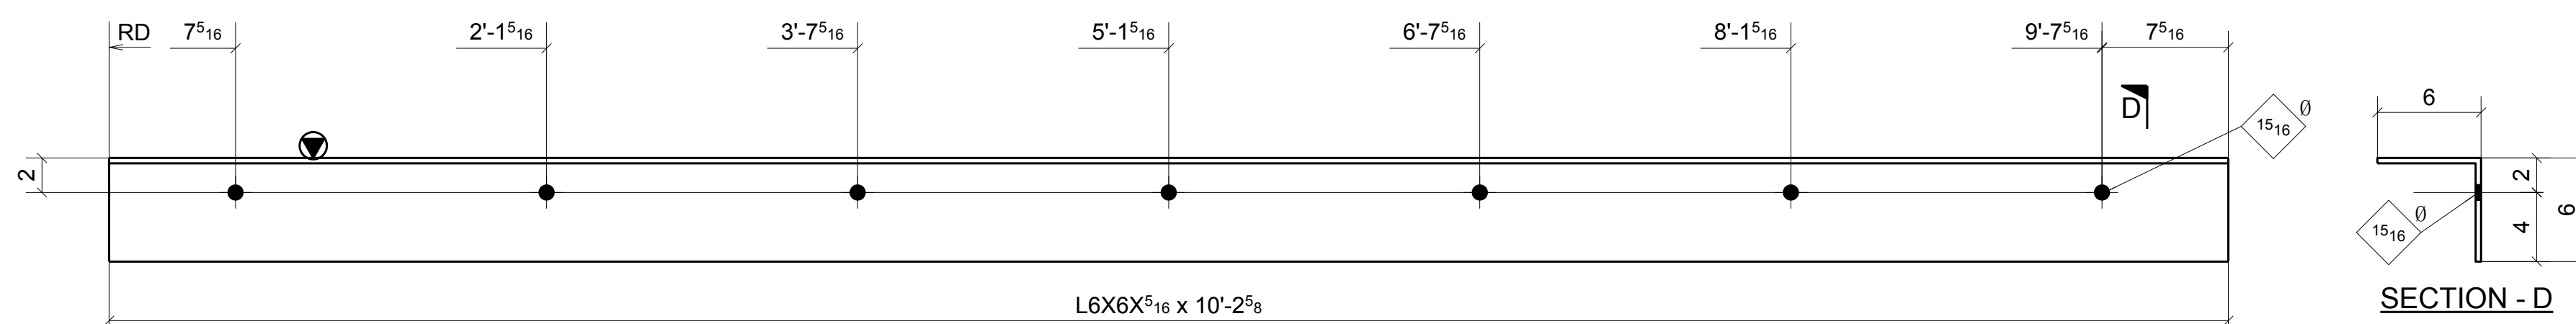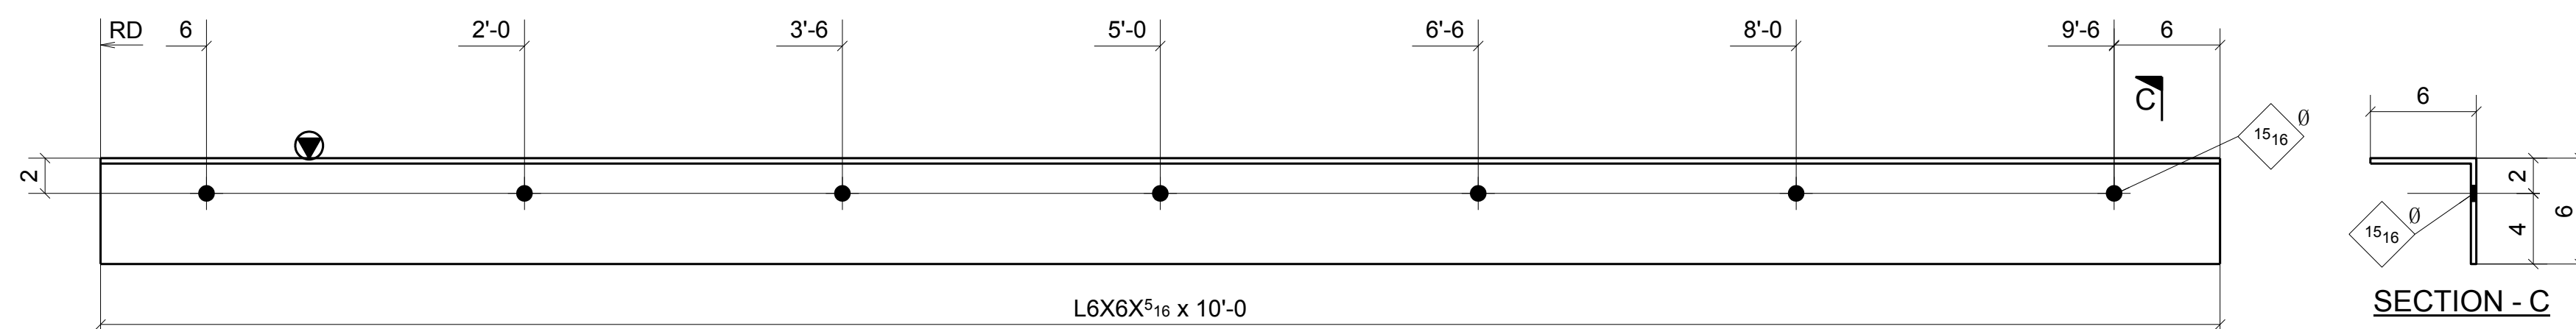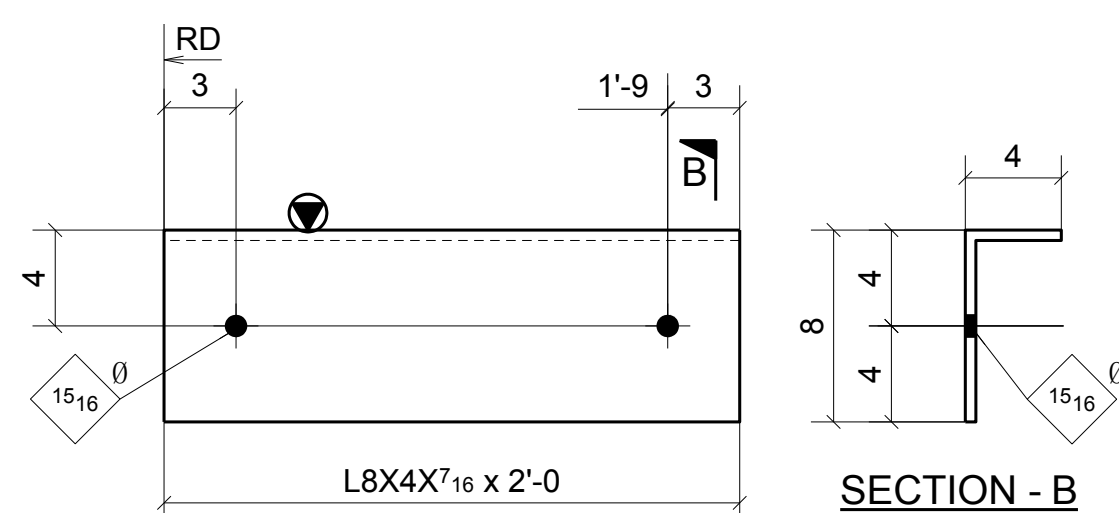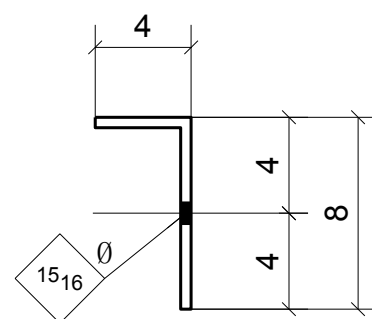

	FOR APPROVAL		05/30/16	
	Sequence:	2	Ref. E-Plans:	-
	Material:	A992 U.N.O.	Edge Dist.:	1 1/2" U.N.O.
	Holes:	13/16" DIA.	Bolts:	NOTED
	Cleaning:	NONE		
	Paint:	NO		
DFT:		COLOR:		

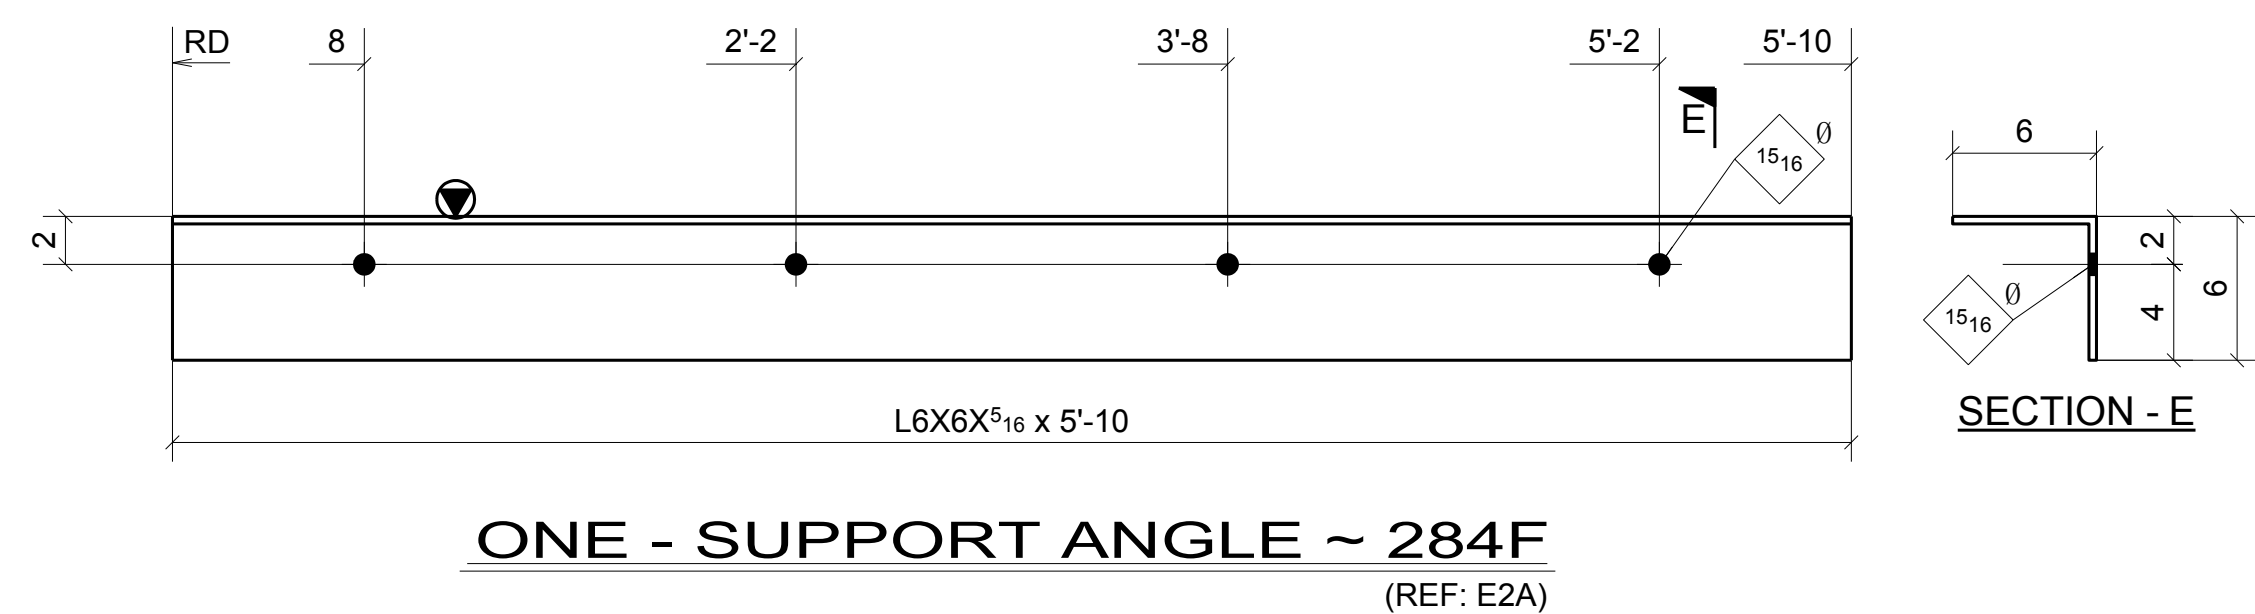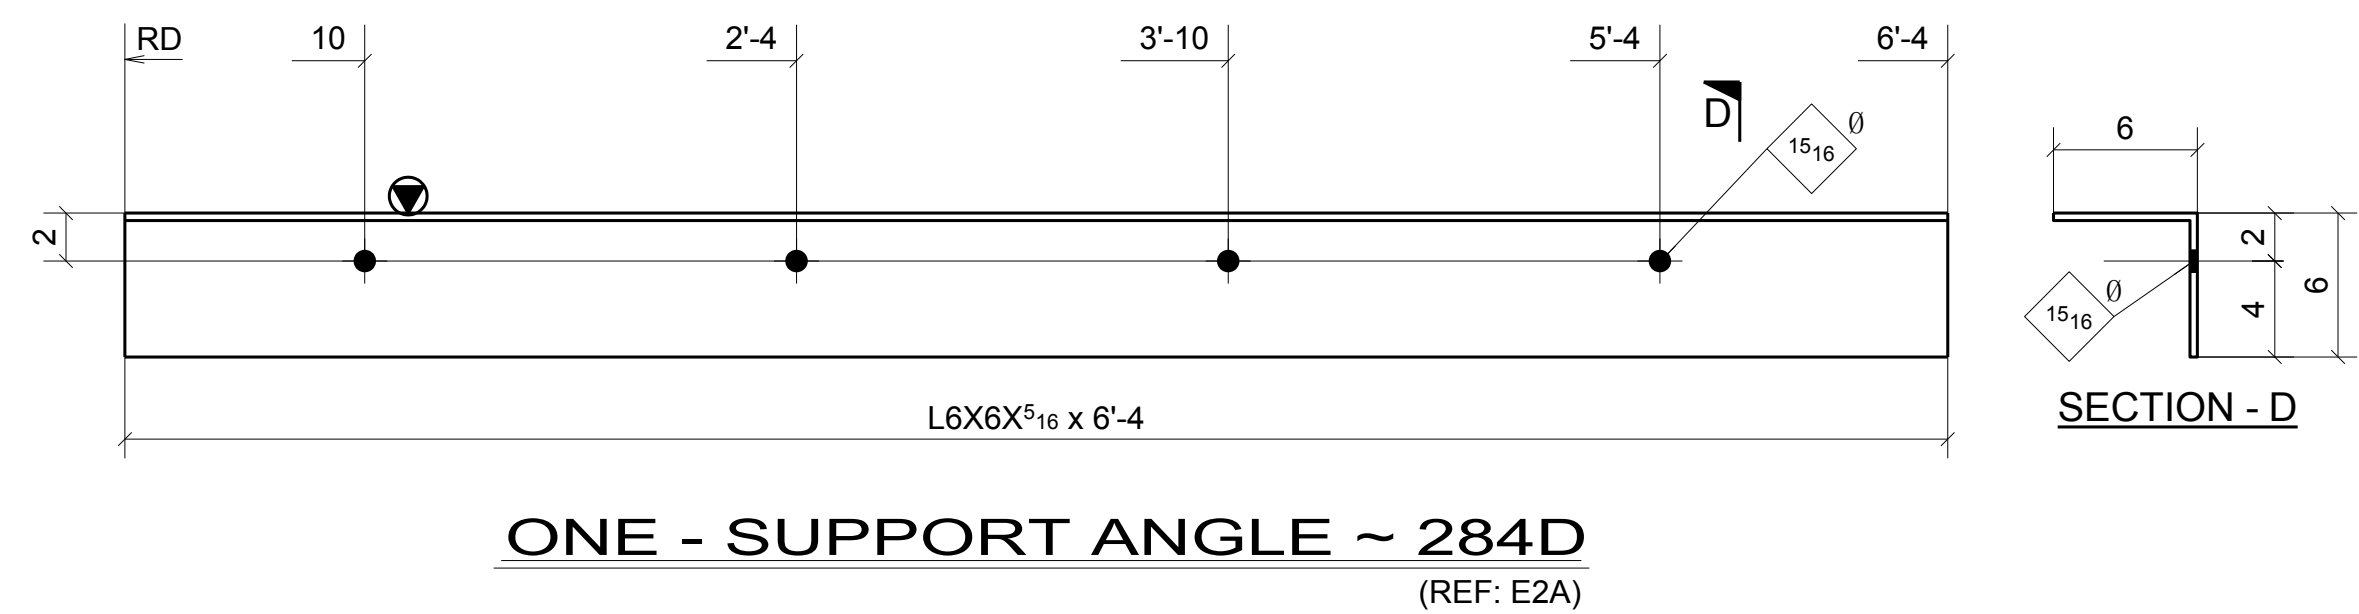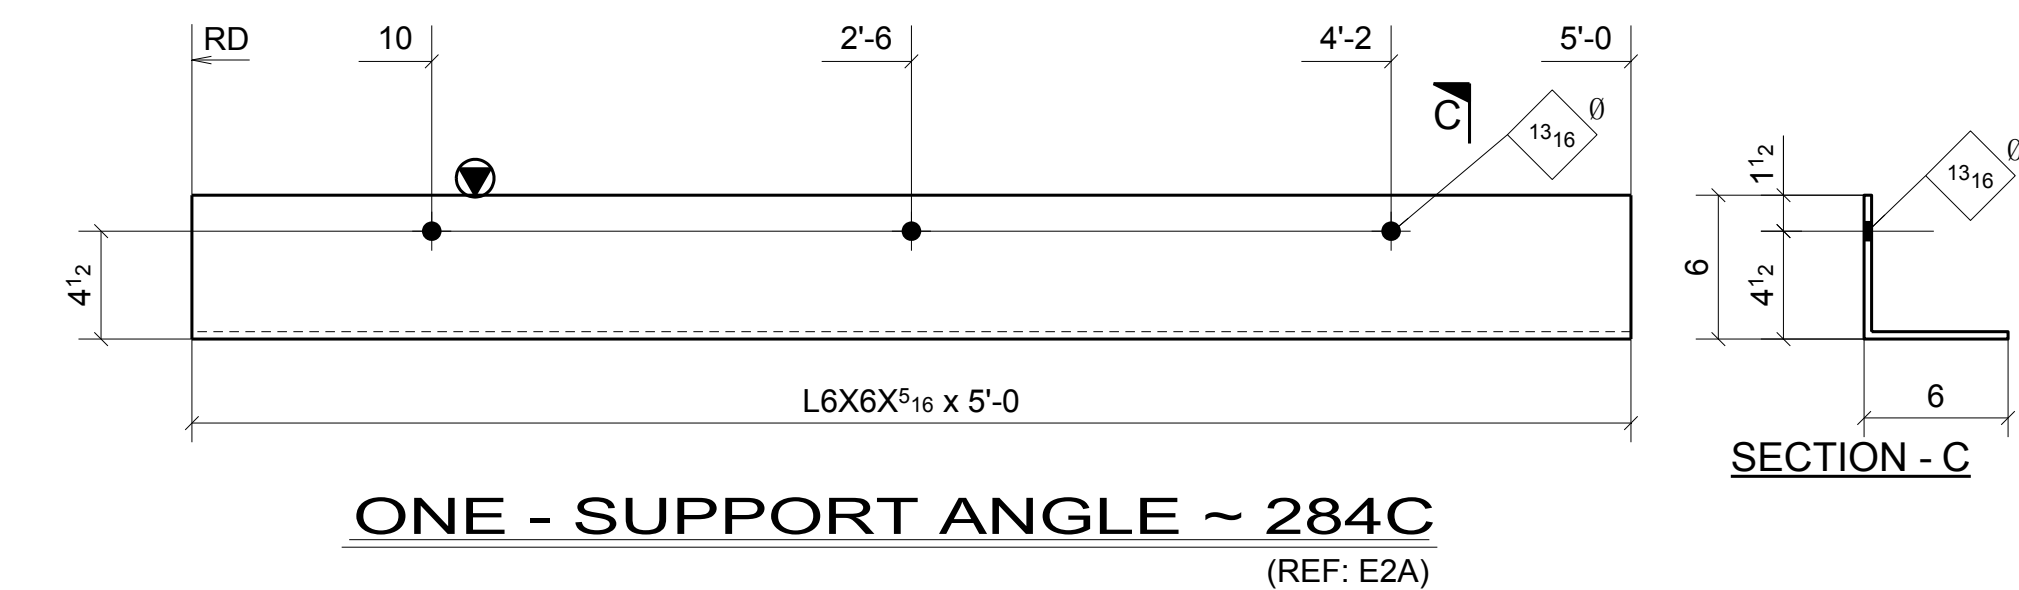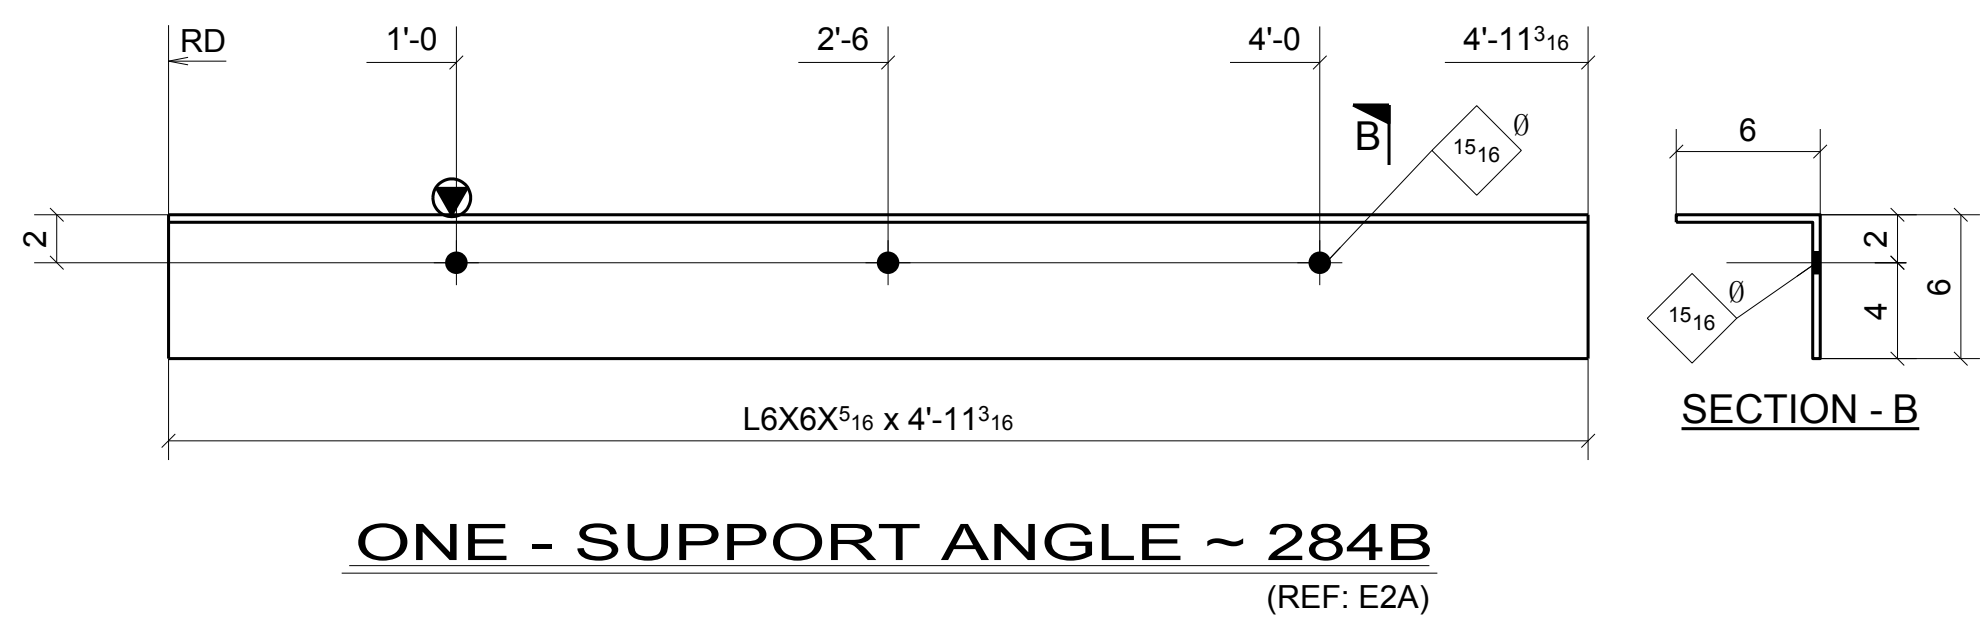[illegible]

Romac By: _____ Checked By: _____

Beamline By: _____ Checked By: _____

ATLAS IRON WORKS
ST. LOUIS, MO.

A	FOR APPROVAL		05/30/16	
Sequence:	<u>2</u>		Ref. E-Plans:	<u>-</u>
Material:	<u>A992</u>	<u>U.N.O.</u>	Edge Dist.:	<u>1 1/2"</u> <u>U.N.O.</u>
Holes:	<u>13/16"DIA.</u>		Bolts:	<u>NOTED</u>
Cleaning:	<u>NONE</u>			
Paint:	<u>NO</u>			
DFT:	<u> </u>		COLOR:	<u> </u>

Project:	WEBSTER UNIVERSITY INTERDISCIPLINARY SCIENCE BUILDING						
Customer:	PARIC CORPORATION						
Owner:	WEBSTER UNIVERSITY						
Location:	WEBSTER GUOVES,MO 63119						
Dwn:	TLI	Date:	05/30/2016	Ckd:	LJ	Date:	05/30/2016
Job No.	A16013		BAT:	DWG#:		284	

SUBMITTAL IDENTIFICATION SHEET

To be completed by Contractor/CM

PROJECT NAME

ADDRESS

NUMBER

OWNER

ARCHITECT / ENGINEER

SUBMITTED BY

CONTRACTOR / CM SUBMITTAL NO. CANNON DESIGN SUBMITTAL NO.

DRAWING / DETAIL REFERENCE SPECIFICATION SECTION / PARAGRAPH

MANUFACTURER / SUPPLIER ITEM / PRODUCT ID

REQUIRED DATE PRIORITY CRITICAL

ITEM BEING SUBMITTED (check only one)

- ☐ Shop Drawings
☐ Samples
☐ (____ copies)
☐ LEED Submittal
☐ Other _____
- ☐ Certification / Qualifications
☐ Record Documents
☐ Product Data
- ☐ Coordination Drawing
☐ Calculations
☐ Schedules
☐ O&M Manuals

ITEM BEING SUBMITTED FOR (check only one)

- ☐ Action
☐ Information Only
☐ Record

REMARKS OR DEVIATIONS

IT IS THE RESPONSIBILITY OF THE THE FABRICATOR TO COORDINATE DESIGN CALCULATIONS WITH STEEL SHOP DRAWINGS

CONTRACTOR / CM CERTIFICATION (SUBMITTALS NOT CERTIFIED WILL BE RETURNED WITHOUT REVIEW)



PARIC CORPORATION
SUBMITTAL STAMP

THIS SHOP DRAWING HAS BEEN REVIEWED BY PARIC CORPORATION

Subcontractor remains responsible for dimensions, quantities, coordination with other trades and compliance with contract documents.

By:

Devin D. Gates

To be completed by Reviewer

CANNON DESIGN SUBMITTAL NUMBER

RECEIVED DATE

☐ A. No Exceptions Taken
 No further review of submittal is required.

☐ B. Make Corrections Noted
 Incorporate corrections in work; resubmission is not required.

☐ C. Revise and Resubmit
 Revise as noted, and resubmit for review.

☐ D. Rejected
 Submittal is not in compliance with Contract Documents; provide new submittal.

☐ E. For Record / Information Only
 Submittal was reviewed for Record / Information purposes only.

☐ F. Not Required for Review
 Submittal is not required by Contract Documents and has not been reviewed.

Review is for conformance with the design concept of this project and for general compliance with contract documents. Contractor is responsible for quantities, dimensions and compliance with contract documents and for information that pertains to fabrication processes, construction techniques and coordination of this work with all trades which will be affected thereby. This review is null and void if submittal deviates from contract documents and does not indicate or note deviations.

ADD'L COMMENTS ON SHEET E2C

☐ See attached sheet(s) for additional comments

6/27/16

A/E COMMENTS

SHOP DRAWING / SUBMITTAL REVIEW

- ☐ NO EXCEPTION TAKEN
☒ EXCEPTIONS NOTED, RESUBMITTAL NOT REQUIRED
- ☐ REJECTED
☐ REVIEWED FOR INFORMATION ONLY
- ☐ REVISE AND RESUBMIT AS NOTED

Checking is only for general conformance with the design concept of the project and general compliance with the information given in the Contract Documents. Any action shown is subject to the requirements of the plans and specifications. Contractor is responsible for: Dimensions which shall be confirmed and correlated at the job site, fabrication processes and techniques of the construction, coordination of his work with that of all other trades and the satisfactory performance of his work.

DAVID MASON & ASSOCIATES, INC.

REVIEW BY: JYW DATE: 06/23/2016

REVIEWED BY

DATE

REVIEWED BY

DATE



77 Westport Plaza
Suite 250
St. Louis, MO 63146

TRANSMITTAL

No. 15051-0071

Paric Corporation

PROJECT: 15051-Webster University Interdisciplinary Science Building

DATE: 06/02/2016

TO: Cannon Design
1100 Clark Ave
St Louis MO 63102

RE: Webster Seq #2 Steel For Approval

ATTN: Kelvin Patel

JOB: 15051

WE ARE SENDING:	SUBMITTED FOR:	ACTION TAKEN:
☒ Shop Drawings	☒ Approval	☒ Approved as Submitted
☐ Letter	☐ Your Use	☐ Approved as Noted
☐ Prints	☐ As Requested	☐ Returned After Loan
☐ Change Order	☐ Review and Comment	☐ Resubmit
☐ Plans		☐ Submit
☐ Samples	SENT VIA:	☐ Returned
☐ Specifications		☐ Returned for Corrections
☐ Other:		☐ Due Date:

Item	Package	Code	Rev.	Copies	Date	Description	Status
Submittal		052100-015	1		06/02/2016	Webster Seq #2 Steel For Approval	Submitted

NOTES:

CC: Paric Corporation, Kathy Bathe

Project Coordinator: Paric Corporation, Kathy Bathe

Signed: _____
Devin Gates