


ERECTOR NOTE:
VULCRAFT, DIVISION OF NUCOR CORPORATION, HAS FURNISHED THE SHEAR CONNECTOR LAY-OUT SHOWN ON THESE DRAWINGS AS A SERVICE TO ITS CUSTOMER. HOWEVER, SINCE VULCRAFT IS NEITHER THE SUPPLIER OF THE SHEAR CONNECTORS, NOR THE DESIGNER OF THE COMPOSITE BEAMS, WE ASSUME NO RESPONSIBILITY FOR THE ACCURACY OF THE LAYOUT, NOR THE ADEQUACY OF THE DESIGN.

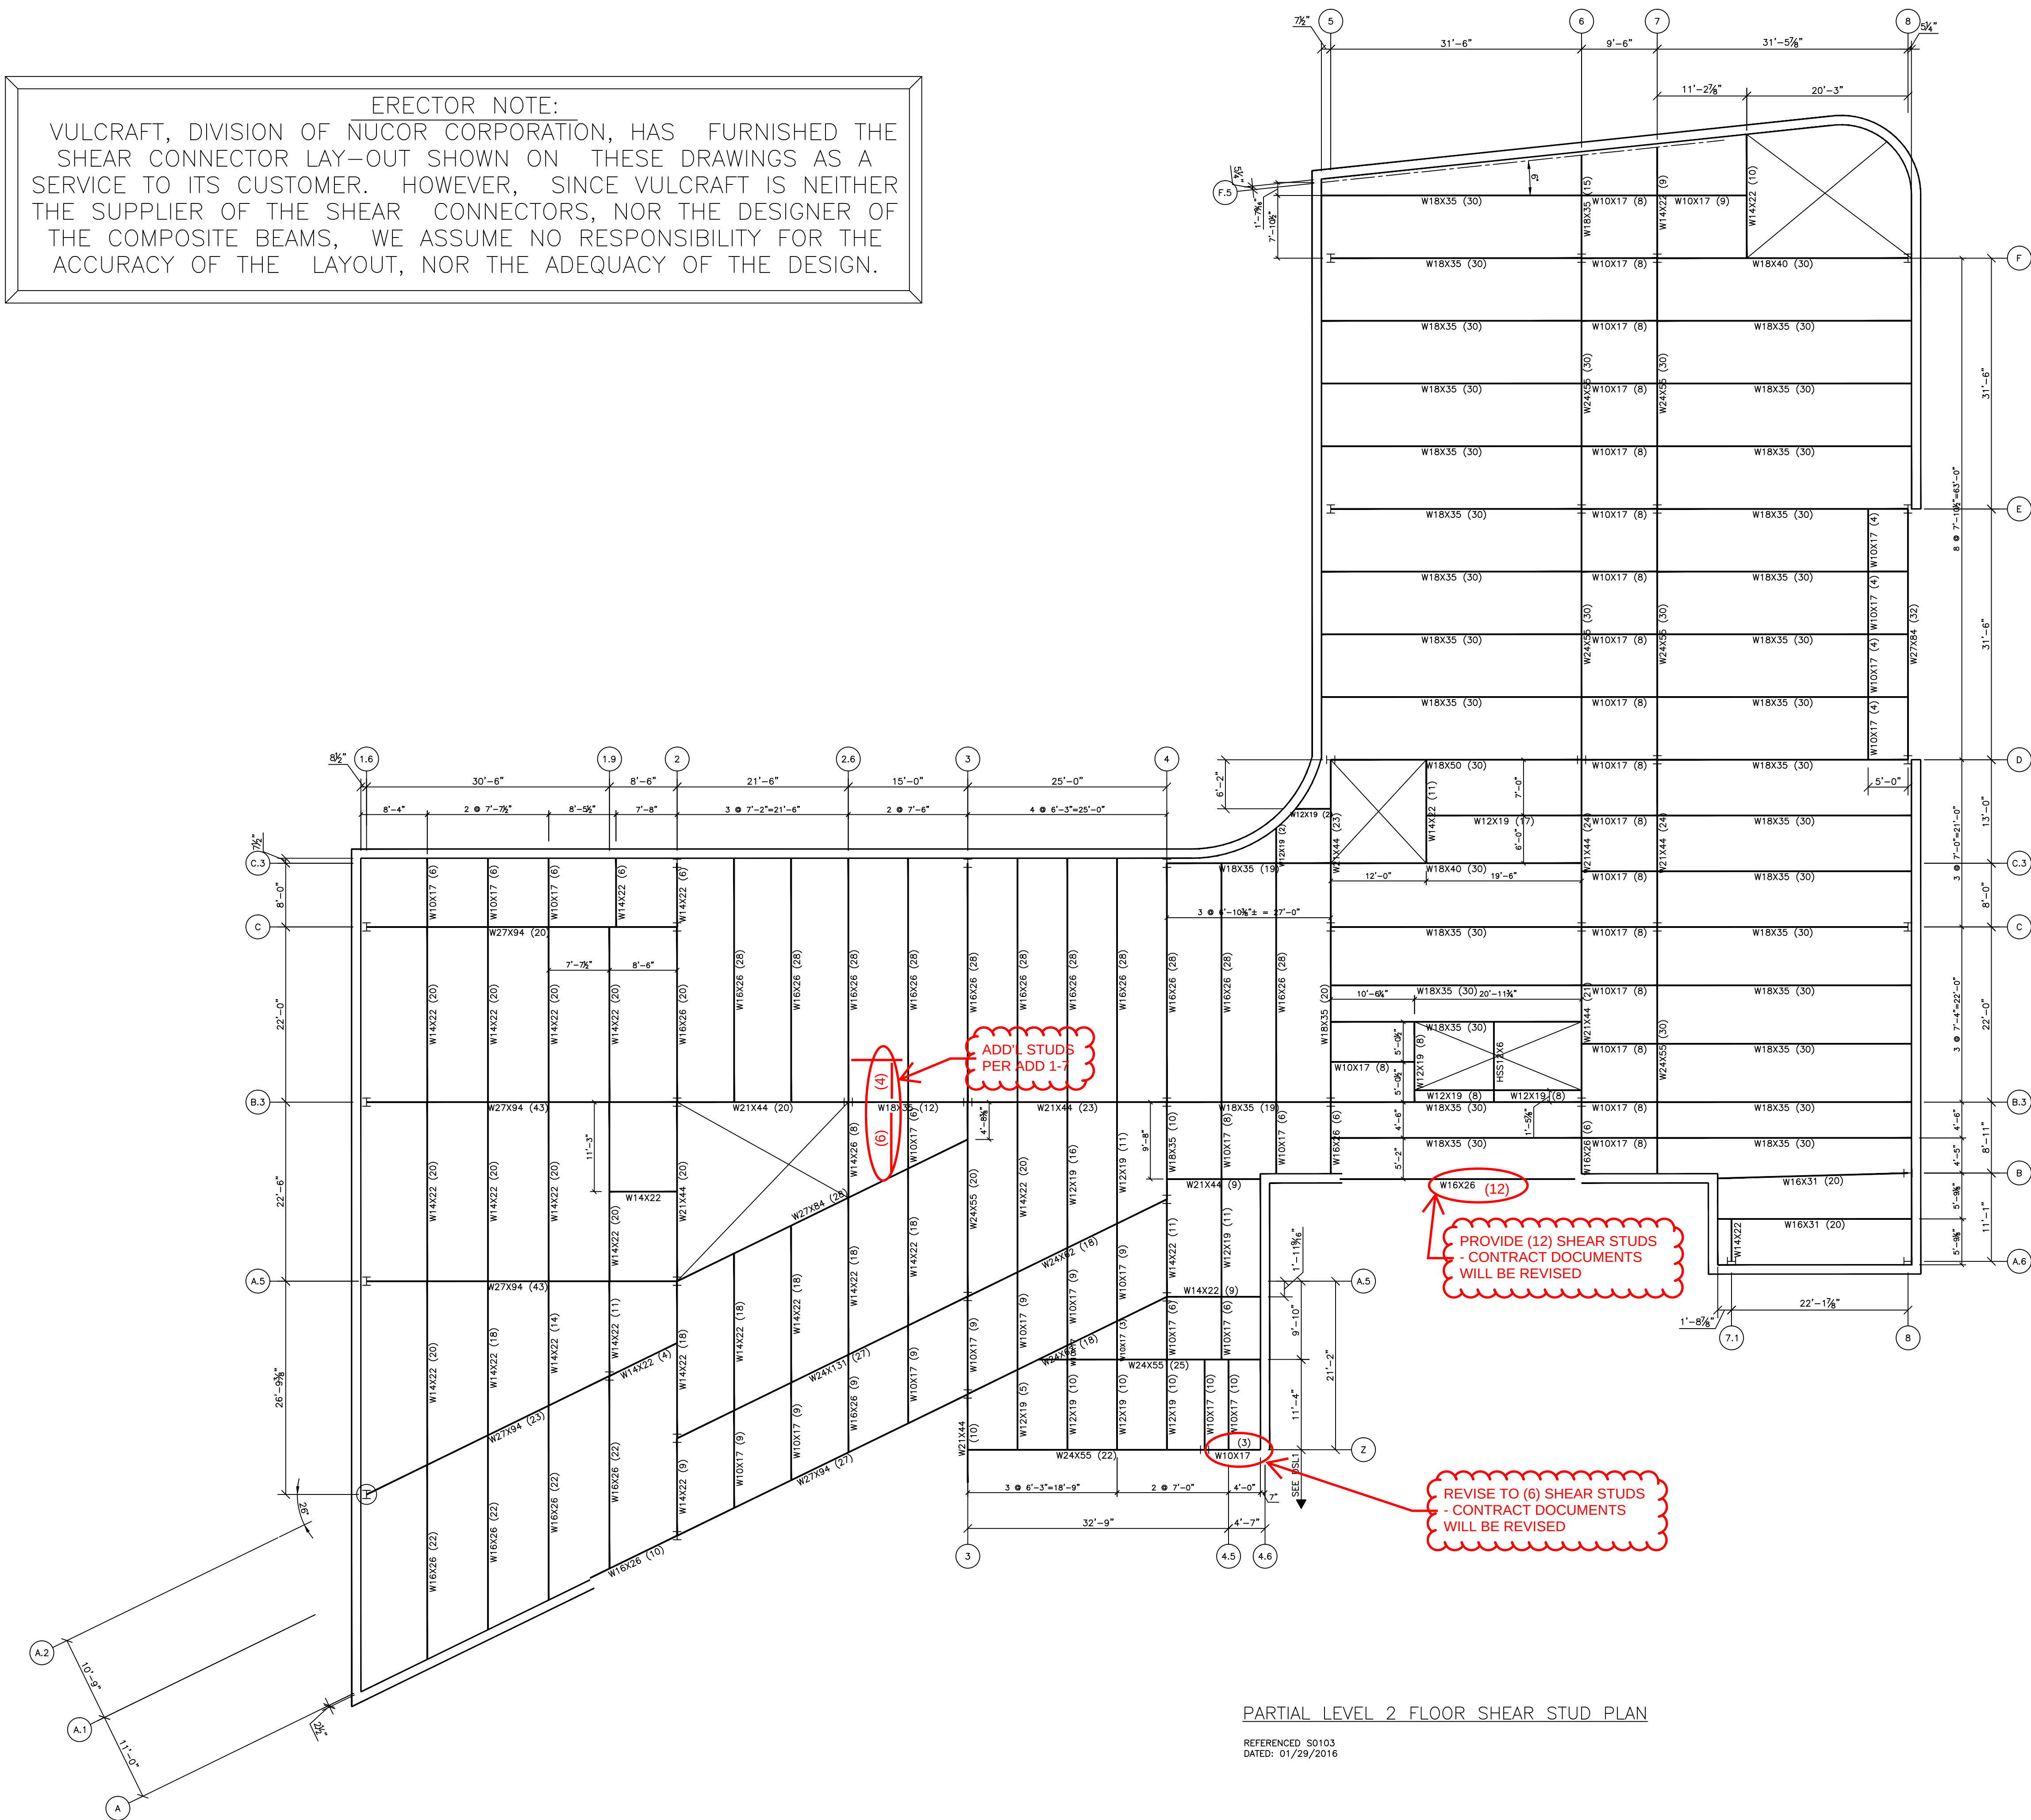


PARTIAL LEVEL 2 FLOOR SHEAR STUD PLAN
REFERENCED S0103
DATED: 01/29/2016

GENERAL CONTRACTOR
FOR APPROVAL ONLY
NOT FOR FIELD USE
VERIFICATION OF DIMENSIONS, DETAILS,
ETC., ARE REQUESTED WHERE INDICATED.
MATERIAL WILL NOT BE RELEASED FOR
FABRICATION WITHOUT EACH VERIFICATION
ADDRESSED.
June 6, 2016


SEQUENCES	
ALL JOISTS U.N.O. TO RECEIVE Gray @ 1 shop coats PRIMER	
	
DOCUMENT PREPARED IN THE USA	
PH# (256)845-2460 FAX# (256)845-2139 7205 GAULT AVENUE NORTH P.O. BOX 680169 FORT PAYNE, AL 35967	
	
	
PRINTS	FOR
APV 5	AT ST LOUIS, MO - USA
	JOB WEBSTER ISD
	AT WEBSTER GROVES, MO - USA
DRAWN BY	JUDY MARTIN
CK'D BY	
No.	REVISIONS
	DATE
FILE No.	048-16-4022
DRWG No.	DSL2
OF	0

Monday, June 6, 2016 9:24:58 AM

ERECTOR NOTE:
VULCRAFT, DIVISION OF NUCOR CORPORATION, HAS FURNISHED THE SHEAR CONNECTOR LAY-OUT SHOWN ON THESE DRAWINGS AS A SERVICE TO ITS CUSTOMER. HOWEVER, SINCE VULCRAFT IS NEITHER THE SUPPLIER OF THE SHEAR CONNECTORS, NOR THE DESIGNER OF THE COMPOSITE BEAMS, WE ASSUME NO RESPONSIBILITY FOR THE ACCURACY OF THE LAYOUT, NOR THE ADEQUACY OF THE DESIGN.

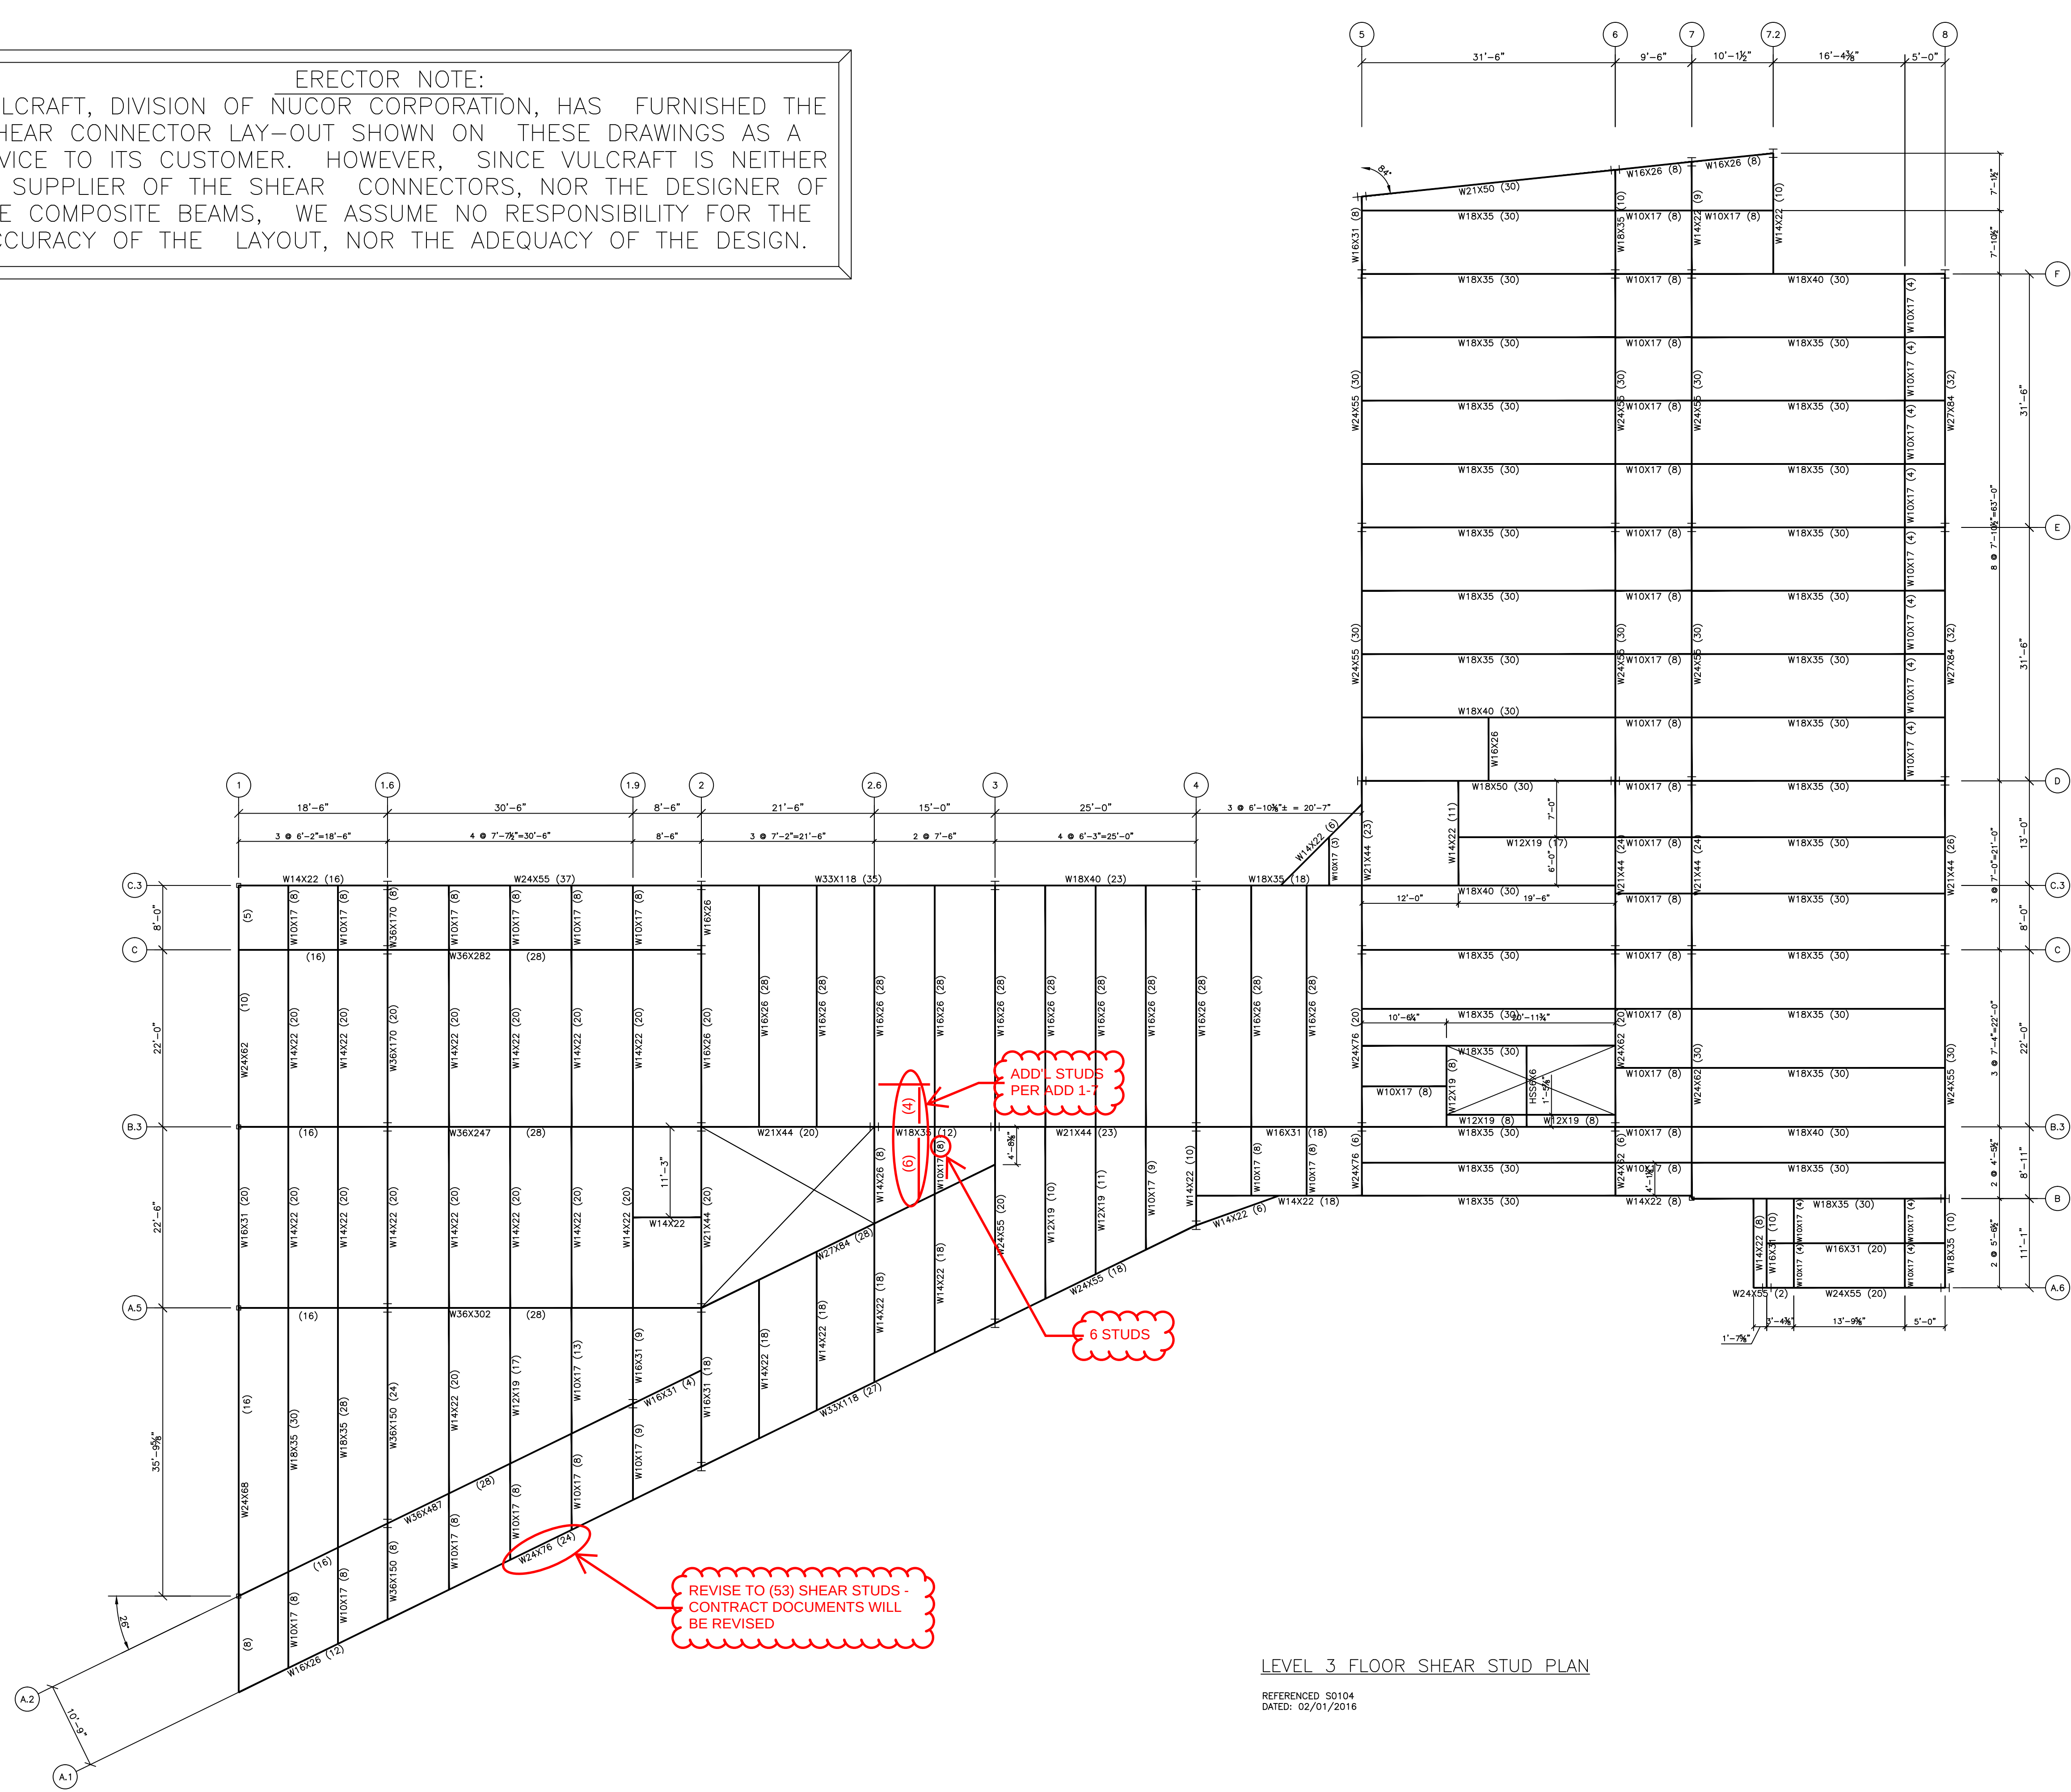

GENERAL CONTRACTOR
FOR APPROVAL ONLY
NOT FOR FIELD USE
VERIFICATION OF DIMENSIONS, DETAILS,
ETC., ARE REQUESTED WHERE INDICATED.
MATERIAL WILL NOT BE RELEASED FOR
FABRICATION WITHOUT EACH VERIFICATION
ADDRESSED.
June 6, 2016

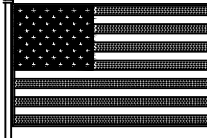
SEQUENCES	
ALL JOISTS U.N.O. TO RECEIVE Gray @ 1 shop coats PRIMER	
 NUCOR VULCRAFT GROUP	
DOCUMENT PREPARED IN THE USA	
PH# (256)845-2460 7205 GAULT AVENUE NORTH FORT PAYNE, AL 35967	FAX# (256)845-2139 P.O. BOX 680169 FORT PAYNE, AL 35968
	
PRINTS	FOR
APV 5	AT ST LOUIS, MO - USA
	JOB WEBSTER ISD
	AT WEBSTER GROVES, MO - USA
DRAWN BY JUDY MARTIN	DATE 6/3/16
CK'D BY	DATE
No.	REVISIONS
FILE No. 048-16-4022	
DRWG No. DSL3	
OF 0	

Monday, June 6, 2016 9:25:04 AM

ERECTOR NOTE:
VULCRAFT, DIVISION OF NUCOR CORPORATION, HAS FURNISHED THE SHEAR CONNECTOR LAY-OUT SHOWN ON THESE DRAWINGS AS A SERVICE TO ITS CUSTOMER. HOWEVER, SINCE VULCRAFT IS NEITHER THE SUPPLIER OF THE SHEAR CONNECTORS, NOR THE DESIGNER OF THE COMPOSITE BEAMS, WE ASSUME NO RESPONSIBILITY FOR THE ACCURACY OF THE LAYOUT, NOR THE ADEQUACY OF THE DESIGN.




REFERENCED S0105
DATED: 01/29/2016

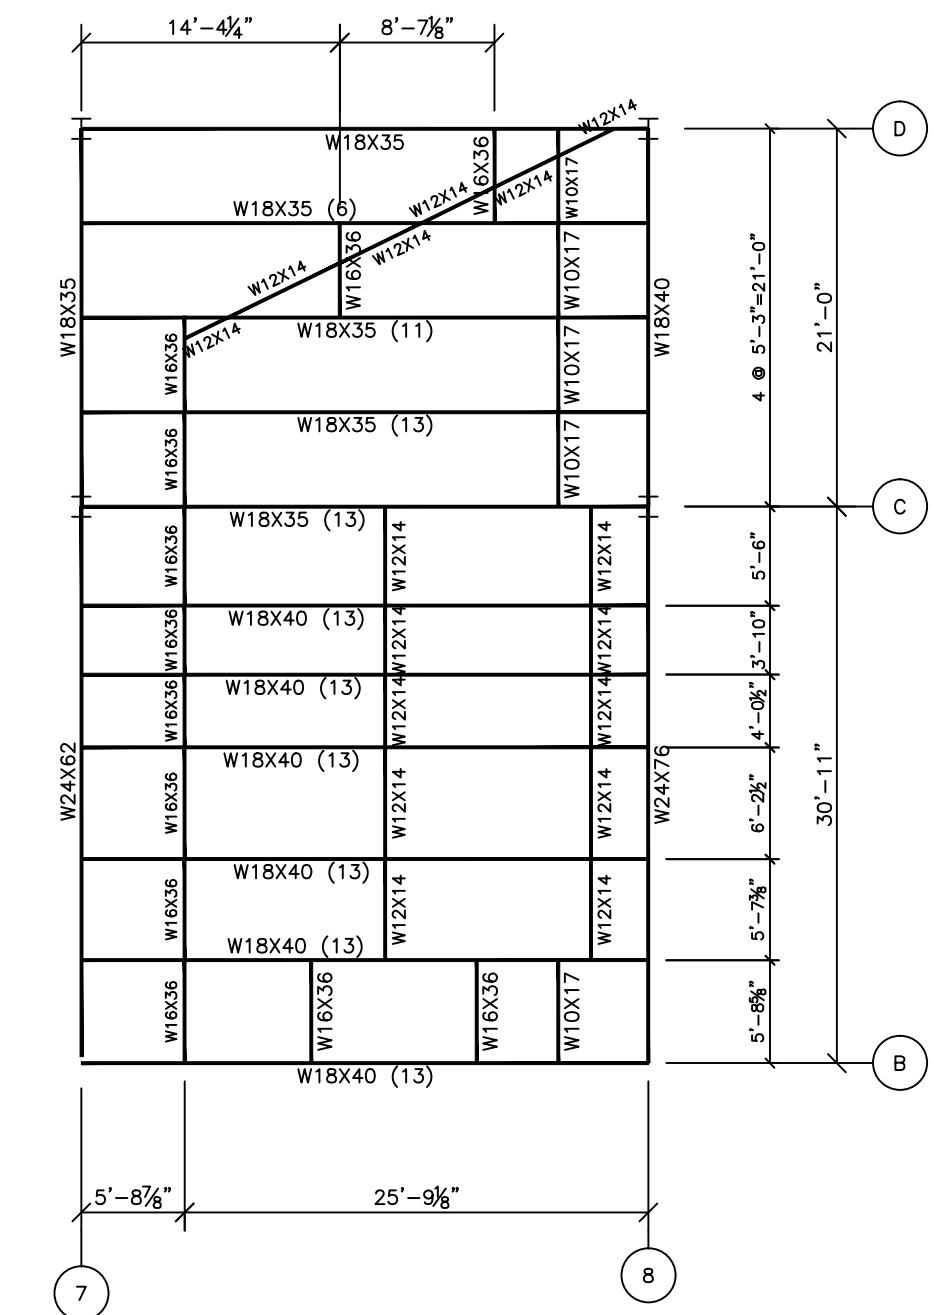

REFERENCED S0107
DATED: 02/02/2016

June 6, 2016

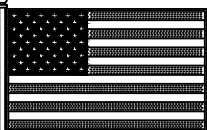SEQUENCES			
ALL JOISTS U.N.O. TO RECEIVE		Gray @ 1 shop coats	PRIMER
		 	
DOCUMENT PREPARED IN THE USA		PH.# (256)845-2460 7205 GAULT AVENUE NORTH FORT PAYNE, AL 35967	FAX# (256)845-2139 P.O. BOX 680169 FORT PAYNE, AL 35968
			
PRINTS	FOR		
APV	5	AT ST LOUIS, MO - USA	
		JOB WEBSTER ISD	
		AT WEBSTER GROVES, MO - USA	
DRAWN BY		JUDY MARTIN	DATE 6/3/16
CK'D BY			DATE
No.	REVISIONS		DATE
FILE No.	048-16-4022		DRWG No. DSJ 4 OF 0

SUBMITTAL IDENTIFICATION SHEET

To be completed by Contractor/CM

PROJECT NAME	
ADDRESS	
NUMBER	
OWNER	
ARCHITECT / ENGINEER	
SUBMITTED BY	
CONTRACTOR / CM SUBMITTAL NO.	CANNON DESIGN SUBMITTAL NO.
DRAWING / DETAIL REFERENCE	SPECIFICATION SECTION / PARAGRAPH
MANUFACTURER / SUPPLIER	ITEM / PRODUCT ID
REQUIRED DATE	PRIORITY
CRITICAL	

ITEM BEING SUBMITTED (check only one)

- | | | |
|---|--|--|
| ☐ Shop Drawings | ☐ Certification / Qualifications | ☐ Coordination Drawing |
| ☐ Samples (____ copies) | ☐ Record Documents | ☐ Calculations |
| ☐ LEED Submittal | ☐ Product Data | ☐ Schedules |
| ☐ Other _____ | ☐ O&M Manuals | |

ITEM BEING SUBMITTED FOR (check only one)

- ☐ Action ☐ Information Only ☐ Record

REMARKS OR DEVIATIONS

CONTRACTOR / CM CERTIFICATION (SUBMITTALS NOT CERTIFIED WILL BE RETURNED WITHOUT REVIEW)



PARIC CORPORATION
SUBMITTAL STAMP

THIS SHOP DRAWING HAS BEEN REVIEWED BY PARIC CORPORATION

Subcontractor remains responsible for dimensions, quantities, coordination with other trades and compliance with contract documents.

By:

Devin D. Gates

To be completed by Reviewer

CANNON DESIGN SUBMITTAL NUMBER
RECEIVED DATE
☐ A. No Exceptions Taken No further review of submittal is required.
☐ B. Make Corrections Noted Incorporate corrections in work; resubmission is not required.
☐ C. Revise and Resubmit Revise as noted, and resubmit for review.
☐ D. Rejected Submittal is not in compliance with Contract Documents; provide new submittal.
☐ E. For Record / Information Only Submittal was reviewed for Record / Information purposes only.
☐ F. Not Required for Review Submittal is not required by Contract Documents and has not been reviewed.

Review is for conformance with the design concept of this project and for general compliance with contract documents. Contractor is responsible for quantities, dimensions and compliance with contract documents and for information that pertains to fabrication processes, construction techniques and coordination of this work with all trades which will be affected thereby. This review is null and void if submittal deviates from contract documents and does not indicate or note deviations.

A/E COMMENTS

☐ See attached sheet(s) for additional comments

SHOP DRAWING / SUBMITTAL REVIEW ☐ NO EXCEPTION TAKEN ☒ EXCEPTIONS NOTED, RESUBMITTAL NOT REQUIRED ☐ REJECTED ☐ REVIEWED FOR INFORMATION ONLY ☐ REVISE AND RESUBMIT AS NOTED Checking is only for general conformance with the design concept of the project and general compliance with the information given in the Contract Documents. Any action shown is subject to the requirements of the plans and specifications. Contractor is responsible for: Dimensions which shall be confirmed and correlated at the job site; fabrication processes and techniques of the construction, coordination of his work with that of all other trades and the satisfactory performance of his work. DAVID MASON & ASSOCIATES, INC. REVIEW BY: JYW DATE: 06/20/2016

REVIEWED BY

DATE

REVIEWED BY

DATE



77 Westport Plaza
Suite 250
St. Louis, MO 63146

TRANSMITTAL

No. 15051-0075

Paric Corporation

PROJECT: 15051-Webster University Interdisciplinary Science Building

DATE: 06/07/2016

TO: Cannon Design
1100 Clark Ave
St Louis MO 63102

RE: Shear Stud Shop Drawings

ATTN: Kelvin Patel

JOB: 15051

WE ARE SENDING:		SUBMITTED FOR:	ACTION TAKEN:
☒ Shop Drawings		☒ Approval	☒ Approved as Submitted
☐ Letter		☐ Your Use	☐ Approved as Noted
☐ Prints		☐ As Requested	☐ Returned After Loan
☐ Change Order		☐ Review and Comment	☐ Resubmit
☐ Plans			☐ Submit
☐ Samples		SENT VIA:	☐ Returned
☐ Specifications			☐ Returned for Corrections
☐ Other:			☐ Due Date:

<i>Item</i>	<i>Package</i>	<i>Code</i>	<i>Rev.</i>	<i>Copies</i>	<i>Date</i>	<i>Description</i>	<i>Status</i>
Submittal		051200-016	1		06/07/2016	Shear Stud Shop Drawings	Submitted

NOTES:

CC: Paric Corporation, Kathy Bathe

Project Coordinator: Paric Corporation, Kathy Bathe

Signed: _____
Devin Gates