




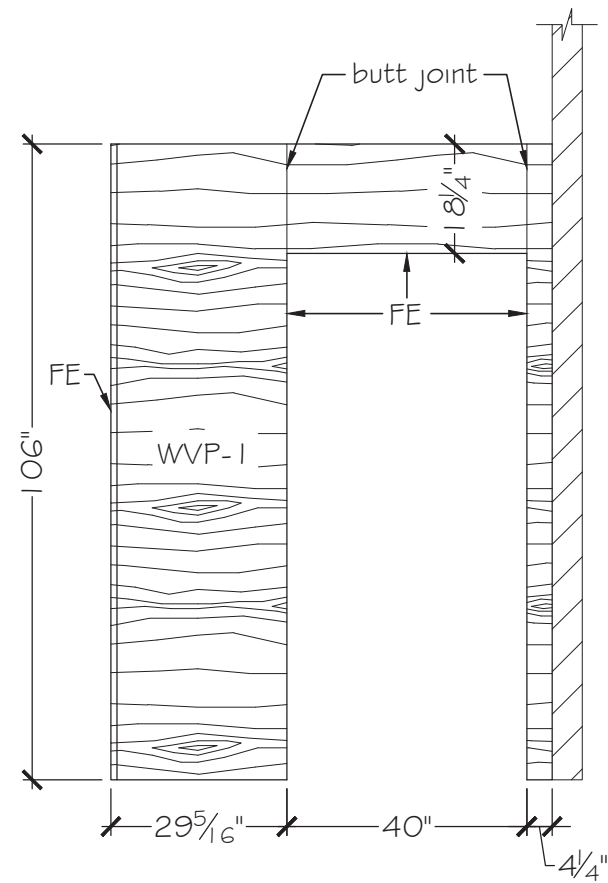


WOMEN 177

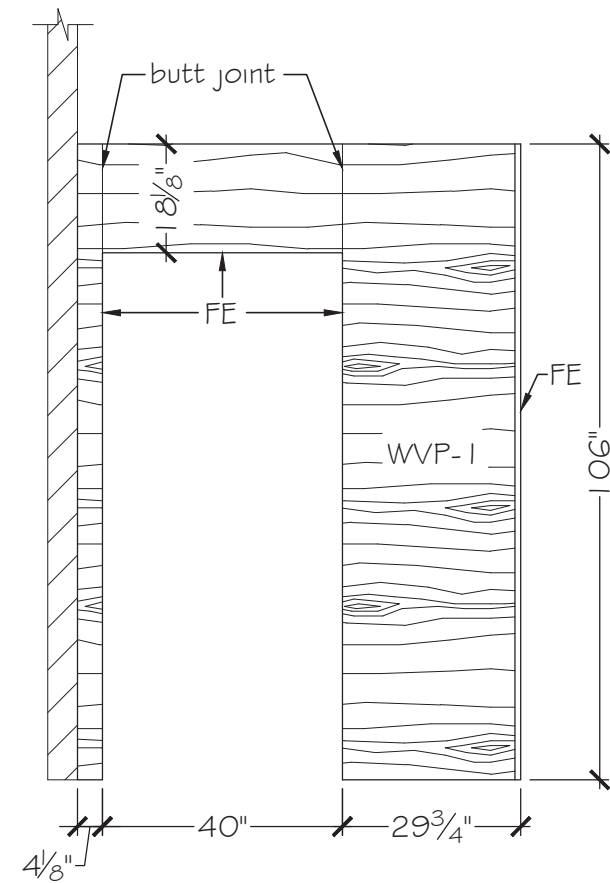

MEN 179

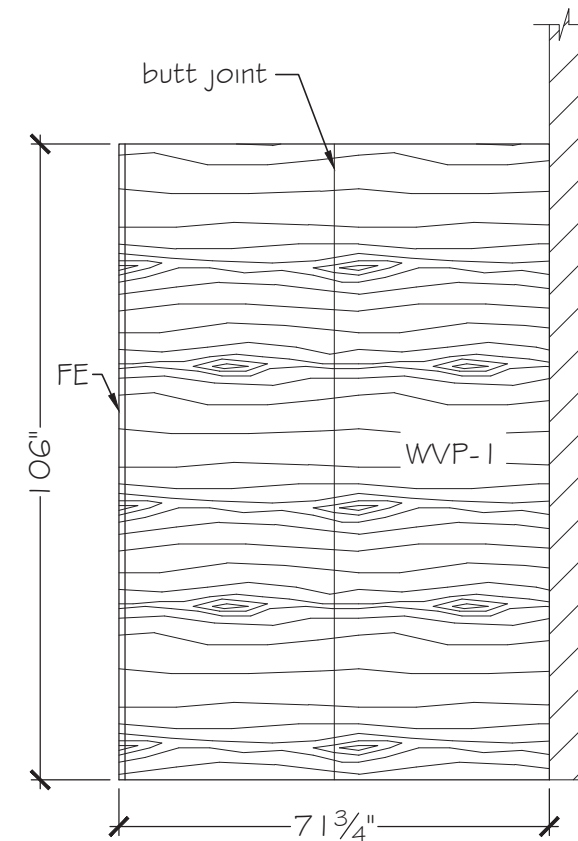


JC 175

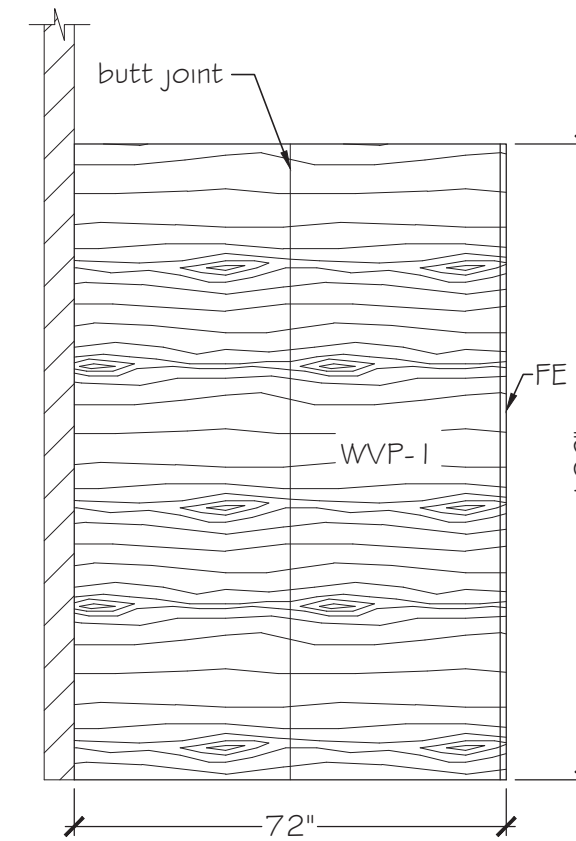


JC 175


1st FLOOR

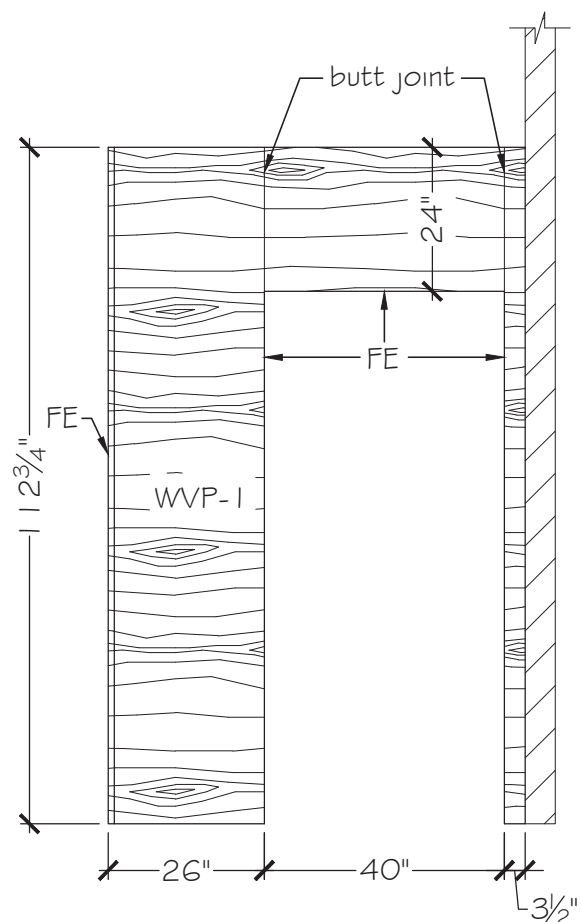


WOMEN 277

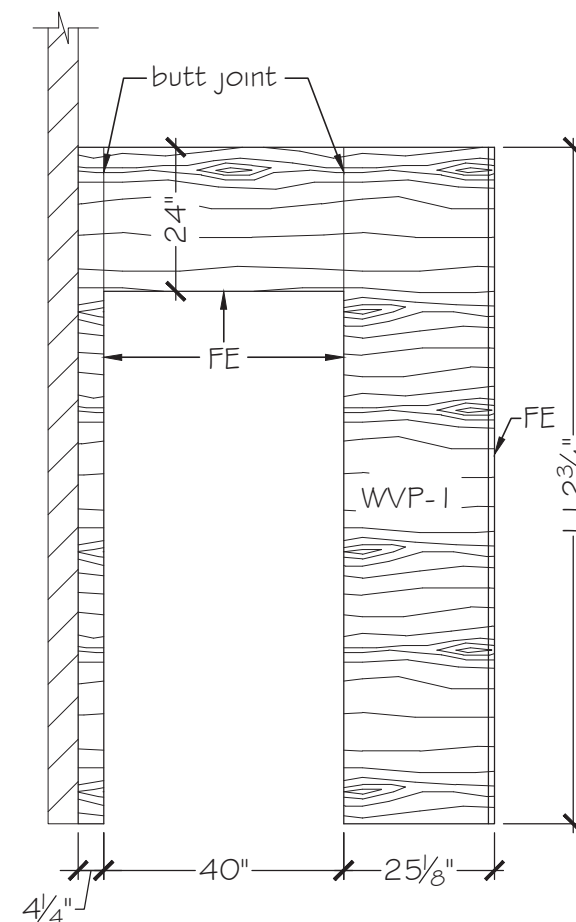

MEN 279

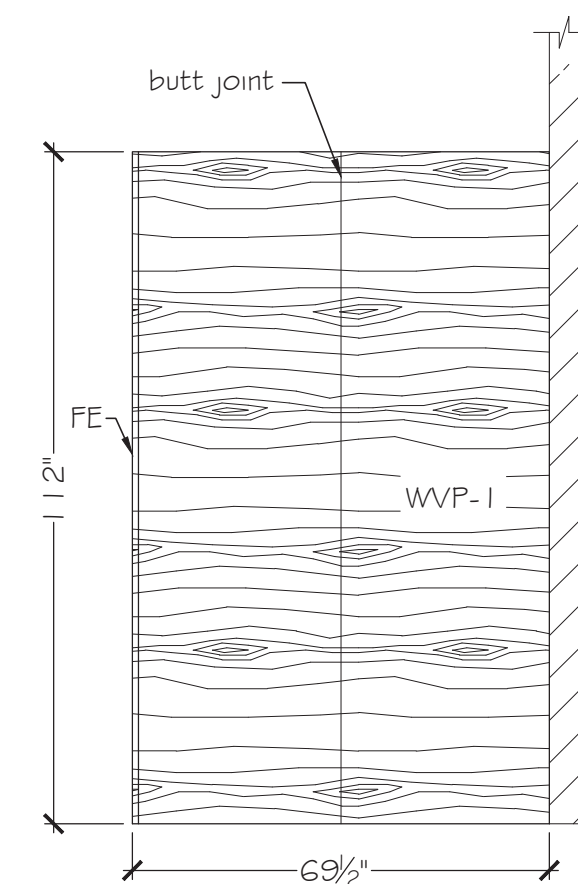

LACT 275

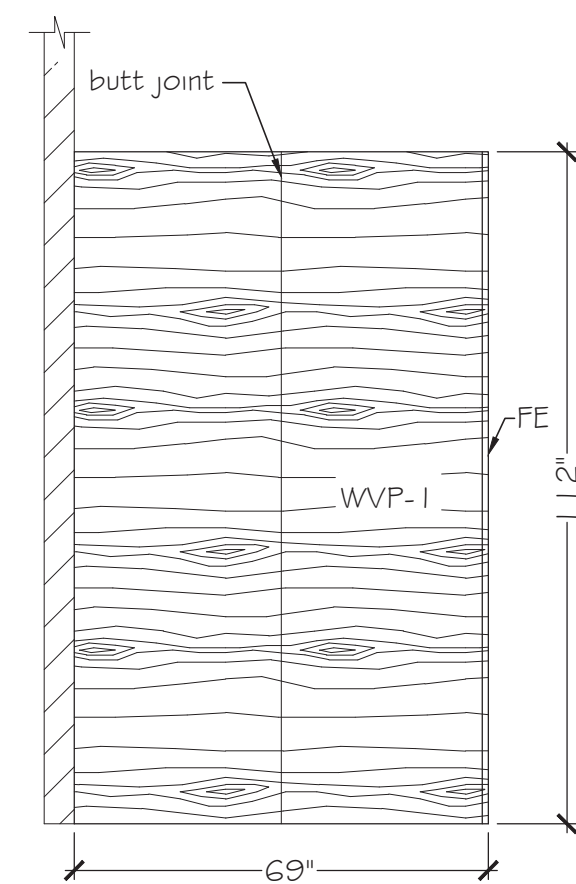

LACT 275

2nd FLOOR

PROVIDE WOOD PANELS AT THE DEAN'S SUITE ENTRY (ROOM 202) ON LEVEL 02, THEY ARE MISSING IN THIS SUBMITTAL.

PROVIDE SOLID WOOD EDGING AT THE FINISHED ENDS ALONG CORRIDOR, MATCH EDGING PER SUBMITTAL 064116-003.

VERIFY IN FIELD ALL THE DIMENSIONS.

GENERAL NOTES

Hardware quantities are per page.

HARDWARE

FINISHES


WVP-1 : White Oak Rift Clear Finish

St. Louis Wood Works will field verify all dimensions


Approved:	Approved Date:
Project:	Webster Science
Job No:	Job 16243
Drawn by:	Paul Rose
Date:	7/19/17
Scale:	As Noted
Revision Date:	
Sheet No.	01 of 02

**ST. LOUIS
WOODWORKS**


500 Prospect Ave.
St. Louis, MO 63110
ph. # 314-652-8663 fax # 314-652-7664

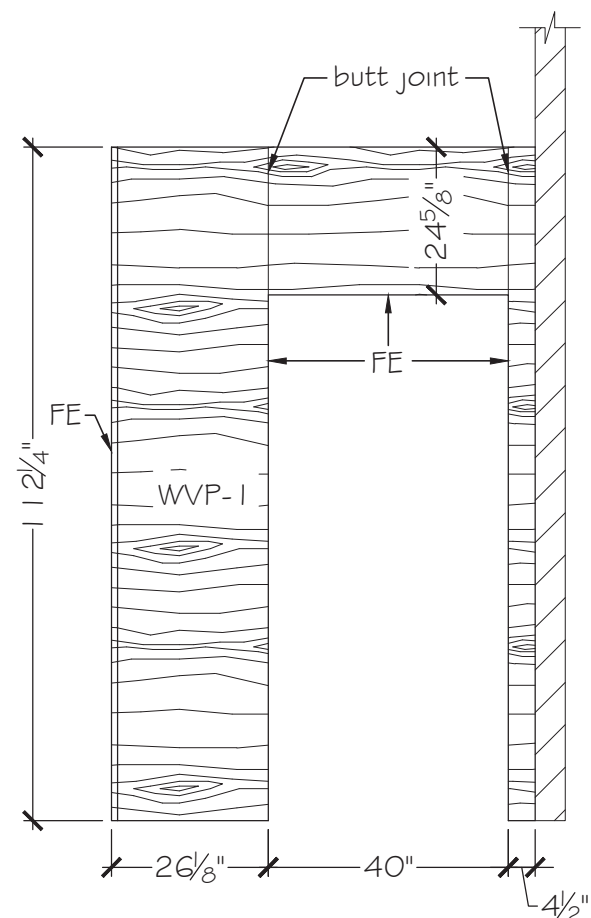


WOMEN 377

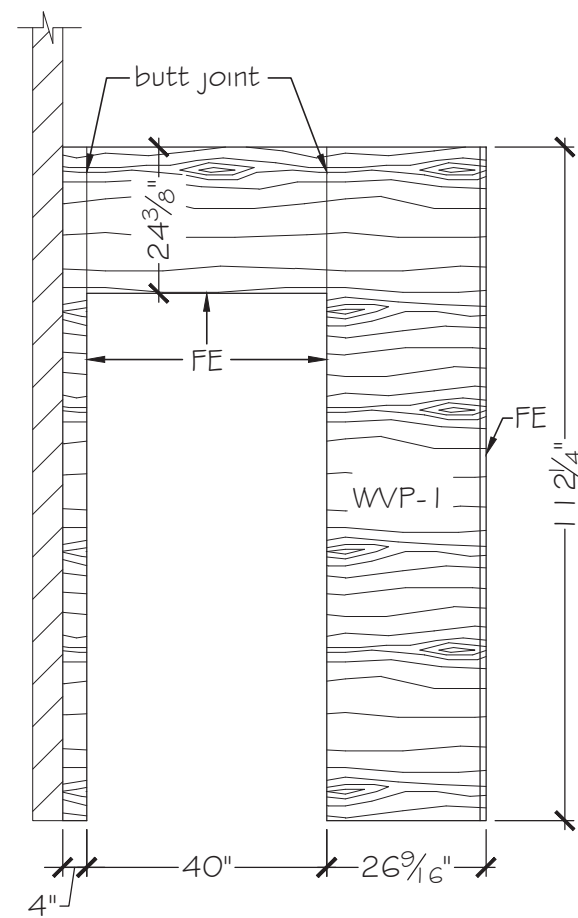

MEN 379

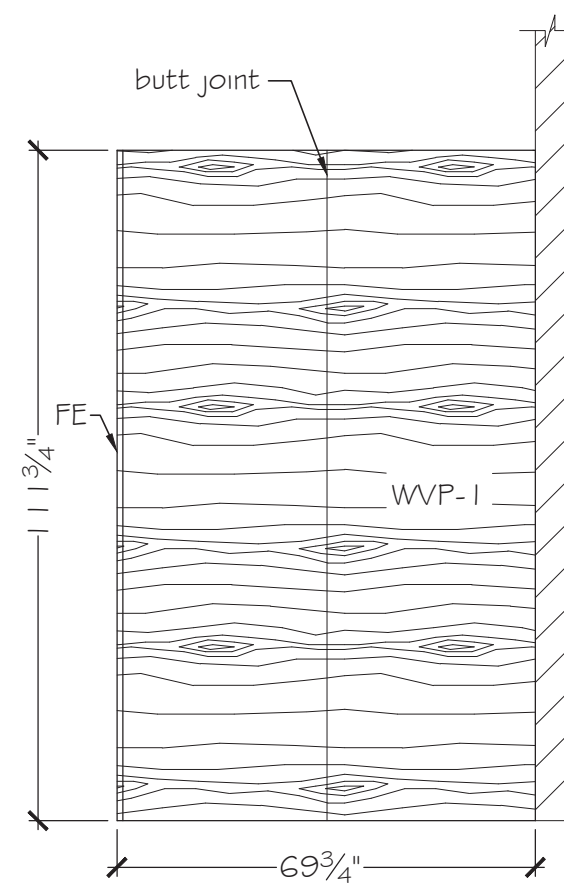


JC 375

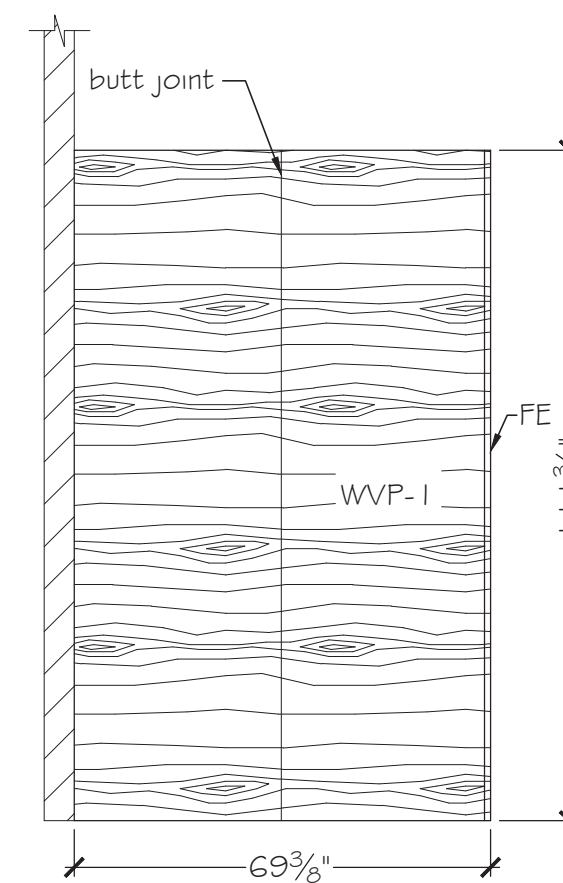


JC 375


3rd FLOOR

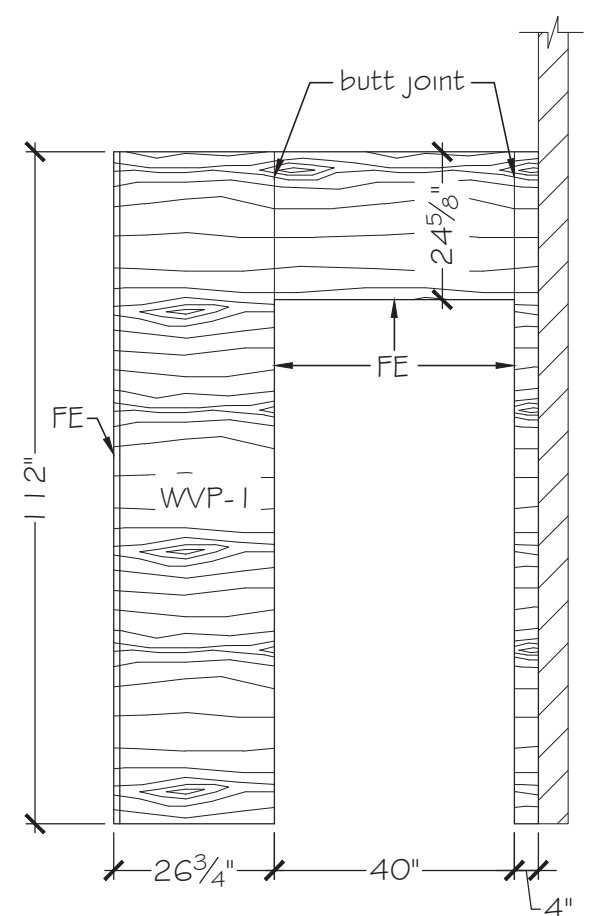


WOMEN 477

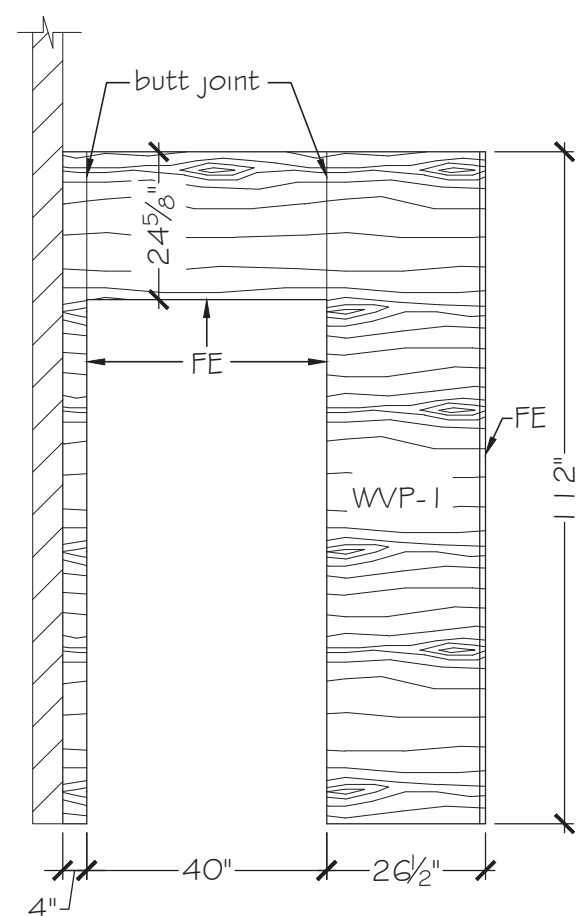

MEN 479

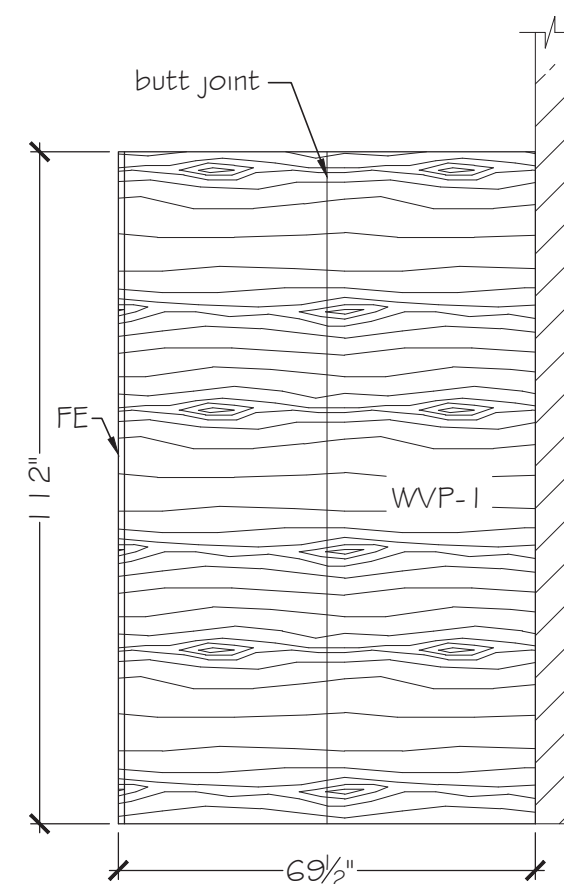

LAB WASTE CHEM 475

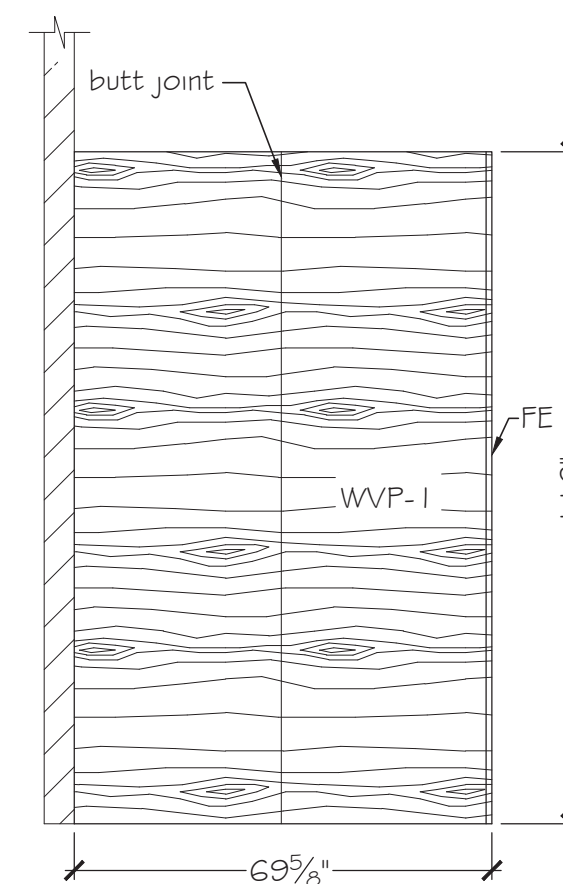

LAB WASTE CHEM 475

4th FLOOR

GENERAL NOTES

Hardware quantities are per page.

HARDWARE

FINISHES

WVP-1 : White Oak Rift Clear Finish

St. Louis Wood Works will
field verify all dimensions

Approved:	Approved Date:
Project:	Webster Science
Job No: Job 16243	Drawn by: Paul Rose
ST. LOUIS WOODWORKS 500 Prospect Ave. St. Louis, MO 63110 ph.# 314-652-8663 fax# 314-652-7664	Date: 7/19/17
	Scale: As Noted
	Revision Date:
Sheet No. 02 of 02	

PROVIDE SOLID WOOD EDGING AT THE
FINISHED ENDS ALONG CORRIDOR, MATCH
EDGING PER SUBMITTAL 064116-003.

VERIFY IN FIELD ALL THE DIMENSIONS.

SUBMITTAL IDENTIFICATION SHEET

To be completed by Contractor/CM

WEBSTER UNIVERSITY ISB	
PROJECT NAME	
8274 BIG BEND BLVD	
ADDRESS	
NUMBER	
WEBSTER UNIVERSITY	
OWNER	
CANNON DESIGN	
ARCHITECT / ENGINEER	
Ryan Tune	
SUBMITTED BY	
064116-018	
CONTRACTOR / CM SUBMITTAL NO.	CANNON DESIGN SUBMITTAL NO.
	064116
DRAWING / DETAIL REFERENCE	SPECIFICATION SECTION / PARAGRAPH
MANUFACTURER / SUPPLIER	ITEM / PRODUCT ID
REQUIRED DATE	PRIORITY
	☐ CRITICAL

ITEM BEING SUBMITTED (check only one)

- | | | |
|--|--|--|
| ☒ Shop Drawings | ☐ Certification / | ☐ Coordination Drawing |
| ☐ Samples | ☐ Qualifications | ☐ Calculations |
| (_____ copies) | ☐ Record Documents | ☐ Schedules |
| ☐ LEED Submittal | ☐ Product Data | ☐ O&M Manuals |
| ☐ Other _____ | | |

ITEM BEING SUBMITTED FOR (check only one)

- ☒ Action ☐ Information Only ☐ Record

REMARKS OR DEVIATIONS

CONTRACTOR / CM CERTIFICATION (SUBMITTALS NOT CERTIFIED WILL BE RETURNED WITHOUT REVIEW)



PARIC CORPORATION
SUBMITTAL STAMP

THIS SHOP DRAWING HAS BEEN REVIEWED BY PARIC CORPORATION

Subcontractor remains responsible for dimensions, quantities, coordination with other trades and compliance with contract documents.

By:

Devin D. Gates

Ryan Tune	07/24/17
REVIEWED BY	DATE

To be completed by Reviewer

06 4116-018
CANNON DESIGN SUBMITTAL NUMBER
7/25/17
RECEIVED DATE

- ☐ A. No Exceptions Taken
No further review of submittal is required.
- ☒ B. Make Corrections Noted
Incorporate corrections in work; resubmission is not required.
- ☐ C. Revise and Resubmit
Revise as noted, and resubmit for review.
- ☐ D. Rejected
Submittal is not in compliance with Contract Documents; provide new submittal.
- ☐ E. For Record / Information Only
Submittal was reviewed for Record / Information purposes only.
- ☐ F. Not Required for Review
Submittal is not required by Contract Documents and has not been reviewed.

Review is for conformance with the design concept of this project and for general compliance with contract documents. Contractor is responsible for quantities, dimensions and compliance with contract documents and for information that pertains to fabrication processes, construction techniques and coordination of this work with all trades which will be affected thereby. This review is null and void if submittal deviates from contract documents and does not indicate or note deviations.

A/E COMMENTS

☐ See attached sheet(s) for additional comments

-PROVIDE WOOD PANELS AT THE DEAN'S SUITE ENTRY (ROOM 202) ON LEVEL 02, THEY ARE MISSING IN THIS SUBMITTAL.

-PROVIDE SOLID WOOD EDGING AT THE FINISHED ENDS ALONG CORRIDOR, MATCH EDGING PER SUBMITTAL 064116-003.

- VERIFY IN FIELD ALL THE DIMENSIONS.

Kelvin Patel	8/15/17
REVIEWED BY	DATE

Digitally signed by Kelvin Patel
DN: cn=Kelvin Patel, o=Cannon Design,
ou=Architect, email=K-Patel@cannondesign.com, c=US
Date: 2017.08.15 15:21:13 -0500