


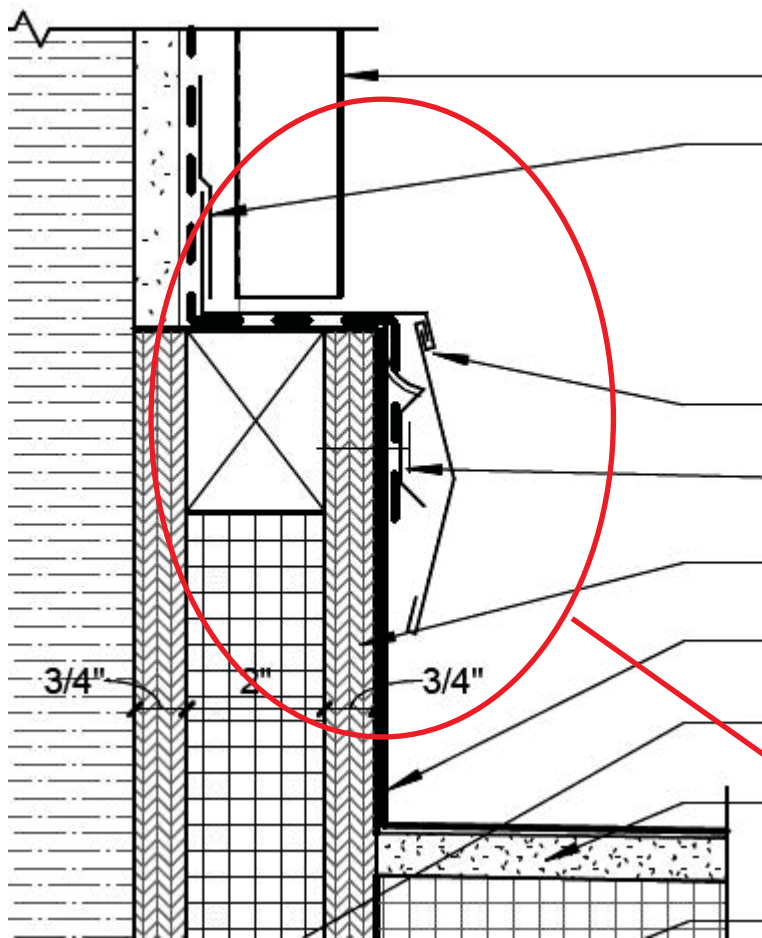


ALUMINUM COMPOSITE PANEL (BY VOGEL) OR GLAZING (BY OTHERS)

FLASHING UP BACK OF WALL 3" AND FASTENED WITH 1" SS RING SHANK AT 16"OC

- 26GA 304 STAINLESS STEEL 2-PIECE MIN 4" TALL
- 2B MILL FINISH
- CORNERS/MITERS AND END DAMS WILL BE SOLDERED
- EXPANSION JOINTS WILL BE OVERLAPPED AND CAULKED WITH DOW CORNING 795 SEALANT
- COORDINATION WITH GLAZER AS REQUIRED
- TERMINATION BAR BY ROOFER
- SEE ATTACHED RED LINE ROOF PLAN SHOWING WHERE THIS DETAIL APPLIES

expansion joints to be overlapped 6" min per

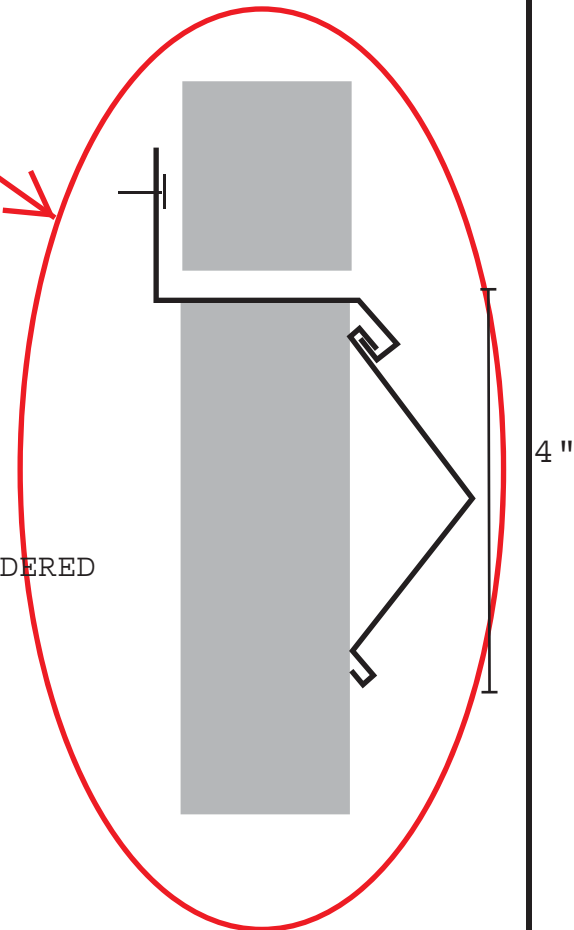

Submitted By:
Rick Sowa
Architectural
Metal Specialist

PROJECT NAME:
Webster Interdisciplinary Science

DESCRIPTION/NOTES:
Counterflashing

SPEC SECTION:
076200

DATE:
12/23/16

END DAMS
WHERE
REQUIRED

3"

VIF

4" MIN





1642 MANUFACTURERS DRIVE
FENTON, MO 63026
PHONE: (314) 351-2533
FAX: (314) 351-3253

LETTER OF TRANSMITTAL

Date: December 27, 2016	Job No. A31750
Attention: Devin Gates	
Re: Webster Interdisciplinary Science Building	

TO: Paric Corporation

77 Westport Plaza Dr. Ste.250

St.Louis, Mo 63146

WE ARE SENDING YOU:

- ☒ Attached
 ☐ Under separate cover via _____ the following:
- ☒ Shop drawings
 ☐ Prints
 ☐ Plans
 ☐ Samples
 ☐ Specifications
- ☐ Copy of letter
 ☐ Change order
 ☐ other:

COPIES	DATE	NO.	DESCRIPTION
1	12/27/16	1	072600 - 26Ga Stainless steel flashing, roof plan showing application, Dow Corning 795 sealant

THESE ARE TRANSMITTED as checked below:

- | | | | |
|--|---|---|--|
| ☒ For approval | ☐ Approved as submitted | ☒ Resubmit | ☐ Copies for approval |
| ☐ For your use | ☐ Approved as noted | ☐ Submit | ☐ Copies for distribution |
| ☐ As Requested | ☐ Returned for corrections | ☐ Return | ☐ Corrected prints |
| ☐ For review and comment | ☐ For Bids Due on _____ | ☐ Prints Returned after loan to us | |

REMARKS: _____

Copy To:

Signature: Rick Sowa, Architectural Specialist

If enclosures are not as noted, kindly notify us at once.