

SUBMITTAL IDENTIFICATION SHEET

To be completed by Contractor/CM

WEBSTER UNIVERSITY ISB	
PROJECT NAME	
8274 BIG BEND BLVD	
ADDRESS	
NUMBER	
WEBSTER UNIVERSITY	
OWNER	
CANNON DESIGN	
ARCHITECT / ENGINEER	
Devin Gates	
SUBMITTED BY	
081216-008	
CONTRACTOR / CM SUBMITTAL NO.	CANNON DESIGN SUBMITTAL NO.
	081216
DRAWING / DETAIL REFERENCE	SPECIFICATION SECTION / PARAGRAPH
MANUFACTURER / SUPPLIER	ITEM / PRODUCT ID
REQUIRED DATE	PRIORITY
	CRITICAL

ITEM BEING SUBMITTED (check only one)

- | | | |
|--|--|--|
| ☒ Shop Drawings | ☐ Certification / | ☐ Coordination Drawing |
| ☐ Samples | ☐ Qualifications | ☐ Calculations |
| (_____ copies) | ☐ Record Documents | ☐ Schedules |
| ☐ LEED Submittal | ☐ Product Data | ☐ O&M Manuals |
| ☐ Other _____ | | |

ITEM BEING SUBMITTED FOR (check only one)

- ☒ Action ☐ Information Only ☐ Record

REMARKS OR DEVIATIONS

Dimensions to be coordinated with wood grill contractor prior to installation.

CONTRACTOR / CM CERTIFICATION (SUBMITTALS NOT CERTIFIED WILL BE RETURNED WITHOUT REVIEW)



PARIC CORPORATION
SUBMITTAL STAMP

THIS SHOP DRAWING HAS BEEN REVIEWED BY PARIC CORPORATION

Subcontractor remains responsible for dimensions, quantities, coordination with other trades and compliance with contract documents.

By:

Devin D. Gates

To be completed by Reviewer

08 1216-008
CANNON DESIGN SUBMITTAL NUMBER
4/12/17
RECEIVED DATE

- ☐ A. No Exceptions Taken
No further review of submittal is required.
- ☒ B. Make Corrections Noted
Incorporate corrections in work; resubmission is not required.
- ☐ C. Revise and Resubmit
Revise as noted, and resubmit for review.
- ☐ D. Rejected
Submittal is not in compliance with Contract Documents; provide new submittal.
- ☐ E. For Record / Information Only
Submittal was reviewed for Record / Information purposes only.
- ☐ F. Not Required for Review
Submittal is not required by Contract Documents and has not been reviewed.

Review is for conformance with the design concept of this project and for general compliance with contract documents. Contractor is responsible for quantities, dimensions and compliance with contract documents and for information that pertains to fabrication processes, construction techniques and coordination of this work with all trades which will be affected thereby. This review is null and void if submittal deviates from contract documents and does not indicate or note deviations.

A/E COMMENTS

☐ See attached sheet(s) for additional comments

see marks - as indicated - close coordination is required with wood grill, building elements and installed mep.

Devin Gates

REVIEWED BY

4/12/17

DATE

Lynn Grossman


REVIEWED BY

Digitally signed by Lynn Grossman
DN: C=US, E=lgrossman@cannondesign.com, O=Cannon
Design, CN=Lynn Grossman
Date: 2017.04.20 18:15:03-05'00'

04.20.17

DATE

Paric to hold coordination meeting with framing supplier, installer, and wood wall installer to confirm all dimensions work prior to installation.

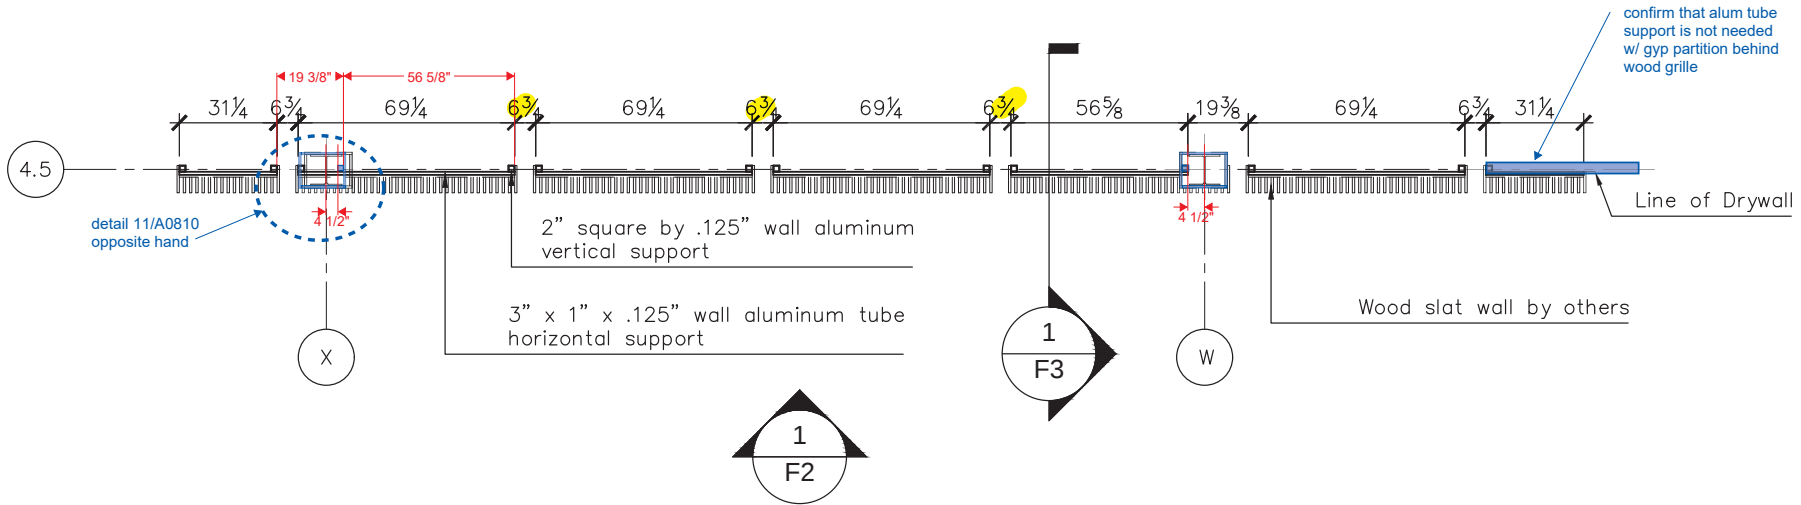

1/F1 Plan View Lecture Hall 160

GENERAL NOTES:
1. Aluminum to have powdercoated finish.



FOREMAN FABRICATORS INC.
Stainless Steel Aluminum Brass Steel
www.foremanfab.com
4605 McRee - St. Louis, MO. 63110
(314) 771-1717 Fax (314) 772-5991

Webster ISB
Paric
550 TURNER BLVD.
ST. LOUIS, MO. 63376
Aluminum Wall Frame at Lecture Hall

Job Number
170111-01
DRAWN
T-LOVELL
SCALE
As Noted
DATE
4/9/17
F1

081216 per a0810

level 01

varies

Varies


6

1 Section View
F3

F3

NOTES


- SUSPENSION SYSTEM TO BE INSTALLED PER LOCAL CODE AND SEISMIC REQUIREMENTS (BY THE SUBCONTRACTOR).
- SYSTEM WEIGHT: ~8LBS PER SQFT.

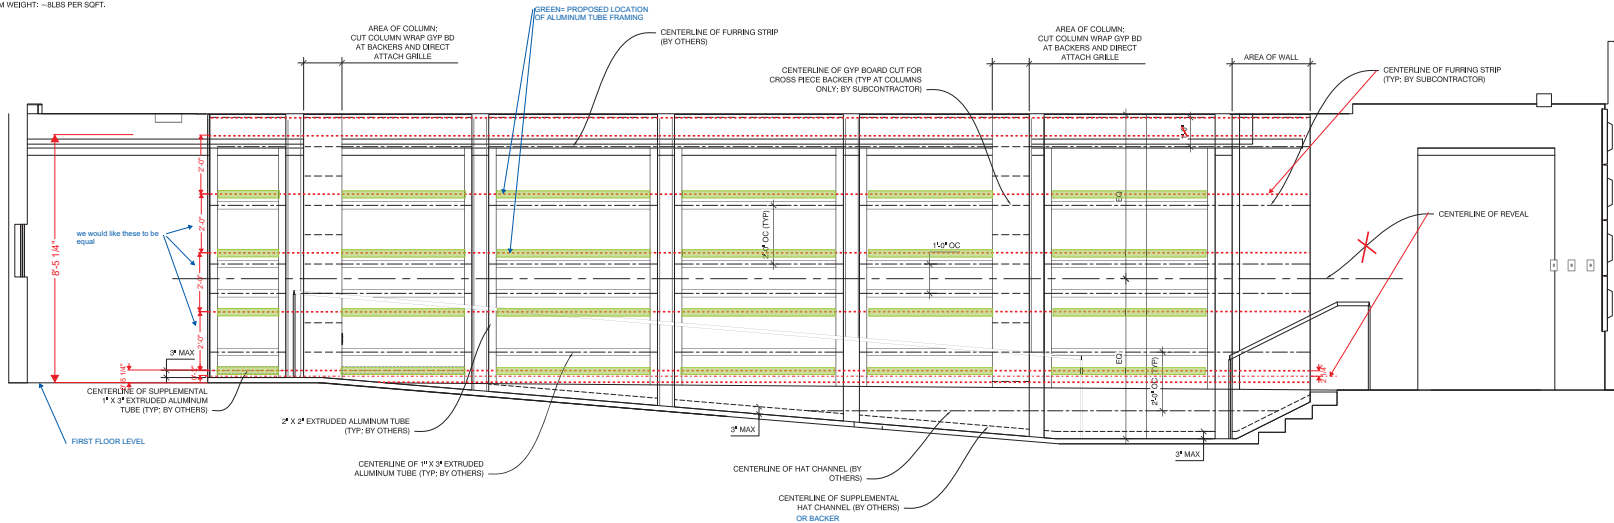

C1 SUSPENSION LAYOUT - LECTURE HALL 160
SCALE: 1/8" = 1'

NOTES

- UNLESS OTHERWISE NOTED, ALL DIMENSIONS ARE PULLED FROM WOOD TO WOOD AND NEED TO BE VERIFIED IN FIELD BY THE SUBCONTRACTOR PRIOR TO FABRICATION.

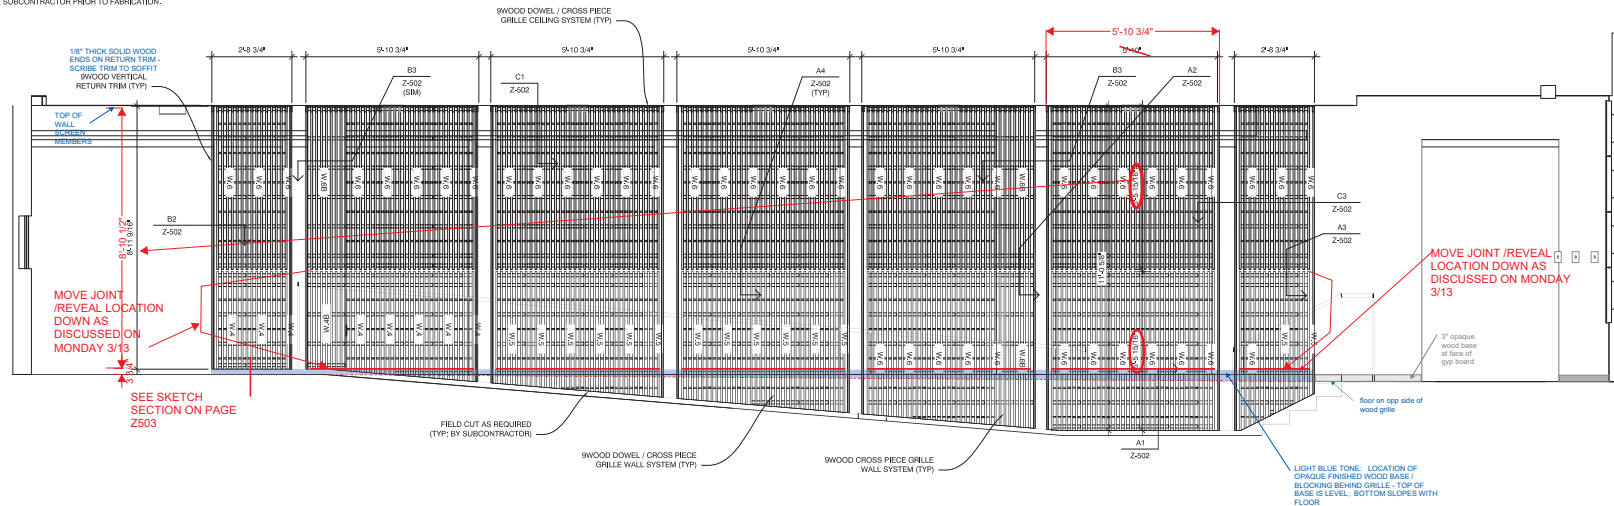

A1 INTERIOR ELEVATION - LECTURE HALL 160
SCALE: 1/8" = 1'



DIVISION 9 ENGINEERED-TO-ORDER WOOD CEILINGS

899 SOUTH A STREET
SPRINGFIELD, OR 97477

TOLL-FREE FACSIMILE
888.767.9990 888.767.9998

WWW.9WOOD.COM
ENGINEERING@9WOOD.COM

FSC CERTIFIED PROJECT: YES ☐ NO ☒

PROJECT
**WEBSTER U -
INTERDISCIPLINARY
SCIENCE BLDG**
WEBSTER GROVES, MISSOURI

PROJECT NUMBER: 14055
PROPOSAL NUMBER: 14055.P1.0

REVISION HISTORY

REV#	DATE	DESCRIPTION
10		
9		
8		
7		
6		
5		
4		
3		
2		
1		
0	02.21.17	RELEASE FOR APPROVALS

SHEET INFORMATION

DRAWING TYPE: SHOP DRAWINGS
DRAWN BY: MMC
STANDARDS REVIEW: RJB
TECHNICAL REVIEW: RJB & RLH

THIS DOCUMENT CONTAINS PROPRIETARY INFORMATION OF WOOD. INC.
CONFIDENTIAL AND TRADE SECRET. ALL RIGHTS RESERVED.

KEY NOTES

- 15/16" HEAVY DUTY T-BAR MAIN RUNNER (TYP: BY SUBCONTRACTOR)
- 15/16" T-BAR CROSS TEE (TYP: BY SUBCONTRACTOR)
- HANGER WIRE (TYP: BY SUBCONTRACTOR)
- WALL ANGLE AND APPROPRIATE INSTALLATION FASTENER (TYP: BY SUBCONTRACTOR)
- PERMETER CONDITION (TYP: BY OTHERS)

SHEET TITLE

**INTERIOR ELEVATION
AND SUSPENSION
LAYOUT**

Z-402
SHEET 4 OF 7