


ALL APPROVAL DRAWINGS MUST BE SIGNED AND RETURNED TO PROCESS THE ORDER
PRODUCT MAY NOT BE EXACTLY AS SHOWN

MAX. SINGLE AXLE LOAD

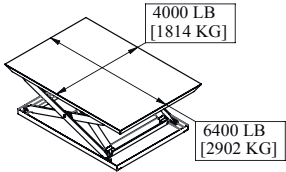

DOCK SUMMARY:

MODEL: ED8/72X96-1402 S3 (Tapered edges)
CAPACITY: 8000 LB
LOWERED HEIGHT: 14 IN
TRAVEL: 59 IN
RAISED HEIGHT: 73 IN
POWER PACK: 5HP 3PH INTERMITTENT DUTY
VOLTAGE: 440-480V /3PH /60HZ
SIDE A LIP: LIP WELD 60"W - 18"L - 8000#
ONE PIECE SPRING ASSIST
STEEL

LIP NOT REQUIRED

CONTROLS:

OPTIONS:

- WOG VALVE FOR EMERGENCY DOWN
- AUTO MECHANICAL SAFETY POP UP
- ELECTRIC TOE GUARD PROTECTION (OUTSIDE THE SAFETY SKIRTING)
- SIDE B: REMOVABLE & DECK MOUNTED RAILING
- SIDE D: REMOVABLE & DECK MOUNTED RAILING
- ACCORDION SAFETY SKIRTING
- SKIRTING ON SIDE(S): [A] [B] [D]
- INTERLOCKING SWING GATES WITH LOCKING LATCH
 - SIDE A: DECK MOUNTED
 - SIDE C: FLOOR MOUNTED AT UPPER LANDING
- ADJUSTABLE MAINTENANCE STAND
- WARNING HORN C/W ADJ. VOLUME CONTROL
- FLASHING AMBER BEACON LIGHT
- RETURN LINE OIL FILTER

PROVIDE ELECTRICALLY
INTERLOCKING GATES


- KEY SWITCH ON CONTROLS

FINISH:

- BLUE





STANDARD FEATURES:

- REMOTE NEMA 4 (WATER RESISTANT) PUSH-BUTTON ON 12FT CORD FROM POWER PACK.
- UL/CSA APPROVED.
- CHECKER DECK AND LIP.
- 42IN HIGH REMOVABLE GUARD RAILS WITH MID-RAIL 4IN KICK PLATE ON SIDES.
- HYDRAULIC (VELOCITY FUSE) FALL SAFE.
- UP TRAVEL LIMIT SWITCH NEMA 4X RATED (SET AT 59IN UNLESS SPECIFIED OTHERWISE).
- BUILT-IN, HINGED TO FRAME MAINTENANCE STOP.
- SAFETY STRIPING ON FOUR SIDES.
- FACTORY PRE-SET LOWERING SPEED FOR SAFE LOWERING OF TABLE WITH RATED LOAD.

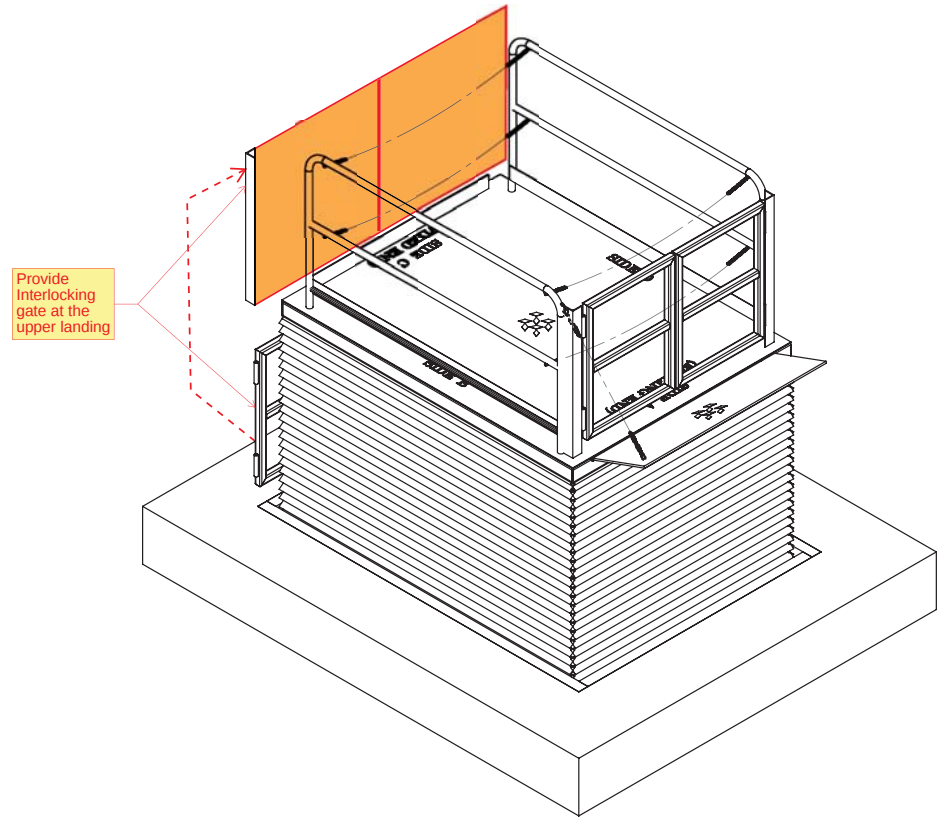

CUSTOMER APPROVAL FOR MANUFACTURING		THE INFORMATION CONTAINED HEREIN IS THE SOLE PROPERTY OF BLUE GIANT EQUIPMENT CORPORATION. ANY REPRODUCTION IN PART OR AS A WHOLE WITHOUT THE WRITTEN PERMISSION OF BLUE GIANT EQUIPMENT CORPORATION IS PROHIBITED.		CUSTOMER ROBERTS LOADING DOCK		BLUE GIANT®	
NAME: _____		UNLESS OTHERWISE SPECIFIED: DO NOT SCALE DRAWING DIMENSIONS ARE IN INCHES [mm] TOLERANCES APPLY AS SHOWN BELOW		JOB NAME			
SIGNATURE: _____		FRACTIONAL ANGLES ± 1/4 [6mm] ± 2°		ARCHITECT/CONTRACTOR		GENERAL ASSEMBLY	
DATE: _____		AFTER APPROVAL PLEASE RETURN THIS DRAWING TO BLUE GIANT		PREPARED BY Peter Parisotto			
				JOB NUMBER		SIZE B	
				THIRD ANGLE PROJECTION		DRAWING NO. CB-064882-02	
				DRAWN ConfigureBLUE 2/2/2016		SCALE 1:29	
				DATE		APPROXIMATE WEIGHT 6486.77 lbs	
						SHEET 1 OF 3	

ALL APPROVAL DRAWINGS MUST BE SIGNED AND RETURNED TO PROCESS THE ORDER

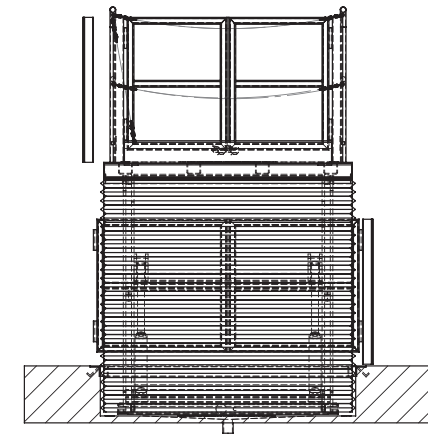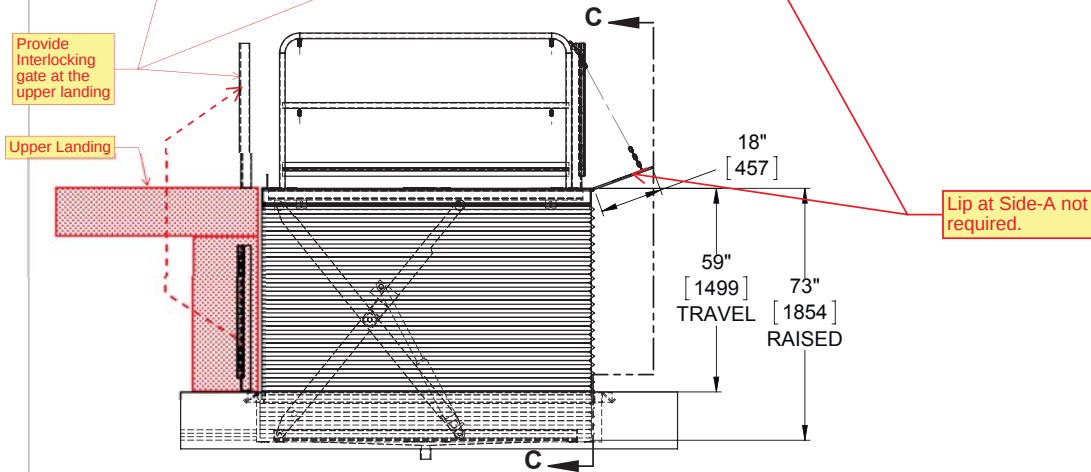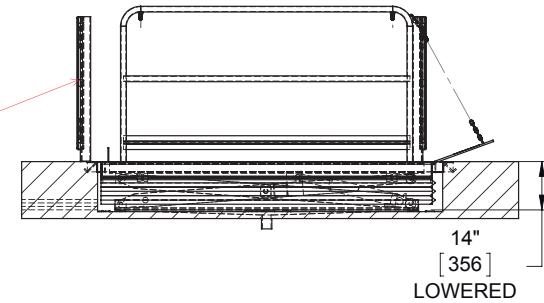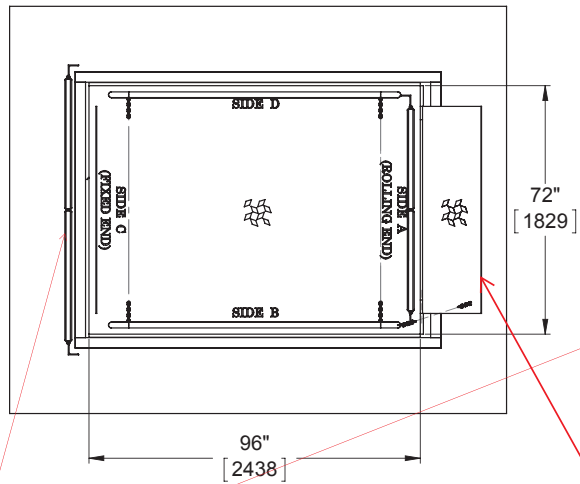


SECTION C-C

CUSTOMER APPROVAL FOR MANUFACTURING
 NAME: _____
 SIGNATURE: _____
 DATE: _____
 AFTER APPROVAL PLEASE RETURN THIS DRAWING TO BLUE GIANT

THE INFORMATION CONTAINED HEREIN IS THE SOLE PROPERTY OF BLUE GIANT EQUIPMENT CORPORATION. ANY REPRODUCTION IN PART OR AS A WHOLE WITHOUT THE WRITTEN PERMISSION OF BLUE GIANT EQUIPMENT CORPORATION IS PROHIBITED.

BLUE GIANT

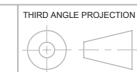

SIZE: _____ DRAWING NO:

B CB-064882-02-DOCK

SCALE: 1:36

WEIGHT:

lbs

SHEET 2 OF 3

SUBMITTAL IDENTIFICATION SHEET

To be completed by Contractor/CM

PROJECT NAME	
ADDRESS	
NUMBER	
OWNER	
ARCHITECT / ENGINEER	
SUBMITTED BY	
CONTRACTOR / CM SUBMITTAL NO.	CANNON DESIGN SUBMITTAL NO.
DRAWING / DETAIL REFERENCE	SPECIFICATION SECTION / PARAGRAPH
MANUFACTURER / SUPPLIER	ITEM / PRODUCT ID
REQUIRED DATE	PRIORITY
	☐ CRITICAL

ITEM BEING SUBMITTED (check only one)

- | | | |
|---|--|--|
| ☐ Shop Drawings | ☐ Certification / Qualifications | ☐ Coordination Drawing |
| ☐ Samples (____ copies) | ☐ Record Documents | ☐ Calculations |
| ☐ LEED Submittal | ☐ Product Data | ☐ Schedules |
| ☐ Other _____ | ☐ O&M Manuals | |

ITEM BEING SUBMITTED FOR (check only one)

- ☐ Action
 ☐ Information Only
 ☐ Record

REMARKS OR DEVIATIONS

CONTRACTOR / CM CERTIFICATION (SUBMITTALS NOT CERTIFIED WILL BE RETURNED WITHOUT REVIEW)



PARIC CORPORATION
SUBMITTAL STAMP

THIS SHOP DRAWING HAS BEEN REVIEWED BY PARIC CORPORATION

Subcontractor remains responsible for dimensions, quantities, coordination with other trades and compliance with contract documents.

By:

Devin D. Gates

REVIEWED BY	DATE

To be completed by Reviewer

CANNON DESIGN SUBMITTAL NUMBER
RECEIVED DATE
☐ A. No Exceptions Taken No further review of submittal is required.
☐ B. Make Corrections Noted Incorporate corrections in work; resubmission is not required.
☐ C. Revise and Resubmit Revise as noted, and resubmit for review.
☐ D. Rejected Submittal is not in compliance with Contract Documents; provide new submittal.
☐ E. For Record / Information Only Submittal was reviewed for Record / Information purposes only.
☐ F. Not Required for Review Submittal is not required by Contract Documents and has not been reviewed.

Review is for conformance with the design concept of this project and for general compliance with contract documents. Contractor is responsible for quantities, dimensions and compliance with contract documents and for information that pertains to fabrication processes, construction techniques and coordination of this work with all trades which will be affected thereby. This review is null and void if submittal deviates from contract documents and does not indicate or note deviations.

A/E COMMENTS

☐ See attached sheet(s) for additional comments

REVIEWED BY	DATE



77 Westport Plaza
Suite 250
St. Louis, MO 63146

TRANSMITTAL

No. 15051-0028

Paric Corporation

PROJECT: Webster University Interdisciplinary Science Building

DATE: 04/29/2016

TO: Cannon Design
1100 Clark Ave
St Louis MO 63102

RE: Loading dock product data

ATTN: Kelvin Patel

JOB: 15051

WE ARE SENDING:		SUBMITTED FOR:	ACTION TAKEN:
☐ Shop Drawings		☒ Approval	☐ Approved as Submitted
☐ Letter		☐ Your Use	☐ Approved as Noted
☐ Prints		☐ As Requested	☐ Returned After Loan
☐ Change Order		☐ Review and Comment	☐ Resubmit
☐ Plans			☐ Submit
☐ Samples		SENT VIA:	☐ Returned
☐ Specifications			☐ Returned for Corrections
☐ Other:			☐ Due Date:

<i>Item</i>	<i>Package</i>	<i>Code</i>	<i>Rev.</i>	<i>Copies</i>	<i>Date</i>	<i>Description</i>	<i>Status</i>
Submittal		111319-003	1		04/29/2016	Loading dock product data	Open

NOTES:

CC:

Signed: _____
Devin Gates