




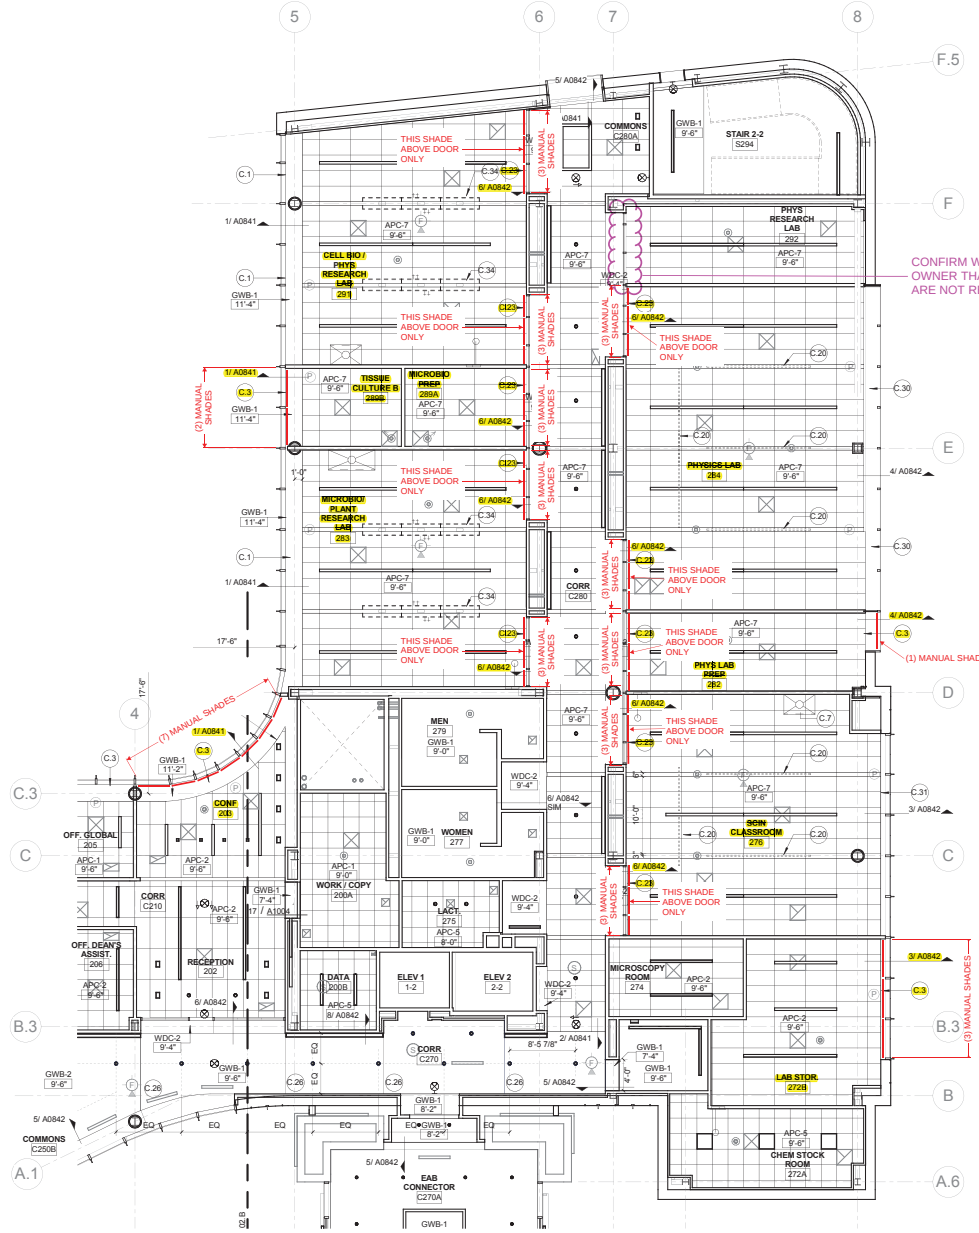


LEVEL 02- AREA A FLOOR PLAN

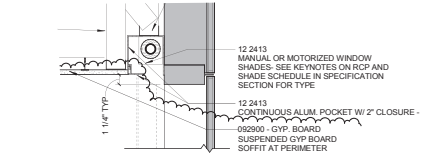


PERIMETER GYP BOARD POCKET W/ SHADE
(TYP. ROOMS: 203 & 289B)
122413 TYPE 3 SHADES: MANUAL SHADES IN RECESSED POCKET

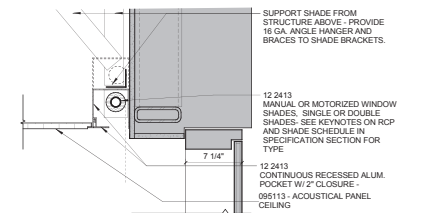

RECESSED SHADE - EAST SIDE
(TYP. ROOMS: 272B)
122413 TYPE 3 SHADES: MANUAL SHADES IN RECESSED POCKET


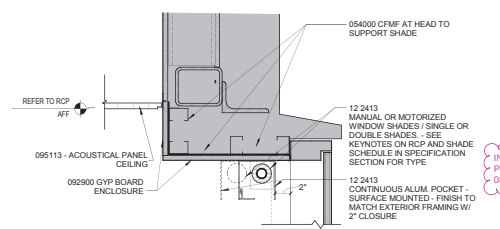


PROJECTED WINDOW SHADE - EAST SIDE
(TYP. ROOM: 282)
122413 TYPE 3 SHADES: MANUAL SHADES IN RECESSED POCKET

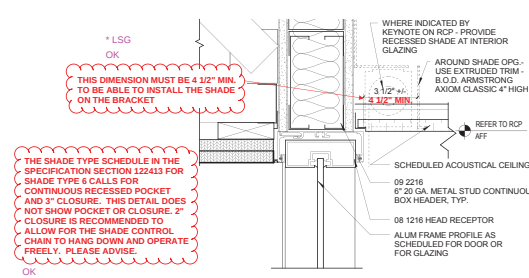


WOOD SOFFIT DETAIL @ INTERIOR
(TYP. ROOMS: 283, 289A, 291, 276, 282, 284 INTERIOR WINDOWS ONLY)
122413 TYPE 6 SHADES: MANUAL SHADES IN RECESSED POCKET AT INTERIOR GLAZING, POCKET CONTINUOUS ACROSS OPENING


Interdisciplinary Science Building

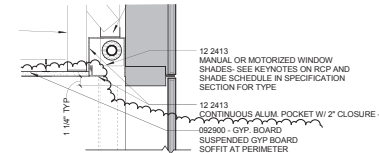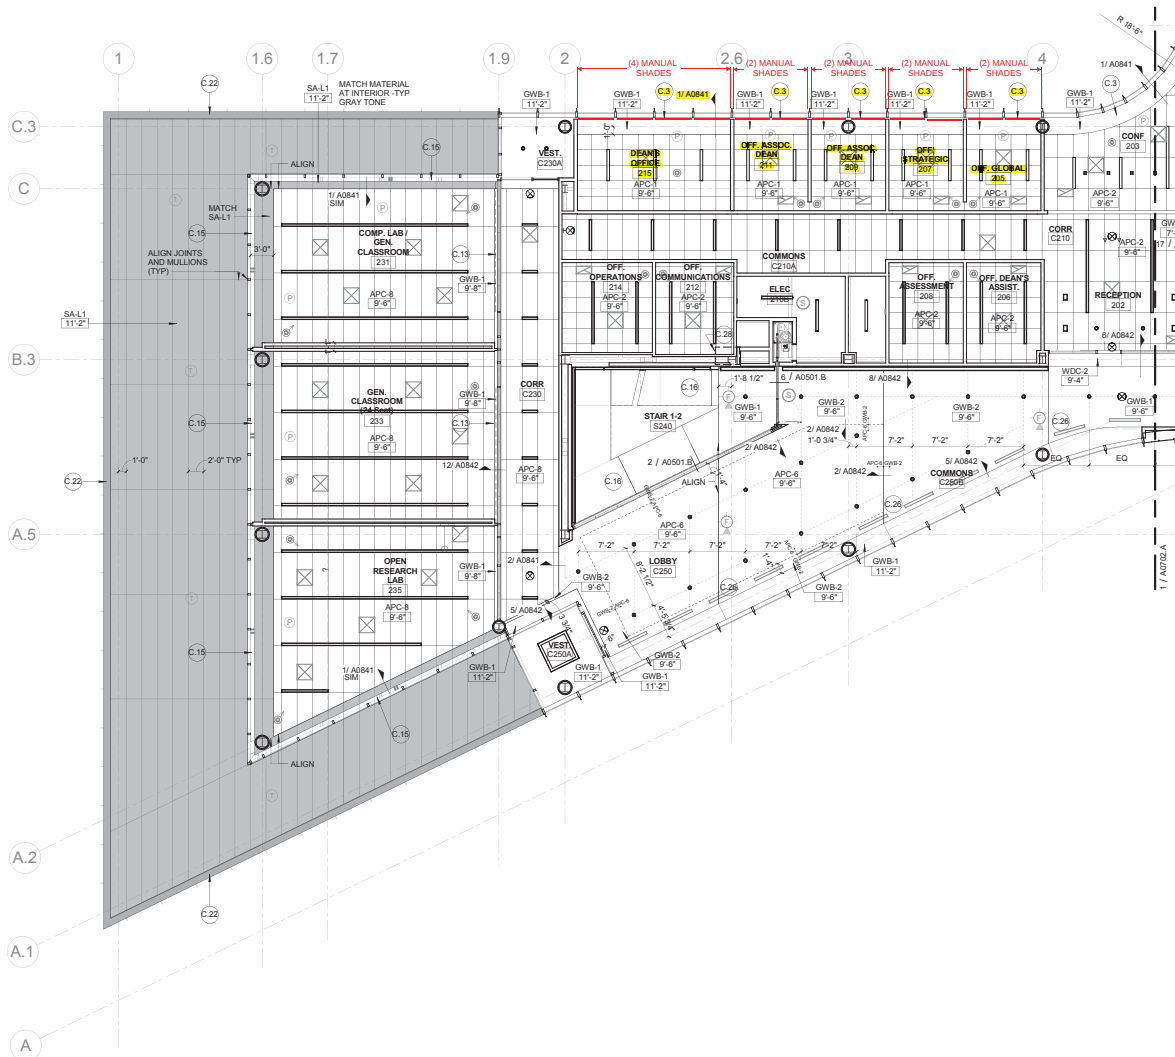

1 PERIMETER GYP BOARD POCKET W/ SHADE
1 1/2" = 1'-0"
(TYP. ROOMS: 205, 207, 209, 211 & 215)
C.3 122413 TYPE 3 SHADES: MANUAL SHADES IN RECESSED POCKET

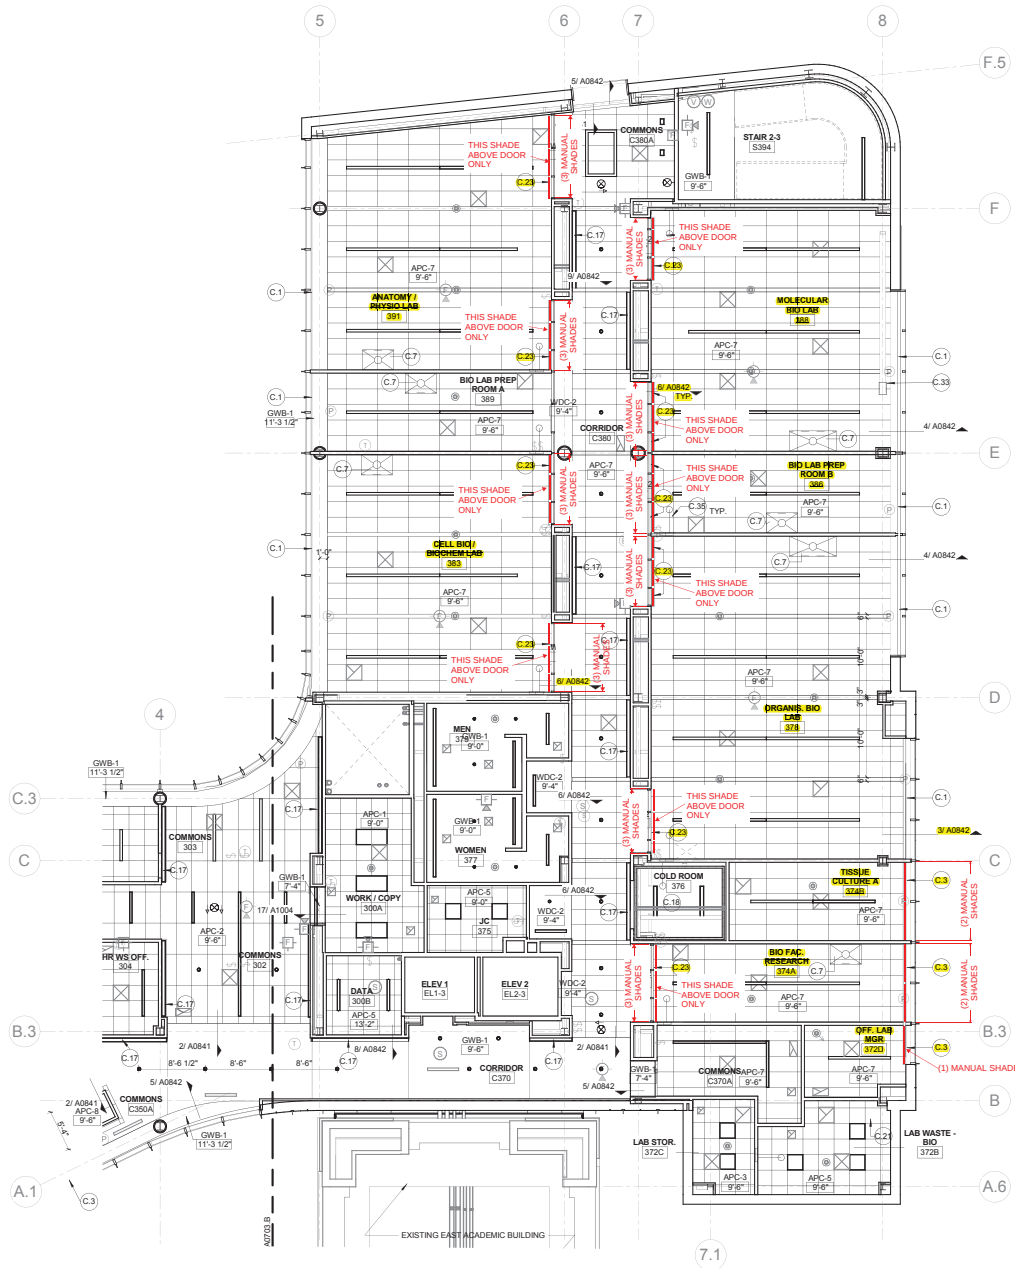


LEVEL 03 AREA A - NORTH FLOOR PLAN

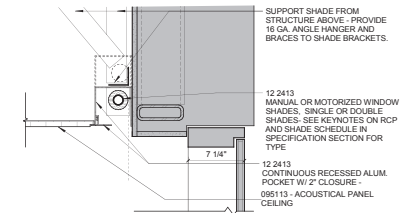

RECESSED SHADE - EAST SIDE

(TYP. ROOMS: 372D, 374A, 374B)

C.3 122413 TYPE 3 SHADES: MANUAL SHADES IN RECESSED POCKET

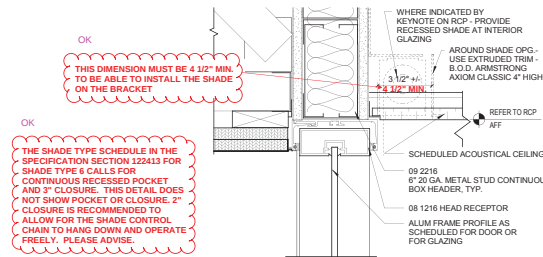

OK
THIS DIMENSION MUST BE 4 3/2\"/>

WOOD SOFFIT DETAIL

(TYP. ROOMS: 374A, 378, 383, 386, 388 & 391 INTERIOR WINDOWS ONLY)

C.23 122413 TYPE 6 SHADES: MANUAL SHADES IN RECESSED POCKET AT INTERIOR GLAZING. POCKET CONTINUOUS ACROSS OPENING



9 SUNNEN DRIVE, SUITE 100
ST. LOUIS, MO 63143

314-300-5900 MAIN
314-644-5007 FAX

WWW.INTERIORINVESTMENTS.COM

Interdisciplinary Science
Building

Webster
UNIVERSITY

Sheet Title:
**THIRD FLOOR AREA 'A'
MANUAL WINDOW SHADES**

Project Number: _____ Sheet Number:
Drawn By: _____
Issue Date: _____ **3 OF 6**

4 OF 6






Webster
UNIVERSITY


Project Number: _____
 Sheet Number: _____
 Drawn By: _____
 Issue Date: _____



**Interdisciplinary Science
Building**

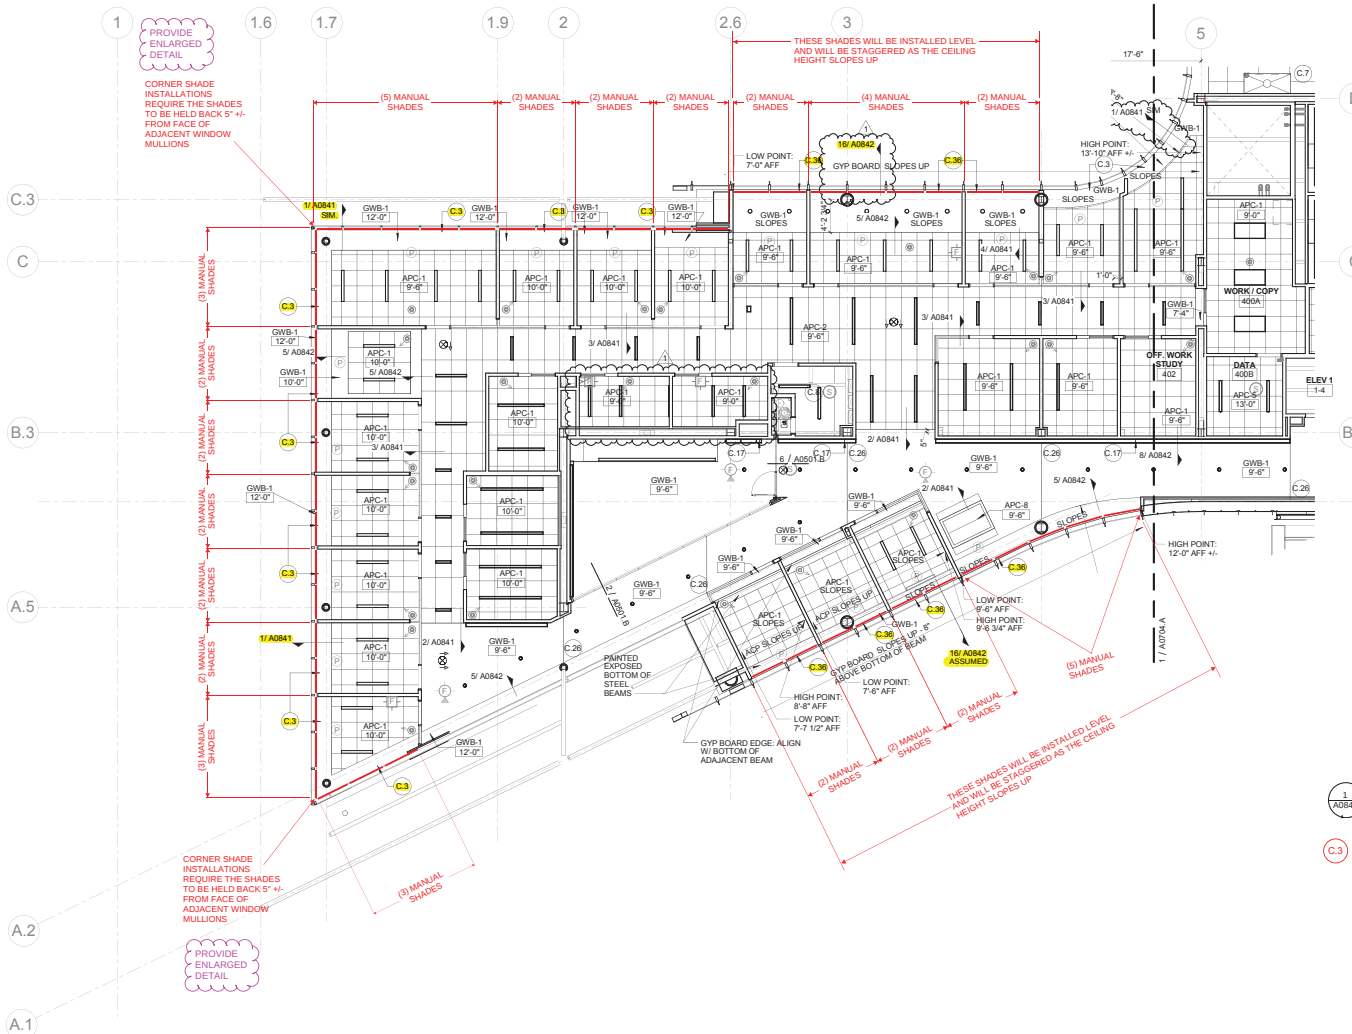


LEVEL 04 AREA B - WEST FLOOR PLAN

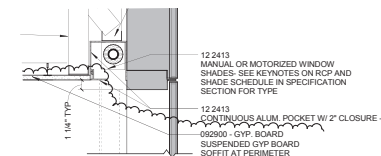

1 PERIMETER GYP BOARD POCKET W/ SHADE
1 1/2\"/>

(TYP. ROOMS: 413, 415, 417, 419, 431, 433, 435, 437, 439, 441)
122413 TYPE 3 SHADES: MANUAL SHADES IN RECESSED POCKET

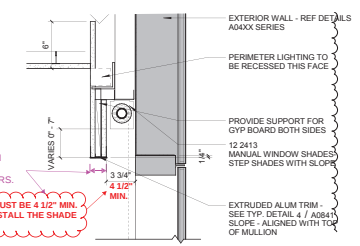

16 PERIMETER GYP BOARD LEVEL 04 AREA B
1 1/2\"/>

(TYP. ROOMS: 405, 407, 411, 452, 454, 456, C450A)
122413 TYPE 3 SHADES: MANUAL SHADES - STEPPED WITH SLOPE IN CONT. SLOPED OPENING

OK. COORDINATE & REVISE TRIM DIMENSION IF THERE ARE CONFLICTS WITH COLUMN COVERS.

THIS DIMENSION MUST BE 4 1/2\"/>



77 Westport Plaza
Suite 250
St. Louis, MO 63146

TRANSMITTAL

No. 15051-0410

Paric Corporation

PROJECT: 15051-Webster University Interdisciplinary Science Building

DATE: 12/27/2016

TO: Cannon Design
1100 Clark Ave
St Louis MO 63102

Fax;
314-241-2203

RE: manual roller window shades shop drawings

ATTN: Kelvin Patel

JOB: 15051

WE ARE SENDING:	SUBMITTED FOR:	ACTION TAKEN:
☒ Shop Drawings	☒ Approval	☐ Approved as Submitted
☐ Letter	☐ Your Use	☐ Approved as Noted
☐ Prints	☐ As Requested	☐ Returned After Loan
☐ Change Order	☐ Review and Comment	☐ Resubmit
☐ Plans		☐ Submit
☐ Samples	SENT VIA:	☐ Returned
☐ Specifications	☐ Attached	☐ Returned for Corrections
☐ Other:	☐ Separate Cover Via:	☒ Due Date: 12/07/2016

Item	Package	Code	Rev.	Copies	Date	Description	Status
Submittal		122413-002	1		12/27/2016	manual roller window shades shop drawings	Submitted

NOTES:

CC:

Signed: _____
Devin Gates