



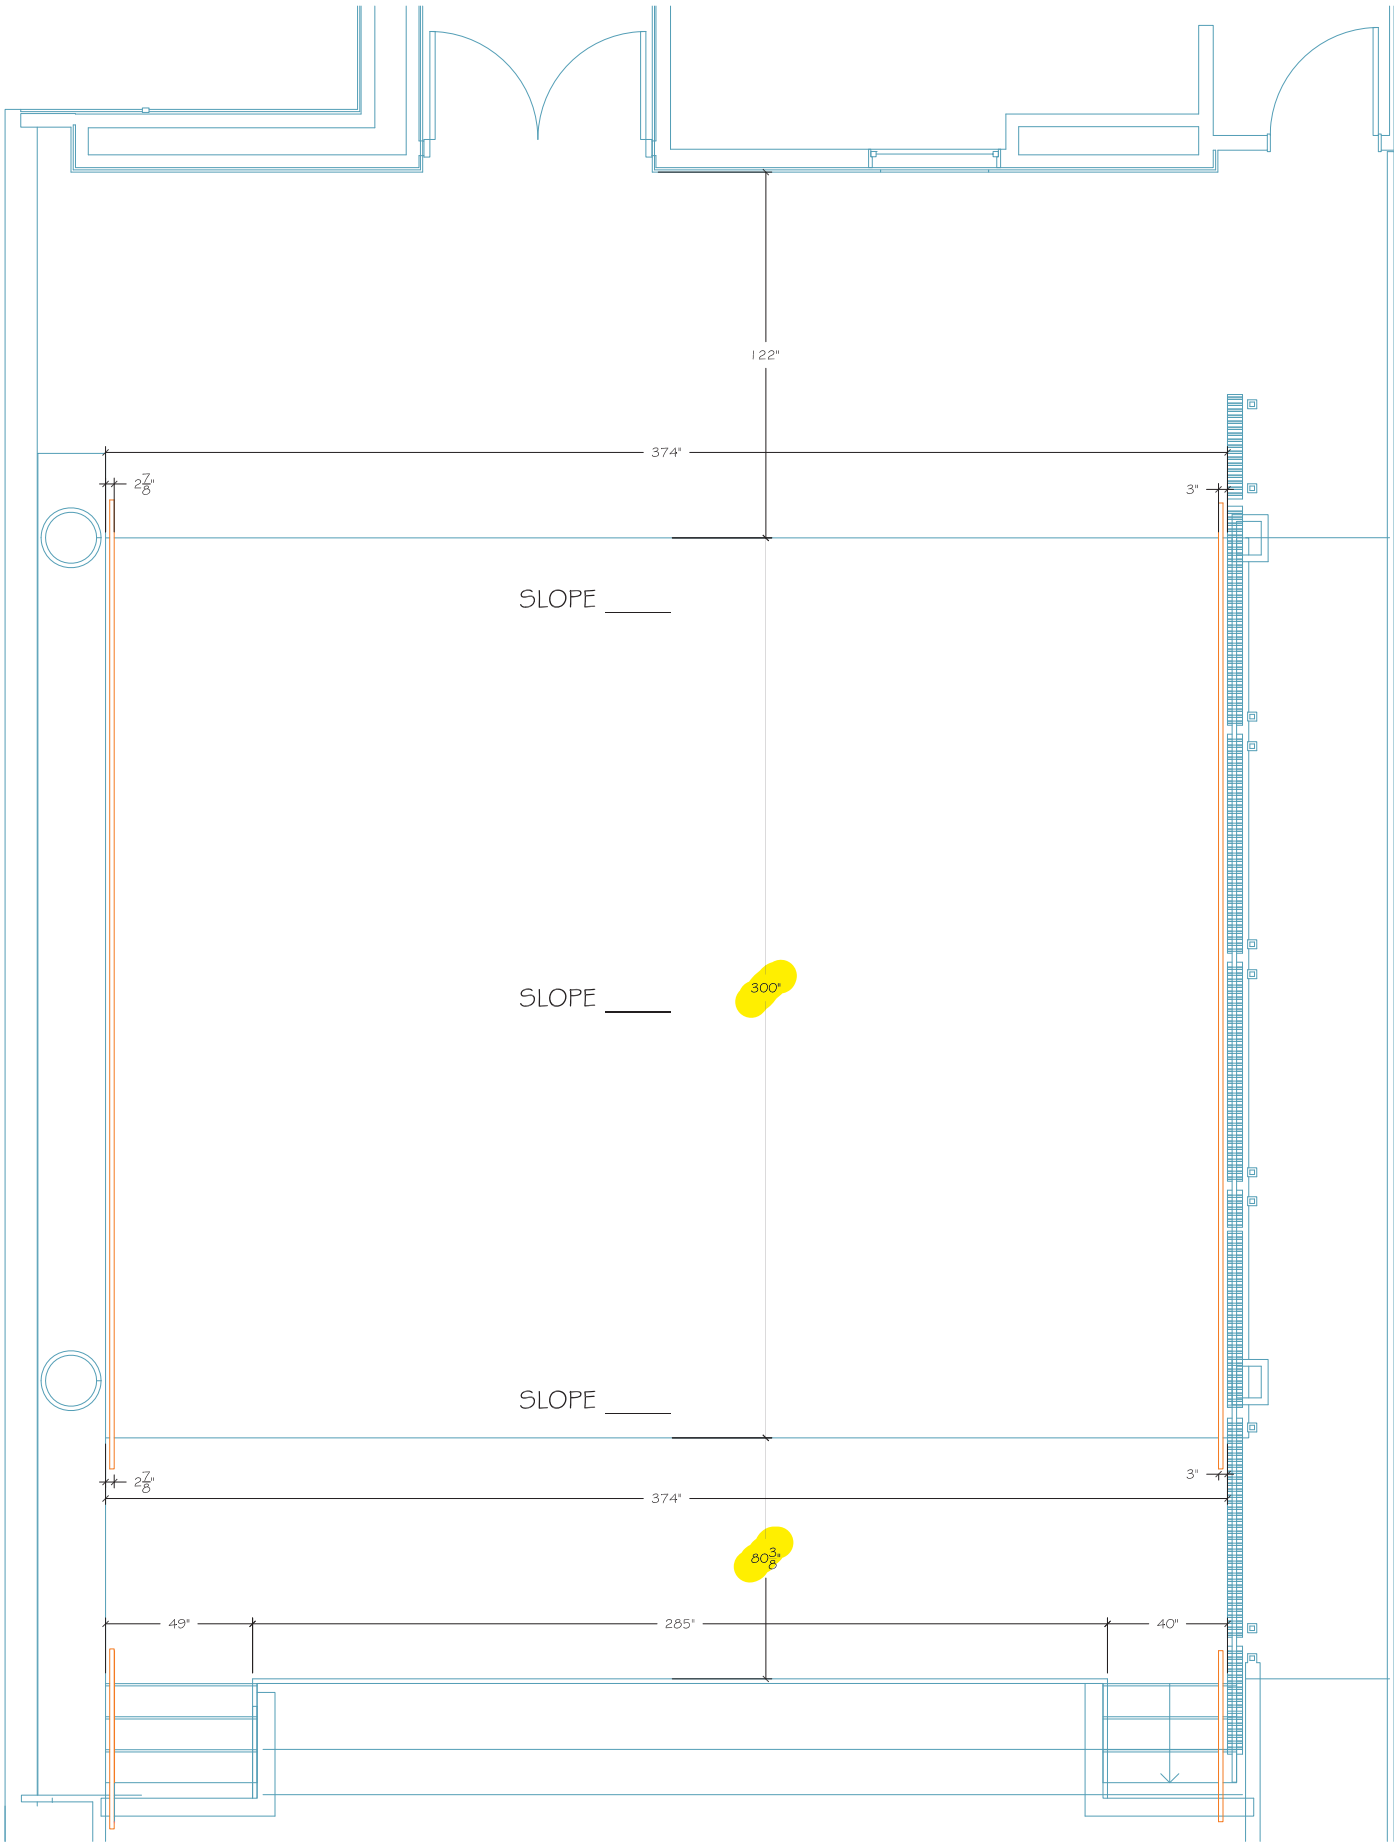

slope is 1:12 per A0202.

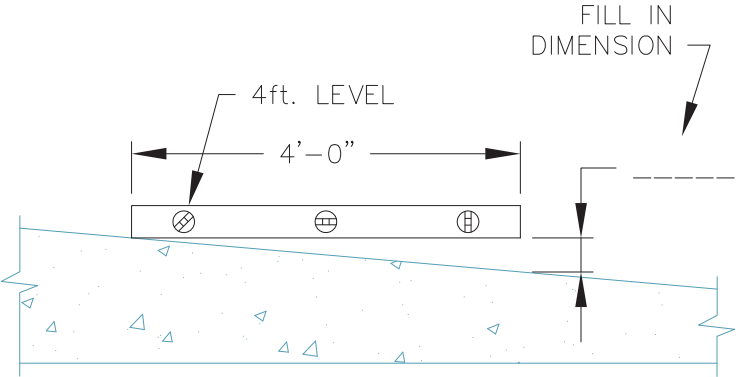

SLOPED FLOOR MEASUREMENT

METHOD #1: USE INCLINOMETER TO INDICATE SLOPE.
METHOD #2: USE A 4ft. LEVEL AND MEASURE THE DISTANCE FROM END OF LEVEL TO FLOOR.

PHOTOGRAPH OVERALL ROOM FROM A VARIETY OF ANGLES. ALSO DETAIL SHOTS OF ITEMS AFFECTING INSTALLATION SUCH AS STUB-UPS.
NOTE FLOOR CONSTRUCTION (CONCRETE, WOOD, ETC) _____

FIELD CHECK REQUIREMENTS

*ALL ROOM MEASUREMENTS MUST BE VERIFIED O.K.
OR CROSSED-OUT & CHANGED TO THE CORRECT DIMENSION.

FIELD CHECK PERFORMED BY:

SIGNATURE: _____
TITLE: _____
DATE: _____


PROPERTY OF SEDIA SYSTEMS
Reproduction or disclosure to third parties
without written consent of Sedia Systems
THIS DRAWING IN DESIGN AND DETAIL
IS THE PROPERTY OF SEDIA SYSTEMS
AND MUST NOT BE USED EXCEPT IN
CONNECTION WITH OUR WORK.
ALL RIGHTS OF DESIGN OR
INVENTION ARE RESERVED.

DESCRIPTION:
FIELD CHECK REQUIREMENTS

REVISION

DRAWN: E. KRUEGER	DATE: 9/18/16
SCALE: 3/8"=1'-0"	SHEET No.: 1 of 1
PROJECT: WEBSTER U. SCIENCE	
DRAWING: FC-1604030-01	SIZE: D


sedia systems
1820 W. HUBBARD, SUITE 300
CHICAGO, IL 60622
PH: 312-212-8010
FX: 312-226-1199


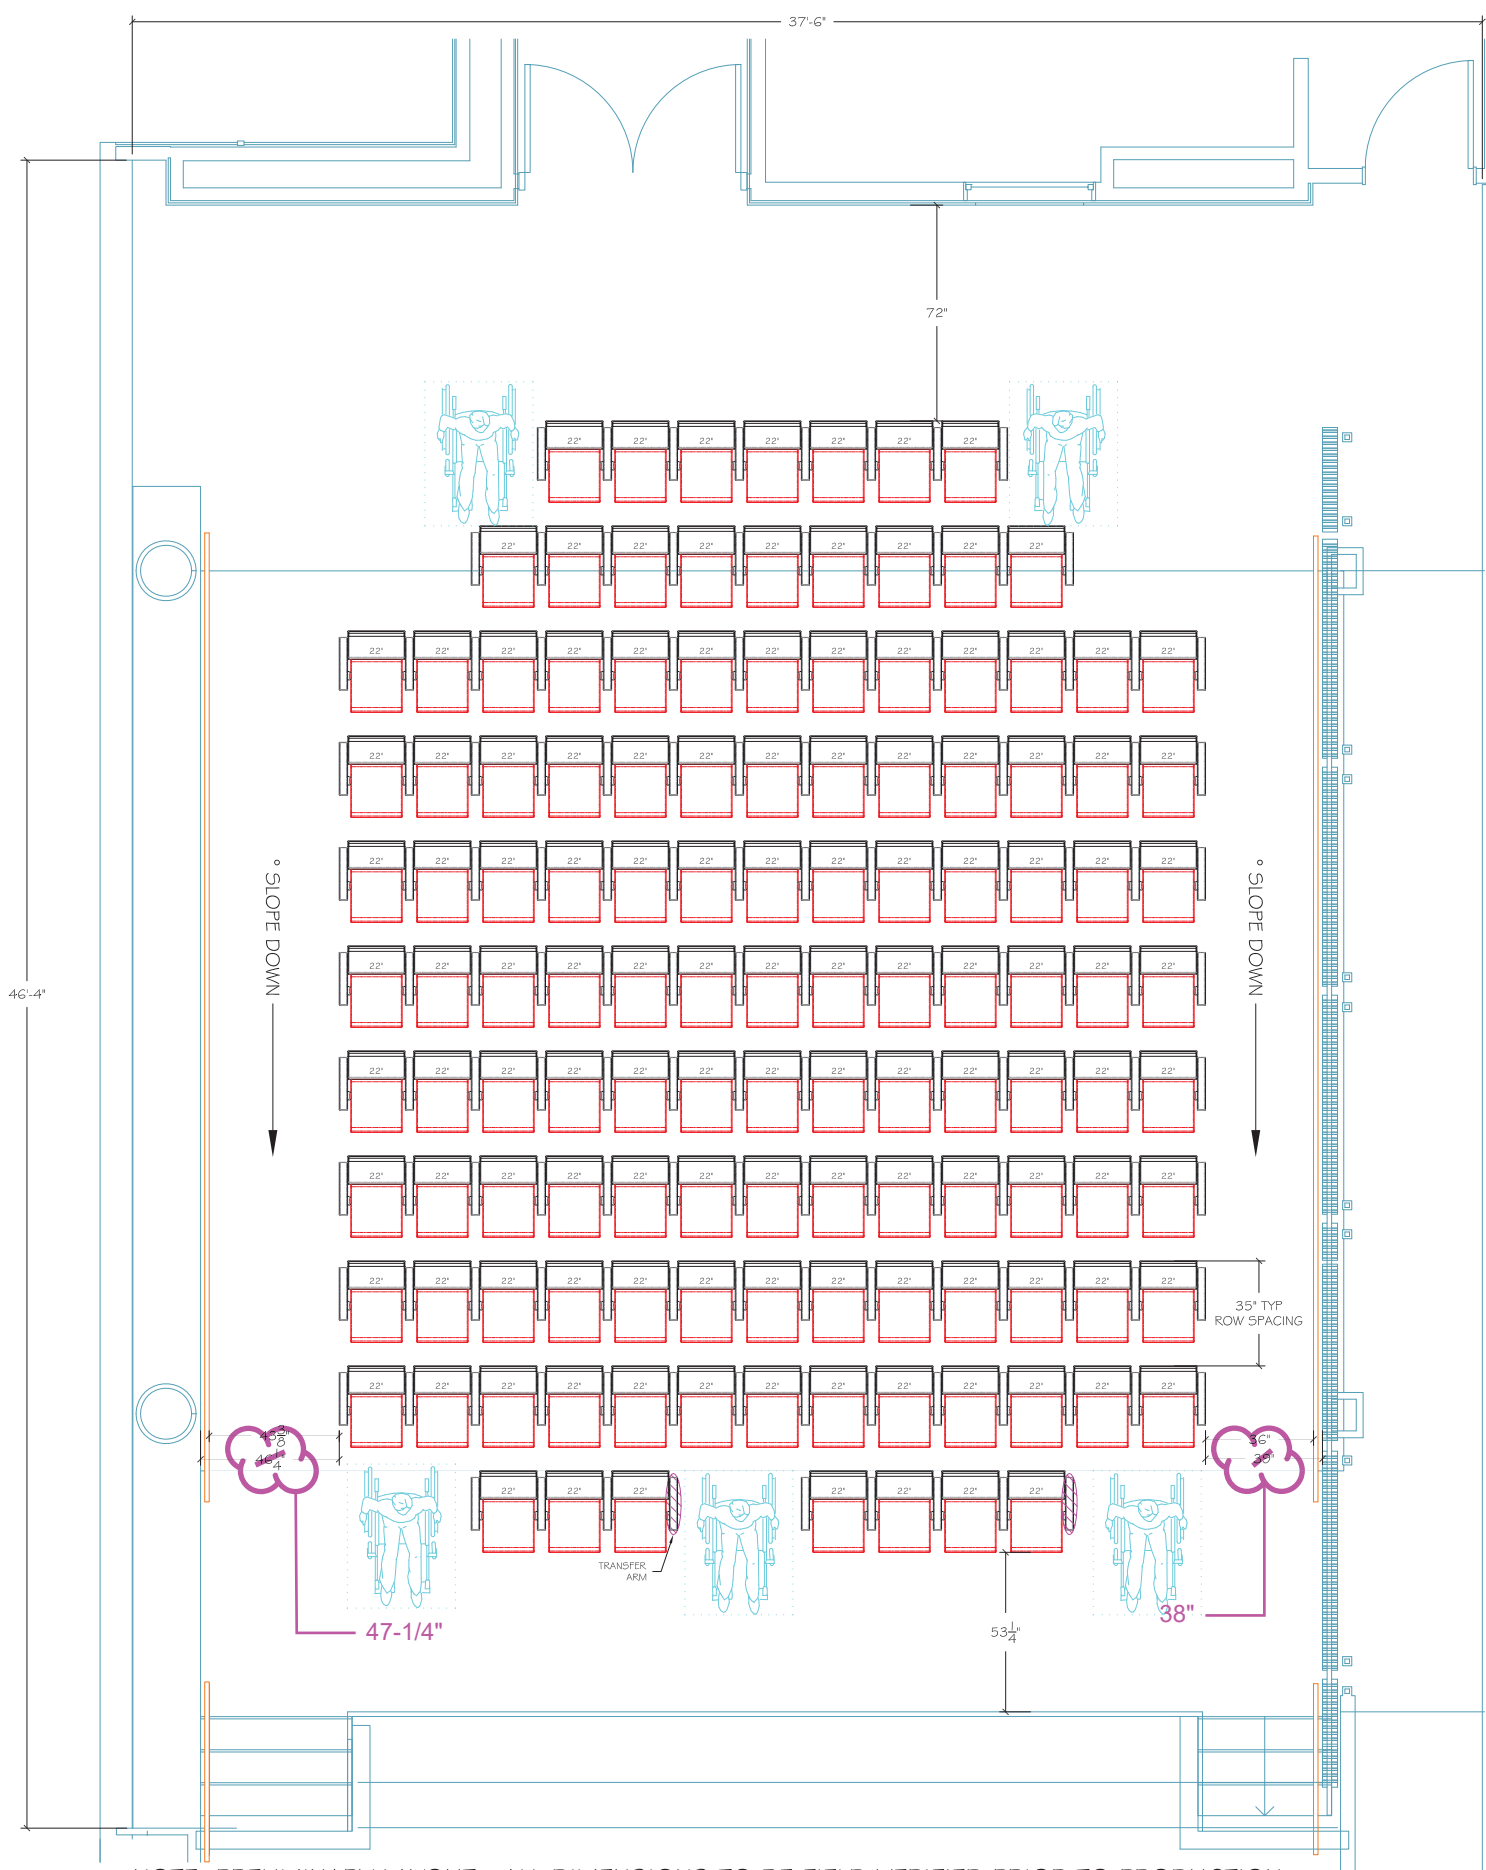


NOTE: PRELIMINARY LAYOUT. ALL DIMENSIONS TO BE FIELD VERIFIED PRIOR TO PRODUCTION.
LAYOUT BASED ON PROJECT DOCUMENT " - Floor Plan - AO202_I_LEVEL 01 - AREA B - LECTURE HALL AV-2"

132 TOTAL POSITIONS
127 J30 POSITIONS
5 ADA LOCATIONS, CHAIRS NOT PROVIDED BY SEDIA SYSTEMS

APPROVAL / SIGN-OFF	
☐	- APPROVED NO CHANGES
☐	- CHANGE AS NOTED \$ RE-SUBMIT
APPROVAL SIGNATURE: _____	
TITLE: _____	
DATE: _____	

J30 ELEVATION

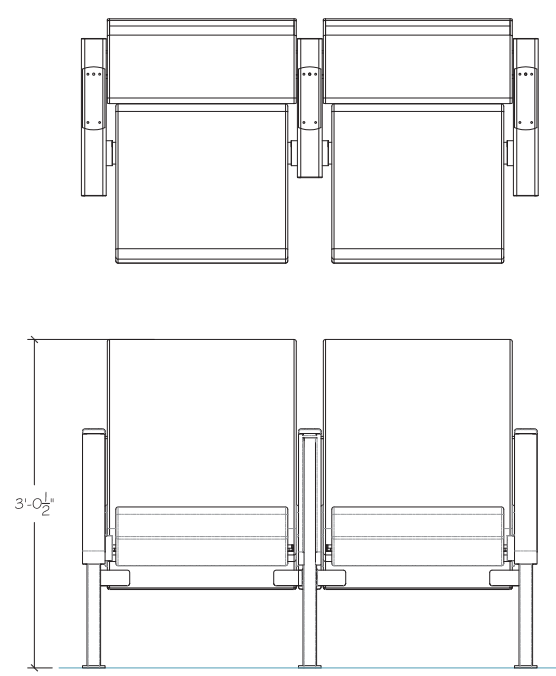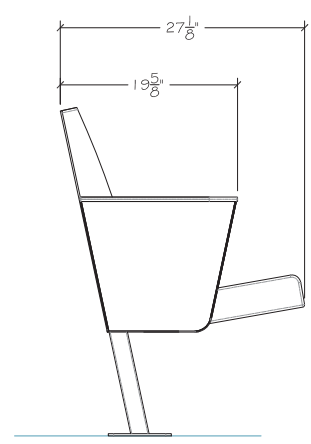

PROPERTY OF SEDIA SYSTEMS
Reproduction or disclosure to third parties
in any form or by any means without
written consent of SEDIA SYSTEMS
THIS DRAWING IN DESIGN AND DETAIL
IS THE PROPERTY OF SEDIA SYSTEMS
AND MUST NOT BE USED EXCEPT IN
CONNECTION WITH OUR WORK.
ALL RIGHTS OF DESIGN OR
INVENTION ARE RESERVED.

DESCRIPTION:
J30 AUDITORIUM SEATING

1
REVISION

DRAWN: E. KRUEGER	DATE: 9/19/16
SCALE: 3/8"=1'-0"	SHEET No: 1 of 1
PROJECT: WEBSTER U. SCIENCE	
DRAWING: SS-1604030-01	SIZE: D


sediasystems
1820 W. HUBBARD, SUITE 300
CHICAGO, IL 60622
PH: 312-212-8010
FX: 312-226-1199

132 TOTAL POSITIONS
127 J30 POSITIONS
5 ADA LOCATIONS, CHAIRS NOT PROVIDED BY SEDIA SYSTEMS

APPROVAL / SIGN-OFF

☐

- APPROVED NO CHANGES

☐




- CHANGE AS NOTED
\$ RE-SUBMIT

APPROVAL SIGNATURE:

TITLE:

DATE:

J30 ELEVATION

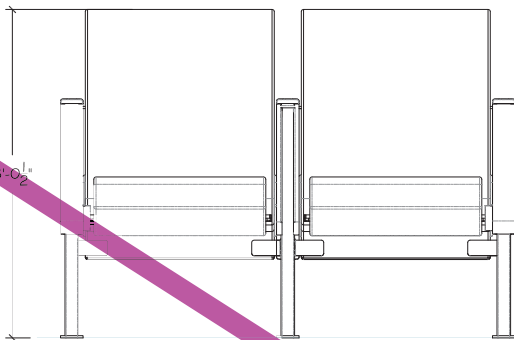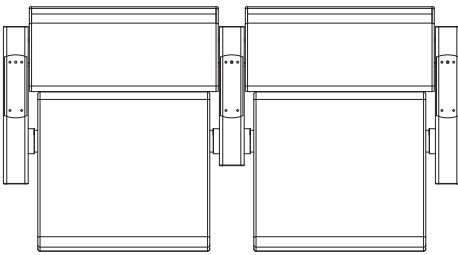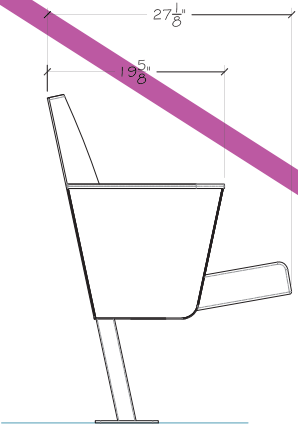

NOTE: PRELIMINARY LAYOUT. ALL DIMENSIONS TO BE FIELD VERIFIED PRIOR TO PRODUCTION.
LAYOUT BASED ON PROJECT DOCUMENT "I- Floor Plan - AO202_I_LEVEL 01 - AREA B - LECTURE HALL AV-2"

PROPERTY OF SEDIA SYSTEMS
Reproduction or disclosure to third parties
in any form or by any means without
written consent of Sedia Systems is prohibited.
THIS DRAWING IN DESIGN AND DETAIL
IS THE PROPERTY OF SEDIA SYSTEMS
AND MUST NOT BE USED EXCEPT IN
CONNECTION WITH OUR WORK.
ALL RIGHTS OF DESIGN OR
INVENTION ARE RESERVED.

DESCRIPTION:
J30 AUDITORIUM SEATING

2
REVISION

DRAWN: E. KRUEGER	DATE: 9/19/16
SCALE: 3/8"=1'-0"	SHEET No.: 1 of 1
PROJECT: WEBSTER U. SCIENCE	
DRAWING: SS-1604030-01	SIZE: D


sedia systems
1820 W. HUBBARD, SUITE 100
CHICAGO, IL 60622
PH: 312-212-8010
FX: 312-226-1199



PARIC
EXPERIENCE. EXCELLENCE.

77 Westport Plaza
Suite 250
St. Louis, MO 63146

TRANSMITTAL

No. 15051-0342

Paric Corporation

PROJECT: 15051-Webster University Interdisciplinary Science Building

DATE: 11/28/2016

TO: Cannon Design
1100 Clark Ave
St Louis MO 63102

RE: Sedia Seating Shop Drawings

ATTN: Kelvin Patel

JOB: 15051

WE ARE SENDING:		SUBMITTED FOR:	ACTION TAKEN:
☒ Shop Drawings		☒ Approval	☐ Approved as Submitted
☐ Letter		☐ Your Use	☐ Approved as Noted
☐ Prints		☐ As Requested	☐ Returned After Loan
☐ Change Order		☐ Review and Comment	☐ Resubmit
☐ Plans			☐ Submit
☐ Samples		SENT VIA:	☐ Returned
☐ Specifications			☐ Returned for Corrections
☐ Other:			☐ Due Date:

Item	Package	Code	Rev.	Copies	Date	Description	Status
Submittal		126100-005	2		11/28/2016	Sedia Seating Shop Drawings	Submitted

NOTES:

CC:

Signed: _____
Devin Gates



PARIC
EXPERIENCE. EXCELLENCE.

77 Westport Plaza
Suite 250
St. Louis, MO 63146

TRANSMITTAL

No. 15051-0332

Paric Corporation

PROJECT: 15051-Webster University Interdisciplinary Science Building

DATE: 11/17/2016

TO: Cannon Design
1100 Clark Ave
St Louis MO 63102

RE: Sedia Seating Shop Drawings

ATTN: Kelvin Patel

JOB: 15051

WE ARE SENDING:	SUBMITTED FOR:	ACTION TAKEN:
☒ Shop Drawings	☒ Approval	☐ Approved as Submitted
☐ Letter	☐ Your Use	☐ Approved as Noted
☐ Prints	☐ As Requested	☐ Returned After Loan
☐ Change Order	☐ Review and Comment	☐ Resubmit
☐ Plans		☐ Submit
☐ Samples	SENT VIA:	☐ Returned
☐ Specifications	☐ Attached	☐ Returned for Corrections
☐ Other:	☐ Separate Cover Via:	☐ Due Date:

Item	Package	Code	Rev.	Copies	Date	Description	Status
Submittal		126100-005		1		Sedia Seating Shop Drawings	Submitted

NOTES:

CC:

Signed: _____
Devin Gates