

Architect's Supplemental Instructions

Architect's Project No:
04561.01

Architect's ASI No: 003

Project:
Webster University
Interdisciplinary Science
Building

Date Issued: 08/01/2016

Contract Date:

Reason Code: 05 A/E Scope

Discipline Code: 07 General/Architectural
13 Structural

St. Louis
Baltimore
Boston
Buffalo
Calgary
Chicago
Houston
Los Angeles
Mumbai
New York
Phoenix
San Francisco
Shanghai
Toronto
Vancouver
Victoria
Washington DC

Owner:
Webster University

Architect:
Cannon Design
1100 Clark Avenue
St. Louis, MO 63102

Contractor:
Paric Construction

Contract For: General Construction

The Work shall be carried out in accordance with the following supplemental instructions issued in accordance with the Contract Documents without change in Contract Sum or Contract Time. Indicate your acceptance of these instructions for minor change to the Work as consistent with the Contract Documents and return a copy to the Architect within fourteen (14) business days of the date of issuance of these instructions. If you feel a change in Contract Sum or Contract Time is warranted, please submit an itemized quotation for the changes for approval within fourteen (14) business days of the date of issuance of these instructions prior to proceeding on the Work. Proceeding with the Work in accordance with these instructions indicates your acknowledgement that there will be no change.

Attachments:

Drawings:

S004, A0505, A0506, A0507.A, A0507.B, A0508.A, A0508.B, A0508.C,
A0508.D A0508.E, A0509.A, A0509.B

1100 Clark Avenue
St. Louis, Missouri
63102
T: 314.241.6250
F: 314.241.2570
www.cannondesign.com

Reason Codes:
#1. Jurisdictional Agency
#2. Constructor Driven
#3. Document Inconsistency
#4. Fast Track Driven
#5. A/E Scope
#6. Owners Scope
#7. Unforeseeable Conditions
#8. Other

Discipline Codes
#1. Demo-demolition
#2. Div1-Division 1 items on the spec book
(this item is not used)
#3. Electrical
#4. Elevator
#5. Equipment (Changes in equipment,
Owner Purchased)
#6. Fire Protection

Discipline Codes
#7. General Construction (Architectural)
#8. General Conditions (Div. 1)
#9. HVAC
#10. Other
#11. Plumbing
#12. Site Work/Landscaping
#13. Structural

Architect's Supplemental Instructions

Page 2

Description:

Please submit an itemized proposal for changes in contract Sum and Contract Time for proposed modifications to the Contract Documents described herein:


1. Description and detailing of site walls and retaining walls.

Issued by Architect: Lynn Grossman, CannonDesign

Accepted by Contractor:

GRADE BEAM NOTES

1. PROVIDE STANDARD HOOKS FOR TOP & BOTTOM BARS AS INDICATED AT SUPPORTS
2. PROVIDE CORNER BARS AT INTERSECTING GRADE BEAMS.

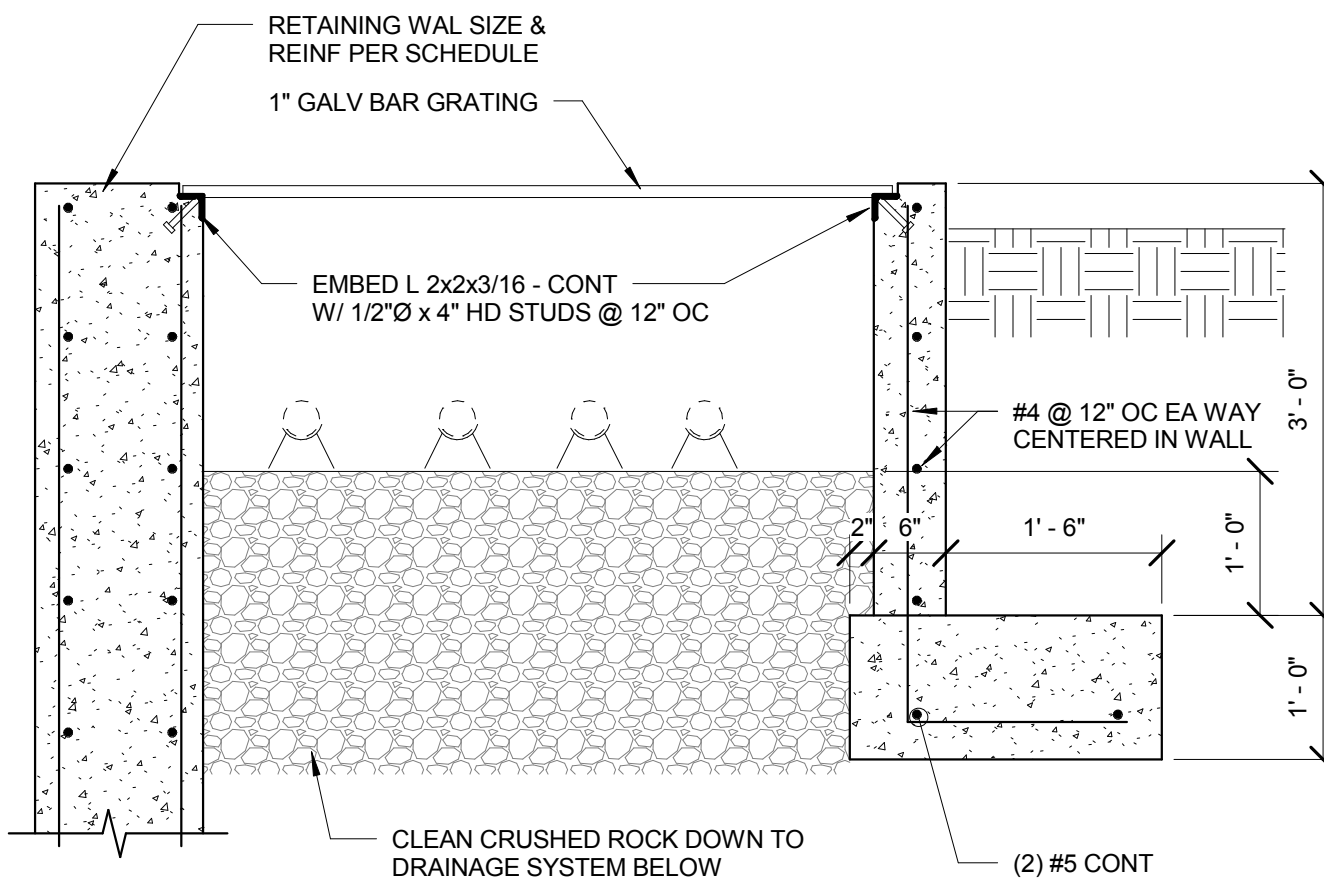

5 GAS (TOP) & REFRIGERANT LINE TROUGH DETAILS
3/4" = 1'-0"

2

ESTIMATED BOTTOM OF DRILLED PIER ELEVATIONS – FOR BIDDING PURPOSES ONLY

LEVEL 0 DRILLED PIERS LOCATED ON AND NORTH OF GRID C.3 = 518'-0"
LEVEL 0 DRILLED PIERS LOCATED SOUTH OF GRID C.3 = 515'-0"
LEVEL 1 DRILLED PIERS LOCATED NORTH OF GRID E = 517'-0"
LEVEL 1 DRILLED PIERS LOCATED ON GRIDS A.6 & B = 522'-0"
LEVEL 1 DRILLED PIERS LOCATED FROM GRID V TO Z ON GRID 3 = 508'-0"
LEVEL 1 DRILLED PIERS LOCATED FROM GRID V TO Z ON GRID 4.5 = 521'-0"
LEVEL 1 DRILLED PIERS LOCATED IN WEST WING = 517'-0"



3	ASI 003	27 JULY 2016
2	ADDENDUM 1-11	13 MAY 2016
1	ADDENDUM 1-1	29 JAN 2016
-	ISSUED FOR CONSTRUCTION (BP1)	15 JAN 2016
No.	Description	Date

Drawing Title:

FOUNDATION SCHEDULES

Project No.: 04561.01 Checked by:

S0004



1100 Clark Avenue
St. Louis, Missouri 63102
T: 314.241.6250
F: 314.241.2570

William Tao & Associates, Inc
MEP/FP Engineer
7955 Manchester Road, Suite 125
St. Louis, MO 63143
314-884-7600

David Mason & Associates, Inc
Structural & Civil Engineer
800 South Vandeventer Avenue
St. Louis, MO 63110
314.534.1053

Faith Group
Technology
3101 S. Hanley Rd, Suite 100
St. Louis, MO 63143
314.991.2228

Kuhlmann Leavitt, Inc.
Environmental Graphics & Signage
7400 Pershing Ave
St. Louis, MO 63130
314.725.6616

KWA Architects
Architecture
9721 Litzinger Road
St. Louis, MO 63124
314.962.2560

Spellman Brady & Company
Interior Designer
8251 Maryland Avenue, Suite 300
St. Louis, MO 63105
314.862.0070

SWT Design
Landscape Architect
7722 Big Bend Blvd
St. Louis, MO 63119
314.644.5700

Webb Engineering Services, Inc.
Plumbing & Fire Protection
1400 S. 3rd Street, Suite 201
St. Louis, MO 63104
314.588.0600



Drawing Title:


Project No.: 04561.01


Checked by:

A0505


© Canon Design 2015

© Cannon Design 2015
All rights reserved. No part of this document may be reproduced or utilized in any form, without prior written authorization by The Cannon Corporation.
8/8/2016 5:01:08 PM

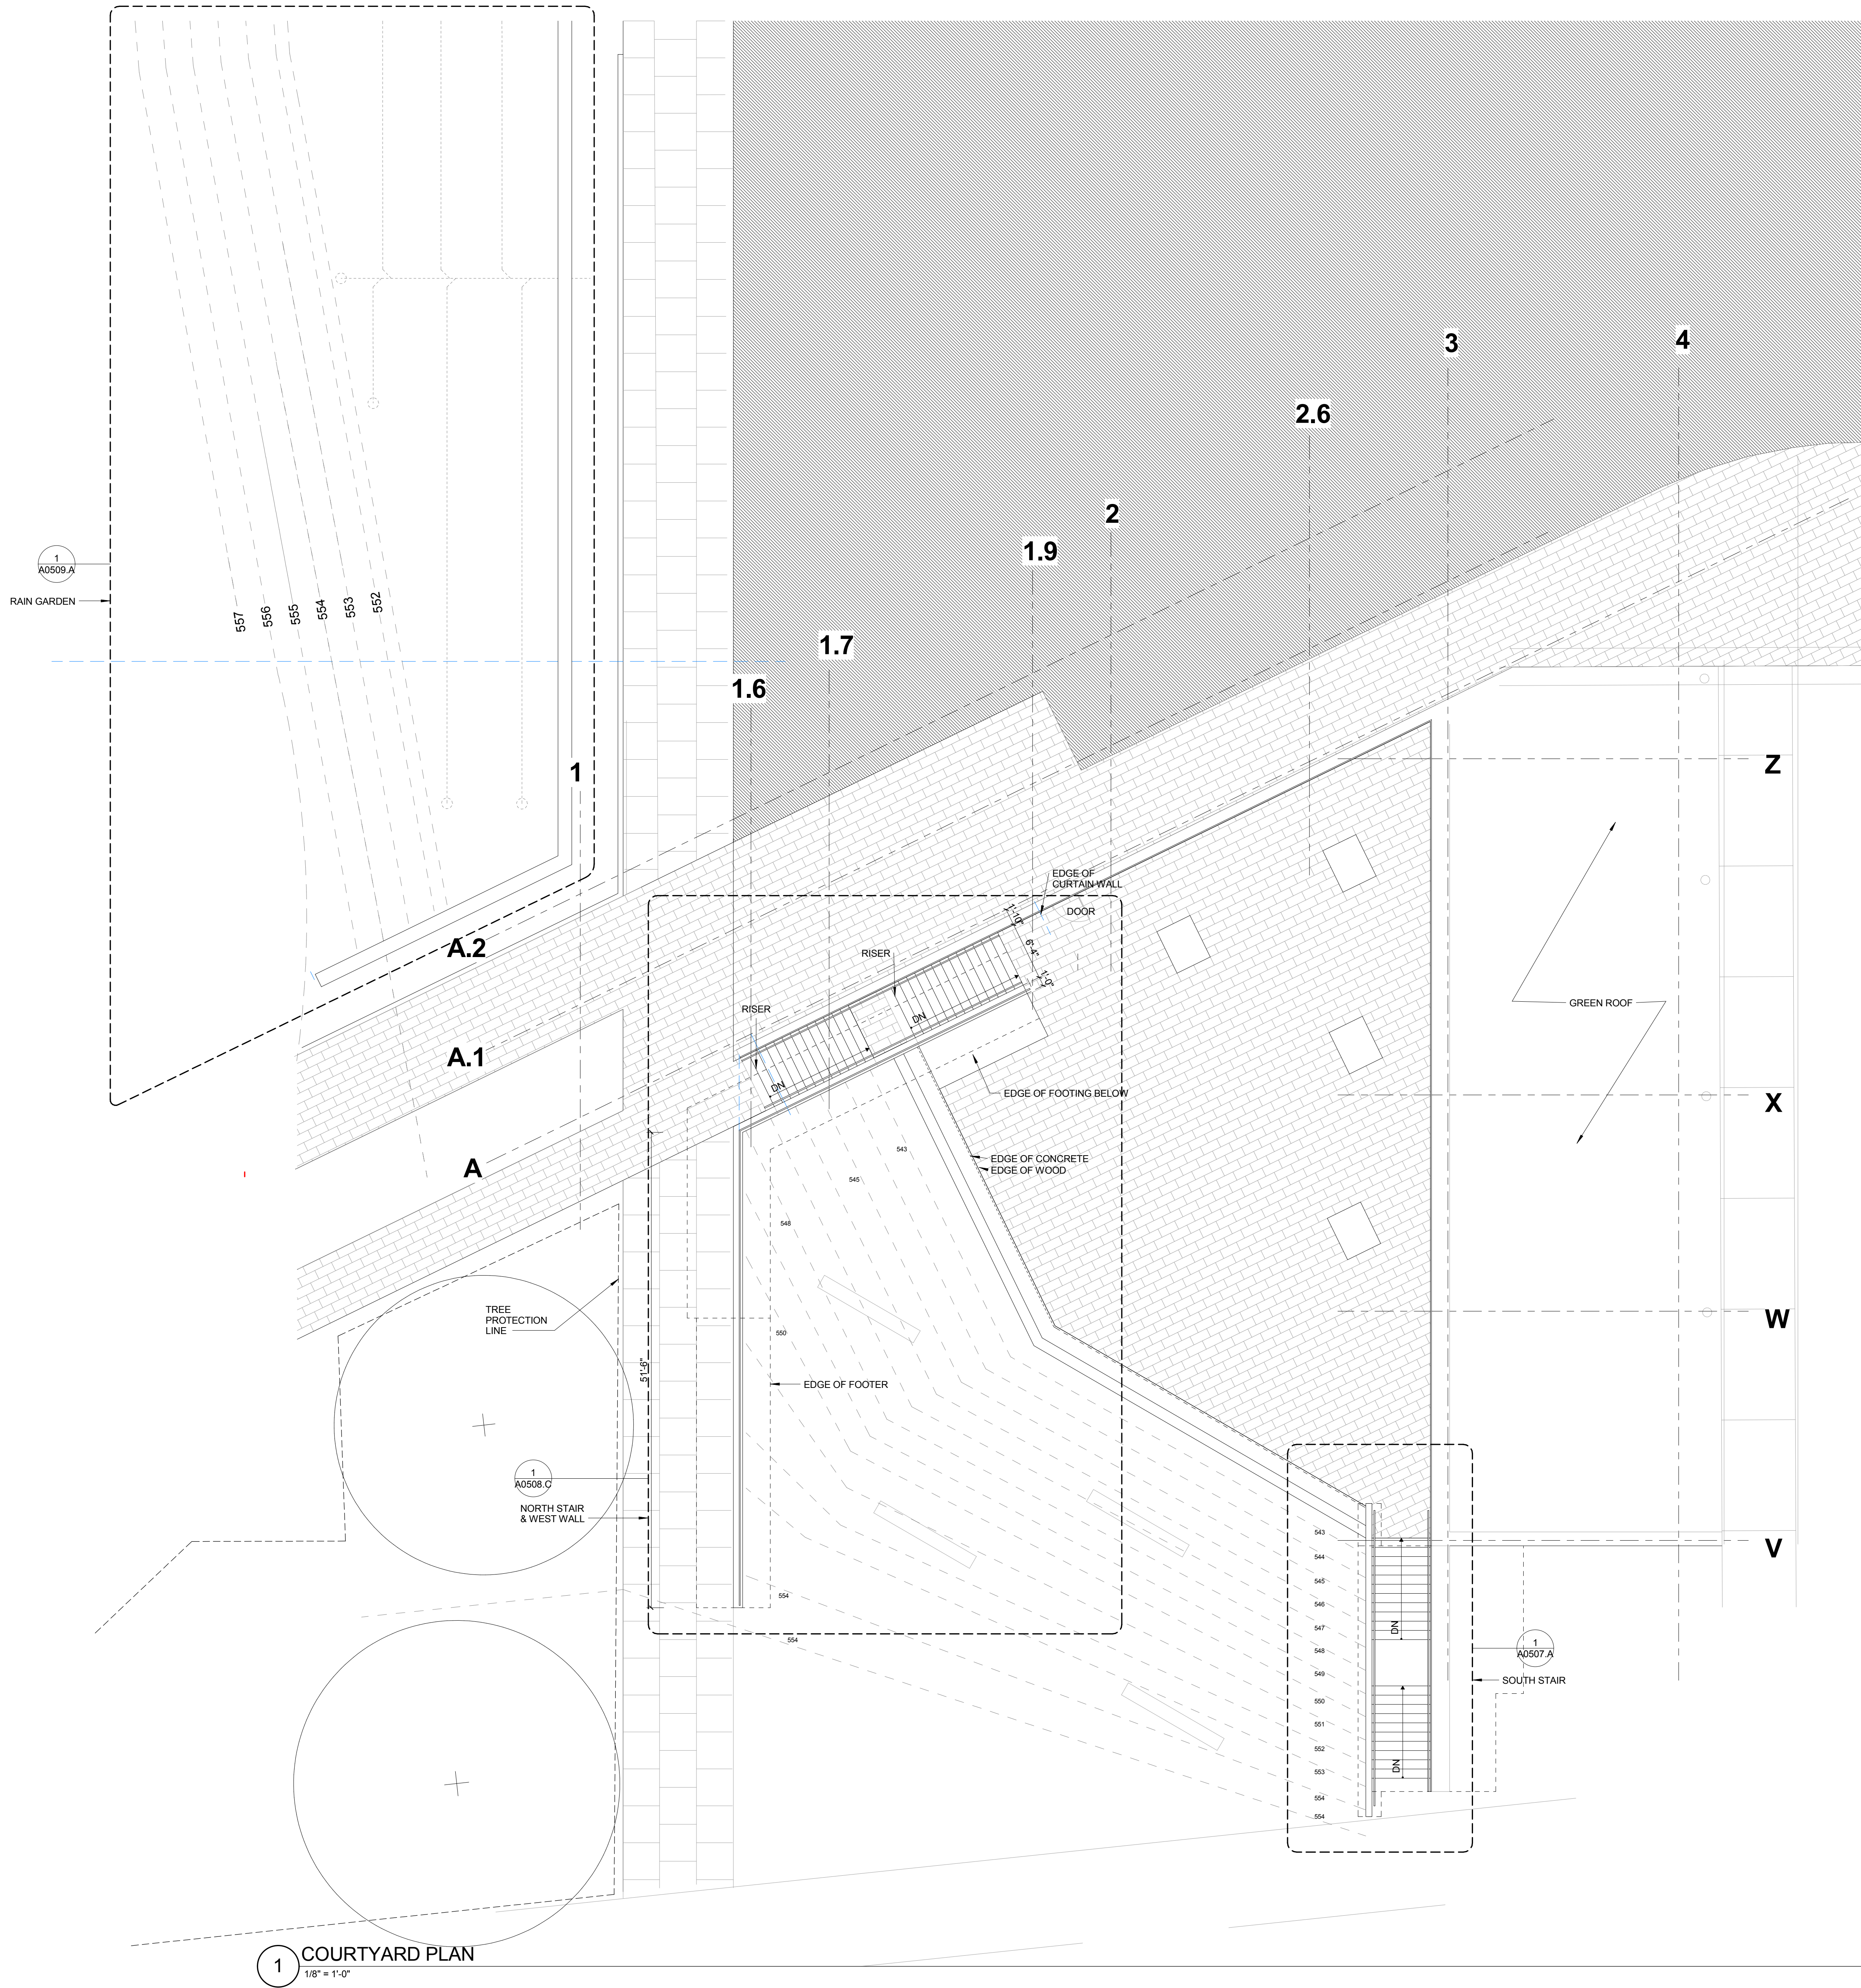

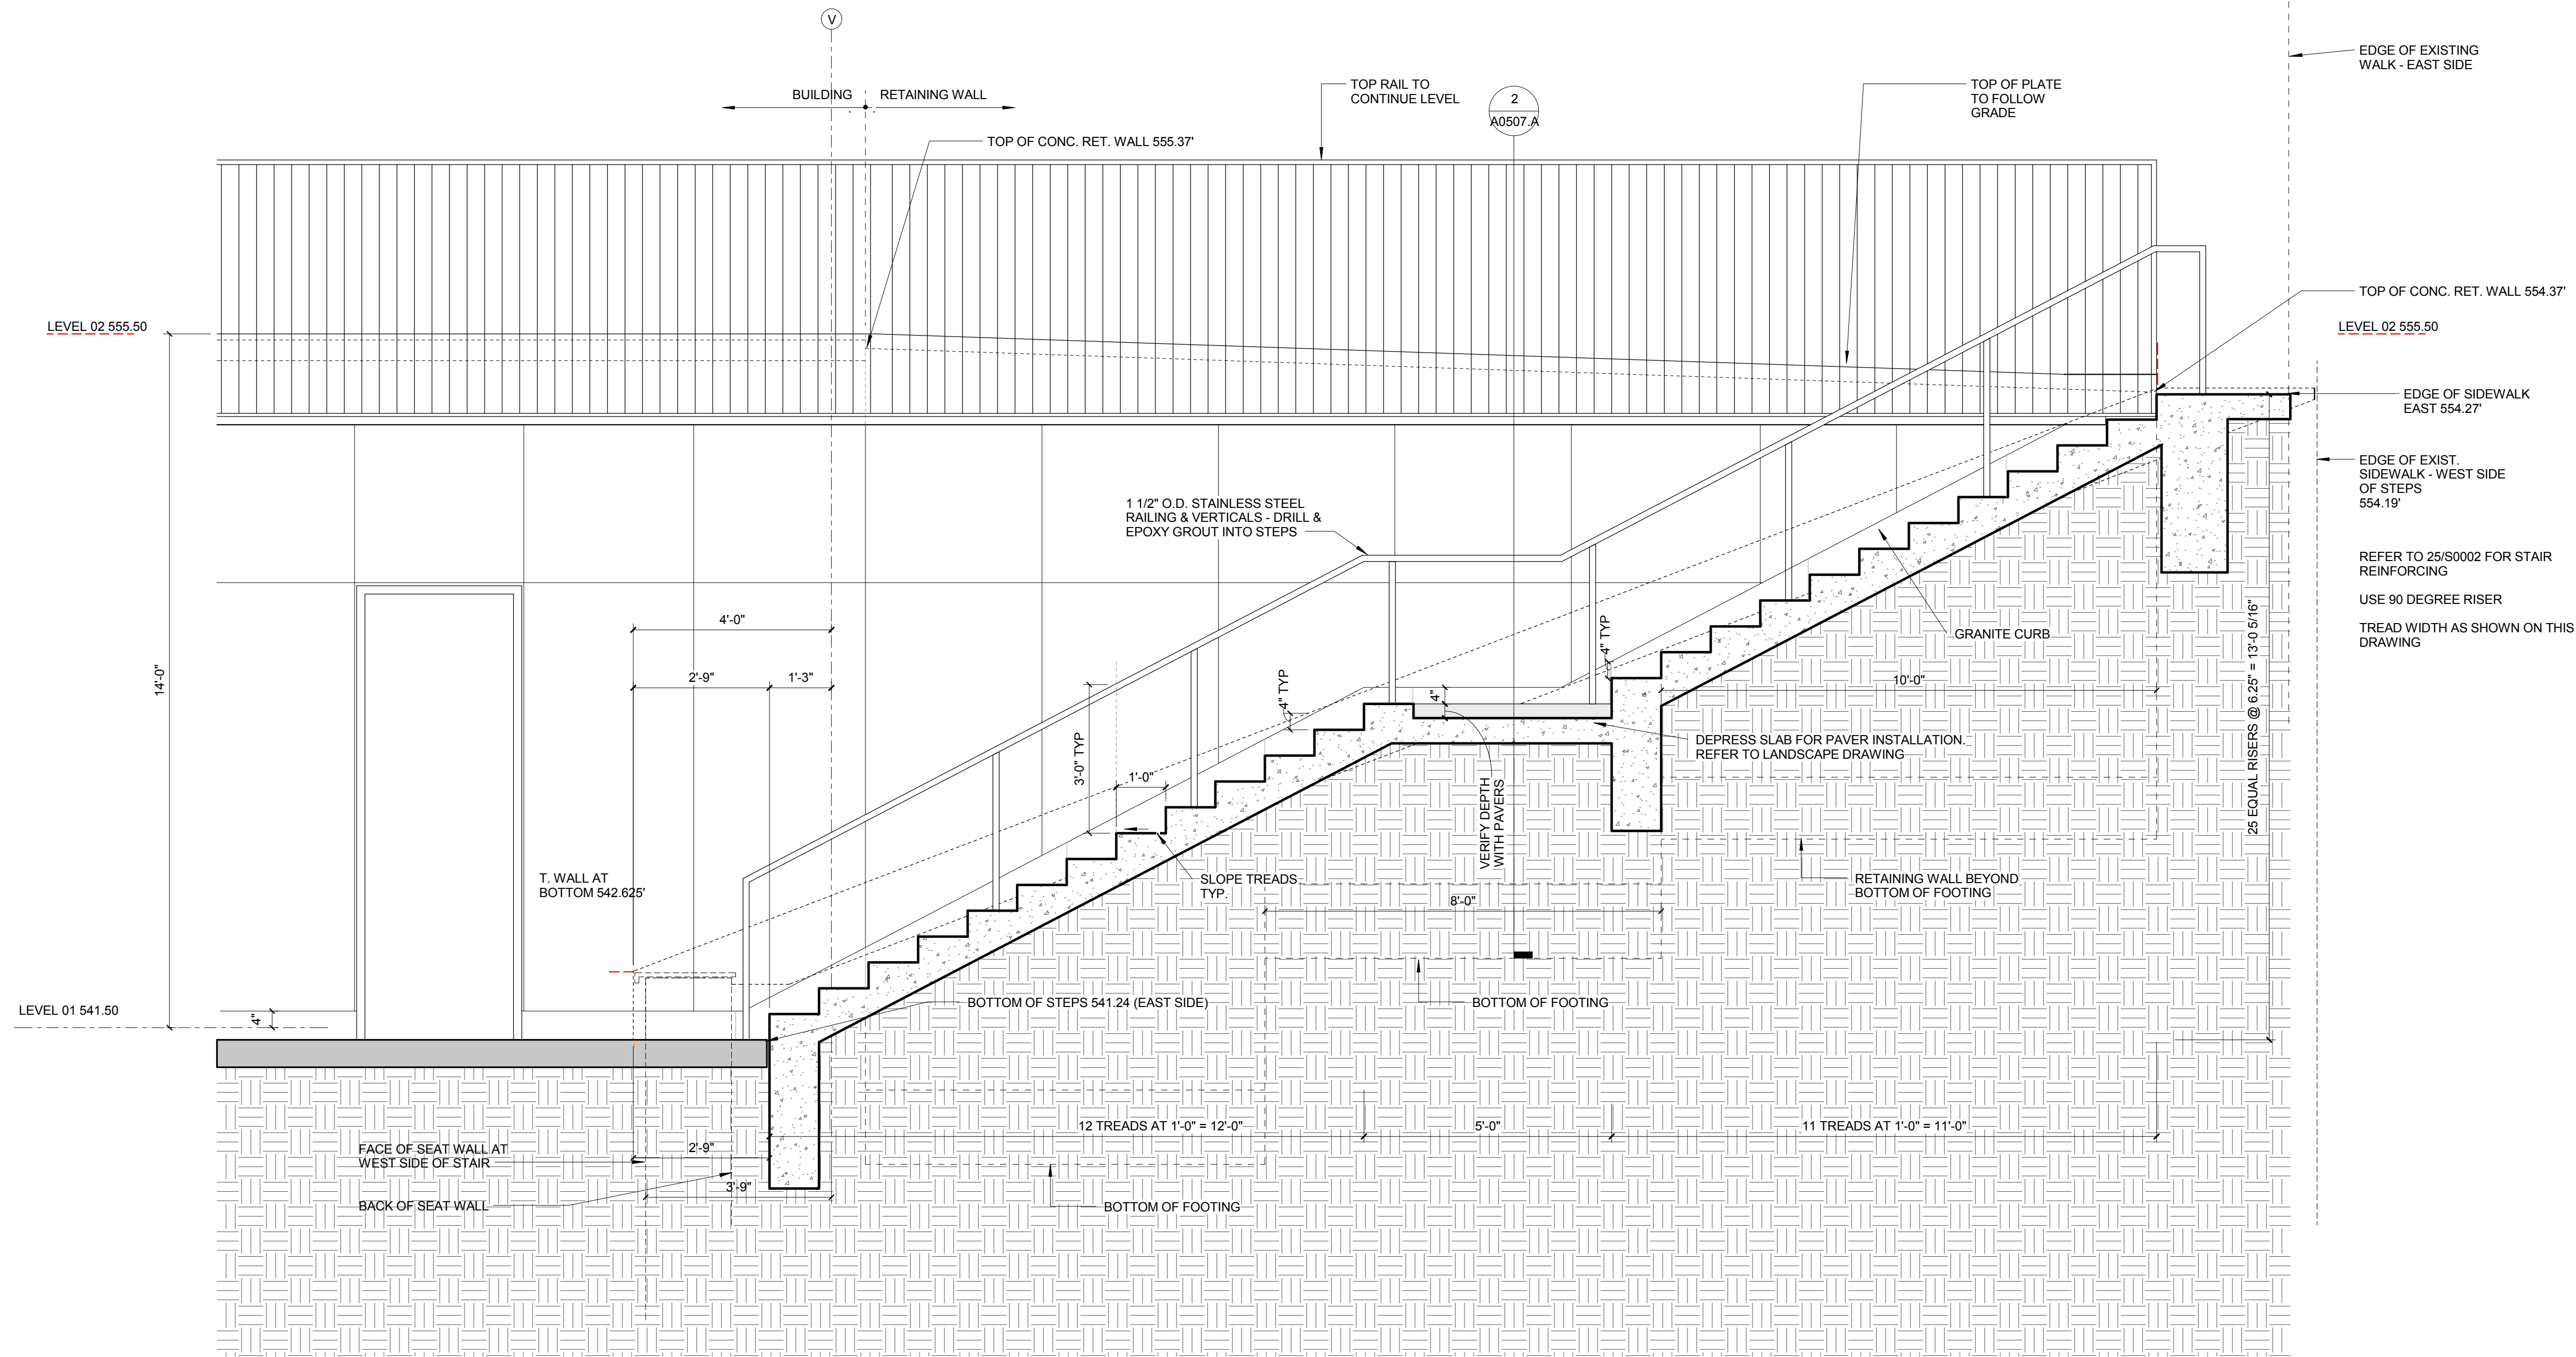

2 SOUTH COURTYARD STAIR - SECTION
1/2" = 1'-0"

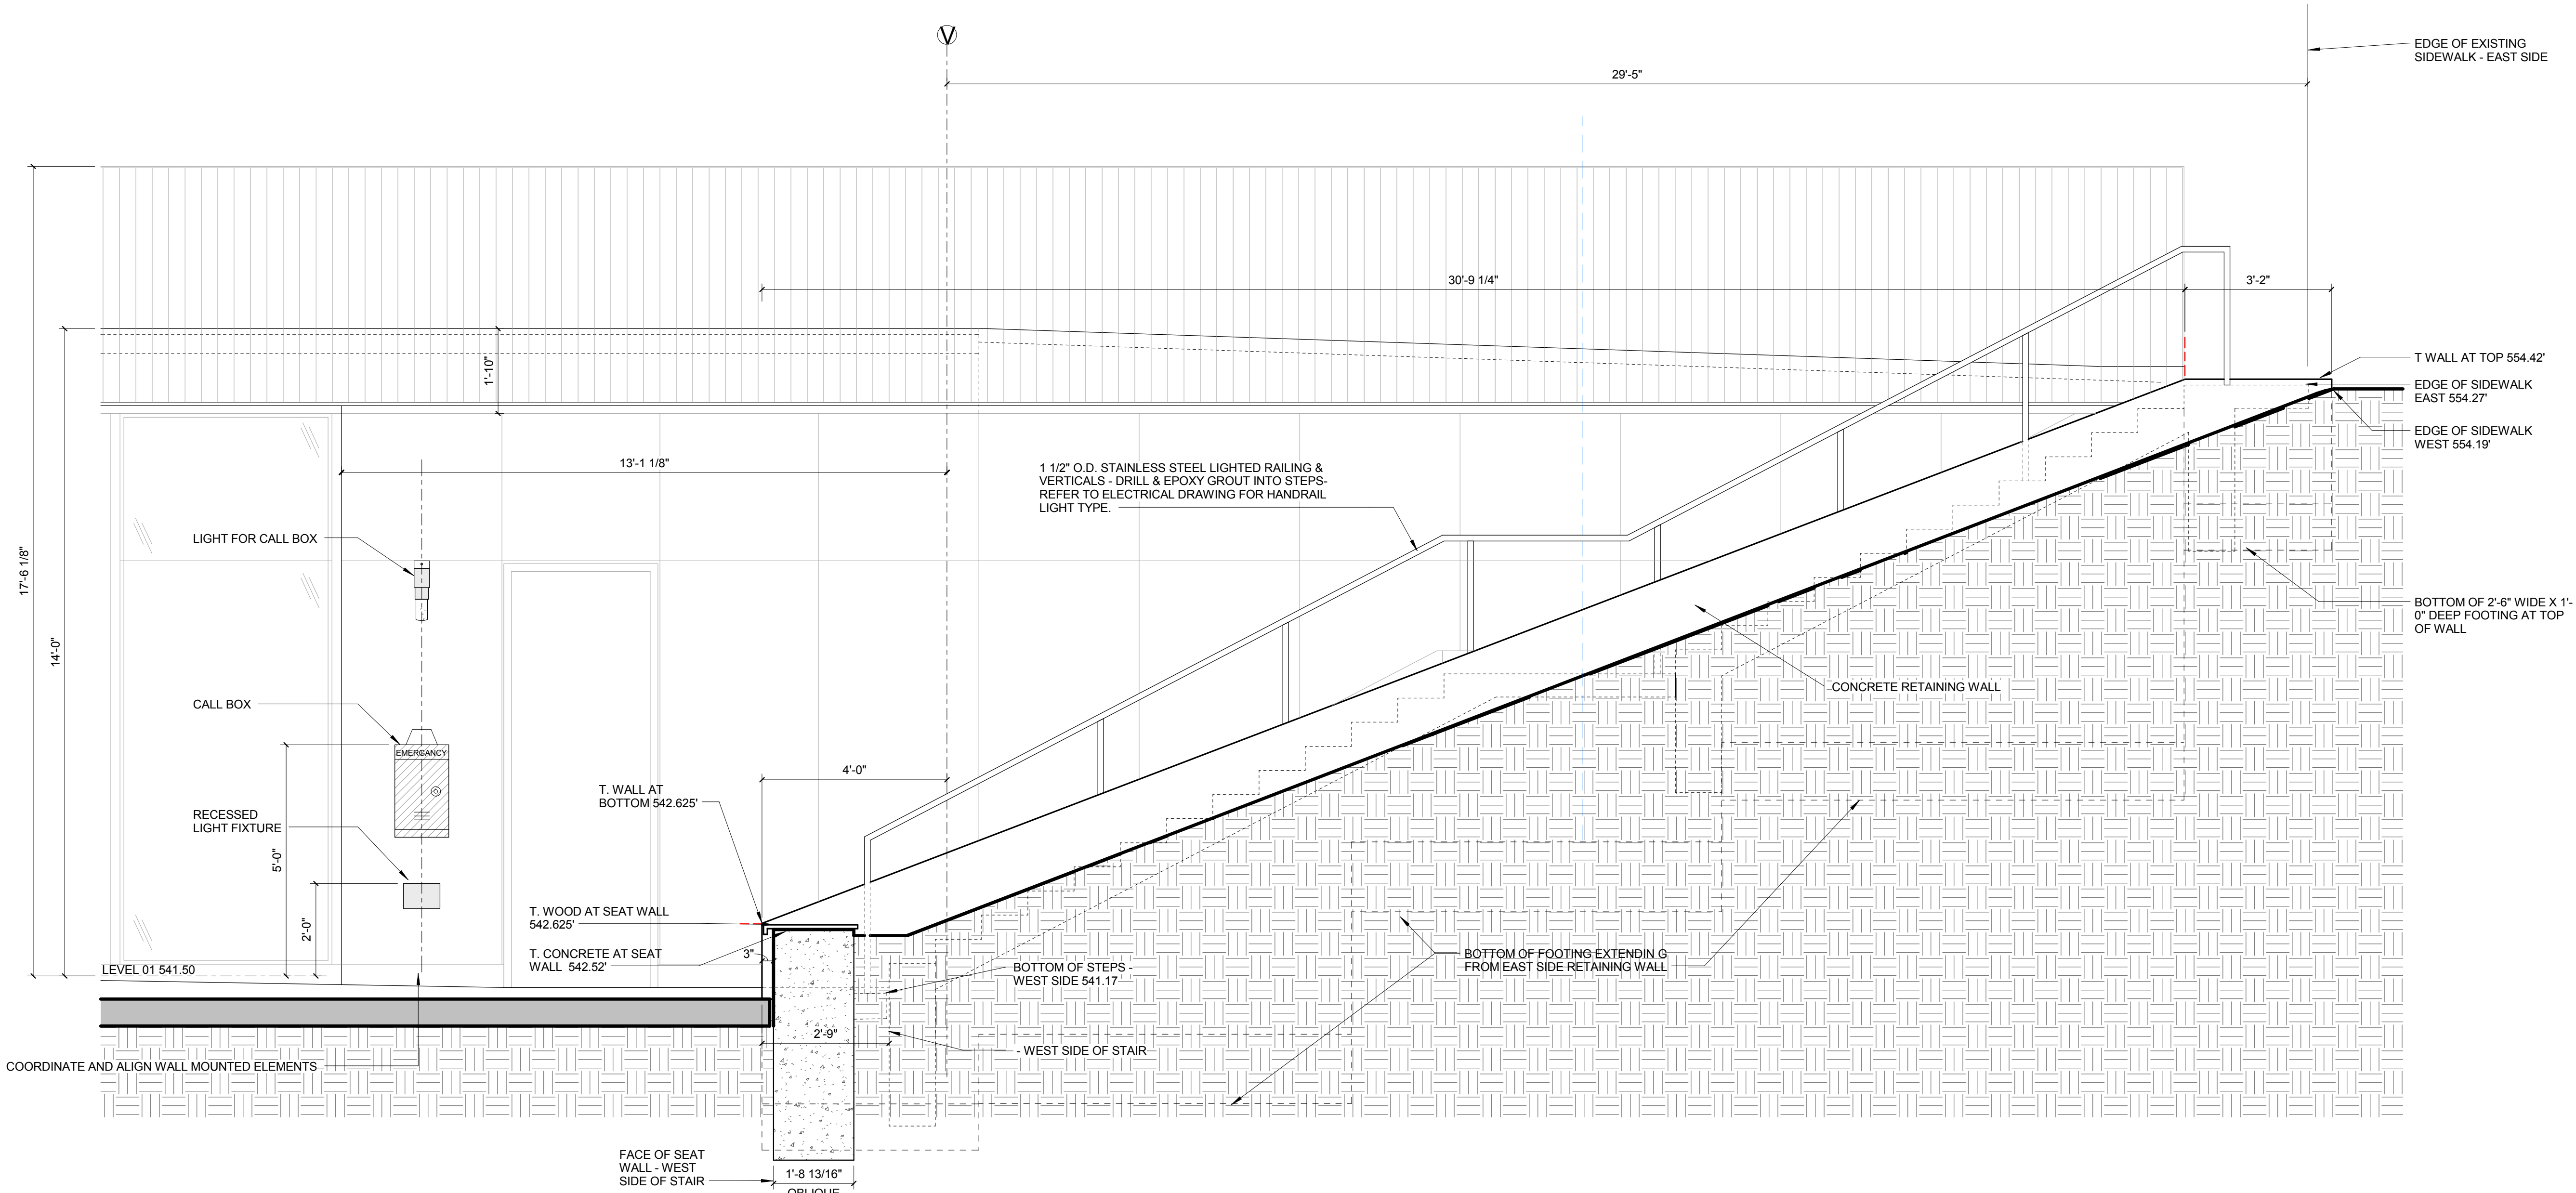

1 SOUTH COURTYARD STAIR - WEST SIDE WALL ELEVATION
1/2" = 1'-0"

1	ASI-003	01 AUG 2016
-	ISSUED FOR CONSTRUCTION (BP1)	15 JAN 2016
No.	Description	Date

Drawing Title:

COURTYARD WALLS &
STAIRS - SOUTH

Project No.: 04561.01

Checked by:

A0507.B



1100 Clark Avenue
St. Louis, Missouri 63102
T: 314.241.6250
F: 314.241.2570

William Tao & Associates, Inc
MEP/FP Engineer
7955 Manchester Road, Suite 125
St. Louis, MO 63143
314-884-7600

David Mason & Associates, Inc
Structural & Civil Engineer
800 South Vandeventer Avenue
St. Louis, MO 63110
314.534.1053

**Faith Group
Technology**
3101 S. Hanley Rd, Suite 100
St. Louis, MO 63143
314.991.2228

Kuhlmann Leavitt, Inc.
Environmental Graphics & Signage
7400 Pershing Ave
St. Louis, MO 63130
314.725.6616

KWA Architects
Architecture
9721 Litzinger Road
St. Louis, MO 63124
314.962.2560

Spellman Brady & Company
Interior Designer
8251 Maryland Avenue, Suite 300
St. Louis, MO 63105
314.862.0070

SWT Design
Landscape Architect
7722 Big Bend Blvd
St. Louis, MO 63119
314.644.5700

Webb Engineering Services, Inc.
Plumbing & Fire Protection
1400 S. 3rd Street, Suite 201
St. Louis, MO 63104
314.588.0600



1	ASI-003	01 AUG 2016
-	ISSUED FOR CONSTRUCTION (BP1)	15 JAN 2016
No.	Description	Date

Drawing Title:

COURTYARD WALLS & STAIRS - NORTH


Project No.: 04561.01

Checked by:


A0508.A

© Canyon Design 20


© Cannon Design 2015
All rights reserved. No part of this document may
be reproduced or utilized in any form, without prior
written authorization by The Cannon Corporation.
8/8/2016 5:45:22 PM

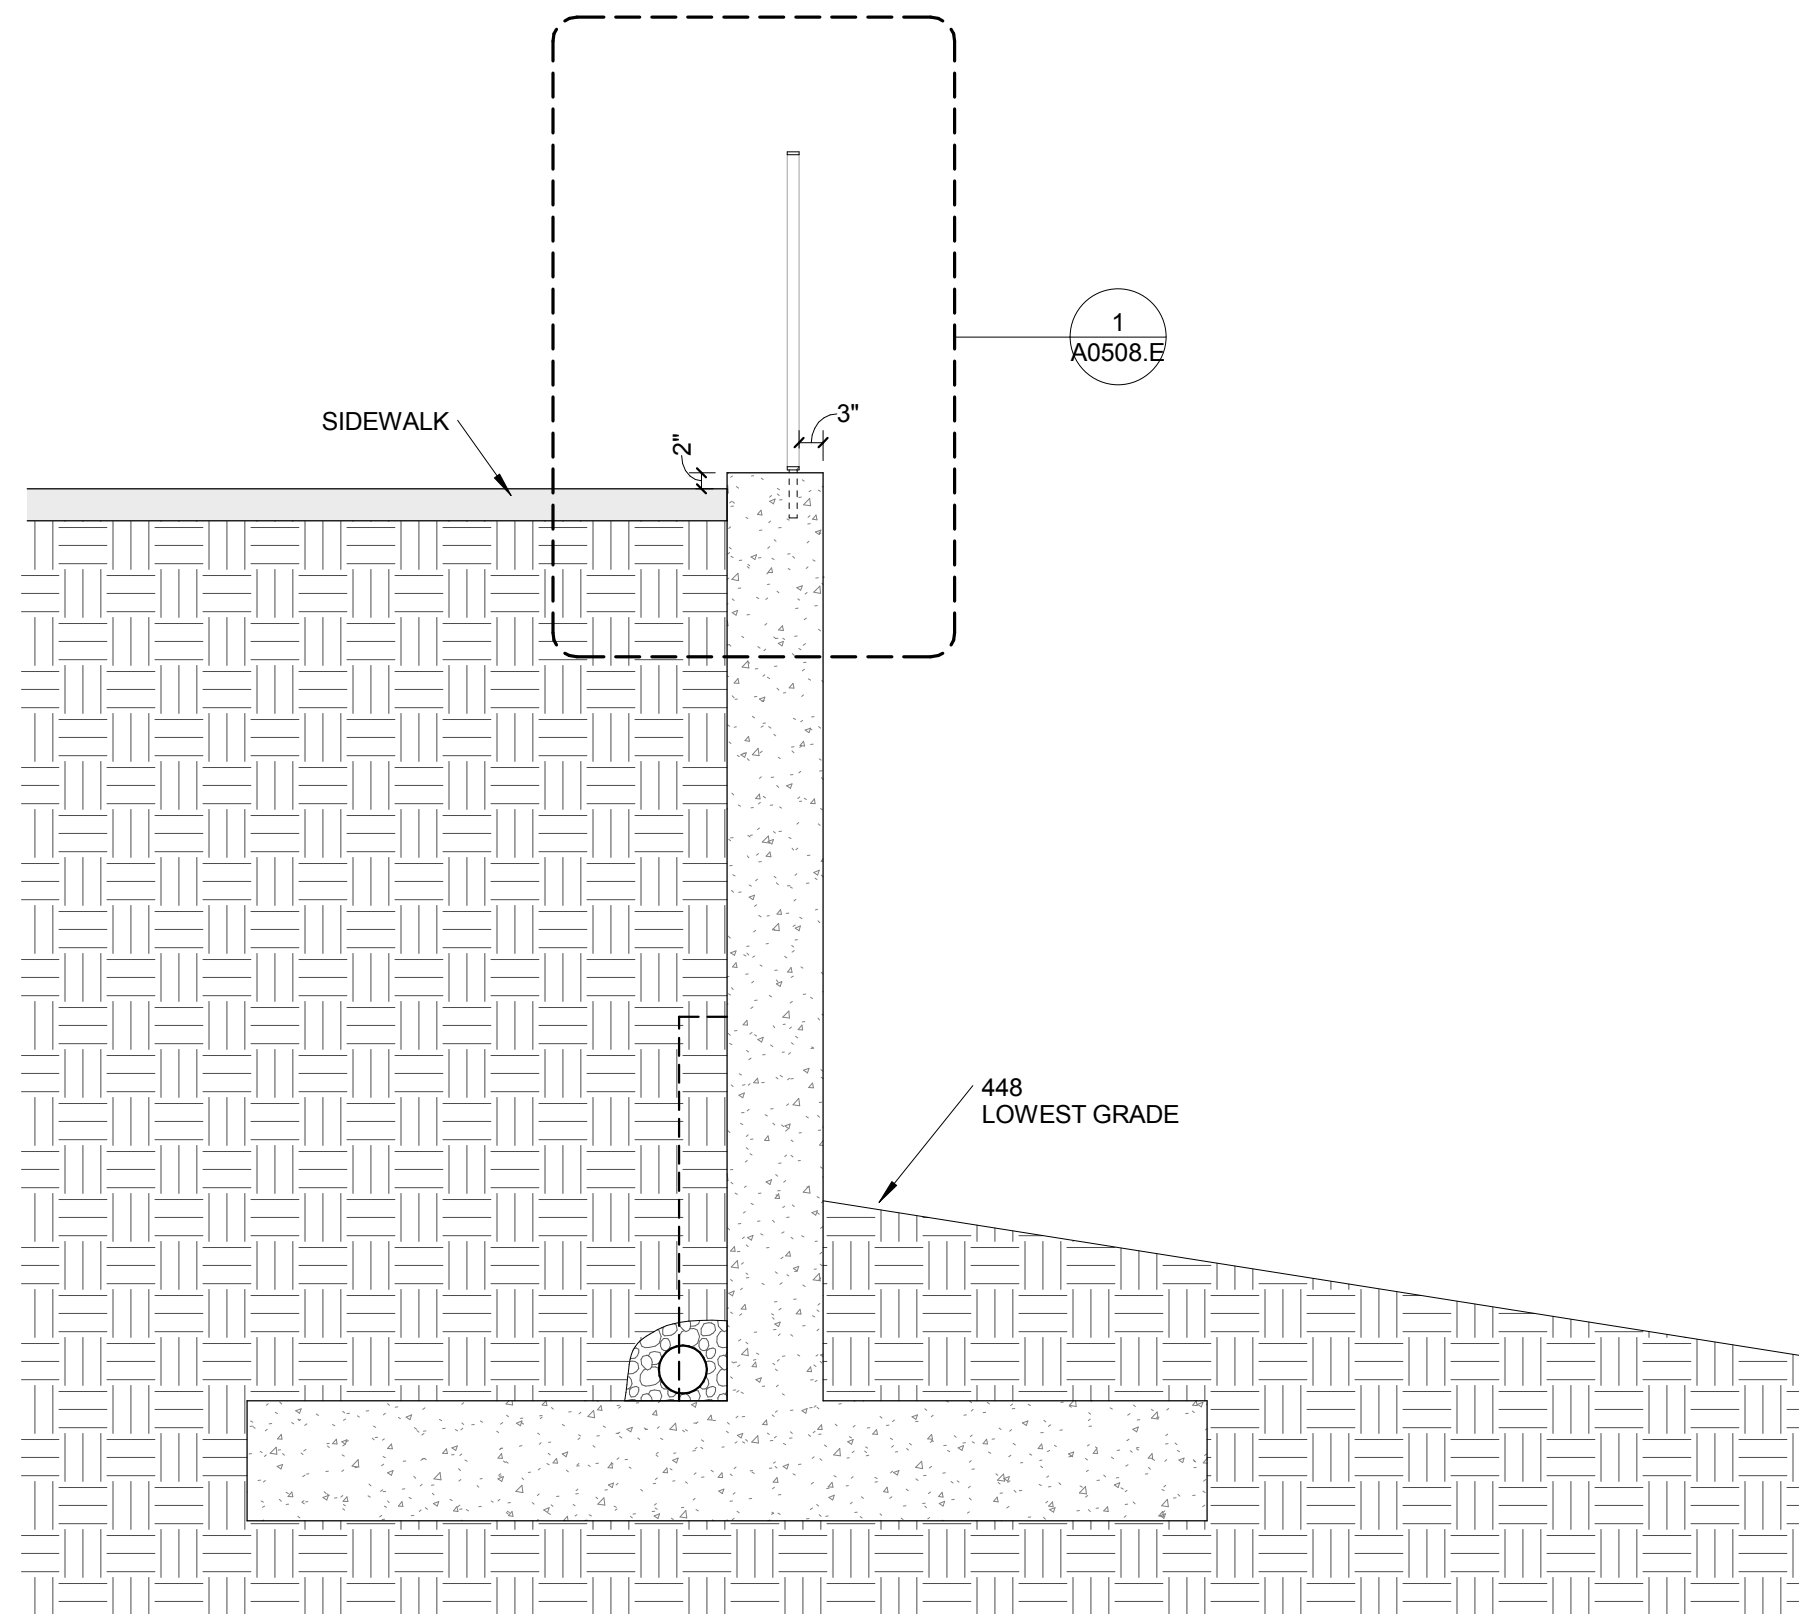


3 West Wall Section
1/2" = 1'-0"

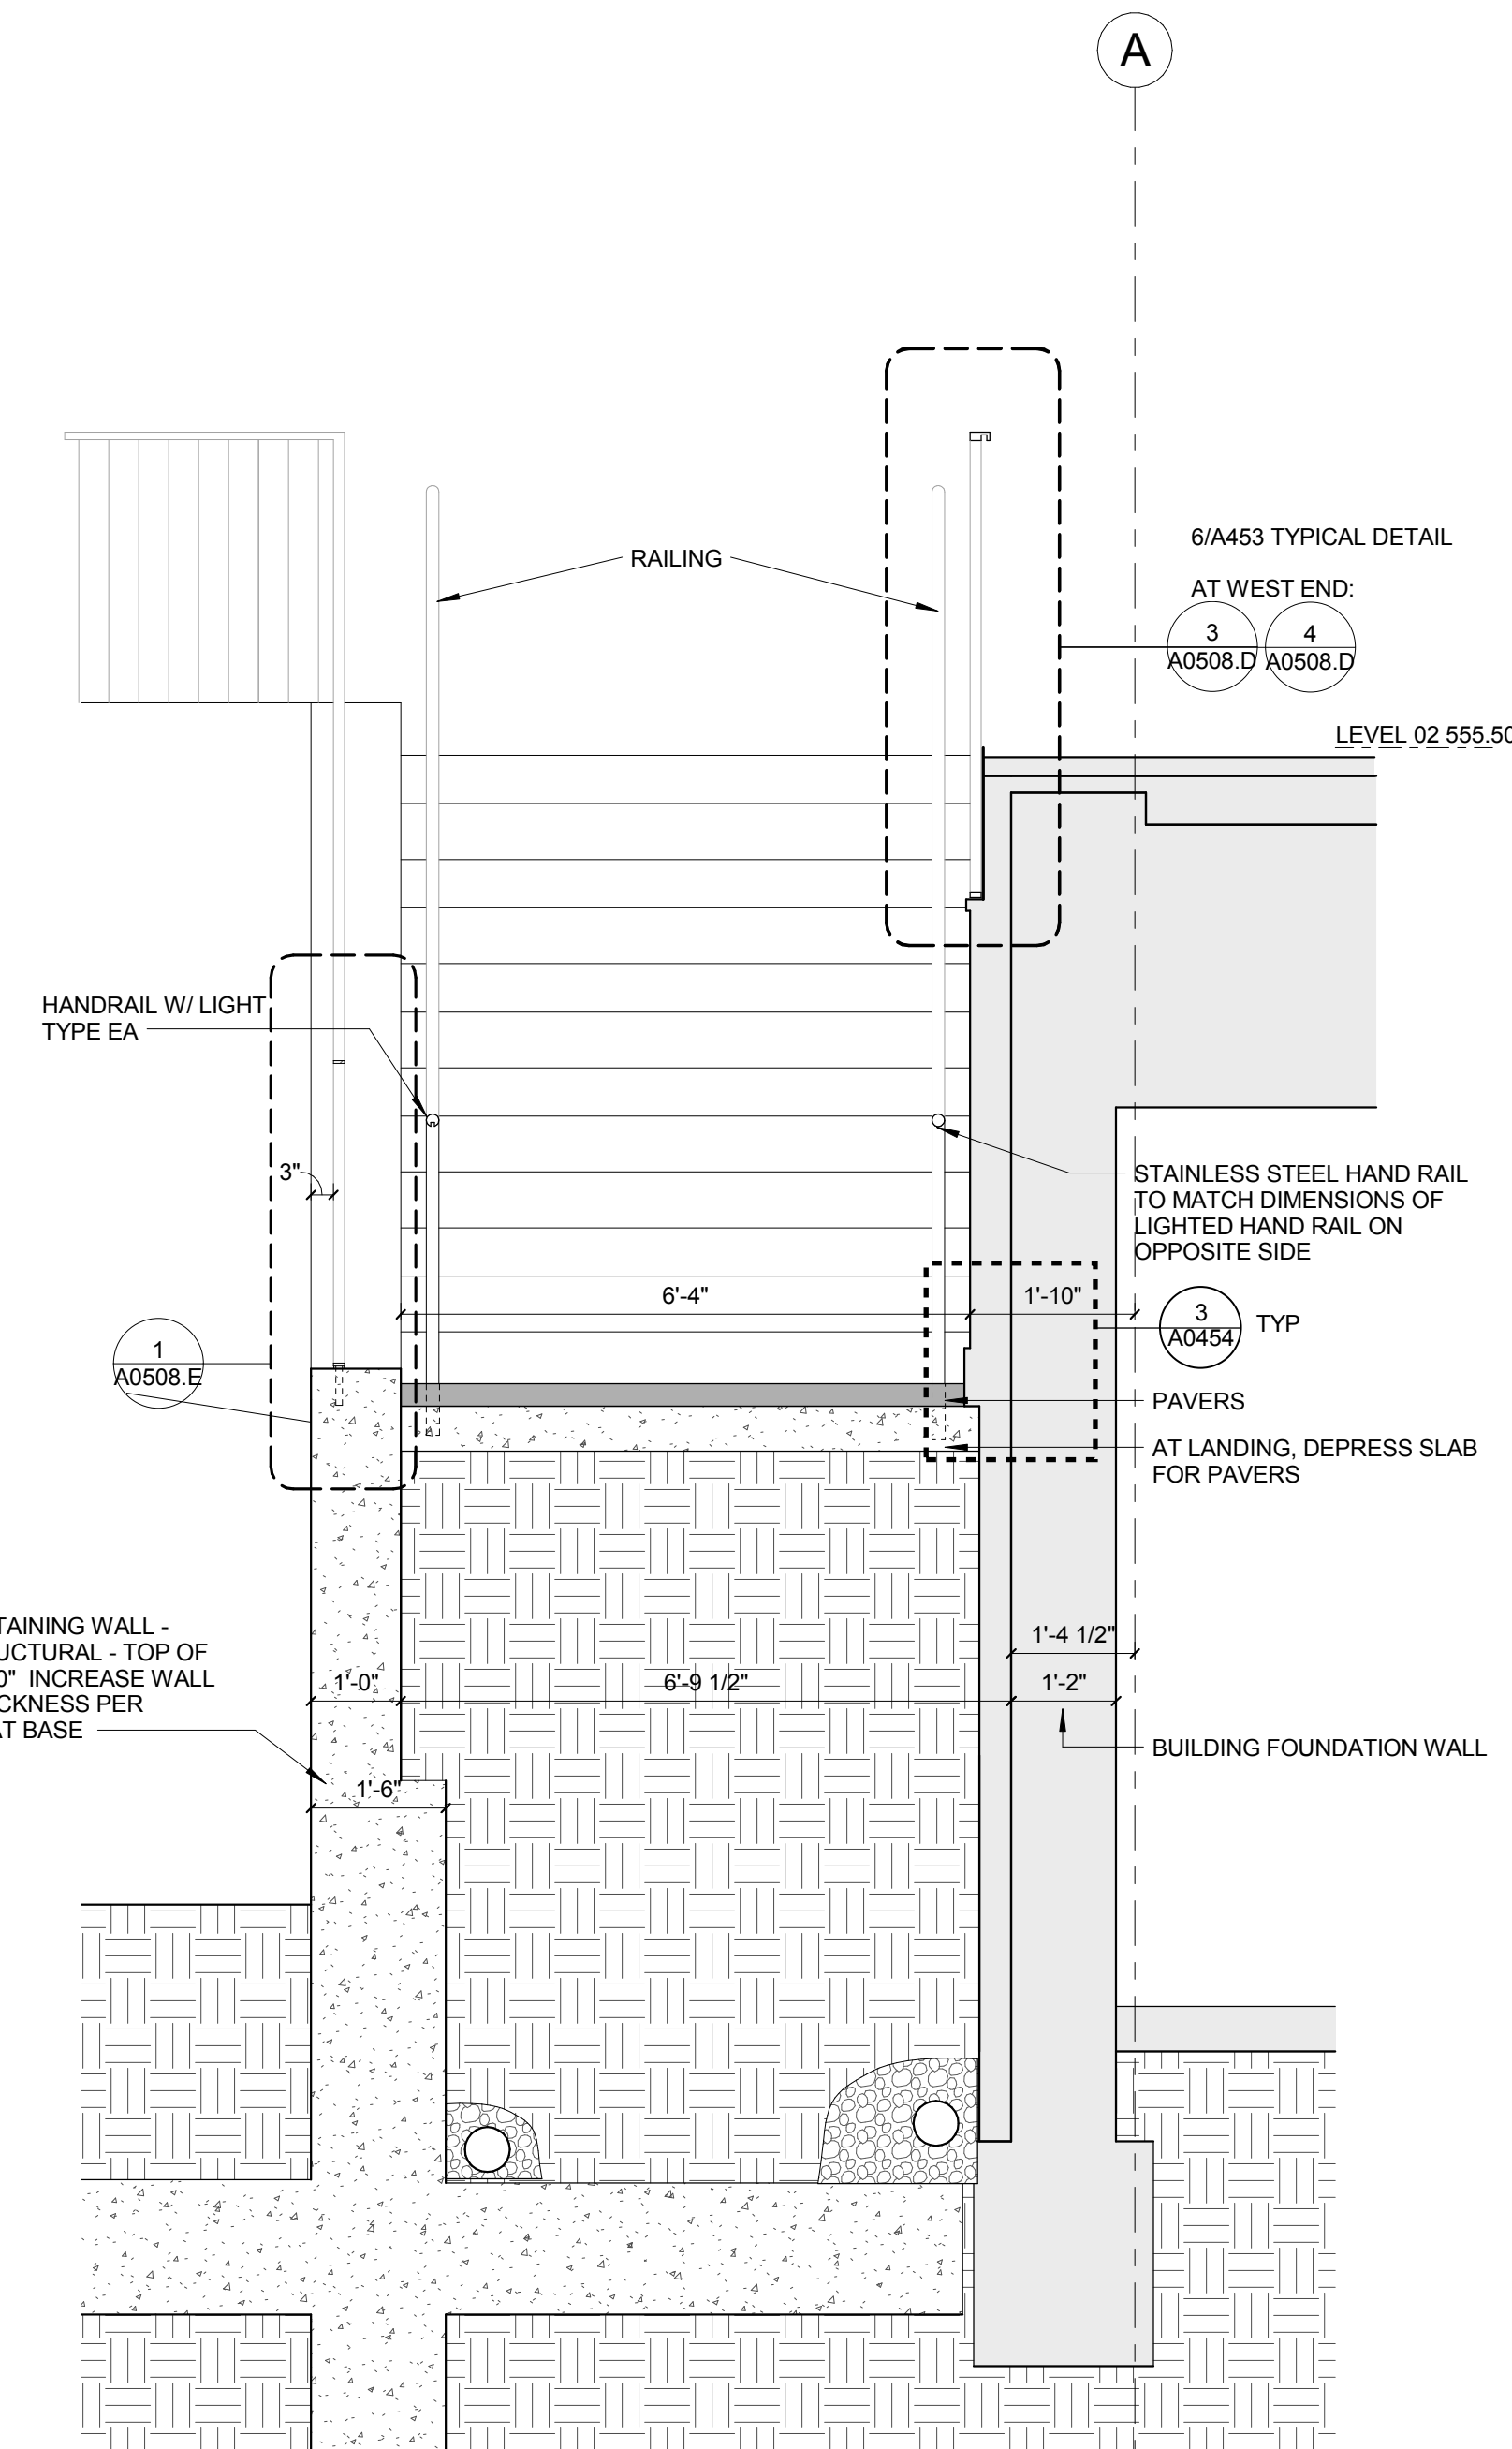


2 WEST STAIR LANDING SECTION
1/2" = 1'-0"

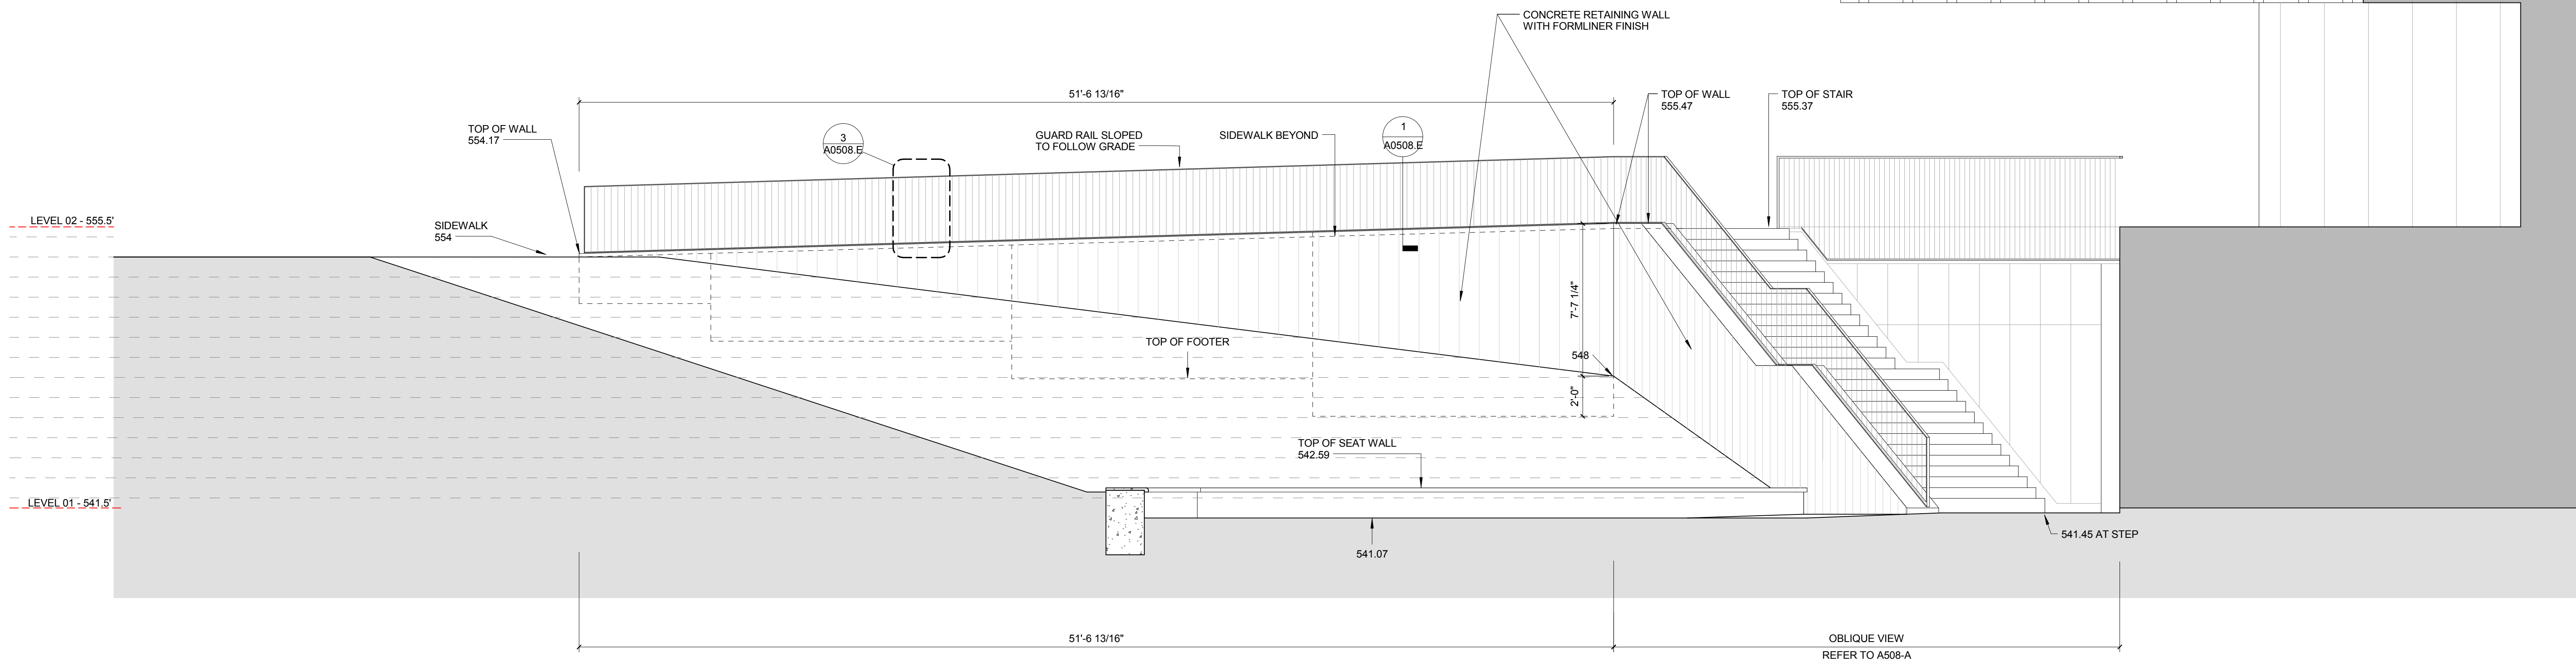


1 West Retaining Wall
1/4" = 1'-0"

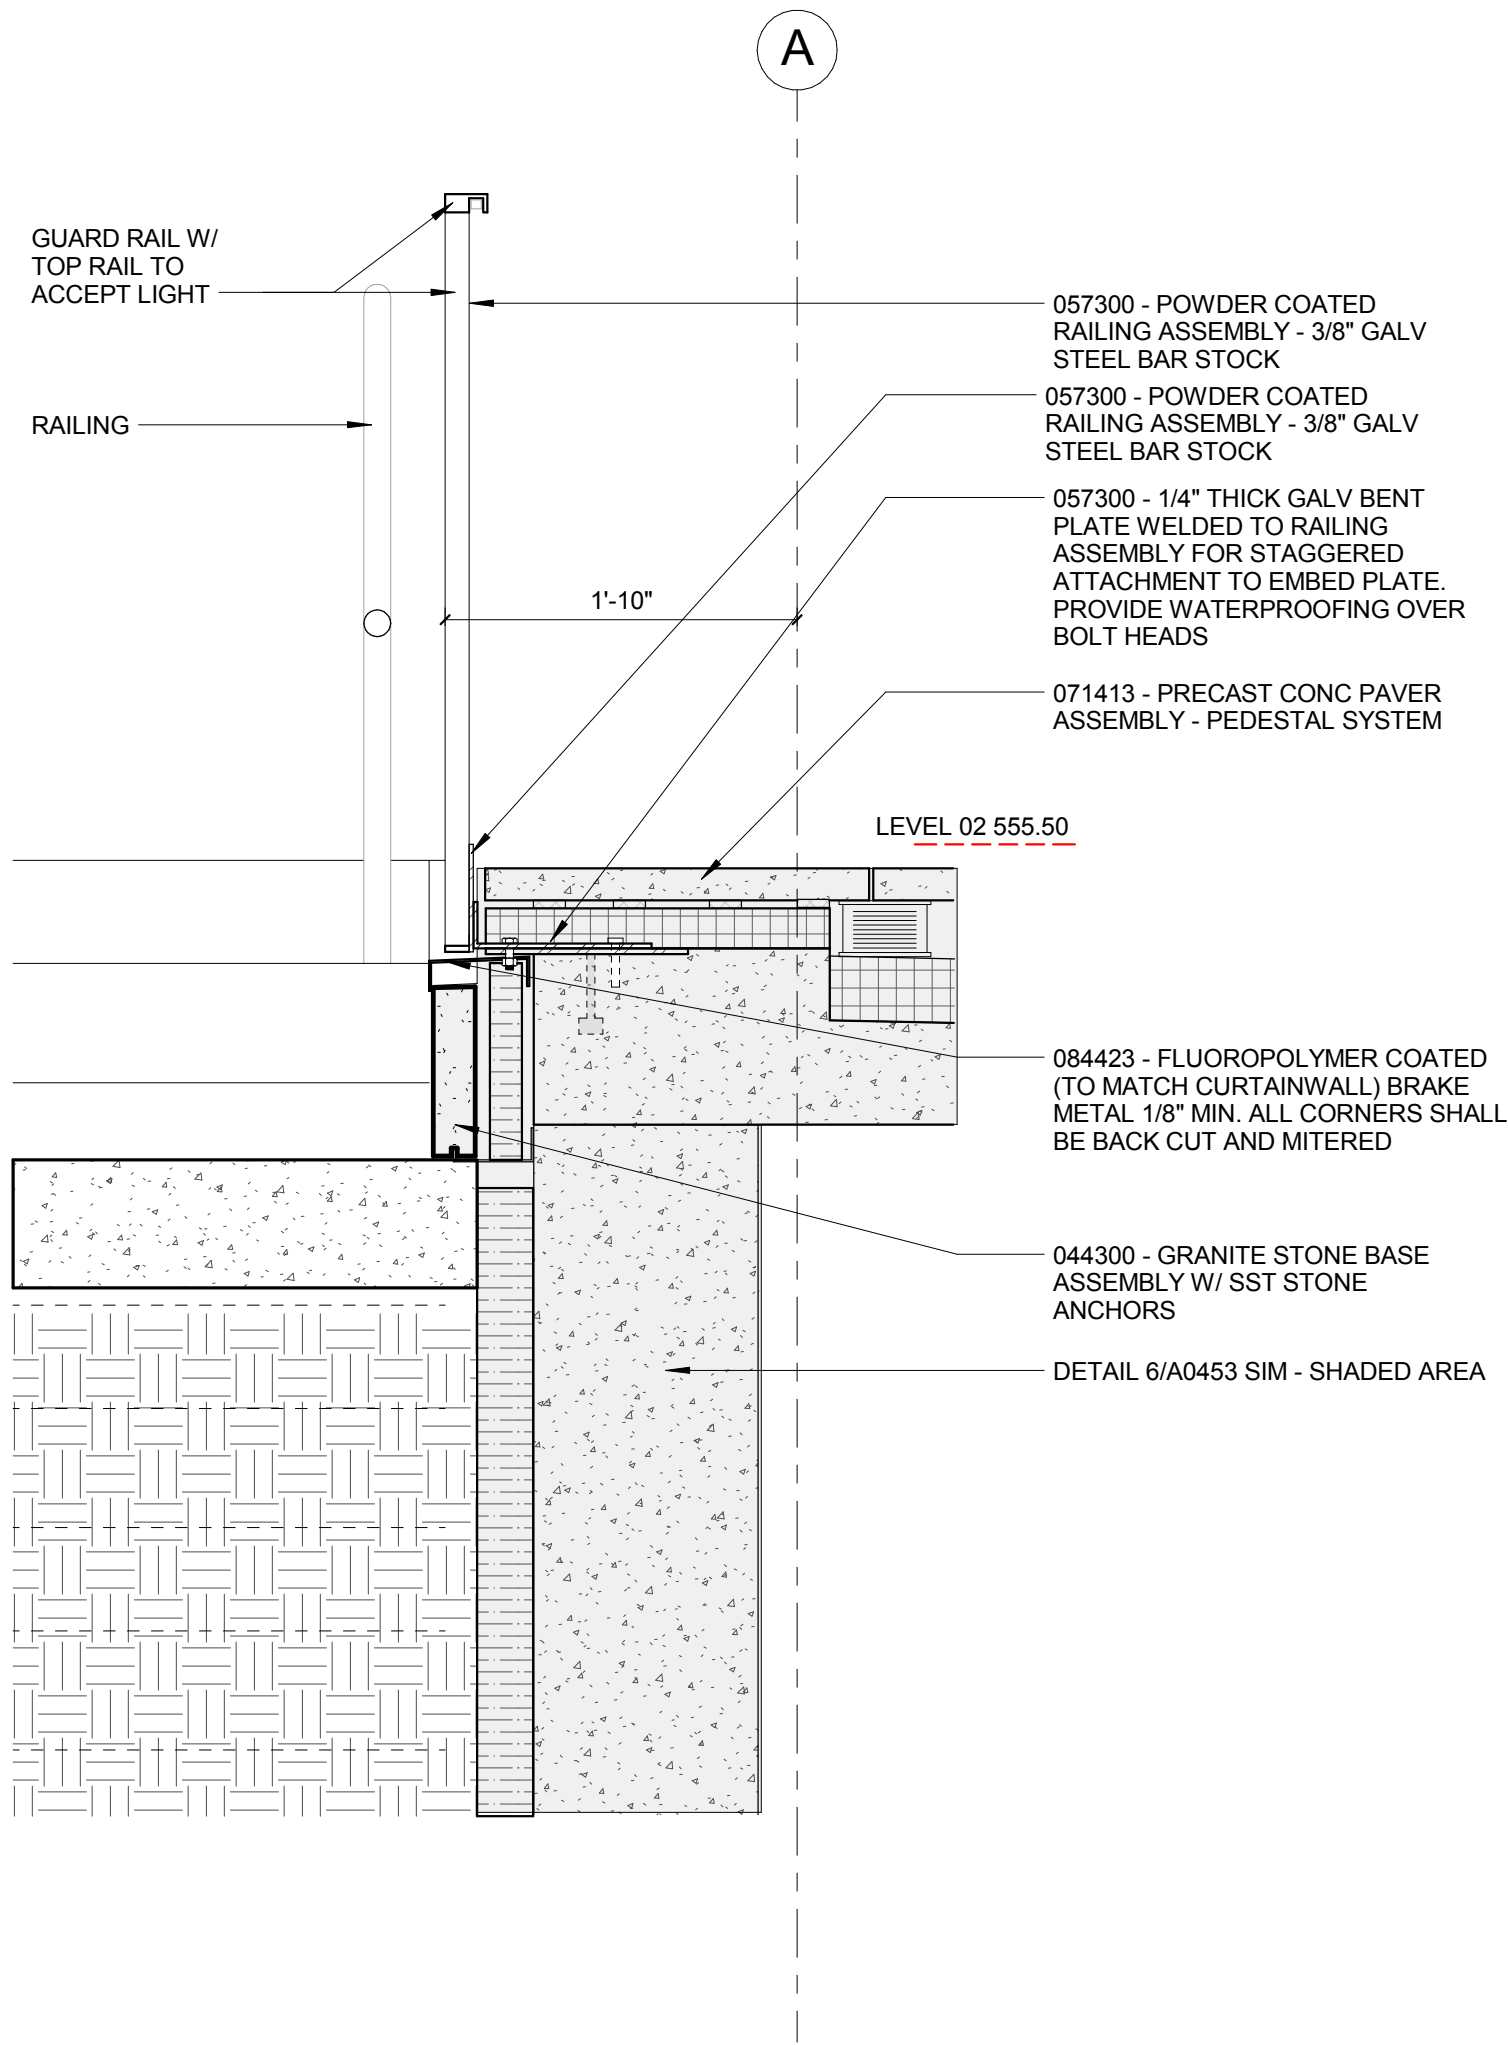


3 NORTH HAND RAIL SECTION 1
1" = 1'-0"

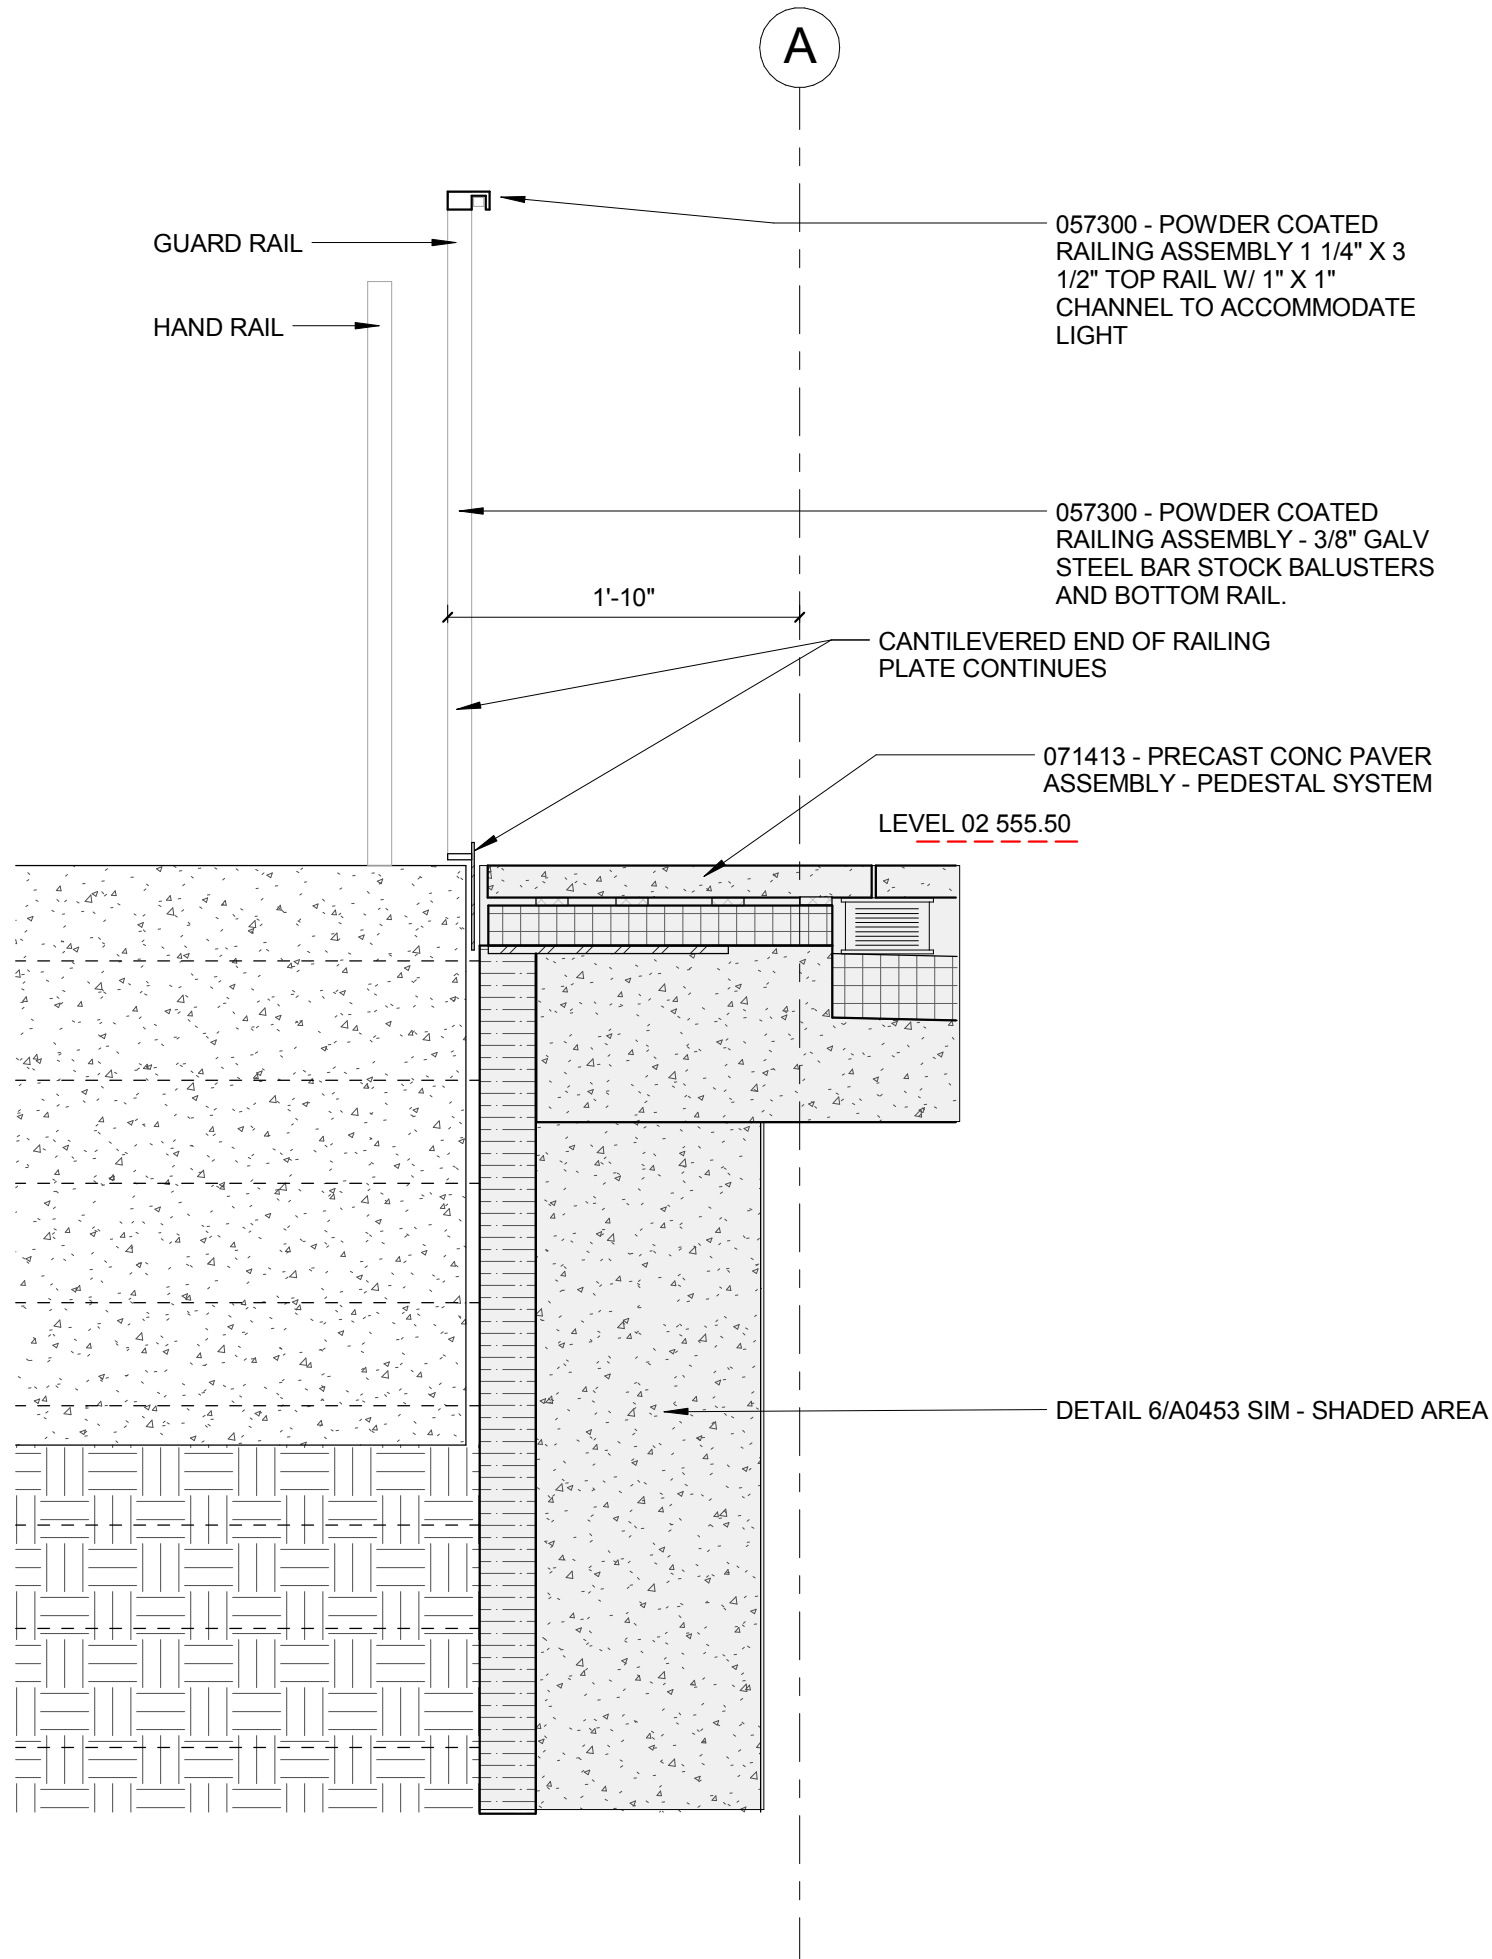


4 NORTH HAND RAIL SECTION 2
1" = 1'-0"

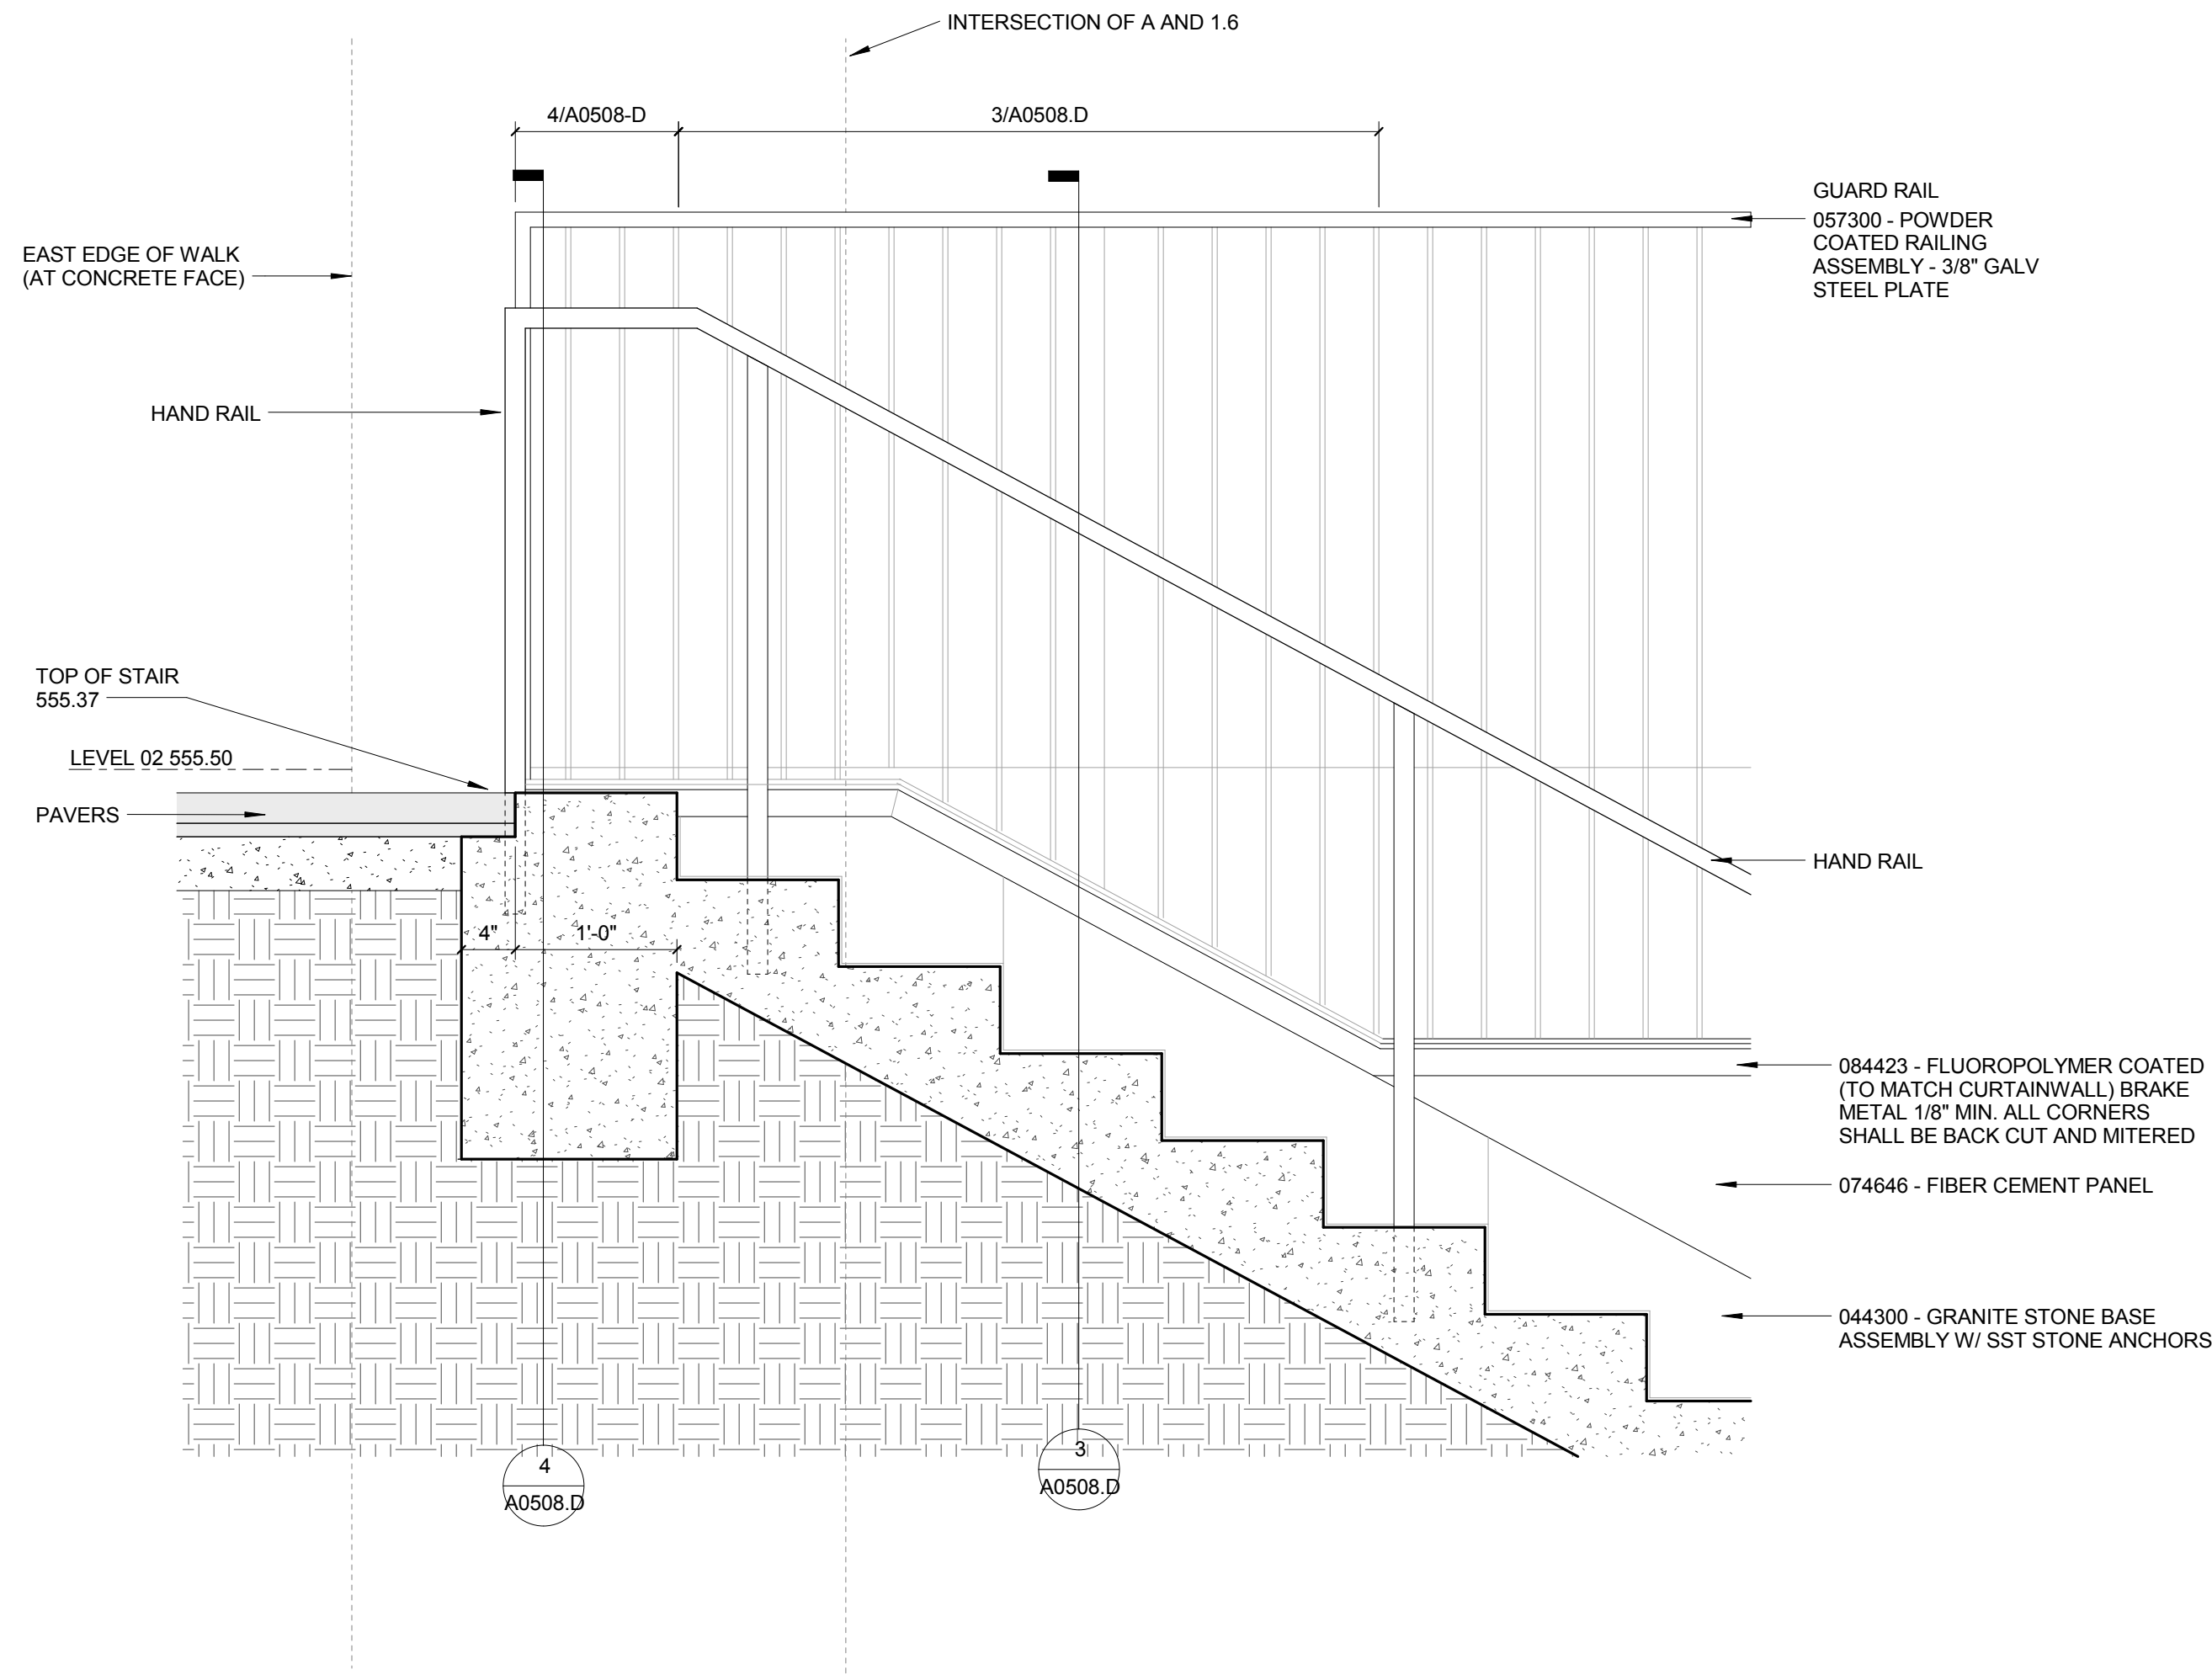

2 NORTH HAND RAIL ELEVATION
1" = 1'-0"

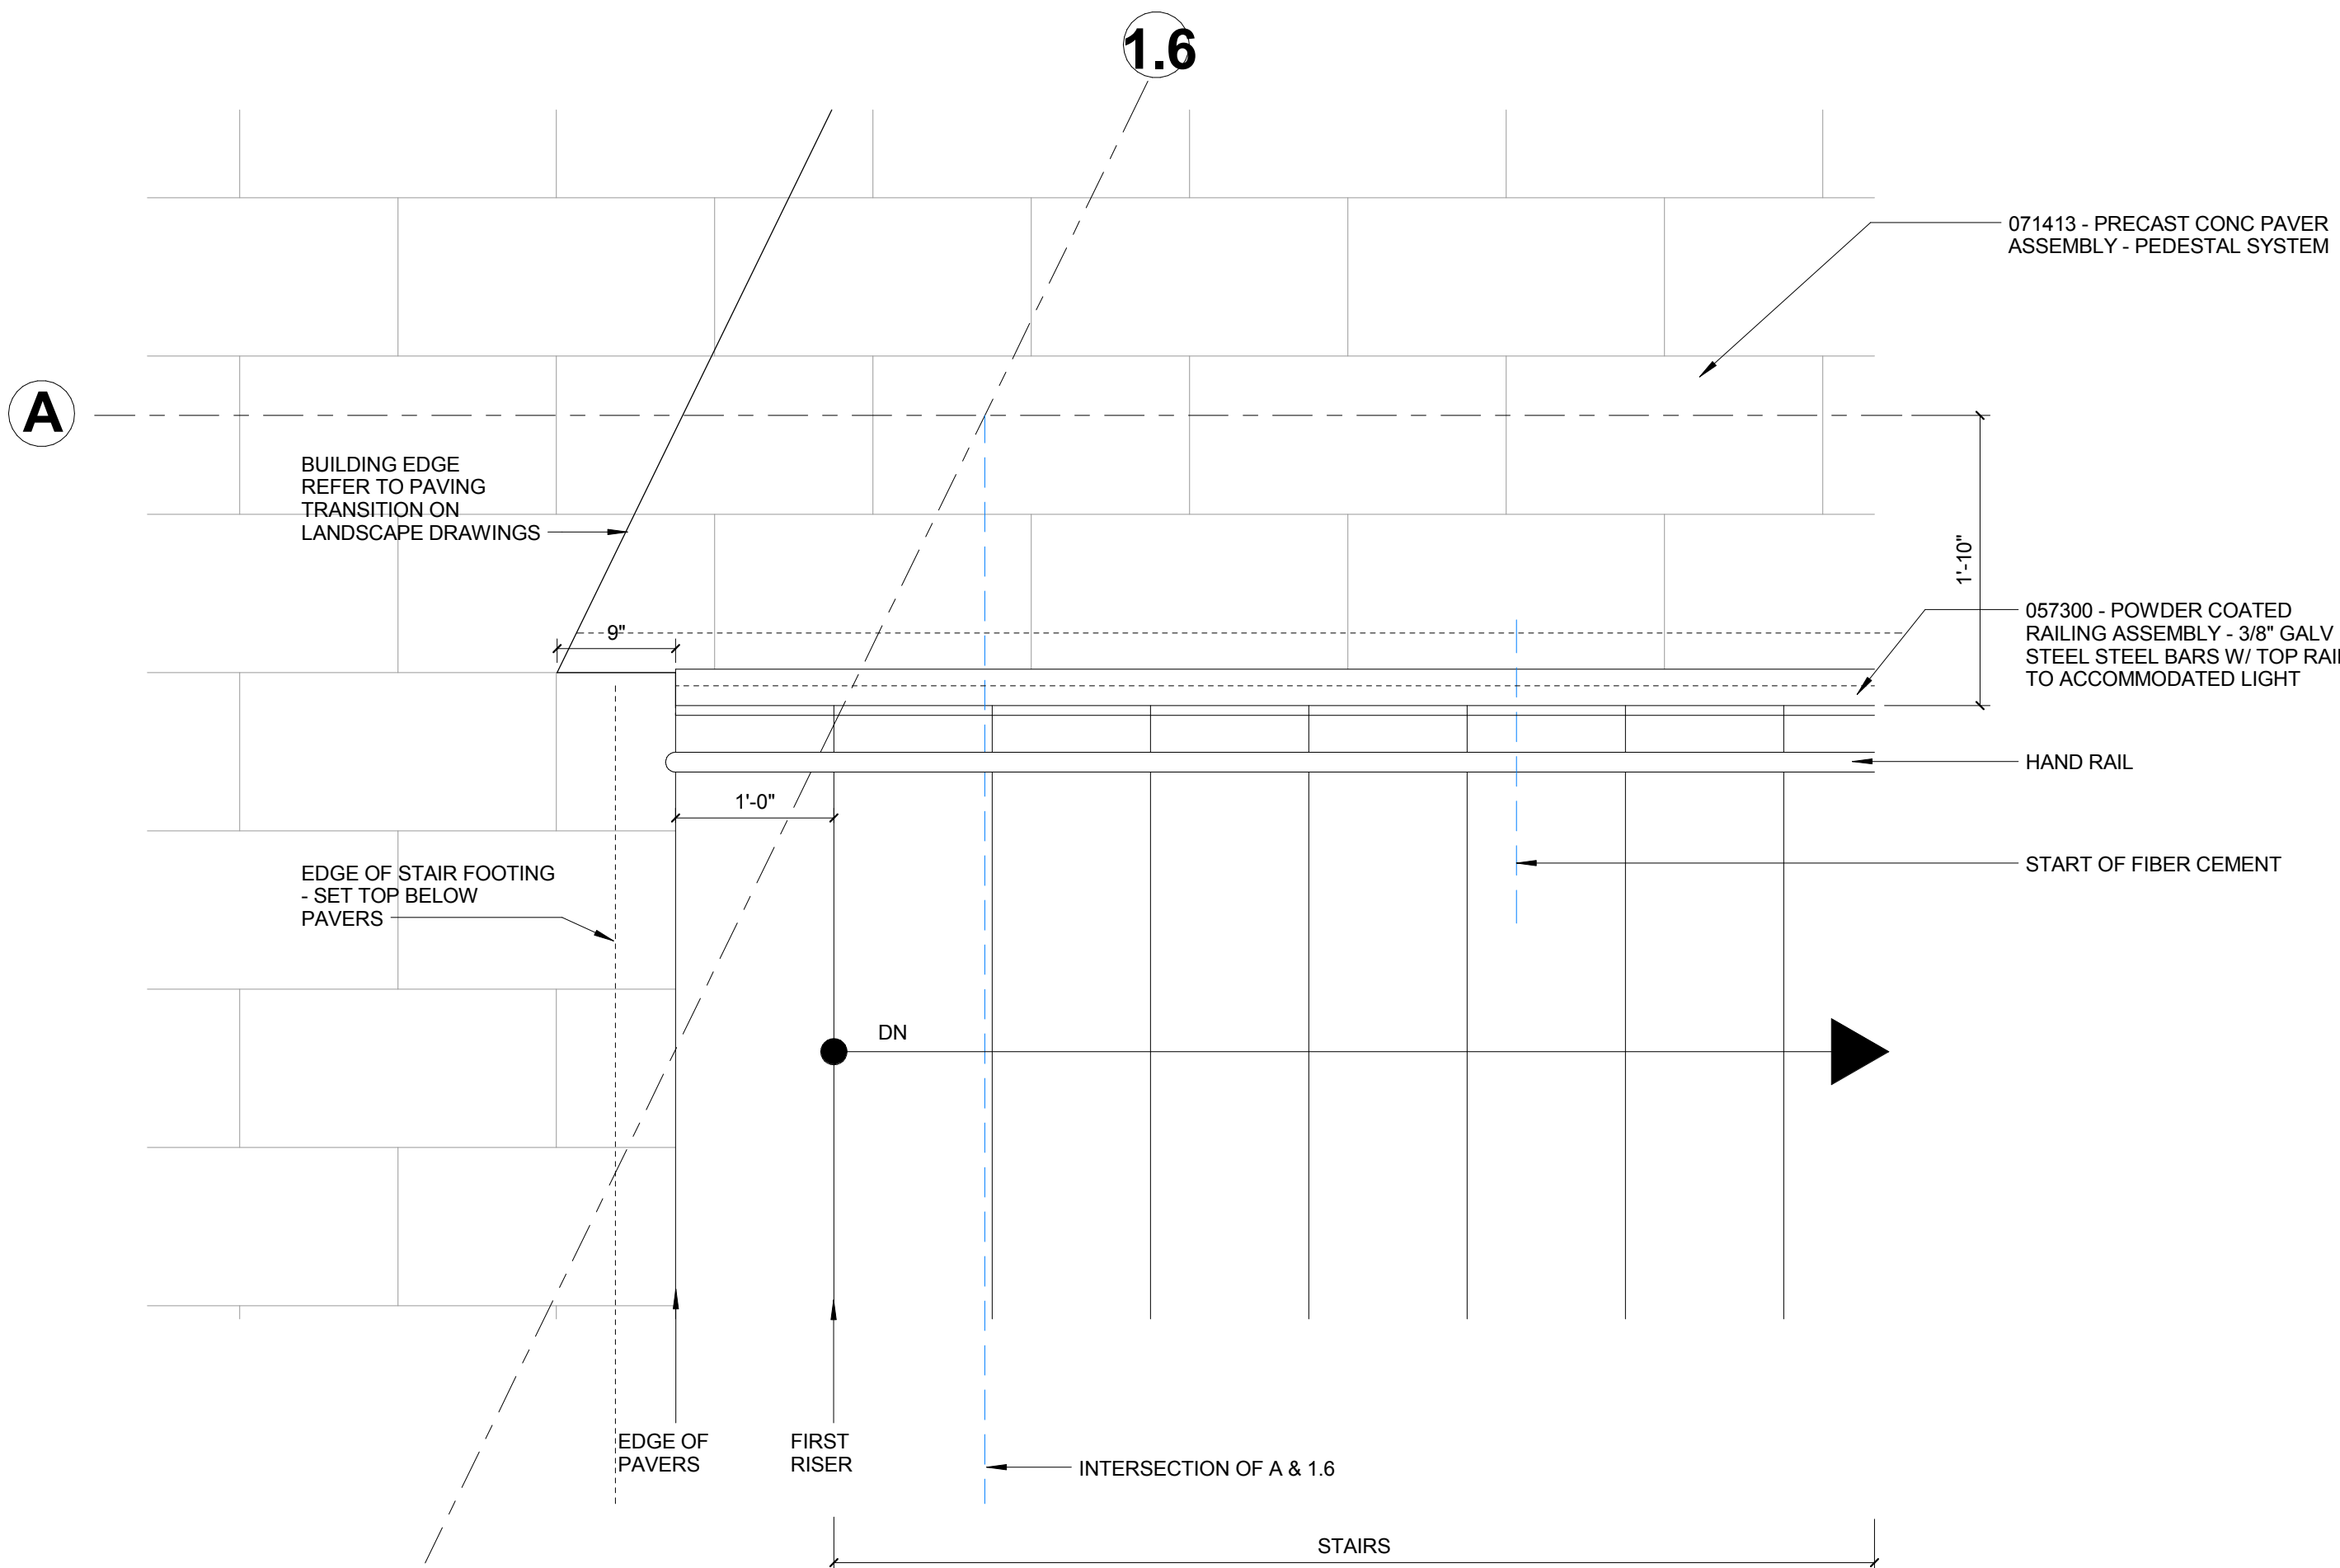


1 NORTH HAND RAIL DETAIL PLAN
1" = 1'-0"

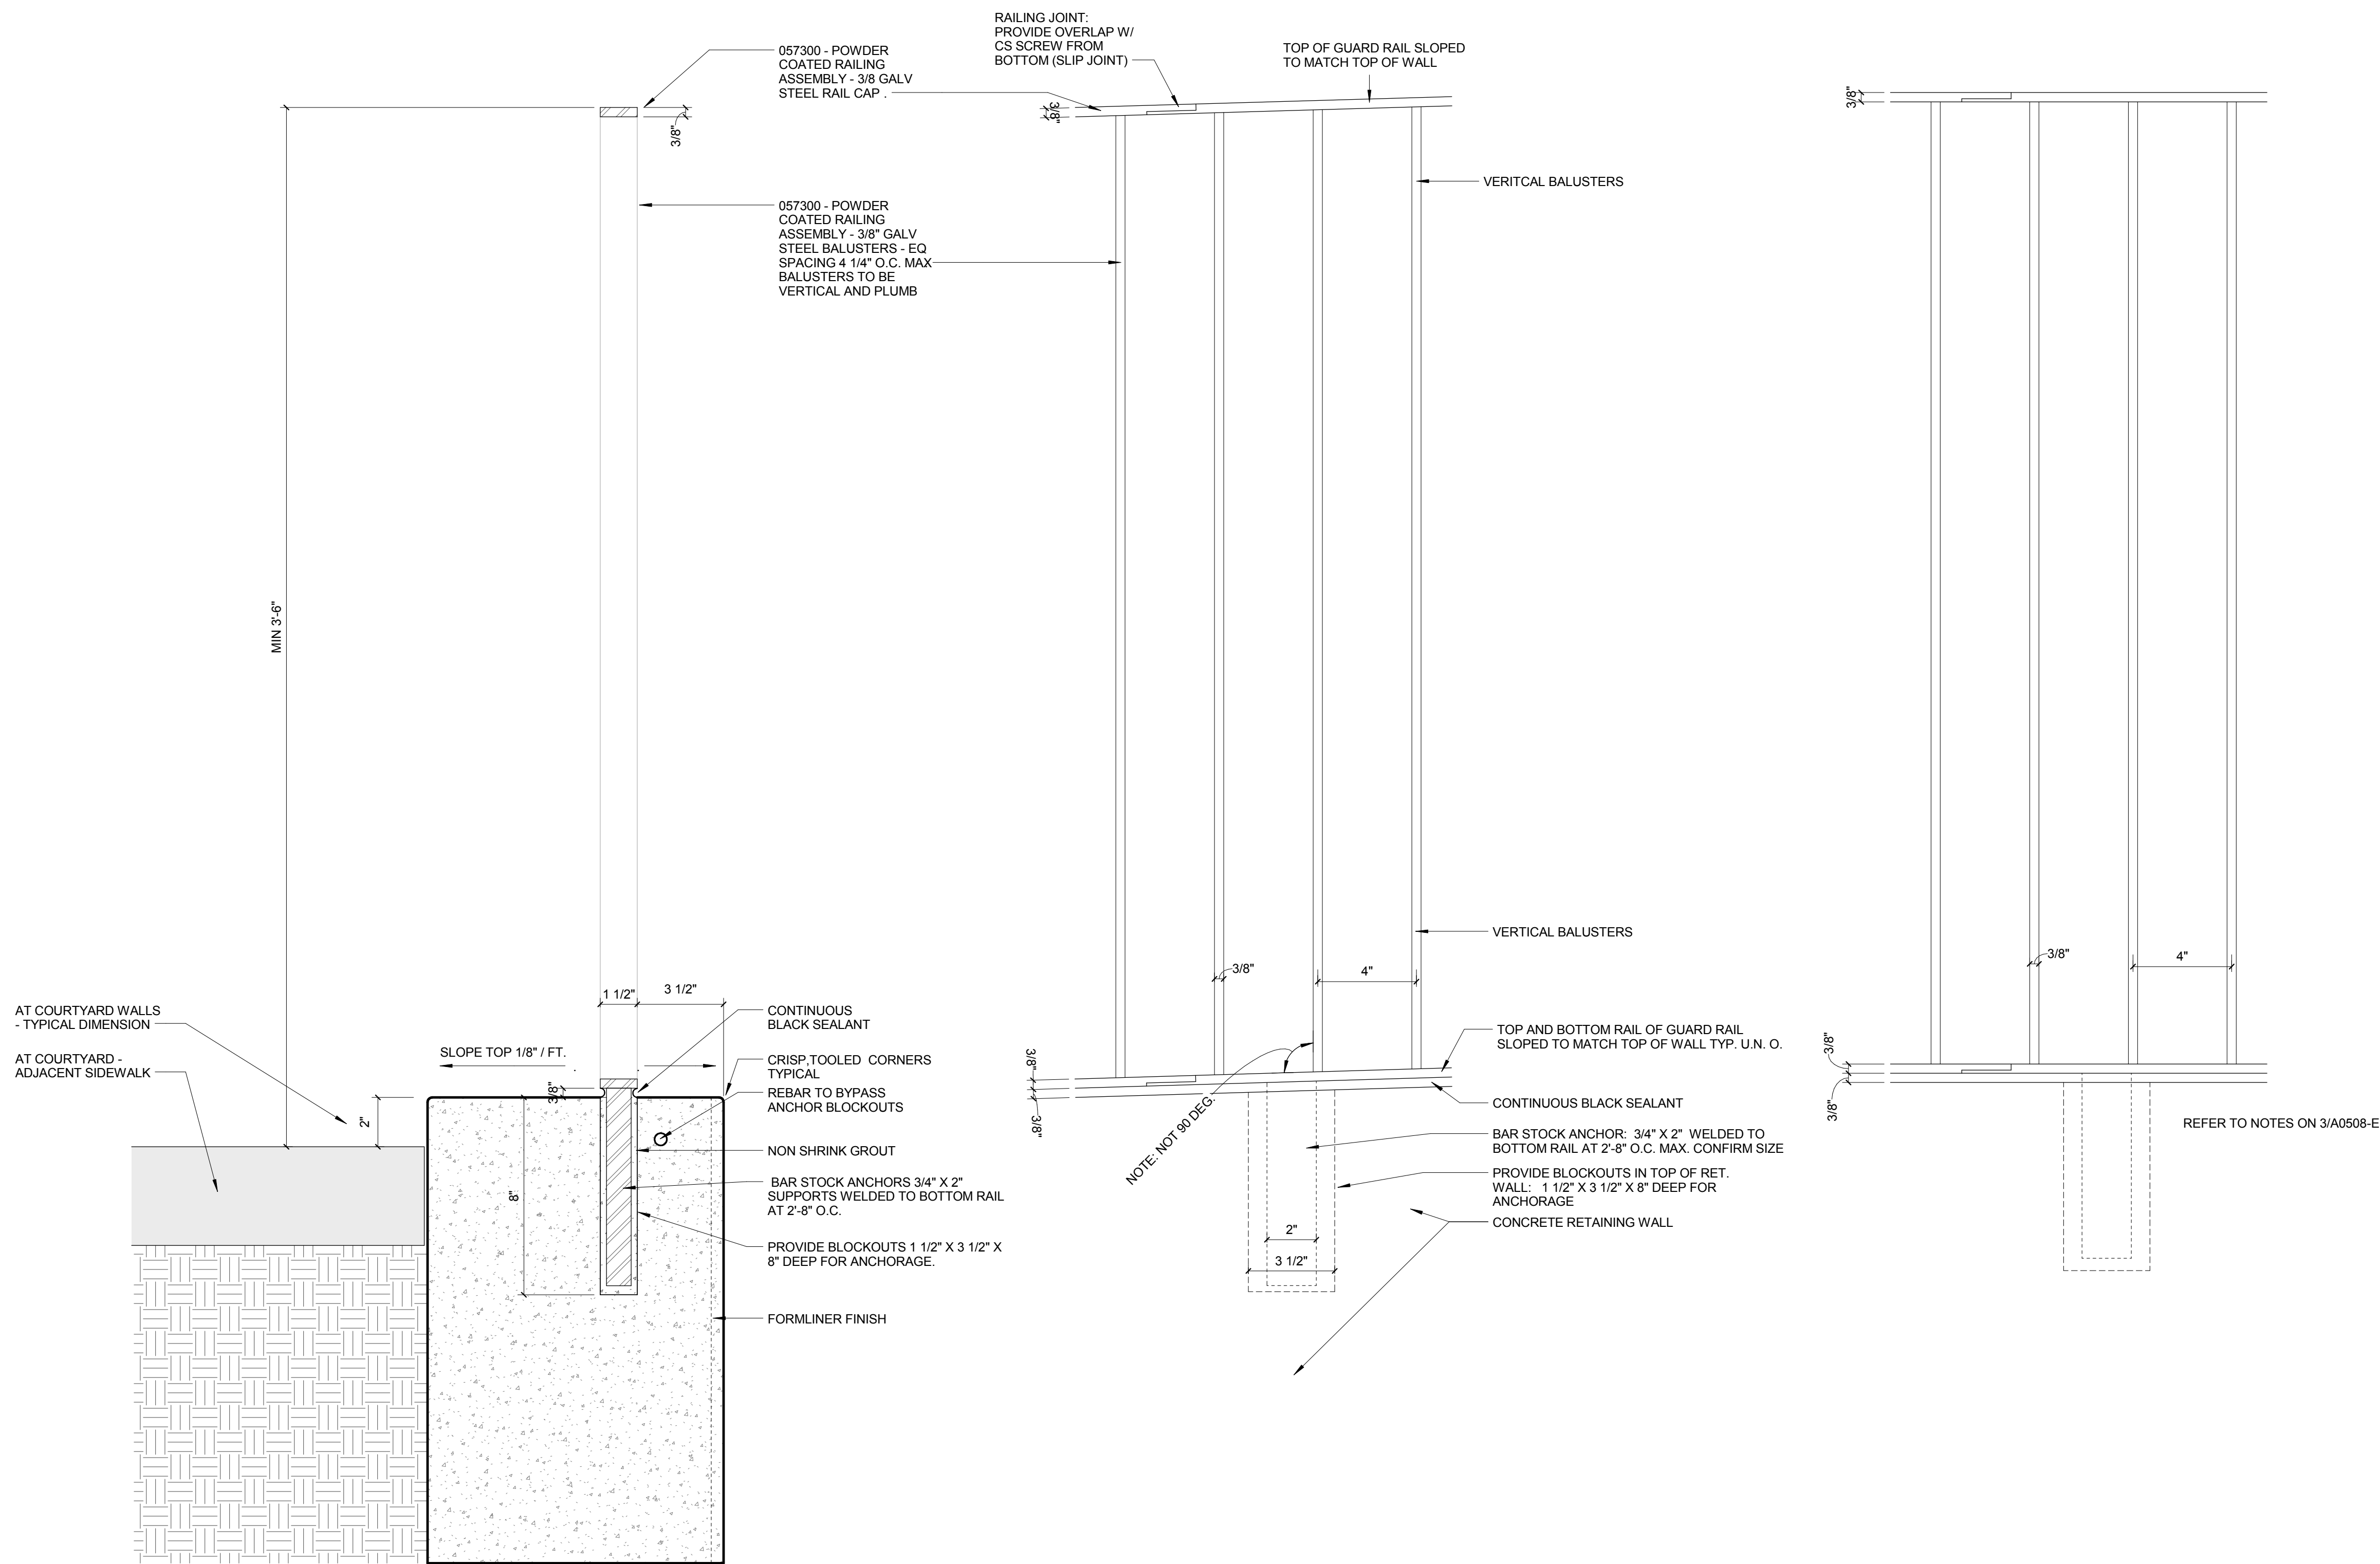

1 WEST WALL & RAIN GARDEN RAILING SECTION
3" = 1'-0"

3 WEST WALL RAILING ELEVATION
3" = 1'-0"

4 RAIN GARDEN RAILING ELEVATION
3" = 1'-0"

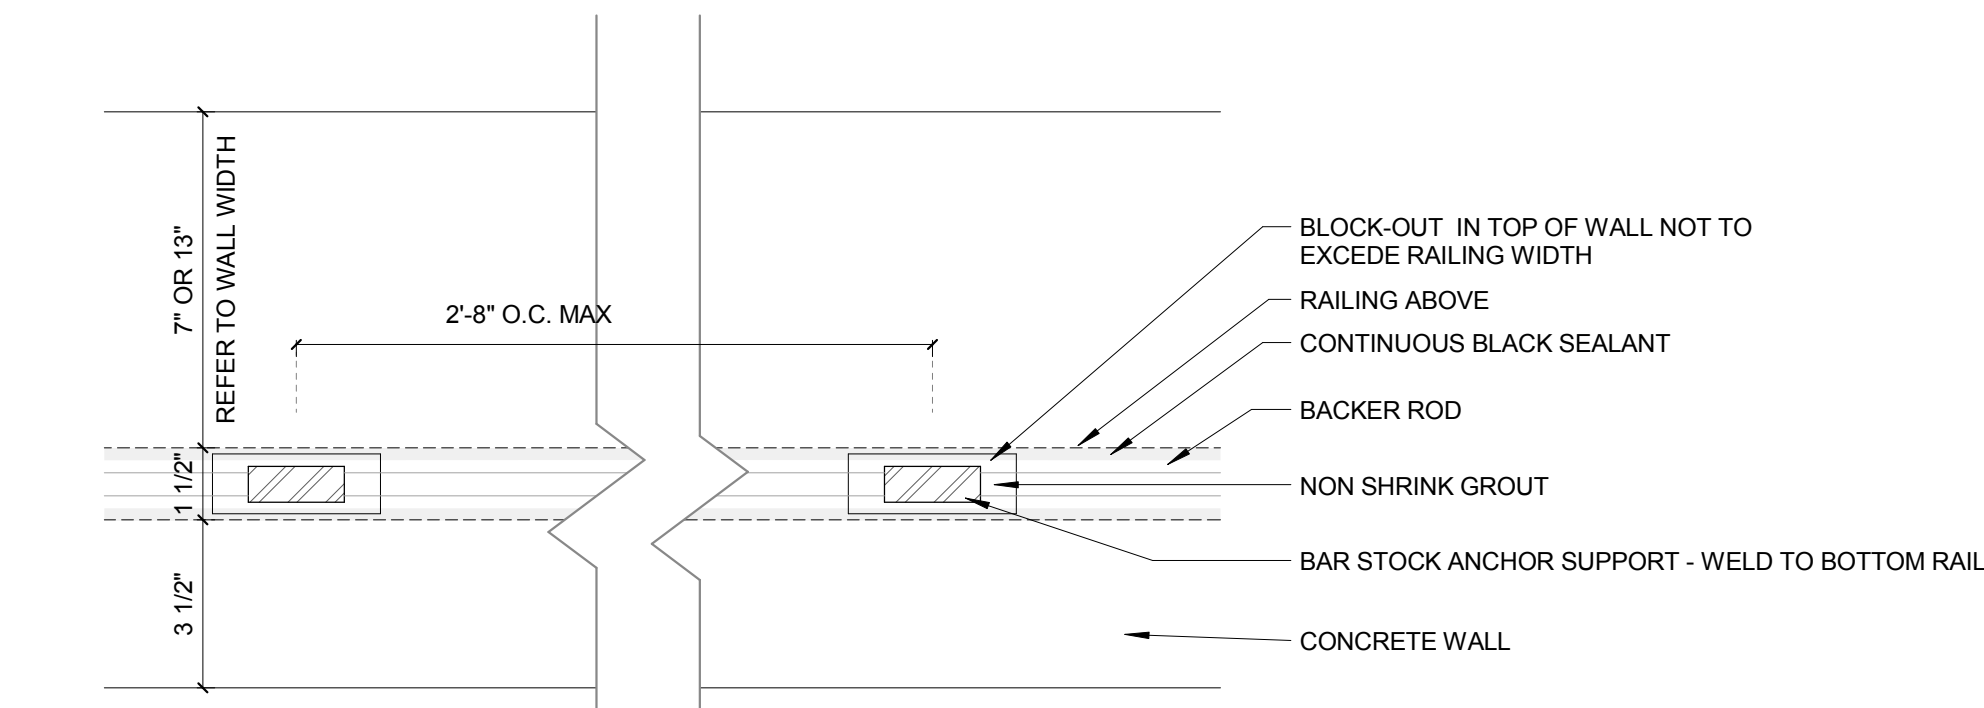

2 WEST WALL & RAIN GARDEN RAILING PLAN
3" = 1'-0"


1	ASI-003	01 AUG 2016
-	ISSUED FOR CONSTRUCTION (BP1)	15 JAN 2016
No.	Description	Date

Drawing Title:


RAILING DETAILS

Project No.: 04561.01 Checked by:

A0508.E

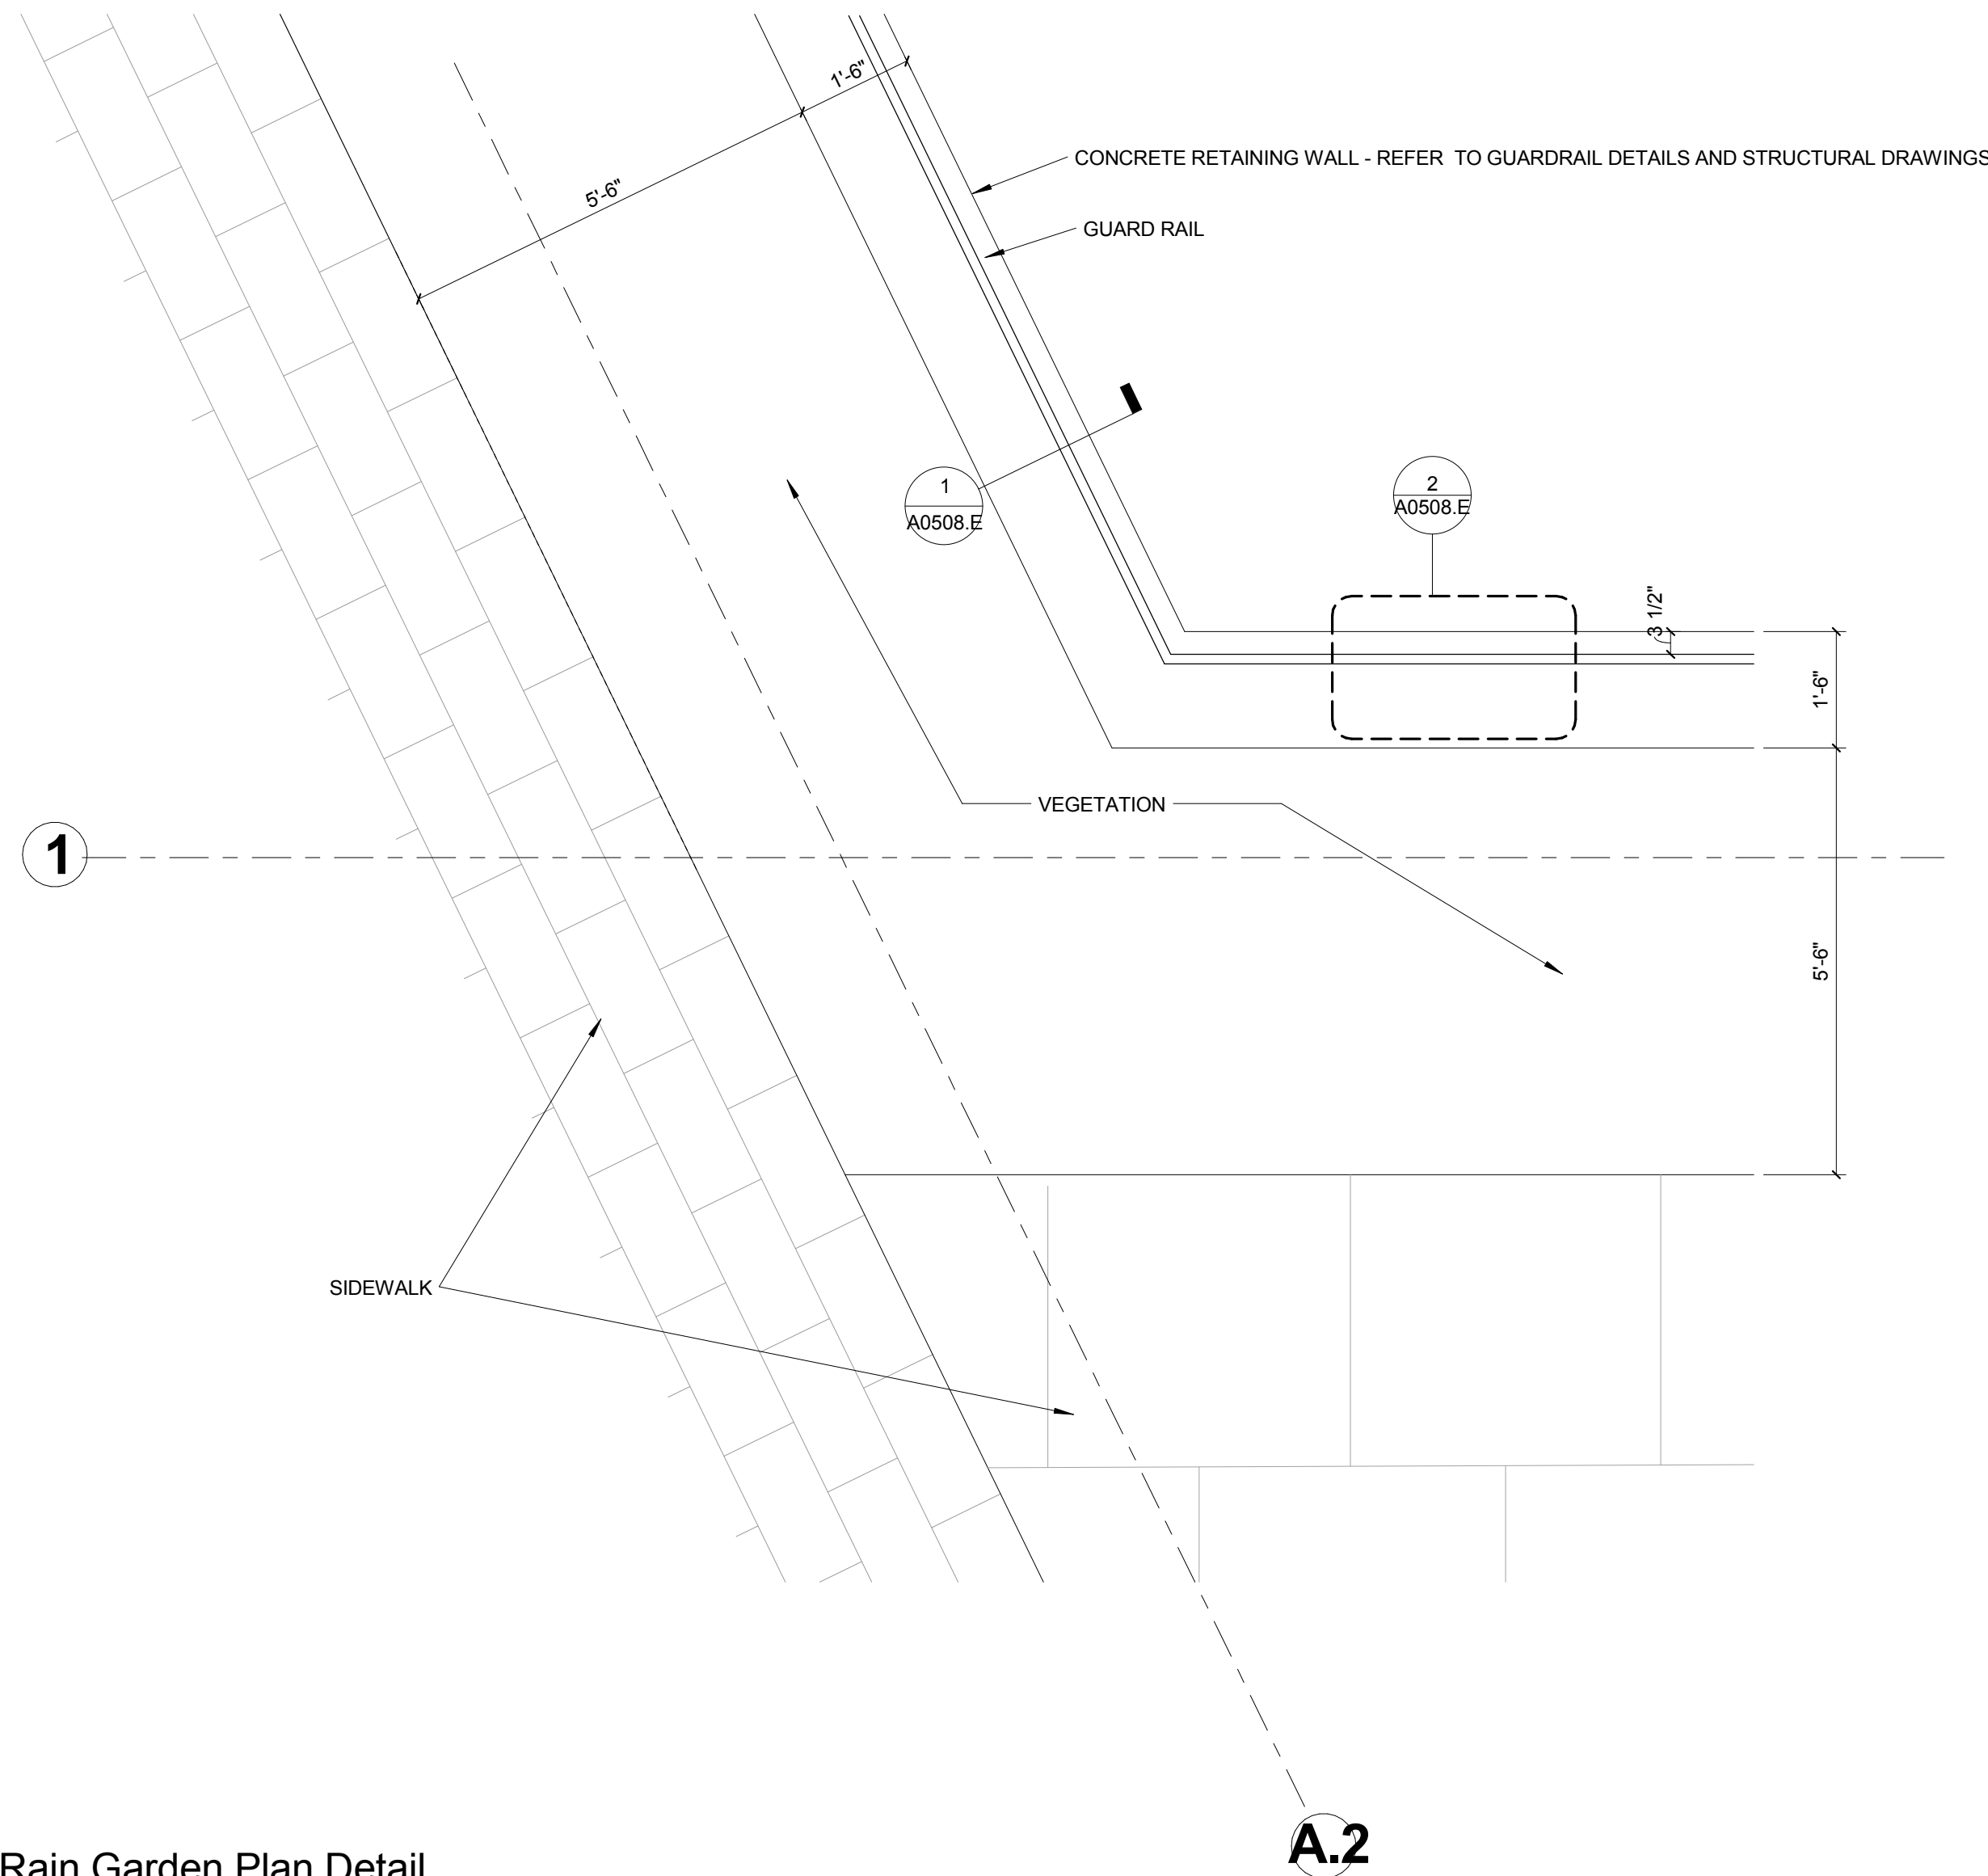

2 Rain Garden Plan Detail
1/2" = 1'-0"

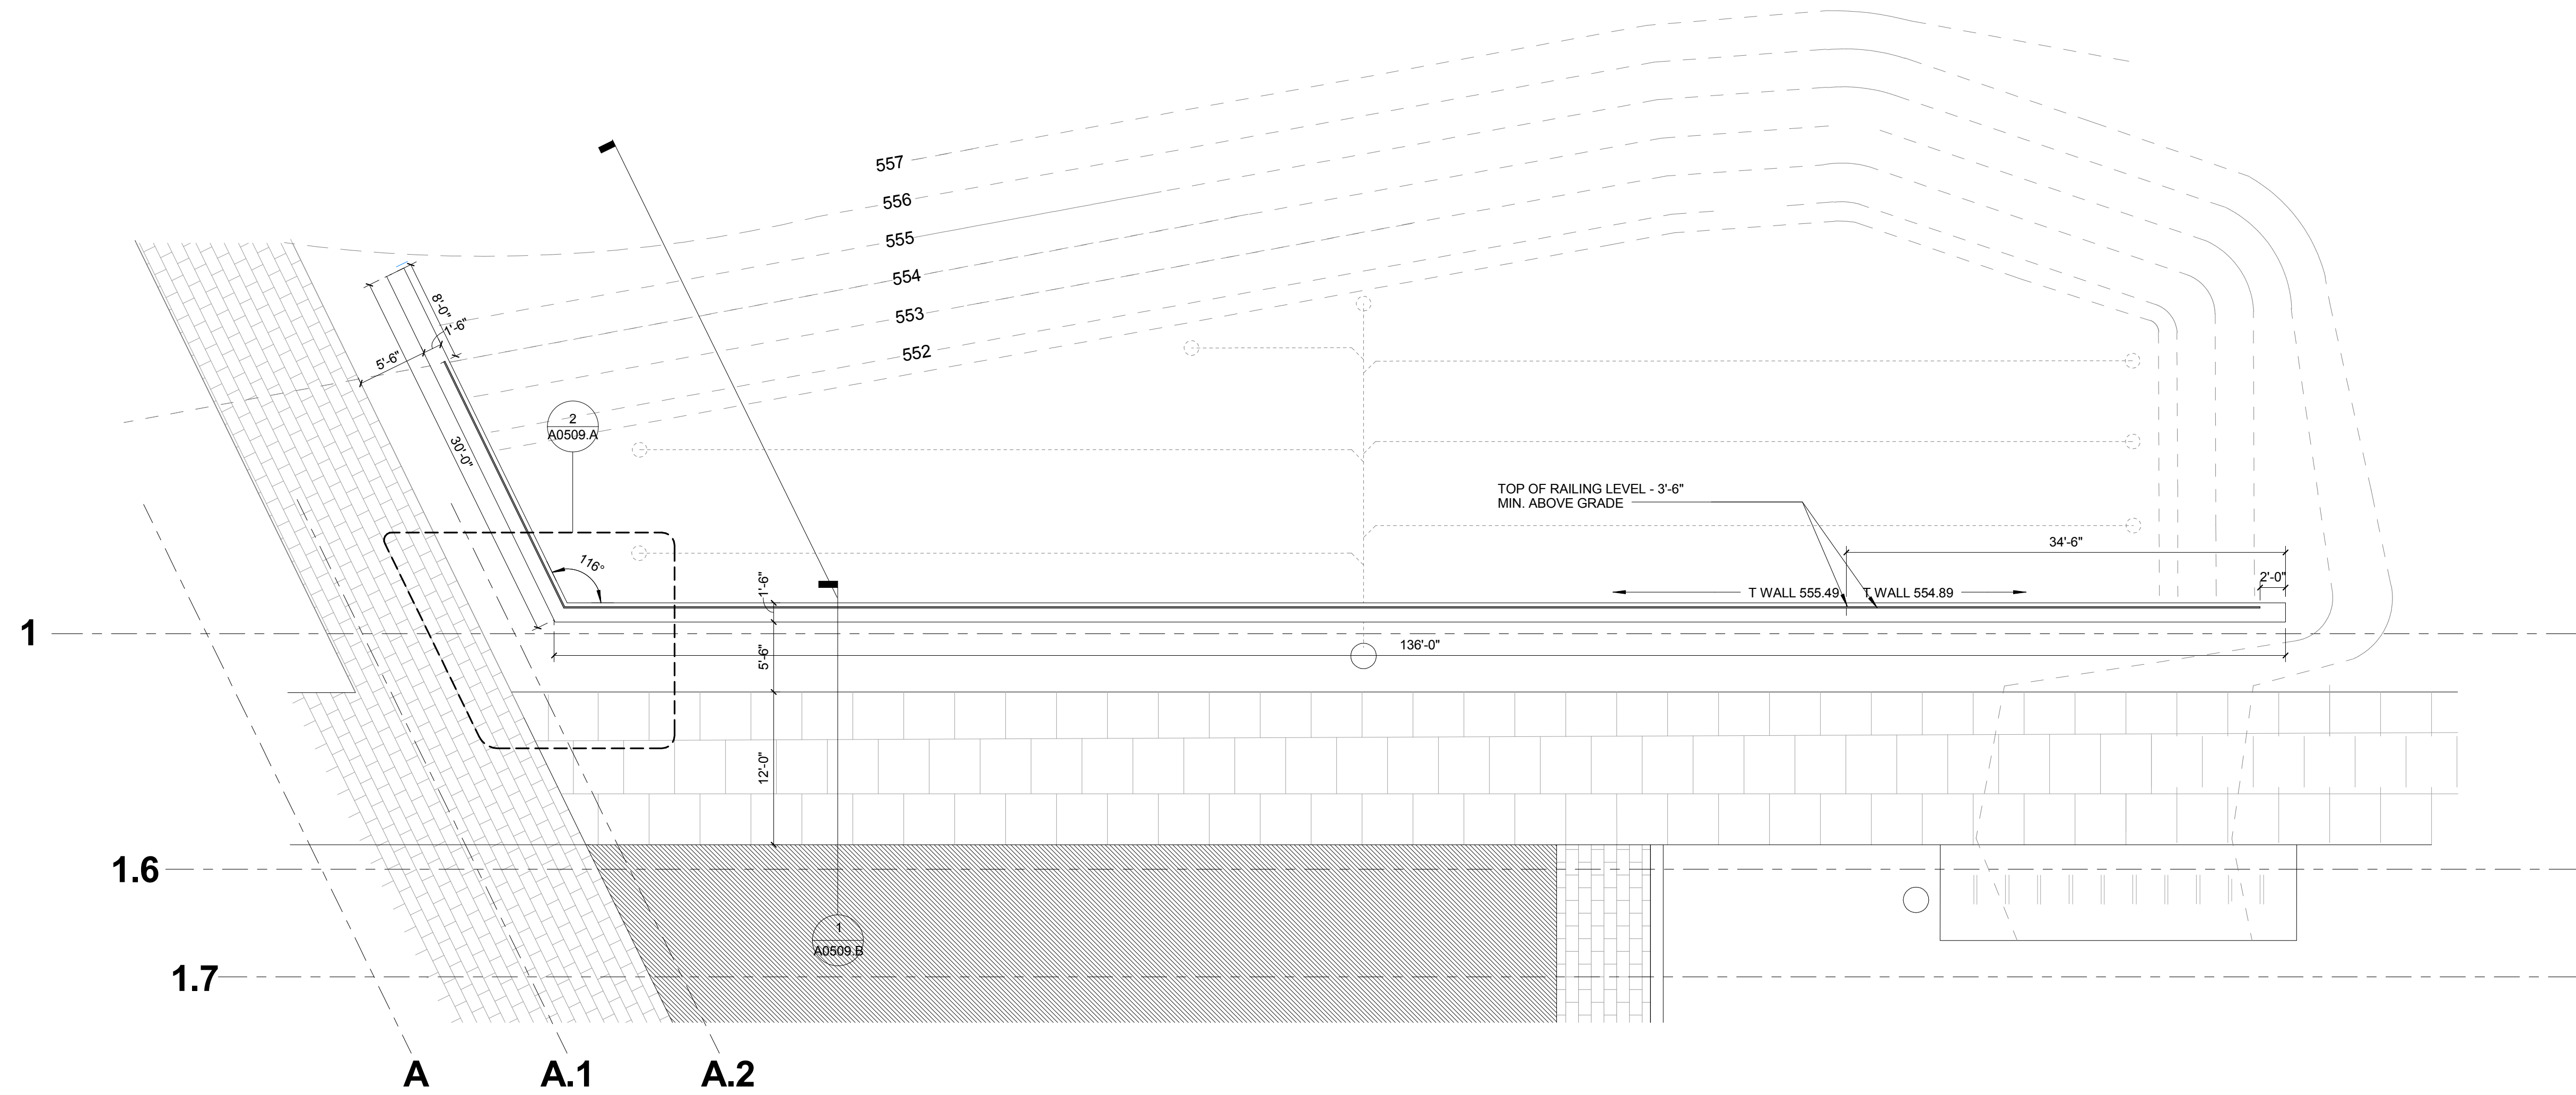

1 RAIN GARDEN PLAN
1/8" = 1'-0"

1	ASI-003	01 AUG 2016
-	ISSUED FOR CONSTRUCTION (BP1)	15 JAN 2016
No.	Description	Date

Drawing Title:

SITE WALLS - RAIN
GARDEN

Project No.: 04561.01

Checked by:

A0509.A

1	ASI-003	01 AUG 2016
-	ISSUED FOR CONSTRUCTION (BP1)	15 JAN 2016
No.	Description	Date


Drawing Title:

SITE WALLS - RAIN
GARDEN


Project No.: 04561.01

Checked by:

A0509.B

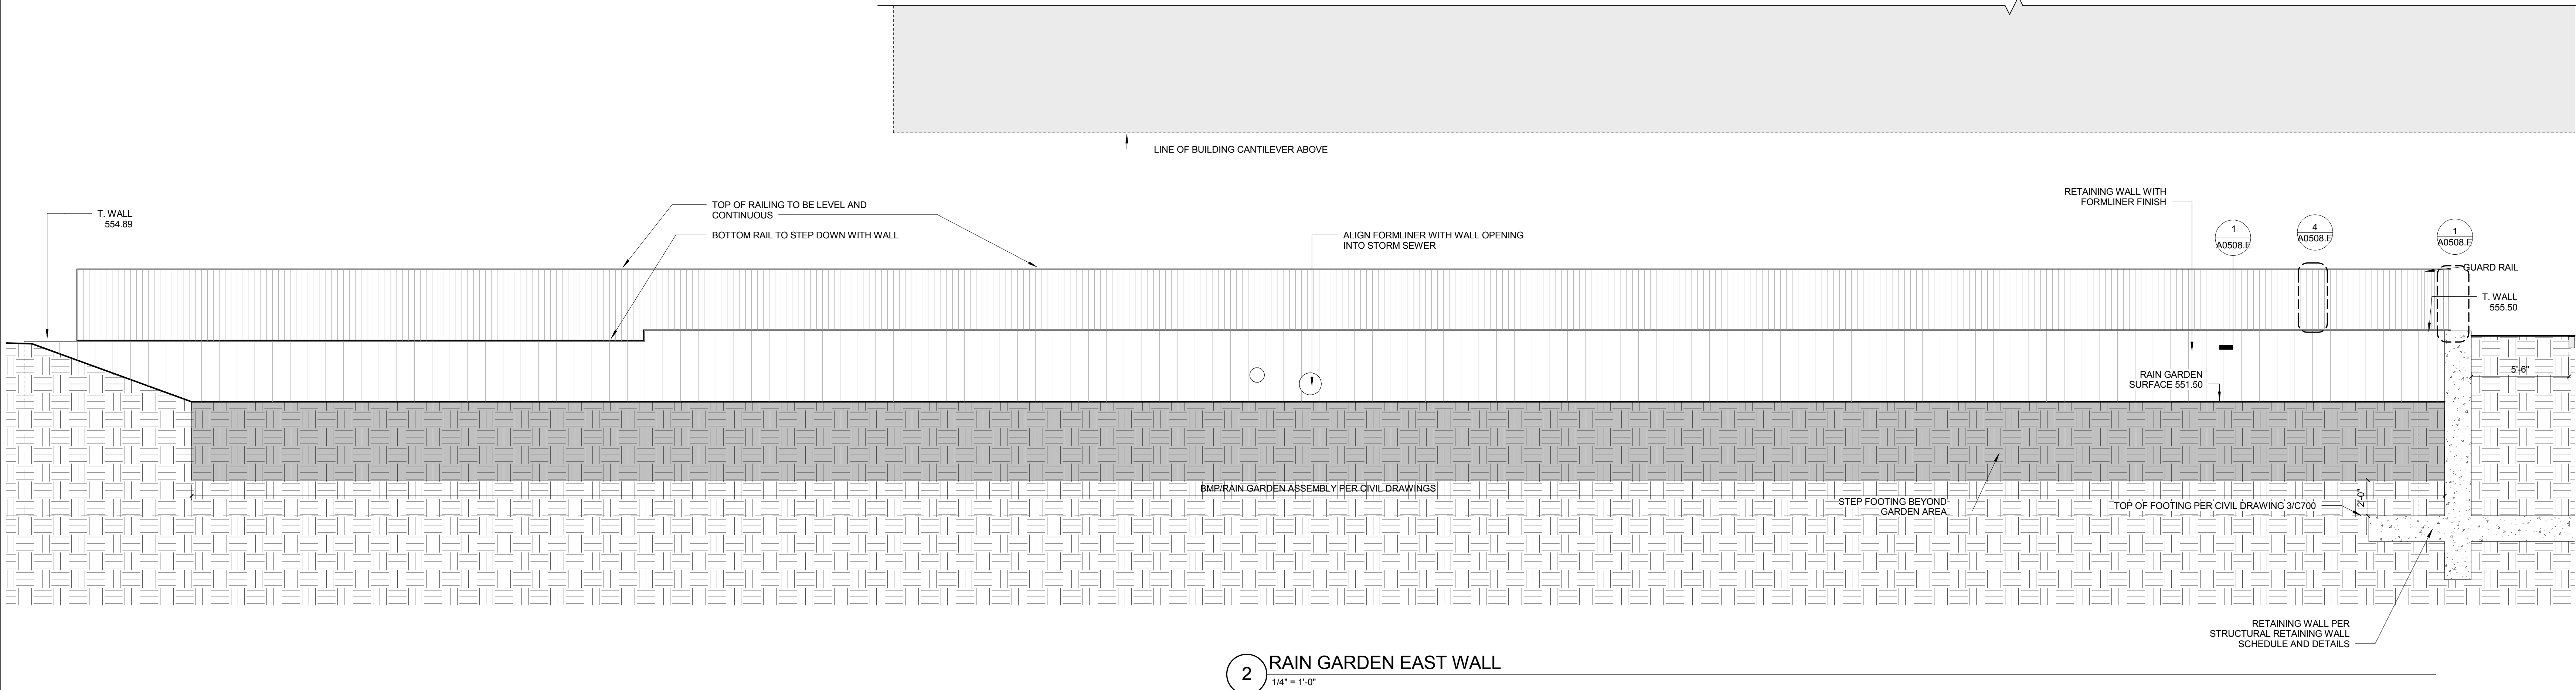

2 RAIN GARDEN EAST WALL
1/4" = 1'-0"

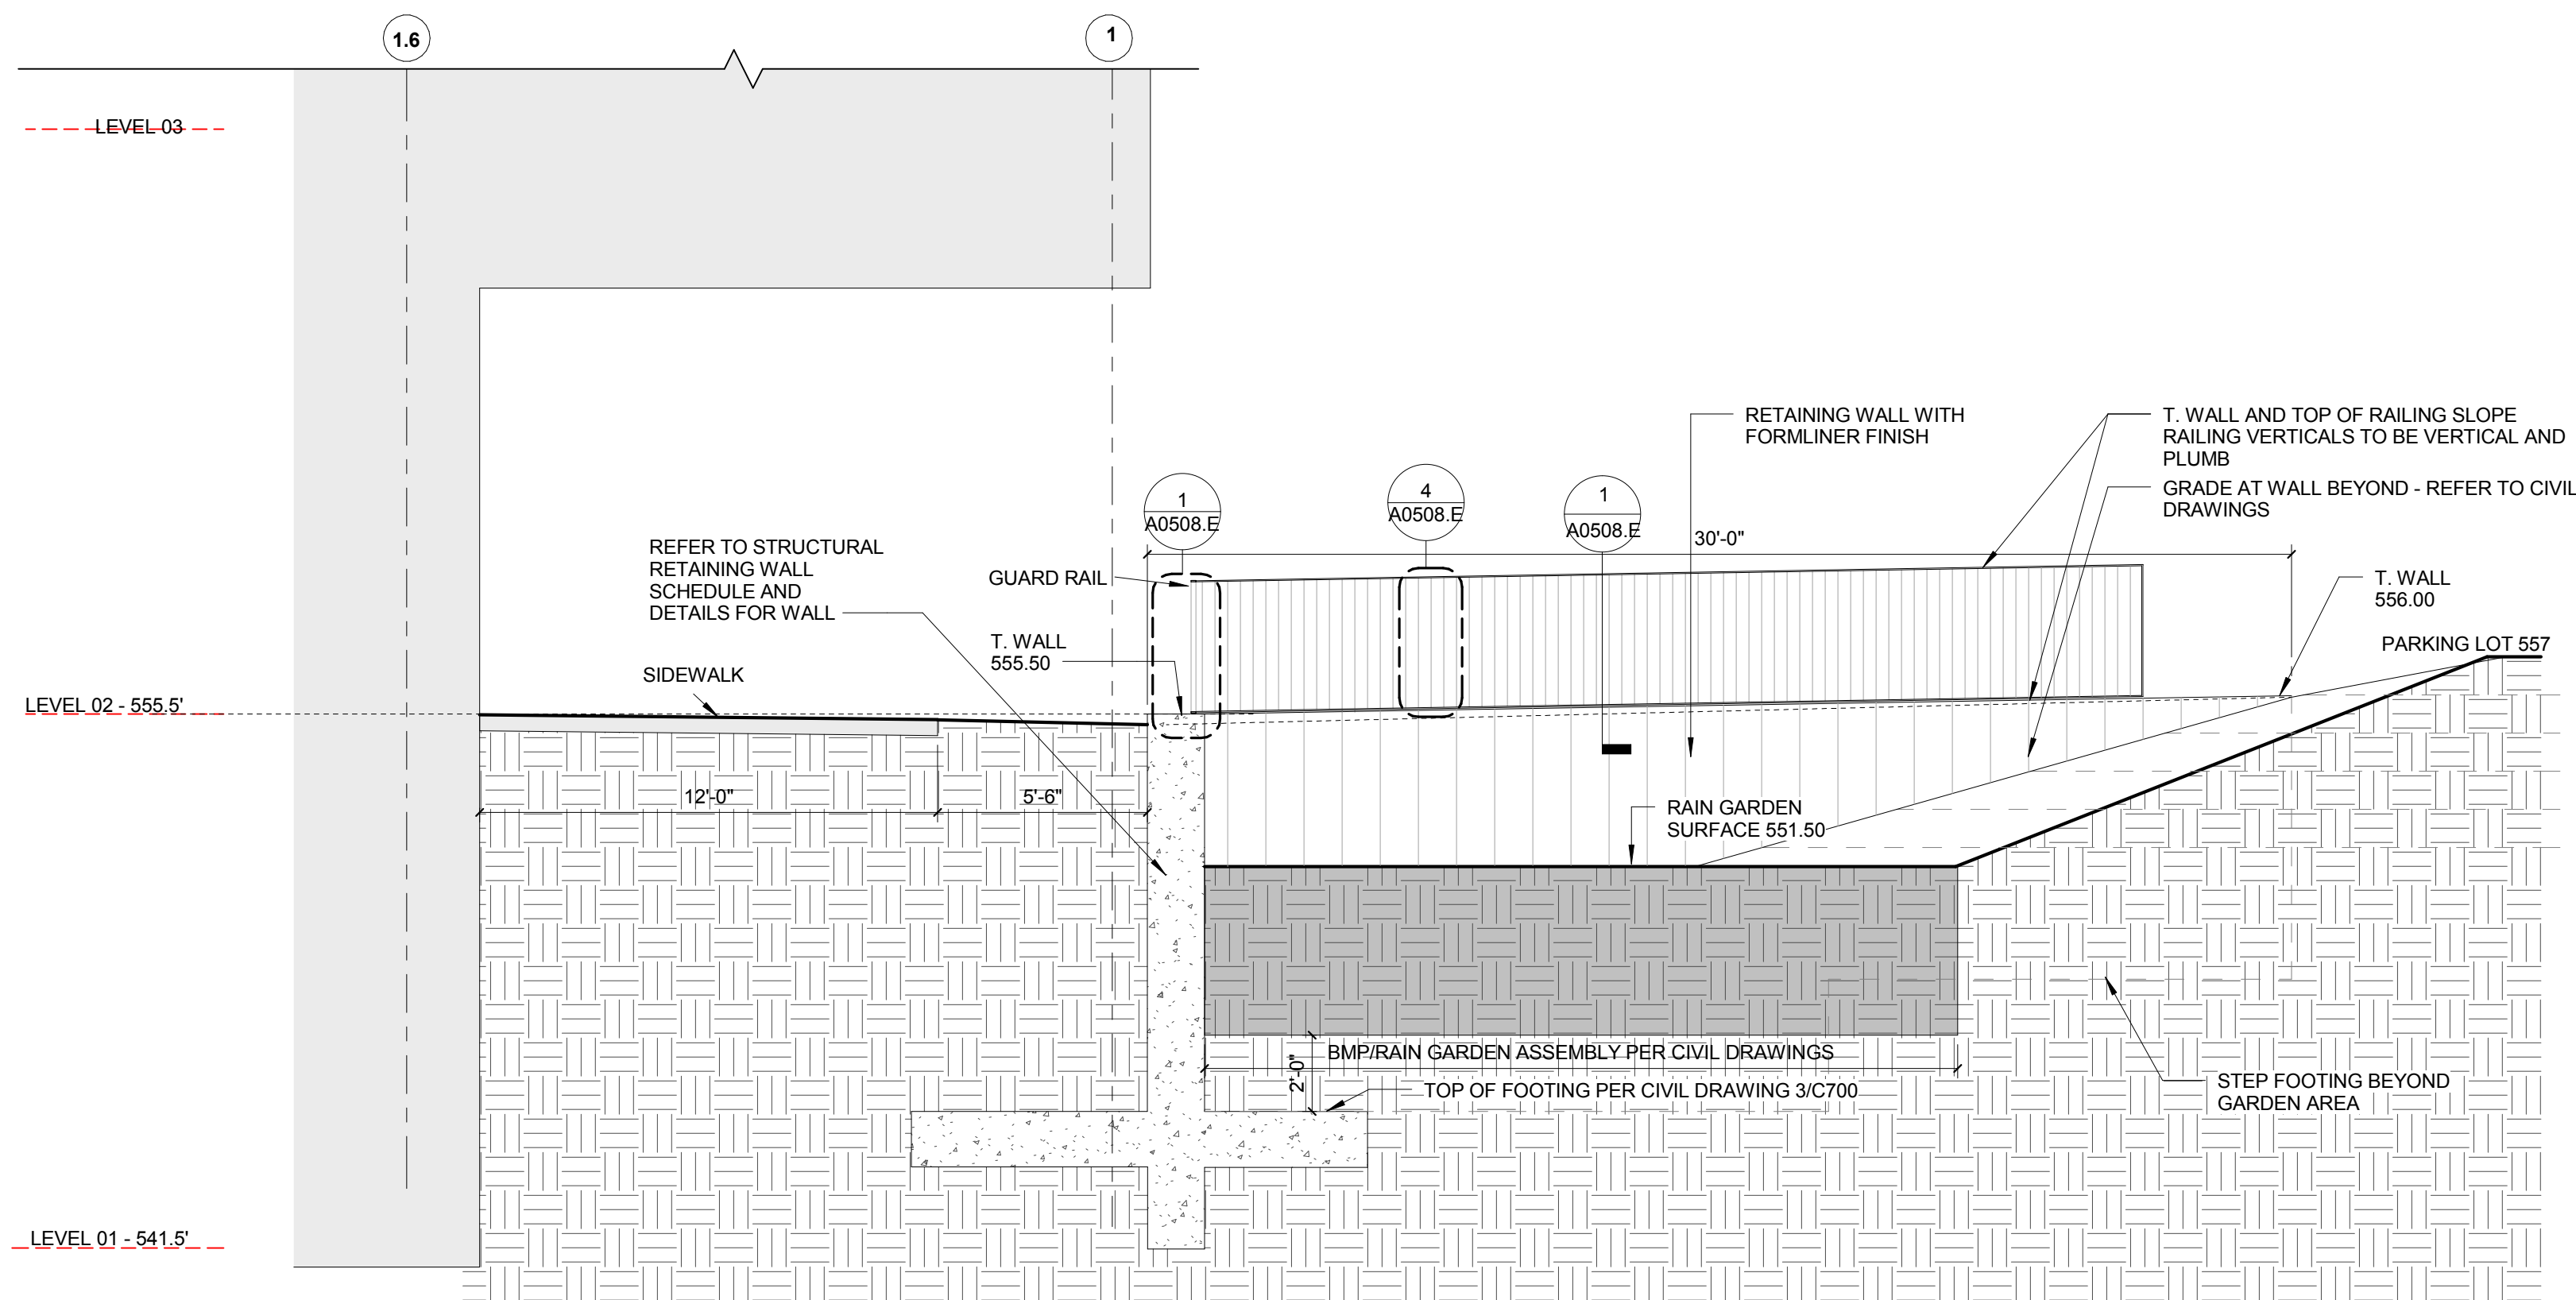

1 RAIN GARDEN SOUTH WALL
1/4" = 1'-0"