

Architect's Supplemental Instructions

Architect's Project No:
04561.01

Architect's ASI No: 029

Project:
Webster University
Interdisciplinary Science
Building

Date Issued: 07/10/2016

Contract Date:

Reason Code: 05 A/E Scope

Discipline Code: 07 7 General Construction
(Architectural)

St. Louis
Baltimore
Boston
Buffalo
Calgary
Chicago
Houston
Los Angeles
Mumbai
New York
Phoenix
San Francisco
Shanghai
Toronto
Vancouver
Victoria
Washington DC

Owner:
Webster University

Architect:
Cannon Design
1100 Clark Avenue
St. Louis, MO 63102

Contractor:
Paric Construction

Contract For: General construction

The Work shall be carried out in accordance with the following supplemental instructions issued in accordance with the Contract Documents without change in Contract Sum or Contract Time. Indicate your acceptance of these instructions for minor change to the Work as consistent with the Contract Documents and return a copy to the Architect within fourteen (14) business days of the date of issuance of these instructions. If you feel a change in Contract Sum or Contract Time is warranted, please submit an itemized quotation for the changes for approval within fourteen (14) business days of the date of issuance of these instructions prior to proceeding on the Work. Proceeding with the Work in accordance with these instructions indicates your acknowledgement that there will be no change.

Attachments:

Drawings: EG102

1100 Clark Avenue
St. Louis, Missouri
63102
T: 314.241.6250
F: 314.241.2570
www.cannondesign.com

Reason Codes:
#1. Jurisdictional Agency
#2. Constructor Driven
#3. Document Inconsistency
#4. Fast Track Driven
#5. A/E Scope
#6. Owners Scope
#7. Unforeseeable Conditions
#8. Other

Discipline Codes
#1. Demo-demolition
#2. Div1-Division 1 items on the spec book
(this item is not used)
#3. Electrical
#4. Elevator
#5. Equipment (Changes in equipment,
Owner Purchased)
#6. Fire Protection

Discipline Codes
#7. General Construction (Architectural)
#8. General Conditions (Div. 1)
#9. HVAC
#10. Other
#11. Plumbing
#12. Site Work/Landscaping
#13. Structural

Architect's Supplemental Instructions

Page 2

Description:

1. EG102 – Environmental Graphics
 - A. Omit “W” with 1/16” Naval brass with satin finish on all levels.

Please submit an itemized proposal for changes in contract Sum and Contract Time for proposed modifications to the Contract Documents described herein:

Issued by Architect:


Jill Berkbuegler-Lembke, Kuhlmann Leavitt, Inc.

Accepted by Contractor:

Environmental Graphic Type:

EG1

EG1-Overall Multi-Level Feature Wall

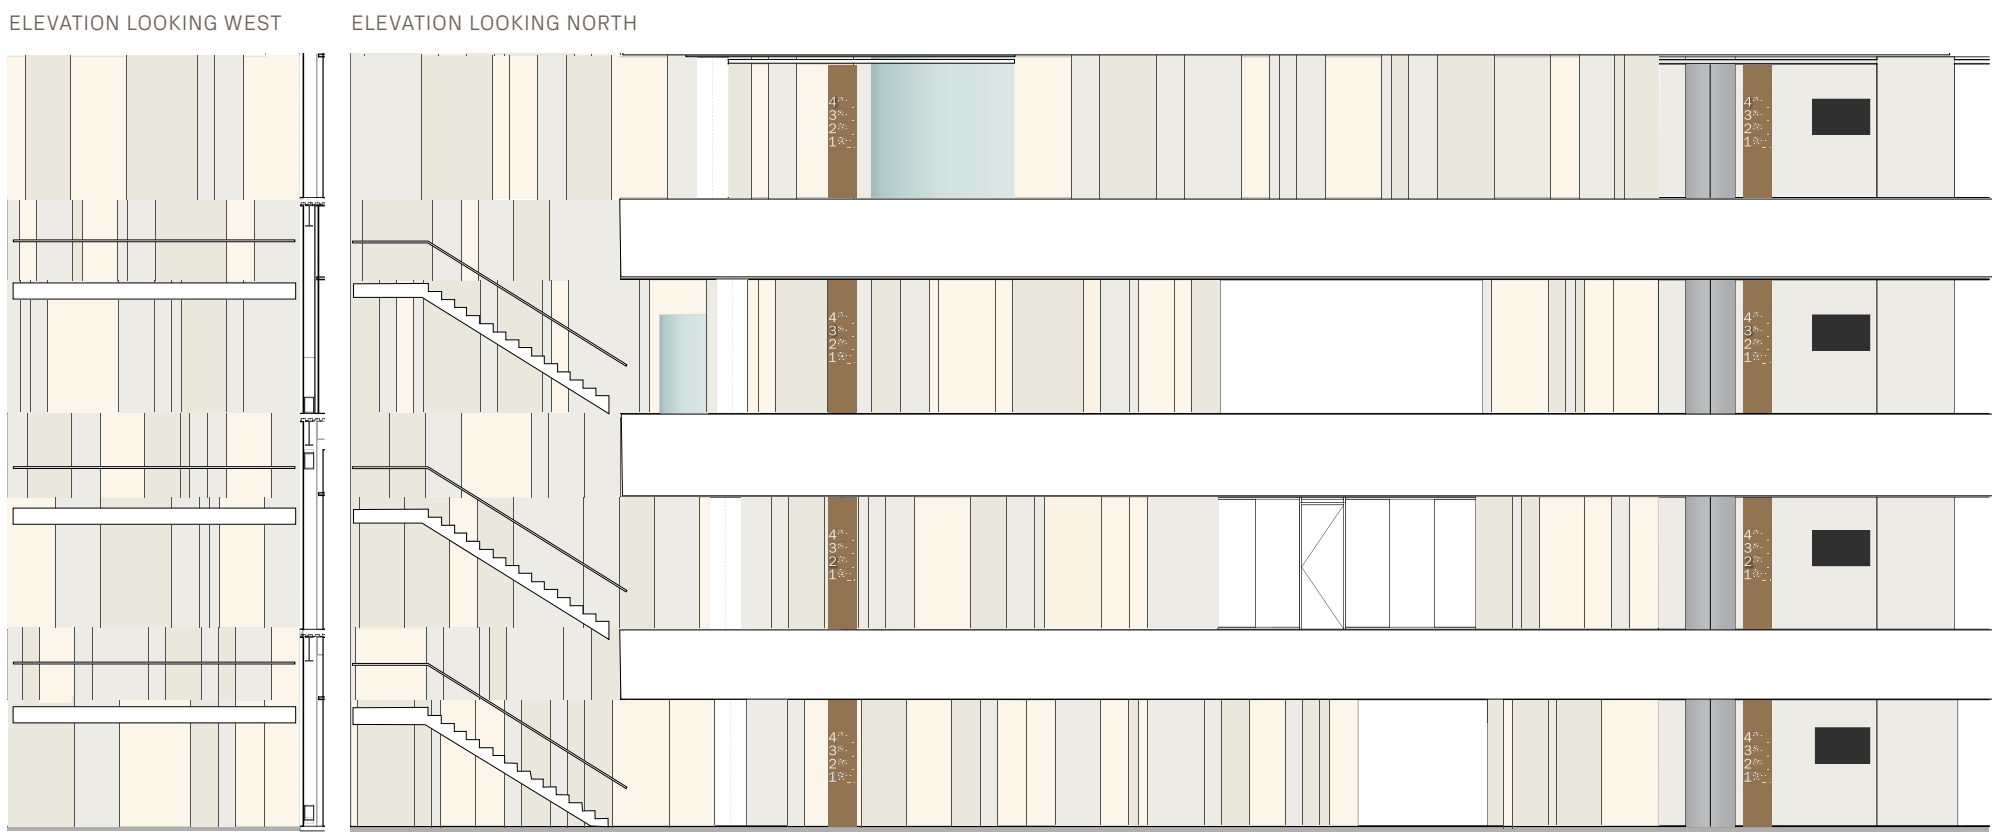

* DESIGN ASSIST:
FABRICATOR RESPONSIBLE FOR DETERMINING STRUCTURAL INTEGRITY OF INSTALLATION AND OVERALL ENGINEERING THROUGH SHOPS AND THE SAMPLE AND MOCKUP PROCESS. DRAWINGS HERE TO SHOW DESIGN INTENT ONLY AND ARE NOT A REPLACEMENT FOR SHOP DRAWINGS.

This information is no longer in scope

* SEE PROJECT MANUAL SECTION 101400 FOR SAMPLE AND MOCK-UP REQUIREMENTS.

EG1

Environmental Graphic Type:

EG1

EG1-111 Multi-Level Feature Wall


* DESIGN ASSIST:
SEE EG-1-OVERALL

PANELS ARE 3/4" PAINTED MDF WITH
3/32" BUTT JOINT REVEAL IN 3 DIFFERENT
PROJECT COLORS: 1. COLOR A,
2. COLOR B & 3. COLOR C WITH A SMOOTH
LACQUER FINISH

PANELS RUN CEILING HEIGHT TO
BASEBOARDS.
7 TOTAL PANEL WIDTHS USED
8": 14", 24", 30", 48" & 60"


COLOR AND PANEL WIDTH KEY:
COMMON PANEL WIDTH
8"
14"
24"
30"
38"
48"
60"
ODD PANEL WIDTH
8.5"
9"
12.5"
13"
34.5"

PANEL COLOR
COLOR A
COLOR B
COLOR C

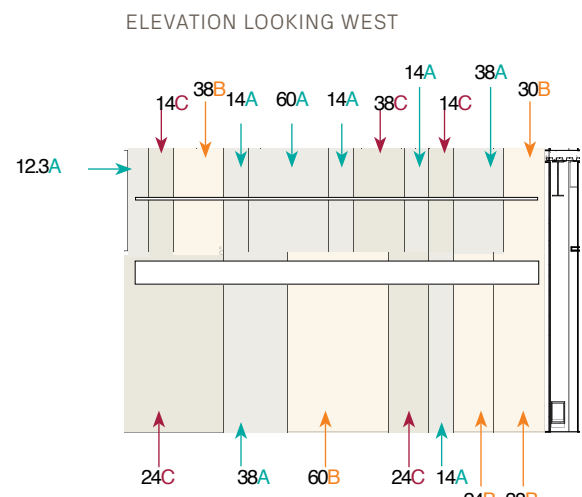

This information is no longer in scope

ELEVATION LOOKING NORTH

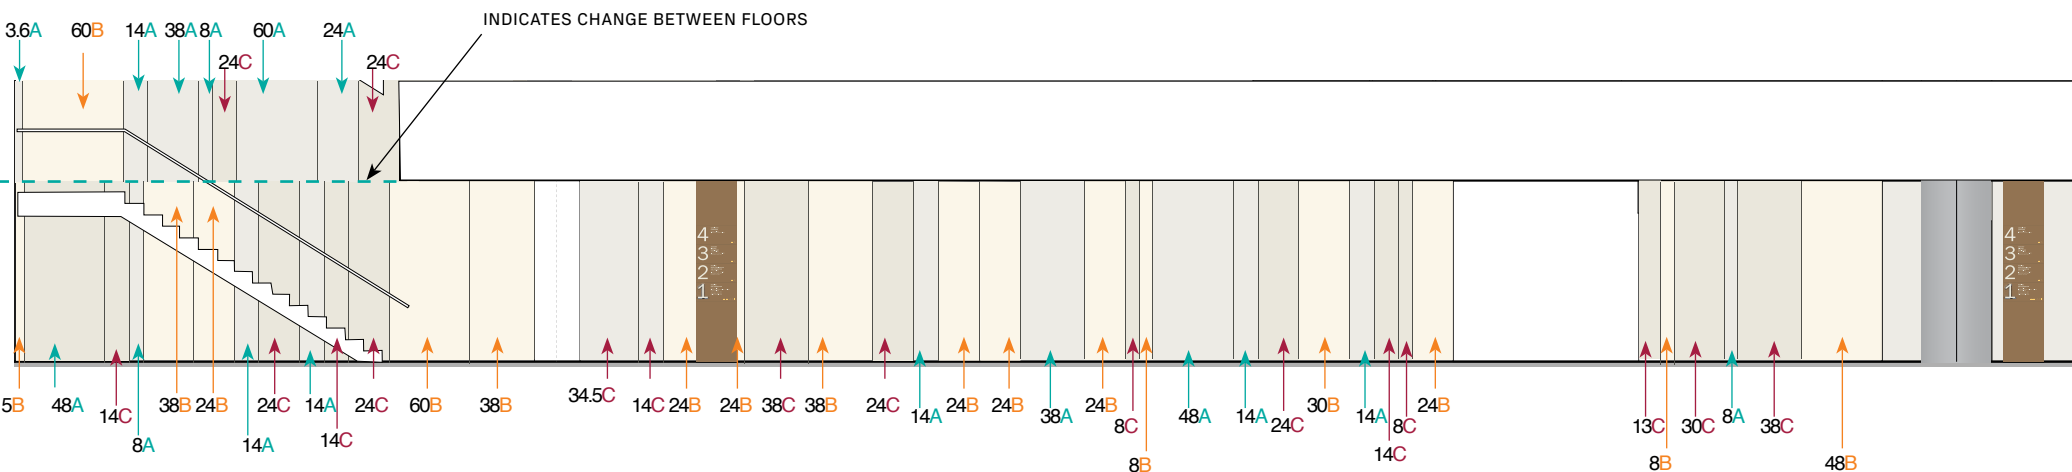

EG1

Environmental Graphic Type:

EG1

EG1-214 Multi-Level Feature Wall


* DESIGN ASSIST:
SEE EG-1-OVERALL

PANELS ARE 3/4" PAINTED MDF WITH
3/32" BUTT JOINT REVEAL IN 3 DIFFERENT
PROJECT COLORS: 1. COLOR A,
2. COLOR B & 3. COLOR C WITH A SMOOTH
LACQUER FINISH

PANELS RUN CEILING HEIGHT TO
BASEBOARDS.
7 TOTAL PANEL WIDTHS USED
8": 14", 24", 30", 48" & 60"


COLOR AND PANEL WIDTH KEY:
COMMON PANEL WIDTH
8"
14"
24"
30"
38"
48"
60"
ODD PANEL WIDTH
8.5"
9"
12.5"
13"
34.5"

PANEL COLOR
COLOR A
COLOR B
COLOR C

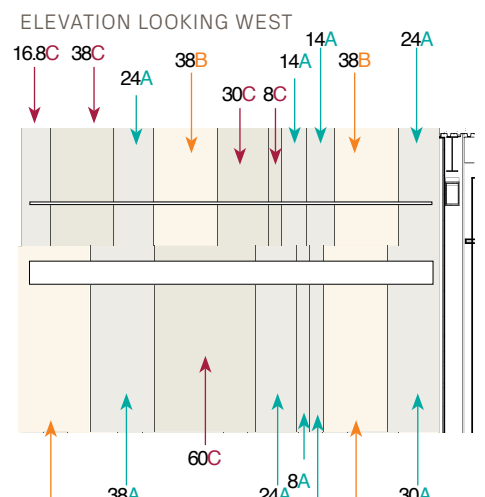

This information is no longer in scope

ELEVATION LOOKING NORTH

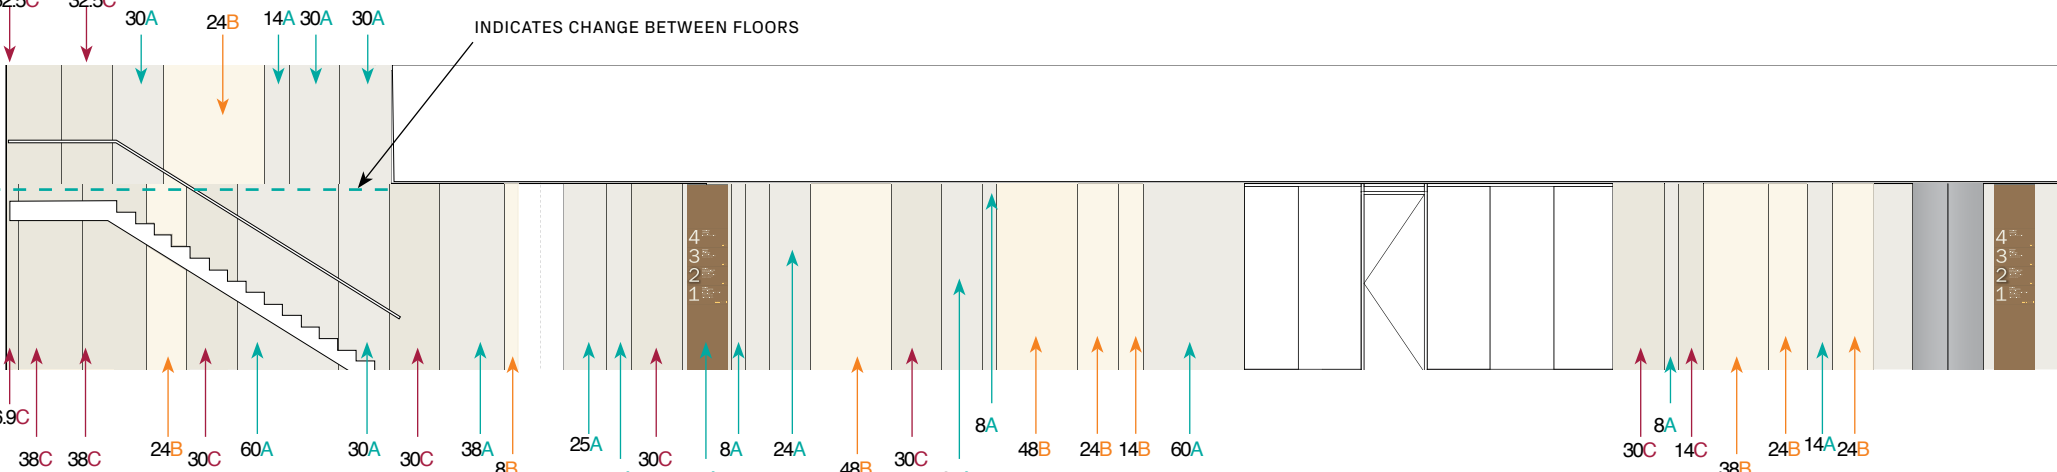

EG1

Environmental Graphic Type:

EG1

EG1-303 Multi-Level Feature Wall


* DESIGN ASSIST:
SEE EG-1-OVERALL

PANELS ARE 3/4" PAINTED MDF WITH
3/32" BUTT JOINT REVEAL IN 3 DIFFERENT
PROJECT COLORS: 1. COLOR A,
2. COLOR B & 3. COLOR C WITH A SMOOTH
LACQUER FINISH

PANELS RUN CEILING HEIGHT TO
BASEBOARDS.
7 TOTAL PANEL WIDTHS USED
8": 14", 24", 30", 48" & 60"


COLOR AND PANEL WIDTH KEY:
COMMON PANEL WIDTH
8"
14"
24"
30"
38"
48"
60"
ODD PANEL WIDTH
8.5"
9"
12.5"
13"
34.5"

PANEL COLOR
COLOR A
COLOR B
COLOR C

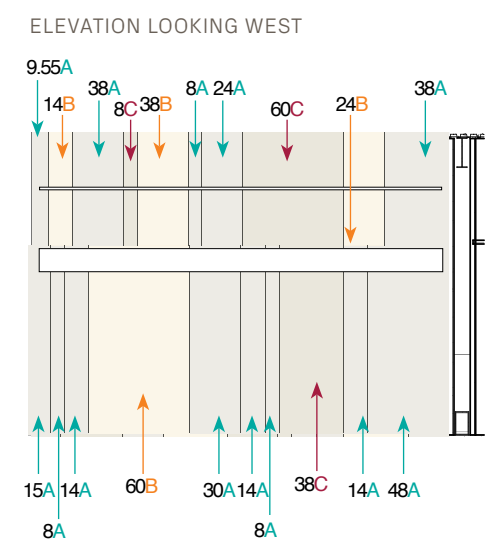

This information is no longer in scope

ELEVATION LOOKING NORTH

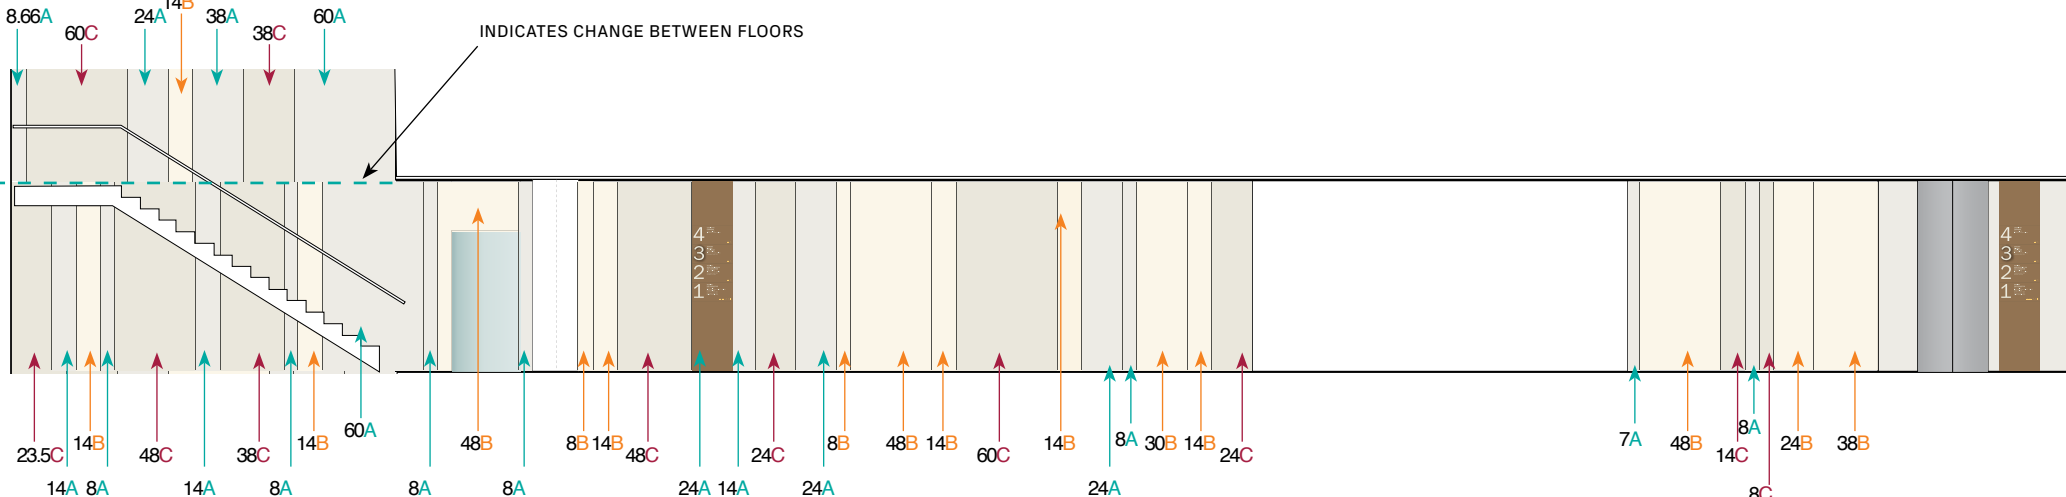

EG1

Environmental Graphic Type:

EG1

EG1-409 Multi-Level Feature Wall


* DESIGN ASSIST:
SEE EG-1-OVERALL

PANELS ARE 3/4" PAINTED MDF WITH
3/32" BUTT JOINT REVEAL IN 3 DIFFERENT
PROJECT COLORS: 1. COLOR A,
2. COLOR B & 3. COLOR C WITH A SMOOTH
LACQUER FINISH

PANELS RUN CEILING HEIGHT TO
BASEBOARDS.
7 TOTAL PANEL WIDTHS USED
8": 14", 24", 30", 48" & 60"


COLOR AND PANEL WIDTH KEY:
COMMON PANEL WIDTH
8"
14"
24"
30"
38"
48"
60"
ODD PANEL WIDTH
8.5"
9"
12.5"
13"
34.5"

PANEL COLOR
COLOR A
COLOR B
COLOR C

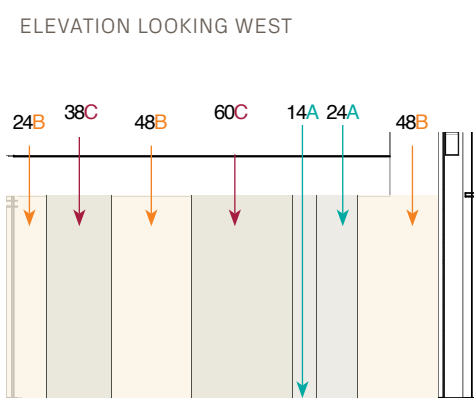

This information is no longer in scope

ELEVATION LOOKING NORTH

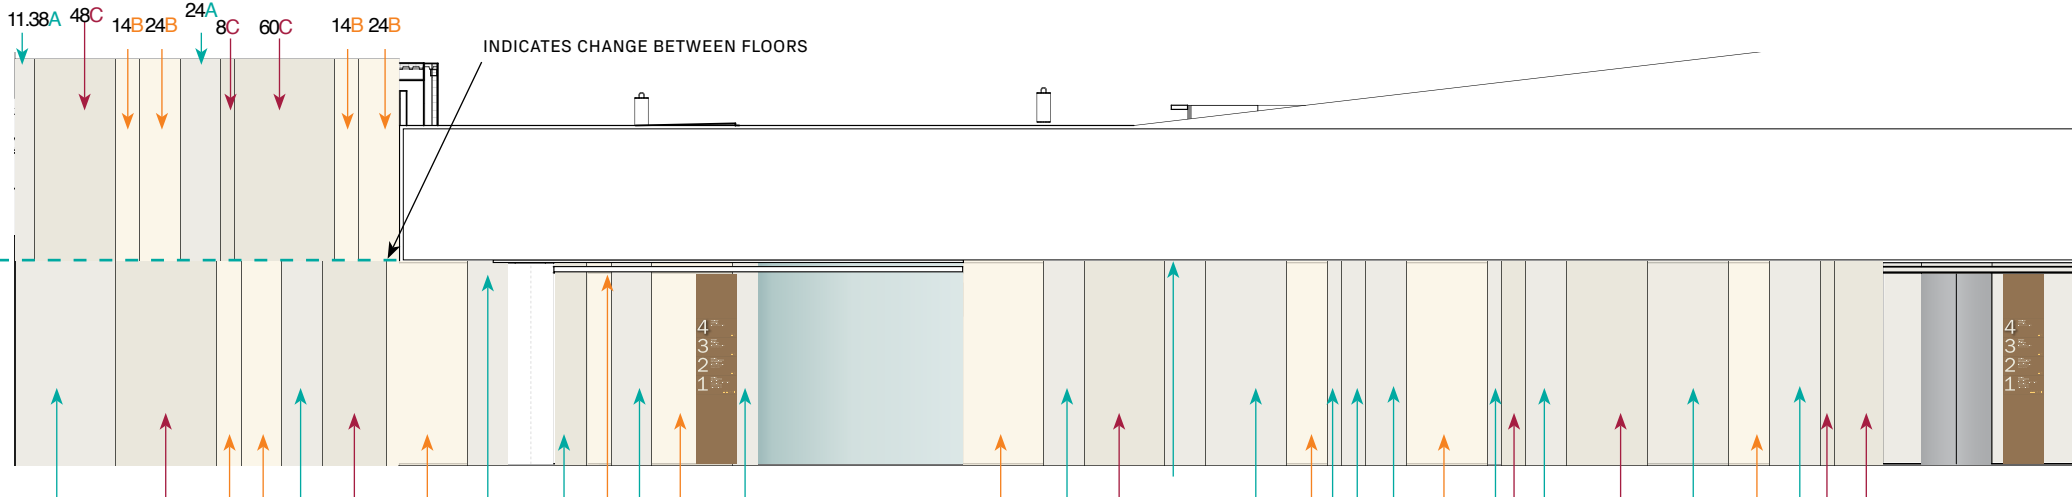

EG1

"W" with 1/16" Naval brass with satin finish on all levels has been removed. Painted MDF should run floor to ceiling in the areas that the "W" previously ran.