




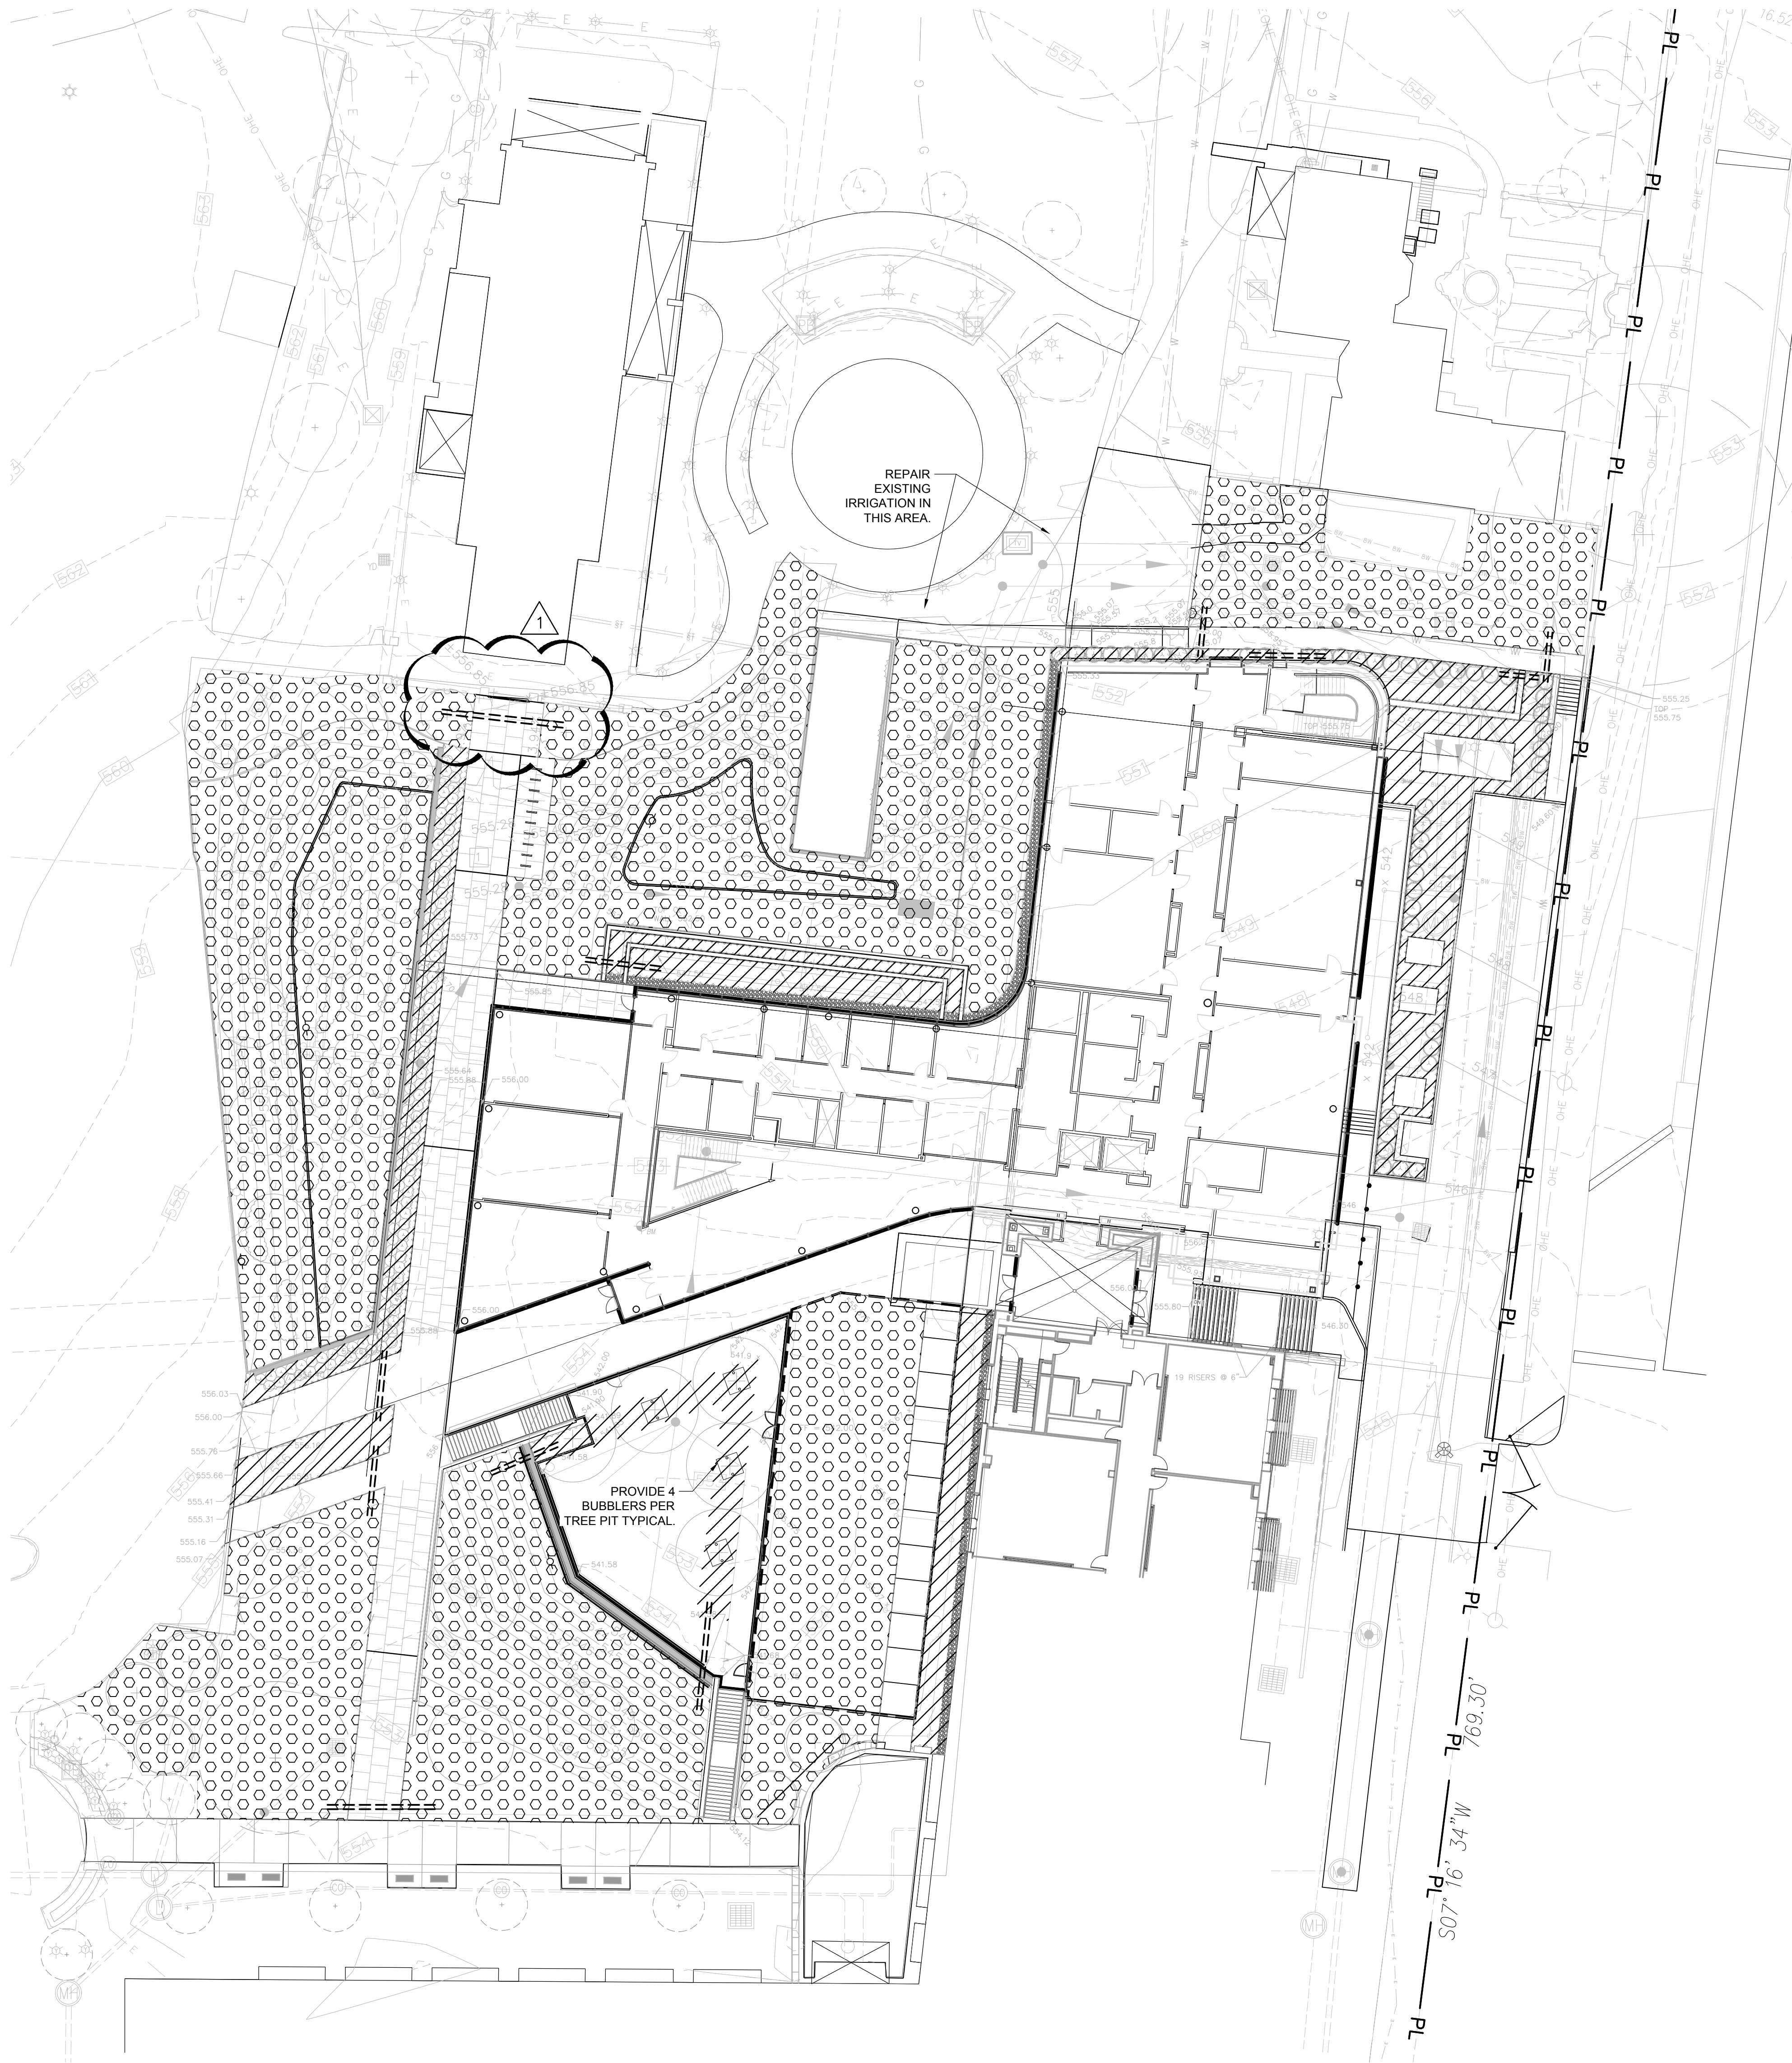


LEGEND

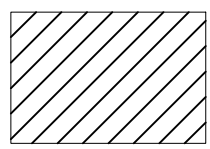

POP UP SHRUB BUBBLERS

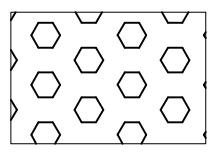

SPRAY IRRIGATION
- TURF AREAS, POPUP ROTORS.
- BMP AREAS SHALL BE IRRIGATED BY
HIGH POPUP SPRAYS/ROTORS.
LOCATED ALONG THE PERIMETER OF
THE PLANTING AREAS.

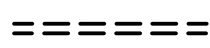

IRRIGATION SLEEVE

NOTES:

1. COORDINATE CONTROLLER LOCATION WITH OWNER.
2. COORDINATE BACKFLOW LOCATION WITH CIVIL/MEP DRAWINGS.
3. SEE SPECIFICATIONS.



Webster University
Interdisciplinary Science
Building

CANNONDESIGN

1100 Clark Avenue
St. Louis, Missouri 63102
T: 314.241.6250
F: 314.241.2570

William Tao & Associates, Inc.
MEP/FP Engineer
7955 Manchester Road, Suite 125
St. Louis, MO 63143
314-884-7600


David Mason & Associates, Inc.
Structural & Civil Engineer
800 South Vandeventer Avenue
St. Louis, MO 63110
314.534.1053

SWT Design
Landscape Architect
7722 Big Bend Blvd
St. Louis, MO 63119
314.844.5700

Spellman Brady & Company
Interior Designer
8251 Maryland Avenue, Suite 300
St. Louis, MO 63105
314.862.0070

Webb Engineering Services, Inc.
Plumbing & Fire Protection
1400 S. 3rd Street, Suite 201
St. Louis, MO 63104
314.588.0600

Faith Group
Technology
930 N. McKnight Rd
St. Louis, MO 63132
314.991.2228

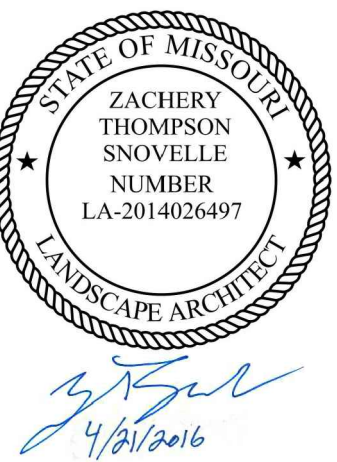

1 ADDENDUM 3-3 21 APR 2016
- ISSUED FOR CONSTRUCTION (BPS) 15 MAR 2016

No.	Description	Date
-----	-------------	------

Drawing Title:

IRRIGATION
PLAN

SWT Project No.: 20018.01 Checked by:

L170

MSD P# 28874-01 MSD BASE MAP 23K2