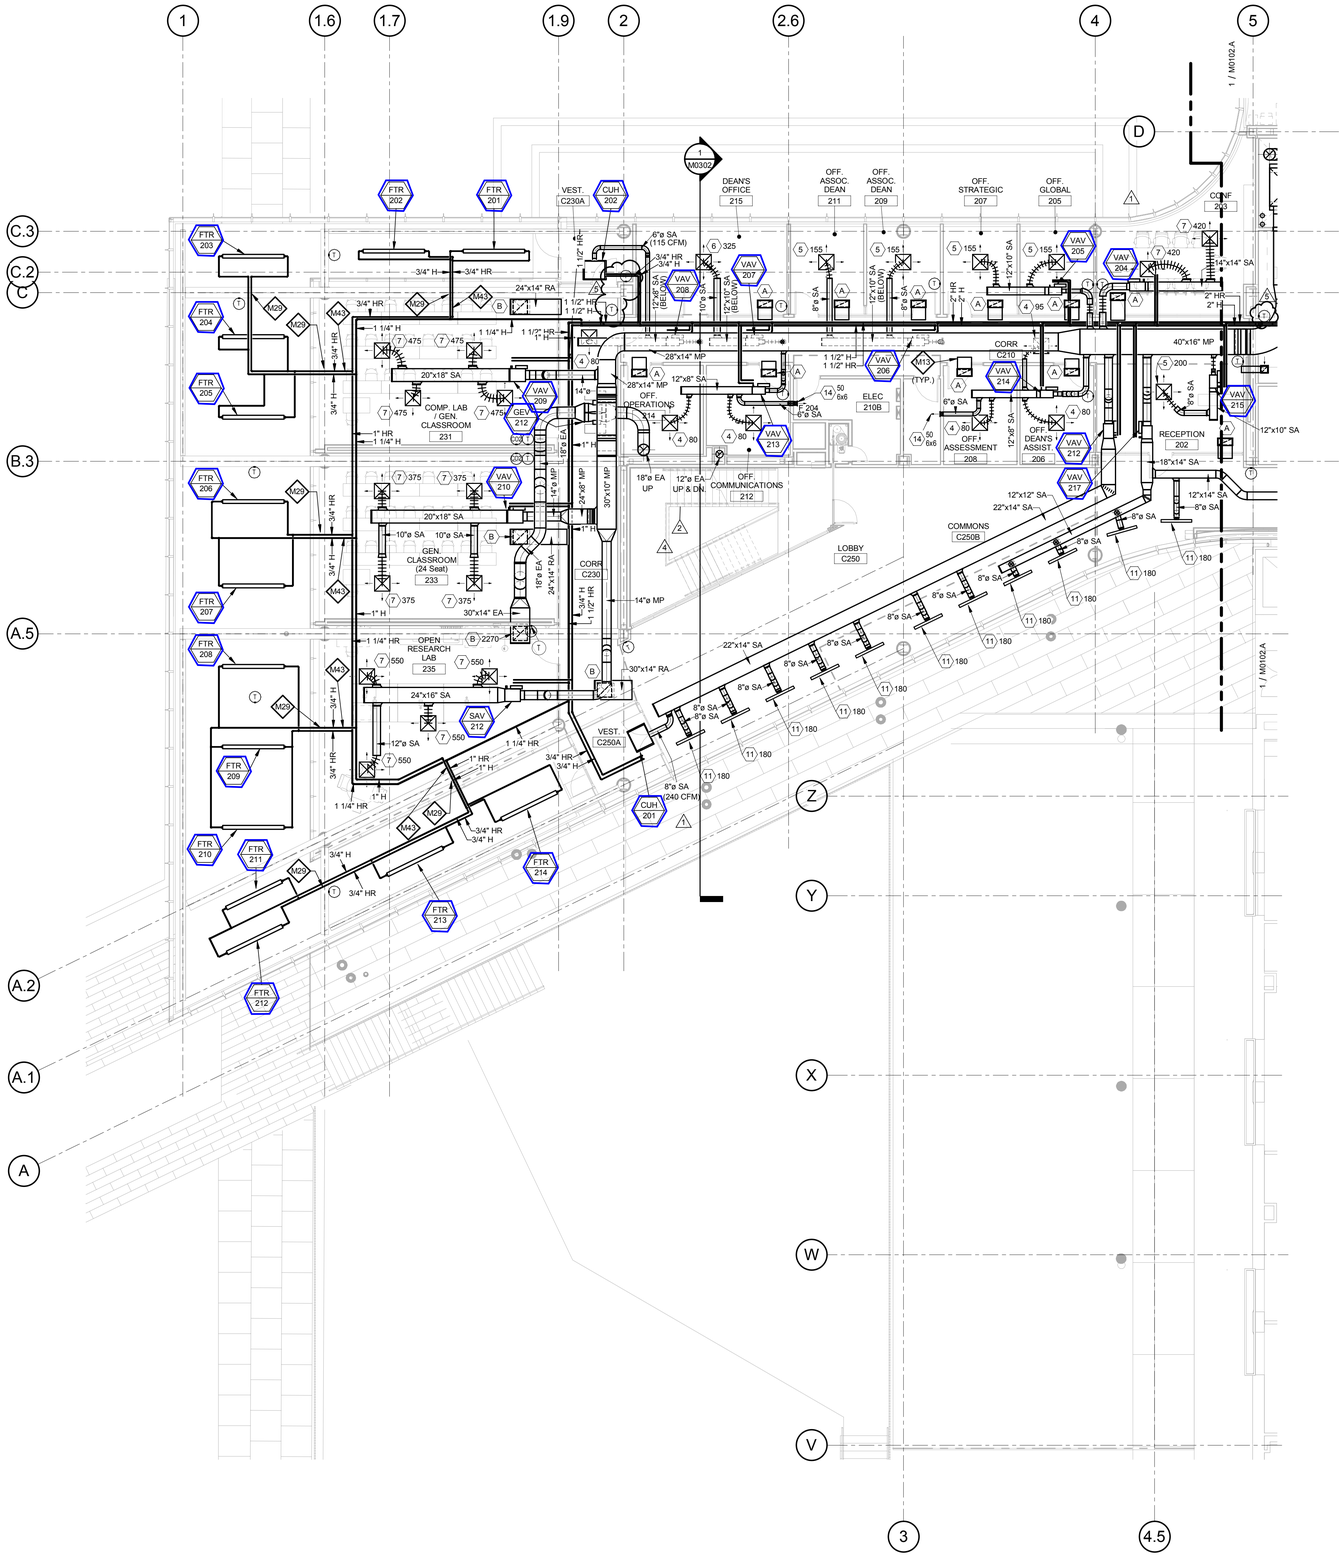

1 **LEVEL 02 - AREA B - MECHANICAL PLAN**

1/8" = 1'-0"

GENERAL NOTES:

A. Because of the limited space available to install all of the mechanical work, coordination between the various trades is of the utmost importance. This contractor shall coordinate with all other trades prior to the fabrication and installation of any work.
B. Refer to the reflected ceiling plans for ceiling construction, ceiling grid layout, ceiling mounted devices, and coordinate exact location and mounting type of all air devices.
C. All ductwork upstream of terminal units shall be Medium Pressure (MP). All ductwork downstream of terminal units shall be Low Pressure (LP). Refer to specifications.
D. All ductwork dimensions indicated on plans are sheet metal sizes. All medium pressure ductwork shall be unlined, externally insulated. All low pressure ductwork shall be lined. See specifications.
E. All mitered 90° rectangular elbows shall be furnished with turning vanes having maximum c = 0.12. All smooth radius rectangular elbows shall have a throat radius greater than one half the duct width, unless furnished with splitter vanes. Under no circumstances shall the throat radius be less than one third the duct width. Unless otherwise noted or specified.
F. Contractor shall furnish and install volume dampers for each duct take-off unless otherwise noted. See detail.
G. Maximum length of Low Pressure (LP) flexible ductwork shall be 8'-0". Round LP duct of lengths greater than 8'-0" shall be rigid round. Flexible duct sizes on plans shall be neck size of diffusers or as indicated. See specifications.
H. Maximum length of Medium Pressure (MP) flexible ductwork shall be 2'-0". Round MP duct of lengths greater than 2'-0" shall be rigid round. Flexible duct sizes on plans shall be air Terminal Unit inlet size or as indicated. See specifications.
I. All ductwork runouts to Air Terminal Units and diffusers shall be the connection size unless otherwise noted.
J. Piping runouts to terminal units shall be 3/4" unless otherwise noted. Refer to reheat box schedule.
K. Verify exact location of thermostats, humidistats, BAS sensors, and other exposed control sensors with architectural elevations and drawings before installation.
L. Schedule systems or equipment shut downs required for new construction with owner two weeks in advance. Some premnuim time work may be required.
M. Refer to piping details for final connections to equipment.
N. Provide service shut-off valves in major piping branch lines. All connections to risers and each building wing; A & B.

KEYED NOTES

M13 LINED RETURN AIR TRANSFER DUCT, 22x10 TYPICAL UNLESS NOTED OTHERWISE.

M28 BAS TEMPERATURE SENSOR TO MONITOR IT/TCOM SPACES. FCU CONTROLLED BY UNIT MOUNTED THERMOSTAT.

M29 PIPING THROUGH HOLE IN BEAM. COORDINATE WITH STRUCTURAL DRAWINGS.

M43 INSTALL CONTROL VALVES AND SERVICE SHUT-OFF VALVES ABOVE ACCESSIBLE CEILING. PROVIDE FLOW MEASURING AND BALANCING VALVE AT EACH FTR ELEMENT. BALANCE WATER FLOW BEFORE OVERHANG ENCLOSURE IS INSTALLED.

4

THE SEAL(S) AND SIGNATURE(S) APPLY ONLY TO THE DOCUMENT TO WHICH THEY ARE AFFIXED, AND EXPRESSLY DISCLAIM ANY RESPONSIBILITY FOR ALL OTHER PLANS, SPECIFICATIONS, ESTIMATES, REPORTS OR OTHER DOCUMENTS OR INSTRUMENTS RELATING TO OR INTENDED TO BE USED FOR ANY PART OR PARTS OF THE ARCHITECTURAL OR ENGINEERING PROJECT.

Webster UNIVERSITY

Webster University
Interdisciplinary Science Building

CANNONDESIGN
1100 Clark Avenue
St. Louis, Missouri 63102
T: 314.241.6250
F: 314.241.2570

William Tao & Associates, Inc
MEP/FP Engineer
7955 Manchester Road, Suite 125
St. Louis, MO 63143
314-884-7600

David Mason & Associates, Inc
Structural & Civil Engineer
800 South Vandeventer Avenue
St. Louis, MO 63110
314.534.1053

Faith Group
Technology
3101 S. Hanley Rd, Suite 100
St. Louis, MO 63143
314.991.2228

Kuhlmann Leavitt, Inc.
Environmental Graphics & Signage
7400 Pershing Ave
St. Louis, MO 63130
314.725.6616

KWA Architects
Architecture
9721 Litzinger Road
St. Louis, MO 63124
314.962.2560

Spellman Brady & Company
Interior Designer
8251 Maryland Avenue, Suite 300
St. Louis, MO 63105
314.862.0070

SWT Design
Landscape Architect
7722 Big Bend Blvd
St. Louis, MO 63119
314.644.5700

Webb Engineering Services, Inc.
Plumbing & Fire Protection
1400 S. 3rd Street, Suite 201
St. Louis, MO 63104
314.588.0600

No.	Description	Date
5	ASI-050	16 FEB 2017
4	ASI-043	20 DEC 2016
3	ASI-032	18 OCT 2016
2	ASI-009	01 AUG 2016
1	ADDENDUM 2-1	17 MAR 2016
-	ISSUED FOR CONSTRUCTION (BP2)	01 MAR 2016

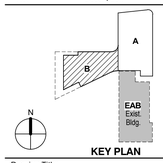

KEY PLAN

Drawing Title:

LEVEL 02 AREA B FLOOR PLAN - MECHANICAL

Project No.: 04561.01 Checked by:

M0102.B

© Cannon Design 2015

© Cannon Design 2015
All rights reserved. No part of this document may be reproduced, subject to any form of disclosure, or written authorization by The Cannon Corporation.
2/16/2017 11:07:58 AM