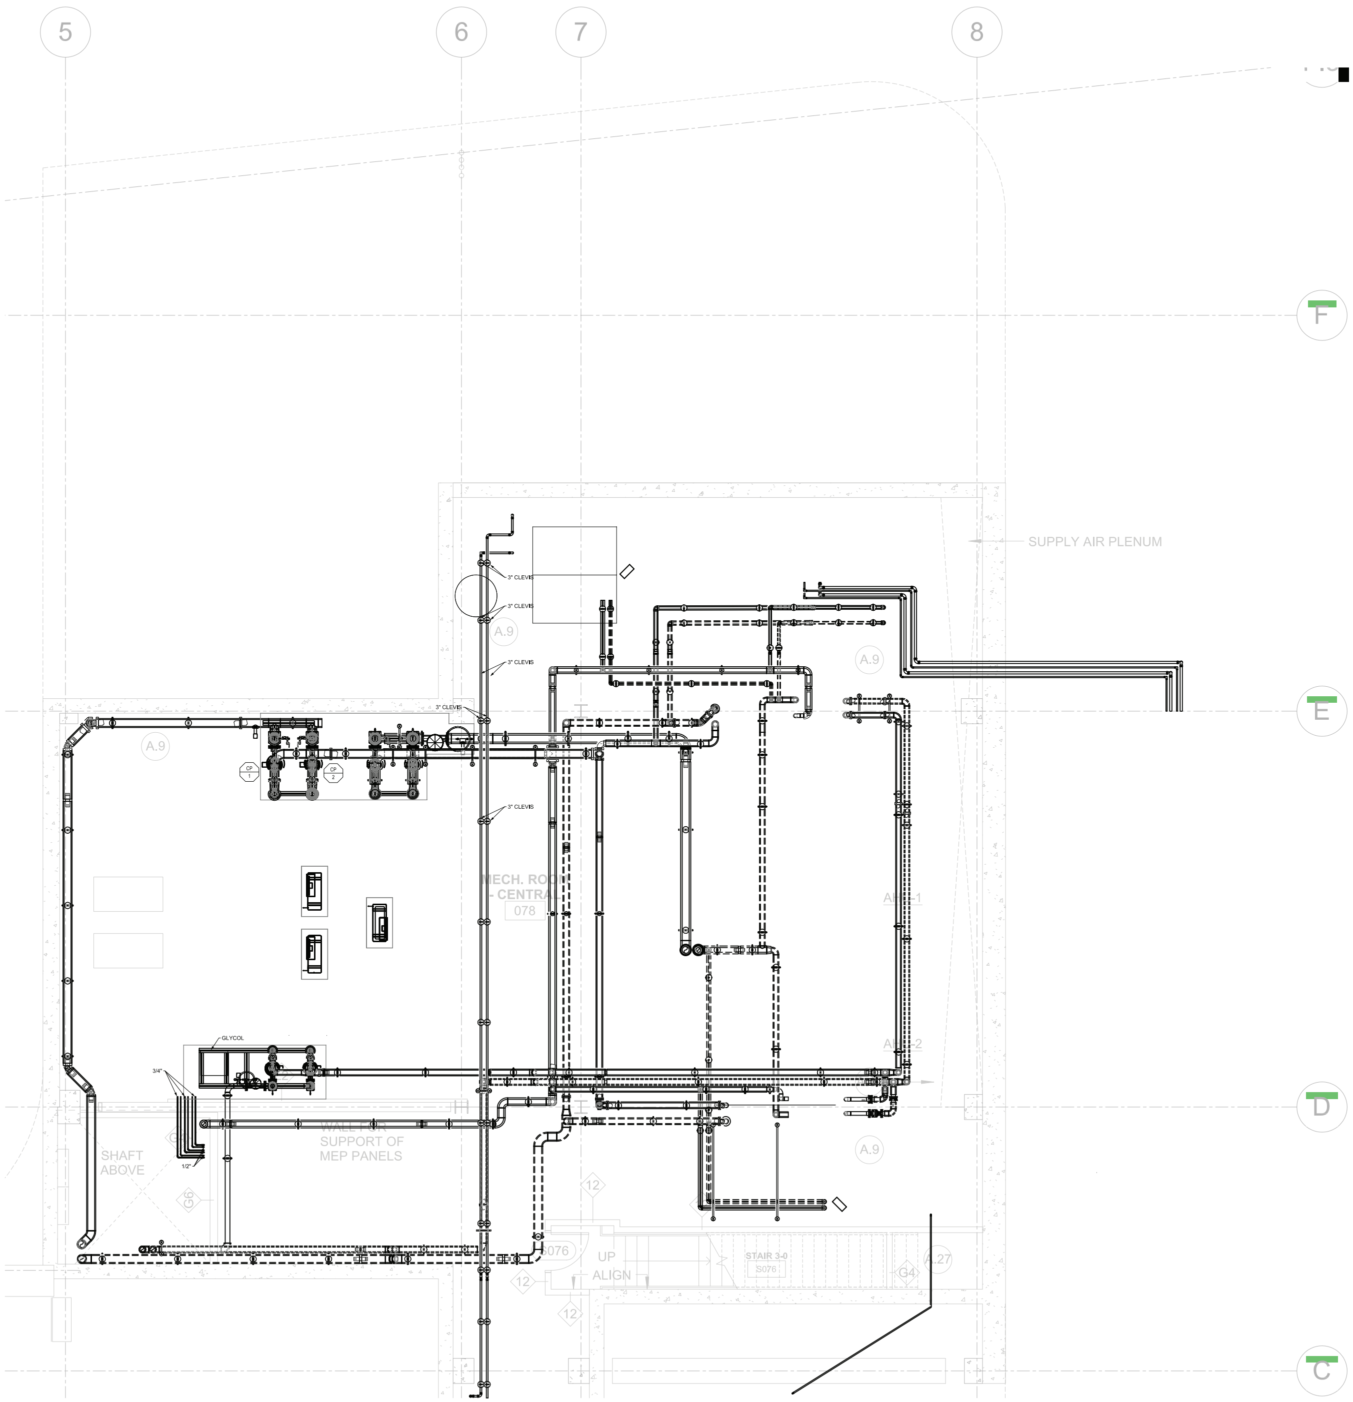

LEVEL 0 - PIPING PLAN
SCALE: 1/4"=1'-0"

RECORD DRAWINGS
DATE: 6/ 30 / 17 DRAWN BY: ZPL

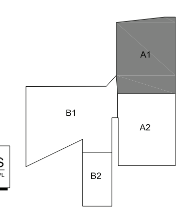

KEY PLAN

icon Mechanical
1616 Cleveland Blvd. • Granite City, IL 62040
www.iconmech.com

WEBSTER UNIVERSITY - ISB
WEBSTER GROVES, MISSOURI
ICON MECHANICAL CONTRACTORS AND ENGINEERS

NOT VALID FOR PERMITS UNLESS SEALED BY ENGINEER

Revision:

Issue Date
XX / XX / XX

Sheet Title
MP100A

Project Number
5768

Sheet Number
1 of 1