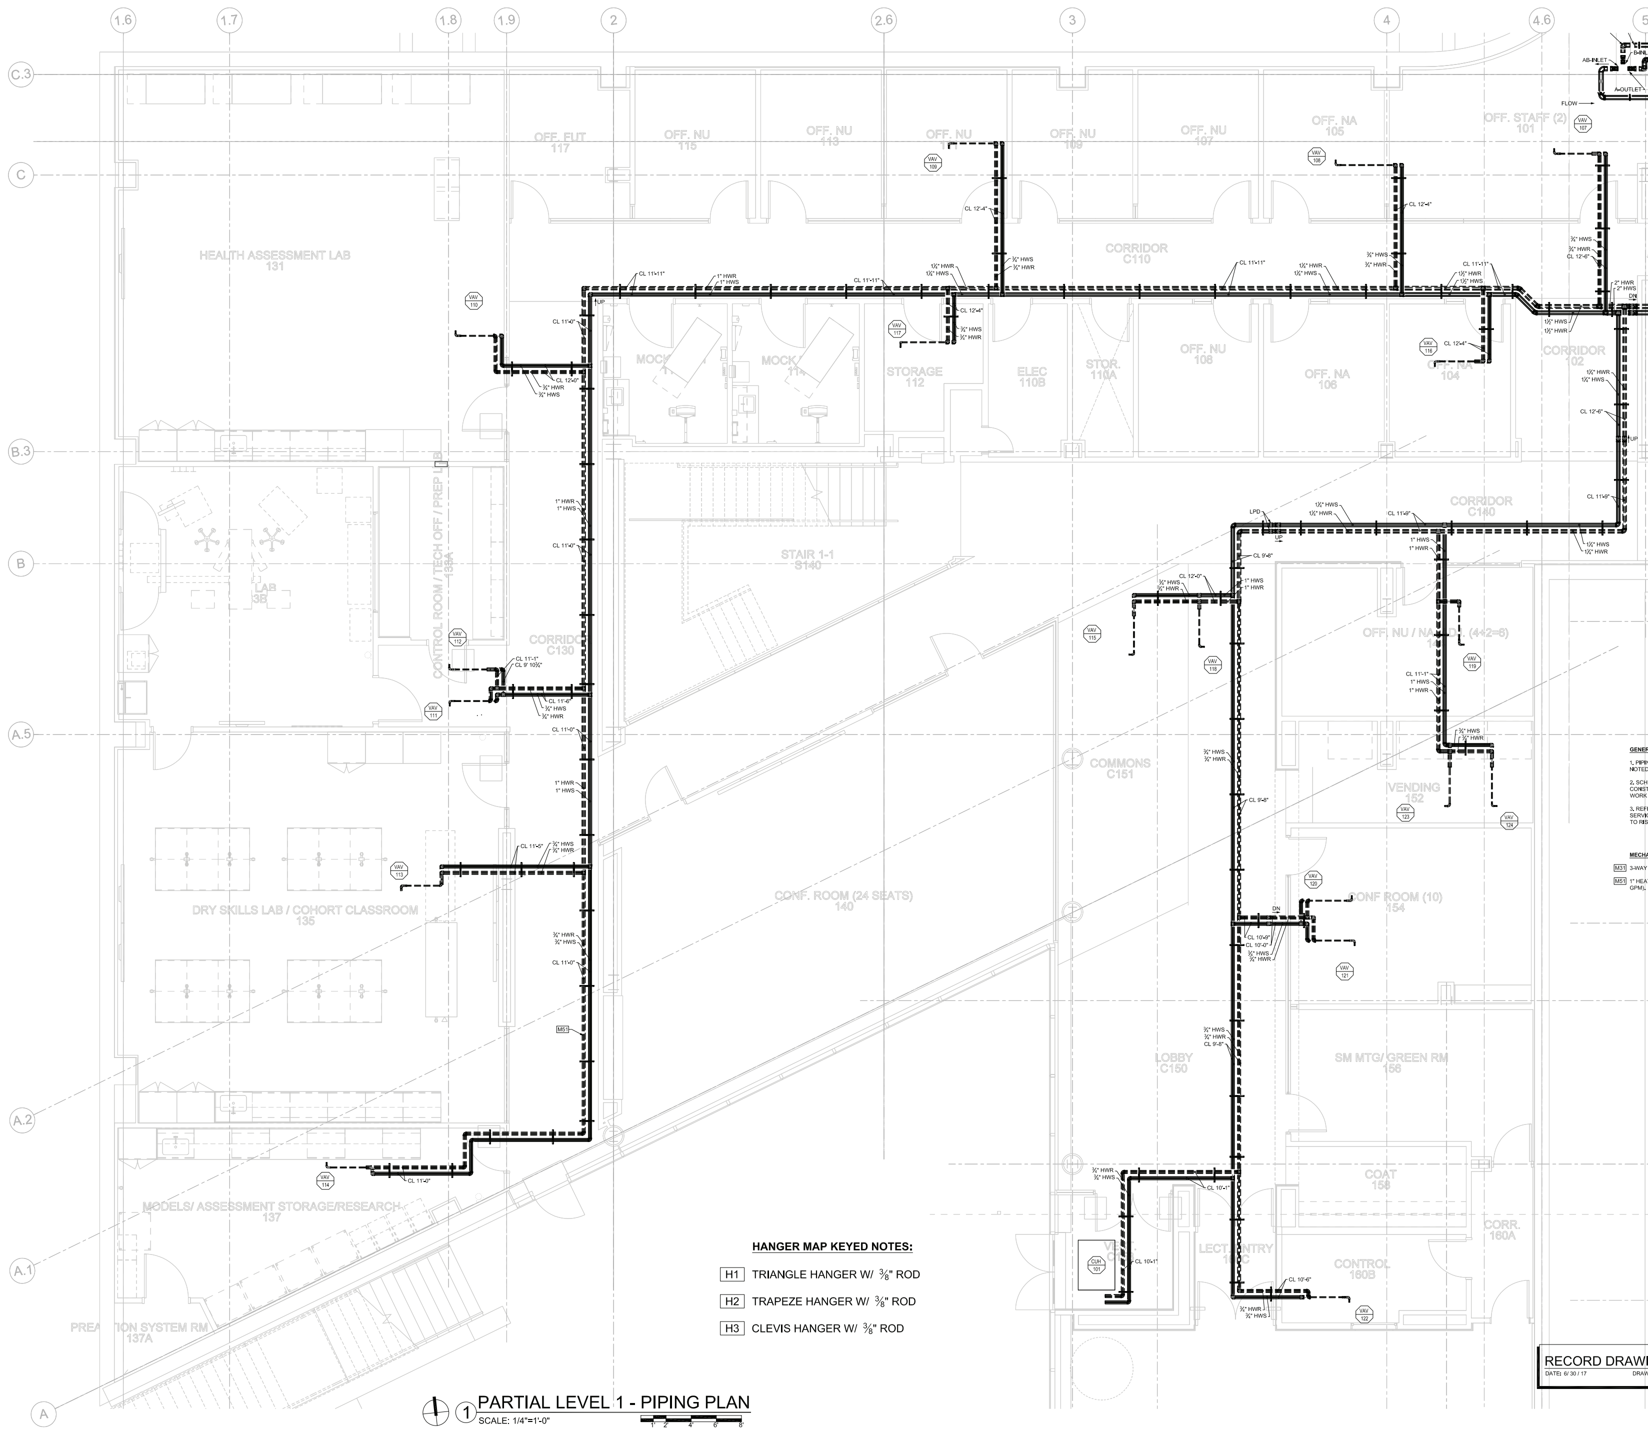

HANGER MAP KEYED NOTES:

- H1 TRIANGLE HANGER W/ 3/8" ROD
- H2 TRAPEZE HANGER W/ 3/8" ROD
- H3 CLEVIS HANGER W/ 3/8" ROD

1 PARTIAL LEVEL 1 - PIPING PLAN
SCALE: 1/4"=1'-0"

GENERAL NOTES:

1. PIPING RUNOUTS TO TERMINAL UNITS SHALL BE 3/4" UNLESS OTHERWISE NOTED. REFER TO REHEAT BOX SCHEDULE.
2. SCHEDULE SYSTEMS OR EQUIPMENT SHUT DOWNS REQUIRED FOR NEW CONSTRUCTION WITH OWNER TWO WEEKS IN ADVANCE. SOME PREMIUM TIME WORK MAY BE REQUIRED.
3. REFER TO PIPING DETAILS FOR FINAL CONNECTIONS TO EQUIPMENT,PROVIDE SERVICE SHUT-OFF VALVES IN MAJOR PIPING BRANCH LINES. ALL CONNECTIONS TO RISERS AND EACH BUILDING WING: A & B

MECHANICAL PIPING KEYED NOTES: (THIS SHEET ONLY)

- M31 3-WAY CONTROL VALVE. SEE CHILLED WATER PIPING DIAGRAM.
- M51 1" HEATING HOT WATER BYPASS WITH BACKPRESSURE CONTROL VAVLE (5 GPM).

RECORD DRAWINGS
DATE: 6/ 30 / 17 DRAWN BY: ZPL

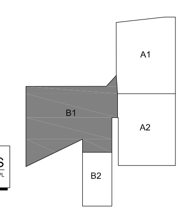

KEY PLAN

DATE: 08/22/2017 FILE PATH: N:\Engineering\CAD\2016 JOBS\5768 - Webster ISB\Design\ Webster ISB\Sheets\MP101B1 PARTIAL LEVEL 1 - PIPING PLAN.dwg
PLOTTED BY: Curtis Lynn

icon Mechanical
1616 Cleveland Blvd. • Granite City, IL 62040
www.iconmech.com

WEBSTER UNIVERSITY - ISB

WEBSTER GROVES, MISSOURI

ICON MECHANICAL CONTRACTORS AND ENGINEERS

NOT VALID FOR PERMITS UNLESS SEALED BY ENGINEER

Revision:

Issue Date
10 / 31 / 16

Sheet Title
MP101B1

Project Number
5768

Sheet Number
1 of 1