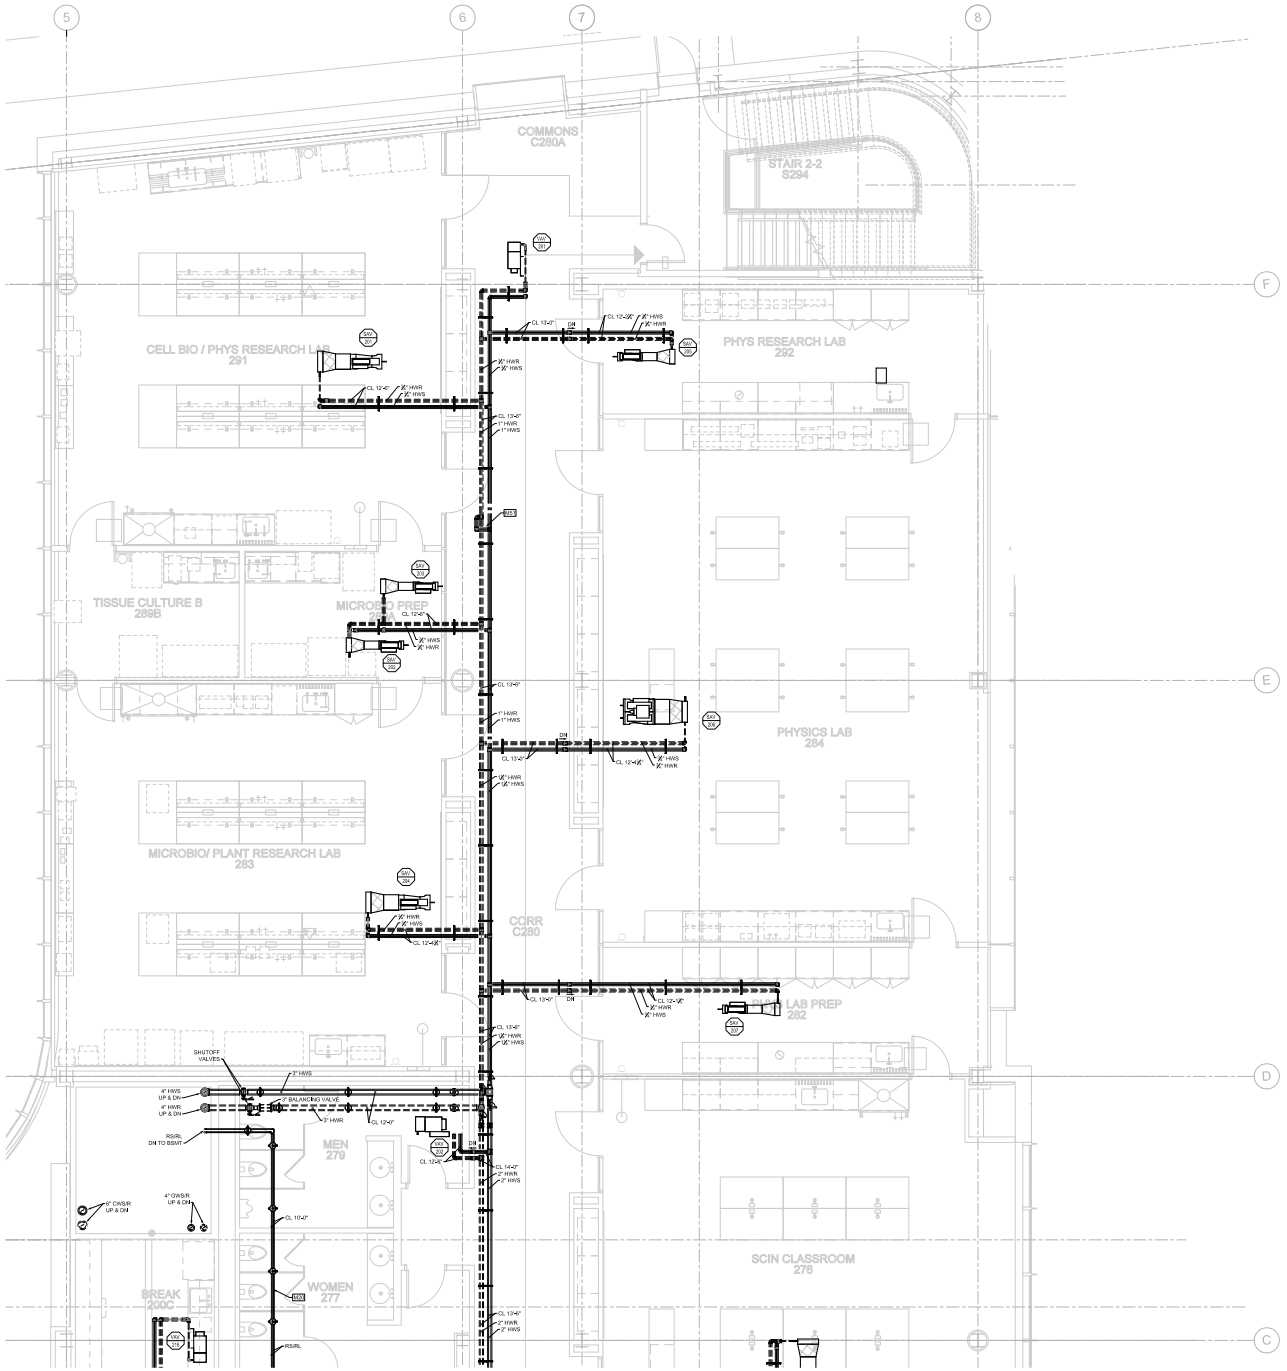

1 PARTIAL LEVEL 2 - PIPING PLAN
SCALE: 1/4"=1'-0"

GENERAL NOTES:

1. PIPING RUNOUTS TO TERMINAL UNITS SHALL BE ¾" UNLESS OTHERWISE NOTED. REFER TO REHEAT BOX SCHEDULE
2. SCHEDULE SYSTEMS OR EQUIPMENT SHUT DOWNS REQUIRED FOR NEW CONSTRUCTION WITH OWNER TWO WEEKS IN ADVANCE. SOME PREMIUM TIME WORK MAY BE REQUIRED.
3. REFER TO PIPING DETAILS FOR FINAL CONNECTIONS TO EQUIPMENT. PROVIDE SERVICE SHUTOFF VALVES IN MAJOR PIPING BRANCH LINES. ALL CONNECTIONS TO RISERS AND EACH BUILDING W/MX2 A & B

MECHANICAL PIPING KEYED NOTES: (THIS SHEET ONLY)

M25 REFRIGERANT LIQUID AND SUCTION PIPING BETWEEN DX COOLING COILS AND CONDENSING UNITS. COORDINATE PIPE SIZES WITH MANUFACTURER.

M26 1" HEATING HOT WATER BYPASS WITH BACKPRESSURE CONTROL VALVE (5 GPM).

HANGER MAP KEYED NOTES:

H1 TRIANGLE HANGER W/ ⅜" ROD

H2 TRAPEZE HANGER W/ ⅜" ROD

H3 CLEVIS HANGER W/ ⅜" ROD

H4 V-BOTTOM CLEVIS HANGER W/ ⅜" ROD

RECORD DRAWINGS
DATE: 6/30/17 DRAWN BY: ZPL

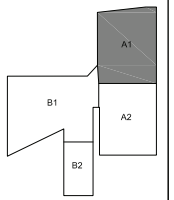

KEY PLAN

icon Mechanical
1618 Olivebud Blvd. • Granite City, IL 62040
www.iconmech.com

WEBSTER UNIVERSITY - ISB

WEBSTER GROVES, MISSOURI

ICON MECHANICAL CONTRACTORS AND ENGINEERS

NOT VALID FOR PERMITS UNLESS SEALED BY ENGINEER

Revision:

Issue Date
11 / 23 / 16

Sheet Title
MP102A1

Project Number
5768

Sheet Number
1 of 1

DATE: 6/22/2017 FILE PATH: K:\Projects\ACAD\2016_JOBS\5768 - Webster ISB\Sheets\MP102A1 PARTIAL LEVEL 2 - PIPING PLAN.dwg
PLOTTED BY: Curtis Lum