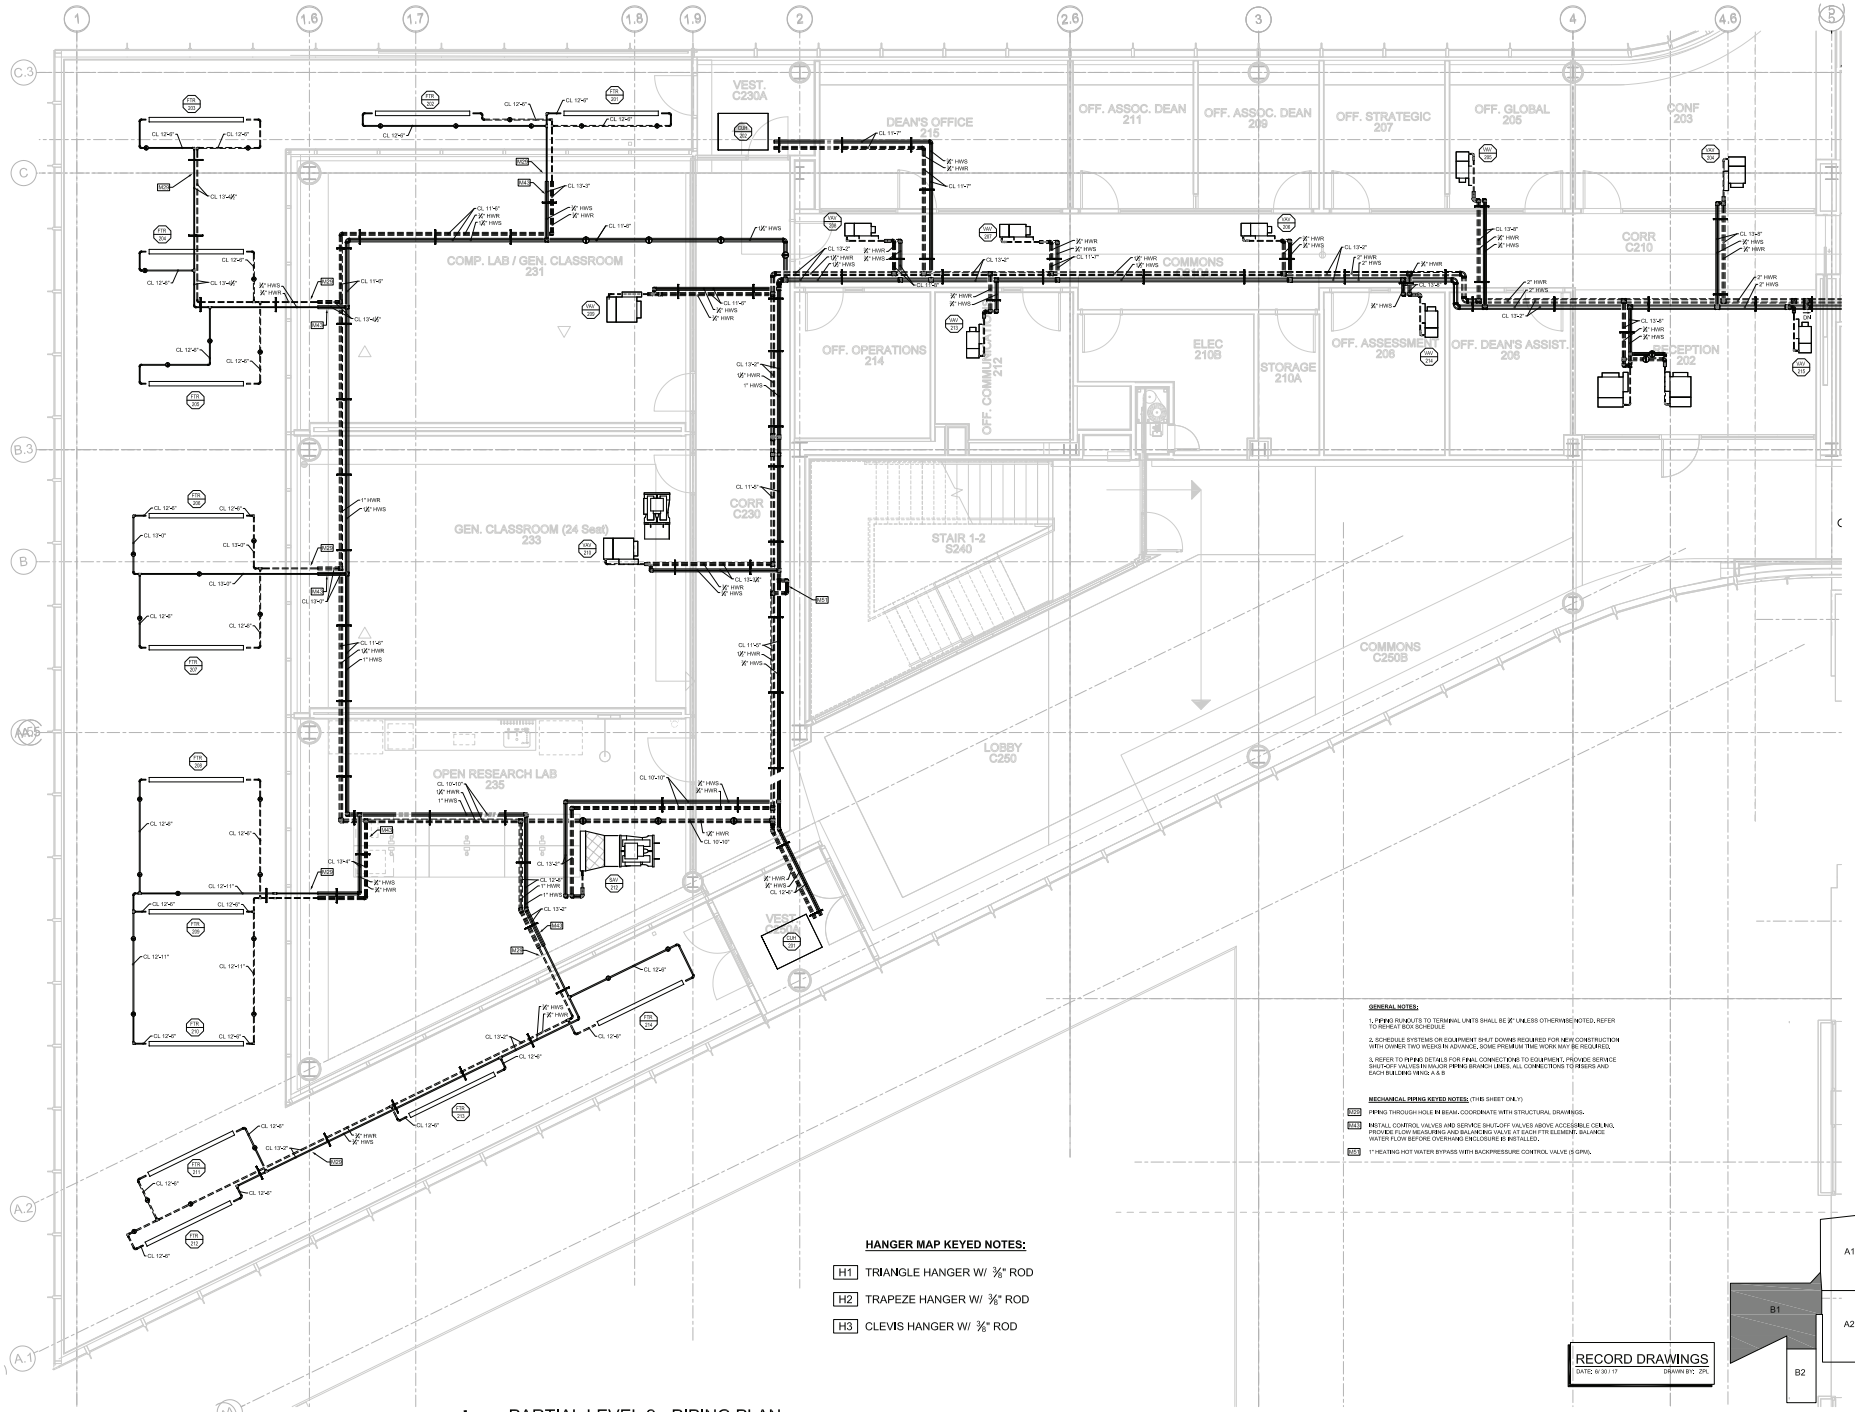

GENERAL NOTES:

1. PIPING RUNOUTS TO TERMINAL UNITS SHALL BE ½" UNLESS OTHERWISE NOTED, REFER TO REHEAT BOX SCHEDULE
2. SCHEDULE SYSTEMS OR EQUIPMENT SHUT DOWNS REQUIRED FOR NEW CONSTRUCTION WITH OWNER TWO WEEKS IN ADVANCE, SOME PREMIUM TIME WORK MAY BE REQUIRED.
3. REFER TO PIPING DETAILS FOR FINAL CONNECTIONS TO EQUIPMENT, PROVIDE SERVICE SHUTOFF VALVES IN MAJOR PIPING BRANCH LINES. ALL CONNECTIONS TO RISERS AND EACH BUILDING WING A & B

MECHANICAL PIPING KEYED NOTES: (THIS SHEET ONLY)

P205 PIPING THROUGH HOLE IN BEAM, COORDINATE WITH STRUCTURAL DRAWINGS.

P412 INSTALL CONTROL VALVES AND SERVICE SHUTOFF VALVES ABOVE ACCESSIBLE CEILING. PROVIDE FLOW MEASURING AND BALANCING VALVE AT EACH FTR ELEMENT. BALANCE WATER FLOW BEFORE OVERHANG ENCLOSURE IS INSTALLED.

P413 T' HEATING HOT WATER BYPASS WITH BACKPRESSURE CONTROL VALVE (5 GPM).

HANGER MAP KEYED NOTES:

H1 TRIANGLE HANGER W/ ⅜" ROD

H2 TRAPEZE HANGER W/ ⅜" ROD

H3 CLEVIS HANGER W/ ⅜" ROD

RECORD DRAWINGS
DATE: 9/30/17 DRAWN BY: ZPL

KEY PLAN

1 PARTIAL LEVEL 2 - PIPING PLAN
SCALE: 1/4"=1'-0"

Mechanical
1616 Cleveland Blvd. • Granite City, IL 62040
www.iconmech.com

WEBSTER UNIVERSITY - ISB
WEBSTER GROVES, MISSOURI
ICON MECHANICAL CONTRACTORS AND ENGINEERS

NOT VALID FOR PERMITS UNLESS SEALED BY ENGINEER

Revision:
Issue Date
11 / 02 / 16
Sheet Title
MP102B1
Project Number
5768
Sheet Number
1 of 1

DATE: 9/22/2017 FILE PATH: K:\Engineering\CAD\2016_JOBS\5768 - Webster ISB\Revit\MP102B1 PARTIAL LEVEL 2 - HVAC PLAN.dwg
PLOTTED BY: Curtis Lum