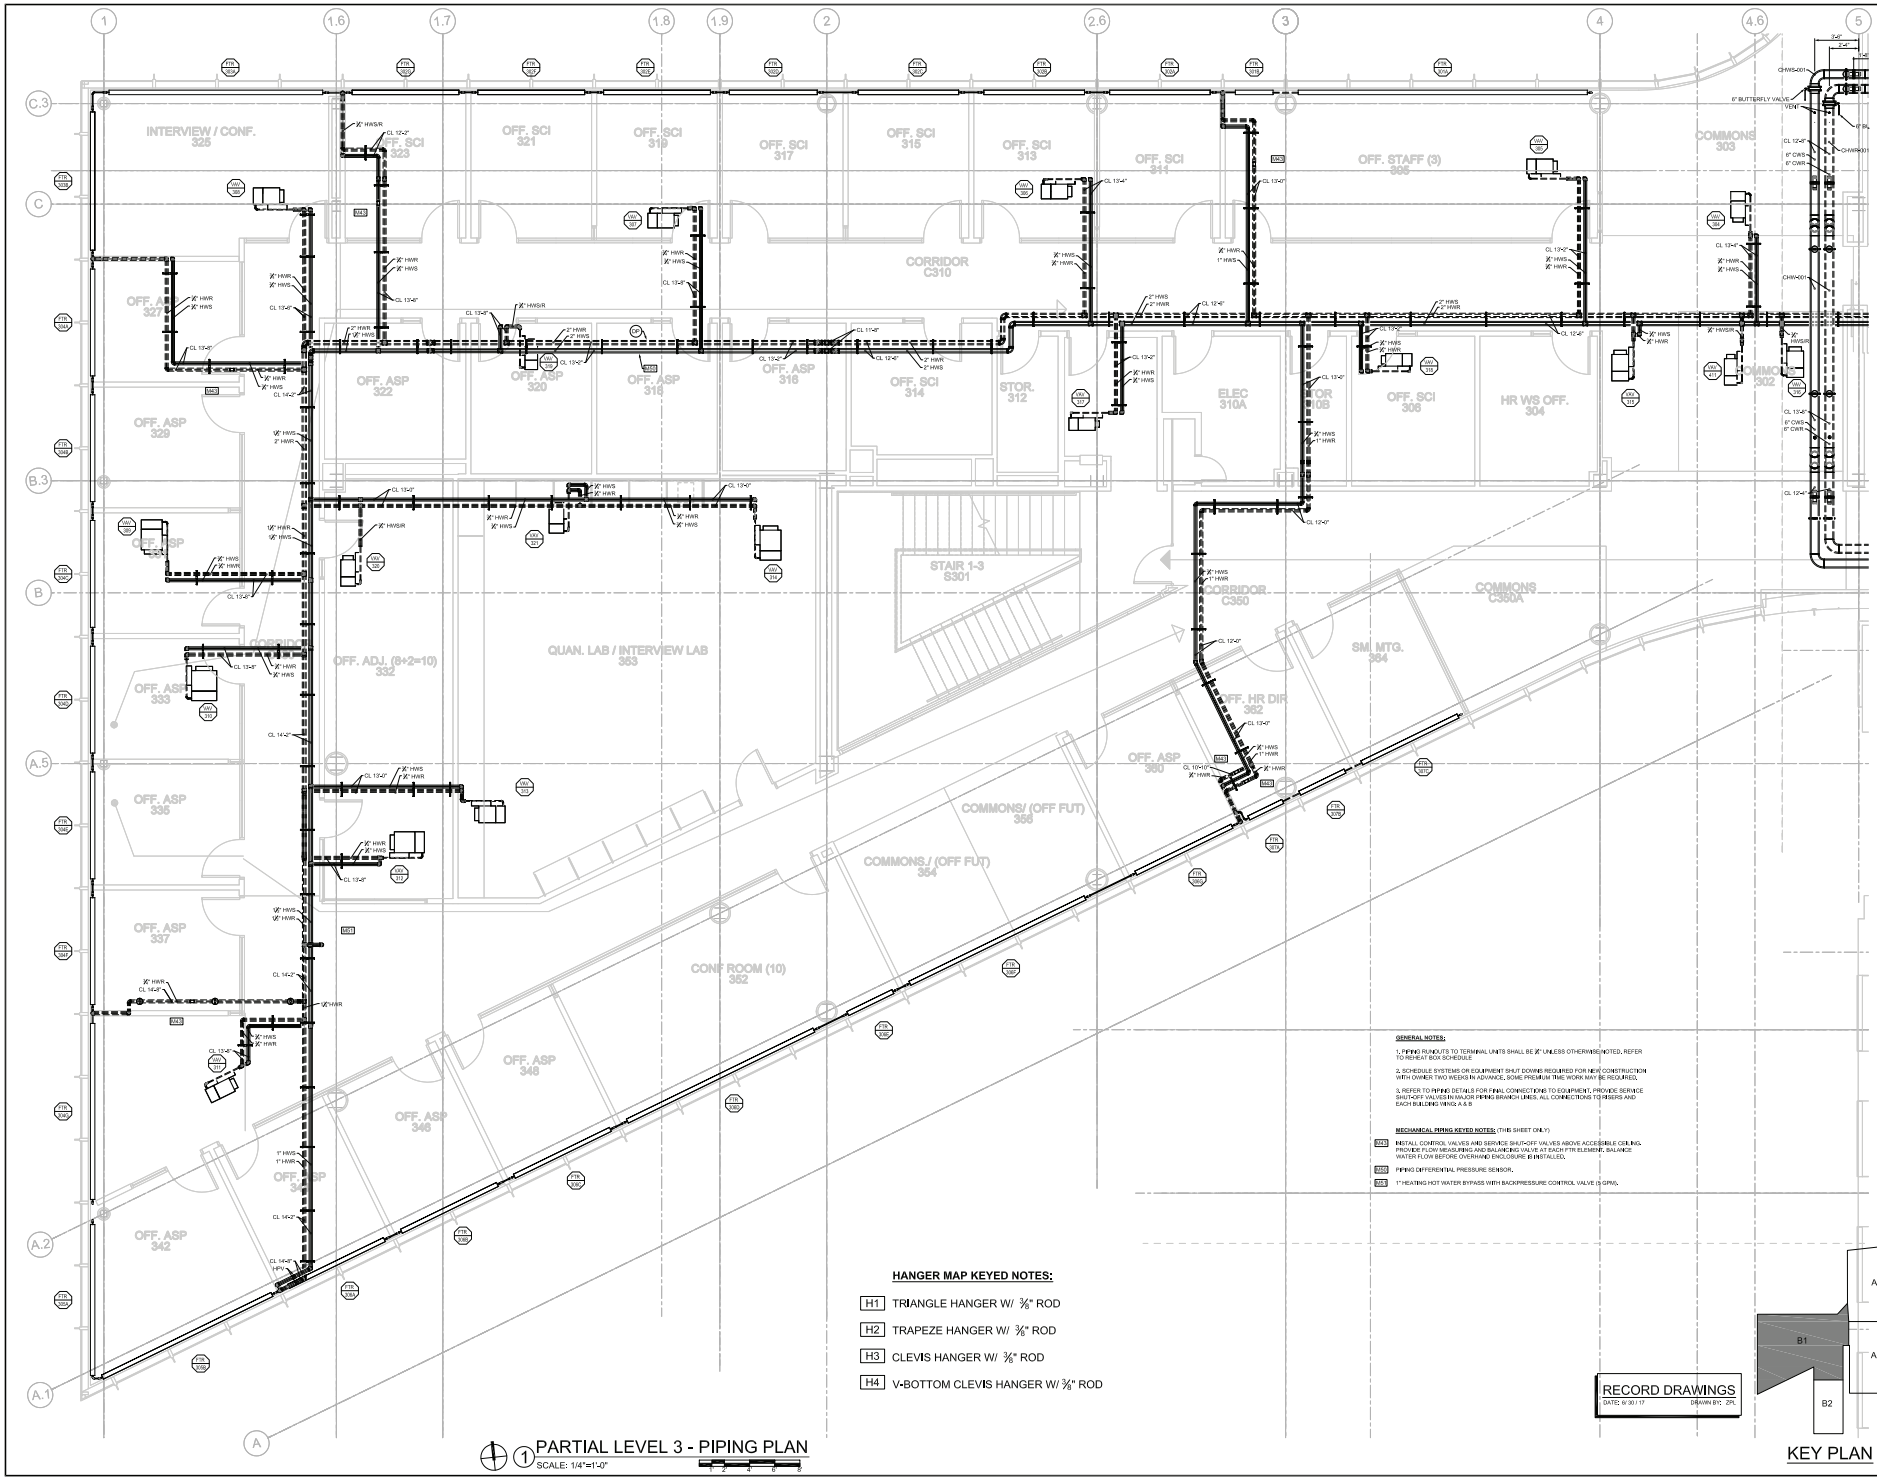
INTERVIEW / CONF. 325
OFF. SCI 323
OFF. SCI 321
OFF. SCI 319
OFF. SCI 317
OFF. SCI 315
OFF. SCI 313
OFF. SCI 311
OFF. STAFF (3) 305
COMMONS 303
CORRIDOR C310
OFF. ASP 327
OFF. ASP 322
OFF. ASP 320
OFF. ASP 318
OFF. ASP 316
OFF. SCI 314
STOR. 312
ELEC 310A
STOR 310B
OFF. SCI 306
HR WS OFF. 304
COMMONS 302
OFF. ASP 329
STAIR 1-3 S301
CORRIDOR C350
COMMONS C350A
QUAN. LAB / INTERVIEW LAB 353
OFF. ADJ. (8+2=10) 332
OFF. ASP 333
SM. MTG. 364
OFF. HR DIR 362
OFF. ASP 360
OFF. ASP 335
COMMONS/ (OFF FUT) 356
COMMONS./ (OFF FUT) 354
OFF. ASP 337
CONF ROOM (10) 352
OFF. ASP 348
OFF. ASP 346
OFF. ASP 342
CHWS-001
CHWR-001
8" BUTTERFLY VALVE
VENT
6" CWS
6" CWR
HWS/R
CL 12'-2"
CL 13'-4"
CL 12'-4"
CL 14'-2"
CL 13'-8"
CL 13'-0"
CL 11'-10"
CL 12'-0"
1" HWS
1" HWR
2" HWS
2" HWR
1½" HWS
1½" HWR
¾" HWS
¾" HWR
½" HWS
½" HWR
