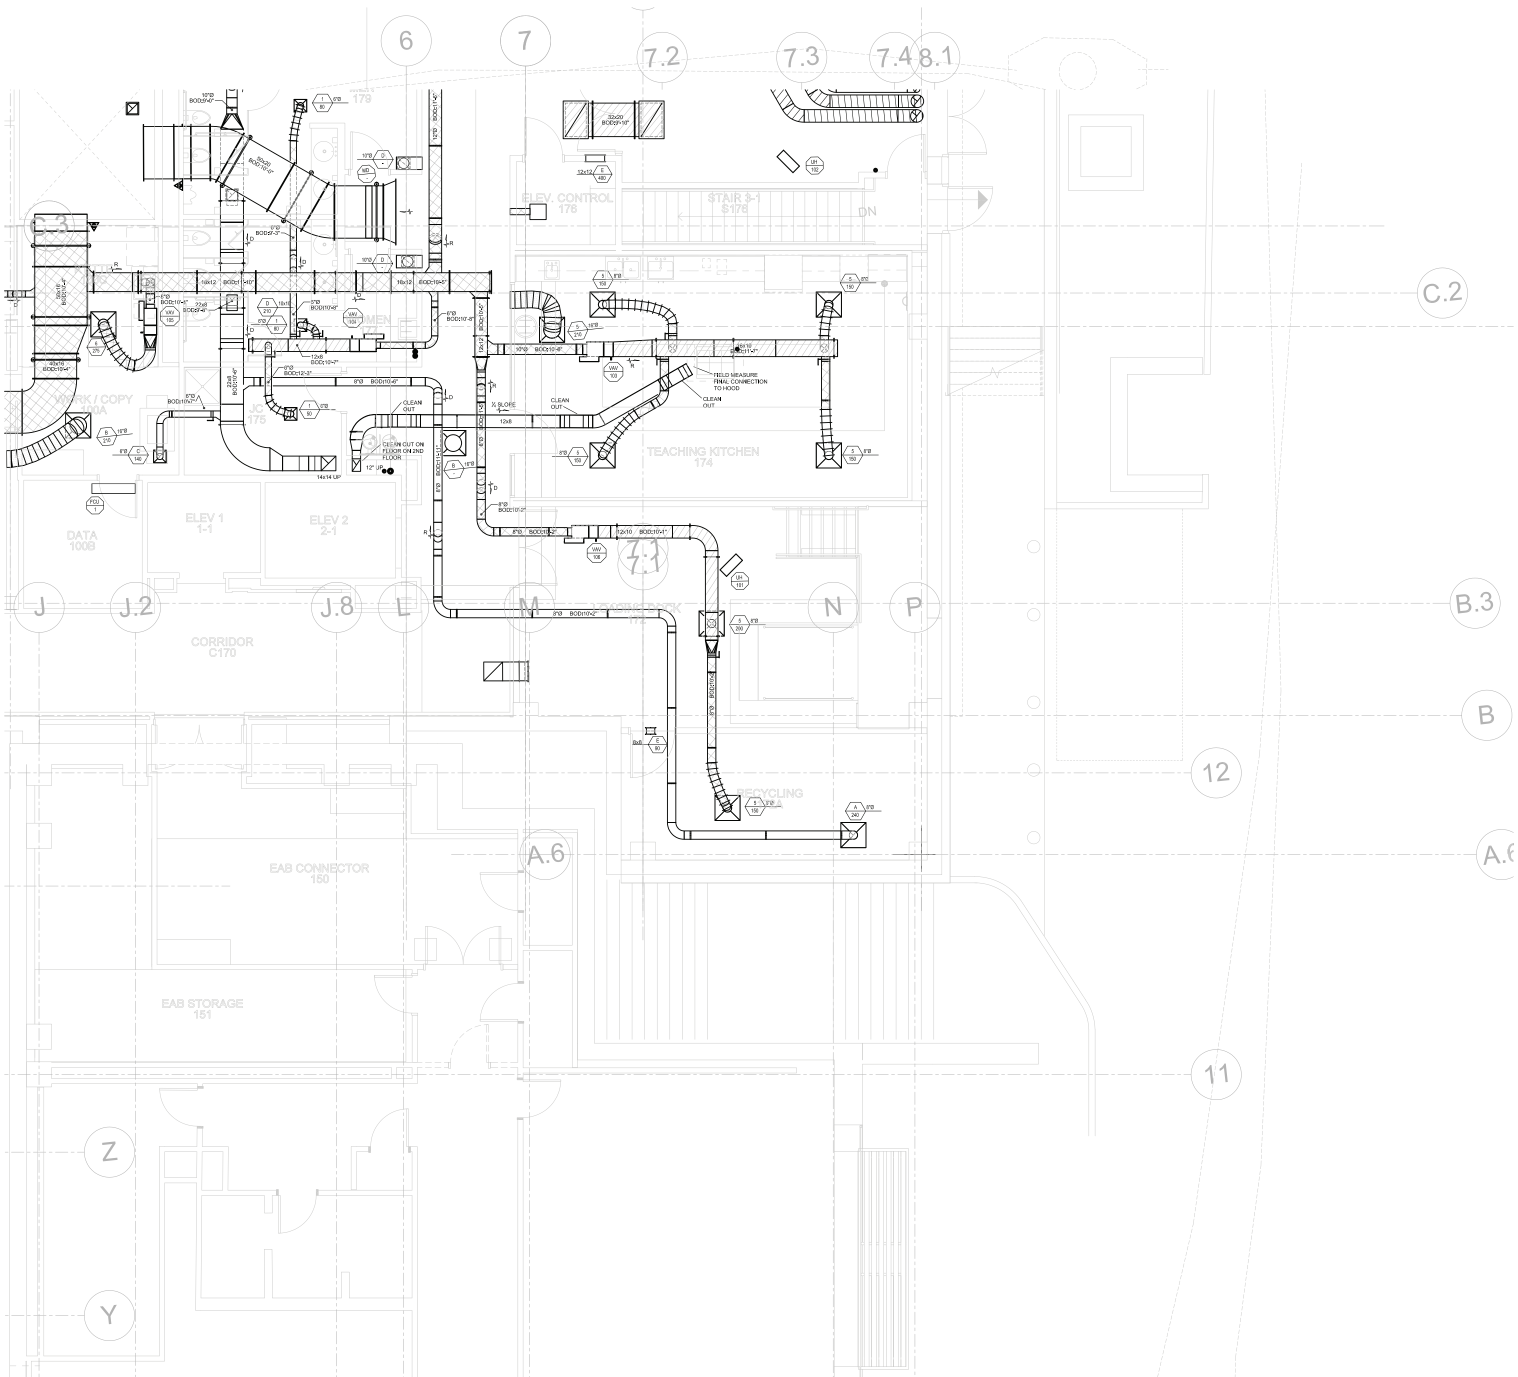

1 PARTIAL LEVEL 1 - DUCTWORK PLAN

SCALE: 1/4"=1'-0"

KEYED NOTES (THIS SHEET ONLY)

- 09 UTSIDE AIR INTAKE LOUVER. SEE ARCHITECTURAL DRAWINGS.
- 12 BOILER AND DOMESTIC WATER HEATER FLUES UP THROUGH ROOF.
- 44 AIRFLOW MEASURING STATION.
- 45 EXHAUST DUCT DOWN THROUGH CHASE FOR DOWNDRAFT TABLE. VERIFY DUCT CONNECTION SIZE AND LOCATION. PROVIDE MANUAL DAMPER AND CONNECTION ADAPTER TO TABLE.
- 47 DOMESTIC WATER HEATER COMBUSTION AIR DUCT THROUGH EXTERIOR WALL ABOVE LOUVER. PROVIDE VENT/TAIN CAP OR ELBOW WITH BIRDSCREEN.
- 48 HEATING HOT WATER BOILER COMBUSTION AIR DUCT. PROVIDE VENT/RAIN CAP OR ELVOW WITH BIRDSCREEN.
- 51 MODIFY EXISTING LOW PRESSURE SUPPLY DUCTWORK IN THIS AREA FOR NEW WALLS. REMOVE EXISTING DUCT MOUNTED AIR DEVICES AND PATCH DUCTWORK AIR-TIGHT. INSTALL NEW CEILING DIFFUSERS AND RETURN AIR GRILLE AS SHOWN AND AS REQUIRED FOR NEW CEILINGS.
- 57 REMOVE EXISTING DUCT MOUNTED AIR DEVICE AND CAP WITH SHEETMETAL, SEAL AIR-TIGHT.
- 59 NEW CONNECTION TO EXISTING DUCTWORK.
- 60 EXISTING AIR DEVICE TO REMAIN. BALANCE TO 60 CFM .

RECORD DRAWINGS
DATE: 6/ 30 / 17 DRAWN BY: ZPL

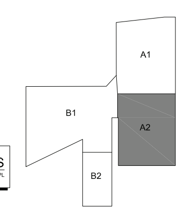

KEY PLAN

Icon Mechanical
1616 Cleveland Blvd. • Granite City, IL 62040
www.iconmech.com

WEBSTER UNIVERSITY - ISB

WEBSTER GROVES, MISSOURI

ICON MECHANICAL CONTRACTORS AND ENGINEERS

NOT VALID FOR PERMITS UNLESS SEALED BY ENGINEER

Revision:

Issue Date: XX / XX / XX

Sheet Title

SM101A2

Project Number: 5768

Sheet Number: 1 of 1