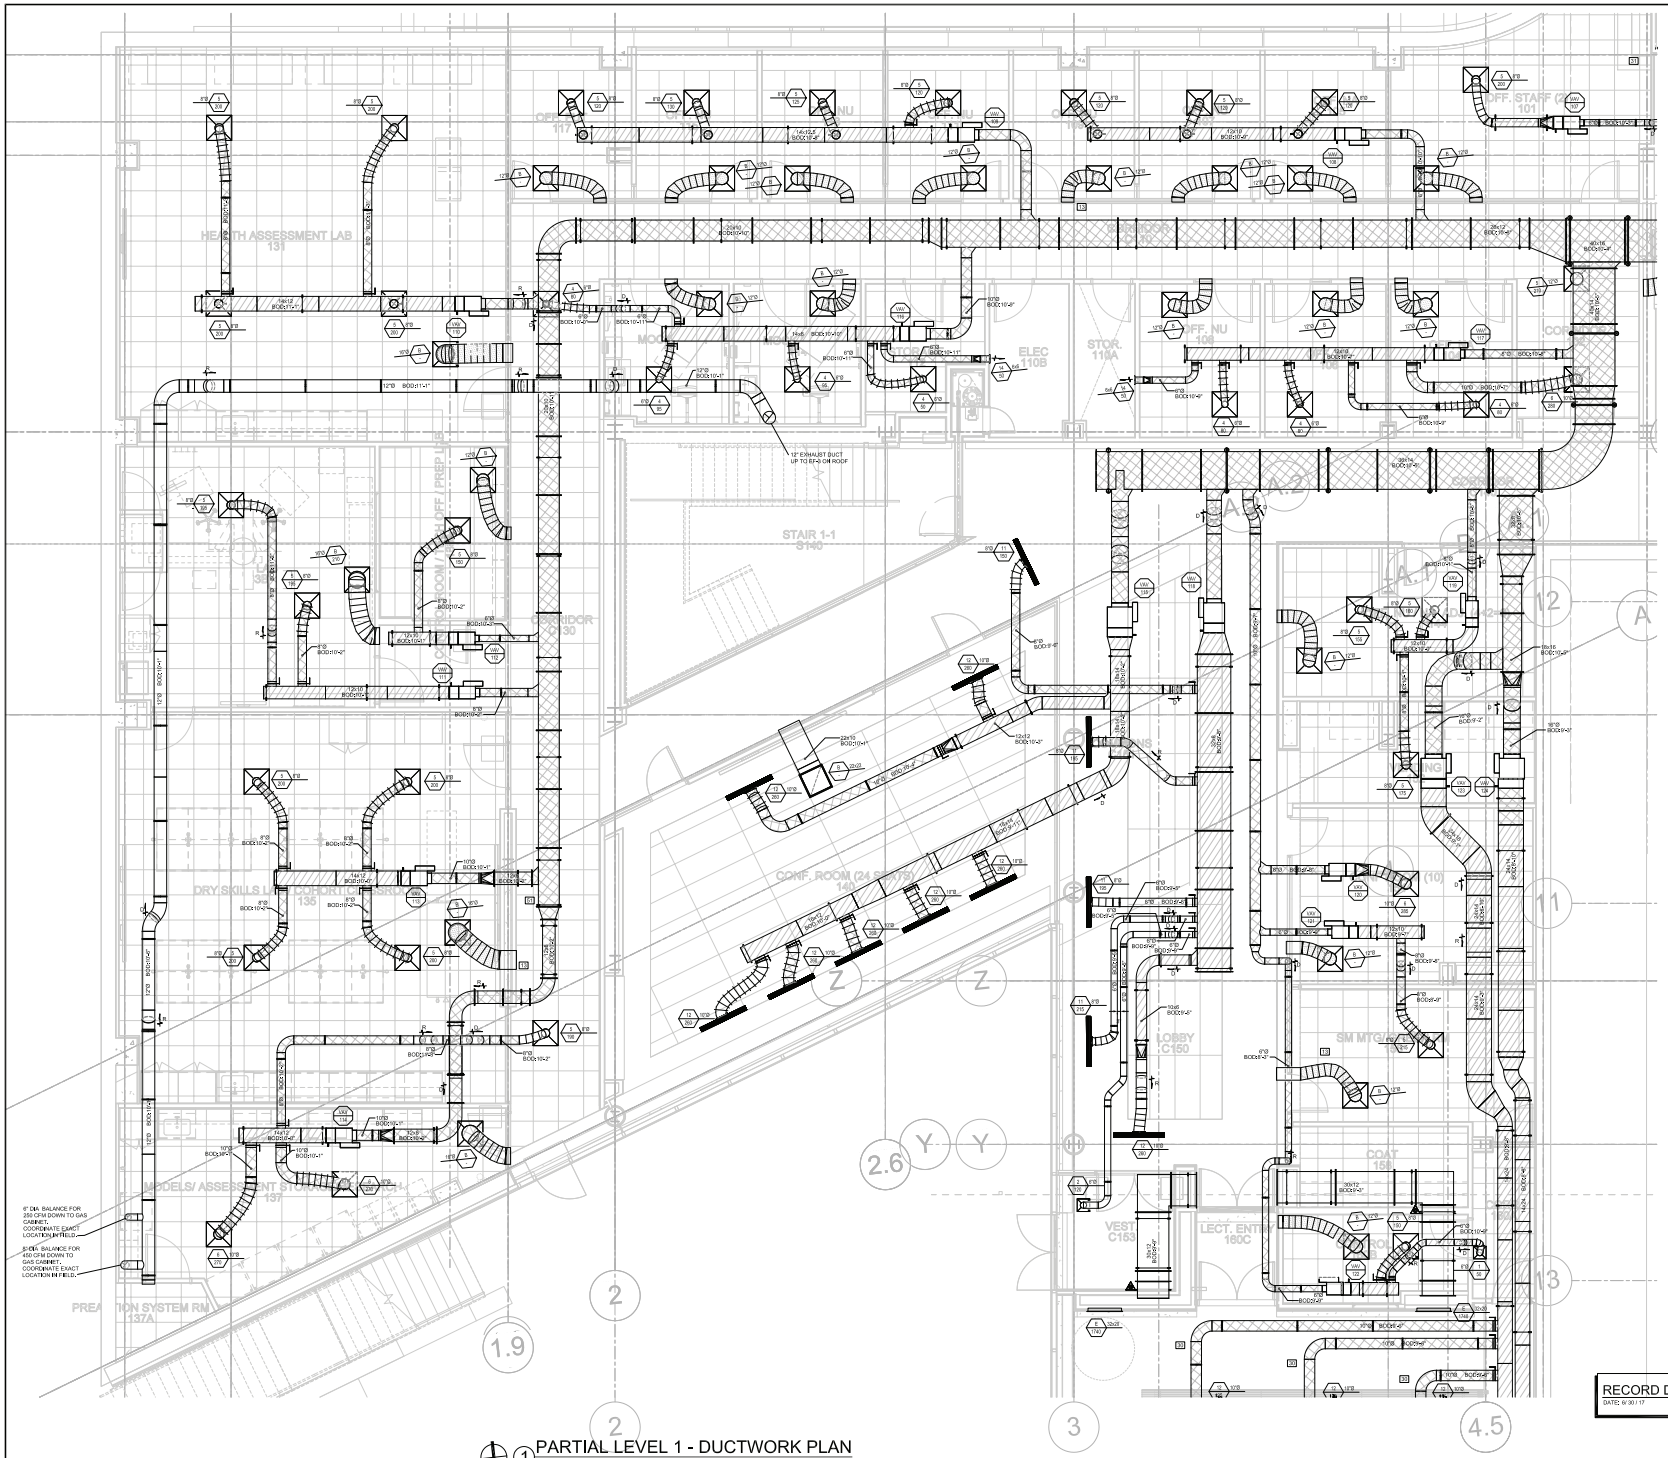

① PARTIAL LEVEL 1 - DUCTWORK PLAN
SCALE: 1/4"=1'-0"

RECORD DRAWINGS
DATE: 8/30/17 DRAWN BY: ZPL

KEY PLAN
A1
A2
B1
B2

Mechanical
1818 Cleveland Blvd. • Granite City, IL 62040
www.iconmech.com

WEBSTER UNIVERSITY - ISB

WEBSTER GROVES, MISSOURI

ICON MECHANICAL CONTRACTORS AND ENGINEERS

NOT VALID FOR PERMITS UNLESS SEALED BY ENGINEER

Revision:

Issue Date
XX / XX / XX

Sheet Title
SM101B1

Project Number
5768

Sheet Number
1 of 1

DATE: 10/27/2017 FILE PATH: K:\Projects\ACAD\2016_JOBS\5768 - Webster ISB\Sheets\SM101B1 PARTIAL LEVEL 1 - DUCTWORK PLAN.dwg
PLOTTED BY: Curtis Lum