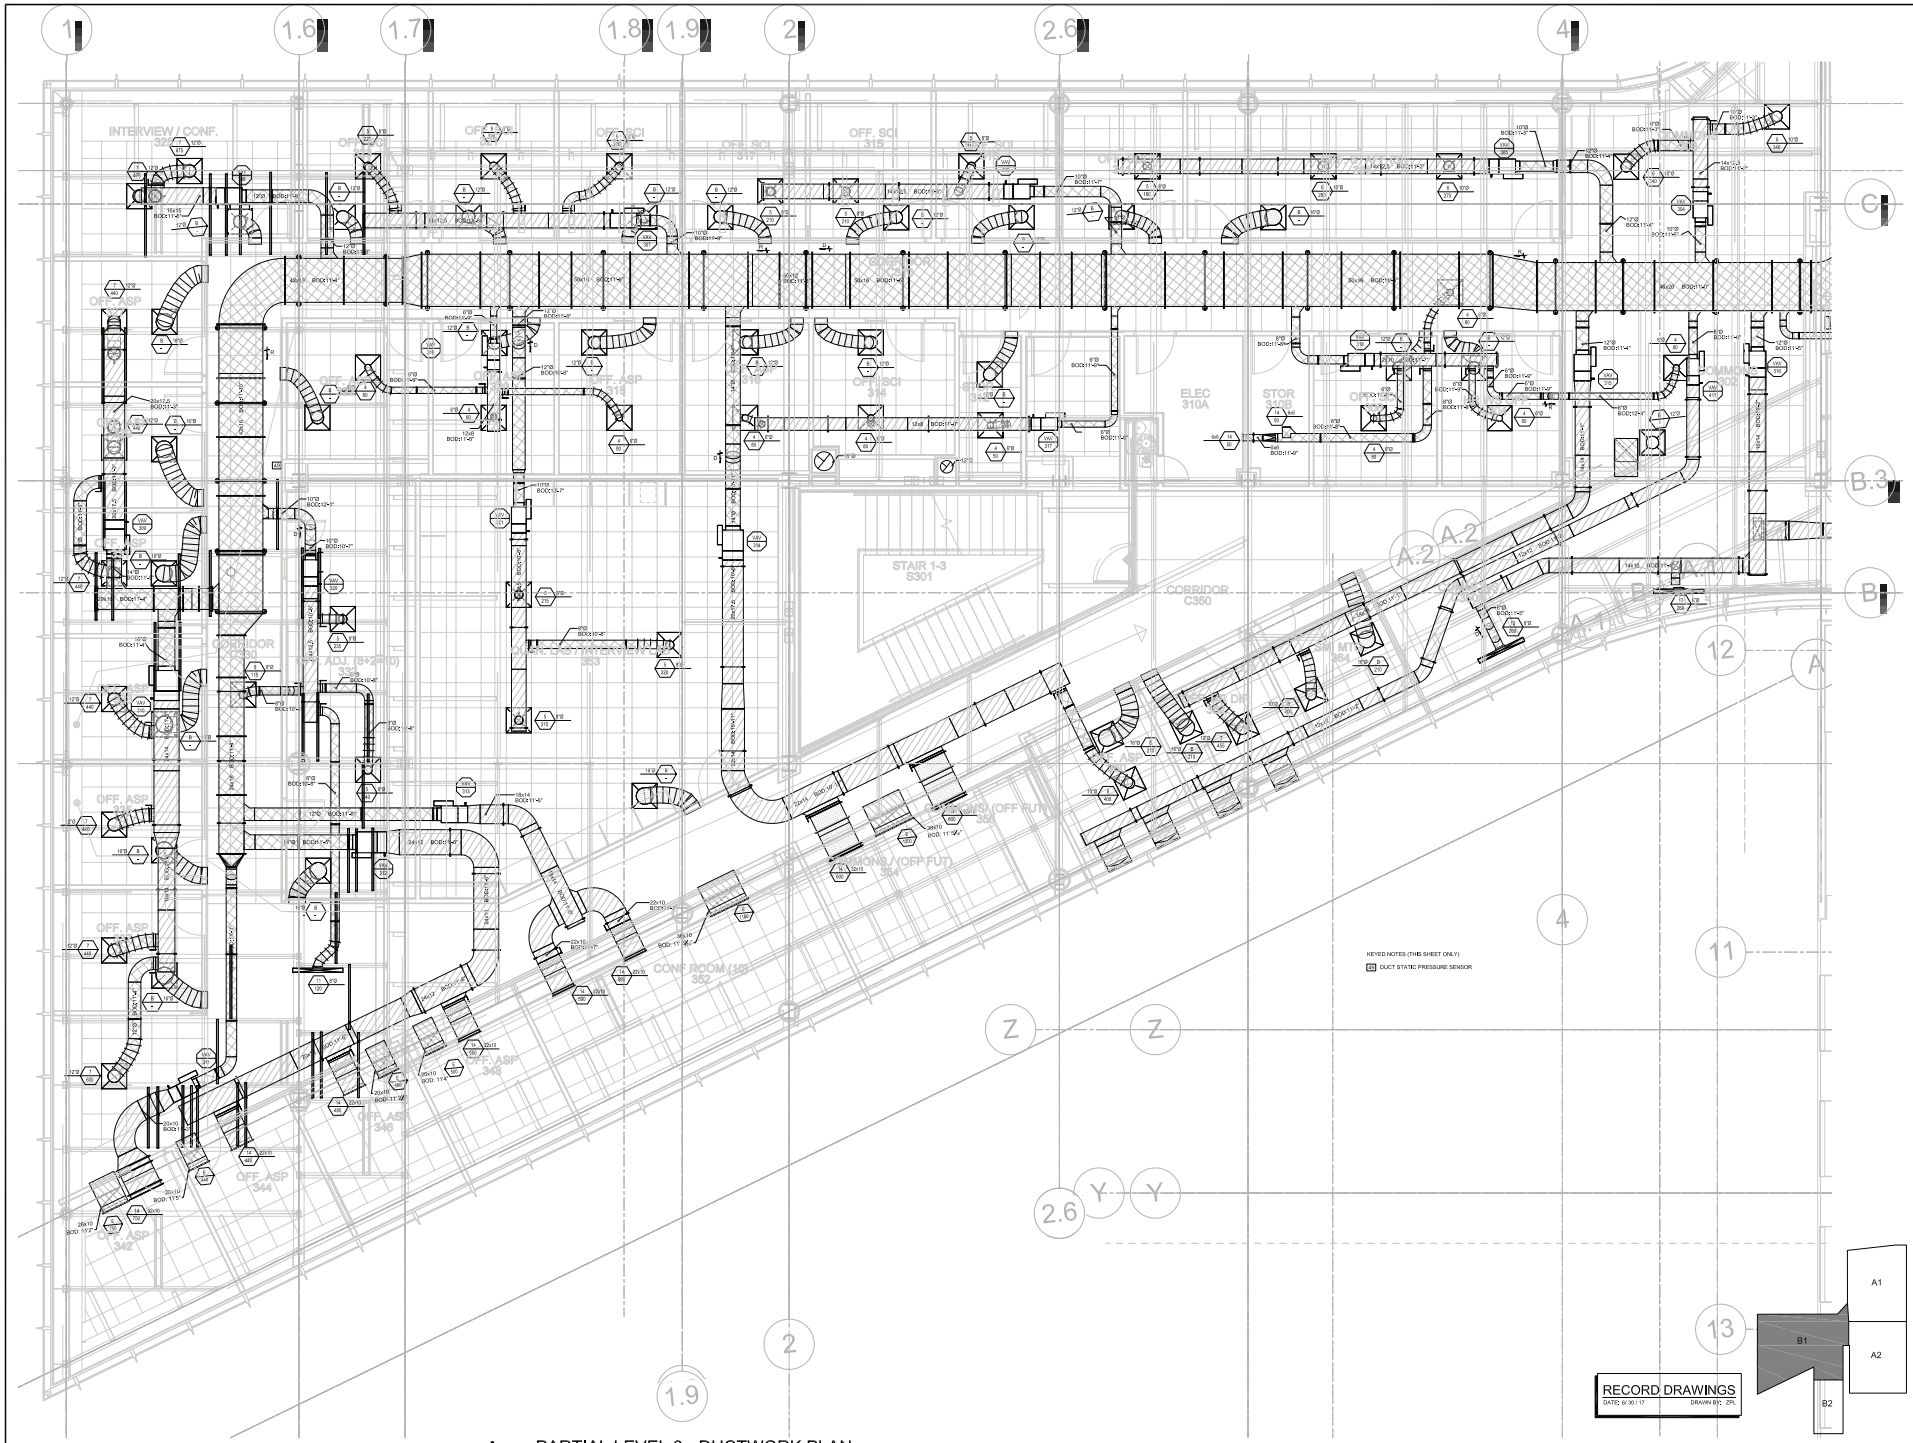

1 PARTIAL LEVEL 3 - DUCTWORK PLAN
SCALE: 1/4"=1'-0"

KEY PLAN

Mechanical
1616 Cleveland Blvd. • Granite City, IL 62040
www.iconmech.com

WEBSTER UNIVERSITY - ISB

WEBSTER GROVES, MISSOURI

ICON MECHANICAL CONTRACTORS AND ENGINEERS

NOT VALID FOR PERMITS UNLESS SEALED BY ENGINEER

Revision:

Issue Date
11 / 14 / 16

Sheet Title
SM103B1

Project Number
5768

Sheet Number
1 of 1

DATE: 6/22/2017 FILE PATH: K:\Eng\Revit\CAD\2016_JOBS\5768 - Webster ISB\Revit\SM103B1 PARTIAL LEVEL 3 - DUCTWORK PLAN.rvt
PLOTTED BY: Curtis Lum