



January 13, 2017

Craig A. Miller Sr
Webster University
470 East Lockwood Ave
St. Louis, MO 63119-3194

Via Email

Re: Paric Corporation Project No. 15051
15051-Webster University Interdisciplinary Science Building
CP-074 - ASI#39 - Electrical fixture revisions

Dear Craig A. Miller Sr:

Paric Corporation proposes to complete the following additional work for the deducted sum of Negative Five Hundred Sixty-Five Dollars And Zero Cents (-\$565.00).

This change will impact the scheduled completion date by 0 days.

- PCI-E-0070 (ASI#39 - Electrical fixture revisions), Total \$ -565.00

The owner contingency shall be used for this change proposal.

Proposed Change Proposal Total: -\$565.00

If this change proposal meets with your approval, please sign and return this proposal for our records by January 20, 2017 at the latest. If accepted this scope will be incorporated into a change order.

Sincerely,

Paric Corporation


Jason Szachnieski
Project Manager

Accepted: 

Date: 1/27/2017
Craig A. Miller Sr
Webster University

Declined:

Date: _____
Craig A. Miller Sr
Webster University

Paric Corporation

PROJECT MANAGEMENT - CHANGE ITEM DETAIL REPORT

15051 - 15051-Webster University Interdisciplinary Science Building

Page: 1 of 1

Date: 13-JAN-17

Time: 07:16 AM

Status: EXT EXT

CI Type	CI Number	Description	Estimated Amount	Quoted Amount	Final Amount	Due to Owner	Notes	Date Sent	Date Received	Date Closed	Budgeted Amount	Billing Amount	Owner CO
EXT	PCI-E-0070	ASI#39 - Electrical fixture revisions			-565.00	13-JAN-17					-565.00	-565.00	
Vendor Name			Description										
	Guarantee Electrical Construction Co	15051	16000.001 S	Electrical Sub	-538.00	ASI#39 - Electrical fixture revisions	Provide revisions for ASI#39 per GECO proposal dated 1/5/17. Deduct \$538						
	PARIC	15051	23150.005 M	Contractor Default Insurance (1.25%)	-7.00	ASI#39 - Electrical fixture revisions	Contractor Default Insurance						
	PARIC	15051	23300.001 F	Fee (2.5%)	-14.00	ASI#39 - Electrical fixture revisions	Contractor Fee						
	PARIC	15051	23100.001 M	Risk Management (1.1%)	-6.00	ASI#39 - Electrical fixture revisions	Risk Management						
Total For EXT			0.00	0.00	-565.00						-565.00	-565.00	
Grand Total:			0.00	0.00	-565.00						-565.00	-565.00	

END OF REPORT

Report Parameters

Job:	15051	Project Code:	
From Change Order:		Run Date:	13-JAN-17
To Change Order:		Run Time:	07:16 AM
Status Code:		Operator:	JAS39SZA
Report Type:	DETAIL	Posting Status:	Unposted CI
Print Notes:	Y	Report Code:	PM5000
Group By:	STATUS		

CP-14
E-0070



ELECTRICAL CONSTRUCTION

3415 Bent Avenue St. Louis, MO 63116 ph (314) 772-5400 fx (314) 772-2526 web geco.com

PROPOSED CHANGE ORDER

Client Address:

PARIC CORPORATION
Contact: Jason Szachnieski
77 W PORT PLAZA # 250
ST. LOUIS, MO 63146

CCN #

Date:

Project Name:

Project Number:

Page Number:

ASI - 039

1/5/2017

WEBSTER GROVES ISB BUILDING

WEBSTER GROVES ISB BUILDING

1

Work Description

WEBSTER ISB ASI - 039

Description of work

- * Fixture Manufacture Changes.
- * Install (3) remote power supplies for the type EK fixtures.

Base Bid Shall Decrease by: \$ 538.00

We reserve the right to correct this quote for errors and omissions.

This quote covers direct costs only and we reserve the right to claim for impact and consequential costs.

This price is good for acceptance within 30 days from the date of receipt.

We request a time extension of 20 days.

We will supply and install all materials, labor, and equipment.

Itemized Breakdown

Description	Qty	Total Mat.	Total Hrs.
3/8" STRAPS	6	0.71	0.30
3/8" STEEL FLEX	25	13.23	1.08
3/8" STL FLEX CONN	6	7.08	0.72
#12 THHN BLACK	120	12.79	0.90
#12 WIRE POWER TERM	6	0.06	1.20
FIXTURE TYPE EK REMOTE POWER SUPPLY	3	0.00	3.00
Totals	166	33.87	7.20

Summary

General Materials	33.87
LIGHTING FIXTURES	-1,121.00
Material Total	-1,087.13
LU 1 - GF - ST - ELEC @ 86.64/hr	31.18
LU 1 - F - ST - ELEC @ 81.10/hr	58.39
LU 1 - JW - ST - ELEC @ 75.60/hr	489.89

ORIGINAL

PROPOSED CHANGE ORDER

Client Address:

PARIC CORPORATION
77 W PORT PLAZA # 250
ST. LOUIS, MO 63146

CCN #

Date:

Project Name:

Project Number:

Page Number:

ASI - 039

1/5/2017

WEBSTER GROVES ISB BUILDING

WEBSTER GROVES ISB BUILDING

2

Summary (Cont'd)

EXPENDABLES	0.68
SMALL TOOLS	17.38
Subtotal	-489.61
Overhead	-48.96
Subtotal	-538.57
Adjustment #1	0.57
Final Amount	\$-538.00

CONTRACTOR CERTIFICATION

Name: _____

Date: _____

Signature: _____

I hereby certify that this quotation is complete and accurate based on the information provided.

CLIENT ACCEPTANCE

CCN #: ASI - 039

Final Amount: \$-538.00

Name: _____

Date: _____

Signature: _____

Change Order #: _____

I hereby accept this quotation and authorize the contractor to complete the above described work.

ORIGINAL

Architect's Supplemental Instructions

Architect's Project No:
04561.01

Architect's ASI No: 039

Project:
Webster University
Interdisciplinary Science
Building

Date Issued: 12/22/2016

Contract Date:

Reason Code: 05 A/E Scope

Discipline Code: 03 Electrical

Owner:
Webster University

Architect:
Cannon Design
1100 Clark Avenue
St. Louis, MO 63102

Contractor:
Paric Construction

Contract For: General Construction

The Work shall be carried out in accordance with the following supplemental instructions issued in accordance with the Contract Documents without change in Contract Sum or Contract Time. Indicate your acceptance of these instructions for minor change to the Work as consistent with the Contract Documents and return a copy to the Architect within fourteen (14) business days of the date of issuance of these instructions. If you feel a change in Contract Sum or Contract Time is warranted, please submit an itemized quotation for the changes for approval within fourteen (14) business days of the date of issuance of these instructions prior to proceeding on the Work. Proceeding with the Work in accordance with these instructions indicates your acknowledgement that there will be no change.

Attachments:

Drawings:

E0204.A, E0204.B, AND E0701

St. Louis
Baltimore
Boston
Buffalo
Calgary
Chicago
Houston
Los Angeles
Mumbai
New York
Phoenix
San Francisco
Shanghai
Toronto
Vancouver
Victoria
Washington DC

1100 Clark Avenue
St. Louis, Missouri
63102
T: 314.241.6250
F: 314.241.2570
www.cannondesign.com

Reason Codes:
#1. Jurisdictional Agency
#2. Constructor Driven
#3. Document Inconsistency
#4. Fast Track Driven
#5. A/E Scope
#6. Owners Scope
#7. Unforeseeable Conditions
#8. Other

Discipline Codes
#1. Demo-demolition
#2. Div1-Division 1 items on the spec book
(this item is not used)
#3. Electrical
#4. Elevator
#5. Equipment (Changes in equipment,
Owner Purchased)
#6. Fire Protection

Discipline Codes
#7. General Construction (Architectural)
#8. General Conditions (Div. 1)
#9. HVAC
#10. Other
#11. Plumbing
#12. Site Work/Landscaping
#13. Structural

Architect's Supplemental Instructions

Page 2

Description:

Please submit an itemized proposal for changes in contract Sum and Contract Time for proposed modifications to the Contract Documents described herein:

SHEET E0204.A LEVEL 04 AREA A FLOOR PLAN - LIGHTING

- In Corridor C480 revise Type RN fixture switching.

SHEET E0204.B LEVEL 04 AREA B FLOOR PLAN - LIGHTING

- In main stairwell, locate Type BC15 centered within skylight opening and 24" above bottom of stairwell ceiling.

SHEET E0701 LIGHT FIXTURE SCHEDULE

- Revise Type EC manufacturer, catalog number, and lumen output.
- Revise Type EK manufacturer and catalog number.

Issued by Architect: Mark de la Fuente, William Tao & Associates, Inc.

Accepted by Contractor:

THE DRAWING AND SPECIFICATIONS APPLY ONLY TO THE
WORK SHOWN TO WHICH THEY ARE ATTACHED, AND
CONTRACTOR SHALL BE RESPONSIBLE FOR ALL
CHANGES, OMISSIONS, AND ADDITIONS. ANY
CHANGES TO BE MADE FOR ANY PART OR PARTS OF
THE ARCHITECTURAL OR ENGINEERING PROJECT.

Webster
UNIVERSITY

Webster University
Interdisciplinary Science
Building

CANNON DESIGN

1100 Oak Avenue
St. Louis, Missouri 63103
T 314.431.6200
F 314.241.2570

William Tate & Associates, Inc.
MECHANICAL ENGINEERS
1045 Manchester Road, Suite 120
St. Louis, MO 63103
T 314.581.7800
David M. H. Associates, Inc.
ELECTRICAL & CIVIL ENGINEERS
800 South Webster Avenue
St. Louis, MO 63103
T 314.524.1033

Path Group
Interior Design
1101 S. Vandeventer Road, Suite 100
St. Louis, MO 63103
T 314.991.2228

Kulmeyer Lendell, Inc.
Environmental Graphics & Signage
1001 N. Grand Blvd.
St. Louis, MO 63103
T 314.752.8818

ROMA Architecture
Architects
3721 Lounsbury Road
St. Louis, MO 63114
T 314.962.0260

Sperman Brady & Company
Interior Design
6021 N. Maryland Avenue, Suite 303
St. Louis, MO 63119
T 314.882.1070

SEIT Design
Landscape Architect
7133 29th Street
St. Louis, MO 63119
T 314.641.8700


Webb Engineering Services, Inc.
Mechanical & Fire Protection
1400 S. Olive Street, Suite 201
St. Louis, MO 63104
T 314.568.0200

GENERAL NOTES:

- DO NOT SCALE DRAWINGS. REFER TO ARCHITECTURAL PLANS AND ELEVATIONS FOR LOCATION AND ORIENTATION OF DEVICES. WHERE LOCATIONS ARE NOT INDICATED ON ARCHITECTURAL DRAWINGS, COORDINATE LOCATION AND ORIENTATION OF DEVICES IN FIELD WITH ARCHITECT PRIOR TO ROUGH IN.
- CONTRACTOR SHALL VISIT PRIOR TO BID SUBMITTALS TO DETERMINE SITE CONDITIONS. EFFECTIVE THE EXECUTION OF WORK, FAILURE TO BE ACCUMULATED WITH EXISTING CONDITIONS WILL NOT BE JUSTIFICATION FOR ADDITIONAL SERVICES.
- PROVIDE FACE PLATES ON ALL J BOXES ABANDONED IN FINISHED FLOOR, WALL OR CEILING. COORDINATE COLOR AND FINISH WITH ARCHITECT. CONTRACTOR TO VERIFY QUANTITY IN THE FIELD.
- WHERE EXPOSED CONDUIT IS NOTED, CONTRACTOR SHALL IDENTIFY ROUTING IN FIELD AND OBTAIN ARCHITECT'S APPROVAL OF ROUTING PRIOR TO ROUGH IN. EXPOSED CONDUIT SHALL BE ROUTED TIGHT TO STRUCTURE.
- MINIMUM 1/2" MIN. CONTROL WIRE SIZE SHALL BE #18 AWG FOR RUNS LONGER THAN 100'. DO NOT MIX HIGH VOLTAGE AND LINE VOLTAGE WIRING UNLESS APPROVED BY CONTROL MANUFACTURER.
- ALL SINGLE PHASE BRANCH CIRCUITS SHOWN WITH COMMON NEUTRAL SHALL HAVE INDIVIDUAL 30A 1P CIRCUIT BREAKER. CONTRACTOR TO PROVIDE HANDLE TIES TO MEET IACS SECTION 2.0.4 MULTI WIRE BRANCH CIRCUIT REQUIREMENTS. REFER TO DRAWINGS FOR CIRCUITS WITH DESIGNATED NEUTRALS.
- SHADE FIXTURES AND FIXTURES NOTED WITH AN "E" ARE FOR EMERGENCY EGRESS. CONNECT FIXTURES TO LIFE SAFETY PANEL. [SEE]
- FIXTURES NOTED WITH "L" ARE LUMINAIRES SWITCHED NIGHT LIGHTS AND SHALL BE LEFT ON AFTER HOURS FOR WAY FINDING.
- WHERE A SWITCH WITH A "D" IS CALLED OUT, PROVIDE LUTRON DIVA 2 10V WALLBOX DIMMER WITH INTEGRAL RELAY. COORDINATE DIMMER VOLTAGE WITH CIRCUIT. WHERE A "D" IS CALLED OUT, CONFIGURE DIMMER FOR 3-WAY DIMMING.
- CONNECT NON-EMERGENCY 277V LIGHTING ON THIS FLOOR TO PANEL. [SEE] CONNECT SHADES TO 120V PANEL, SERVING LAB.

KEYED NOTES

- THE LIGHTING CONTROLS IN THIS ROOM ARE CONNECTED TO THE BUILDING LIGHTING CONTROL SYSTEM.
- PROVIDE SEPARATELY CONTROLLED TYPE BA UNGLAZED FIXTURE, MOUNTED TO AN ARCHITECTURAL CHANNEL WITH WINDOW SILL LIGHTING FEATURE. SHALL EXTEND FROM 3RD FLOOR TO 4TH FLOOR. SEE THIRD AND FOURTH FLOOR PLANS FOR CONTINUATION. PRELIMINARY OVERALL LENGTHS ARE INDICATED IN PARENTHESES. COORDINATE FINAL LENGTHS WITH BUILT ROOM DIMENSIONS AND PROVIDE A CONTINUOUS FIXTURE FROM WALL TO WALL, ALLOW A 3" GAP BETWEEN WALL AND START/END OF FIXTURE. REFER TO DETAIL 1 ON SHEET A04-1 FOR MOUNTING CONFIGURATION.
- PROVIDE SQUARE D AUTOMATIC LOAD CONTROL RELAY (OR APPROVED EQUAL) TO CONTROL SWITCHED LIFE SAFETY LIGHTS IN THIS ROOM. CONFIGURE RELAY TO ENSURE LIGHTS ENERGIZE UPON LOSS OF NORMAL POWER. PROVIDE DIMMING RELAY WHERE A DIMMER CONTROLS THE LIGHTS.
- CONNECT 120 VOLT, TYPE USA MAGNETICALLY MOUNTED UNDERCABINET LIGHTING TO DEDICATED LIGHTING CIRCUIT IN OVERHEAD CARRIER ROUTE CIRCUIT VIA LIGHTING CONTROL SYSTEM. COORDINATE REMOTE DRIVER LOCATION WITH FURNITURE. PROVIDE ONE REMOTE DRIVER PER MOVABLE TABLE.
- PROVIDE 120 VOLT CIRCUIT FOR MOTORIZED SHADES. COORDINATE WIRING REQUIREMENTS AND LOCATIONS WITH SHADE VENDOR.
- PROVIDE MOTORIZED SHADE SYSTEM CONTROL KEYPAD AND CONFIGURE TO OPERATE MOTORIZED SHADES. REFER TO APPROVED SHOP DRAWINGS FOR SYSTEM WIRING.
- COORDINATE LOCATION OF ELEVATOR SHAFT LIGHTS AND SWITCH WITH ELEVATOR EQUIPMENT.

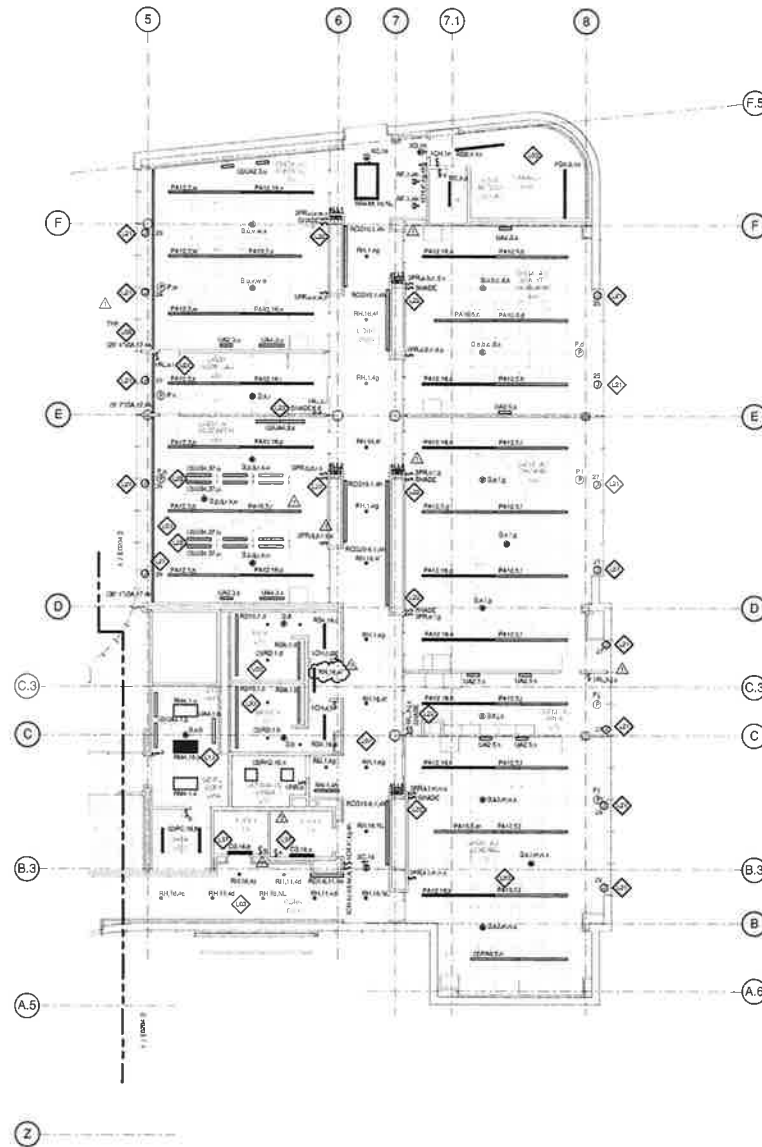

LEVEL 04 - AREA A - LIGHTING PLAN

1

THE RULES AND REGULATIONS APPLY TO THE DOCUMENT TO WHICH THEY ARE APPLIED AND OTHER PLANS, SPECIFICATIONS, NOTES, AND OTHER DOCUMENTS OF THE PROJECT SHALL BE REFERRED TO AS THEY ARE PART OF THE PROJECT'S ARCHITECTURAL POLICY.

Webster
UNIVERSITY

Webster University
Interdisciplinary Science
Building

CANNON DESIGN

1100 Cook Avenue
St. Louis, Missouri 63102
T 314.241.6500
F 314.241.2500










GENERAL NOTES:

- DO NOT SCALE DRAWINGS. REFER TO ARCHITECTURAL PLANS AND ELEVATIONS FOR LOCATION AND ORIENTATION OF DEVICES. WHERE LOCATIONS ARE NOT INDICATED ON ARCHITECTURAL DRAWINGS, COORDINATE LOCATION AND ORIENTATION OF DEVICES IN FIELD WITH ARCHITECT PRIOR TO INSTALLATION.
- CONTRACTOR SHALL VISIT PRIOR TO BID SUBMITTALS TO DETERMINE SITE CONDITIONS AFFECTING THE ERECTION OF WORK. FAILURE TO BE ACQUAINTED WITH EXISTING CONDITIONS WILL NOT BE JUSTIFICATION FOR ADDITIONAL SERVICES.
- PROVIDE FACE PLATES ON ALL J BOXES ABANDONED IN FINISHED FLOOR WALL OR CEILING. COORDINATE COLOR AND FINISH WITH ARCHITECT. CONTRACTOR TO VERIFY QUANTITY IN THE FIELD.
- WHERE EXPOSED CONDUIT IS NOTED, CONTRACTOR SHALL IDENTIFY ROUTING IN FIELD AND OBTAIN ARCHITECT'S APPROVAL OF ROUTING PRIOR TO ROUGH IN. EXPOSED CONDUIT SHALL BE ROUTED TIGHT TO STRUCTURE.
- MINIMUM 120V CONTROL WIRE SIZE SHALL BE #16 (14) FOR RUNS LONGER THAN 600'. DO NOT MIX 120V LOW VOLTAGE AND LINE VOLTAGE WIRING UNLESS APPROVED BY CONTROLS MANUFACTURER.
- ALL SINGLE PHASE BRANCH CIRCUITS SHOWN WITH COMMON NEUTRAL SHALL HAVE INDIVIDUAL GFI-RC CIRCUIT BREAKER. CONTRACTOR TO PROVIDE HANDLE TIES TO MEET NEC SECTION 210.4(B)(1) WHERE BRANCH CIRCUIT REQUIREMENTS REFER TO DRAWINGS FOR CIRCUITS WITH DEDICATED NEUTRALS.
- SHADE FIXTURES AND FIXTURES NOTED WITH AN "E" ARE FOR EMERGENCY EGRESS. CONNECT FIXTURES TO LIFE SAFETY PANEL (JES).
- FIXTURES NOTED WITH "N" ARE UN-SWITCHED NIGHT LIGHTS AND SHALL BE LEFT ON/CHATTER HOUR FOR WAY FINDING.
- WHERE A SWITCH WITH A "D" IS CALLED OUT, PROVIDE LUTRON DIVA 6 (3W WALL/CLIMB DIMMER WITH INTEGRAL RELAY COORDINATE DIMMER VOLTAGE WITH CIRCUIT. WHERE A "SD" IS CALLED OUT, COORDINATE DIMMER 3W/3W DIMMING.
- CONNECT NON-EMERGENCY 277V LIGHTING ON THIS FLOOR TO PANEL 236C. CONNECT SHADES TO 120V PANEL SERVING LAB.

KEYED NOTES

- THE LIGHTING CONTROLS IN THIS ROOM ARE CONNECTED TO THE BUILDING LIGHTING CONTROL SYSTEM.
- PROVIDE SEPARATELY CONTROLLED TYPE SA LINEAR LED FIXTURE, MOUNTED TO AN ARCHITECTURAL CHANNEL WITHIN WINDOW SILL. LIGHTING FIXTURE SHALL EXTEND FROM 3RD FLOOR TO FOURTH FLOOR. SEE THIRD AND FOURTH FLOOR PLANS FOR COORDINATION. PRELIMINARY OVERALL LENGTHS ARE INDICATED IN PARENTHESES. COORDINATE FINAL LENGTHS WITH BUILT ROOM DIMENSIONS AND PROVIDE A CONTRASTING FINISH FROM WALL TO WALL. ALLOW A 3" GAP BETWEEN WALL AND START/END OF FIXTURE. REFER TO DETAIL 1 ON SHEET A084 FOR MOUNTING CONFIGURATION.
- CONNECT 120VOLT TYPE UB4 MAGNETICALLY MOUNTED UNDERCABINET LIGHTING TO DEDICATED LIGHTING CIRCUIT IN OVERHEAD CARRIER HOULTE CIRCUIT VIA LIGHTING CONTROL SYSTEM. COORDINATE REMOTE DRIVER LOCATION WITH FURNITURE. PROVIDE ONE REMOTE DRIVER PER MOVABLE TABLE.
- PROVIDE 120VOLT CIRCUIT FOR MOTORIZED SHADES. COORDINATE WIRING REQUIREMENTS AND LOCATIONS WITH SHADE VENDOR.
- REFER TO SHEET A0091.8 FOR STAIR DETAILS. LOCATE REMOTE DRIVERS FOR STAIRWELL FIXTURES IN AN ACCESSIBLE LOCATION. COORDINATE REMOTE DISTANCE WITH MANUFACTURER.
- WHERE TYPE SA LIGHTS ARE LOCATED ON A CURVED WALL, PROVIDE FIXTURE SEGMENTS.
- LOCATE TYPE SC18 24" ABOVE BOTTOM OF STAIR CEILING, SHIMING DOWNWARDS.

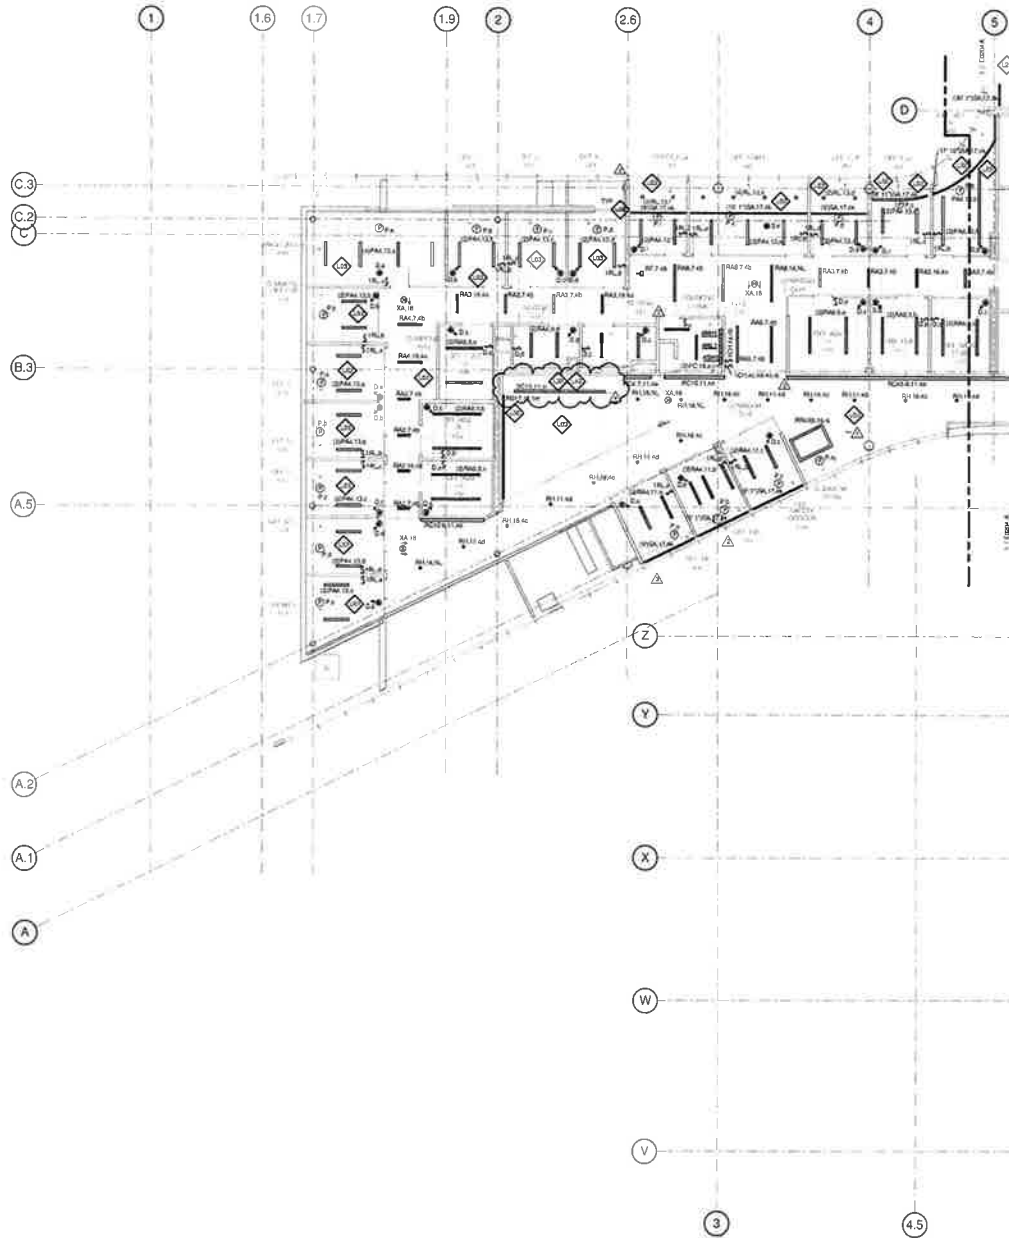

1 LEVEL 04 - AREA B - LIGHTING PLAN

© Cannon Design 2015
All rights reserved. No part of this document may be reproduced without written permission from Cannon Design.
11/15/2015 10:11:11 AM


ASB 100 21 DEC 2016
ASB 100 21 DEC 2016
LEVEL 04 AREA B FLOOR PLAN - LIGHTING

Project No. 04091-01 Created by

E0204.B

[illegible]