




© Cannon Design 2015
All rights reserved. This document may
be reproduced or transmitted in any form
or by any means, electronic, mechanical,
photocopying, recording, or by any
information storage and retrieval system,
without written authorization by The Cannon Corporation.
4/15/2016 4:50:28 PM

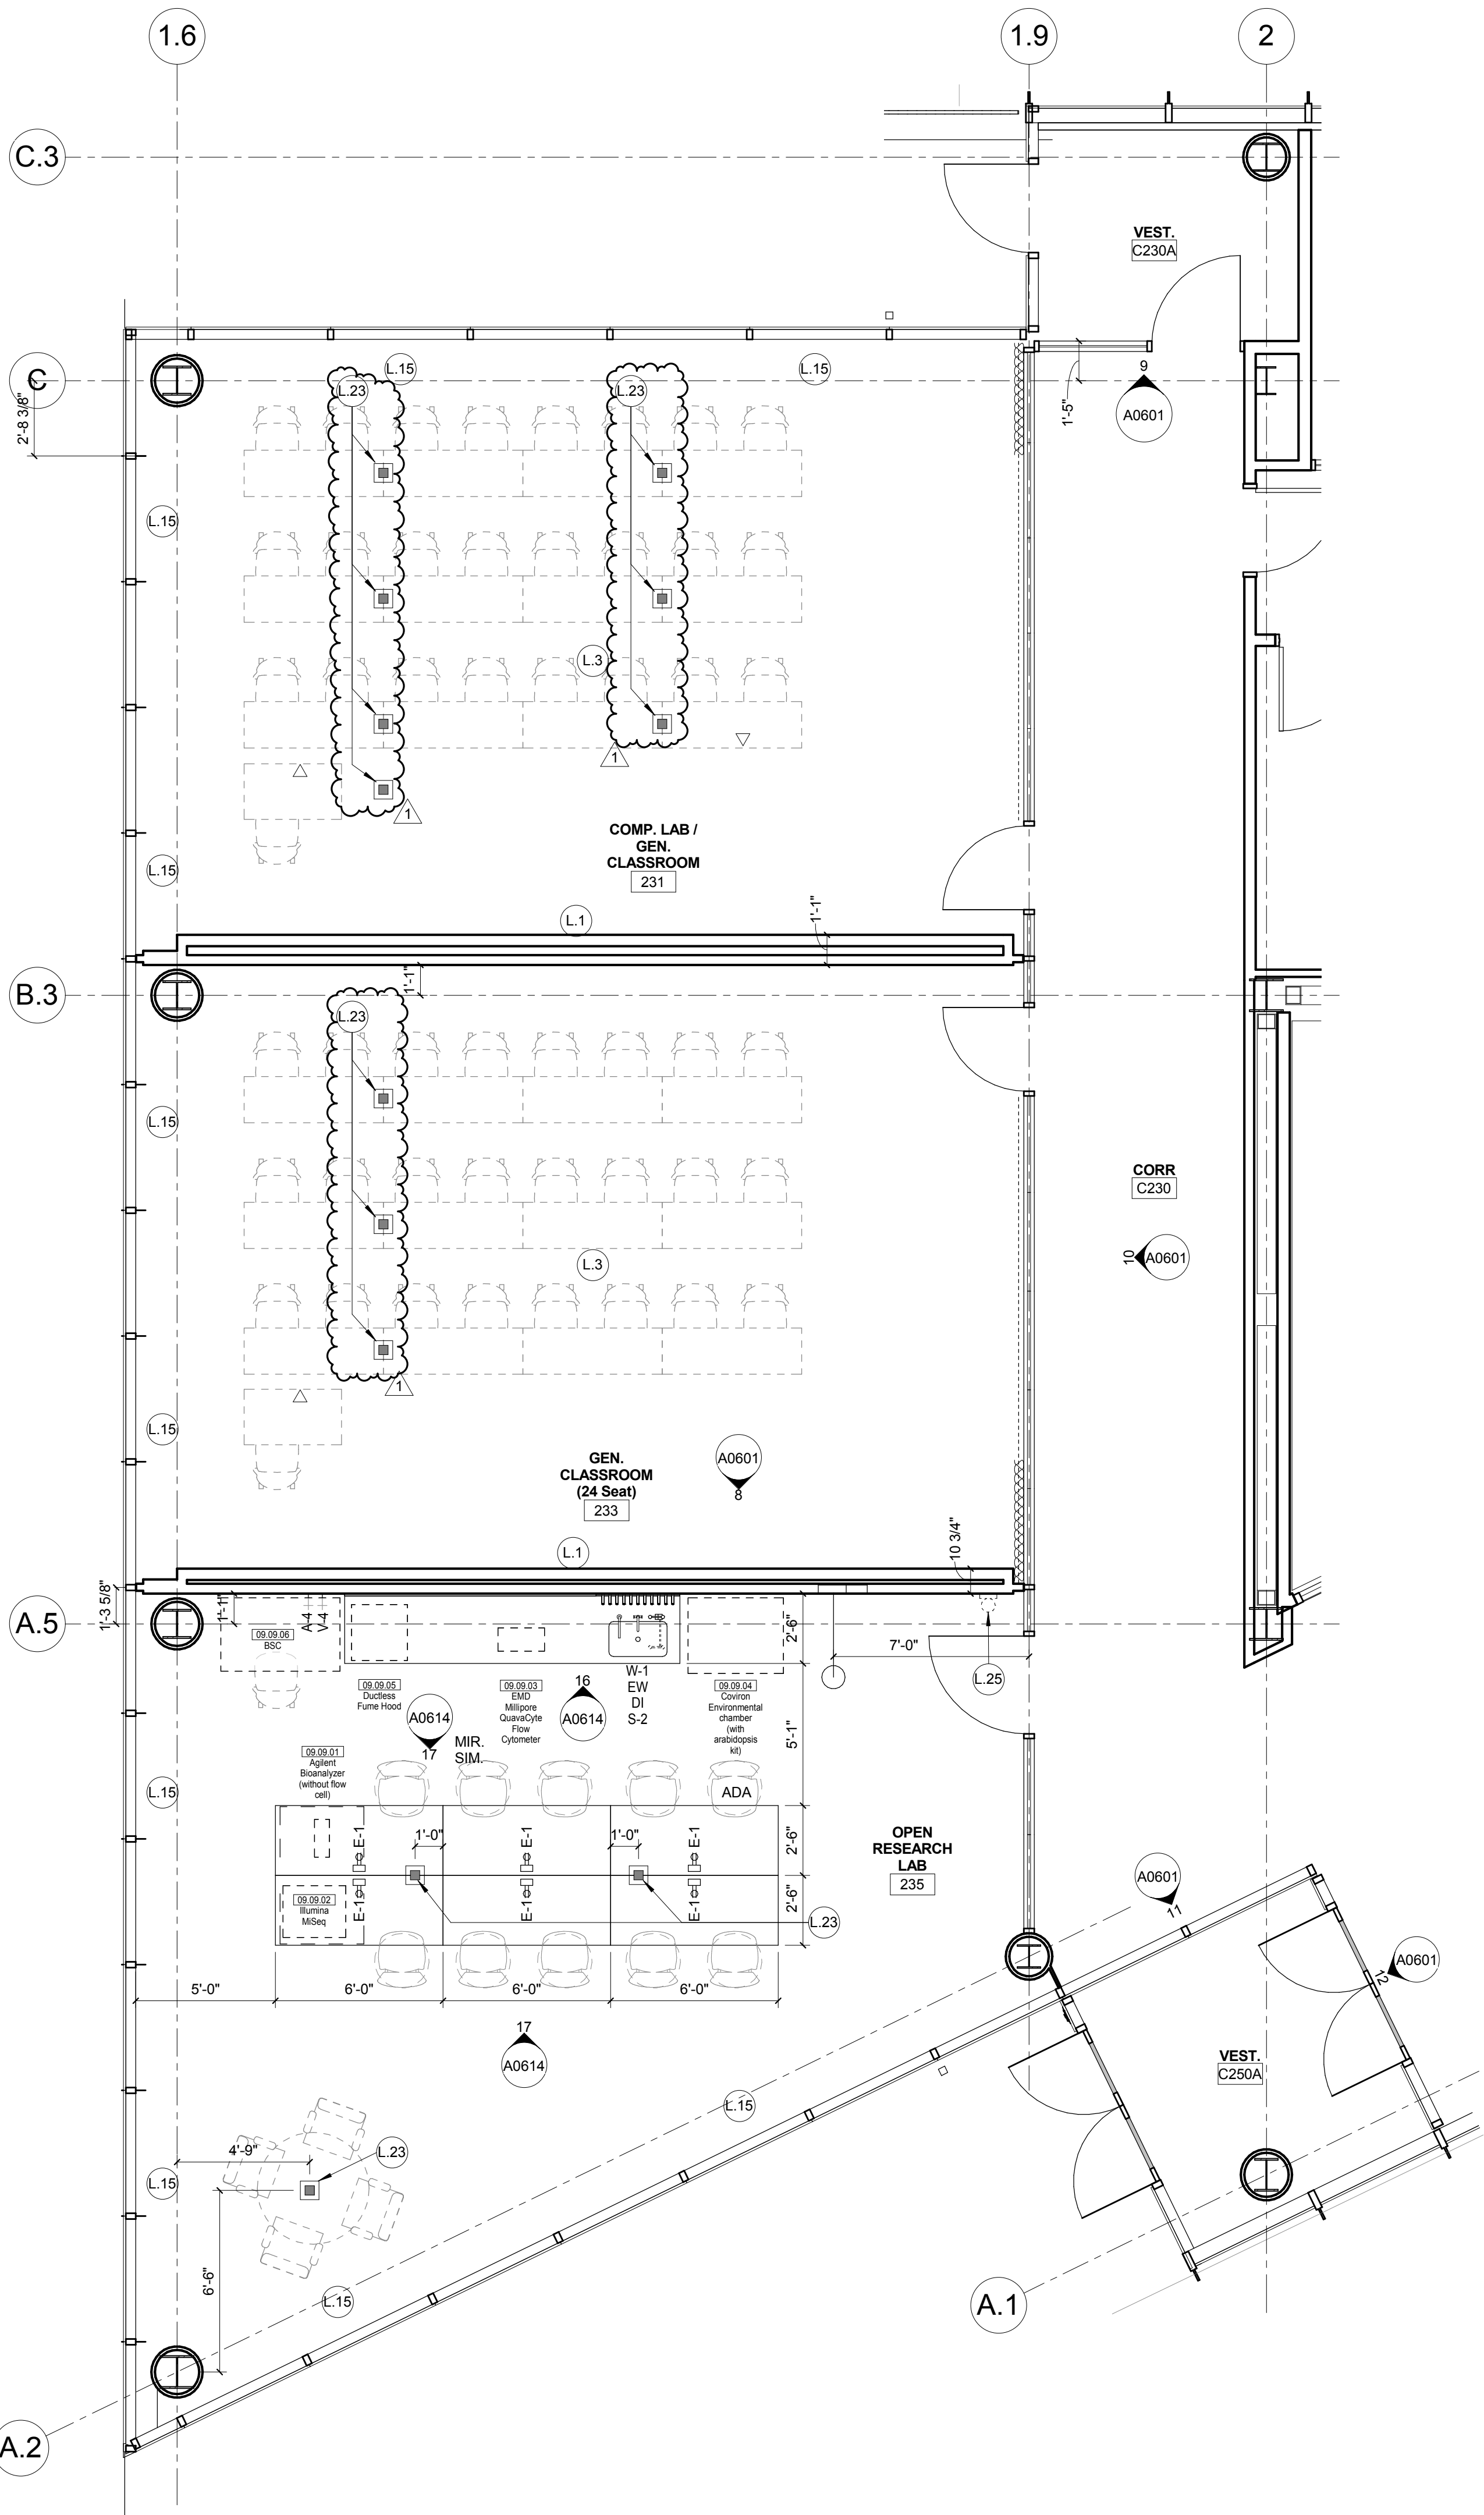

3 LEVEL 02 - AREA B - WEST - CLASSROOMS
1/4" = 1'-0"

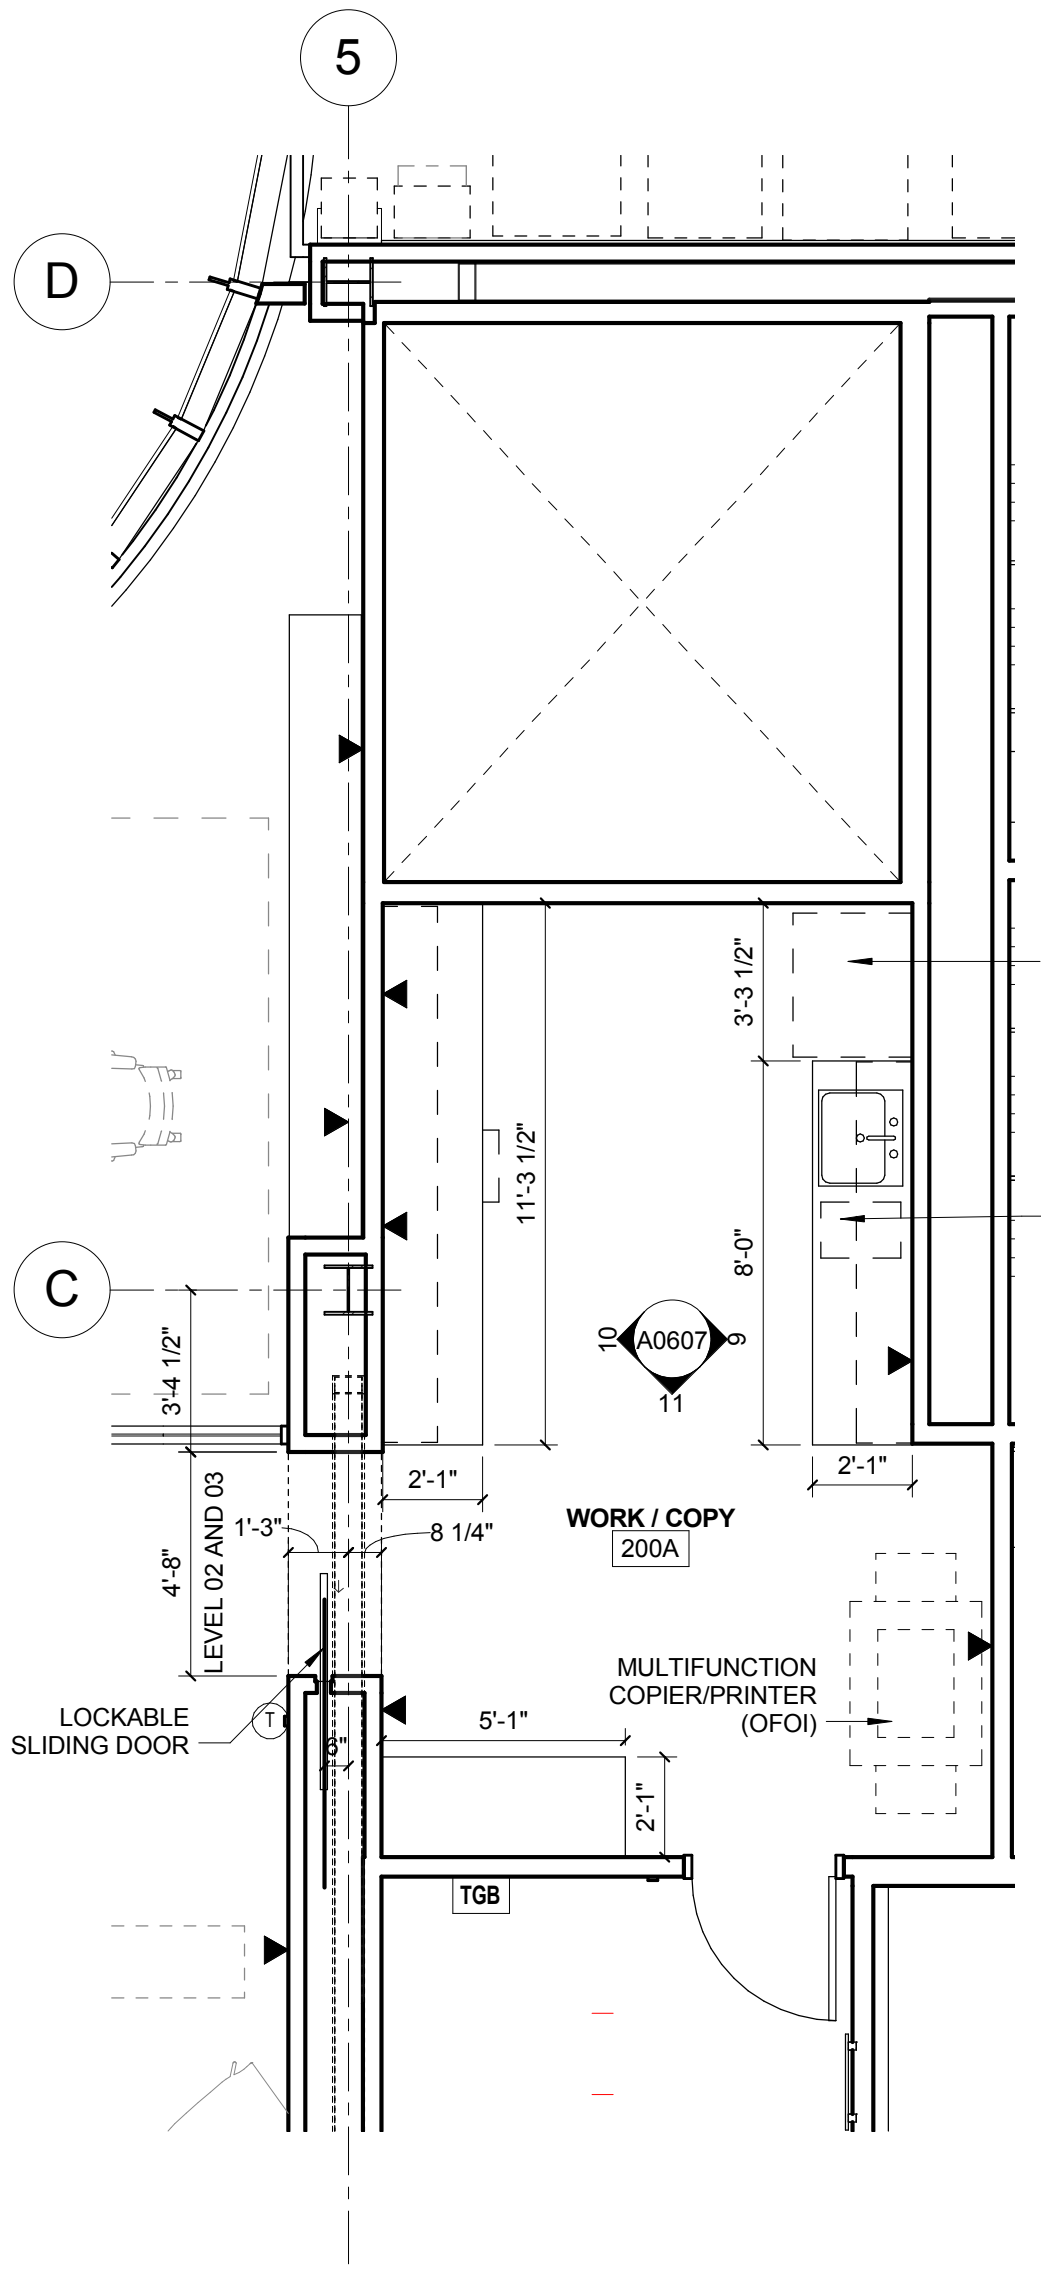

2 LEVEL 02 - AREA B - WORKROOM
1/4" = 1'-0"

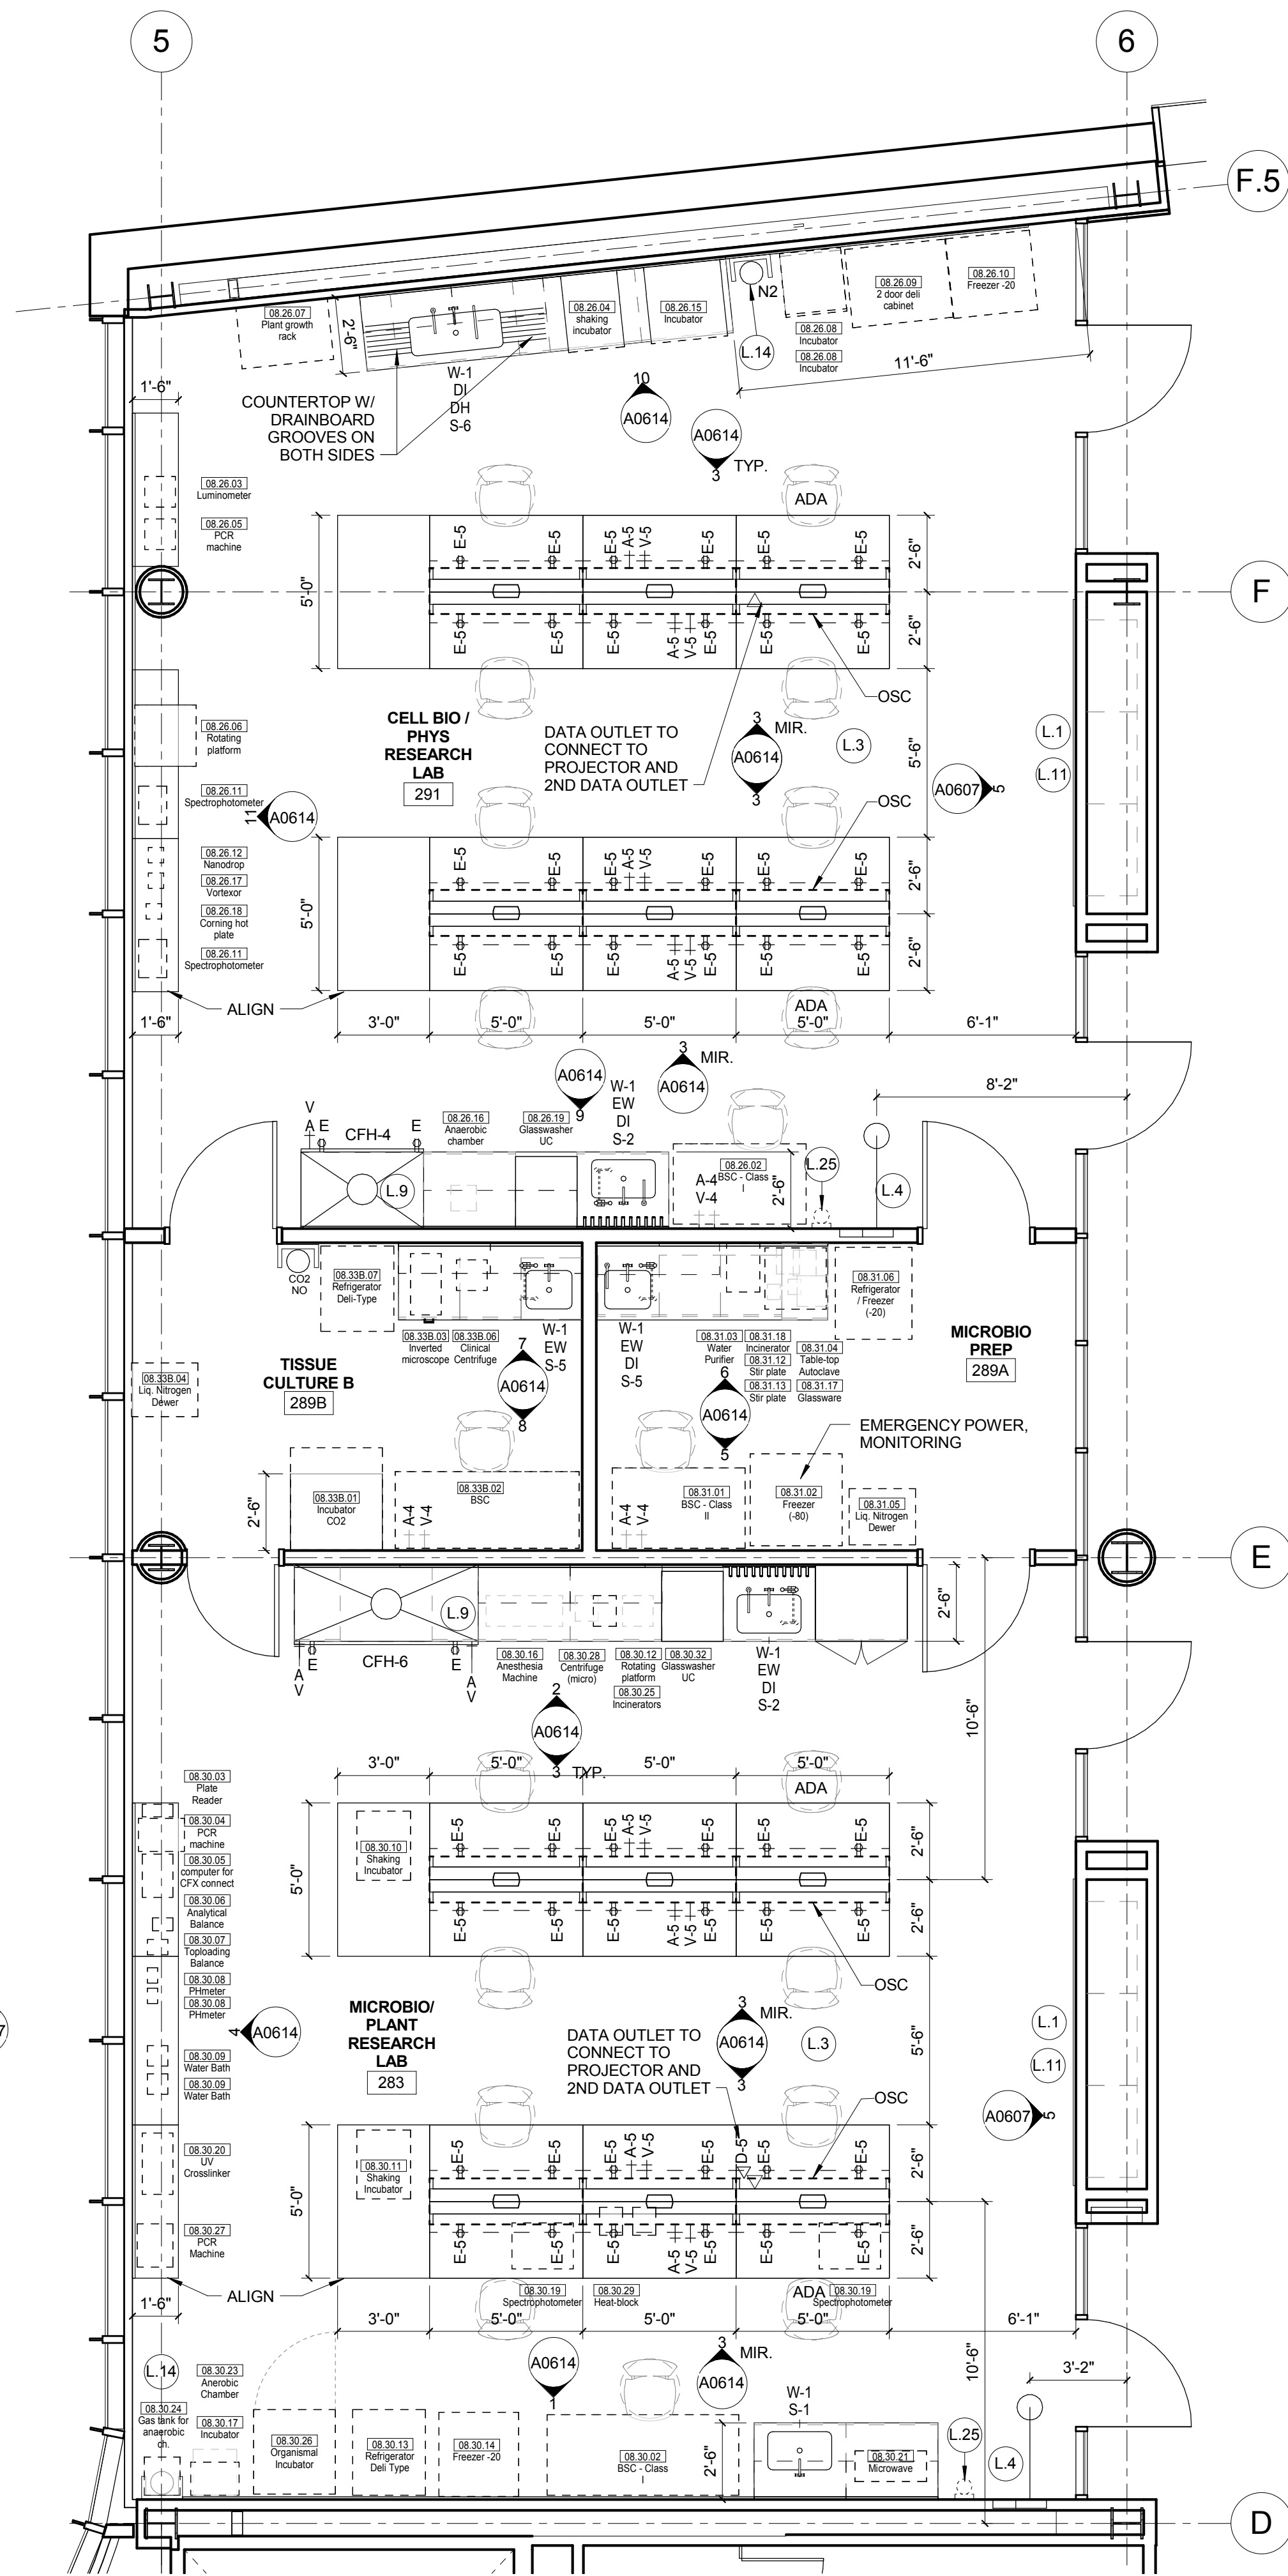

1 LEVEL 02 - AREA A - WEST - BIO LABS
1/4" = 1'-0"

- ### LAB KEYED NOTE LEGEND
- L.1 WRITABLE AND PROJECTABLE SURFACE. DIMENSIONS AS NOTED
 - L.2 RECESSED, CEILING MOUNTED PROJECTION SCREEN
 - L.3 WALL MOUNTED PROJECTOR ABOVE
 - L.4 EMERGENCY SAFETY SHOWER WITH EYEWASH
 - L.5 115313 CHEMICAL FUME HOOD W/ STORAGE BELOW. TYPICAL FUME HOOD TO HAVE ELECTRIC AND UTILITIES AS INDICATED.
 - L.6 WOOD LAB CASEWORK MICROSCOPE CAB
 - L.7 WOOD LAB CASEWORK: TALL CABINET WITH OPEN CUBBIES FOR BOOK BAG STORAGE.
 - L.8 115313 CHEMICAL FUME HOOD - ACCESSIBLE - WITH MOBILE STORAGE BELOW, WHERE SHOWN. TYPICAL FUME HOOD TO HAVE ELECTRIC, AND UTILITIES AS INDICATED.
 - L.9 CABS BELOW WHITEBOARD
 - L.10 CAMERA FOR SKYPE INTERVIEW
 - L.11 GAS CYLINDER STORAGE RACK (CFOI), CYLINDERS TO BE "OF" OF
 - L.12 RECESSED MOTORIZED ROOM DARKENING / BLACKOUT SHADES. USE DOUBLE SHADES AT WEST CLASSROOMS LEVEL 02 AND LECTURE HALL. REFER TO REFLECTED CEILING PLANS
 - L.13 LCD MONITOR
 - L.14 MOBILE LABORATORY CASEWORK SYSTEM. SEE DETAIL 09A0911.
 - L.15 MOVEABLE WOOD LABORATORY CASEWORK: TABLE WITH MODIFIED EPOXY COUNTERTOP. CABINETS SUSPENDED BELOW AS INDICATED.
 - L.16 FIXED WOOD LABORATORY CASEWORK: BASE CABINETS, MODIFIED EPOXY COUNTERTOP. WALL CABINETS AS SHOWN ON ELEVATION
 - L.17 SEE CEILING PLAN FOR CEILING MOUNTED UNISTRUT SYSTEM SUPPORTED BY STRUCTURE ABOVE
 - L.18 8" DEEP x 6" WIDE TRENCH WITH METAL COVER TO RECEIVE FLOOR FINISH TO MATCH ADJACENT FLOOR
 - L.19 FLOOR BOX FOR ELECTRICAL & DATA
 - L.20 09 6666 DRY ERASE FINISH (AWC-1)
 - L.21 PROVIDE BLOCKING FOR FIRE EXTINGUISHER, MOUNTING HEIGHT - 3'-0" TO TOP OF EXTINGUISHER. FIRE EXTINGUISHER & ITS BRACKET BY OWNER.
 - L.22 POINT EXHAUST (SNORKEL) FOR SOLDERING. SEE DETAIL 5/ A0913.

- ### LAB UTILITY LEGEND
- CW WATER COLD WATER FAUCET, DECK MOUNTED GOOSENECK WITH SERRATED NOZZLE. VACUUM BREAKER.
 - W-1 WATER GENERAL MIXING FAUCET, DECK MOUNTED WITH VACUUM BREAKER, SERRATED NOZZLE.
 - DI WATER DI WATER FAUCET DECK MOUNTED.
 - PWS WATER PROCESS COLD WATER SUPPLY.
 - PWR WATER PROCESS COLD WATER RETURN.
 - EW WATER EYEWASH, DECK MOUNTED, AUTOFLOW SWING-DOWN.
 - DH WATER DRENCH HOSE.
 - G GAS FUME HOOD CONTROL
 - V VAC FUME HOOD CONTROL
 - V-3 VAC WALL MOUNTED, SINGLE SERRATED OUTLET
 - V-1 VAC TURRET BASE, SINGLE SERRATED OUTLET
 - V-4 VAC OUTLET FOR BIOSAFETY CABINET CONNECTIONS
 - V-5 VAC QUICK DISCONNECT FOR OVERHEAD SERVICE CARRIER
 - A AIR FUME HOOD CONTROL
 - A-1 AIR TURRET BASE, SINGLE SERRATED OUTLET
 - A-3 AIR WALL MOUNTED, SINGLE SERRATED OUTLET
 - A-4 AIR OUTLET FOR BIOSAFETY CABINET CONNECTIONS
 - A-5 AIR QUICK DISCONNECT FOR OVERHEAD SERVICE CARRIER
 - N NITROGEN FUMEHOOD CONTROL
 - E ELEC. DUPLEX OUTLET (GF) ON FUME HOOD
 - E-1 ELEC. COUNTERTOP MOUNTED PEDESTAL, (1) DUPLEX ELECTRICAL OUTLET.
 - E-2 ELEC. COUNTERTOP MOUNTED PEDESTAL, (2) DUPLEX ELECTRICAL OUTLET.
 - E-3 ELEC. WALL MOUNTED, (1) DUPLEX ELECTRICAL OUTLET.
 - E-5 ELEC. DUPLEX ELECTRICAL OUTLET ON OVERHEAD SERVICE CARRIER
 - E-6 ELEC. DUPLEX ELECTRICAL OUTLET ON TABLE APRON
 - D DATA DATA OUTLET
 - D-1 DATA COUNTERTOP MOUNTED PEDESTAL, (2) DATA OUTLETS
 - D-5 DATA DATA OUTLET ON OVERHEAD SERVICE CARRIER
 - D-6 DATA DATA OUTLET ON TABLE APRON
 - CS CUP SINK LIPPED MODIFIED EPOXY CUP SINK, 8"x3" W OVAL (DROP-IN).
 - S-1 SINK LIPPED MODIFIED EPOXY ADA SINK 25"x15"x10" (DROP-IN).
 - S-2 SINK LIPPED MODIFIED EPOXY ADA SINK 25"x15"x15" (DROP-IN).
 - S-3 SINK STAINLESS STEEL SINK 25"x15"x10" (DROP-IN).
 - S-4 SINK STAINLESS STEEL ADA SINK 25"x15"x15" (DROP-IN).
 - S-5 SINK LIPPED MODIFIED EPOXY ADA SINK 18"x15"x15" (DROP-IN).
 - S-6 SINK LIPPED MODIFIED EPOXY SINK, 36"x15"x10" (DROP-IN).
 - OSC OVERHEAD SERVICE CARRIER. SEE DETAIL 10 / A0913.
 - PTD PAPER TOWEL DISPENSER

- ### CHEMICAL FUME HOOD LEGEND
- CFH-4 4'-0" WIDE CHEMICAL FUME HOOD
 - CFH-6 6'-0" WIDE CHEMICAL FUME HOOD

- ### LAB GENERAL NOTES
- ALL DIMENSIONS ARE TO GWB FACE PARTITION OR COLUMN CENTERLINE U.N.O.
 - OWNER FURNISHED OWNER INSTALLED (OFOI) ITEMS ARE SHOWN DASHED FOR REFERENCE ONLY. COORDINATE SIZE AND INSTALLATION REQUIREMENTS WITH OWNER'S REPRESENTATIVE.
 - CENTERLINE OF SINKS, U.N.O.
 - ALL APRONS AT OPEN KNEE SPACE TO BE 4" U.N.O. PROVIDE APRON OF SOLID WOOD WITH EASED BOTTOM EDGE. FINISH TO MATCH VENEER SPECIES. MAINTAIN MINIMUM 27" CLEAR ABOVE FLOOR FINISH.
 - CENTER ALL COUNTERTOP MOUNTED UTILITY OUTLETS ON CENTER OF CASEWORK U.N.O.
 - ALL SURFACE MOUNTED RACEWAY TO HAVE OUTLETS AT 2'-0" O.C. AND SHALL BE MOUNTED DIRECTLY ABOVE BACKSPLASH U.N.O.
 - ALL BACKSPLASHES TO BE 4" HIGH U.N.O.
 - DASHED LINES ON ELEVATIONS INDICATED ADJUSTABLE SHELVING INSIDE CASEWORK.
 - PROVIDE FINISHED BACK PANEL AT KNEE SPACES BELOW ALL FUMEHOODS, TYPICAL, SIMILAR TO DETAIL.
 - PROVIDE FINISHED BACK PANEL AT ALL KNEE SPACES, TYPICAL.
 - PROVIDE LOCK AND KEY WHERE A CIRCLE NEXT TO DRAWER OR DOOR HANDLE IS SHOWN OR WHERE NOTED.
 - REFER SHEETS A0914 FOR LABORATORY CASEWORK / MILLWORK DETAILS.
 - FOR TYPICAL MOUNTING HEIGHTS REF. 1A0911
 - ALL CASEWORK TO BE WOOD U.N.O.
 - ALL CASEWORK IS LABORATORY CASEWORK UNLESS NOTED AS MILLWORK OR OFOI. SEE DIVISION 12 5655 - LABORATORY CASEWORK FOR SPECIFICATIONS.
 - ALL EQUIPMENT ITEMS HAVE AN EQUIPMENT TAG - XXXXXX. SEE SHEETS A114 FOR EQUIPMENT SCHEDULES.
 - PROVIDE PAPER TOWEL DISPENSER (PTD) AT EACH SINK LOCATION.



Webster University
Interdisciplinary Science
Building

CANNONDESIGN

1100 Clark Avenue
St. Louis, Missouri 63102
T: 314.241.6250
F: 314.241.2570

William Tao & Associates, Inc.
MERFP Engineer
7955 Manchester Road, Suite 125
St. Louis, MO 63143
314-884-7600

David Mason & Associates, Inc.
Structural & Civil Engineer
800 South Vandeventer Avenue
St. Louis, MO 63110
314.534.1053

Faith Group
Technology
3101 S. Hanley Rd., Suite 100
St. Louis, MO 63143
314.591.2229

Kuhmann Lavitt, Inc.
Environmental Graphics & Signage
7400 Pershing Ave.
St. Louis, MO 63130
314.725.6616

KWA Architects
Architecture
9721 Litzinger Road
St. Louis, MO 63124
314.962.2560

Spellman Brady & Company
Interior Designer
8251 Maryland Avenue, Suite 300
St. Louis, MO 63105
314.862.0070

SWT Design
Landscape Architect
7722 Big Bend Blvd
St. Louis, MO 63119
314.644.5700

Webb Engineering Services, Inc.
Plumbing & Fire Protection
1400 S. 3rd Street, Suite 201
St. Louis, MO 63104
314.558.0600

CONFORMED SET 01 JUL 2016

1 ADDENDUM 3-2 15 APR 2016
ISSUED FOR CONSTRUCTION (BPS) 15 MAR 2016
No. Description Date

Drawing Title:

ENLARGED PLANS-LEVEL 02

Project No.: 04561.01 Checked by:

A0204

© Cannon Design 2015