




© Cannon Design 2015
All rights reserved. No part of this document may be reproduced or transmitted in any form or by any means, electronic or mechanical, including photocopying, recording, or by any information storage and retrieval system, without written authorization by The Cannon Corporation.
3/11/2016 12:42:58 PM

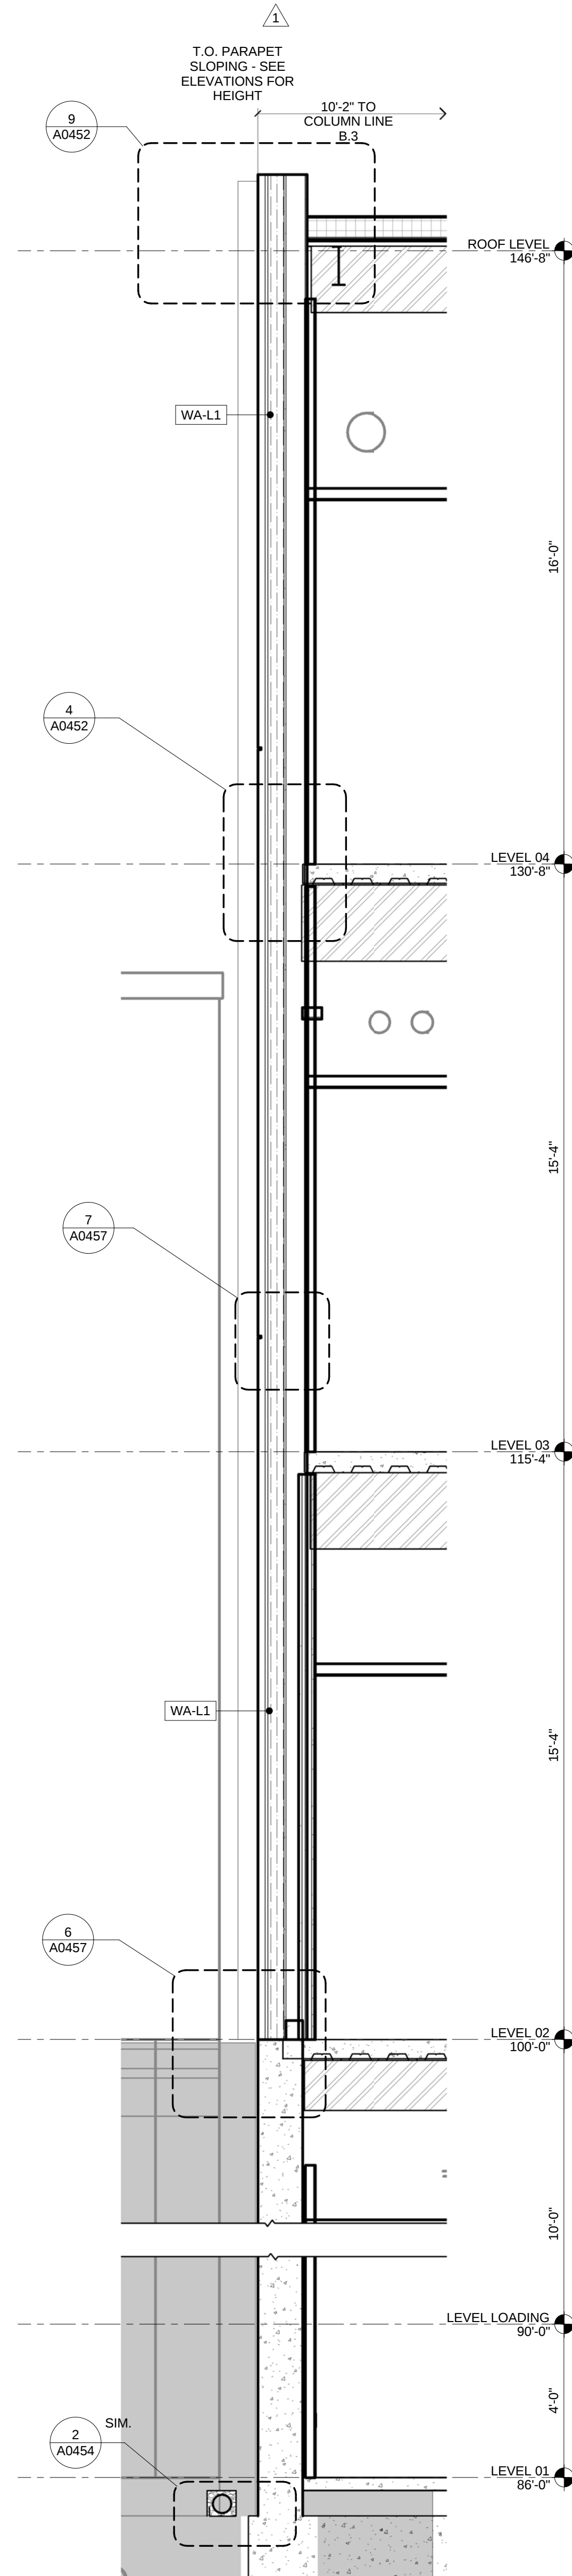


4 SOUTH WALL SECTION - WA-L1
3/8" = 1'-0"

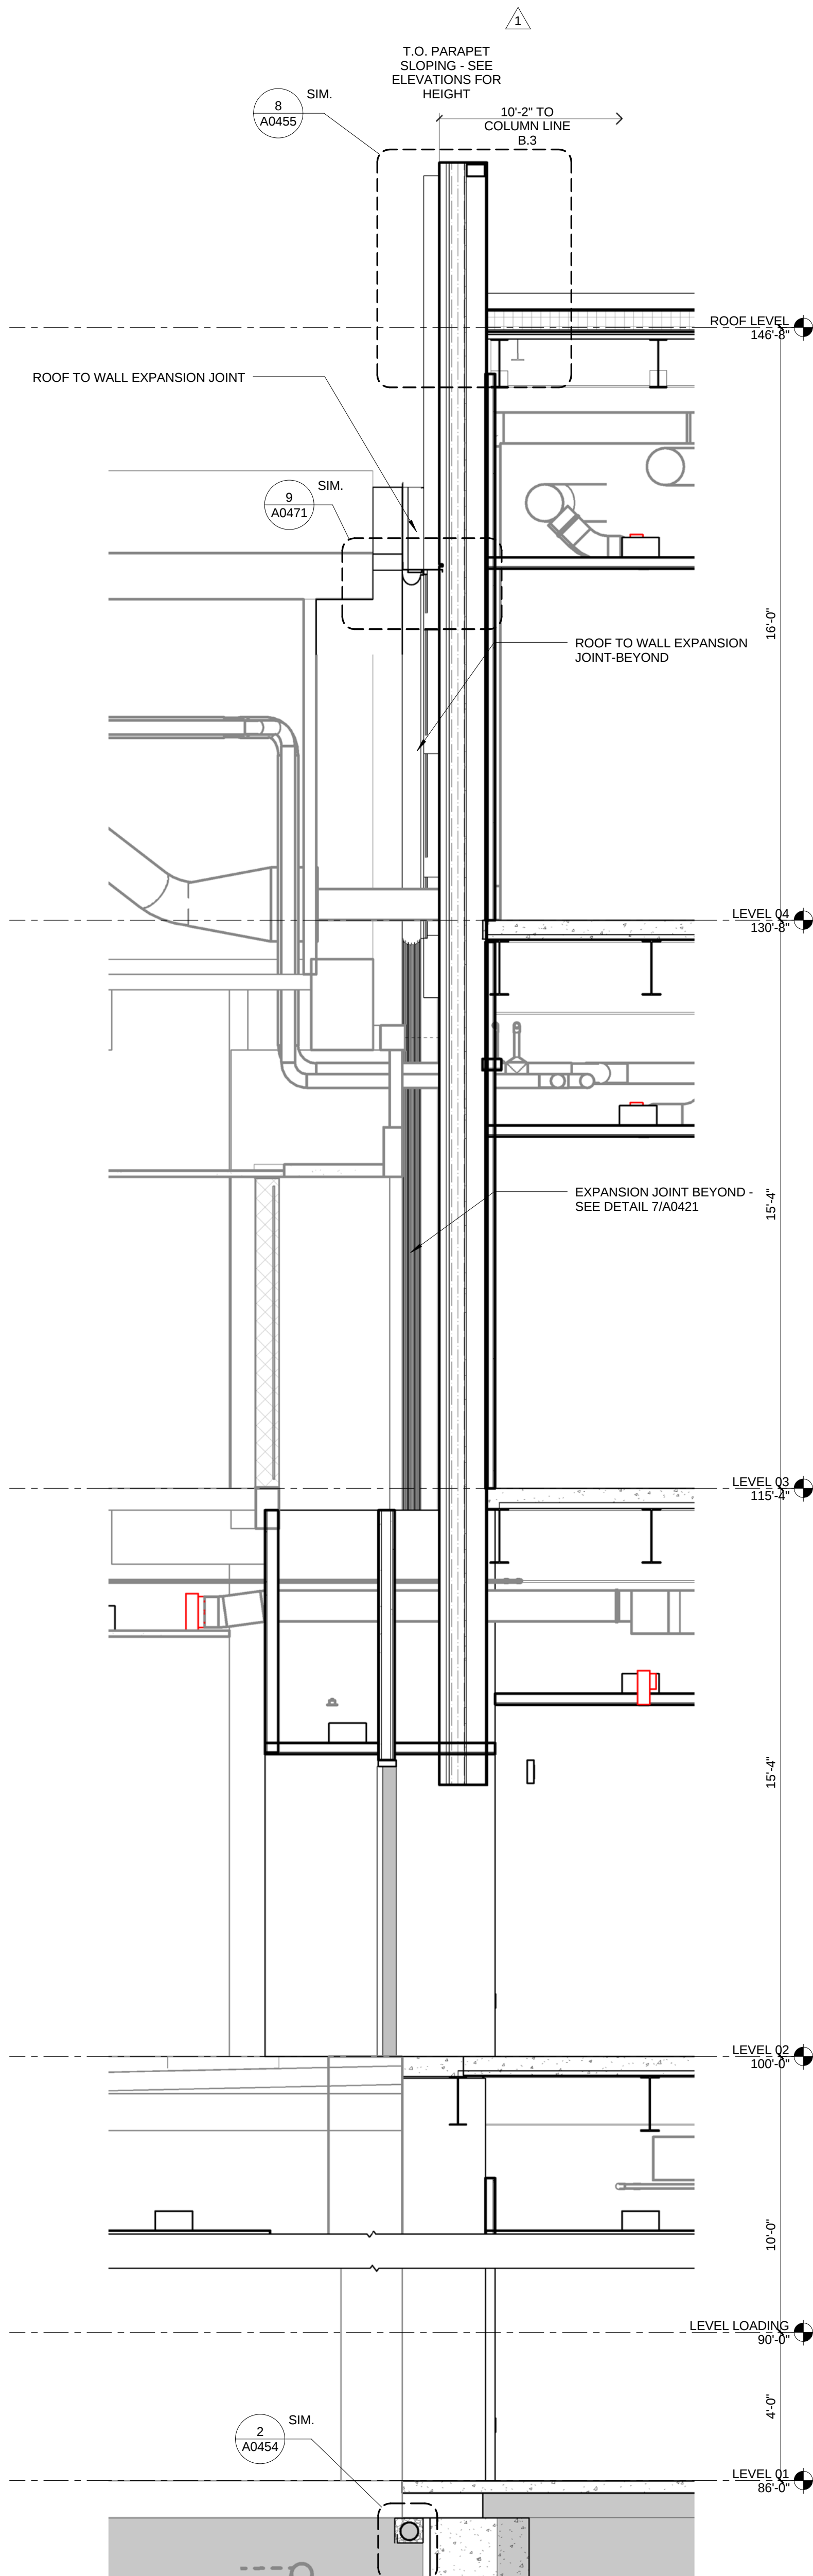


3 WEST WALL SECTION - WA-L1 & EAB CONNECTION
3/8" = 1'-0"

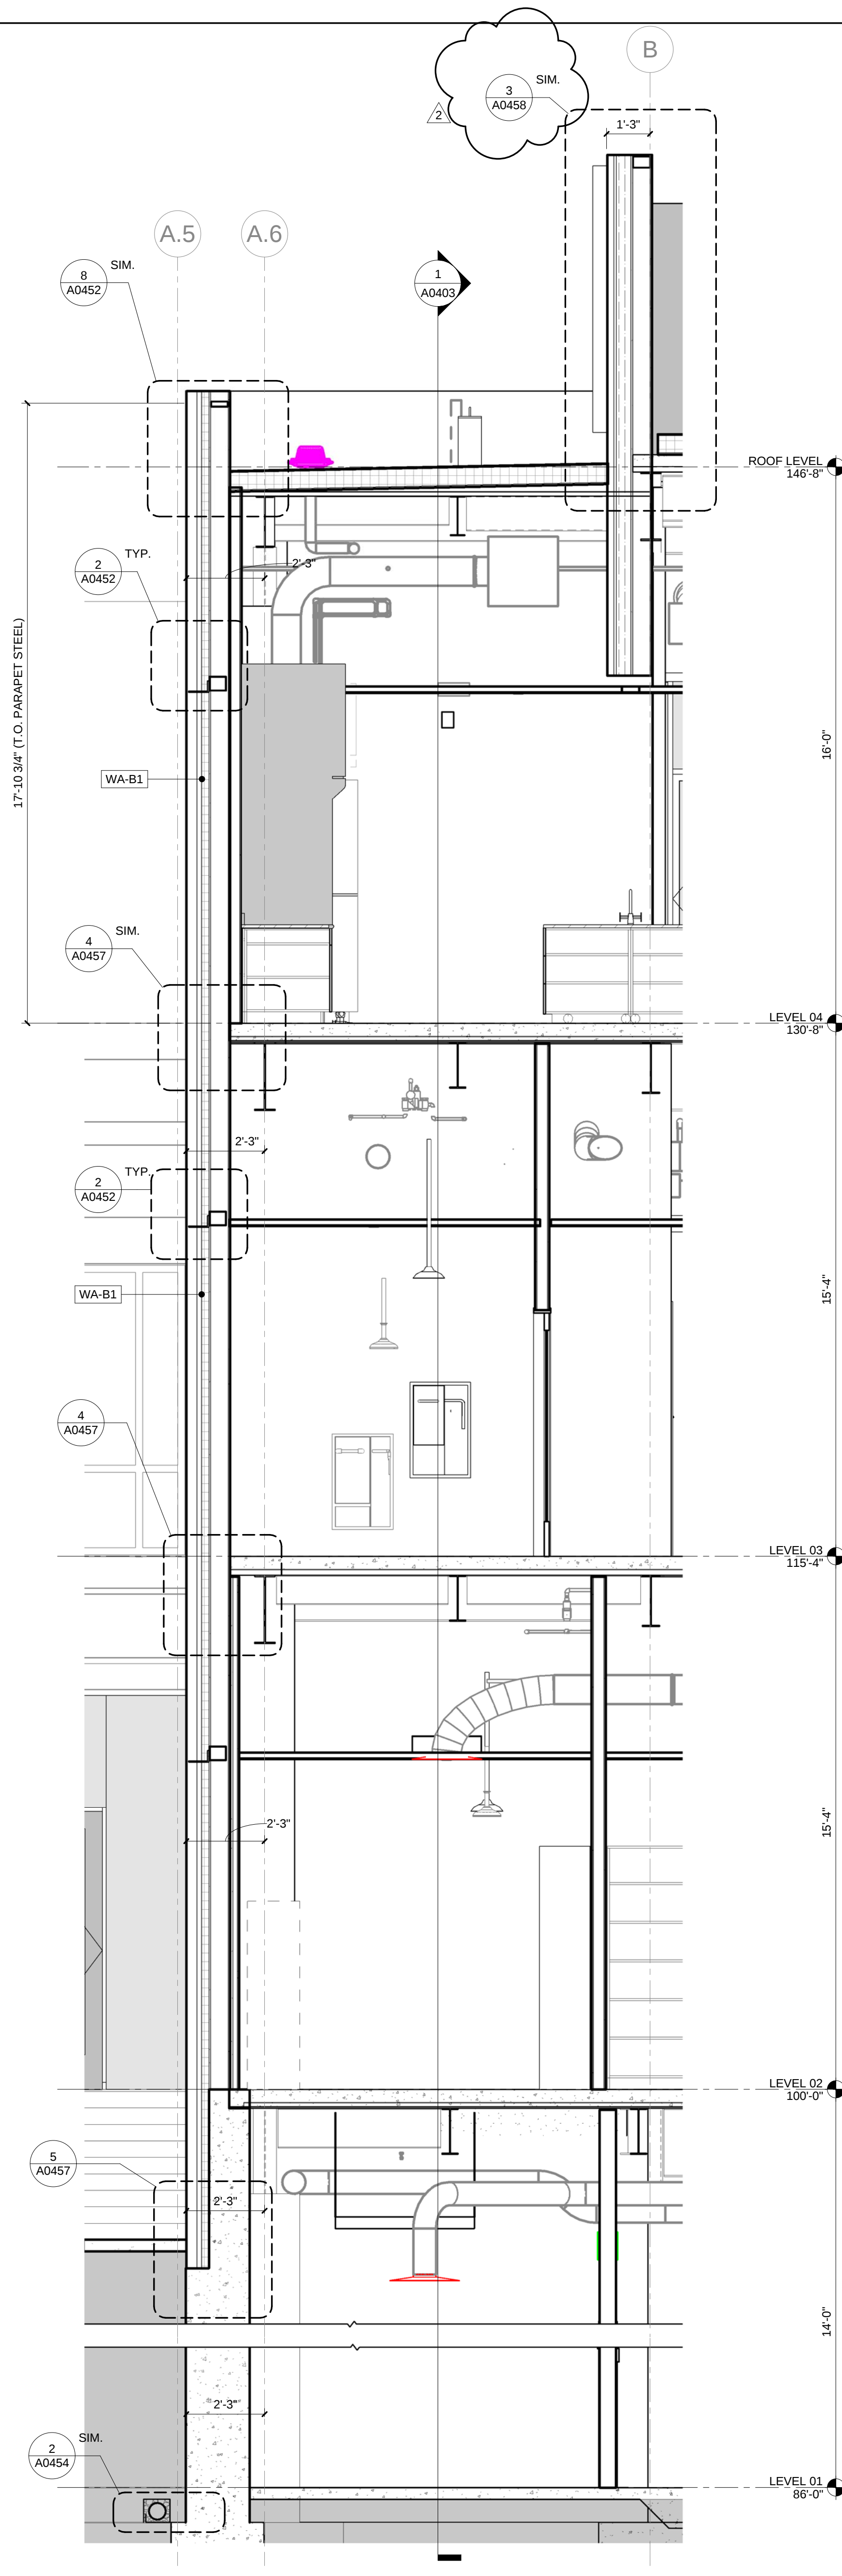

2 SOUTH WALL SECTION - WA-B1
3/8" = 1'-0"

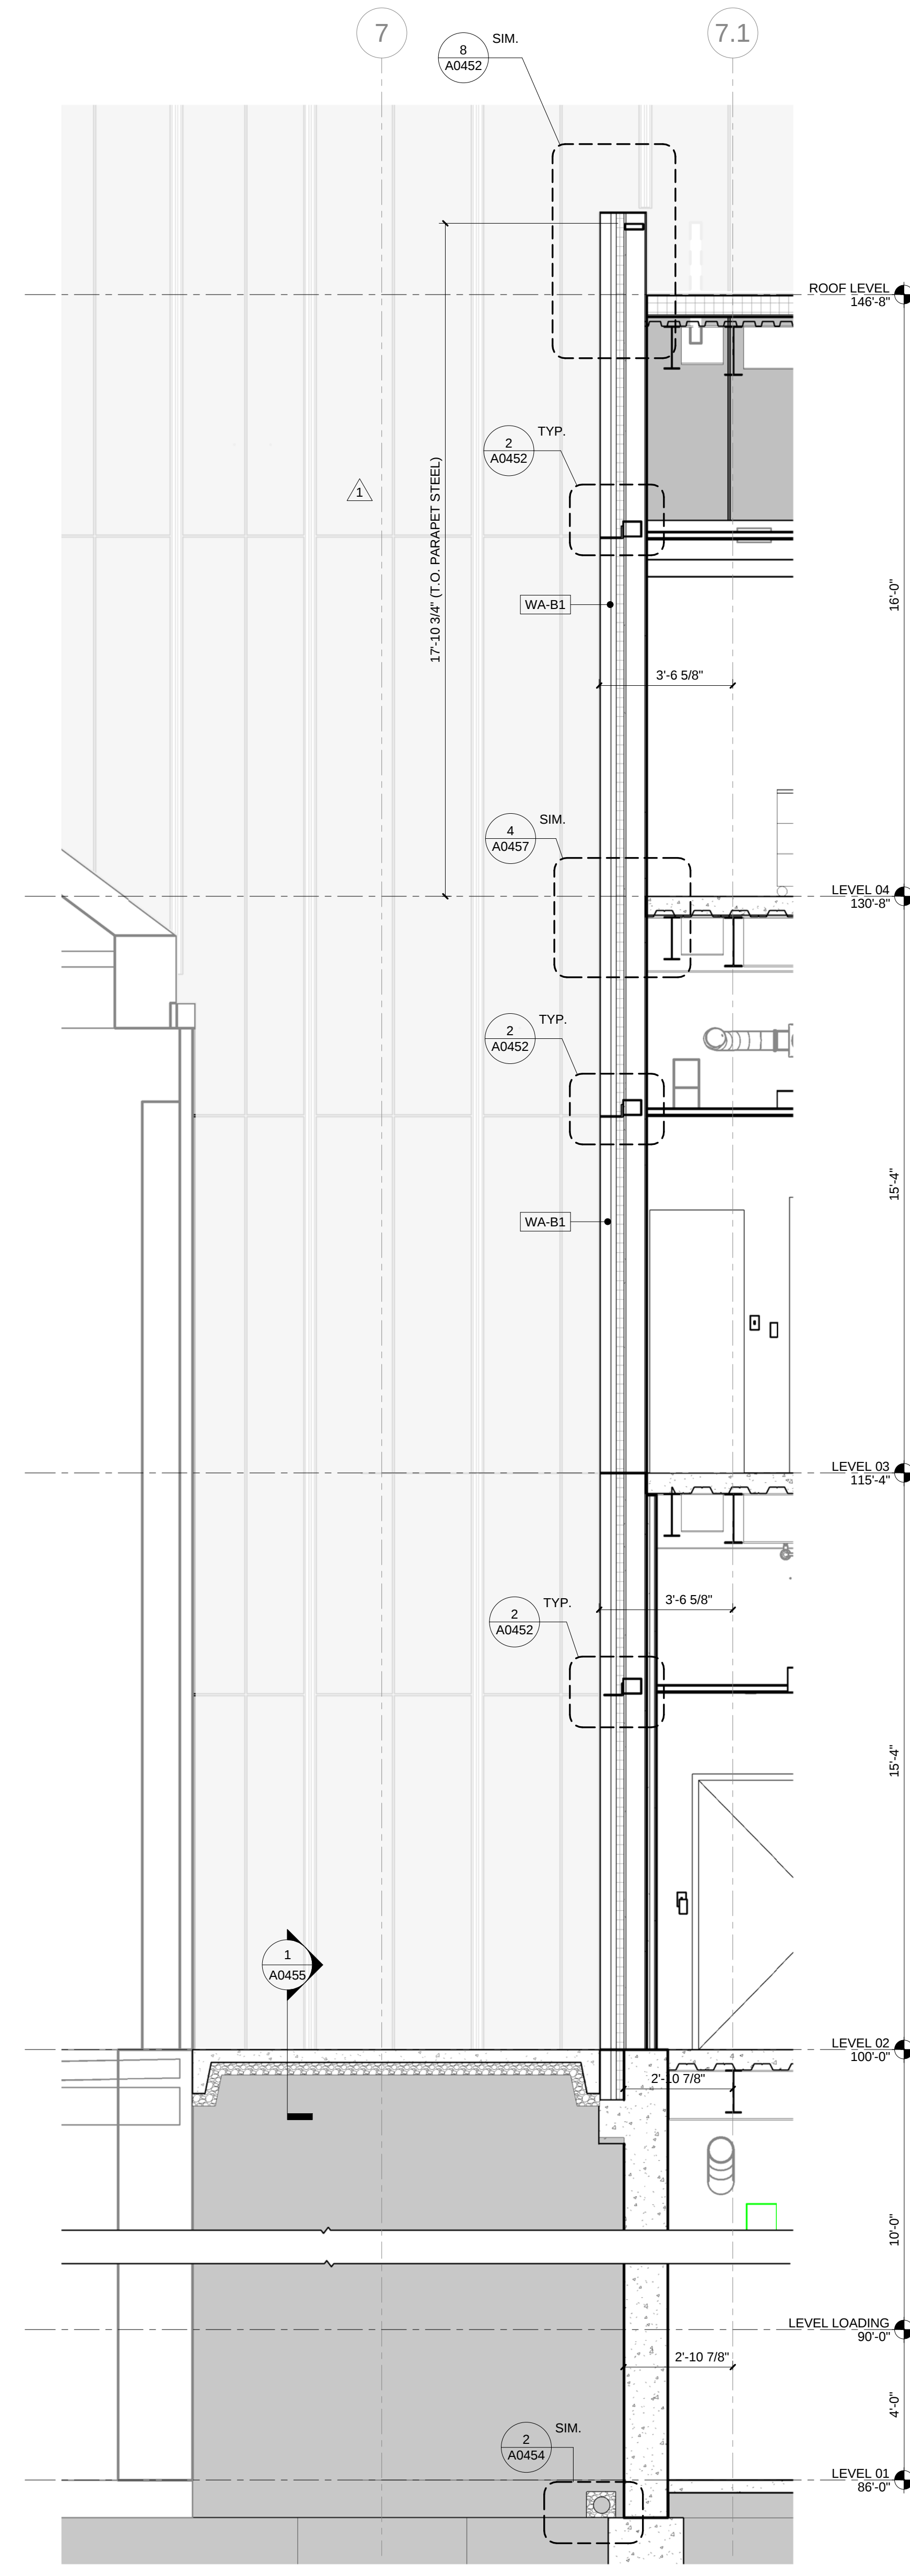

1 WEST WALL SECTION - SOUTH EAB ENTRANCE
3/8" = 1'-0"

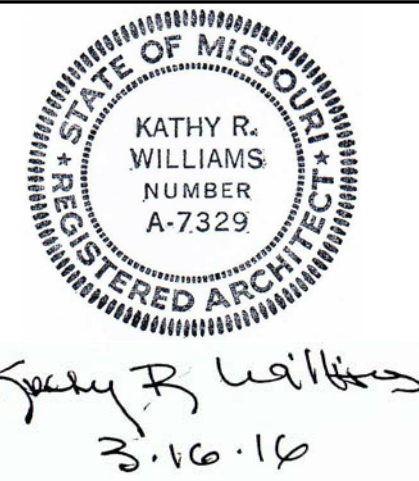

CONFORMED SET 01 JUL 2016

2	ADDENDUM 1-7	16 MAR 2016
1	ADDENDUM 1-1	29 JAN 2016
1	ISSUED FOR CONSTRUCTION (BPI)	15 JAN 2016
No.	Description	Date

Drawing Title:

WALL SECTIONS

Project No.: 04561.01 Checked by:

A0403