
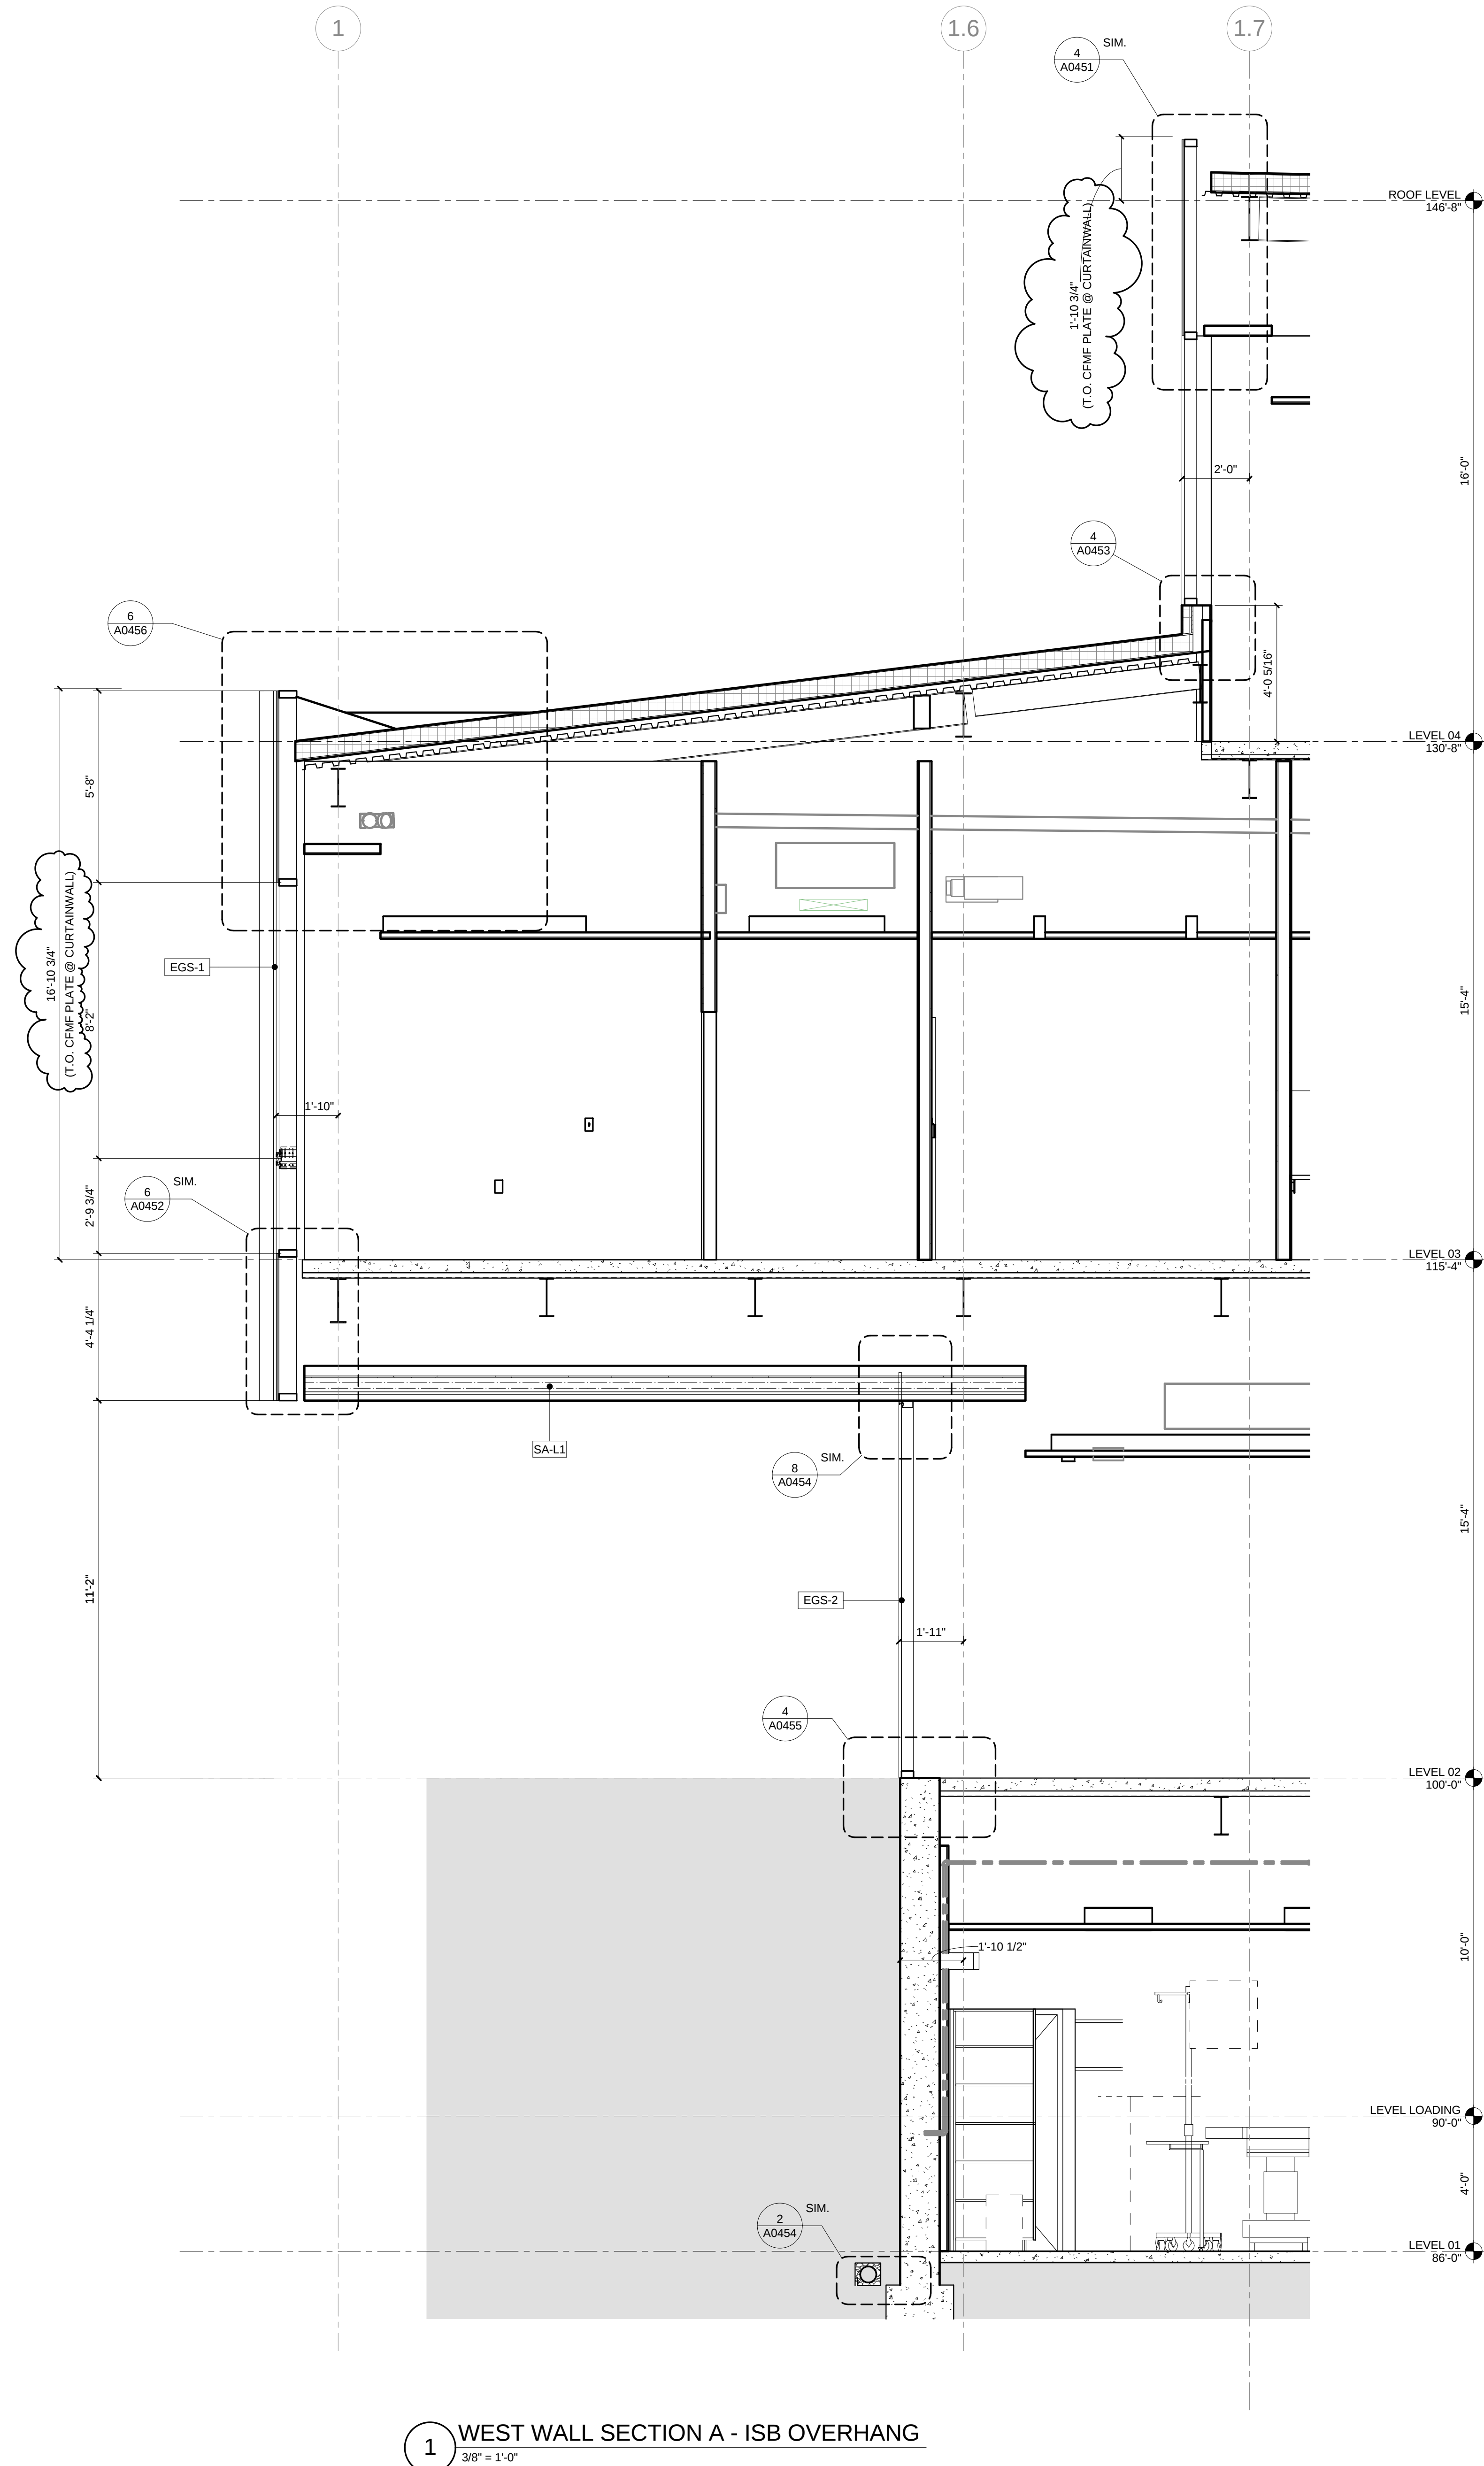


© Cannon Design 2015
All rights reserved. No part of this document may be reproduced or transmitted in any form without written authorization by The Cannon Corporation.
1/28/2016 12:54:05 PM

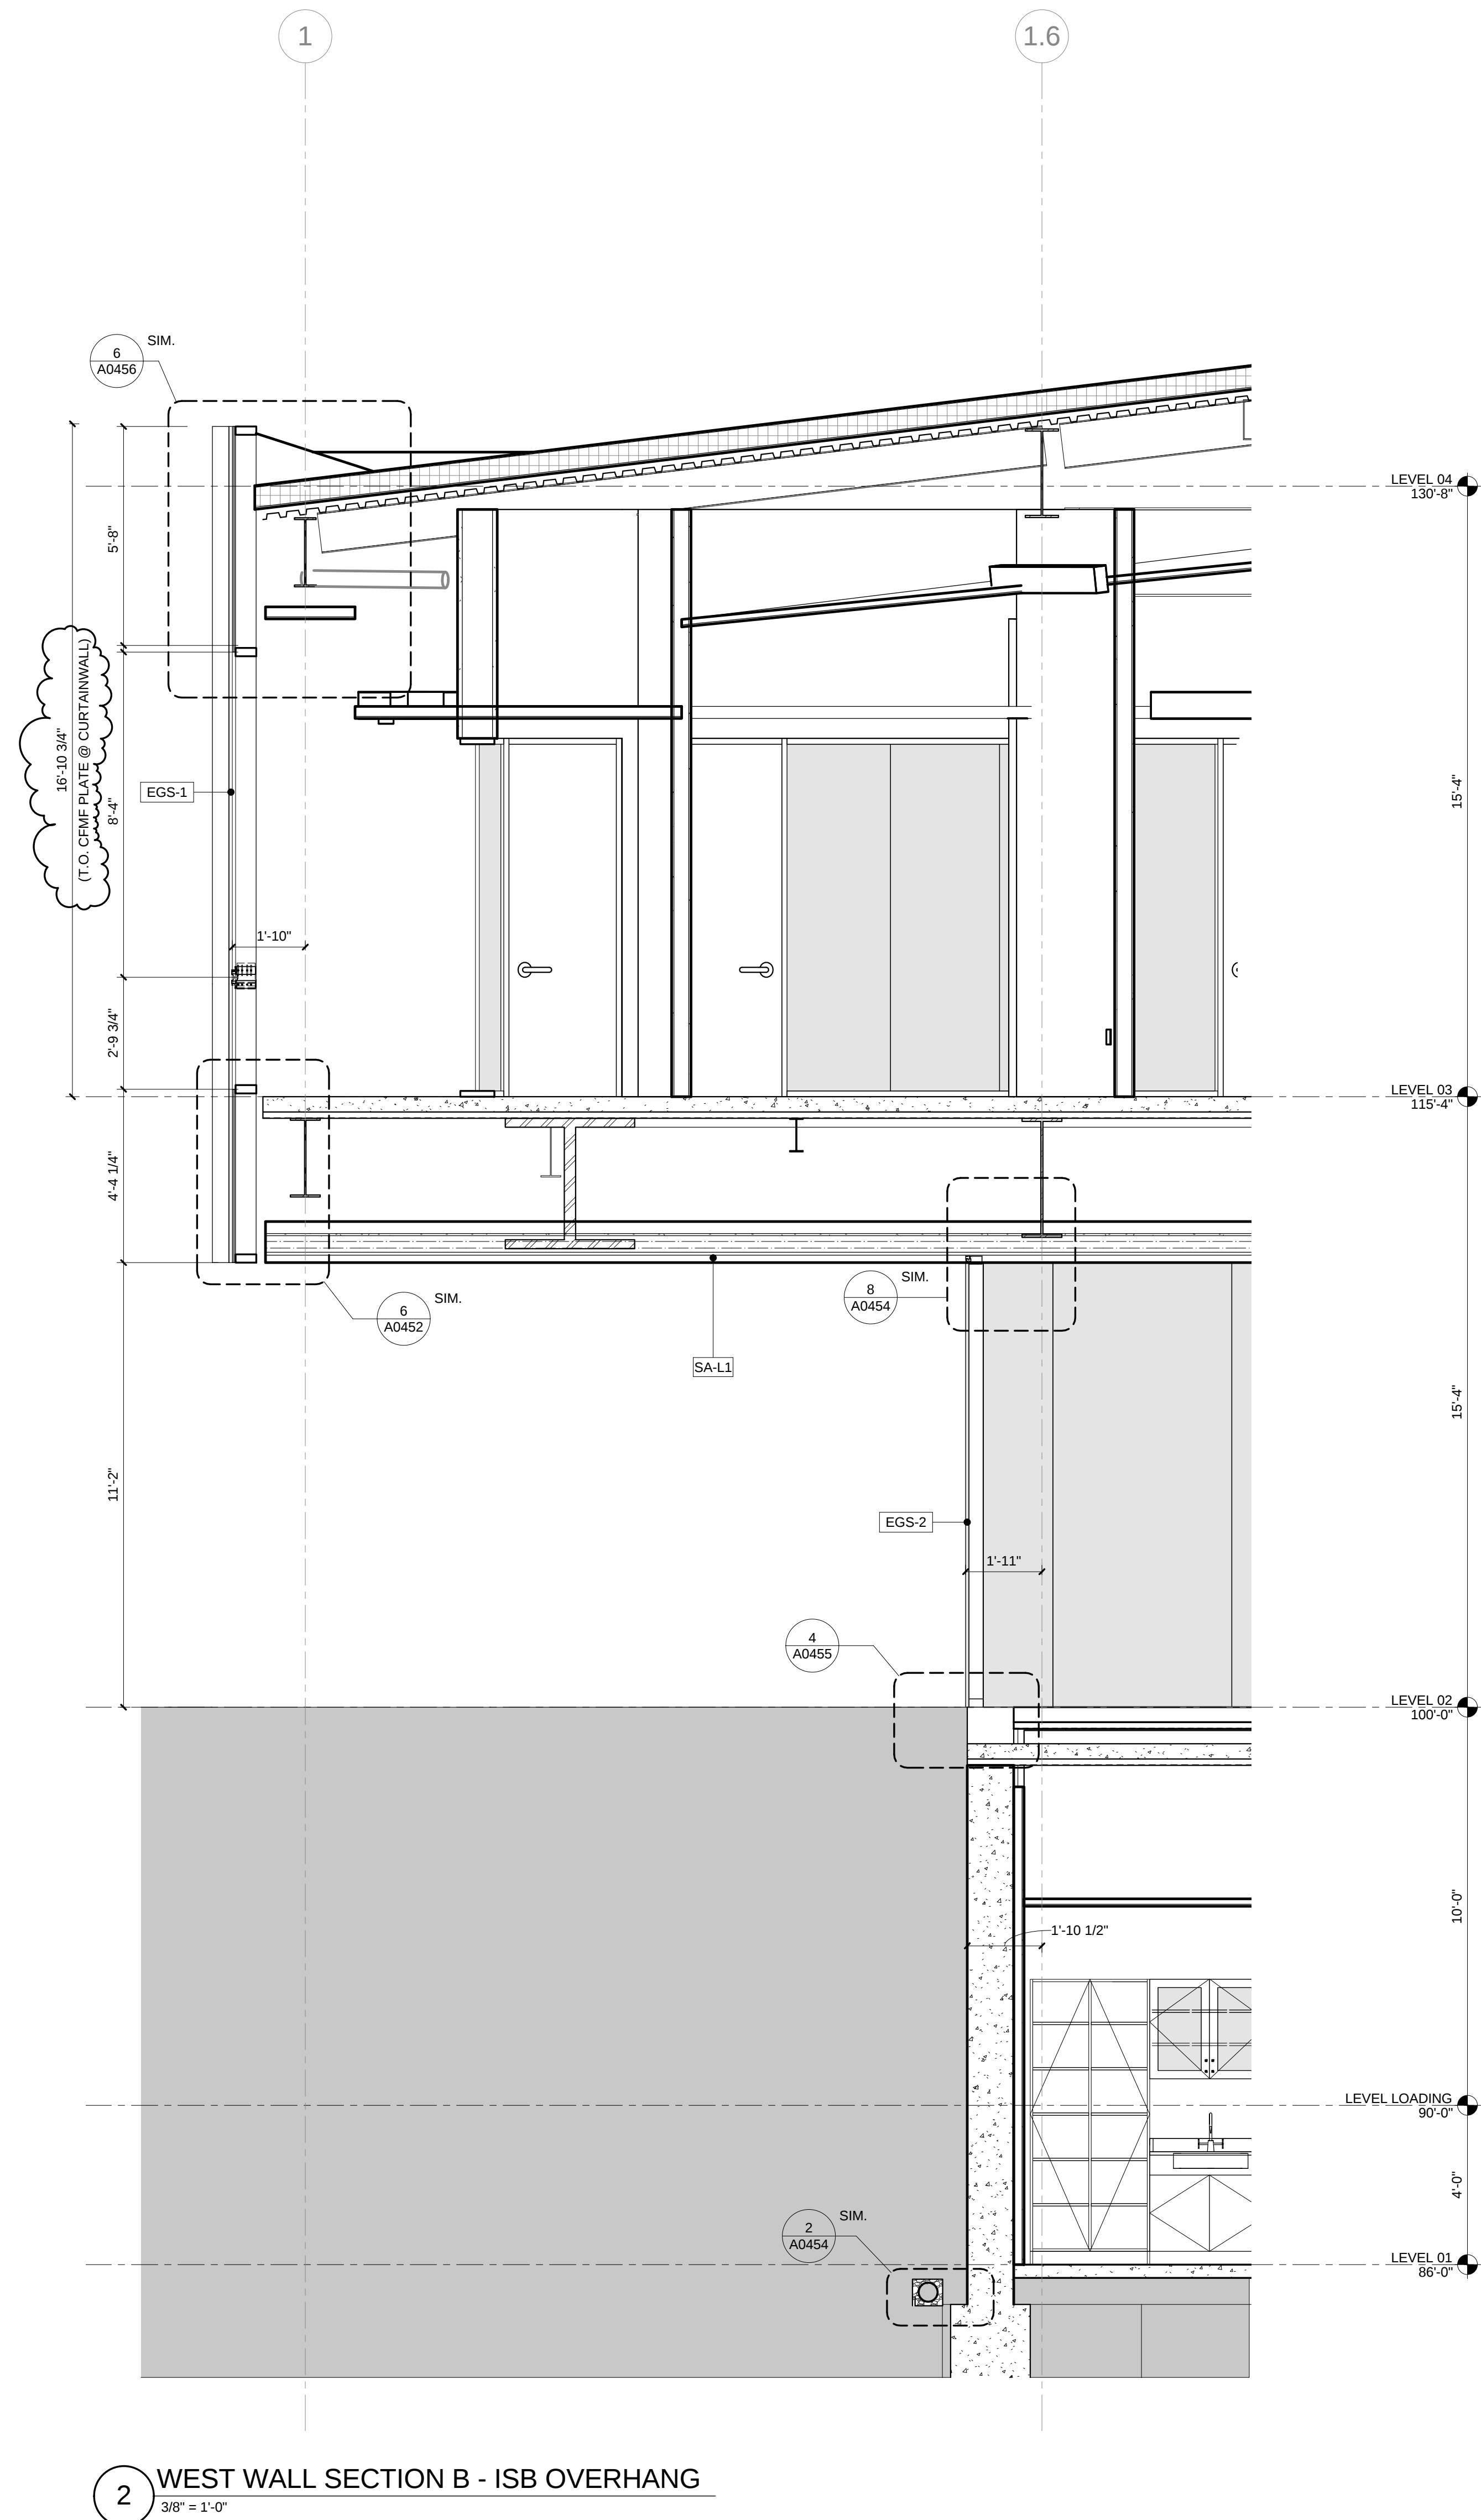

CONFORMED SET 01 JUL 2016

1 ADDENDUM 1-1 29 JAN 2016
ISSUED FOR CONSTRUCTION (BP1) 15 JAN 2016
No. Description Date

Drawing Title:

WALL SECTIONS

Project No.: 04561.01 Checked by:

A0406